CUYAHOGA COUNTY
CUY.-71-13.68

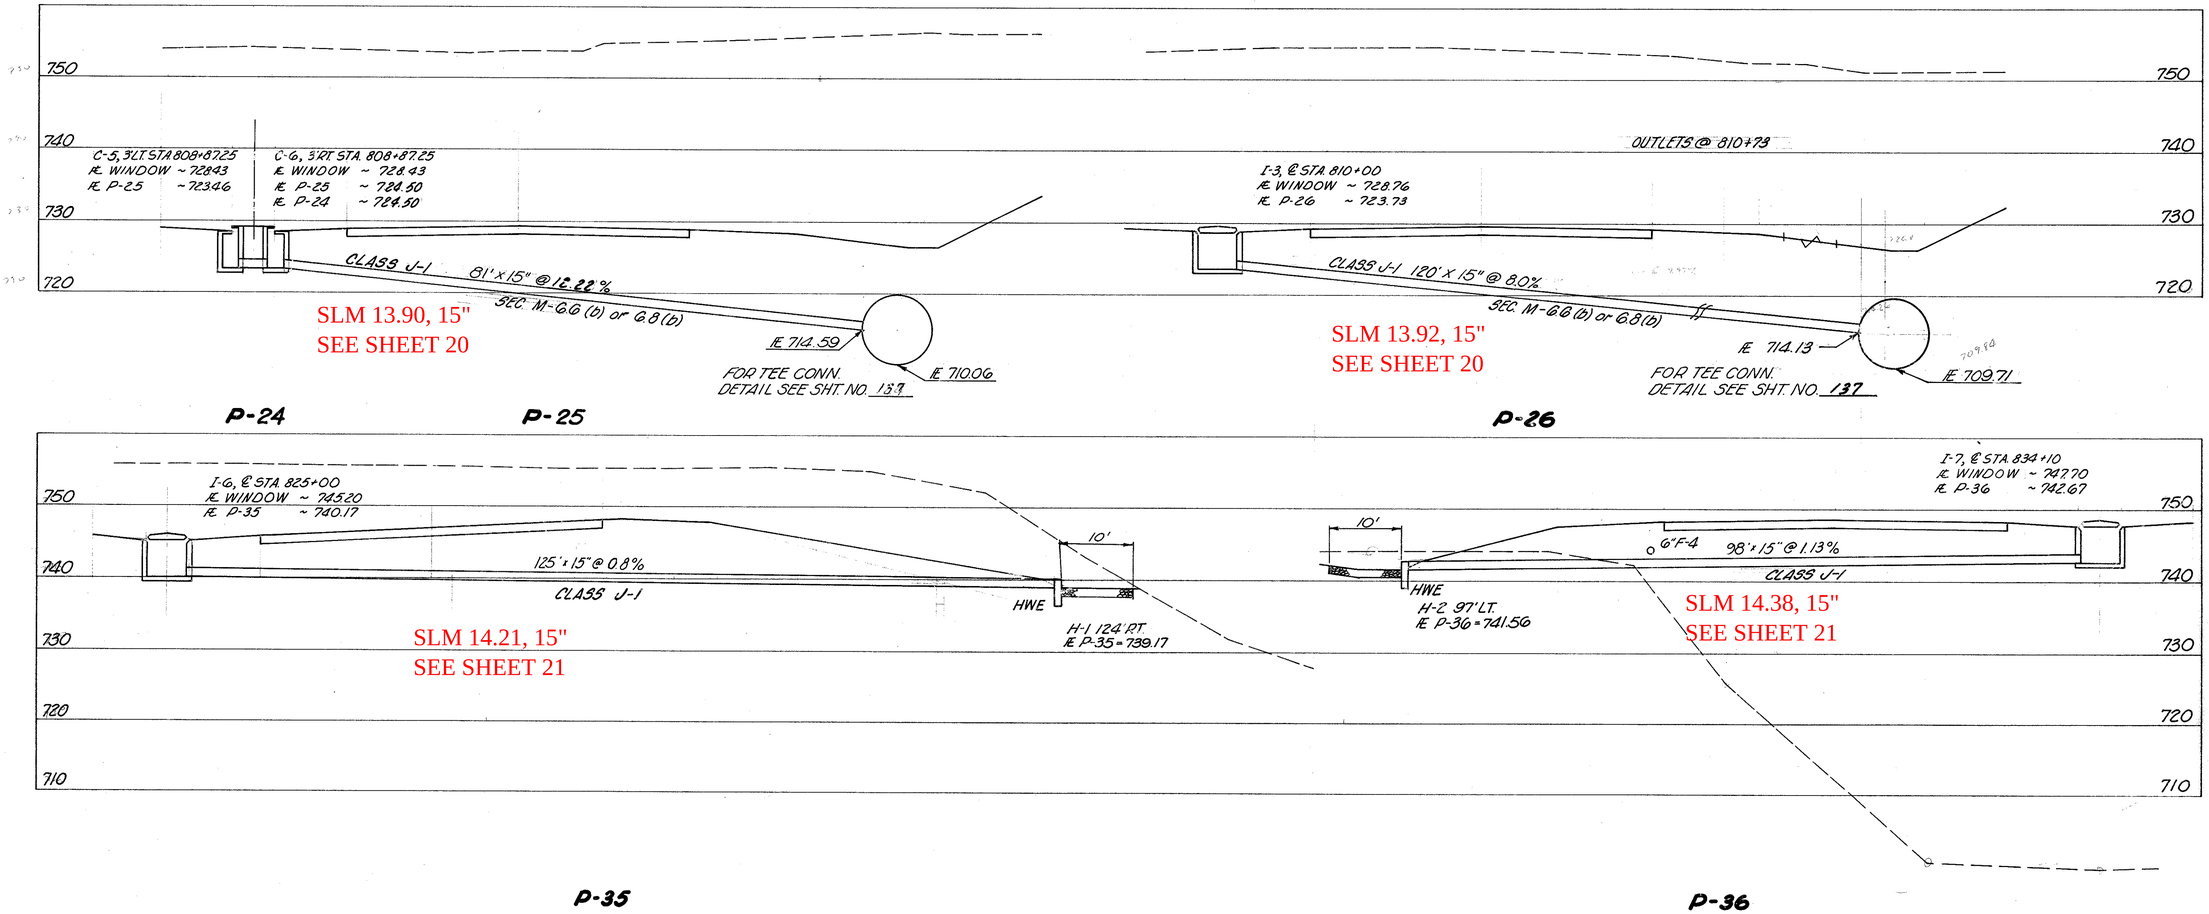

ESTIMATED QUANTITIES

PIPE REFERENCE	STRUCTURES INCLUDED	I-1 CLASS J-1 15" LIN. FT.	I-1 CLASS J-1 SEC. M-6.6 (b) or 6.8 (b) 15" LIN. FT.	I-2 MASONRY C.Y.	I-10 DUMPED ROCK CHANNEL PROTECTION 18" THICK C.Y.	I-8 STANDARD NO. 3 CATCH BASIN EACH	I-8 SPECIAL INLETS NO. 2-6 EA.	I-8 SPECIAL INLETS NO. 2-14 EACH	SEE SHEET NO.
P-24	C-5	6				1			
P-25	C-6		81			1			
P-26	I-3		120				* 1		
P-35	I-6	125		0.26	2			1	
P-36	I-7	98		0.26	2		1 *		
TOTALS		229	201	0.52	4	2	2	1	