CUYAHOGA COUNTY
CUY-71-13.68

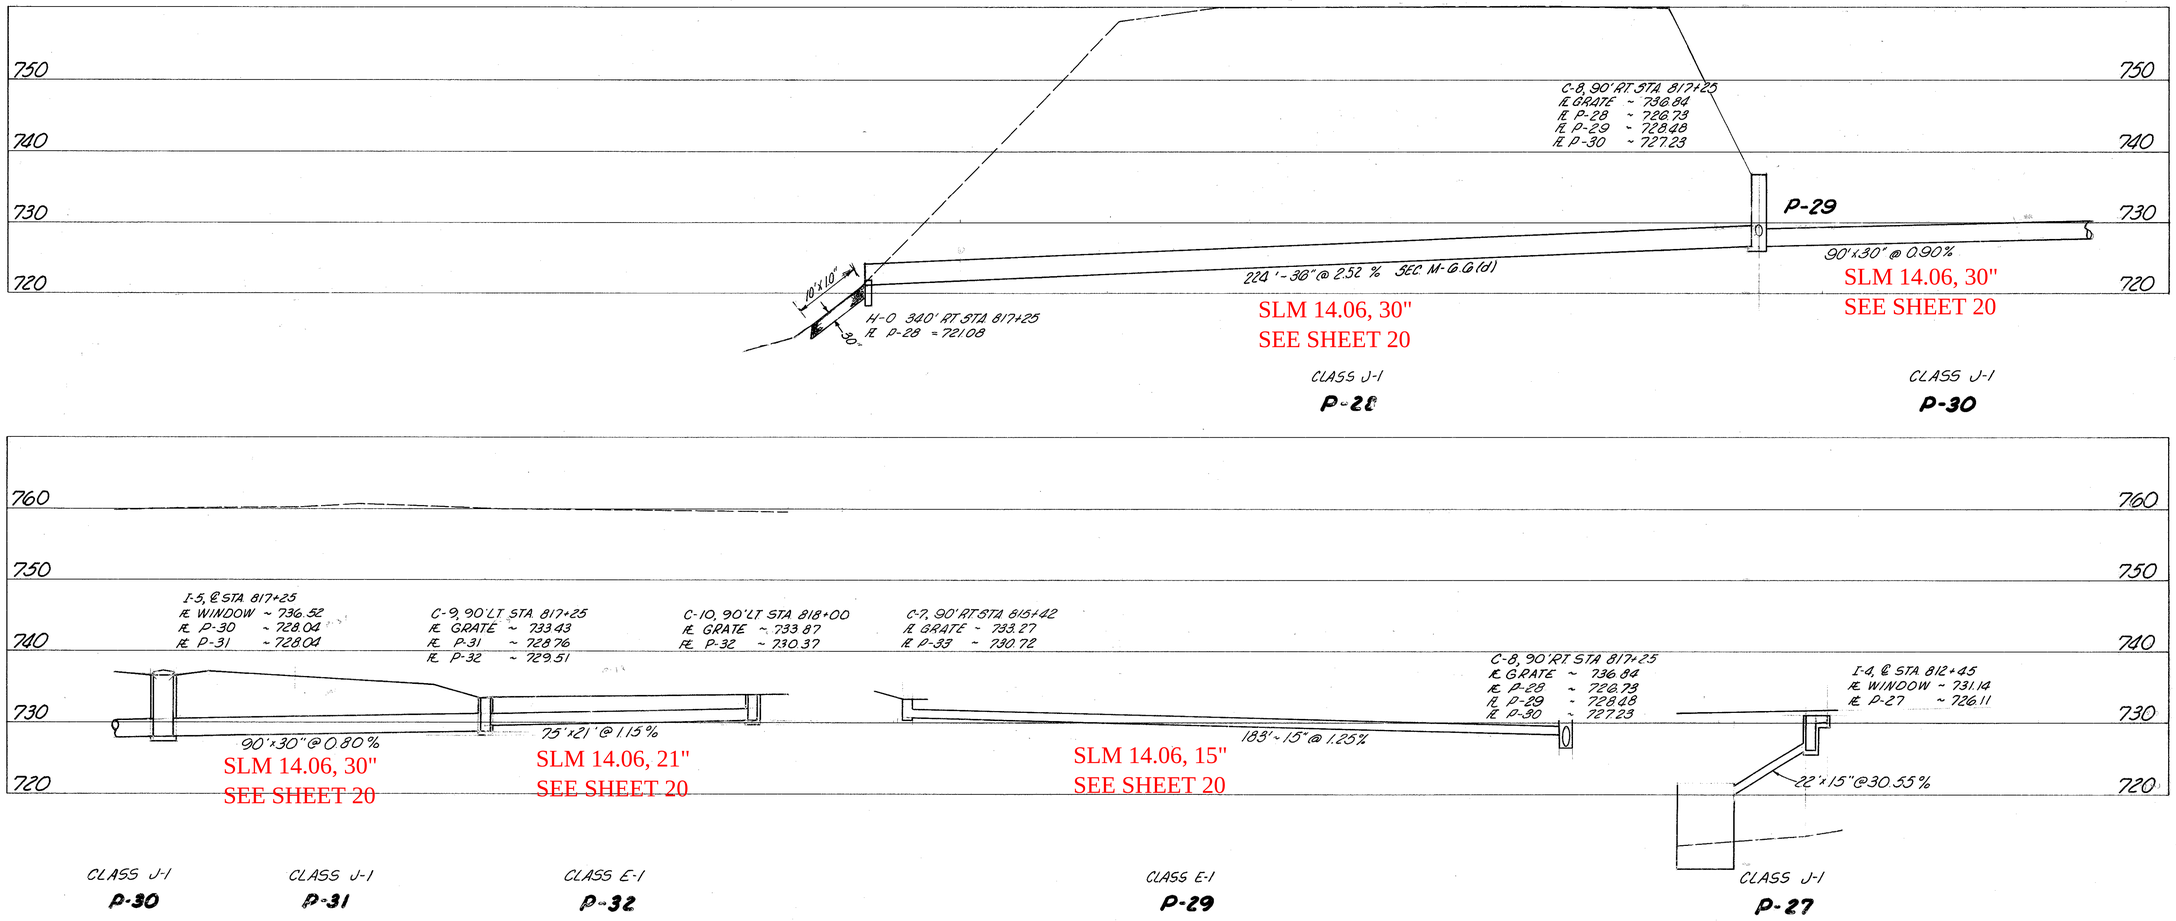

ESTIMATED QUANTITIES

PIPE REFERENCE	STRUCTURES INCLUDED	I-1 CLASS J-1 M-6.6(b) M-6.8(a) 15" LIN. FT.	I-1 CLASS J-1 30" LIN. FT.	I-1 CLASS J-1	I-1 CLASS J-1	I-1 CLASS J-1 Sec M 6.6(d) 36" LIN. FT.	I-1 CLASS E-1	I-1 CLASS E-1 15" LIN. FT.	I-1 CLASS E-1 21" LIN. FT.	I-8 STANDARD NO. 2-5 C.B. MODIFIED EACH	I-8 SPECIAL INLET NO. 2-6 EACH	I-8 SPECIAL INLET NO. 2-12 EACH	I-8 STANDARD NO. 5 CATCH BASIN EACH	L-120 JUTE MATTING S.Y.	I-10 DUMPED ROCK CHANNEL PROTECTION C.Y.	I-2 MASONRY C.Y.		SEE SHEET NO.
P-28	C-7					224							1	125	4	026		
P-29	C-8							183		1				125				
P-30	I-5		90									1						
P-31	C-9		90										1	42				
P-32	C-10								75				1	125				
P-27	I-4	22									1							
TOTALS		22	180			224		183	75	1	1	1	3	417	4	026		