CUYAHOGA COUNTY
CUY-71-13.68

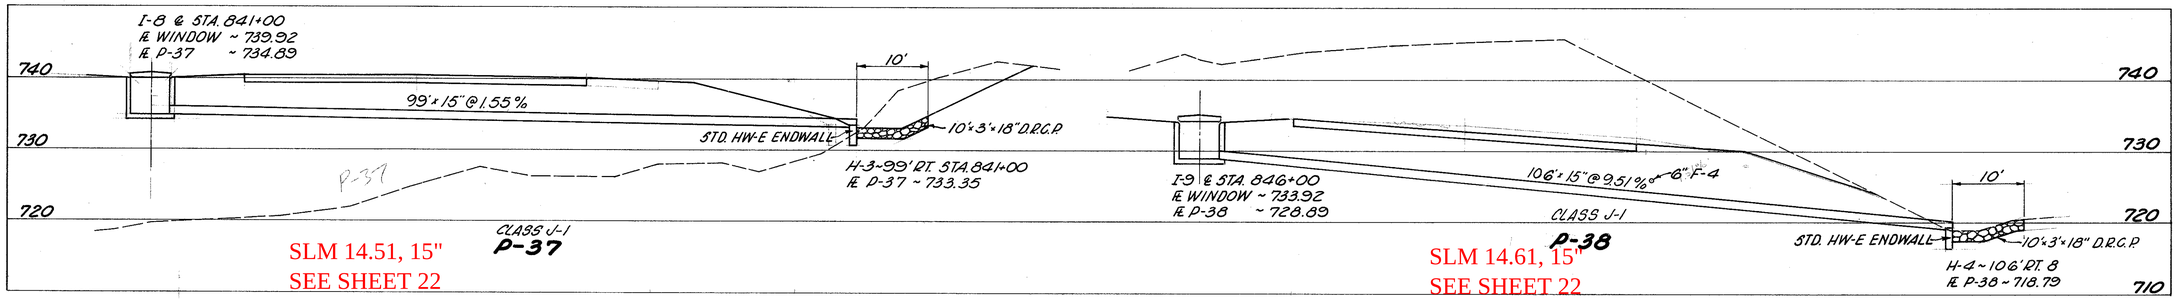

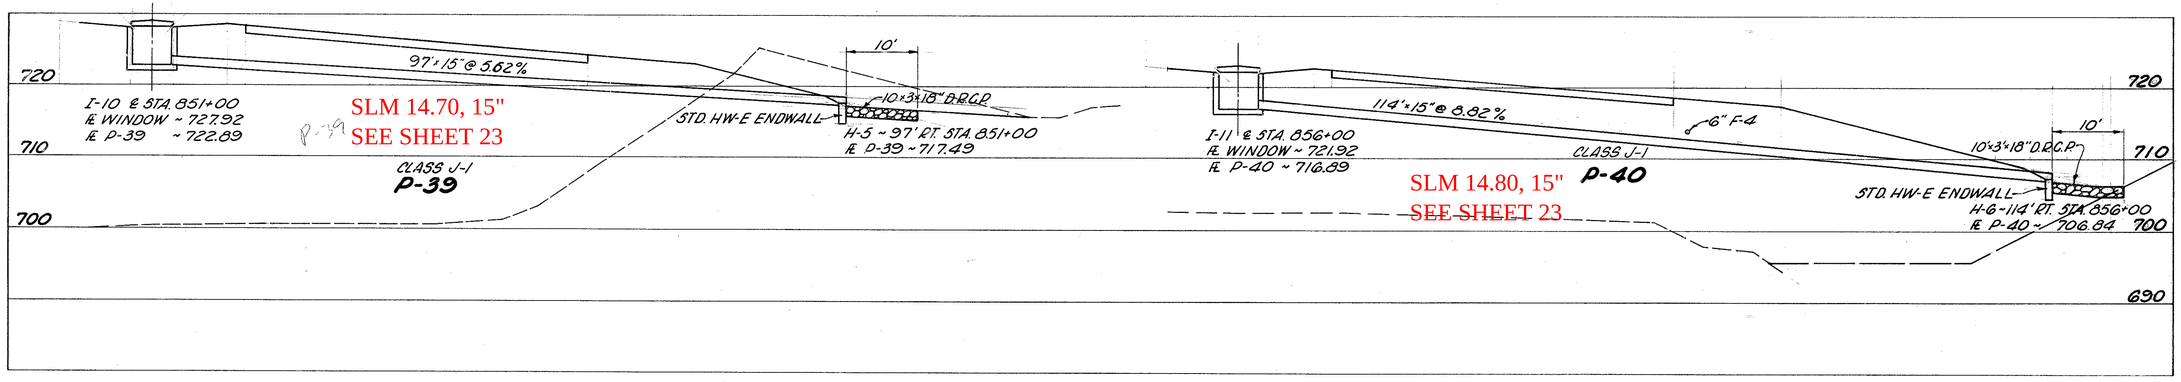

ESTIMATED QUANTITIES

PIPE REFERENCE	STRUCTURES INCLUDED	I-1 CLASS J-1 15"		I-2 MASONRY	I-8 SPECIAL INLET 2-8	I-8 SPECIAL INLET 2-10		I-10 DUMPED ROCK CHANNEL PROT.			SEE SHEET NO.
		LIN. FT.		CU. YDS.	EACH			CU. YDS.			
P-37	I-8, H-3	99		0.26	1			2			
P-38	I-9, H-4	106		0.26		1		2			
P-39	I-10, H-5	97		0.26		1		2			
P-40	I-11, H-6	114		0.26		1		2			
	TOTALS	416		1.04	1	3		8			

PLOTTED BY	DATE	INKED BY	DATE	CHECKED BY	DATE

DESCRIPTION
TOPOGRAPHY
PROFILES
ALIGNMENT
R.O.W.
QUANTITIES