


FED. RD. DIVISION	STATE	PROJECT
2	OHIO	

2
476

CUYAHOGA COUNTY
CITY OF CLEVELAND
MEDINA-CLARK INTERCHANGE
CUY- 71-18.54
CUY- 90-13.81

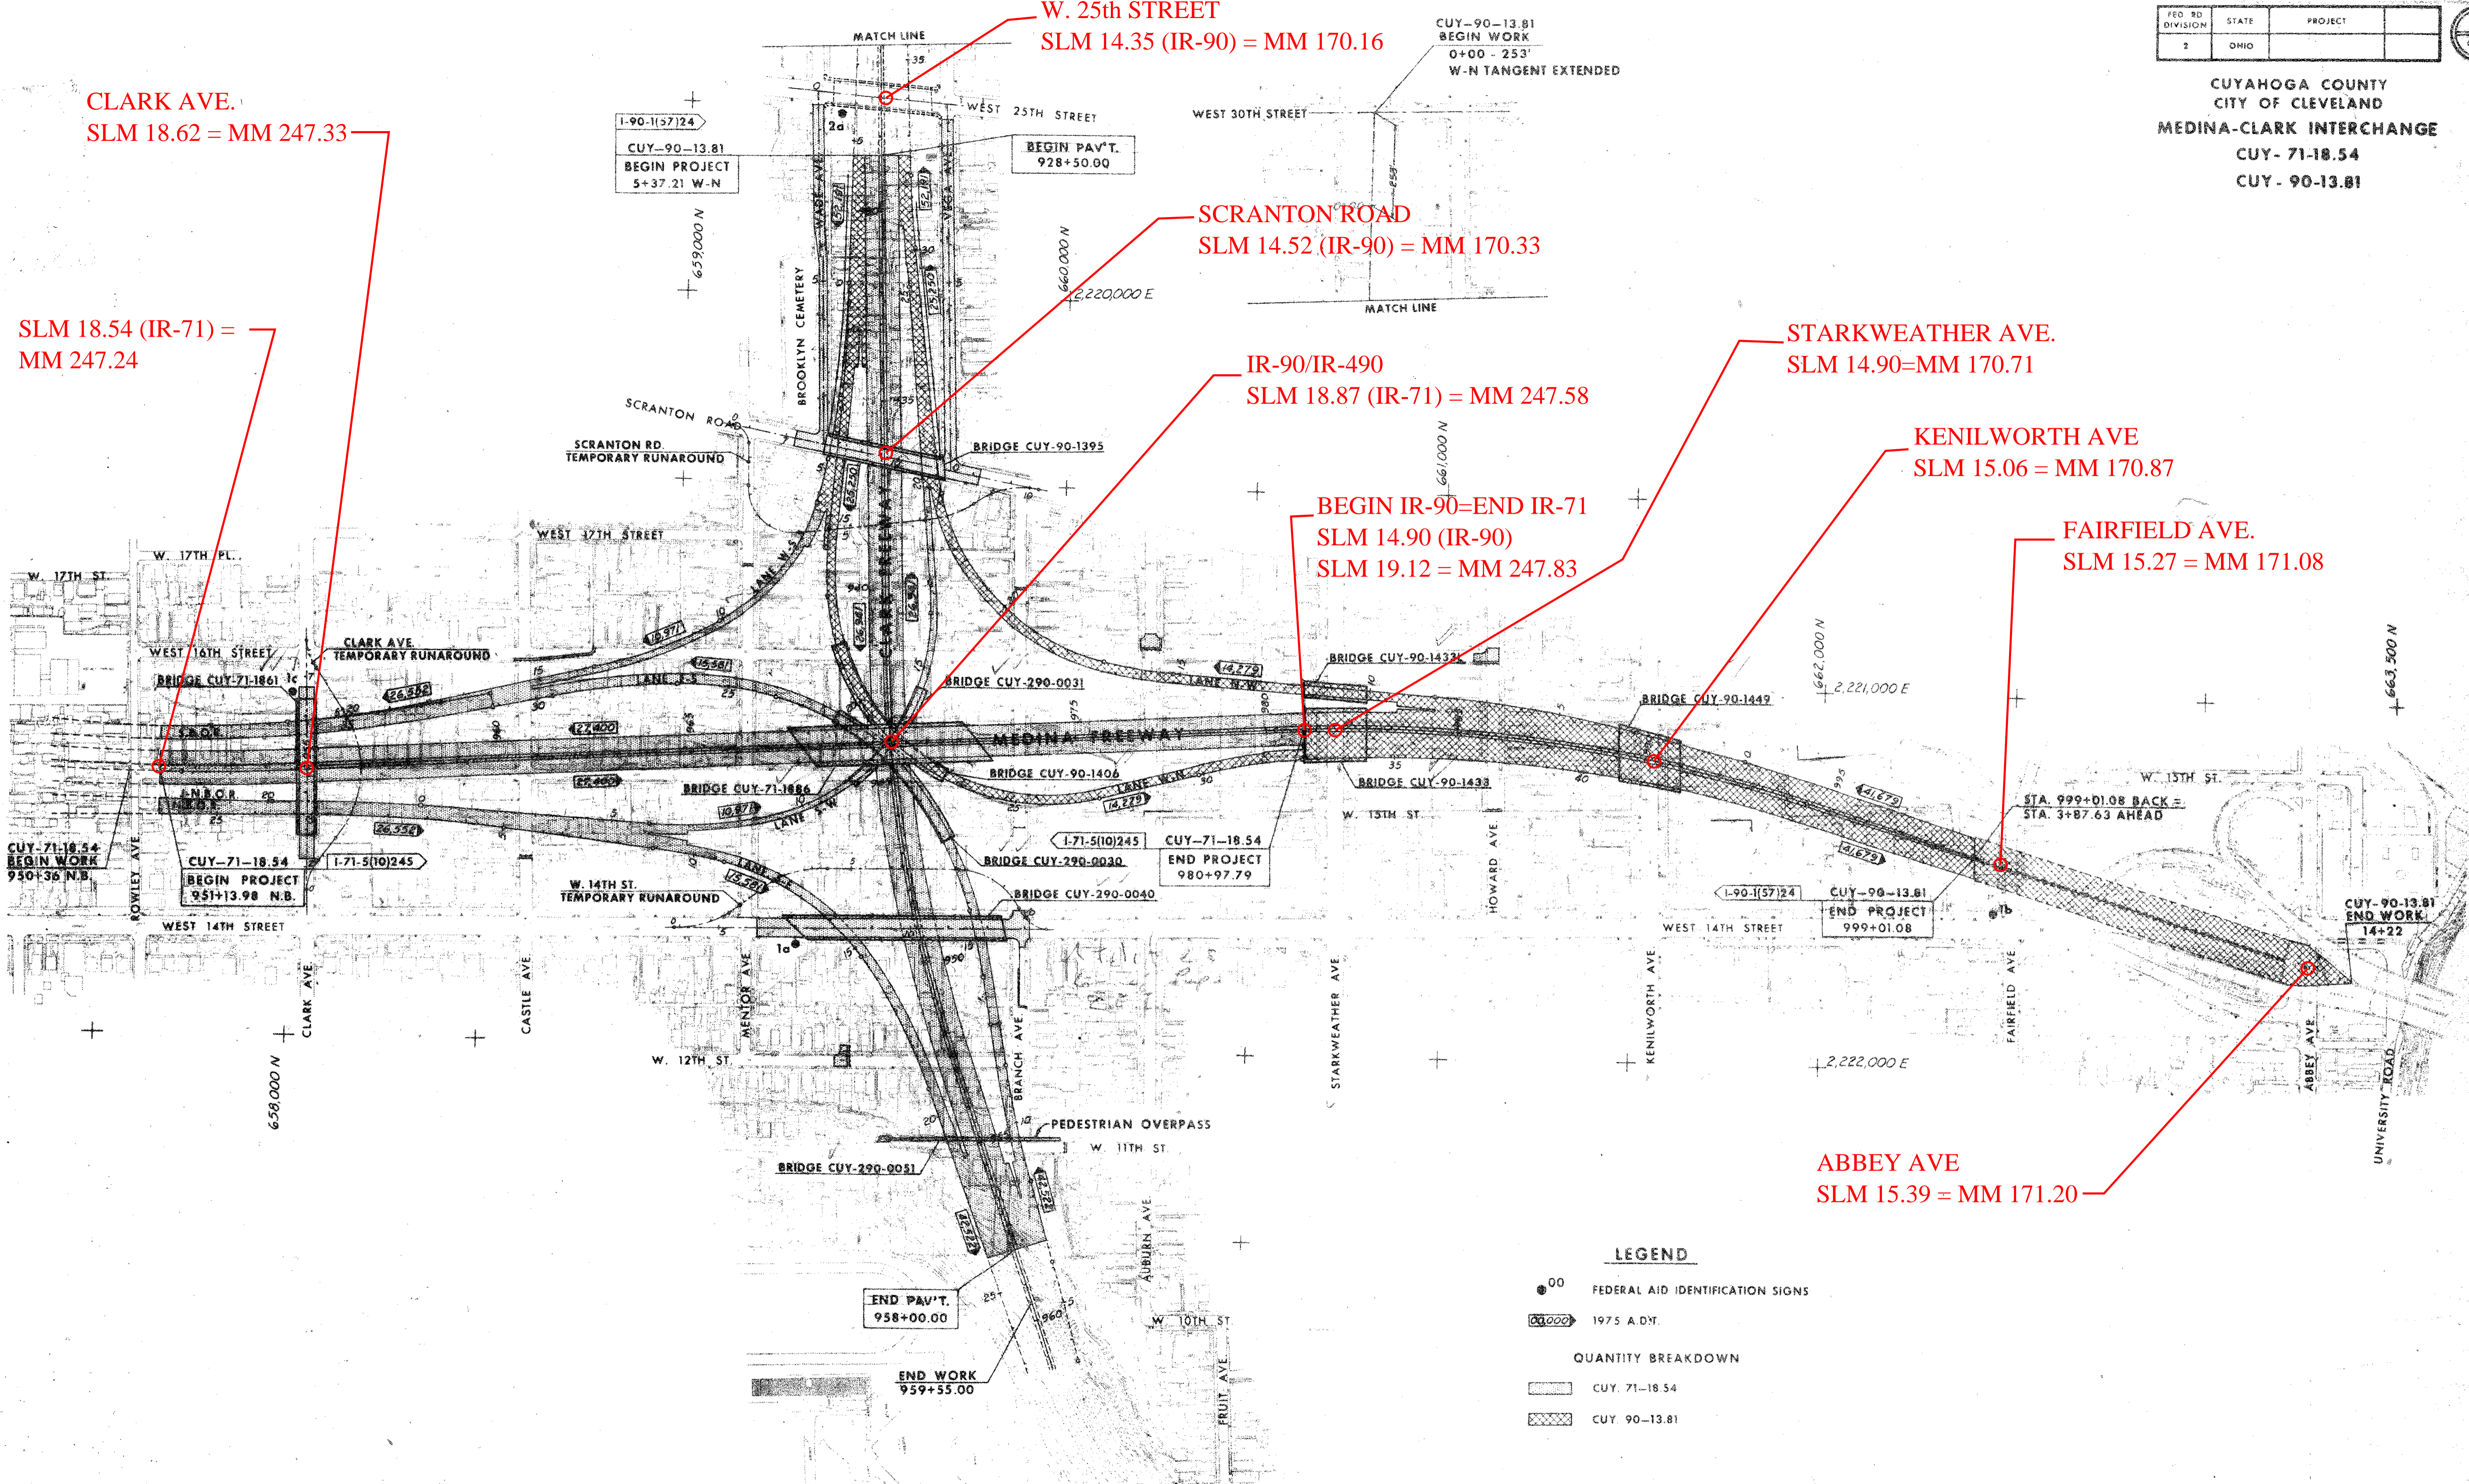

CLARK AVE.
SLM 18.62 = MM 247.33

W. 25th STREET
SLM 14.35 (IR-90) = MM 170.16

SCRANTON ROAD
SLM 14.52 (IR-90) = MM 170.33

IR-90/IR-490
SLM 18.87 (IR-71) = MM 247.58

STARKWEATHER AVE.
SLM 14.90 = MM 170.71

KENILWORTH AVE
SLM 15.06 = MM 170.87

BEGIN IR-90=END IR-71
SLM 14.90 (IR-90)
SLM 19.12 = MM 247.83

FAIRFIELD AVE.
SLM 15.27 = MM 171.08

SLM 18.54 (IR-71) =
MM 247.24

ABBEY AVE
SLM 15.39 = MM 171.20

LEGEND

- 00 FEDERAL AID IDENTIFICATION SIGNS
- 00000 1975 A.D.T.
- QUANTITY BREAKDOWN
- CUY. 71-18.54
- CUY 90-13.81

SCALE 1" = 200'
HOWARD, NEEDLES, TAMMEN & BERGENDOFF
CONSULTING ENGINEERS
MADE DIG DATE 4-2-64
TRCD RHP DATE 4-6-64
CED RHL DATE 4-8-64
KANSAS CITY CLEVELAND NEW YORK

SCHMATIC PLAN