FED. RD. DIVISION	STATE	PROJECT	
2	OHIO		

86
478

CUYAHOGA COUNTY
CITY OF CLEVELAND
MEDINA-CLARK INTERCHANGE
CUY - 71-18.54
CUY - 90-13.81

ESTIMATED QUANTITIES

I-8 STRUCTURES

CODE	LOCATION	Separation Chamber	M.H. No. 2 W/O Drop Pipe	M.H. No. 2 W/Drop
174	0+00 W. 12th St. Connector Sewer	1		
300	0+50 W. 14th St. Connector Sewer	1		
301	2+00 W. 14th St. Connector Sewer		1	
302	0+10 W. 12th St. Connector Sewer			1
303	0+10 W. 12th St. Connector Sewer		1	
304	0+10 W. 12th St. Connector Sewer			1
312	0+10 W. 12th St. Connector Sewer			1
	TOTALS	2	2	3

CODE	ROADWAY	INLET CODE FROM	INLET CODE TO	Class B-1 8" Vit. Clay Encased Sec. M.6.8(b)	Class B-1 12" Vit. Clay Encased Sec. M.6.8(b)
174A	W. 12th Street	174	302	18	
300	W. 14th Street	300	301	216	
301	W. 14th Street	301	302		165
302	W. 12th Street	302	303		109
303	W. 12th Street	303	304		35
304	W. 12th Street	304	312		68
	TOTALS			234	377

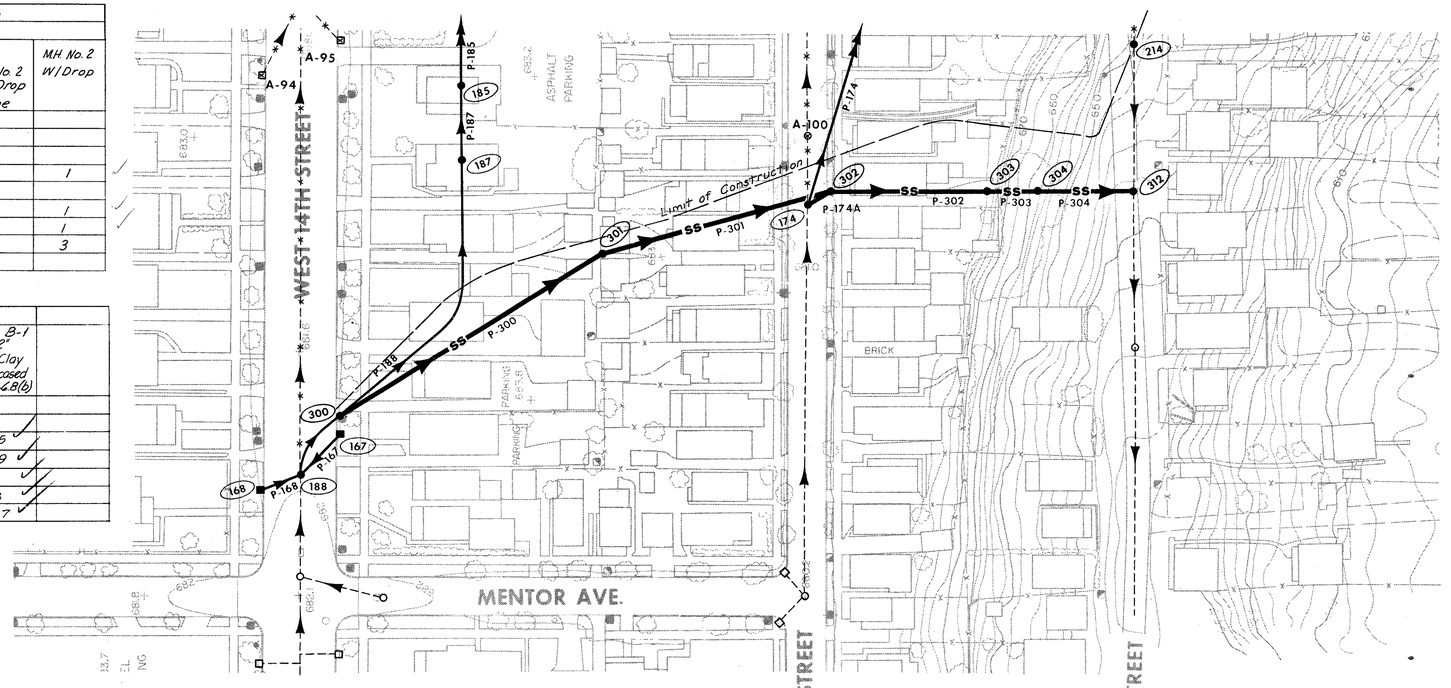

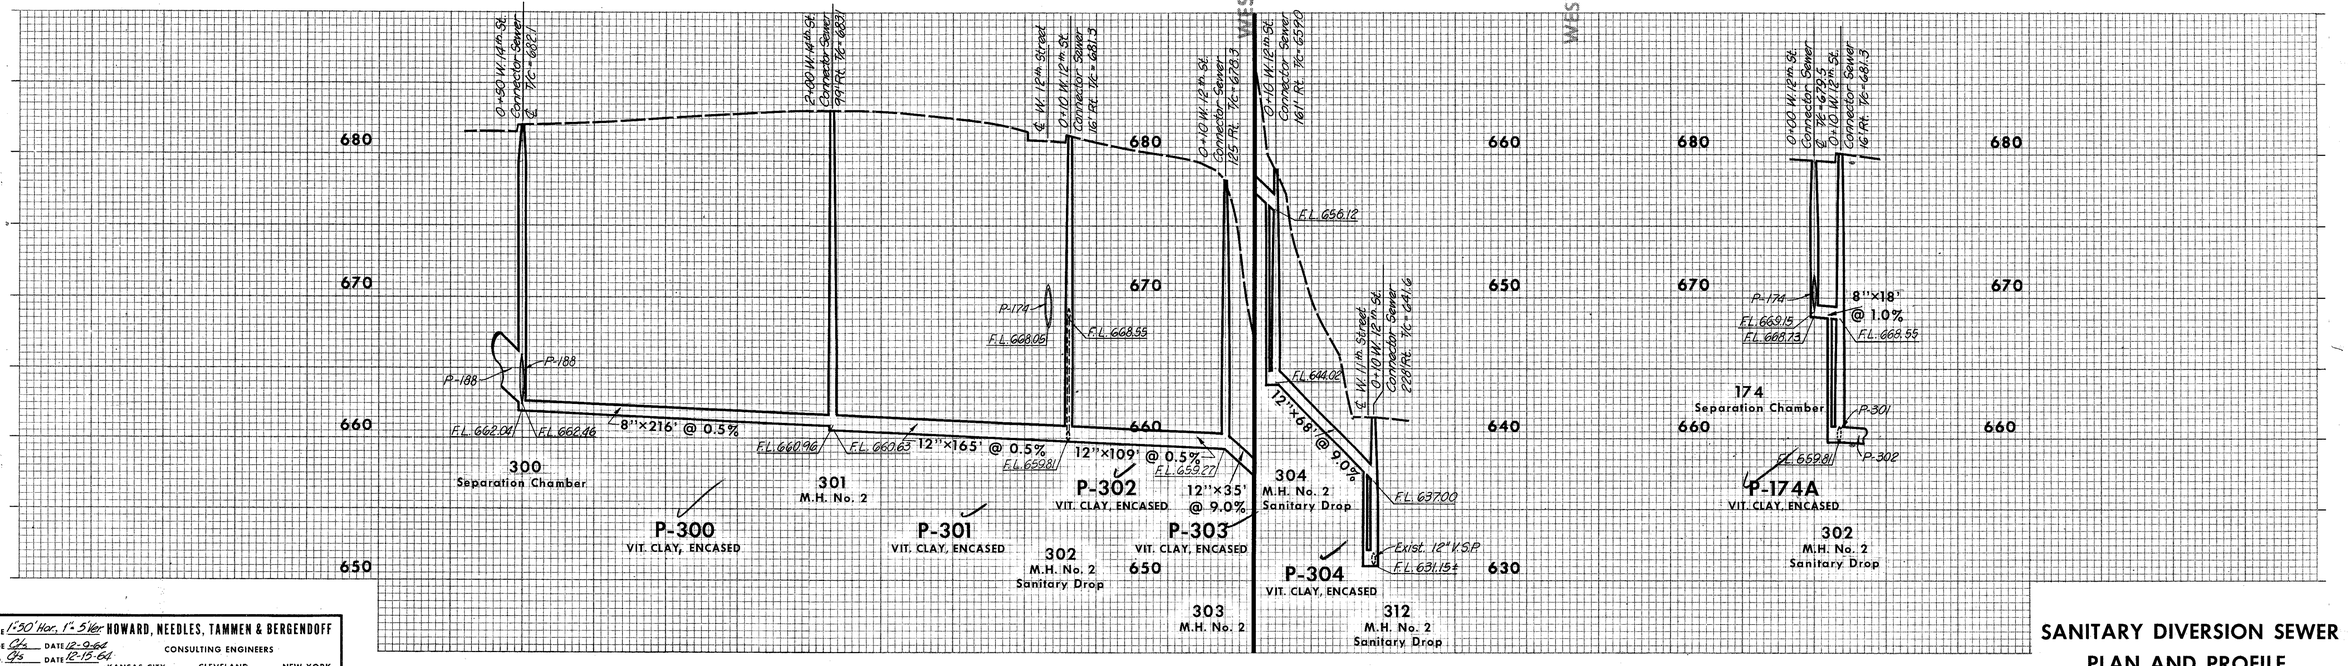

SCALE 1"=50' Hor., 1"=5' Ver. HOWARD, NEEDLES, TAMMEN & BERGENDOFF
MADE GS DATE 12-9-64
TRCD. GS DATE 12-15-64
CKD CPB DATE 12-21-64
CONSULTING ENGINEERS
KANSAS CITY CLEVELAND NEW YORK

SANITARY DIVERSION SEWER PLAN AND PROFILE