XXXX

CORRECTIONS	DATE	BY
REVISIONS		
	12-01-11	SMG

NOTE -- SUBWAY DISTANCES ARE GIVEN TO CENTER OF MANHOLES
VENTS, CURBS & SERVICES ARE GIVEN TO CENTER OF COVERS

THE CLEVELAND
ELECTRIC ILLUMINATING CO.

CANAL RD.

DRAWN 12-01-11

SMG SHEET XXXX

0 10 20 30 40 50 100
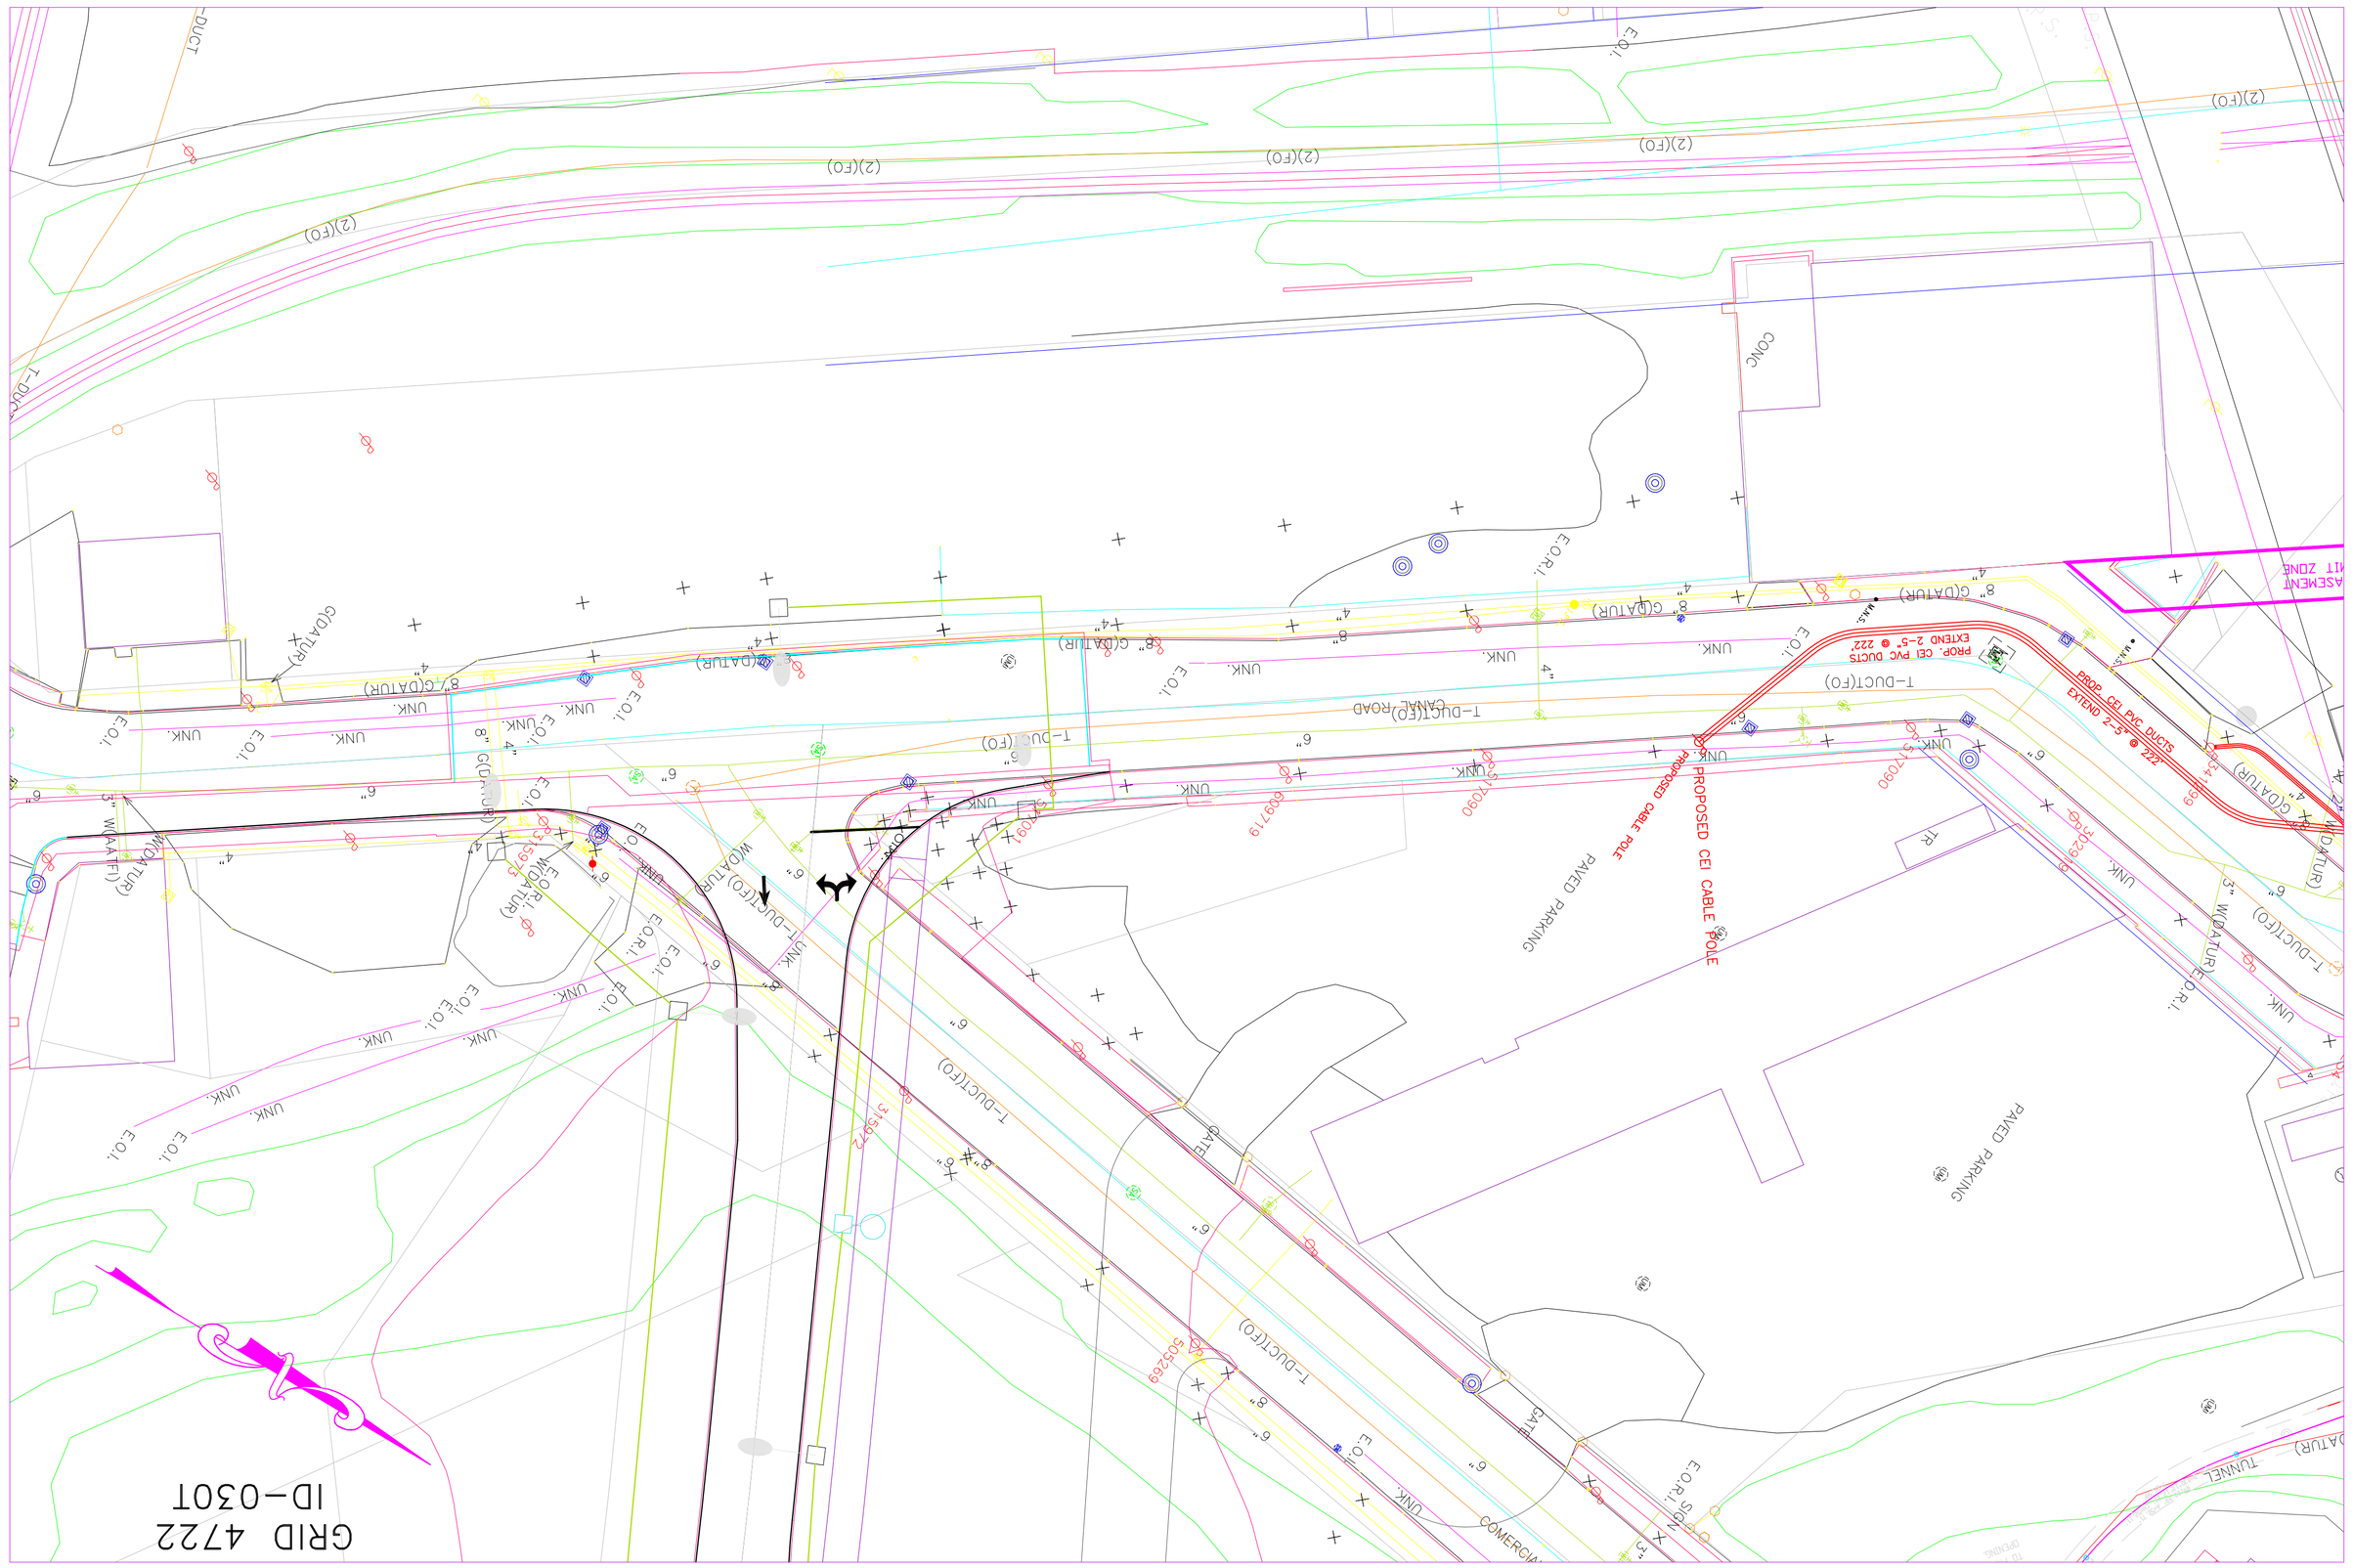
5 15 25 35 45 75