1123S

NOTE -- SUBWAY DISTANCES ARE GIVEN TO CENTER OF MANHOLES
VENTS, CURBS & SERVICES ARE GIVEN TO CENTER OF COVERS

CORRECTIONS	DATE	BY
REVISED	12-01-11	SMG

THE CLEVELAND
ELECTRIC ILLUMINATING CO.

CANAL RD.

DRAWN 12-01-11

SMG SHEET 1123S
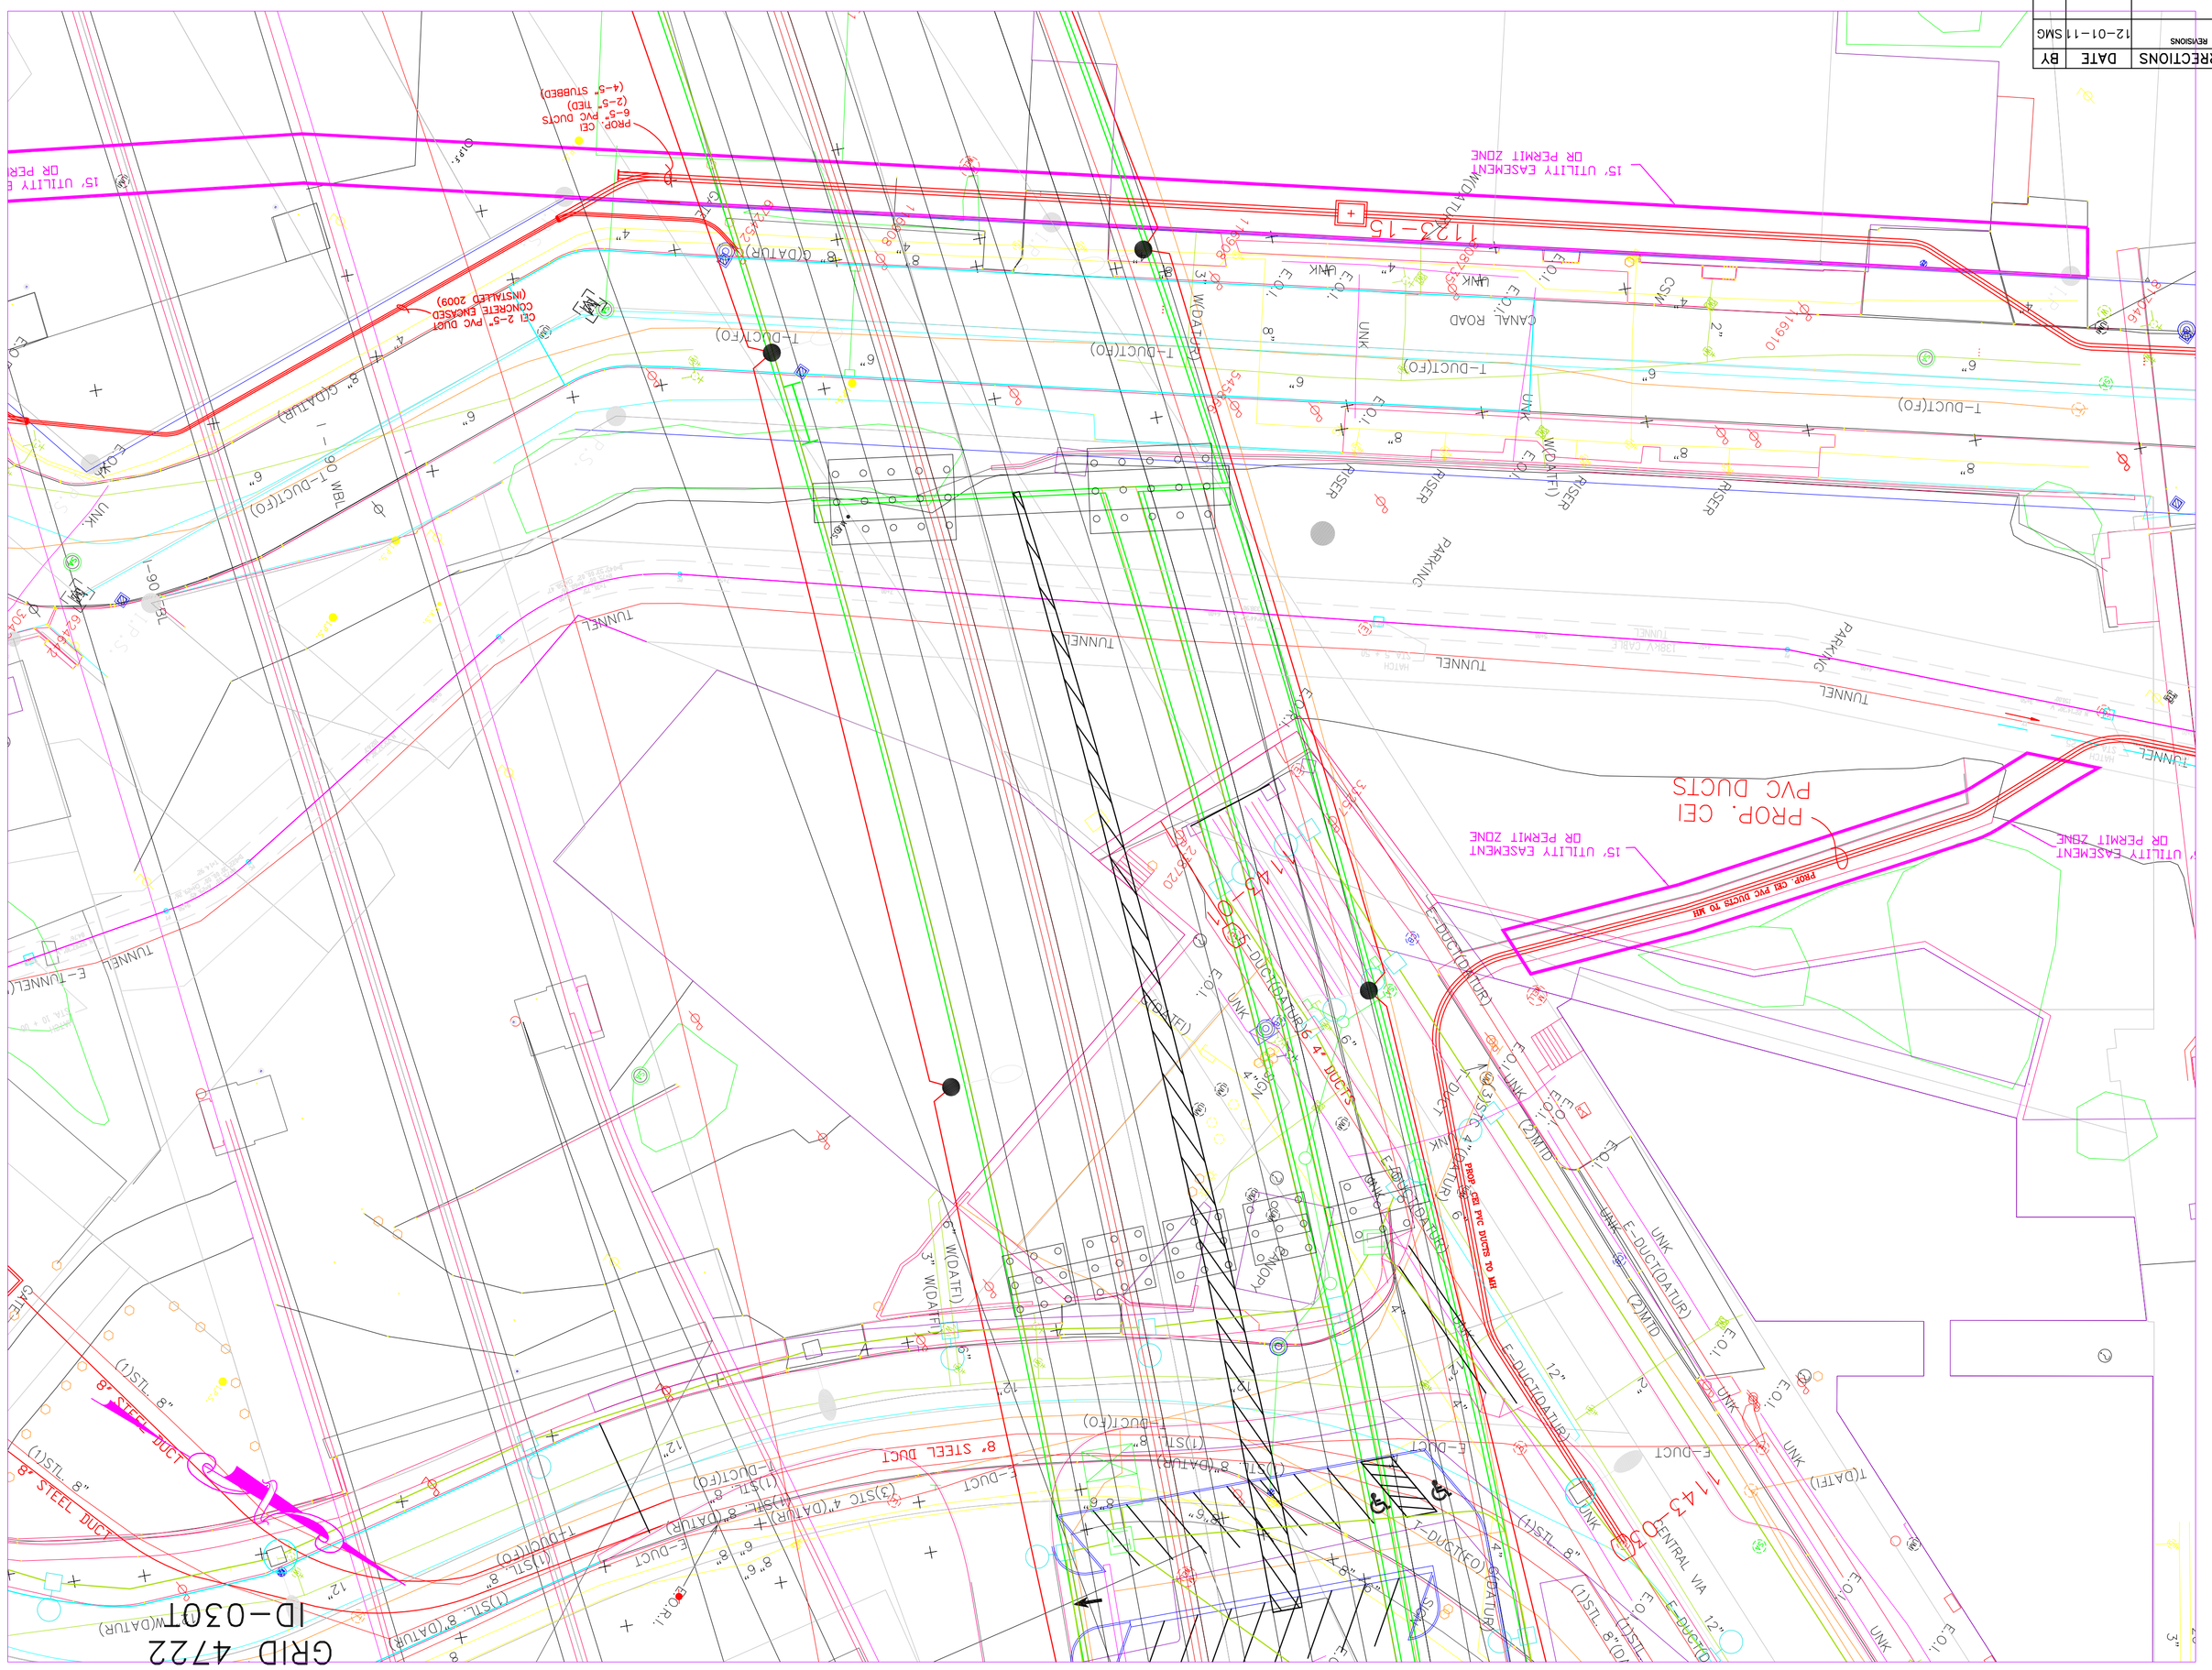
0 10 20 30 40 50 100
5 15 25 35 45 75