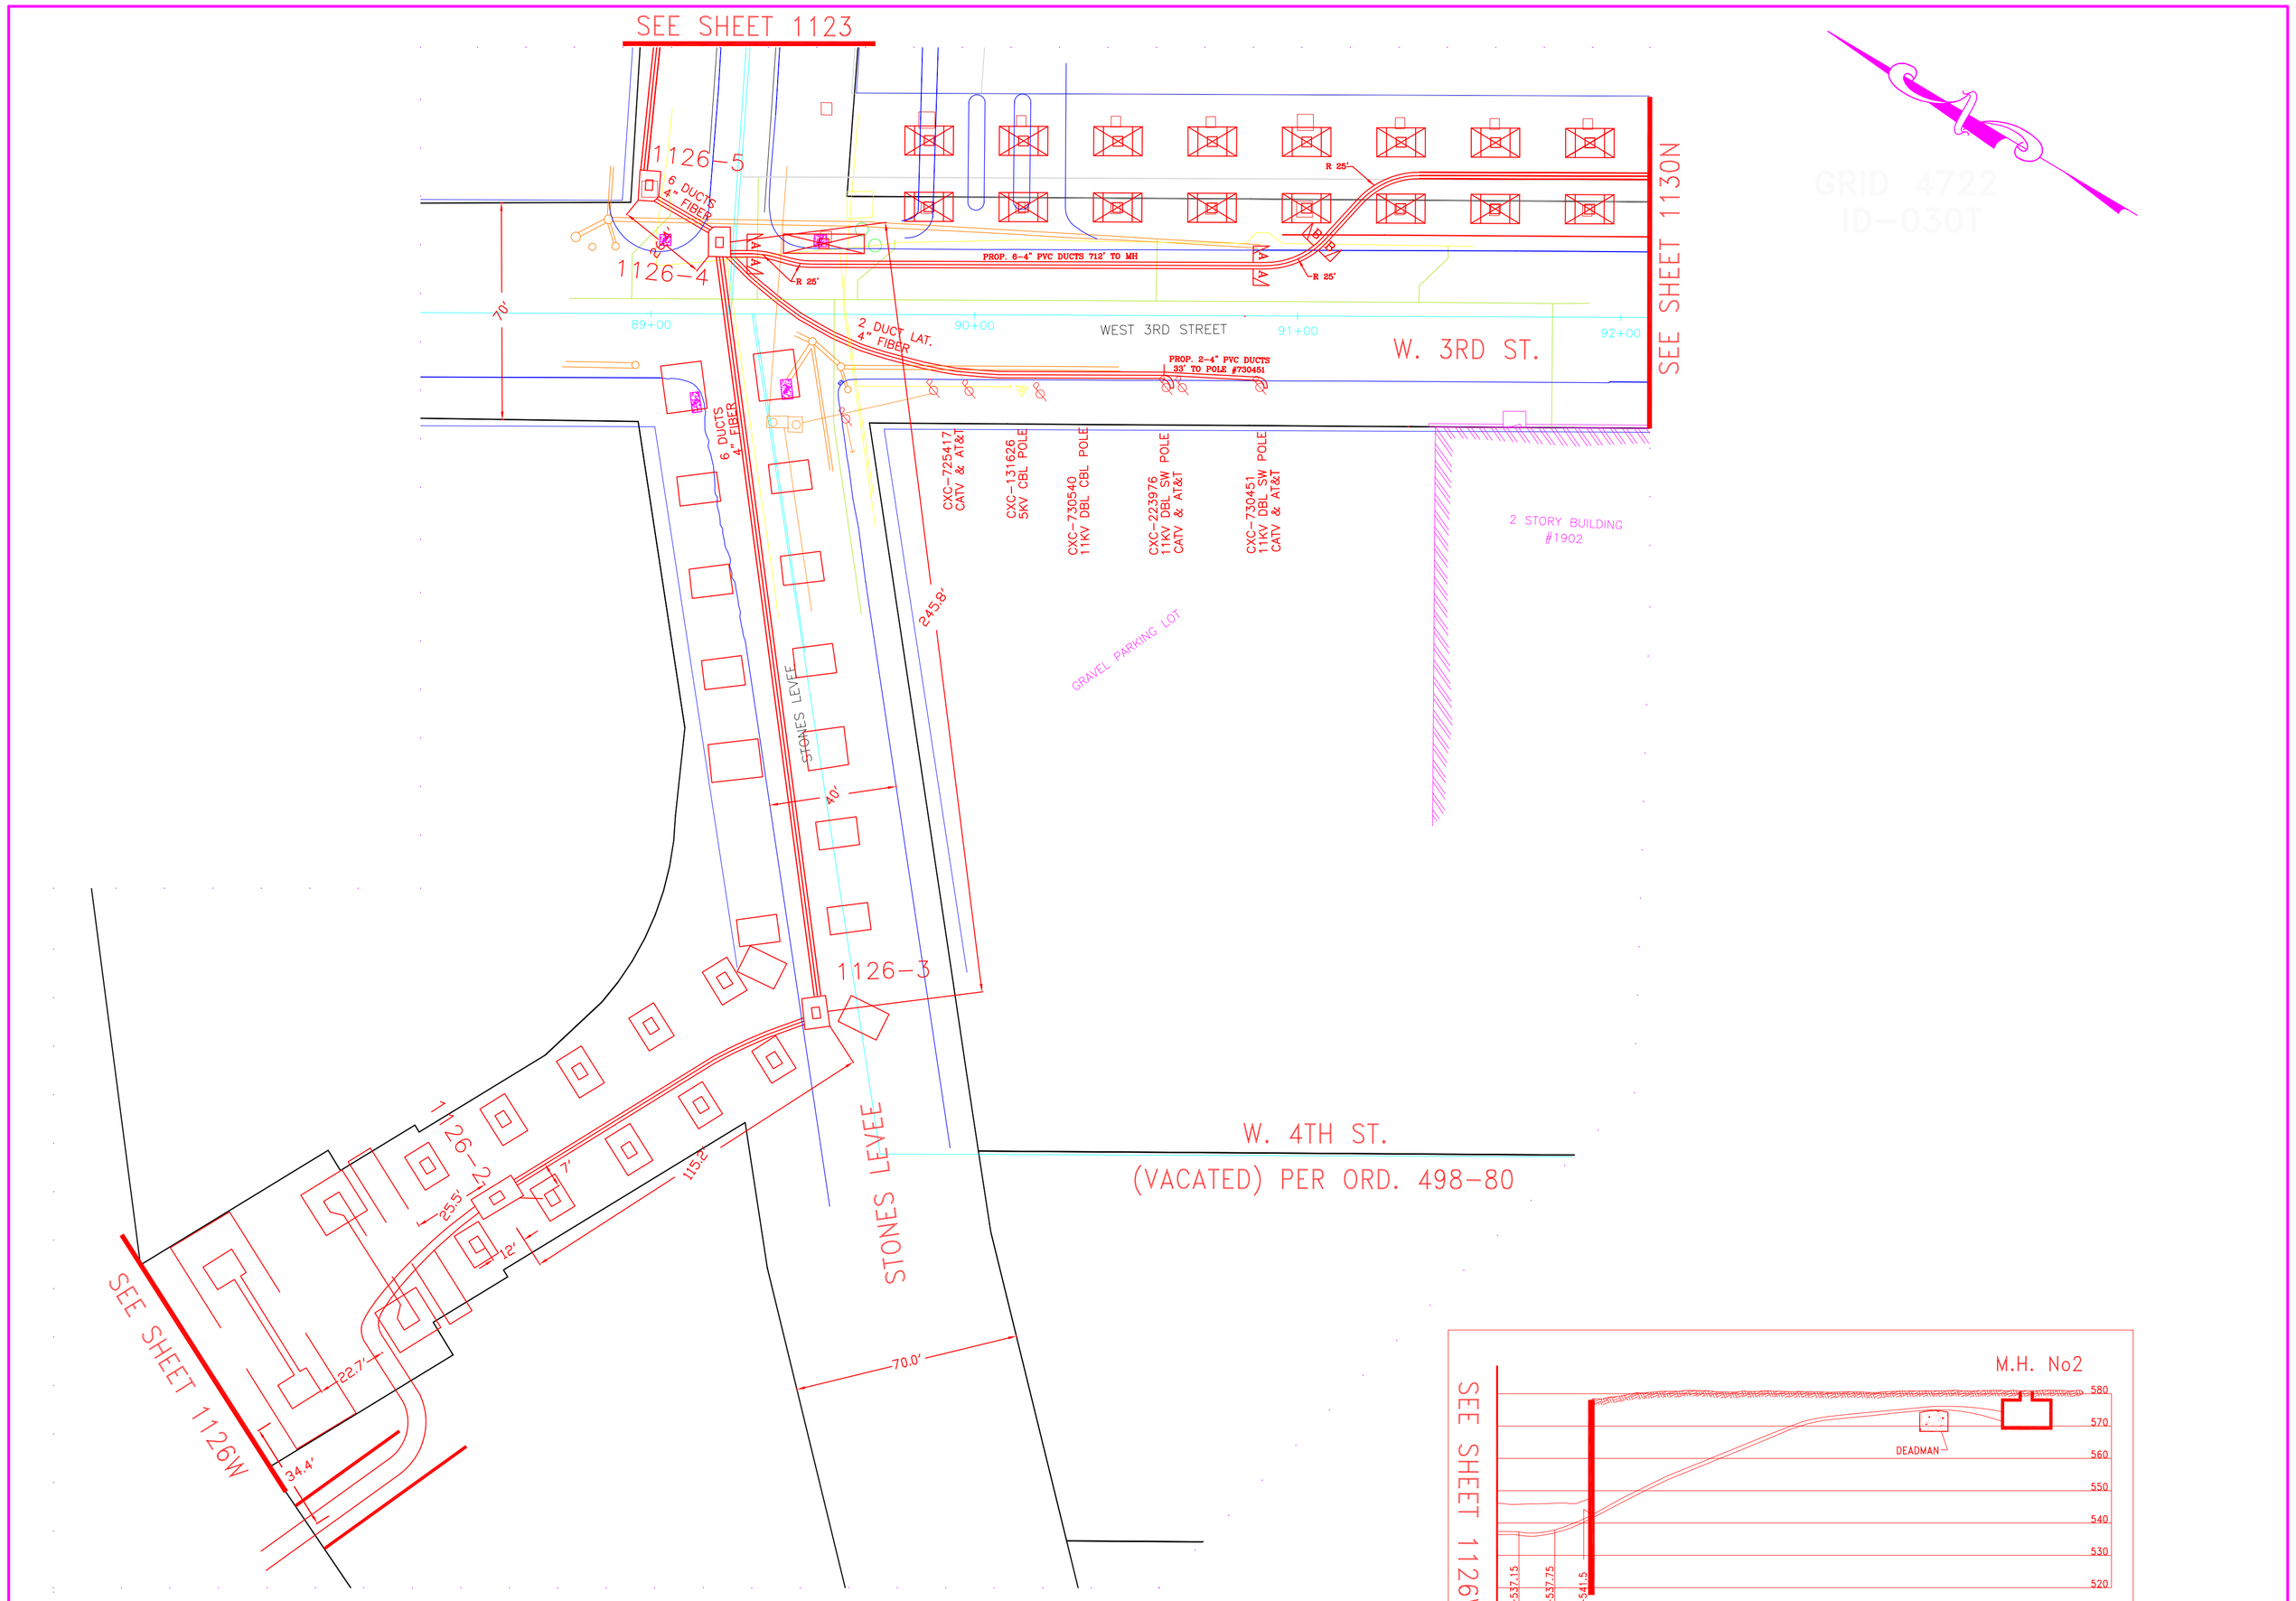

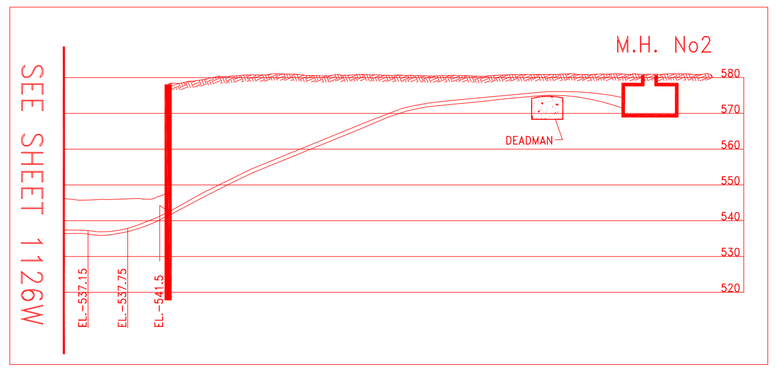

CORRECTIONS NUMBER	DATE	BY
	12-01-11	SMG

NOTE — SUBWAY DISTANCES ARE GIVEN TO CENTER OF MANHOLES
VENTS, CURBS & SERVICES ARE GIVEN TO CENTER OF COVERS

THE CLEVELAND ELECTRIC ILLUMINATING CO.
SCRANTON RD.
SUBMARINE CABLE CROSSING
DRAWN 12-01-11
SMG
SHEET 1126E
0 15 30 35 45 55
0 10 20 30 40 50 FEET
1126E