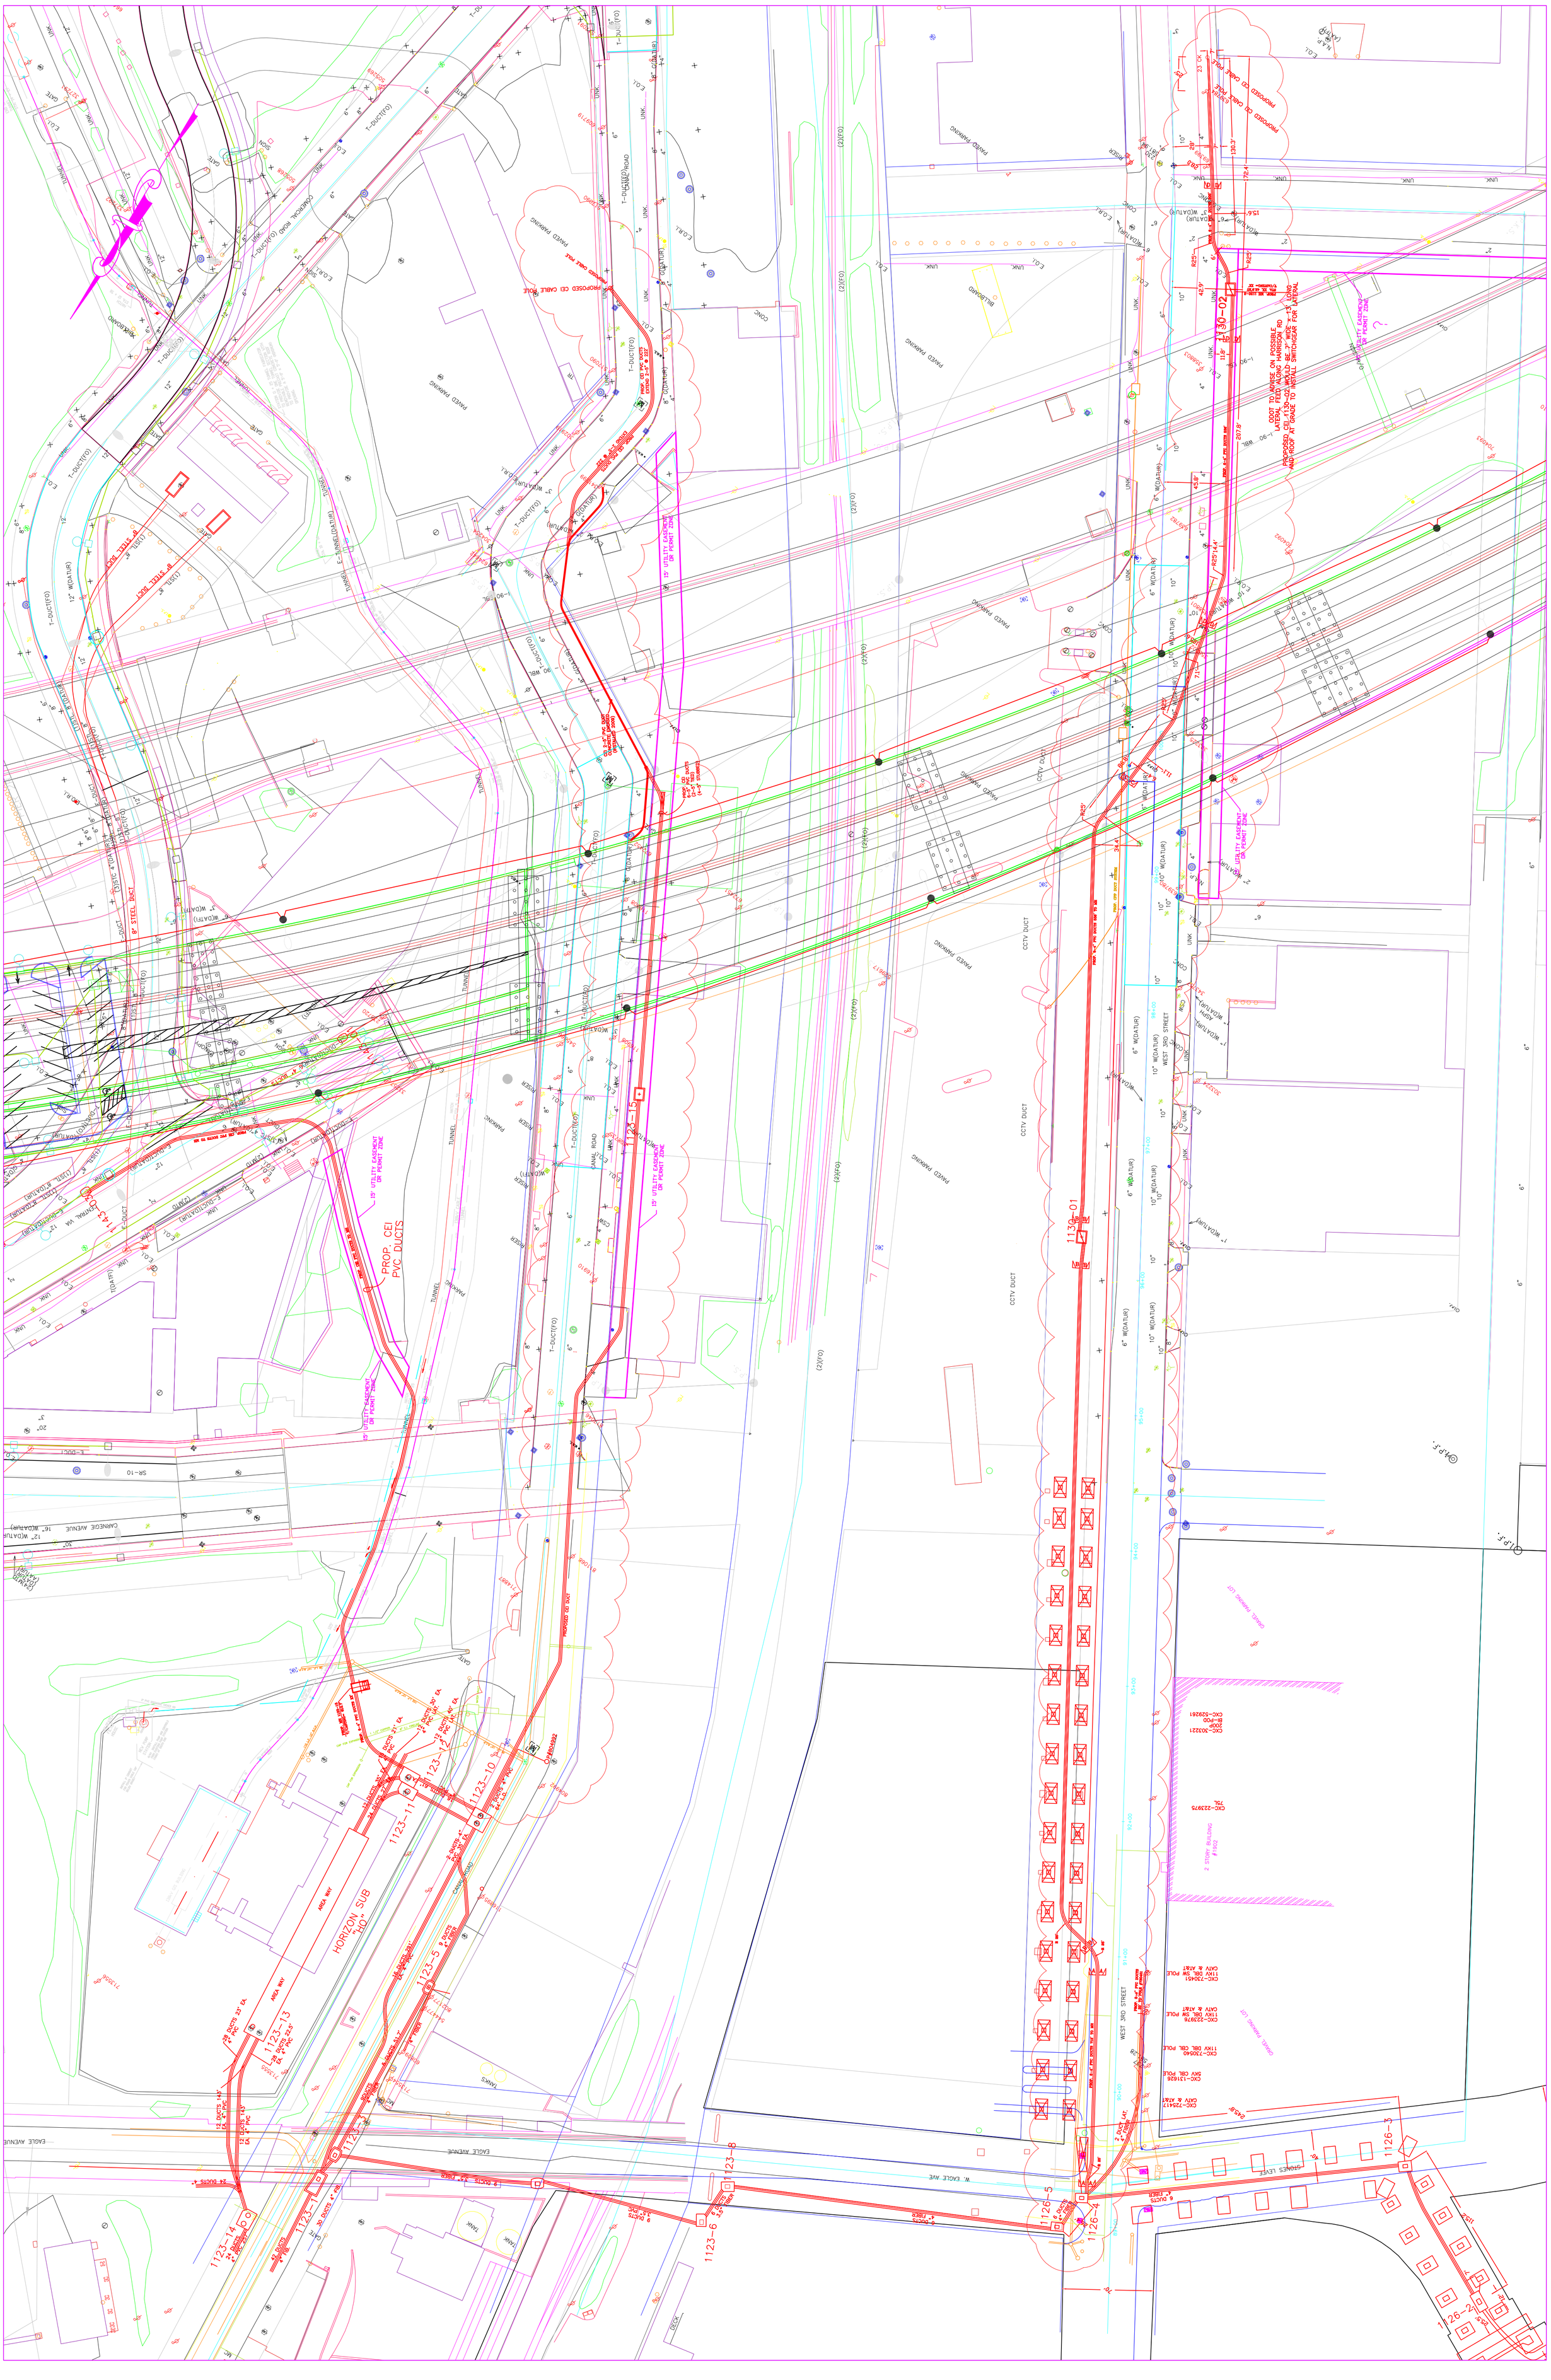
PROPOSED OSP HANDHOLE
PROPOSED OSP CABLE POLE
PROP. OSP PVC DUCTS EXTEND 2-5" Ø 22'
PROP. 2-5" PVC DUCTS OSP CABLE POLE (4-5" STUBBED)
PROP. 8" STEEL DUCT
PROP. CEI PVC DUCTS
PROPOSED OSP DUCT
PROP. 4-4" PVC DUCTS
PROP. 6-4" PVC DUCTS
PROP. 4-4" PVC DUCTS
PROP. 2-4" PVC DUCTS
PROP. 2-4" PVC DUCTS
PROP. 4-4" PVC DUCTS
PROP. 4-4" PVC DUCTS
PROP. 4