



"Paul Fatica "
<faticap@ksassociates.com
>

06/14/2011 01:16 PM

To <jim.breitinger@hdrinc.com>,
<lciborek@mbakercorp.com>, <paul.e.emery@dom.com>,
<kfertal@hntb.com>, <ornette.gibson@dot.state.oh.us>,
cc

cc

bcc

Subject: Cleveland Innerbelt Bridge - Meeting Minutes - DEOG

All,

Attached is a .tif image of the meeting minutes from the Monday, June 13th meeting at the Design-Build Office. Also attached is a .pdf of proposed routes that DEOG has developed to relocate their existing IP gas lines along University.


Paul



2011 06-13 DEOG Mtg 044.tif



DEOG WB Alternatives.pdf

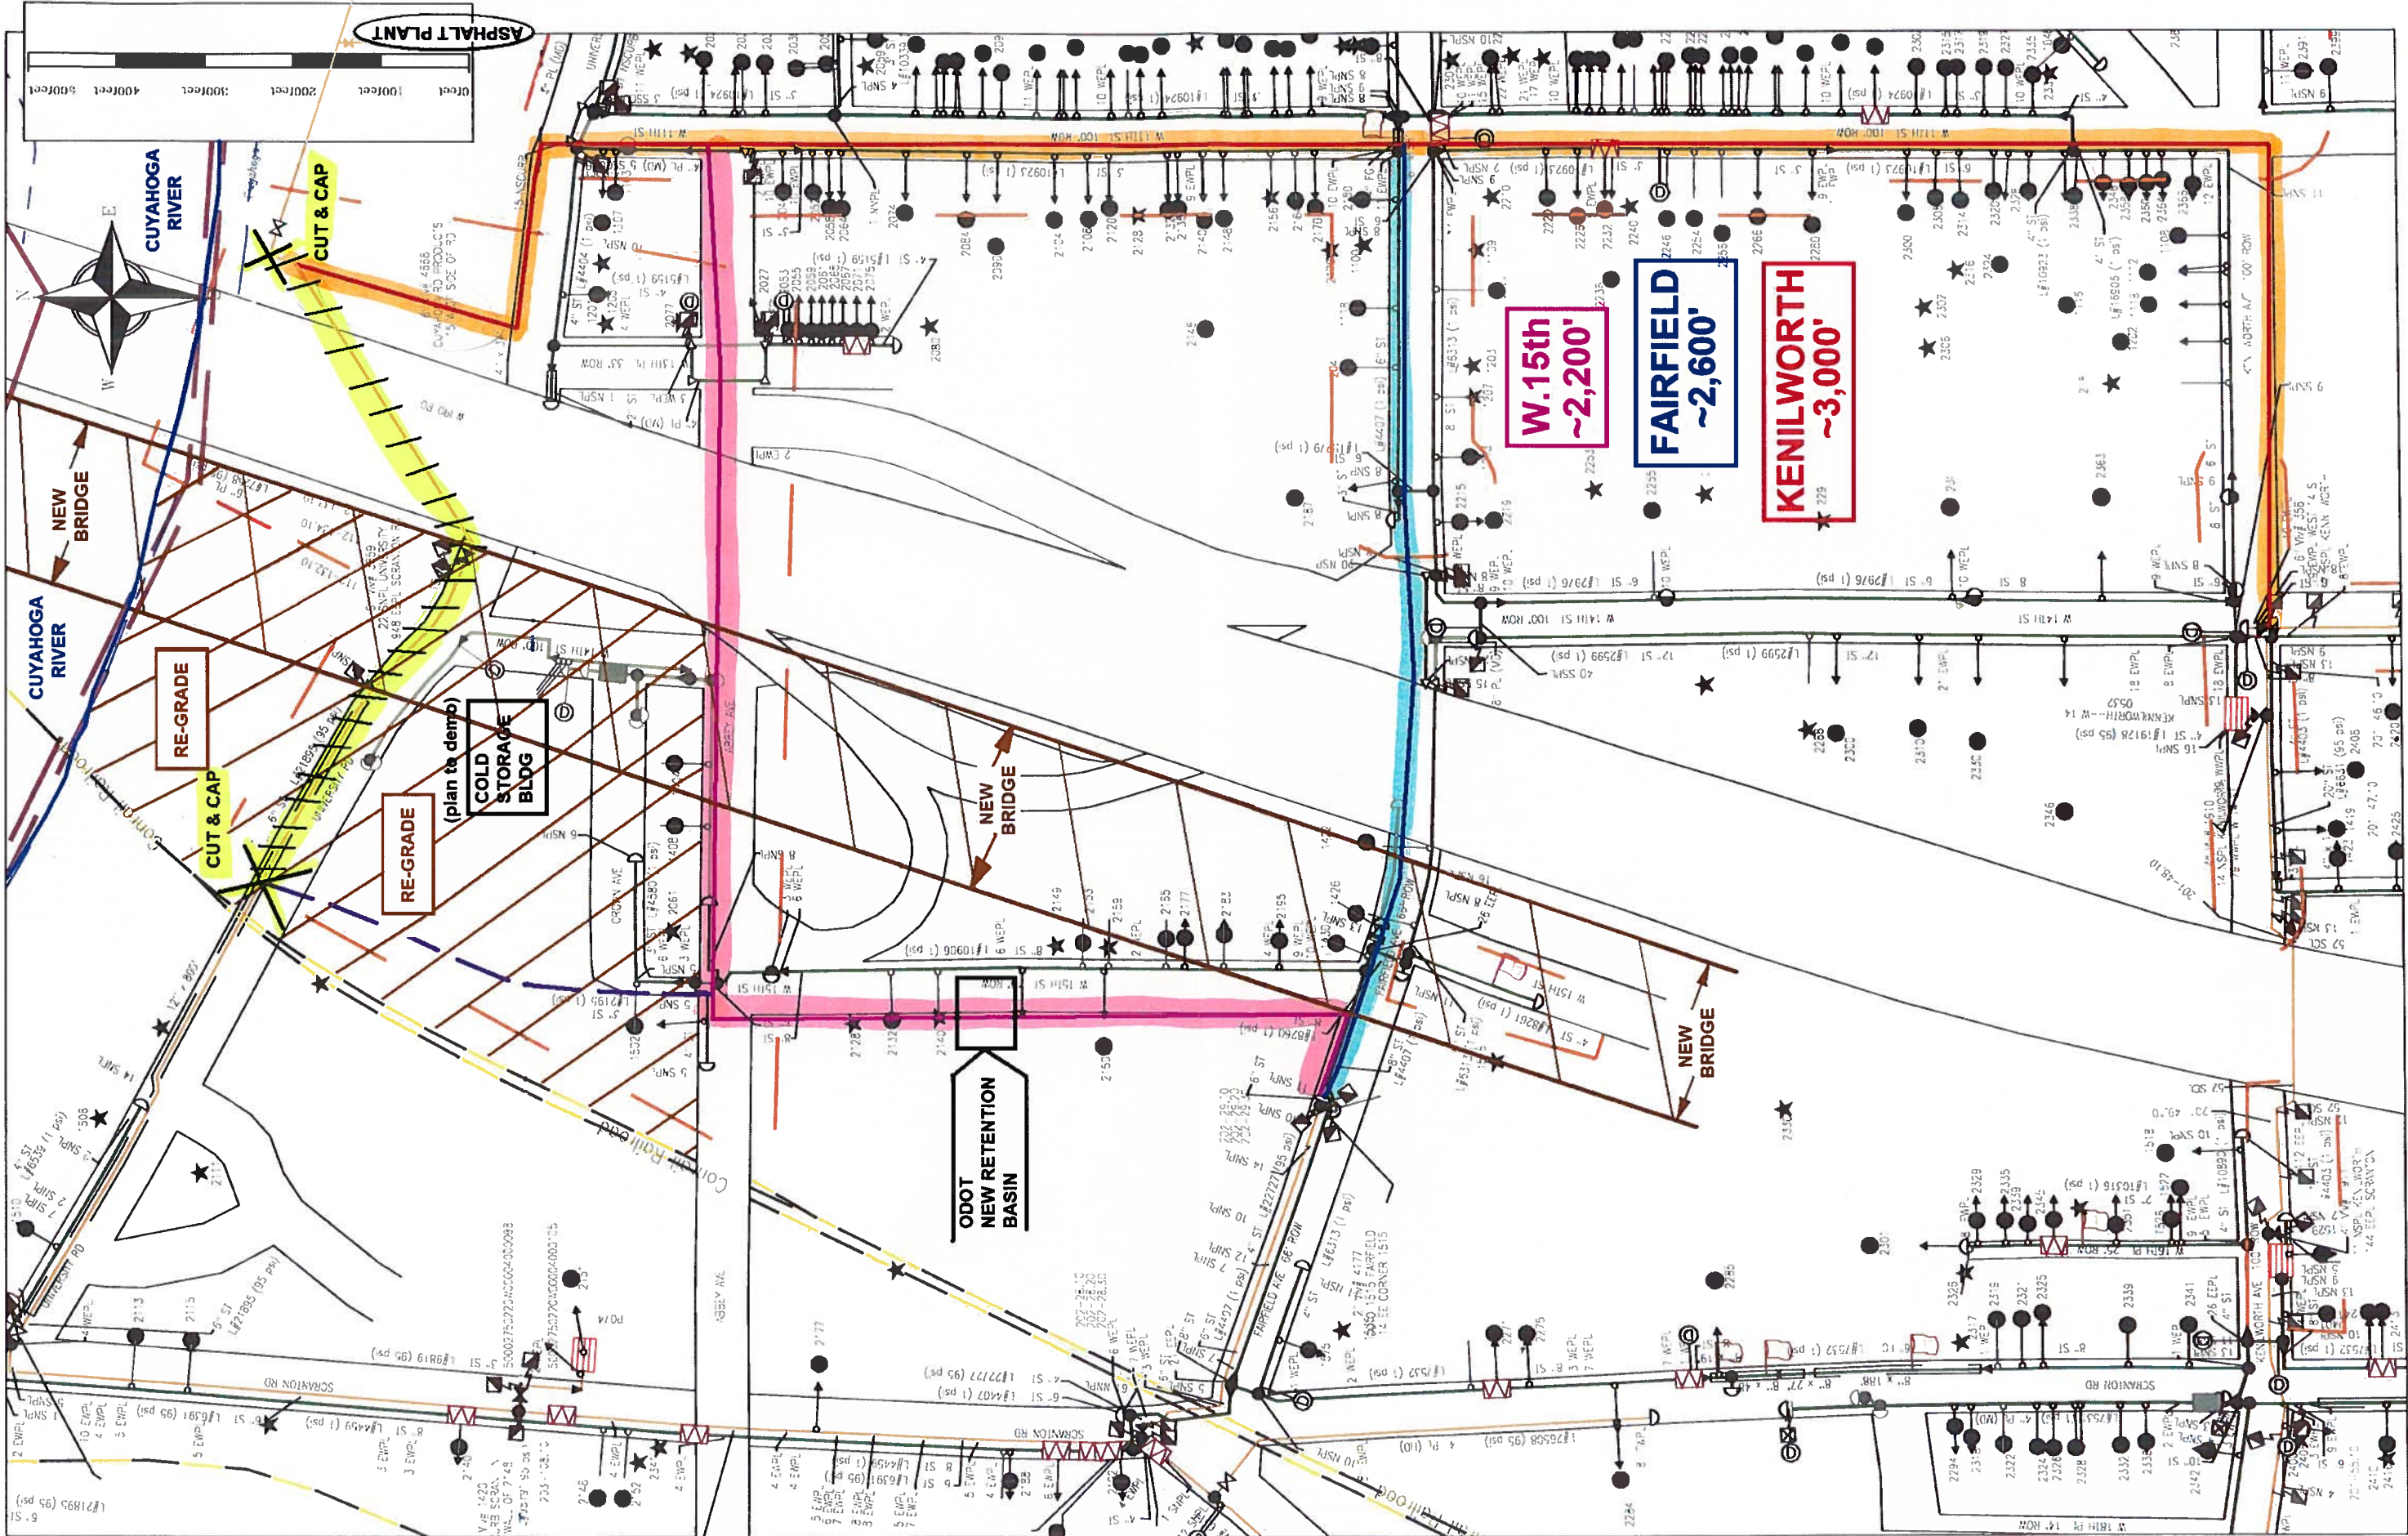

W.15th
~2,200'

FAIRFIELD
~2,600'

KENILWORTH
~3,000'