


CUYAHOGA COUNTY
CITY OF CLEVELAND
MEDINA-CLARK INTERCHANGE
CUY-71-18.54
CUY-90-13.81

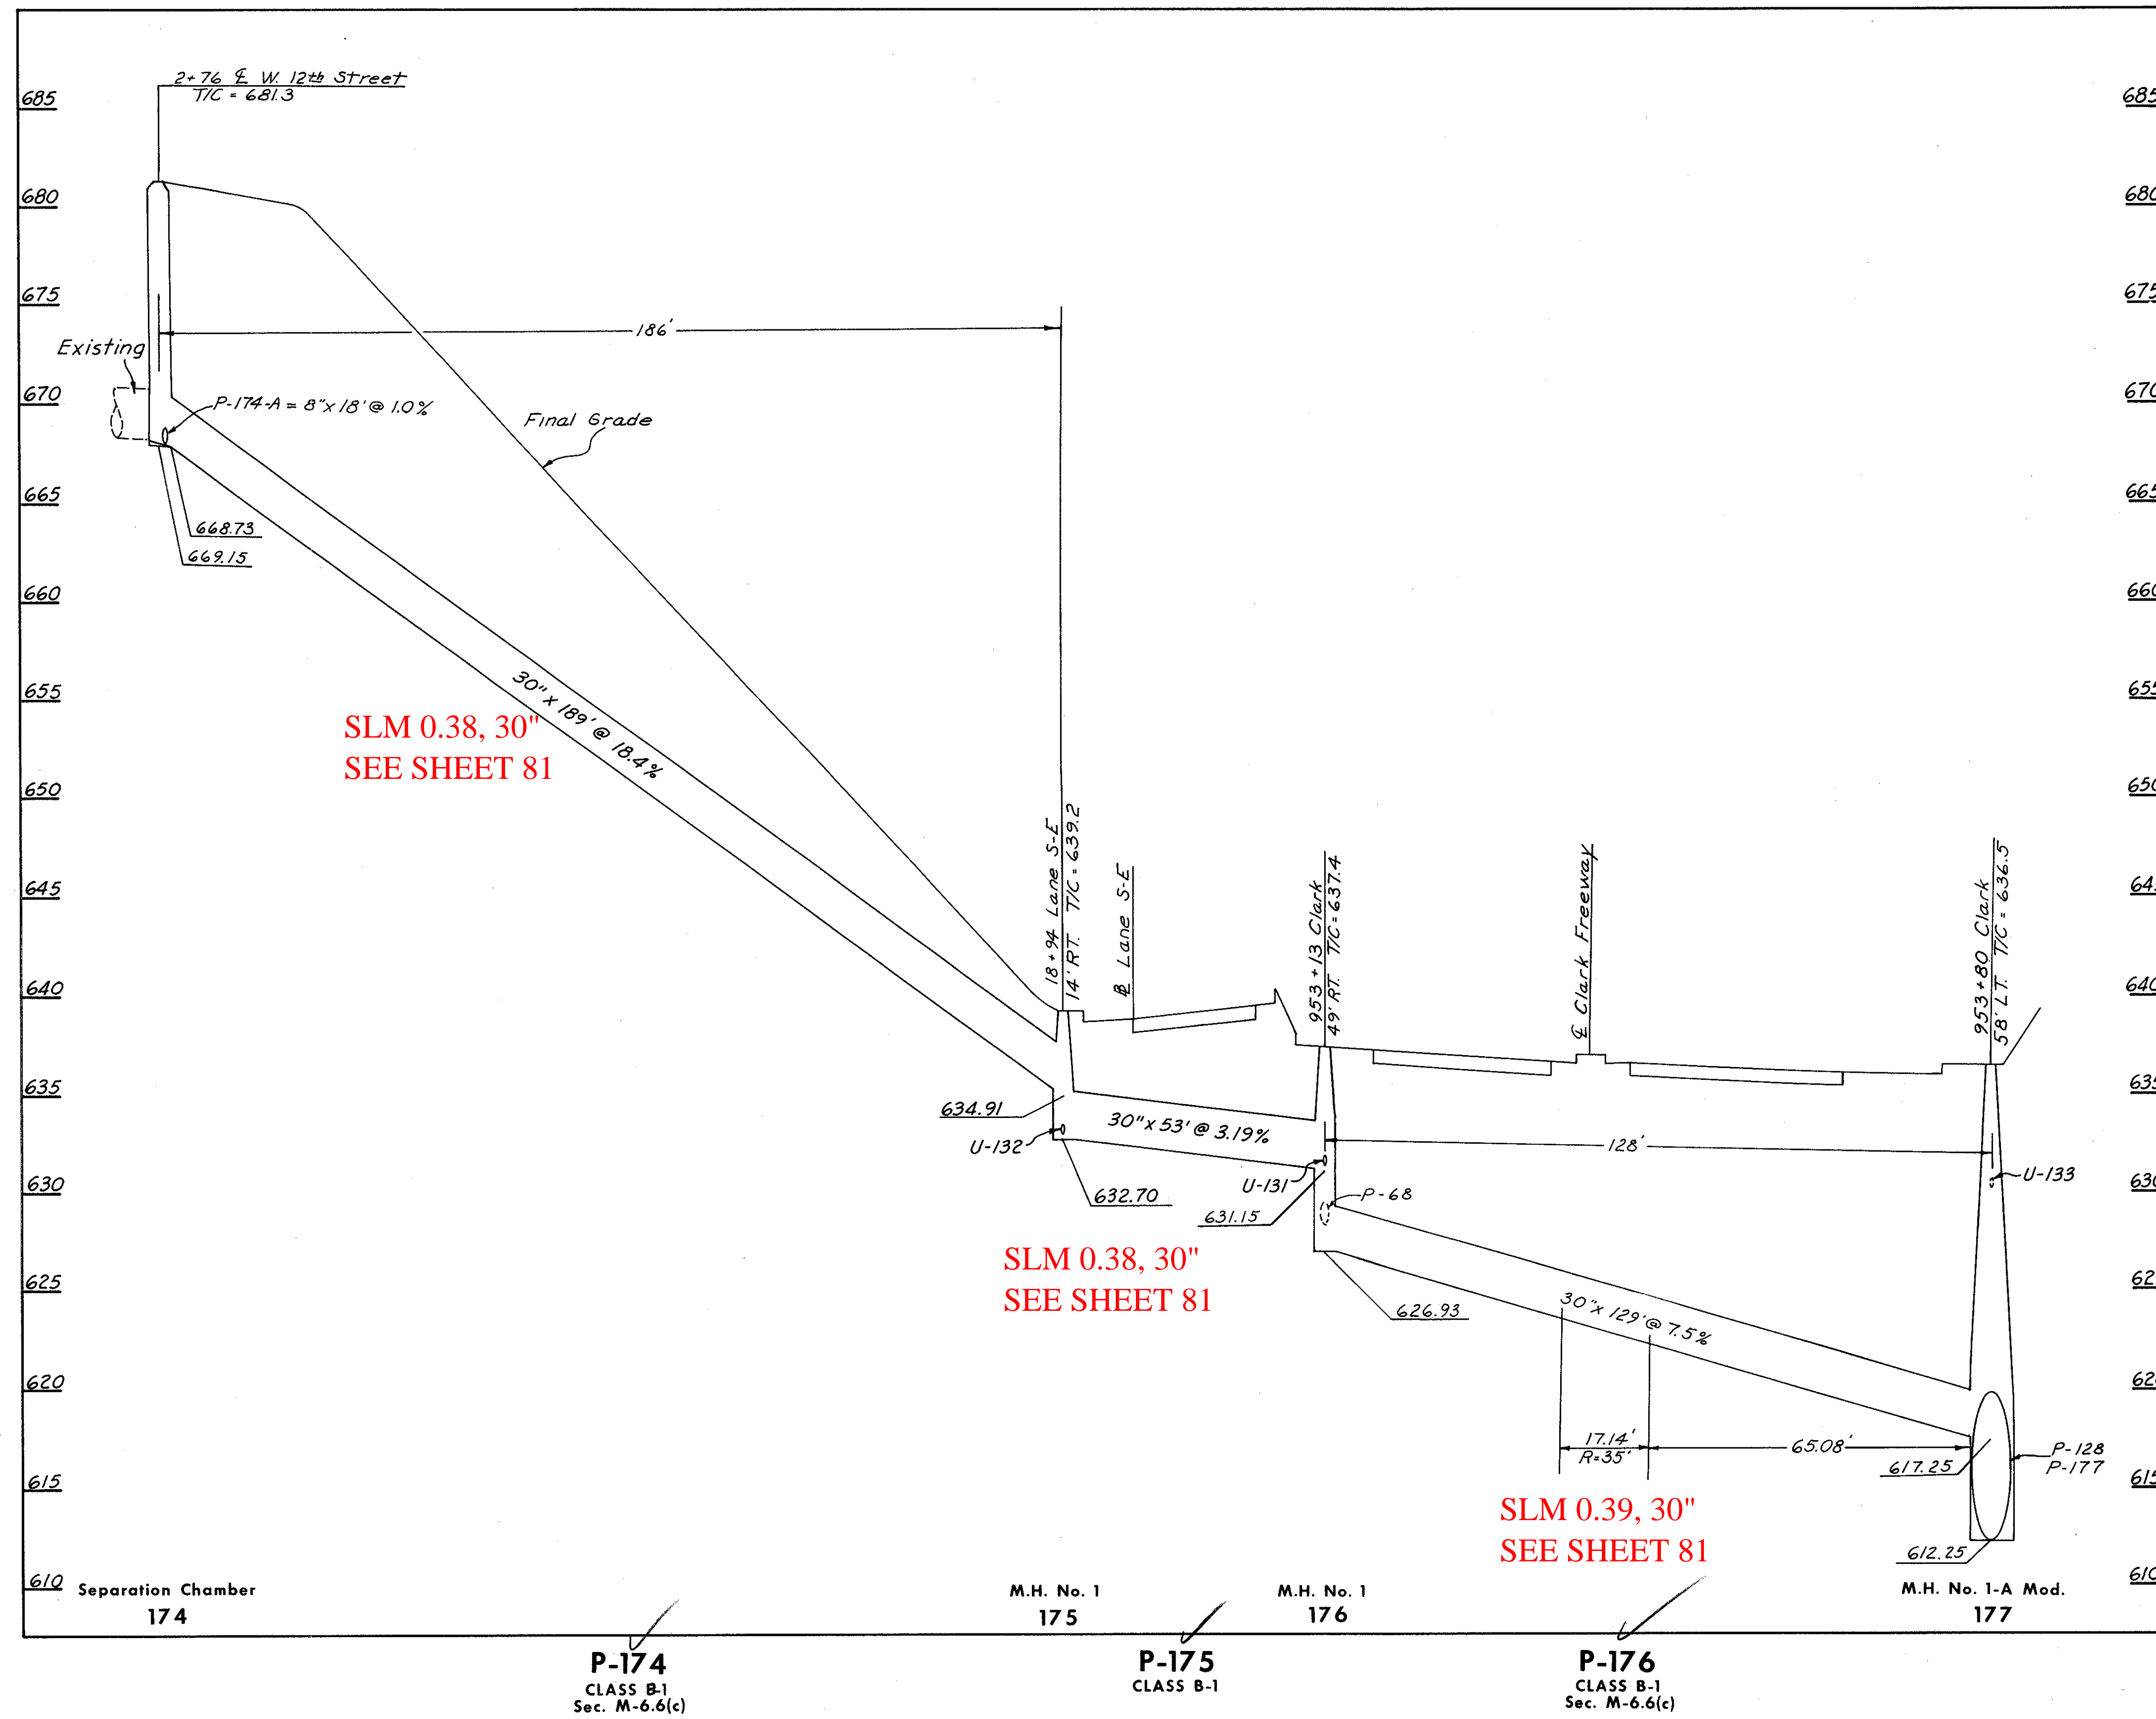

SLM 0.38, 30"
SEE SHEET 81

SLM 0.38, 30"
SEE SHEET 81

SLM 0.39, 30"
SEE SHEET 81

ESTIMATED QUANTITIES

I-B STRUCTURES				
CODE	LOCATION		M.H. No. 1	
P-175	18+94 Lane S-E	14' RT.	1	
P-176	953+13 Clark Freeway	49' RT.	1	
CUY-71-18.54 TOTALS			2	

CODE	ROADWAY	INLET CODE		I-1 PIPE		
				CLASS B-1	CLASS B-1	CLASS B-1
		FROM	TO	30"	Sec. M-6.6(c) 30"	Sec. M-6.6(c) 30" R=35'
P-174	W. 12 th St.	174	175		189'	
P-175	LANE S-E	175	176	53' ✓		
P-176	Clark Freeway	176	177		111' ✓	18' ✓
CUY-71-18.54 TOTALS				53' ✓	300' ✓	18' ✓