

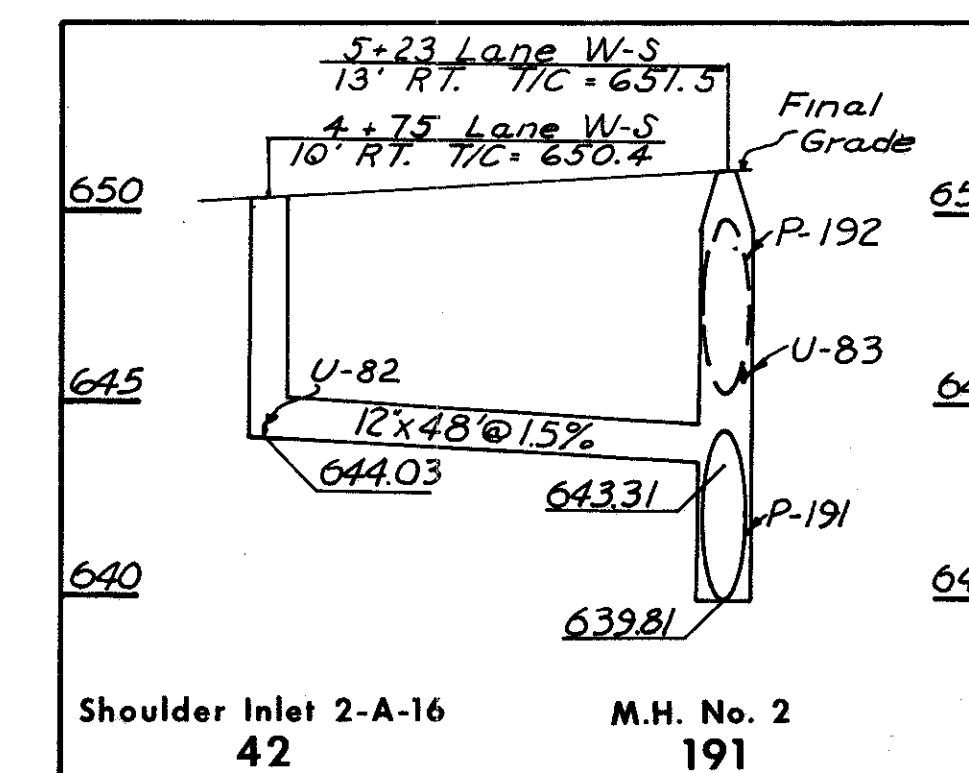



CUYAHOGA COUNTY
CITY OF CLEVELAND
MEDINA-CLARK INTERCHANGE
CUY-71-18.54
CUY-90-13.81

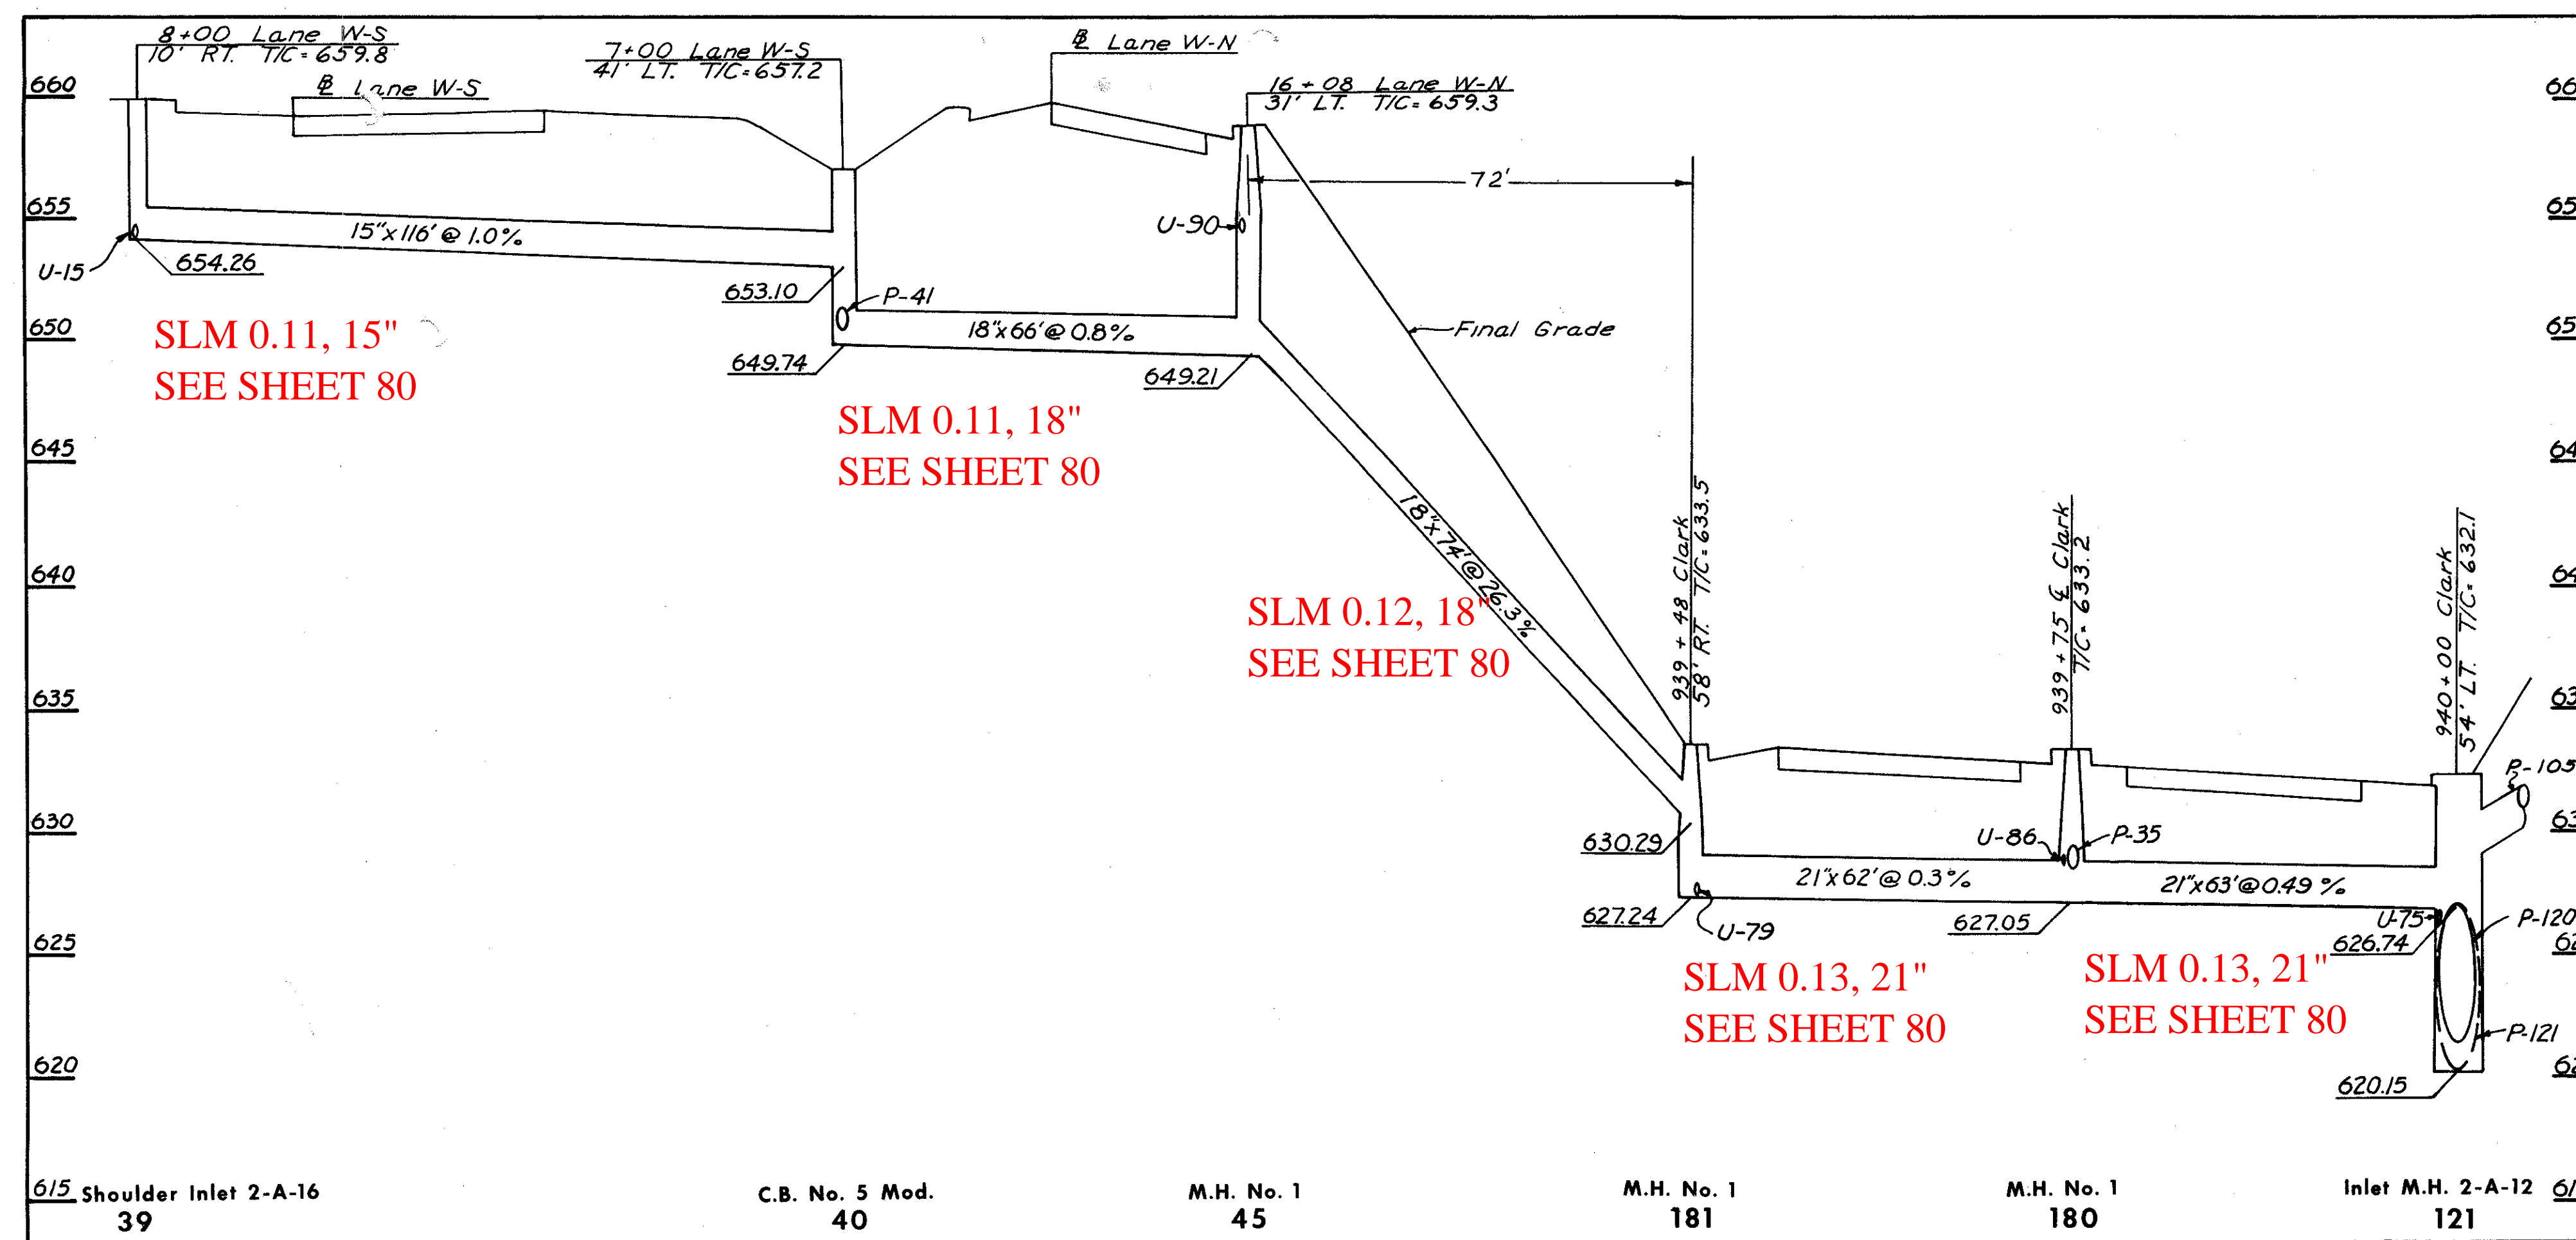

P-42
CLASS E-1

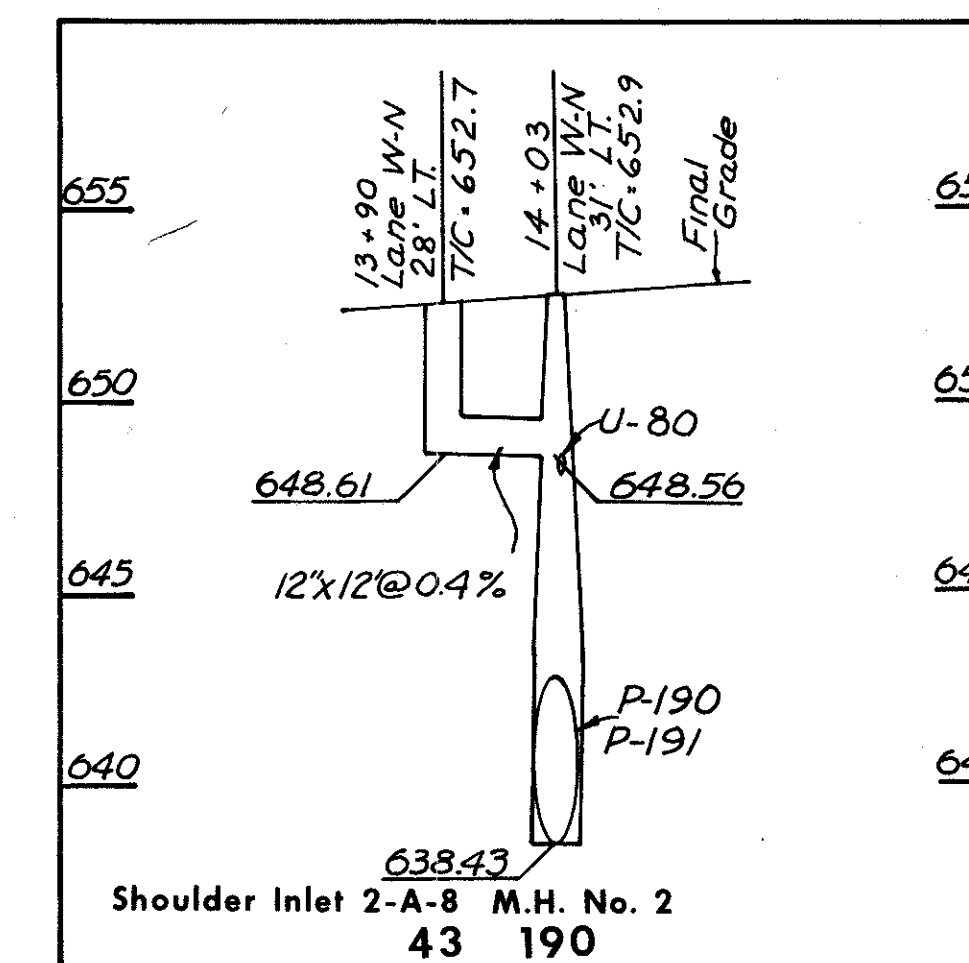

P-43
CLASS E-1

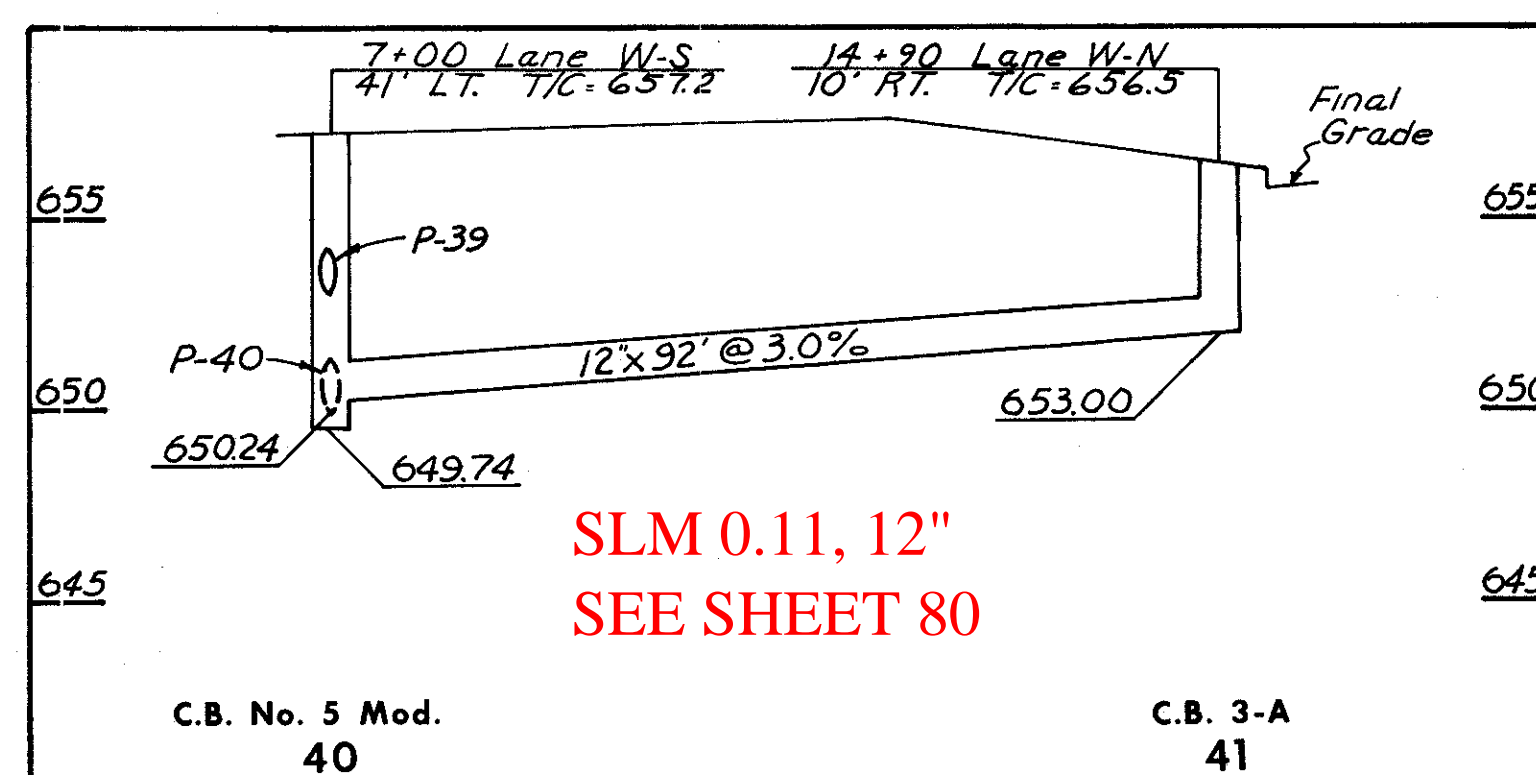

P-41
CLASS E-1

ESTIMATED QUANTITIES

CODE	LOCATION	I-8 STRUCTURES					
		Shoulder Inlet 2-A-8	Shoulder Inlet 2-A-16	C.B. 3-A	C.B. 5 Mod.	M.H. No. 1	M.H. No. 2
39	8+00 Lane W-S 10' RT.		1				
40	7+00 Lane W-S 41' LT.*				1*		
41	14+90 Lane W-N 10' RT.*			1*			
42	4+75 Lane W-S 10' RT.*		1*				
43	13+90 Lane W-N 28' LT.*	1*					
45	16+08 Lane W-N 31' LT.*					1*	
181	939+48 Clark Freeway 58' RT.					1	
190	14+03 Lane W-N 31' LT.*						1*
191	5+23 Lane W-S 13' RT.*						1*
CUY-71-18.54 TOTALS						1	1*
CUY-90-13.81 TOTALS		1*	1*	1*	1*	1*	2*

CODE	ROADWAY	INLET CODE		I-1 PIPE				
				CLASS B-1	CLASS B-1	CLASS B-1	CLASS E-1	CLASS F-4
		FROM	TO	15"	18"	21"	12"	18"
P-39	Lane W-S	39	40	116'				
P-40	Lane W-S *	40	45		66'*			
P-41	Lane W-N *	41	40				92'*	
P-42	Lane W-S *	42	191				48'*	
P-43	Lane W-N *	43	190				12'*	
P-45	Lane W-N *	45	181					74'*
P-180	Clark Freeway	180	121			63'✓		
P-181	Clark Freeway	181	180			62'✓		
CUY-71-18.54 TOTALS				116'✓		125'✓		
CUY-90-13.81 TOTALS					66'*		152'*	74'*

P-39 thru P-43,
P-45,
P-180 and P-181
SEWER PROFILES