FEDERAL AID

S - 9(8)

8
95

GEAUGA COUNTY
GEA.-87-7.72

CFN 280870862
SLM 8.62, 54"
SEE SHEET 86

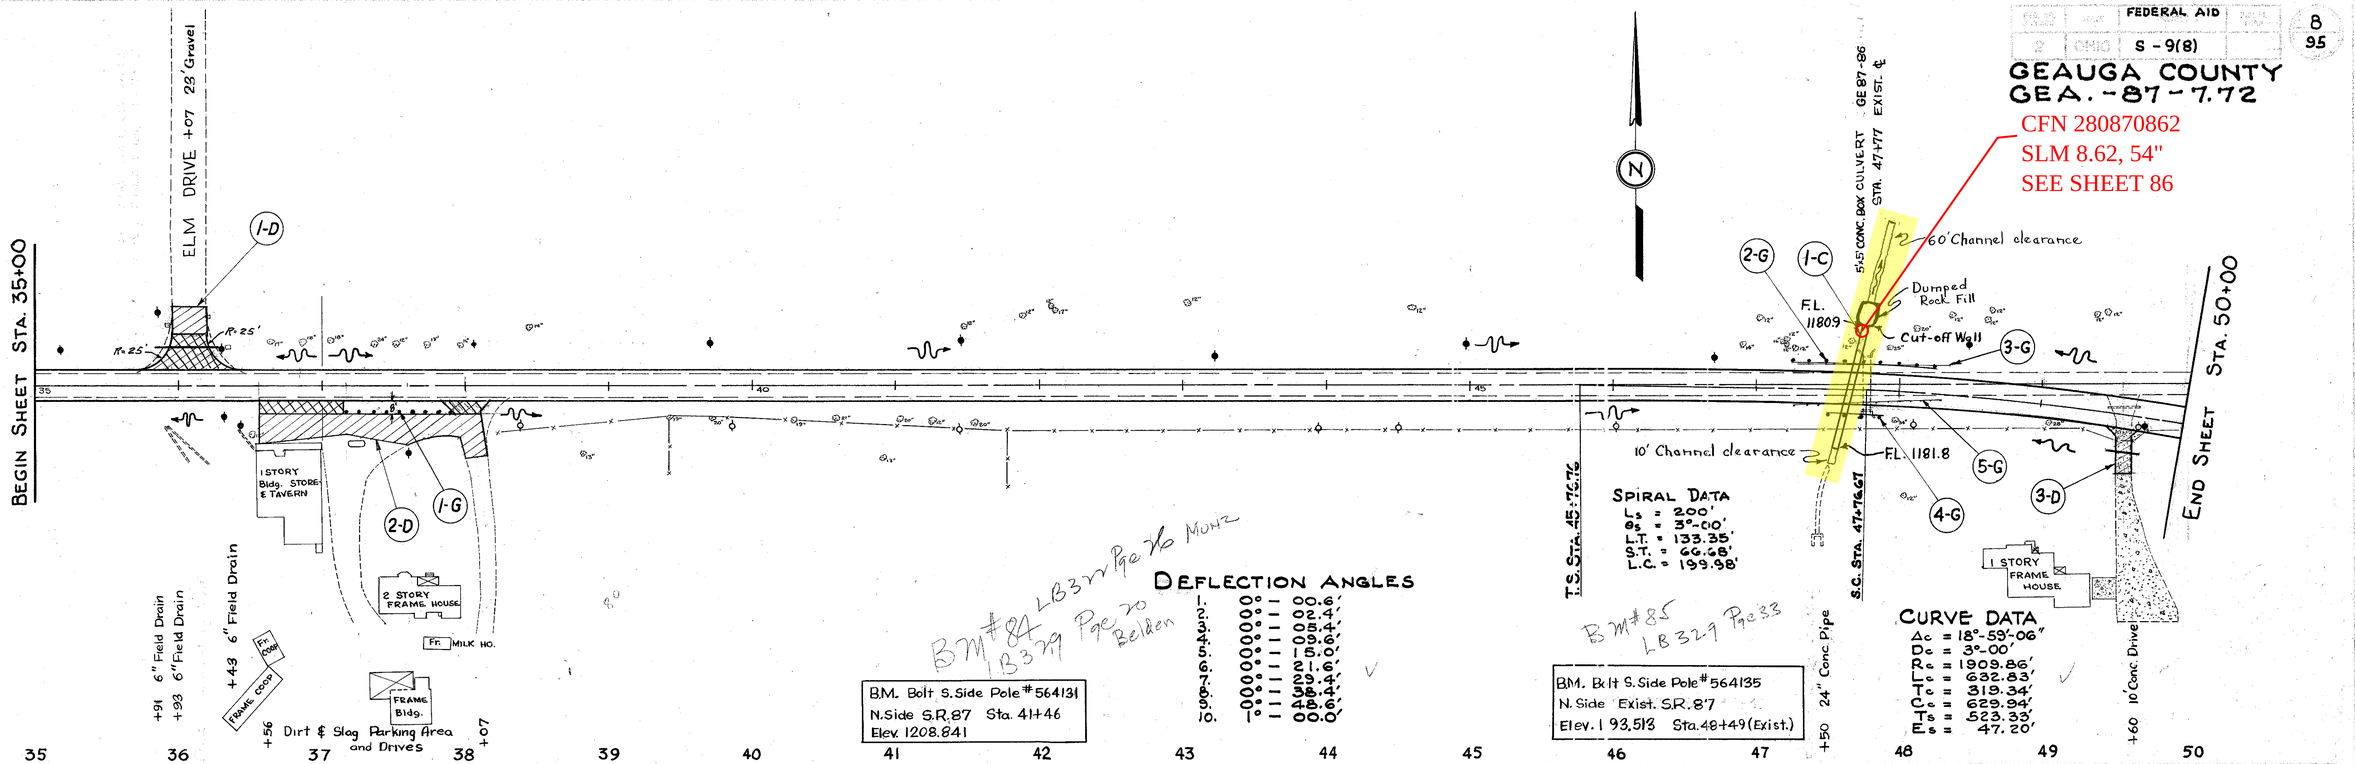

DEFLECTION ANGLES


BM #84 LB329 Page 76 MUNZ
LB329 Page 20 Belden
BM #85 LB329 Page 33

RESURFACE ONLY

35	36	37	38	39	40	41	42	43	44	45	46	47	48	49	50																				

Item I-15 Guard Rail, Etc.

Ref. No.	Station from	Station to	Side	Item I-15.14 or I-15.12 (Lin. ft.)	Removed & Disposed of (Lin.ft.)	No. of Posts *
1-G	37+15	37+95	Rt.			17
2-G	47+25	48+25	Lt.	100		
3-G	47+32	48+35	Lt.		104	
4-G	47+50	47+87.5	Rt.	37.5		
5-G	47+26	48+30	Rt.		104	
TOTAL				137.5	208	17

* Spaced on 5' Centers

DRIVES

Ref. No.	Station	℄ Side	Item E-1 Cubic Yards Excavation Add	Excavation Deduct	Embankment Add	Embankment Deduct	Item 5510 Aggregate Cu. Yds	Item I-1 12" Pipe For Drives Lin. Ft.	Item E-12 Pipe Removal 18" & Under Lin. Ft.	Item E-8 Pave't Removal Sq. Yds	Item T-70 7" Port. Cem. Conc. Sq. Yds
1-D	36+07	Lt.		3	3	1	24.9	50			
2-D	36+86 to 38+00	Rt.					84.3				
3-D	49+64.3	Rt.		4	8	1		22	22	32	36.2
TOTAL				7	6	2	109.2	72	22	32	36.2

ROADSIDE IMPROVEMENT

Station From	Station To	Side	L-9 Seeding And Protecting Sq. yds.	L-9 Commercial Fertilizer Tons
35+00	50+00	L & R	818	0.736
TOTALS			818	0.736

PAVEMENT REMOVAL

Station From	Station To	Item E-8, Removal & Disposal of Exist. Pavement Sq. Yds.
EXIST. ℄ 46+50	EXIST. ℄ 50+00	622.2

STRUCTURES 20' AND UNDER

Ref. No.	Sta.	Size	Skew	Length North of ℄	Length South of ℄	Item S-27 54" Total	Item E-2 Excavation for Structures (Cu.Yds.)	Item E-3 Channel Excavation (Cu.Yds.)	Item S-1 Concrete for Structures Class "E" (Cu.Yds.)	Item I-10 Dumped Rock Fill (Cu.Yds.)	Item S-24 Removal of Existing Structures
1-C	47+65	54" Dia.	L: 10°-30'	47'	43'	90'	108	13	0.8	8.3	Lump Sum

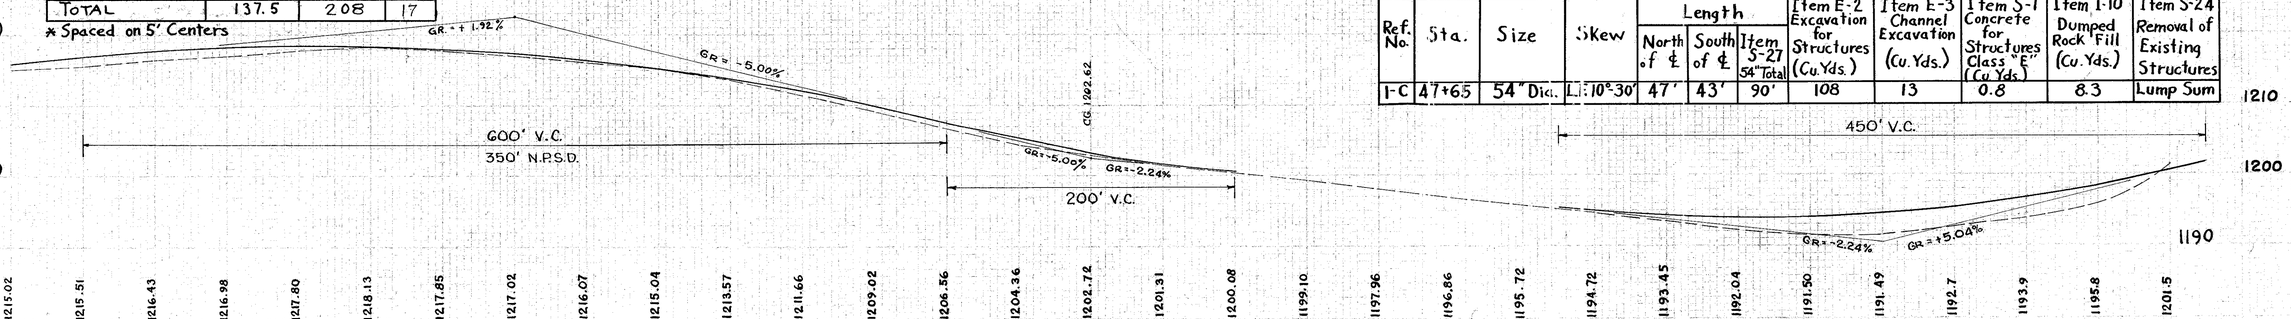

Excavation	1303 Cu.Yds.
Embankment	431 Cu.Yds.
Emb. + 22 %	526 Cu.Yds.

Excavation	12.92 Cu.Yds.
Embankment	1971 Cu.Yds.
Emb. + 22 %	2405 Cu.Yds.

PLAN & PROFILE STA. 35+00 to STA. 50+00