FED. RD. DIVISION	STATE	PROJECT	
2	OHIO		

46

CUYAHOGA COUNTY
CUY-71-10.16

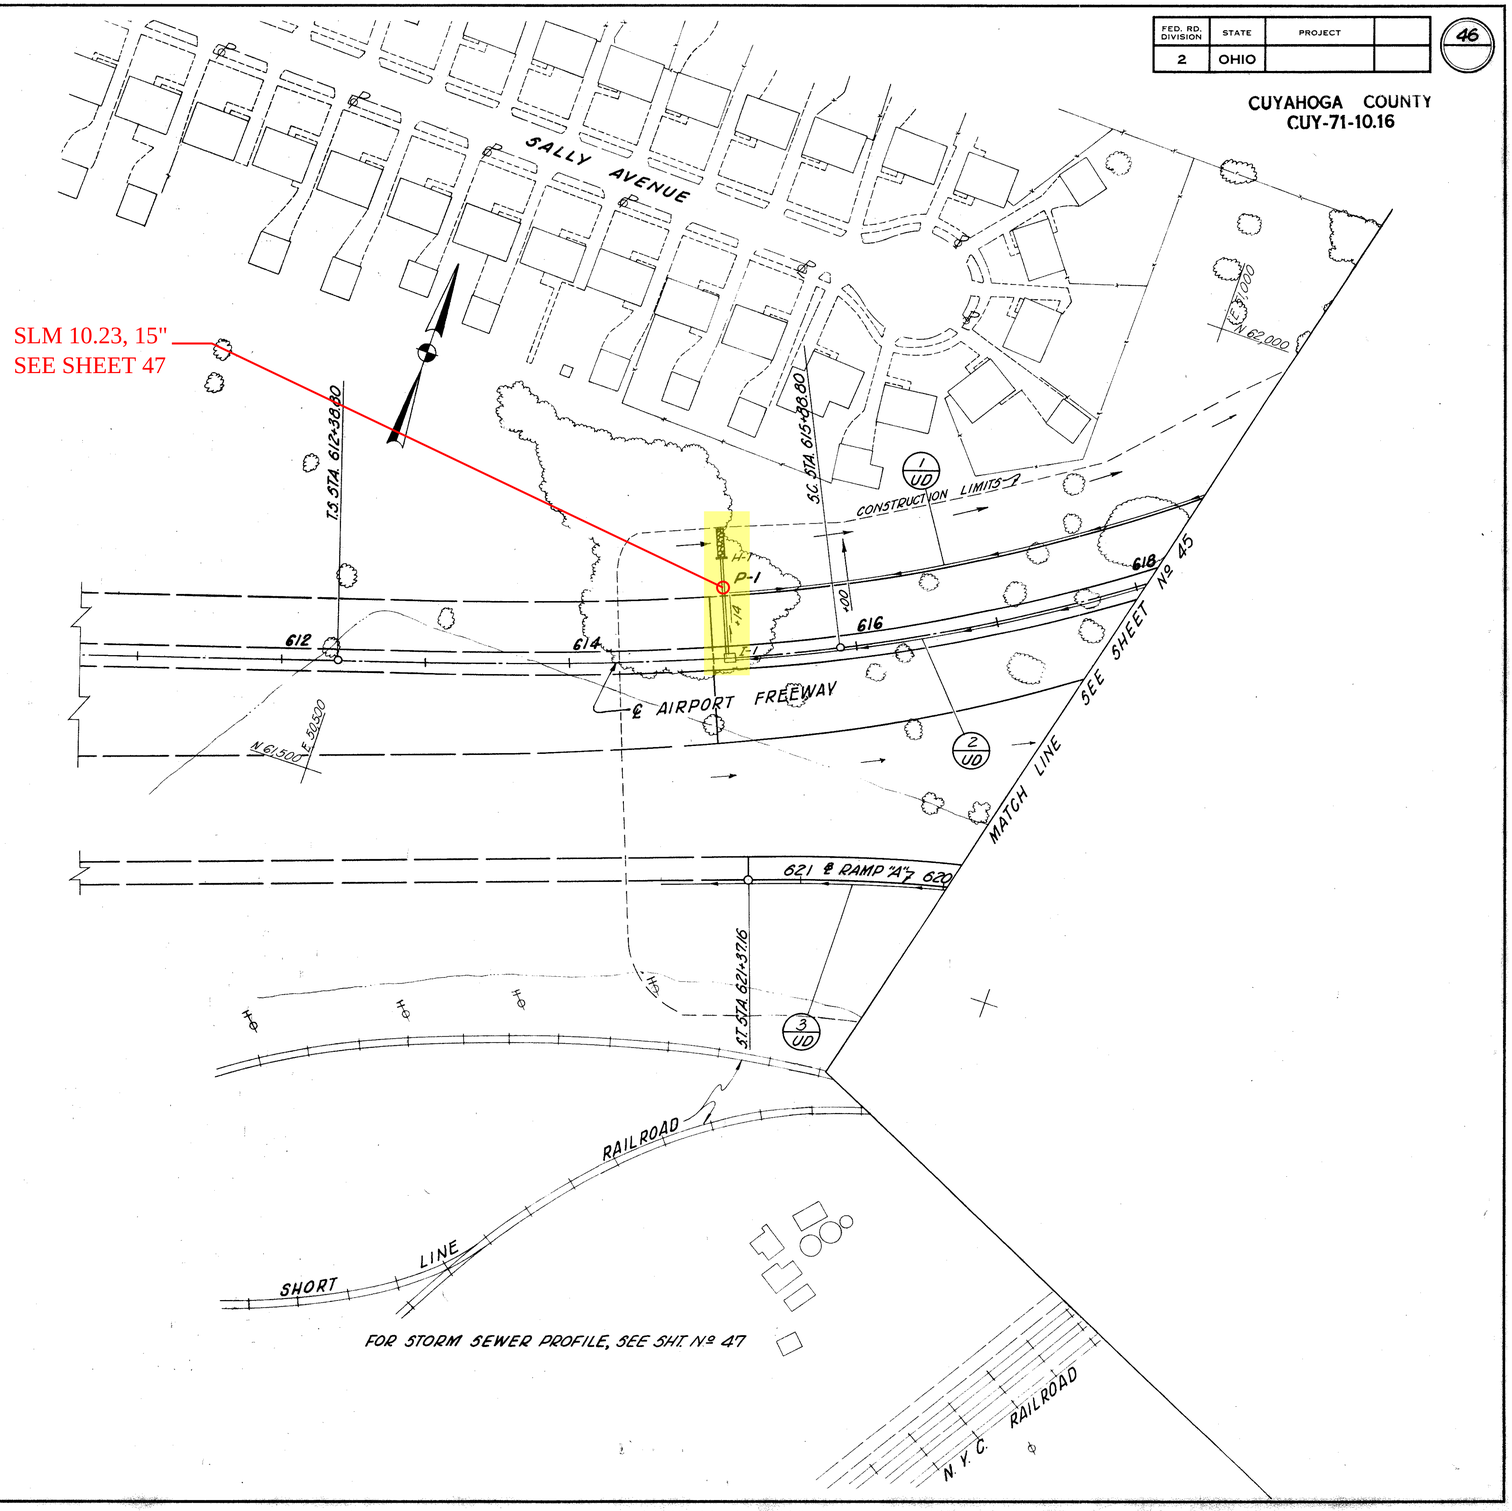

ESTIMATED QUANTITIES

REF NO.	STATION TO STATION	SIDE	I-1 CL. I-3 6"	I-1 CLASS F-4 6"	I-1 CLASS F-4 8", SEC. M-64(c)	I-5 CL. F-3 6" TEE			
			LIN. FT.	LIN. FT.		EACH			
		LT.	138						
1-UD	615+14 ~ 618+60	LT.	431		10	1			
2-UD	615+14 ~ 618+10	℄	286	10					
3-UD	"A" 620+00 ~ 621+97		197						
TOTALS			914	10	10	1			

DRAINAGE - UTILITIES PLAN STA. 610+00 TO STA. 618+00