Ohio Department of Transportation
Vertical Clearance Survey Form

County: CUYAHOGA Route: I90 Date: 12/20/18
Structure No. CUY-322-01.31 By: GARCIA

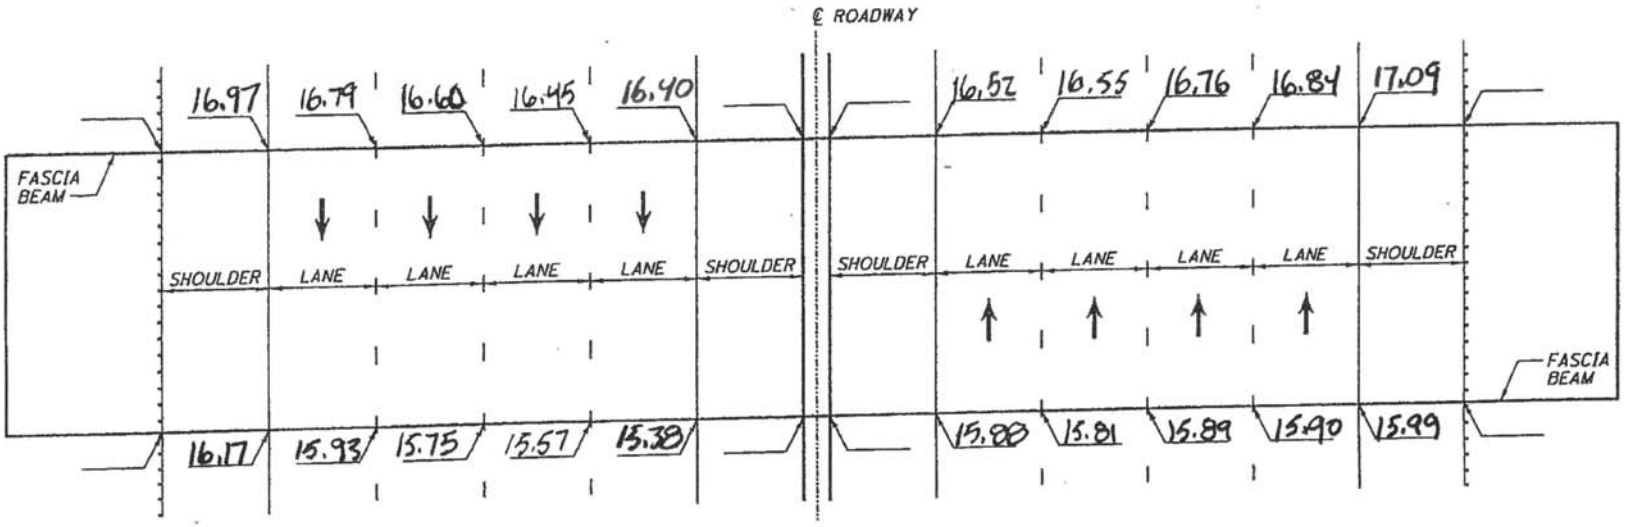

PLAN - FOUR LANE DIVIDED ROADWAY

STATE OF OHIO
ROBERT E. BRAZIER
S-8109
REGISTERED PROFESSIONAL SURVEYOR

Robert E Brazier