


SCIOTO COUNTY  
HARRISON TOWNSHIP  
SECTION 9

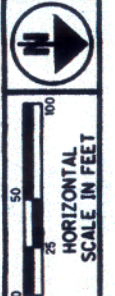

PID NO.  
**19415**


R/W DESIGNER  
R/W REVIEWER  
SRL

**RIGHT OF WAY DETAIL PLAN**  
**STA. 365+00 TO STA. 378+00**

**SCI-823-6.81**

16 / 37

J:\TS\07-320 SCI-823\SCI\19415\row\sheet\19415RD002.dgn 1/18/2010 8:25:29 AM srlindgren ODOT\_MS\_PDF\_FULL.plt ODOT\_MS\_PENTABLE\_Full\_M-E.tbl M-E Companies, Inc.

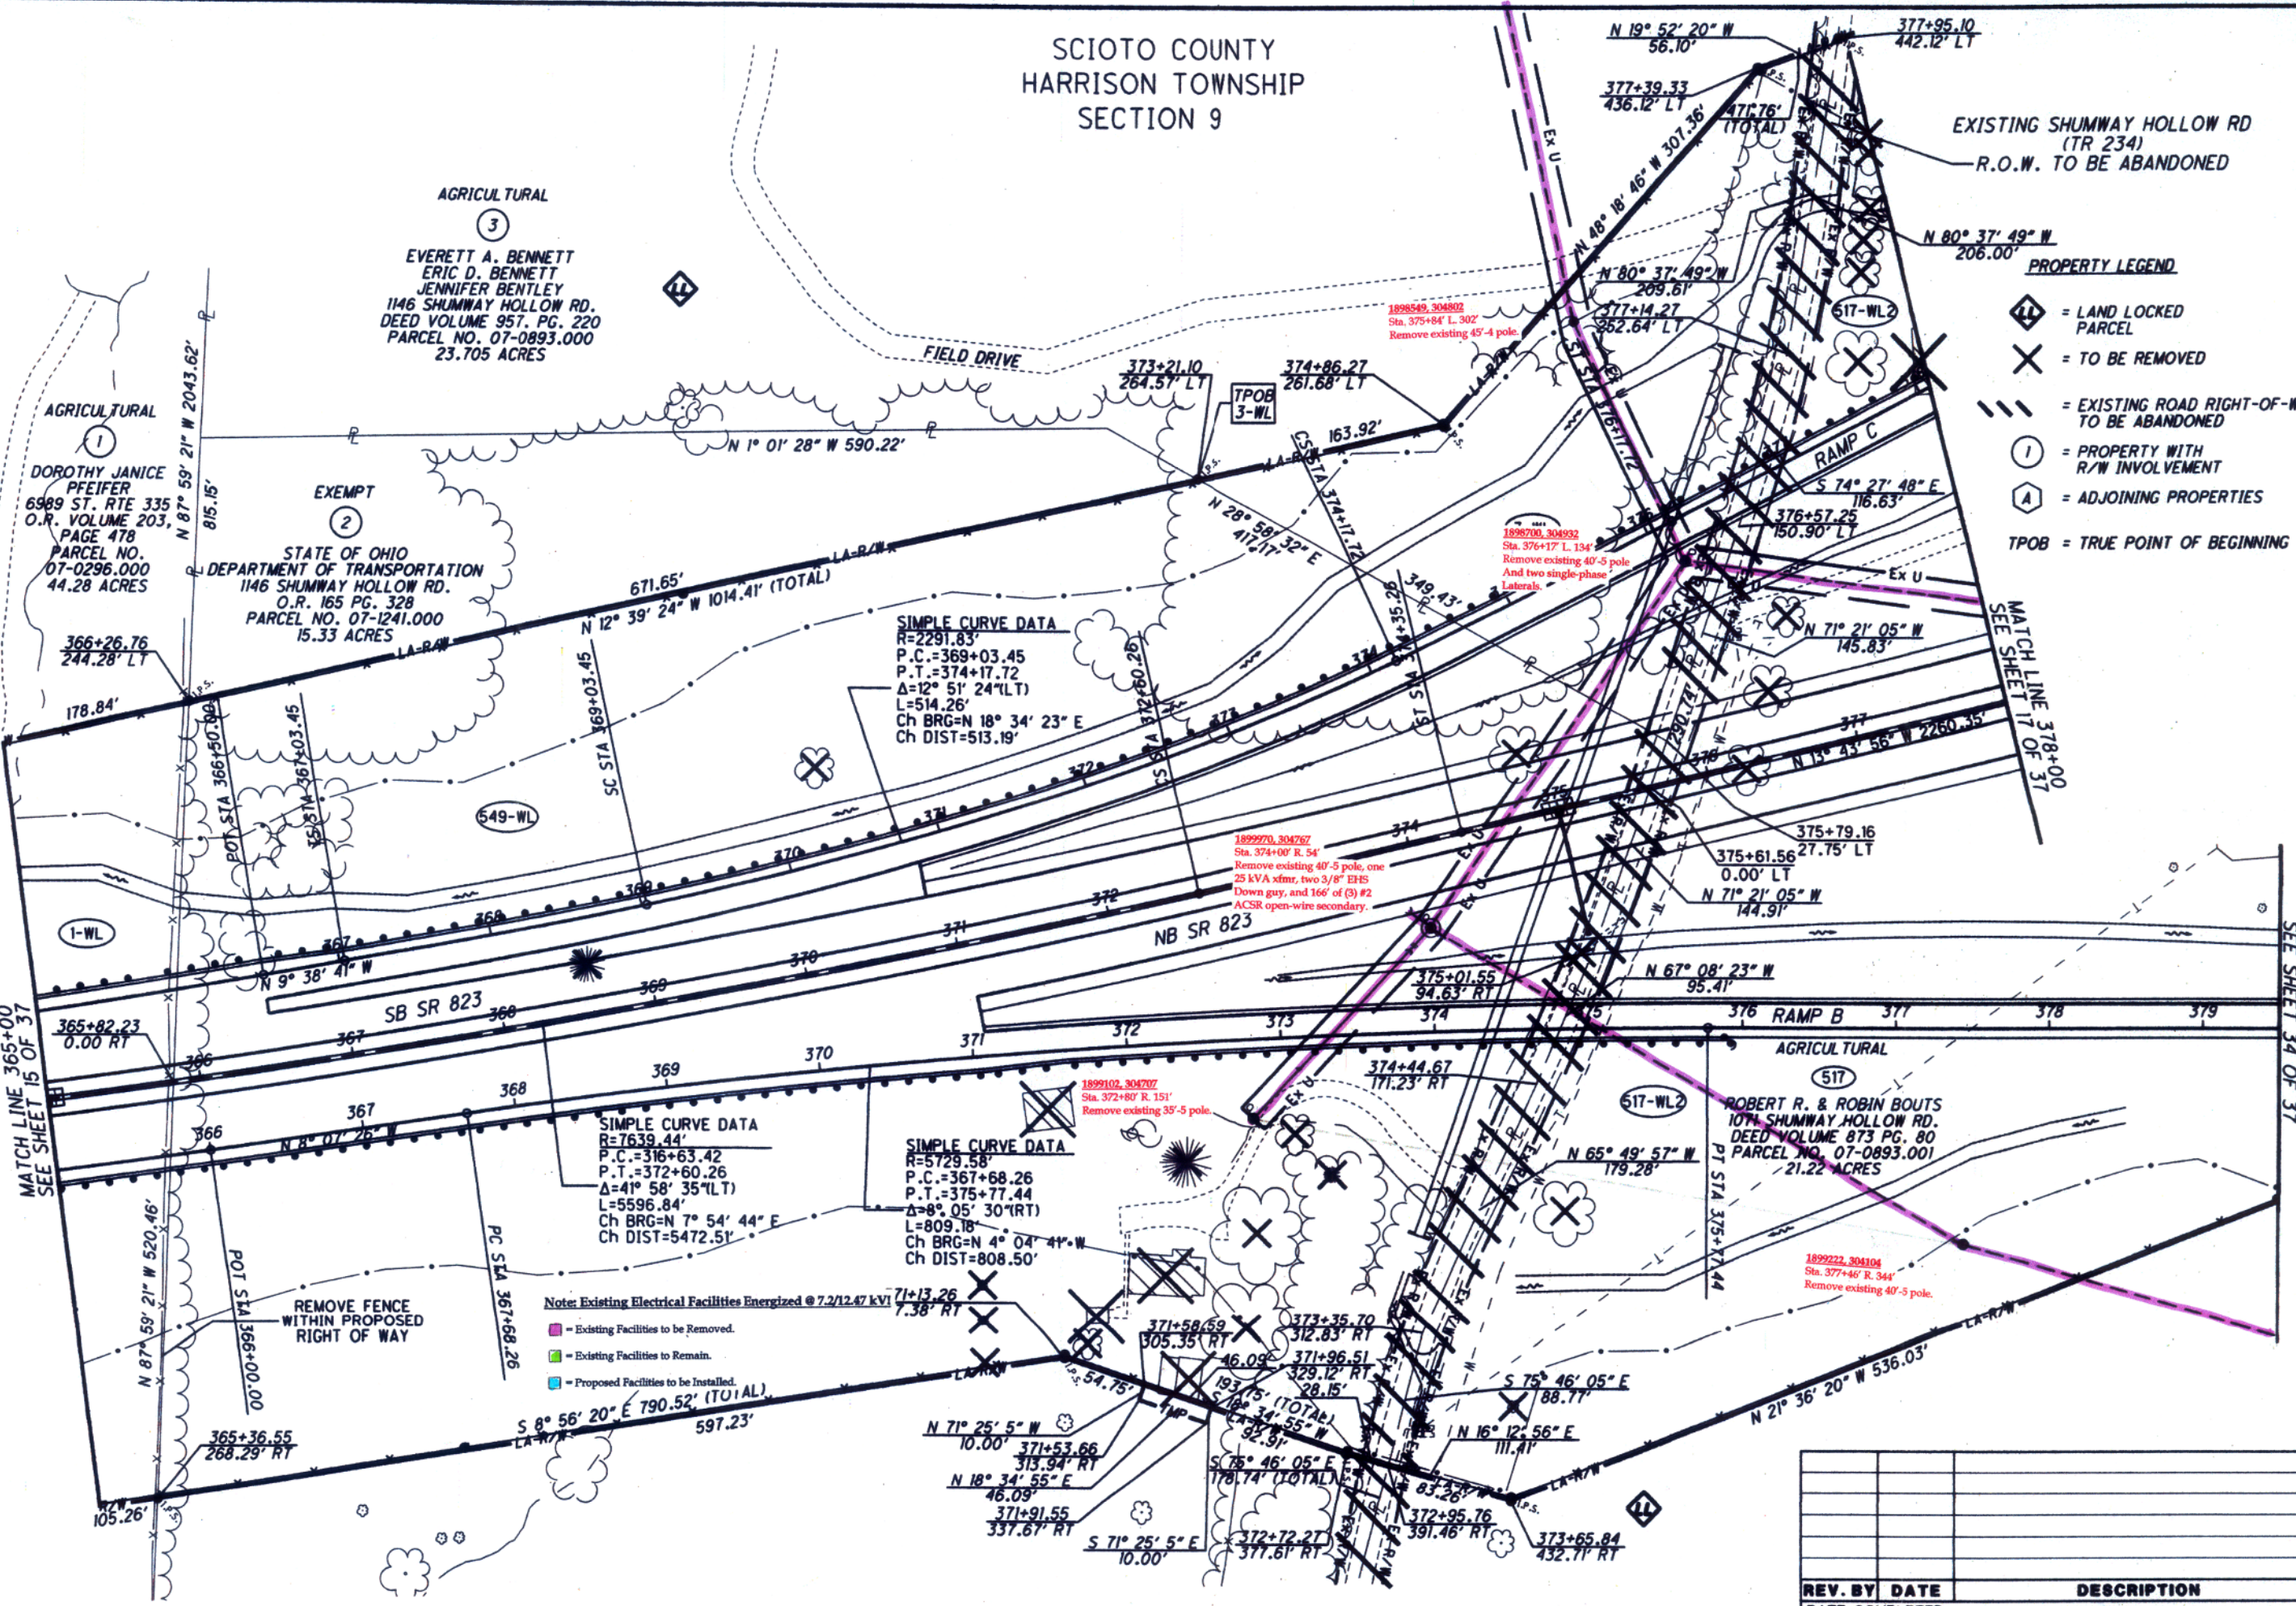

AGRICULTURAL  
3  
EVERETT A. BENNETT  
ERIC D. BENNETT  
JENNIFER BENTLEY  
1146 SHUMWAY HOLLOW RD.  
DEED VOLUME 957, PG. 220  
PARCEL NO. 07-0893.000  
23.705 ACRES

AGRICULTURAL  
1  
DOROTHY JANICE  
PFEIFER  
6989 ST. RTE 335  
O.R. VOLUME 203,  
PAGE 478  
PARCEL NO.  
07-0296.000  
44.28 ACRES

EXEMPT  
2  
STATE OF OHIO  
DEPARTMENT OF TRANSPORTATION  
1146 SHUMWAY HOLLOW RD.  
O.R. 165 PG. 328  
PARCEL NO. 07-1241.000  
15.33 ACRES

**SIMPLE CURVE DATA**  
R=2291.83'  
P.C.=369+03.45  
P.T.=374+17.72  
Δ=12° 51' 24"(LT)  
L=514.26'  
Ch BRG=N 18° 34' 23" E  
Ch DIST=513.19'

**SIMPLE CURVE DATA**  
R=7639.44'  
P.C.=316+63.42  
P.T.=372+60.26  
Δ=41° 58' 35"(LT)  
L=5596.84'  
Ch BRG=N 7° 54' 44" E  
Ch DIST=5472.51'

**SIMPLE CURVE DATA**  
R=5729.58'  
P.C.=367+68.26  
P.T.=375+77.44  
Δ=8° 05' 30"(RT)  
L=809.18'  
Ch BRG=N 4° 04' 41" W  
Ch DIST=808.50'

Note: Existing Electrical Facilities Energized @ 7.2/12.47 kV  
■ Existing Facilities to be Removed.  
■ Existing Facilities to Remain.  
■ Proposed Facilities to be Installed.

EXISTING SHUMWAY HOLLOW RD  
(TR 234)  
R.O.W. TO BE ABANDONED

**PROPERTY LEGEND**

- LL = LAND LOCKED PARCEL
- X = TO BE REMOVED
- = EXISTING ROAD RIGHT-OF-WAY TO BE ABANDONED
- I = PROPERTY WITH R/W INVOLVEMENT
- A = ADJOINING PROPERTIES
- TPOB = TRUE POINT OF BEGINNING

REV. BY	DATE	DESCRIPTION


NOV 23 2010

J:\TS\07-320\_SCI-823\SCI\19415\row\sheets\19415RD003.dgn 1/18/2010 8:25:30 AM srindgren ODOT\_MS\_PDF\_FULL.plt ODOT\_MS\_PENTABLE\_Full\_M-E.tbl M-E Companies, Inc.

**PROPERTY LEGEND**

- = LAND LOCKED PARCEL
- = TO BE REMOVED
- = EXISTING ROAD RIGHT-OF-WAY TO BE ABANDONED
- = PROPERTY WITH R/W INVOLVEMENT
- = ADJOINING PROPERTIES
- TPOB = TRUE POINT OF BEGINNING

SCIOTO COUNTY  
HARRISON TOWNSHIP  
SECTION 9

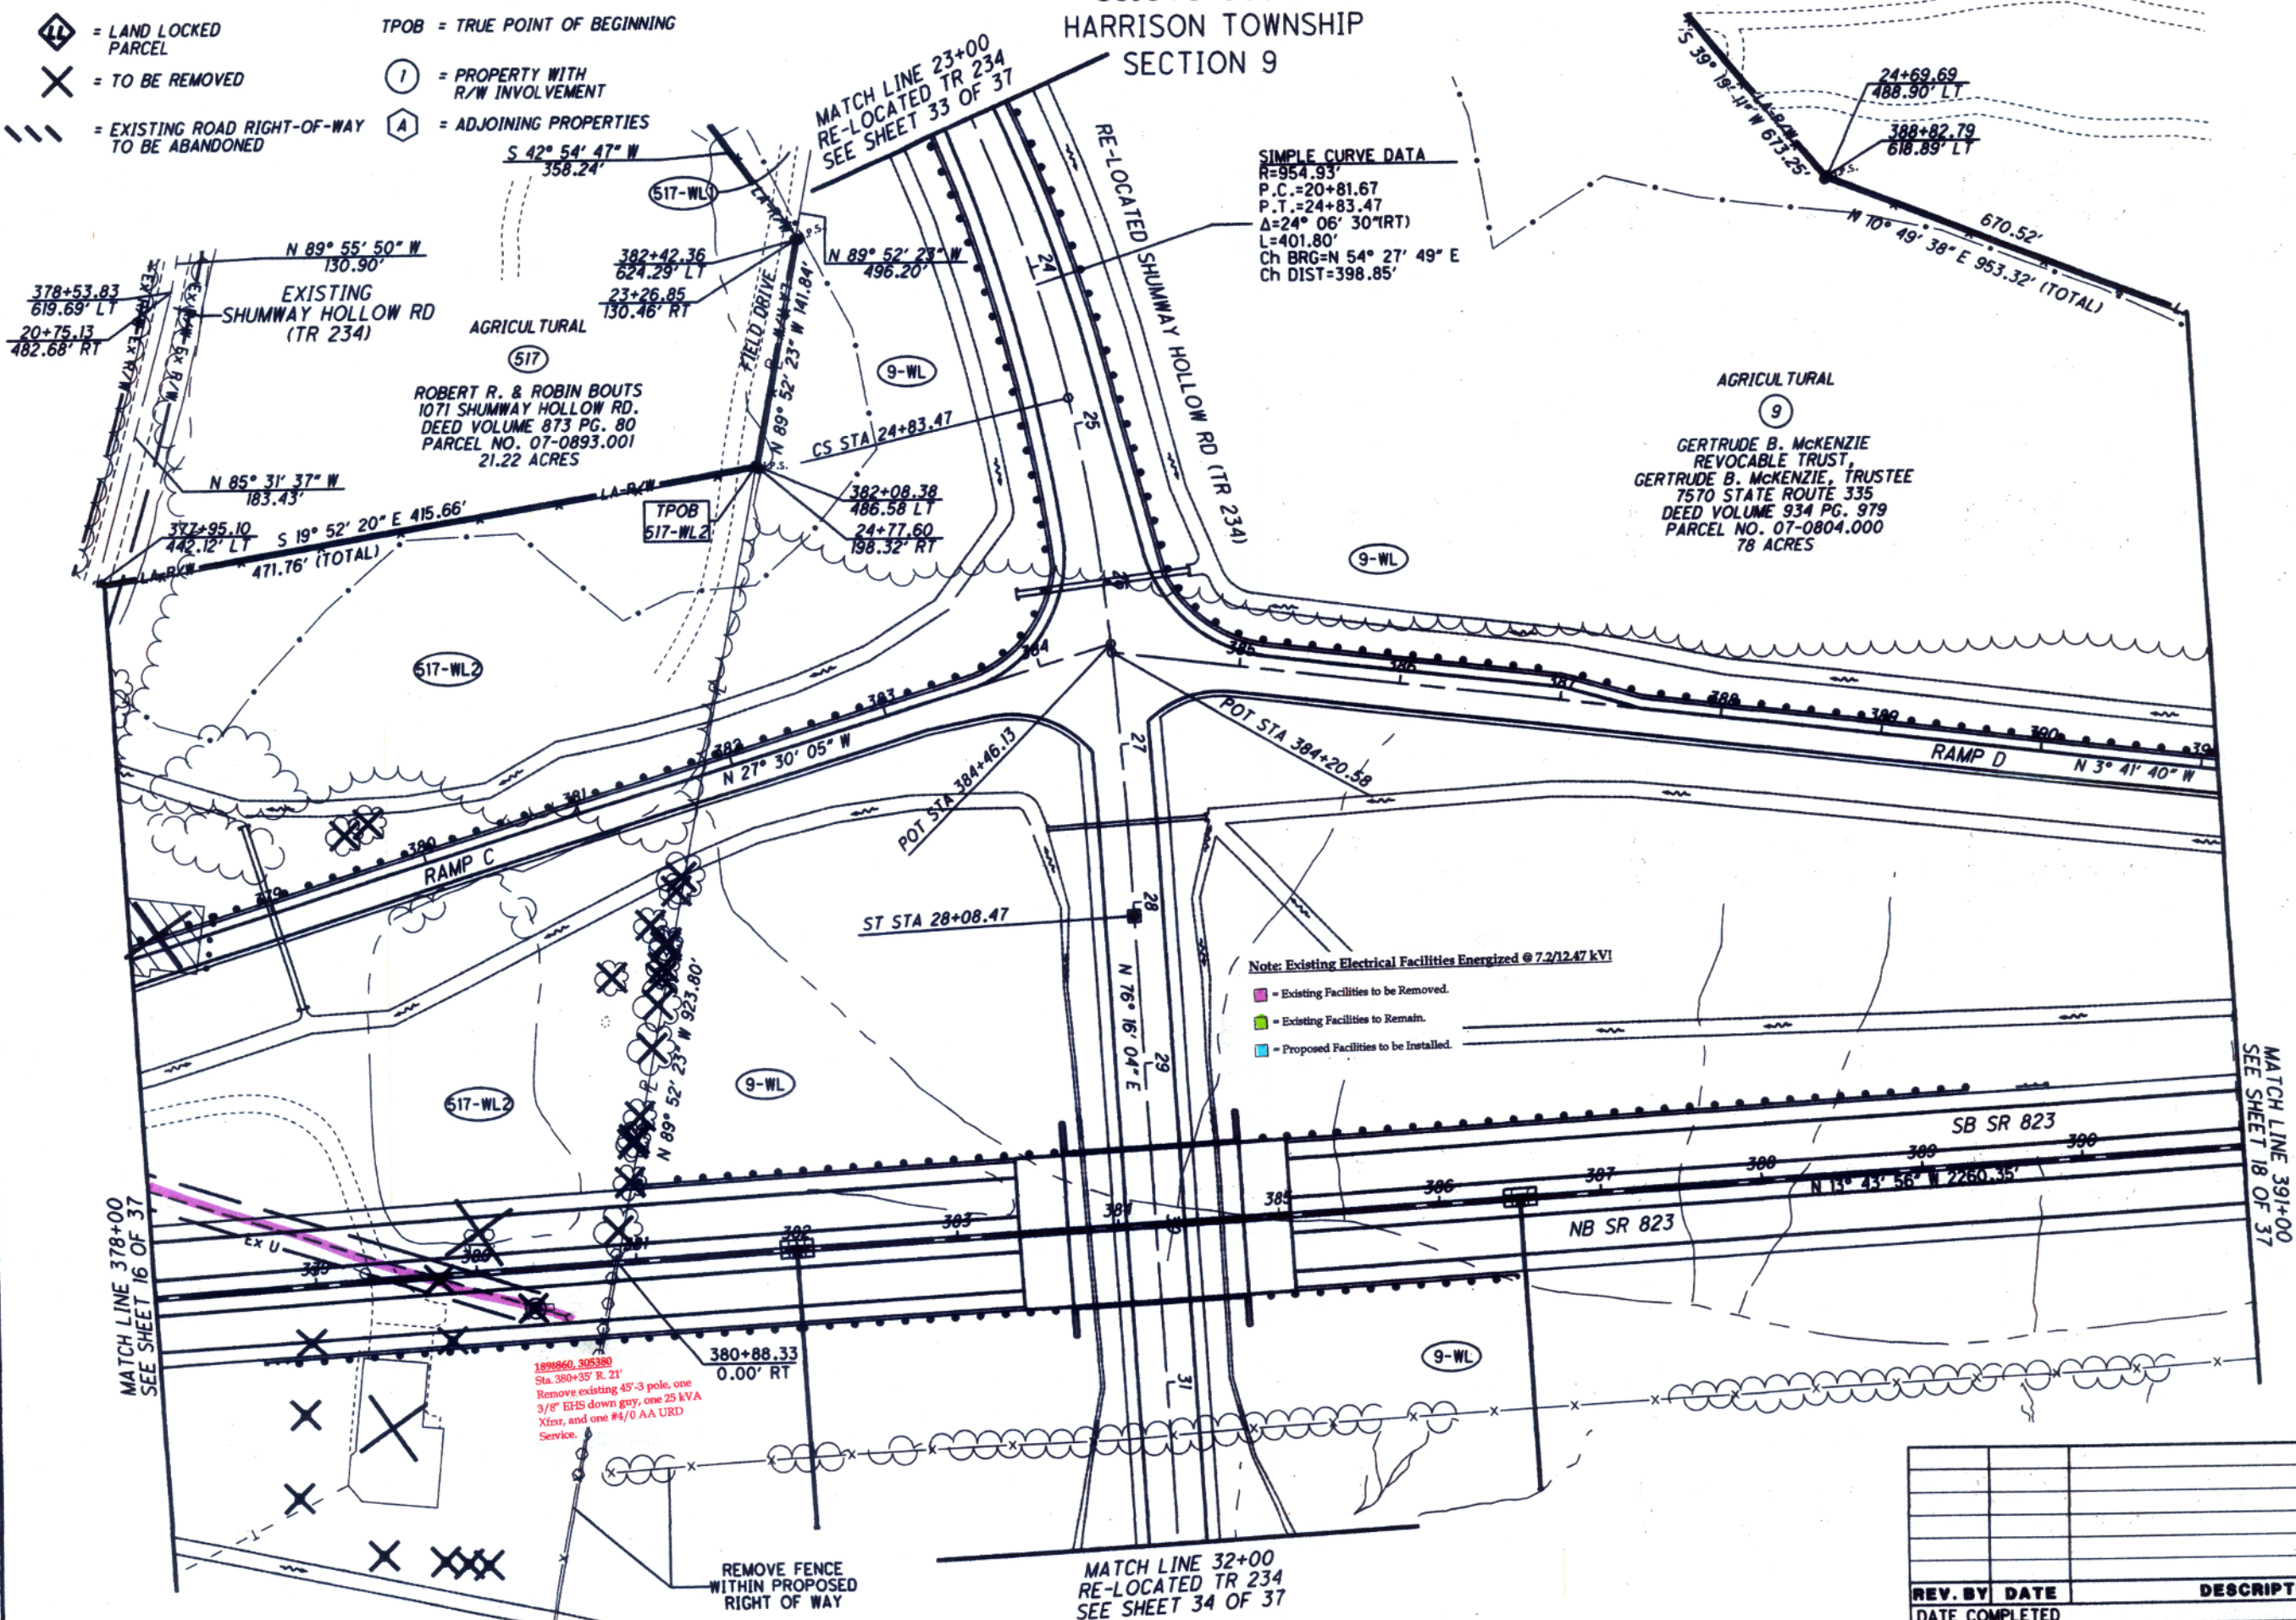

**SIMPLE CURVE DATA**  
 R=954.93'  
 P.C.=20+81.67  
 P.T.=24+83.47  
 Δ=24° 06' 30"(RT)  
 L=401.80'  
 Ch BRG=N 54° 27' 49" E  
 Ch DIST=398.85'


AGRICULTURAL  
 9  
 GERTRUDE B. MCKENZIE  
 REVOCABLE TRUST,  
 GERTRUDE B. MCKENZIE, TRUSTEE  
 7570 STATE ROUTE 335  
 DEED VOLUME 934 PG. 979  
 PARCEL NO. 07-0804.000  
 78 ACRES

Note: Existing Electrical Facilities Energized @ 7.2/12.47 kV!

- = Existing Facilities to be Removed.
- = Existing Facilities to Remain.
- = Proposed Facilities to be Installed.

1899860\_305380  
 Sta. 380+35' R. 21'  
 Remove existing 45'-3 pole, one  
 3/8" EHS down guy, one 25 kVA  
 Xtra, and one #4/0 AA URD  
 Service.

REV. BY	DATE	DESCRIPTION



PID NO.  
**19415**


R/W DESIGNER  
R/JY

R/W REVIEWER  
S/R

**RIGHT OF WAY DETAIL PLAN**  
**STA. 378+00 TO STA. 391+00**

SCI-823-6.81

17 / 37



NOV 23 2010

J:\TS\07-07-320 SCI-823\SCIN19415\row\sheet\19415RD007.dgn 1/18/2010 8:25:36 AM srlindgren ODOT\_MS\_PDF\_FULL.plt ODOT\_MS\_PENTABLE\_Full\_M-E.tbi M-E Companies, Inc.

PROPERTY LEGEND

- = LAND LOCKED PARCEL
- = TO BE REMOVED

= EXISTING ROAD RIGHT-OF-WAY TO BE ABANDONED

= PROPERTY WITH R/W INVOLVEMENT

= ADJOINING PROPERTIES

TPOB = TRUE POINT OF BEGINNING

- N 84° 46' 25" E 54.20'
- N 18° 38' 56" E 34.57'
- N 48° 20' 23" E 43.85'
- N 80° 03' 16" W 243.76'

SCIOTO COUNTY HARRISON TOWNSHIP SECTIONS 4 & 5

RESIDENTIAL

PATRICIA ADAMS  
6000 SWAUGER VALLEY RD.  
DEED VOLUME 941 PG. 34  
PARCEL NO. 07-0017.000  
18 ACRES

HAROLD D. & MARY P. CONKLIN  
PARCEL NO. 07-2592.000  
17.89 ACRES

- N 12° 26' 34" E 50.14'
- S 12° 25' 58" W 170.54'
- N 3° 20' 35" W 1148.64' (SEC. COR TO E)
- N 28° 19' 46" E 50.00'
- S 61° 40' 14" E 65.05'
- S 28° 19' 46" W 50.00'
- S 3° 58' 45" W 83.37'
- S 52° 17' 53" E 23.27'
- S 33° 29' 18" W 74.90'

REMOVE FENCE WITHIN PROPOSED RIGHT OF WAY

MATCH LINE 432+00  
SEE SHEET 20 OF 37

MATCH LINE 446+50  
SEE SHEET 22 OF 37

EX. E SWAUGER VALLEY  
SIMPLE CURVE DATA C-2  
R=625.00'  
Δ=7° 42' 13"  
L=84.86'  
Ch BRG=N 10° 10' 10" E  
Ch DIST=84.79'

EX. E SWAUGER VALLEY  
SIMPLE CURVE I  
R=625.00'  
Δ=27° 47' 41"  
L=303.19'  
Ch BRG=N 20° 10' 46" E  
Ch DIST=300.23'

E SWAUGER VALLEY  
PLE CURVE DATA C-4  
R=25.00'  
Δ=8° 20' 37"  
L=91.01'  
Ch BRG=S 10° 27' 14" W  
Ch DIST=90.93'

Note: Existing Electrical Facilities Energized @ 7.2/12.47 kV!

- Existing Facilities to be Removed.
- Existing Facilities to Remain.
- Proposed Facilities to be Installed.

DAVID R. SAMSON  
O STATE ROUTE 335  
O.R. 16, PG. 473  
PARCEL NO. 07-1166.000  
139.78 ACRES

RESIDENTIAL  
TIMOTHY R. & AMBER D. SPARKS  
6072 SWAUGER VALLEY  
OFFICIAL RECORD 233 PG. 805  
PARCEL NO. 07-0749.000  
0.98 ACRES  
PARCEL NO. 07-0750.000  
0.98 ACRES

RESIDENTIAL  
CHARLES SMITH, JOSH & MICHAEL CONKEL  
JUANITA DROGHEI, ET AL  
6149 SWAUGER VALLEY RD.  
OFFICIAL RECORD 997 PG. 177  
PARCEL NO. 07-1264.000  
0.57 ACRES

AGRICULTURAL  
KEN RASE REAL ESTATE, INC  
6303 SWAUGER VALLEY RD.  
DEED VOLUME 916 PG. 43  
PARCEL NO. 07-1116.000  
13.14 ACRES

16 18 19 20 21 NOT USED



HORIZONTAL SCALE IN FEET

PID NO. 19415

R/W DESIGNER R/JY  
R/W REVIEWER SRL

RIGHT OF WAY DETAIL PLAN  
STA. 432+00 TO STA. 446+50

SCI-823-6.81

21 / 37

REV. BY	DATE	DESCRIPTION

NOV 23 2010

J:\ATS\07\07-320\_SCI-823\SCN19415\row\_sheets\19415RD008.dgn 1/18/2010 8:25:38 AM srlindgren ODOT\_MS\_PDF\_FULL.plt ODOT\_MS\_PENTABLE\_Full\_M-E.tbl M-E Companies, Inc.

SCIOTO COUNTY  
HARRISON TOWNSHIP  
SECTION 5

PROPERTY LEGEND

- = LAND LOCKED PARCEL
- = TO BE REMOVED
- = EXISTING ROAD RIGHT-OF-WAY TO BE ABANDONED
- = PROPERTY WITH R/W INVOLVEMENT
- = ADJOINING PROPERTIES
- TPOB = TRUE POINT OF BEGINNING




PID NO.  
**19415**

R/W DESIGNER  
R/JY  
R/W REVIEWER  
SRL

**RIGHT OF WAY DETAIL PLAN**  
**STA. 446+50 TO STA. 461+00**

**SCI-823-6.81**

22 / 37

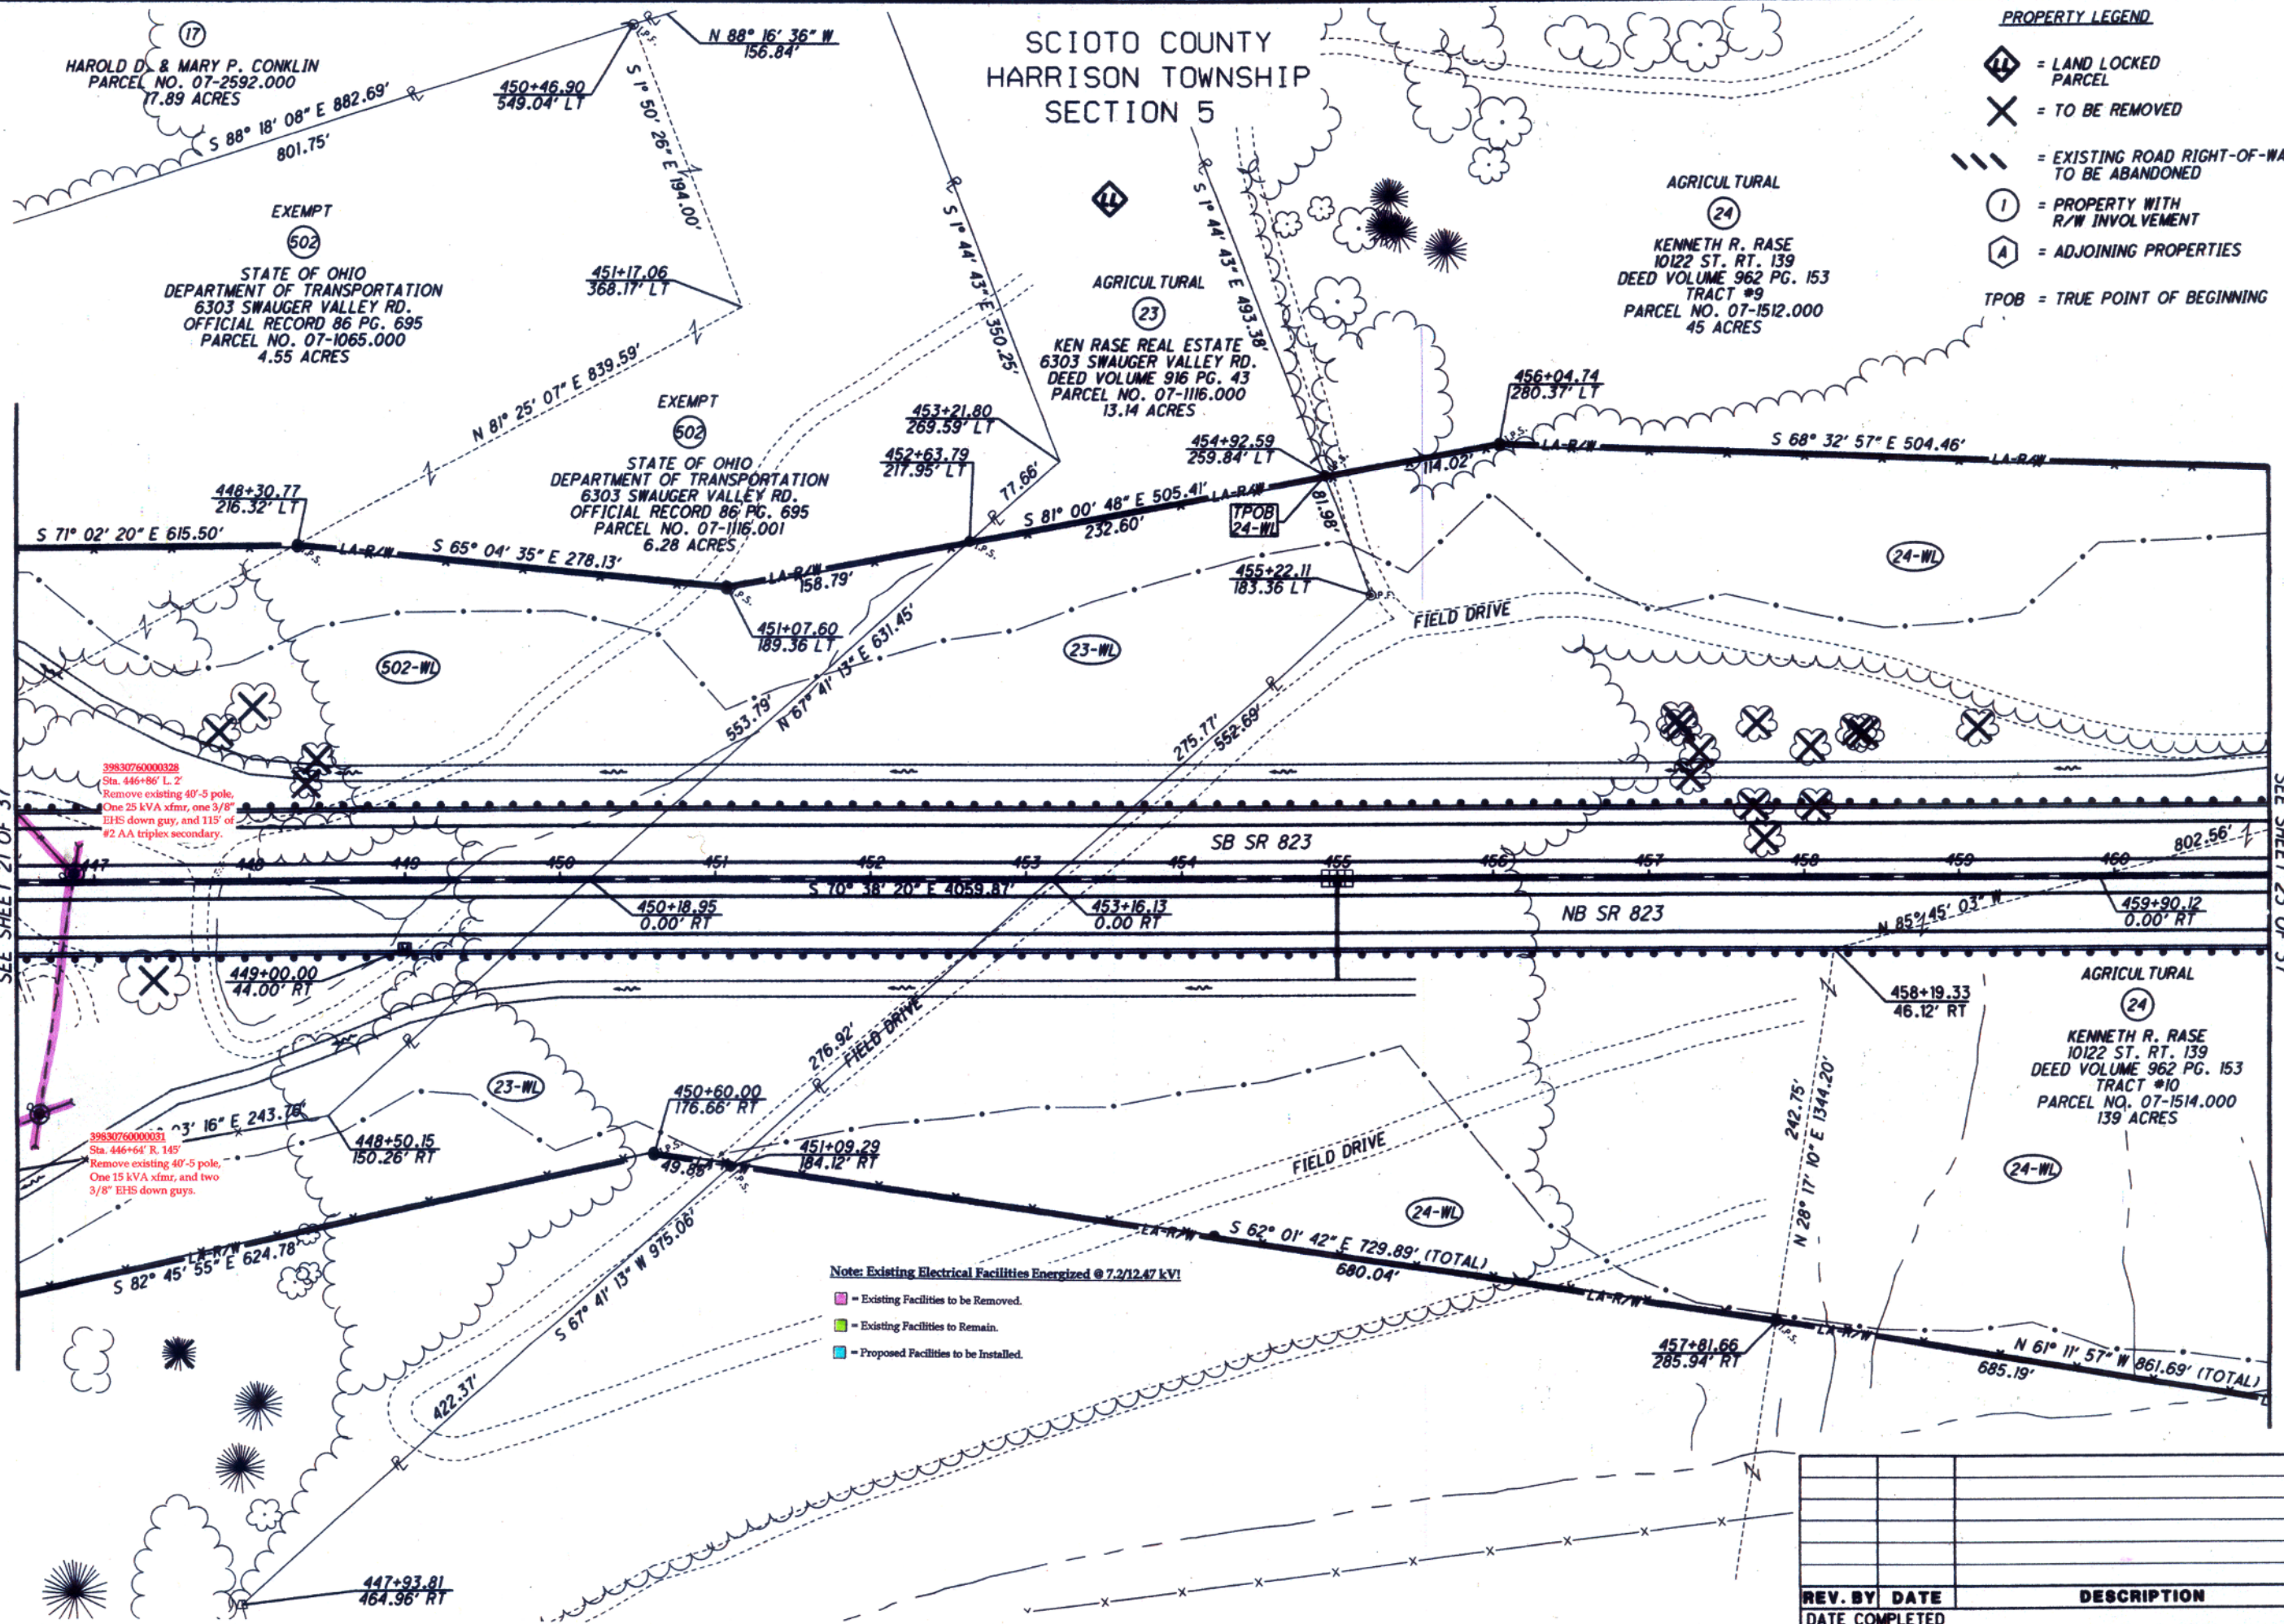

Note: Existing Electrical Facilities Energized @ 7.2/1247 kV!

- = Existing Facilities to be Removed.
- = Existing Facilities to Remain.
- = Proposed Facilities to be Installed.

REV. BY	DATE	DESCRIPTION

MATCH LINE 446+50  
SEE SHEET 21 OF 37

MATCH LINE 461+00  
SEE SHEET 23 OF 37


NOV 23 2010

J:\TS\07-320\_SCI-823\SC19415\row\sheet\19415RD010.dgn 1/18/2010 8:25:43 AM srlindgren ODOT\_MS\_PDF\_FULL.plt ODOT\_MS\_PENTABLE\_Full\_M-E.tbl M-E Companies, Inc.

# SCIOTO COUNTY HARRISON TOWNSHIP SECTION 5

- 27 RESIDENTIAL  
JOSEPH & CRYSTAL PRESTON  
41 OLIVER RD.  
DEED VOLUME 892 PG. 796  
PARCEL NO. 07-0969.000  
3.80 ACRES
- 28 AGRICULTURAL  
RICHARD & BARBARA TROWBRIDGE  
9309 ST. RT. 139  
DEED VOLUME 934 PG. 297  
PARCEL NO. 07-1374.002  
3.172 ACRES
- 29 RESIDENTIAL  
JOSEPH D. & BETH A WEEKLY  
97 OLIVER RD.  
O.R. 0050 PG. 687  
PARCEL NO. 07-2137.000  
LOT 15 EDGEWOOD PARK ADDITION


- 24 AGRICULTURAL  
KENNETH R. RASE  
10122 STATE ROUTE 139  
DEED VOLUME 962 PG. 153  
TRACT #10  
PARCEL NO. 07-1514.000  
139 ACRES
- 26 AGRICULTURAL  
RICHARD TROWBRIDGE,  
JAMES TROWBRIDGE,  
ROBERT TROWBRIDGE  
9309 ST. RT. 139  
DEED VOLUME 774 PG. 836  
PARCEL NO. 07-1374.000  
28.109 ACRES

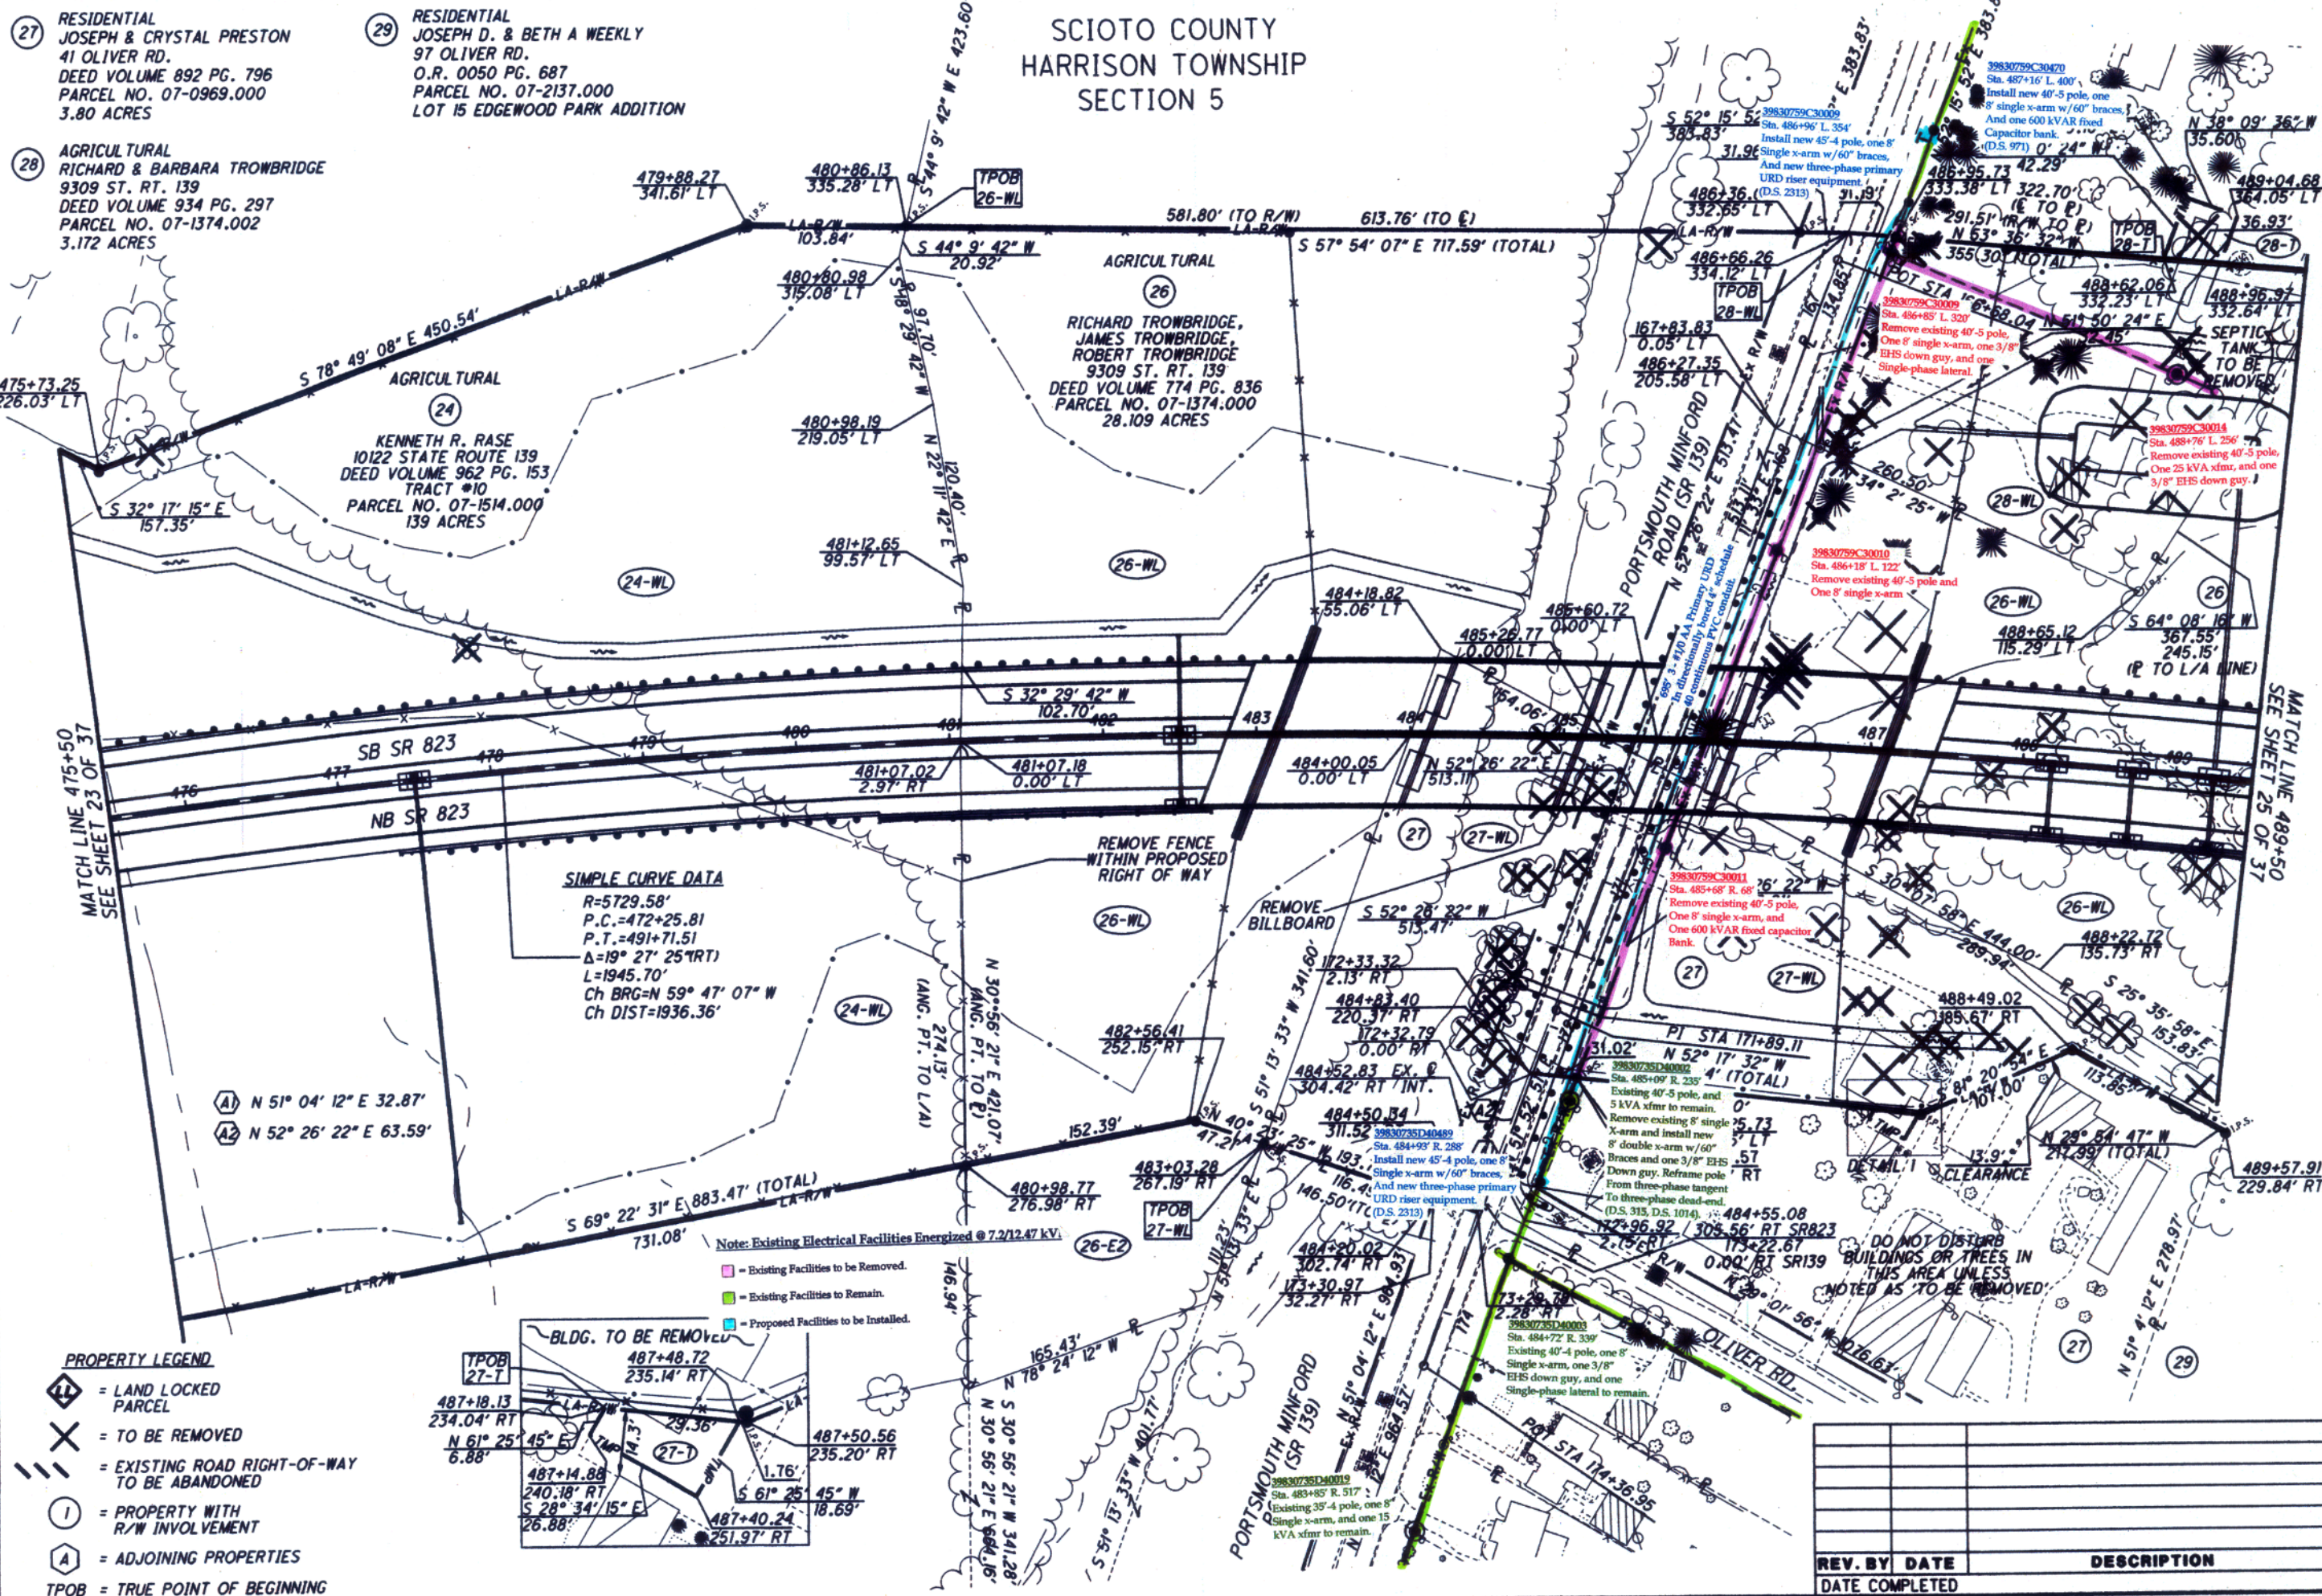

**SIMPLE CURVE DATA**  
 R=5729.58'  
 P.C.=472+25.81  
 P.T.=491+71.51  
 Δ=19° 27' 25" (RT)  
 L=1945.70'  
 Ch BRG=N 59° 47' 07" W  
 Ch DIST=1936.36'

Note: Existing Electrical Facilities Energized @ 7.2/12.47 kV.

- Existing Facilities to be Removed.
- Existing Facilities to Remain.
- Proposed Facilities to be Installed.

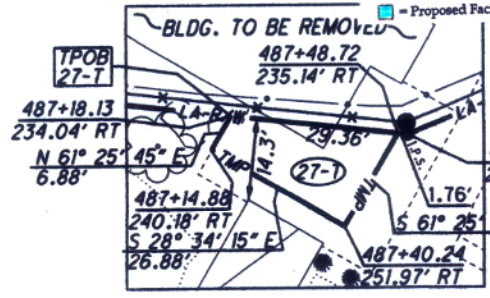

- PROPERTY LEGEND**
- LAND LOCKED PARCEL
  - TO BE REMOVED
  - EXISTING ROAD RIGHT-OF-WAY TO BE ABANDONED
  - PROPERTY WITH R/W INVOLVEMENT
  - ADJOINING PROPERTIES
  - TPOB = TRUE POINT OF BEGINNING

RIGHT OF WAY DETAIL PLAN  
STA. 475+50 TO STA. 489+50

SCI-823-6.81

24 / 37

NOV 23 2010

REV. BY	DATE	DESCRIPTION


PID NO. 19415  
 R/W DESIGNER RJY  
 R/W REVIEWER SRL

J:\NTS\07-07-320 SCI-823\SC19415\row\_sheets\19415RD014.dgn 1/18/2010 8:25:51 AM srrindgren ODOT\_MS\_PDF\_FULL.plt ODOT\_MS\_PDF\_PENTABLE\_Full\_M-E.tbl M-E Companies, Inc.

**PROPERTY LEGEND**

- = LAND LOCKED PARCEL
- = TO BE REMOVED
- = EXISTING ROAD RIGHT-OF-WAY TO BE ABANDONED
- = PROPERTY WITH R/W INVOLVEMENT
- = ADJOINING PROPERTIES
- = TRUE POINT OF BEGINNING

SCIOTO COUNTY  
MADISON TOWNSHIP  
SECTION 31

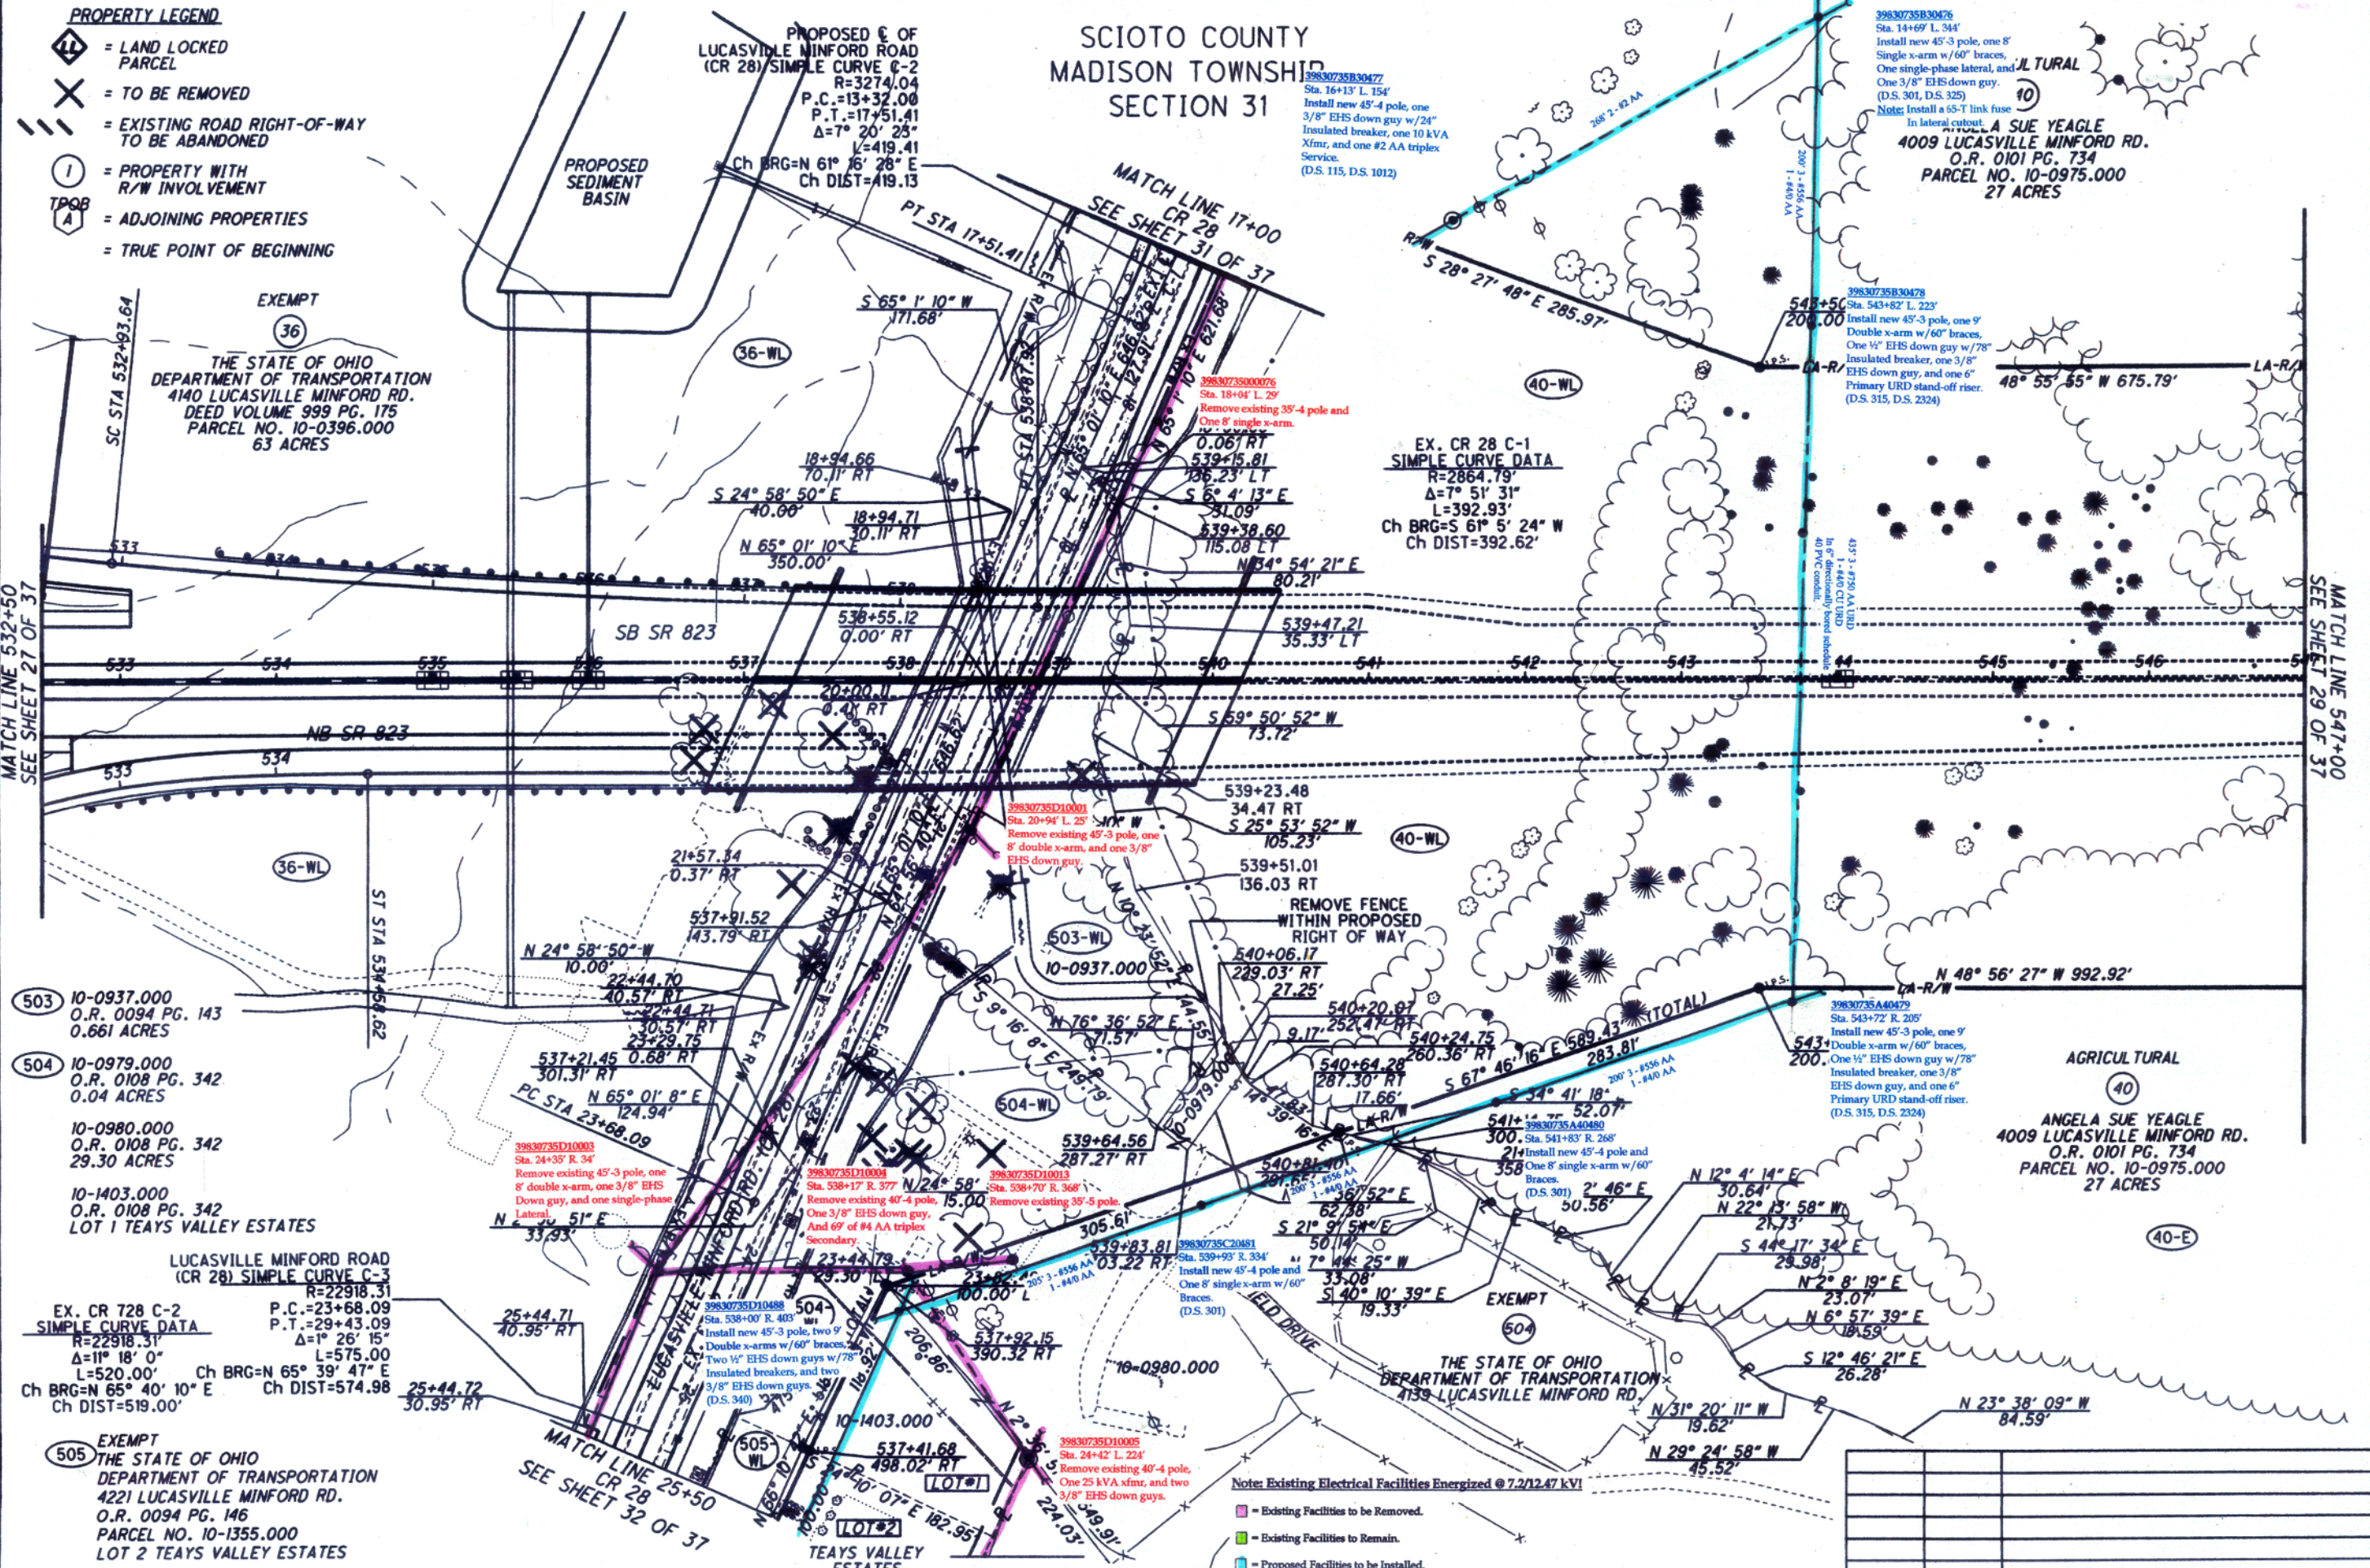

EXEMPT (36)  
THE STATE OF OHIO  
DEPARTMENT OF TRANSPORTATION  
4140 LUCASVILLE MINFORD RD.  
DEED VOLUME 999 PG. 175  
PARCEL NO. 10-0396.000  
63 ACRES

(503) 10-0937.000  
O.R. 0094 PG. 143  
0.661 ACRES

(504) 10-0979.000  
O.R. 0108 PG. 342  
0.04 ACRES

10-0980.000  
O.R. 0108 PG. 342  
29.30 ACRES

10-1403.000  
O.R. 0108 PG. 342  
LOT 1 TEAYS VALLEY ESTATES

LUCASVILLE MINFORD ROAD  
(CR 28) SIMPLE CURVE C-3  
R=22918.31  
EX. CR 728 C-2 P.C.=23+68.09  
SIMPLE CURVE DATA P.T.=29+43.09  
R=22918.31 Δ=11° 18' 0" L=575.00  
Δ=11° 18' 0" Ch BRG=N 65° 39' 47" E  
L=520.00' Ch DIST=574.98  
Ch BRG=N 65° 40' 10" E Ch DIST=519.00'

EXEMPT (505)  
THE STATE OF OHIO  
DEPARTMENT OF TRANSPORTATION  
4221 LUCASVILLE MINFORD RD.  
O.R. 0094 PG. 146  
PARCEL NO. 10-1355.000  
LOT 2 TEAYS VALLEY ESTATES

39830735R30476  
Sta. 14+69' L. 344'  
Install new 45'-3 pole, one 8' Single x-arm w/60° braces, One single-phase lateral, and One 3/8" EHS down guy. (D.S. 301, D.S. 325)  
Note: Install a 65-T link fuse  
In lateral cutout, A SUE YEAGLE  
4009 LUCASVILLE MINFORD RD.  
O.R. 0101 PG. 734  
PARCEL NO. 10-0975.000  
27 ACRES

39830735R30478  
Sta. 543+82' L. 223'  
Install new 45'-3 pole, one 9' Double x-arm w/60° braces, One 1/2" EHS down guy w/78" Insulated breaker, one 3/8" EHS down guy, and one 6" Primary URD stand-off riser. (D.S. 315, D.S. 2324)

39830735A40479  
Sta. 543+72' R. 205'  
Install new 45'-3 pole, one 9' Double x-arm w/60° braces, One 1/2" EHS down guy w/78" Insulated breaker, one 3/8" EHS down guy, and one 6" Primary URD stand-off riser. (D.S. 315, D.S. 2324)

AGRICULTURAL (40)  
ANGELA SUE YEAGLE  
4009 LUCASVILLE MINFORD RD.  
O.R. 0101 PG. 734  
PARCEL NO. 10-0975.000  
27 ACRES

Note: Existing Electrical Facilities Energized @ 7.2/12.47 kV!

- = Existing Facilities to be Removed.
- = Existing Facilities to Remain.
- = Proposed Facilities to be Installed.

HORIZONTAL SCALE IN FEET

PID NO. 19415

R/W DESIGNER RUY R/W REVIEWER SRL

RIGHT OF WAY DETAIL PLAN  
STA. 532+50 TO STA. 547+00

SCI-823-6.81

28 / 37

REV. BY	DATE	DESCRIPTION

NOV 23 2010

J:\ATS\07-320\_SCI-823\SCIN\19415\row\sheet\19415RD017.dgn 1/18/2010 8:25:56 AM srindgren ODOT\_MS\_PDF\_FULL.plt ODOT\_MS\_PENTABLE\_Full\_M-E.tbl M-E Companies, Inc.


# SCIOTO COUNTY HARRISON TOWNSHIP SECTION 6 MADISON TOWNSHIP SECTION 31

39830735830474  
Sta. 10+20 L. 213'  
Install new 45'-3 pole, two  
9' double x-arms w/60' braces,  
Two 1/2" EHS down guys w/78"  
insulated breakers, and two 3/8"  
EHS down guys. Transfer existing  
Single-phase lateral  
(D.S. 325, D.S. 340)  
Note: Install a 65-T link fuse  
in lateral cutout.

39830735000102  
Sta. 10+22 L. 123'  
Remove existing 30'-5 pole and  
One 8' single x-arm.

39830735830475  
Sta. 12+25 L. 270'  
Install new 50'-3 pole and one  
8' single x-arm w/60' braces.  
(D.S. 301)

39830735830476  
Sta. 14+69 L. 344'  
RESIDENT  
ANGELA SUE  
4009 LUCASVILLE MINFORD RD.  
U.R. 010 PG. 134  
PARCEL NO. 10-0975.000  
27 ACRES  
2007 3 - 8556 AA  
1 - 84/0 AA

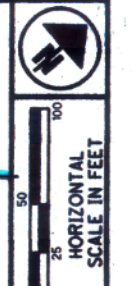

PID NO.  
**19415**

R/W DESIGNER  
RUY


R/W REVIEWER  
SRL

**RIGHT OF WAY DETAIL PLAN**  
**RAMP D 539+00 TO CR 28**

**SCI-823-6.81**

31 / 37

NOV 23 2010

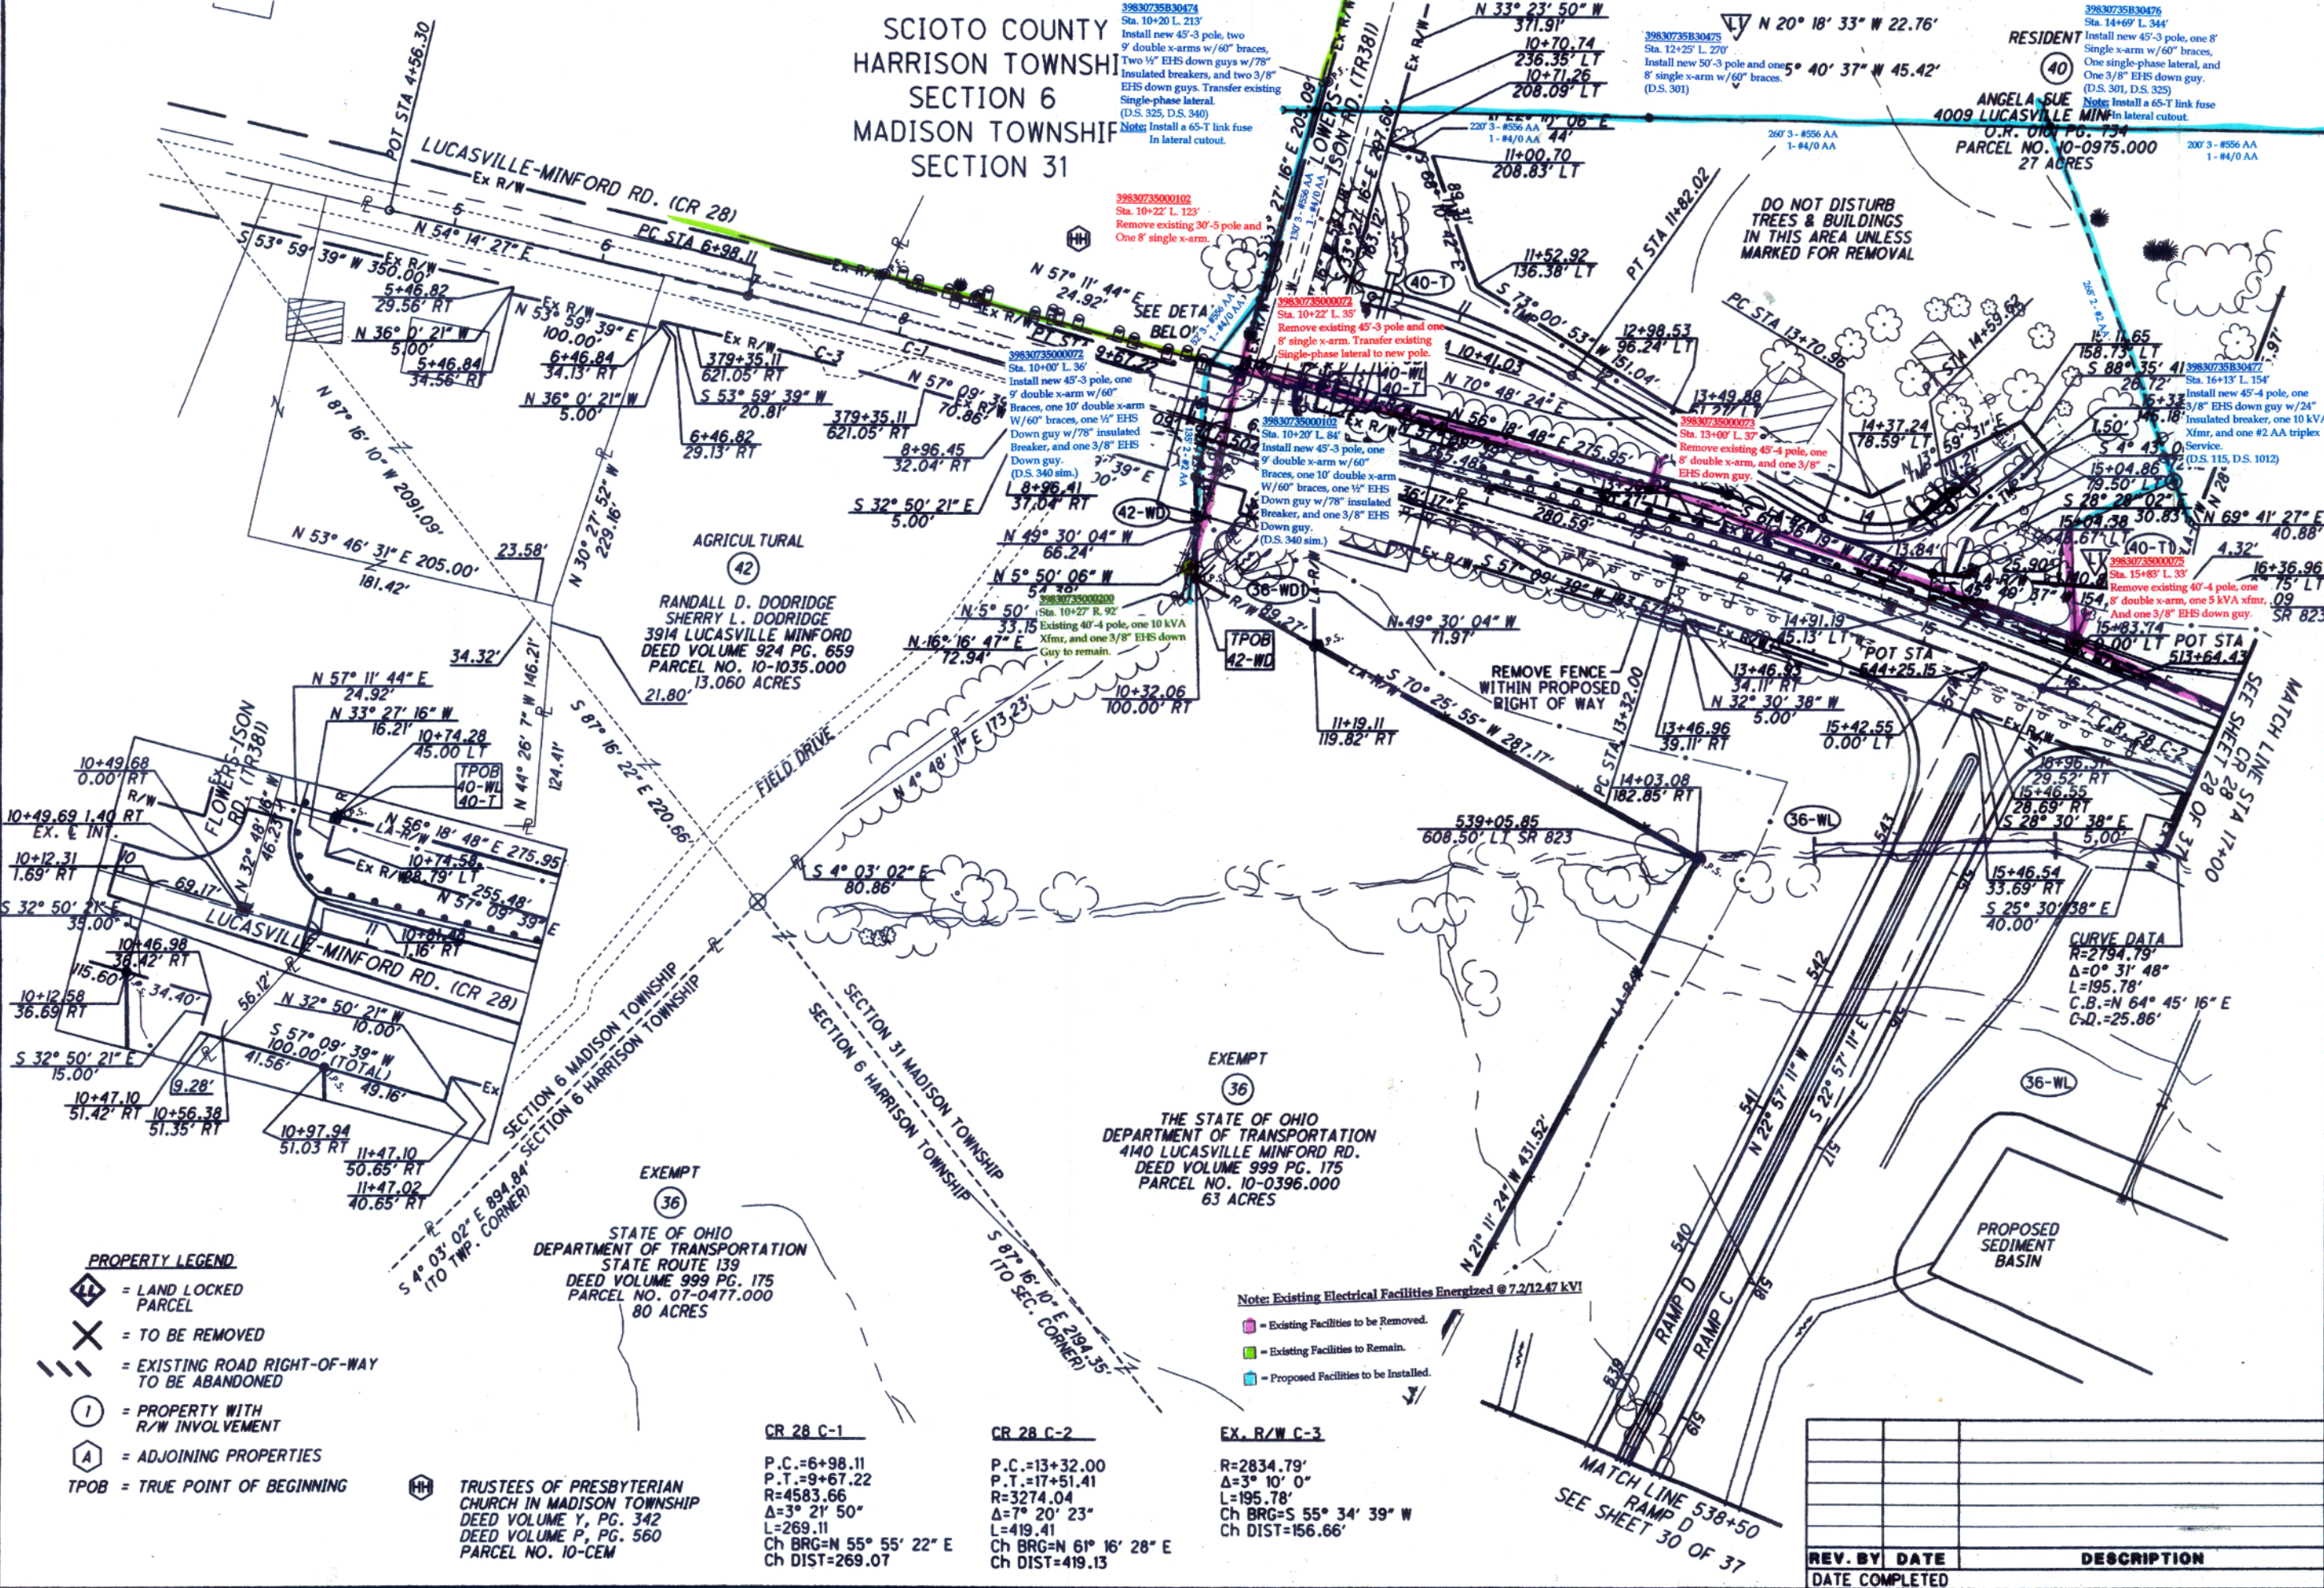

AGRICULTURAL  
(42)  
RANDALL D. DODRIDGE  
SHERRY L. DODRIDGE  
3914 LUCASVILLE MINFORD  
DEED VOLUME 924 PG. 659  
PARCEL NO. 10-1035.000  
13.060 ACRES

EXEMPT  
(36)  
THE STATE OF OHIO  
DEPARTMENT OF TRANSPORTATION  
4140 LUCASVILLE MINFORD RD.  
DEED VOLUME 999 PG. 175  
PARCEL NO. 10-0396.000  
63 ACRES

EXEMPT  
(36)  
STATE OF OHIO  
DEPARTMENT OF TRANSPORTATION  
STATE ROUTE 139  
DEED VOLUME 999 PG. 175  
PARCEL NO. 07-0477.000  
80 ACRES

- PROPERTY LEGEND**
- = LAND LOCKED PARCEL
  - = TO BE REMOVED
  - = EXISTING ROAD RIGHT-OF-WAY TO BE ABANDONED
  - = PROPERTY WITH R/W INVOLVEMENT
  - = ADJOINING PROPERTIES
  - = TRUE POINT OF BEGINNING

CR 28 C-1  
P.C.=6+98.11  
P.T.=9+67.22  
R=4583.66  
Δ=3° 21' 50"  
L=269.11  
Ch BRG=N 55° 55' 22" E  
Ch DIST=269.07


CR 28 C-2  
P.C.=13+32.00  
P.T.=17+51.41  
R=3274.04  
Δ=7° 20' 23"  
L=419.41  
Ch BRG=N 61° 16' 28" E  
Ch DIST=419.13

EX. R/W C-3  
R=2834.79'  
Δ=3° 10' 0"  
L=195.78'  
Ch BRG=S 55° 34' 39" W  
Ch DIST=156.66'

CURVE DATA  
R=2794.79'  
Δ=0° 31' 48"  
L=195.78'  
C.B.=N 64° 45' 16" E  
C.Q.=25.86'

REV. BY	DATE	DESCRIPTION

J:\TS\07\07-320\_SCI-823\SCIN19415\row\sheets\19415R0018.dgn 1/18/2010 8:25:58 AM srlindgren ODOT\_MS\_PDF\_FULL.plt ODOT\_MS\_PENTABLE\_Full\_M-E.tbl M-E Companies, Inc.

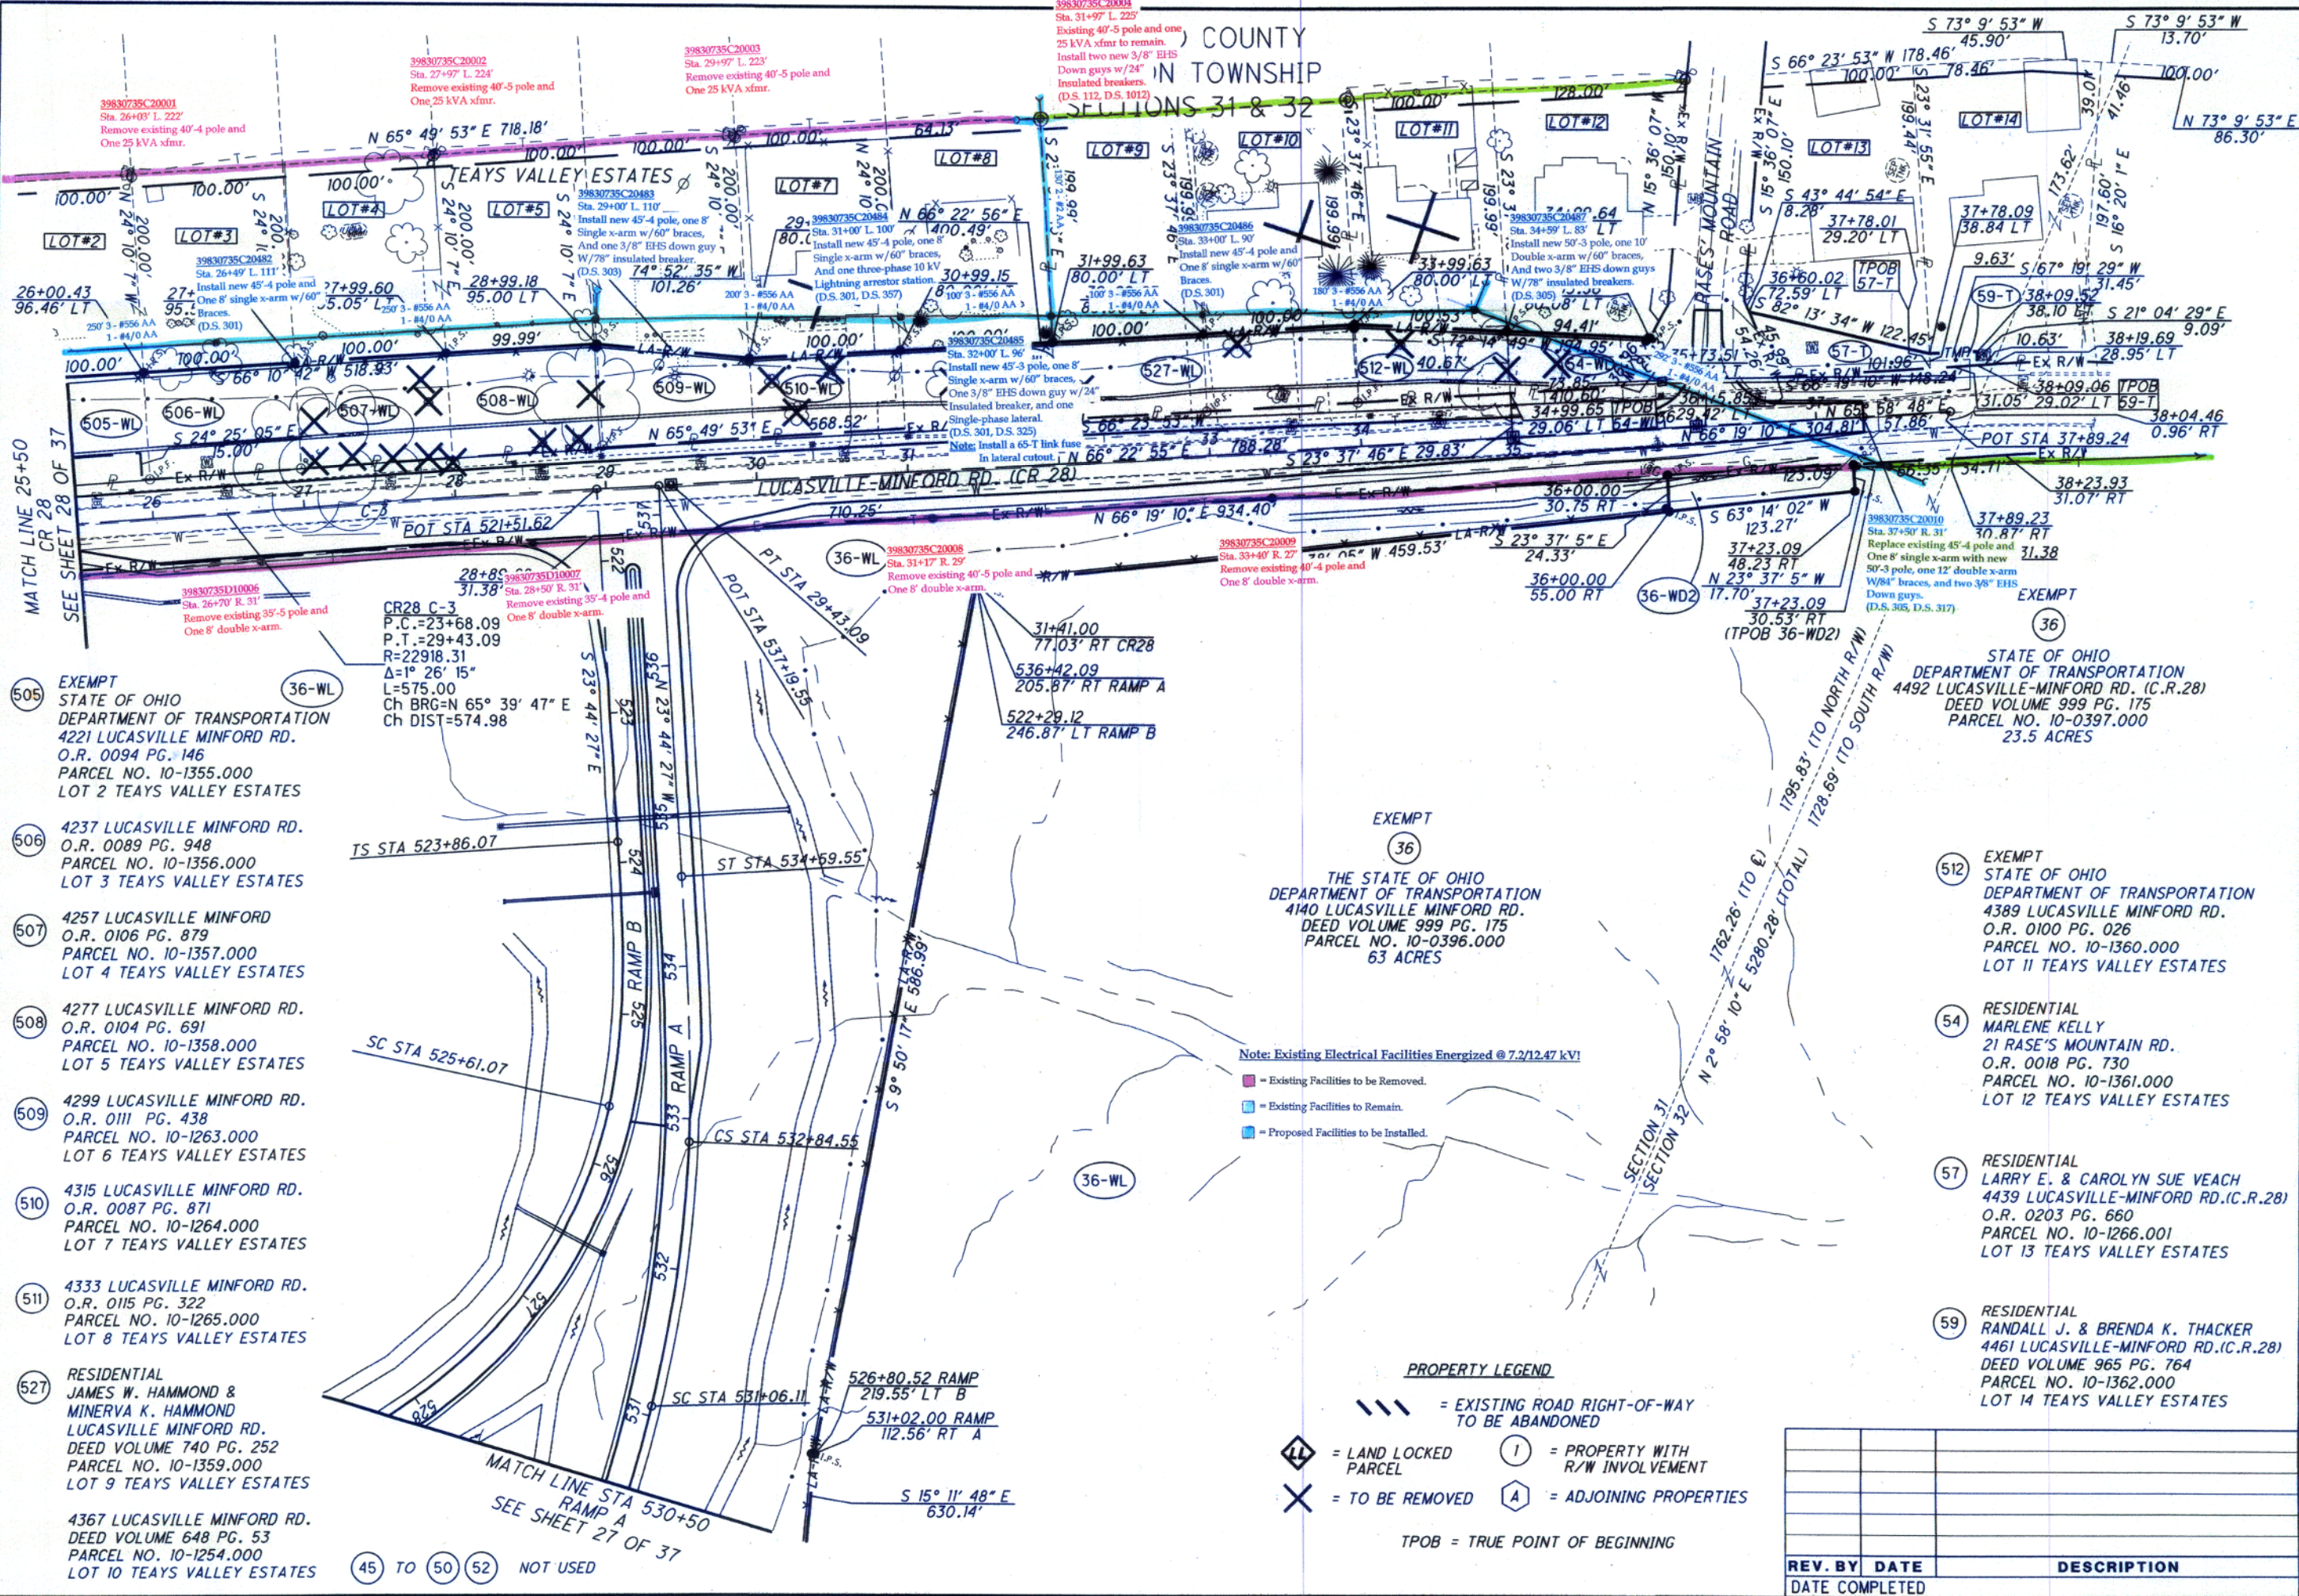

- (505) EXEMPT STATE OF OHIO DEPARTMENT OF TRANSPORTATION 4221 LUCASVILLE MINFORD RD. O.R. 0094 PG. 146 PARCEL NO. 10-1355.000 LOT 2 TEAYS VALLEY ESTATES
- (506) 4237 LUCASVILLE MINFORD RD. O.R. 0089 PG. 948 PARCEL NO. 10-1356.000 LOT 3 TEAYS VALLEY ESTATES
- (507) 4257 LUCASVILLE MINFORD O.R. 0106 PG. 879 PARCEL NO. 10-1357.000 LOT 4 TEAYS VALLEY ESTATES
- (508) 4277 LUCASVILLE MINFORD RD. O.R. 0104 PG. 691 PARCEL NO. 10-1358.000 LOT 5 TEAYS VALLEY ESTATES
- (509) 4299 LUCASVILLE MINFORD RD. O.R. 0111 PG. 438 PARCEL NO. 10-1263.000 LOT 6 TEAYS VALLEY ESTATES
- (510) 4315 LUCASVILLE MINFORD RD. O.R. 0087 PG. 871 PARCEL NO. 10-1264.000 LOT 7 TEAYS VALLEY ESTATES
- (511) 4333 LUCASVILLE MINFORD RD. O.R. 0115 PG. 322 PARCEL NO. 10-1265.000 LOT 8 TEAYS VALLEY ESTATES
- (527) RESIDENTIAL JAMES W. HAMMOND & MINERVA K. HAMMOND LUCASVILLE MINFORD RD. DEED VOLUME 740 PG. 252 PARCEL NO. 10-1359.000 LOT 9 TEAYS VALLEY ESTATES
- 4367 LUCASVILLE MINFORD RD. DEED VOLUME 648 PG. 53 PARCEL NO. 10-1254.000 LOT 10 TEAYS VALLEY ESTATES

(45) TO (50) (52) NOT USED

Note: Existing Electrical Facilities Energized @ 7.2/12.47 kV!

- Existing Facilities to be Removed.
- Existing Facilities to Remain.
- Proposed Facilities to be Installed.

**PROPERTY LEGEND**

- ▬▬▬ = EXISTING ROAD RIGHT-OF-WAY TO BE ABANDONED
- ⊞ = LAND LOCKED PARCEL
- ⊞ = TO BE REMOVED
- Ⓜ = PROPERTY WITH R/W INVOLVEMENT
- Ⓜ = ADJOINING PROPERTIES

TPOB = TRUE POINT OF BEGINNING

REV. BY	DATE	DESCRIPTION


**RIGHT OF WAY DETAIL PLAN**  
**RAMP A STA. 529+00 TO CR 28**

PID NO. **19415**

R/W DESIGNER: R/JY  
R/W REVIEWER: S/R

SCI-823-6.81

32 / 37



J:\TS\07-320\_SCI-823\SC19415\row\sheet\19415RD019.dgn 1/18/2010 8:26:00 AM srlindgren ODOT\_MS\_PDF\_FULL.pit ODOT\_MS\_PDF\_PENTABLE\_Full\_M-E.tbi M-E Companies, Inc.

SCIOTO COUNTY  
HARRISON TOWNSHIP  
SECTION 9

NOTE: ALTHOUGH PARCEL 07-0893.002 IS NOT CONTIGUOUS WITH 07-0893.003, IT IS SHOWN AS SUCH DUE TO THE POSSIBILITY OF EXISTING FIELD DRIVES/LOGGING ROADS BEING PERCEIVED AS A PRESCRIPTIVE EASEMENT FOR INGRESS EGRESS

- PROPERTY LEGEND**
- = LAND LOCKED PARCEL
  - = TO BE REMOVED
  - = EXISTING ROAD RIGHT-OF-WAY TO BE ABANDONED
  - = PROPERTY WITH R/W INVOLVEMENT
  - = ADJOINING PROPERTIES
  - TPOB = TRUE POINT OF BEGINNING



PID NO. 19415


R/W DESIGNER R/JY  
R/W REVIEWER S/R

RIGHT OF WAY DETAIL PLAN  
TR 234 STA 10+00 TO STA 23+00

SCI-823-6.81

33 / 37

NOV 23 2010

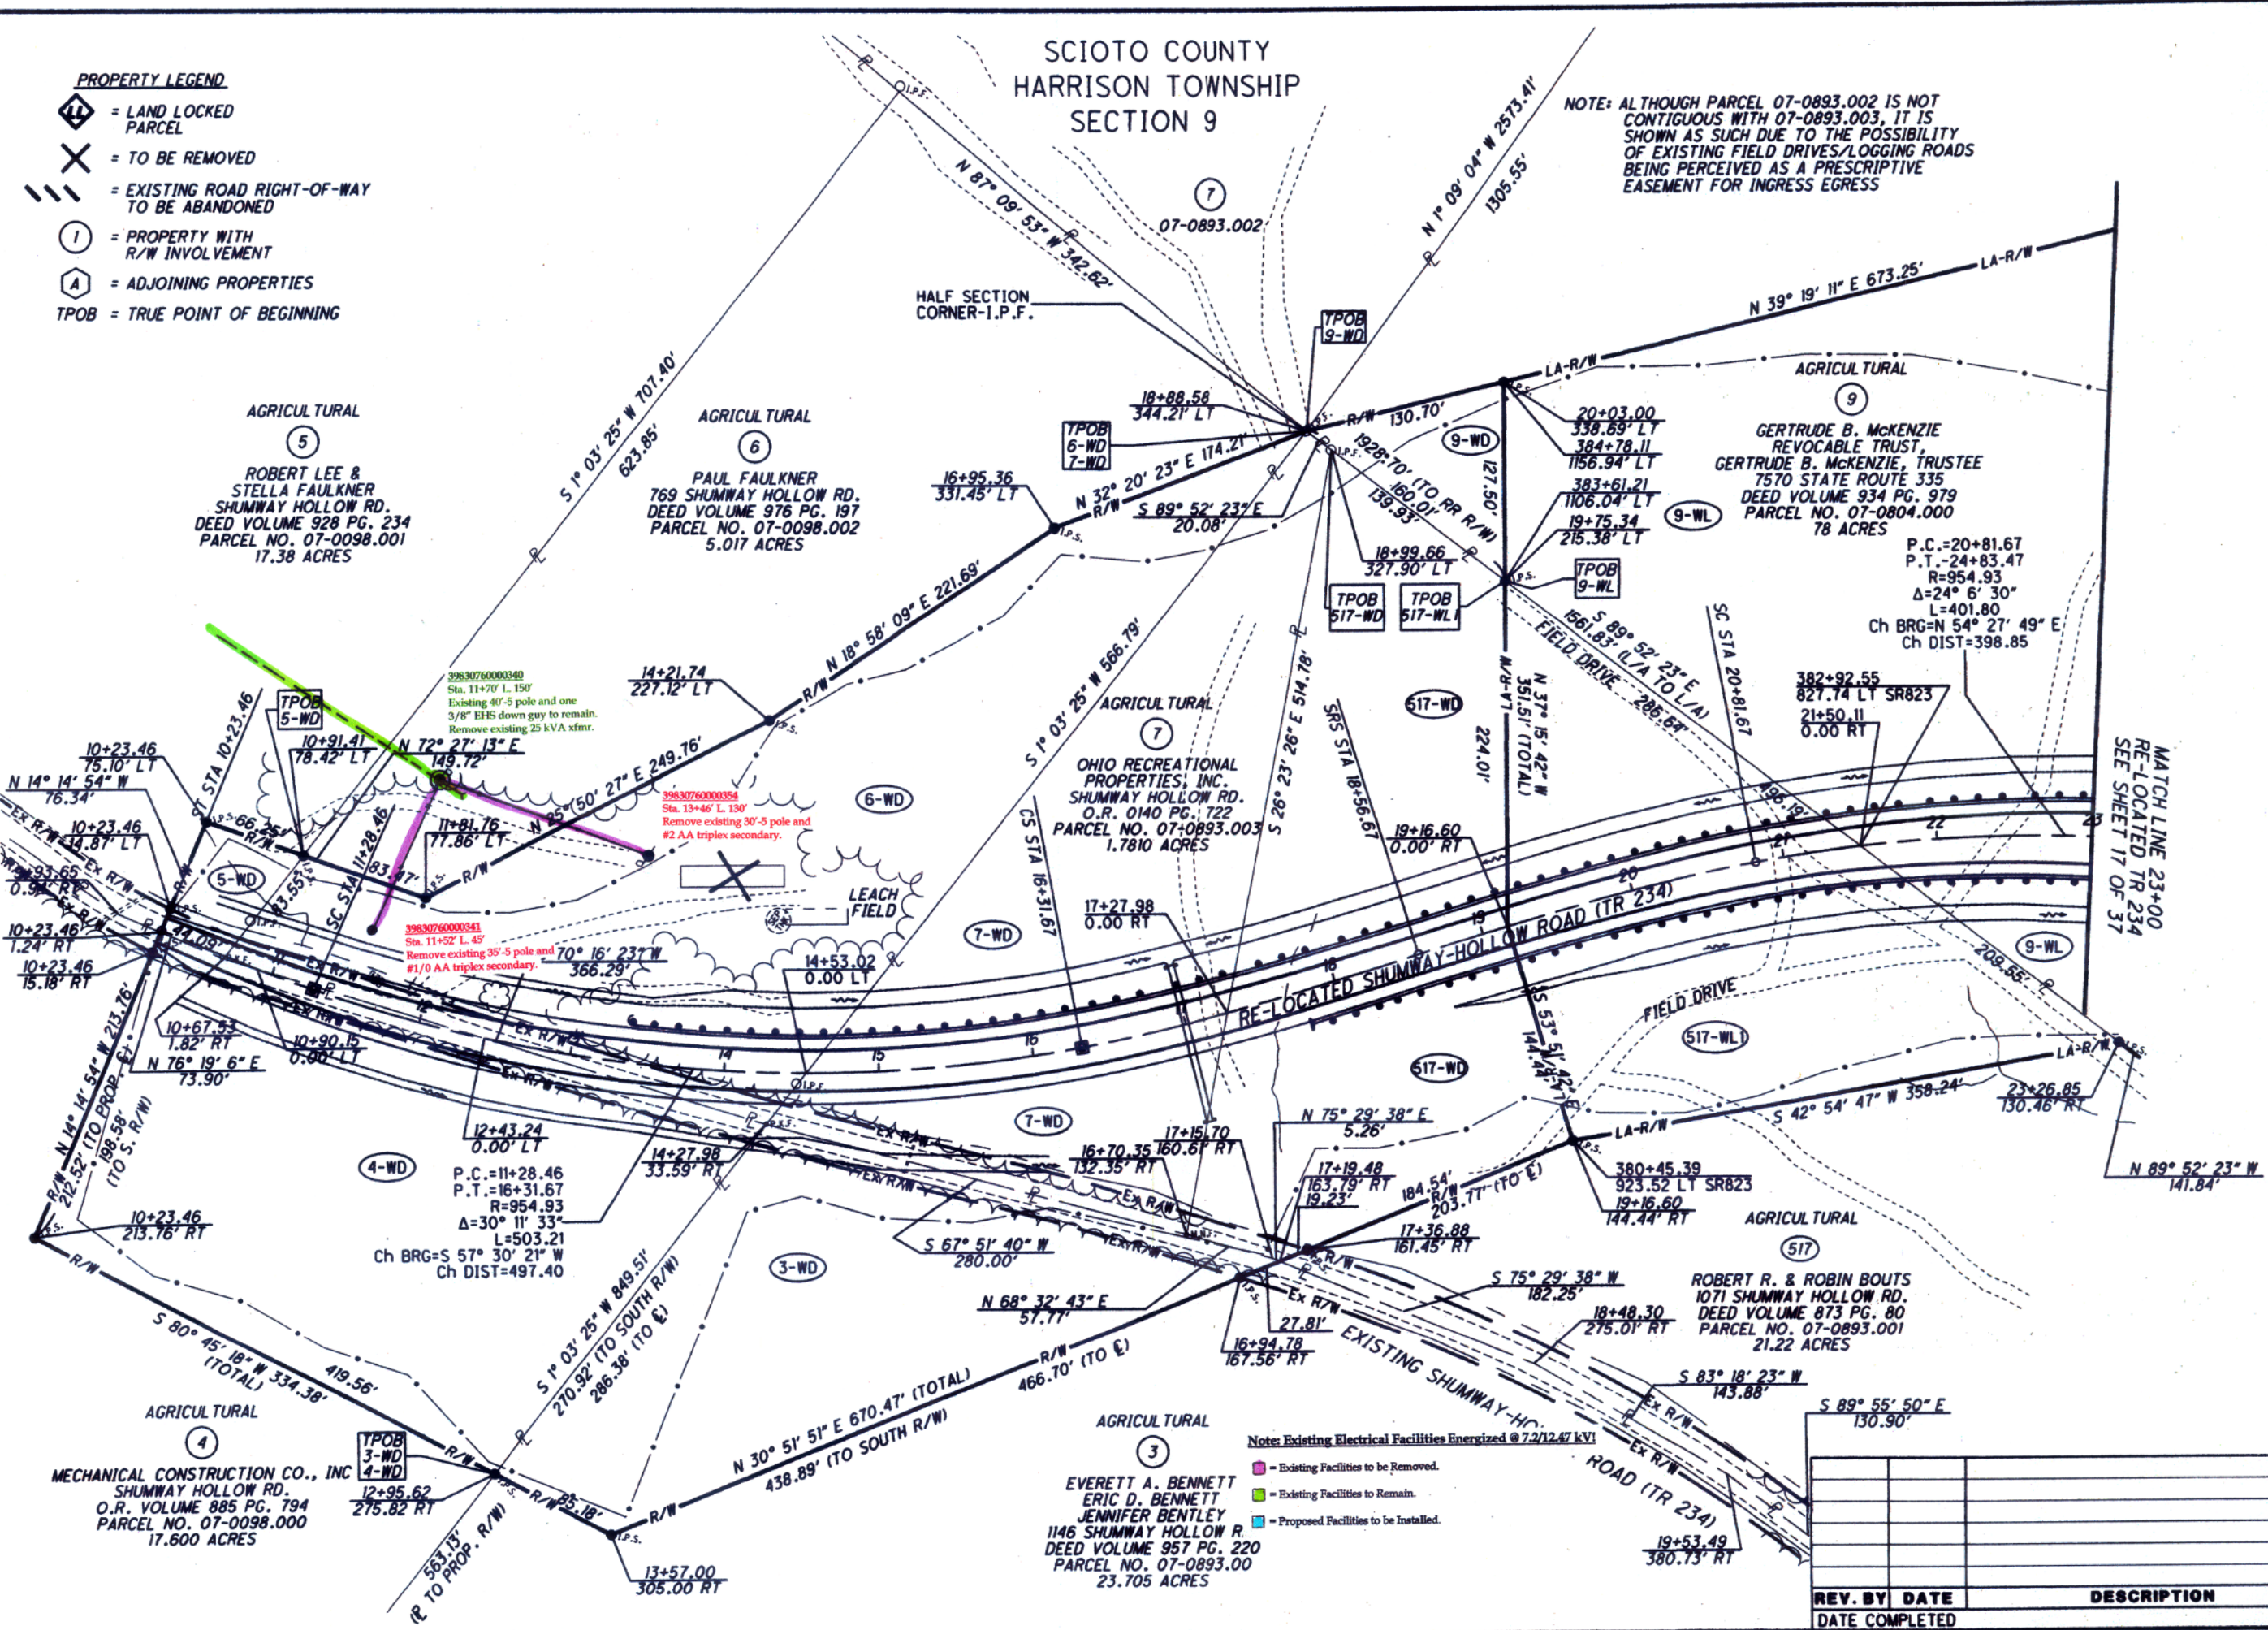

- Notes: Existing Electrical Facilities Energized @ 7.2/12.47 kV
- Existing Facilities to be Removed.
  - Existing Facilities to Remain.
  - Proposed Facilities to be Installed.

REV. BY	DATE	DESCRIPTION

J:\TS\07\07-320 SCI-823\SC19415\row\sheet\19415RD020.dgn 1/18/2010 8:26:02 AM srindgren ODOT\_MS\_PDF\_FULL.plt ODOT\_MS\_PENTABLE\_Full\_M-E.tbl M-E Companies, Inc.

### SCIOTO COUNTY HARRISON TOWNSHIP SECTION 9

NOTE: THERE APPEARS TO BE AN OVERLAP OF APPROXIMATELY 20' BETWEEN THE EASTERLY R/W LINE OF THE CSX RAILROAD AND THE WESTERLY R/W LINE OF S.R. 335.

NOTE: FOR A MORE DETAILED LOCATION OF THE EASEMENTS WITHIN THE RAILROAD PROPERTY, SEE THE RAILROAD PLAT ATTACHED HEREIN PAGE 37 OF 37

MATCH LINE 13+00  
STATE ROUTE 335  
SEE SHEET 36 OF 3637

MATCH LINE 7+00  
STATE ROUTE 335  
SEE SHEET 35 OF 37

55 ROADWAY  
BOARD OF COUNTY COMMISSIONERS  
OF SCIOTO COUNTY  
BARKLOW ROAD  
DEED VOLUME 451 PG. 55  
PARCEL NO. 07-2477.000  
1.357 ACRES

68 RESIDENTIAL  
DONNA G. & JACK E. LESTER  
7496 STATE ROUTE 335  
DEED VOLUME 925 PG. 257  
PARCEL NO. 07-0802.000  
0.87 ACRES

517 AGRICULTURAL  
ROBERT R. & ROBIN BOUTS  
1071 SHUMWAY HOLLOW RD.  
DEED VOLUME 873 PG. 80  
PARCEL NO. 07-0893.001  
21.22 ACRES

- 1 N 13° 45' 47" W 155.64'
- 2 N 13° 45' 47" W 69.27'
- 3 N 13° 45' 47" W 20.00'
- 4 N 13° 45' 47" W 49.27'
- 5 S 76° 56' 39" W 79.83'
- 6 S 77° 03' 00" W 31.76'
- 7 N 13° 45' 47" W 86.37'
- 8 S 13° 32' 00" W 600.01'
- 9 S 76° 51' 00" W 40.85'
- 10 S 76° 51' 00" W 31.38'
- 11 N 13° 35' 46" W 70.84'
- 12 N 13° 57' 15" W 3010.46' (EXIST. RR R/W)
- 13 N 76° 51' 00" E 31.56'
- 14 S 13° 35' 46" E 69.16'
- 15 N 13° 57' 15" W 110.99' (EXIST. RR R/W)

- 51 38+89.55 29.82' RT TR234
- 52 9+70.15 45.00' RT SR335
- 53 39+30.00 30.05' LT TR234
- 54 10+29.72 85.85' RT SR335
- 55 38+89.52 30.18' LT TR234
- 56 10+30.16 45.00' RT SR335
- 57 38+89.48 100.92' LT TR234
- 58 11+00.89 45.00' RT SR335
- 59 38+89.56 49.82' LT TR234
- 60 9+50.15 45.00' RT SR335

Note: Existing Electrical Facilities Energized @ 7.2/12.47 kV!

- Existing Facilities to be Removed.
  - Existing Facilities to Remain.
  - Proposed Facilities to be Installed.
- PROPERTY LEGEND**
- L = LAND LOCKED PARCEL
  - X = TO BE REMOVED
  - = EXISTING ROAD RIGHT-OF-WAY TO BE ABANDONED
  - I = PROPERTY WITH R/W INVOLVEMENT
  - A = ADJOINING PROPERTIES
  - TPOB = TRUE POINT OF BEGINNING

LEACH FIELD TO BE REMOVED BY OTHERS

**SIMPLE CURVE DATA**  
 R=2291.83'  
 P.C.=6+37.50  
 P.T.=8+14.51  
 Δ=4° 25' 32"  
 L=177.02'  
 Ch BRG=N 11° 33' 01" W  
 Ch DIST=176.97'

**RR R/W CURVE DATA C-1**  
 R=5569.65'  
 Δ=2° 0' 50"  
 L=195.78'  
 Ch BRG=N 13° 19' 19" W  
 Ch DIST=195.77'

**RR R/W CURVE DATA C-2**  
 R=5569.65'  
 Δ=0° 30' 18"  
 L=49.08'  
 Ch BRG=S 14° 04' 09" E  
 Ch DIST=49.08'

REV. BY	DATE	DESCRIPTION

HORIZONTAL SCALE IN FEET

PID NO. **19415**

R/W DESIGNER: R/JY  
R/W REVIEWER: SRL

**RIGHT OF WAY DETAIL PLAN**  
TR 234 STA 32+00 TO STA 41+00

**SCI-823-6.81**



34 / 37

NOV 23 2010

J:\TS\07-320\_SCI-823\SC19415\row\sheet\19415RD021.dgn 1/18/2010 8:26:04 AM srlindgren ODOT\_MS\_PDF\_FULL.plt ODOT\_MS\_PENTABLE\_Full\_M-E.tbl M-E Companies, Inc.

NOTE: THERE APPEARS TO BE AN OVERLAP OF APPROXIMATELY 20' BETWEEN THE EASTERLY R/W LINE OF THE CSX RAILROAD AND THE WESTERLY R/W LINE OF S.R. 335.

SCIOTO COUNTY  
HARRISON TOWNSHIP  
SECTION 9

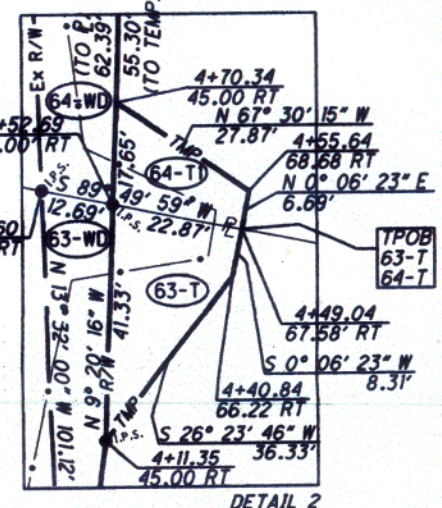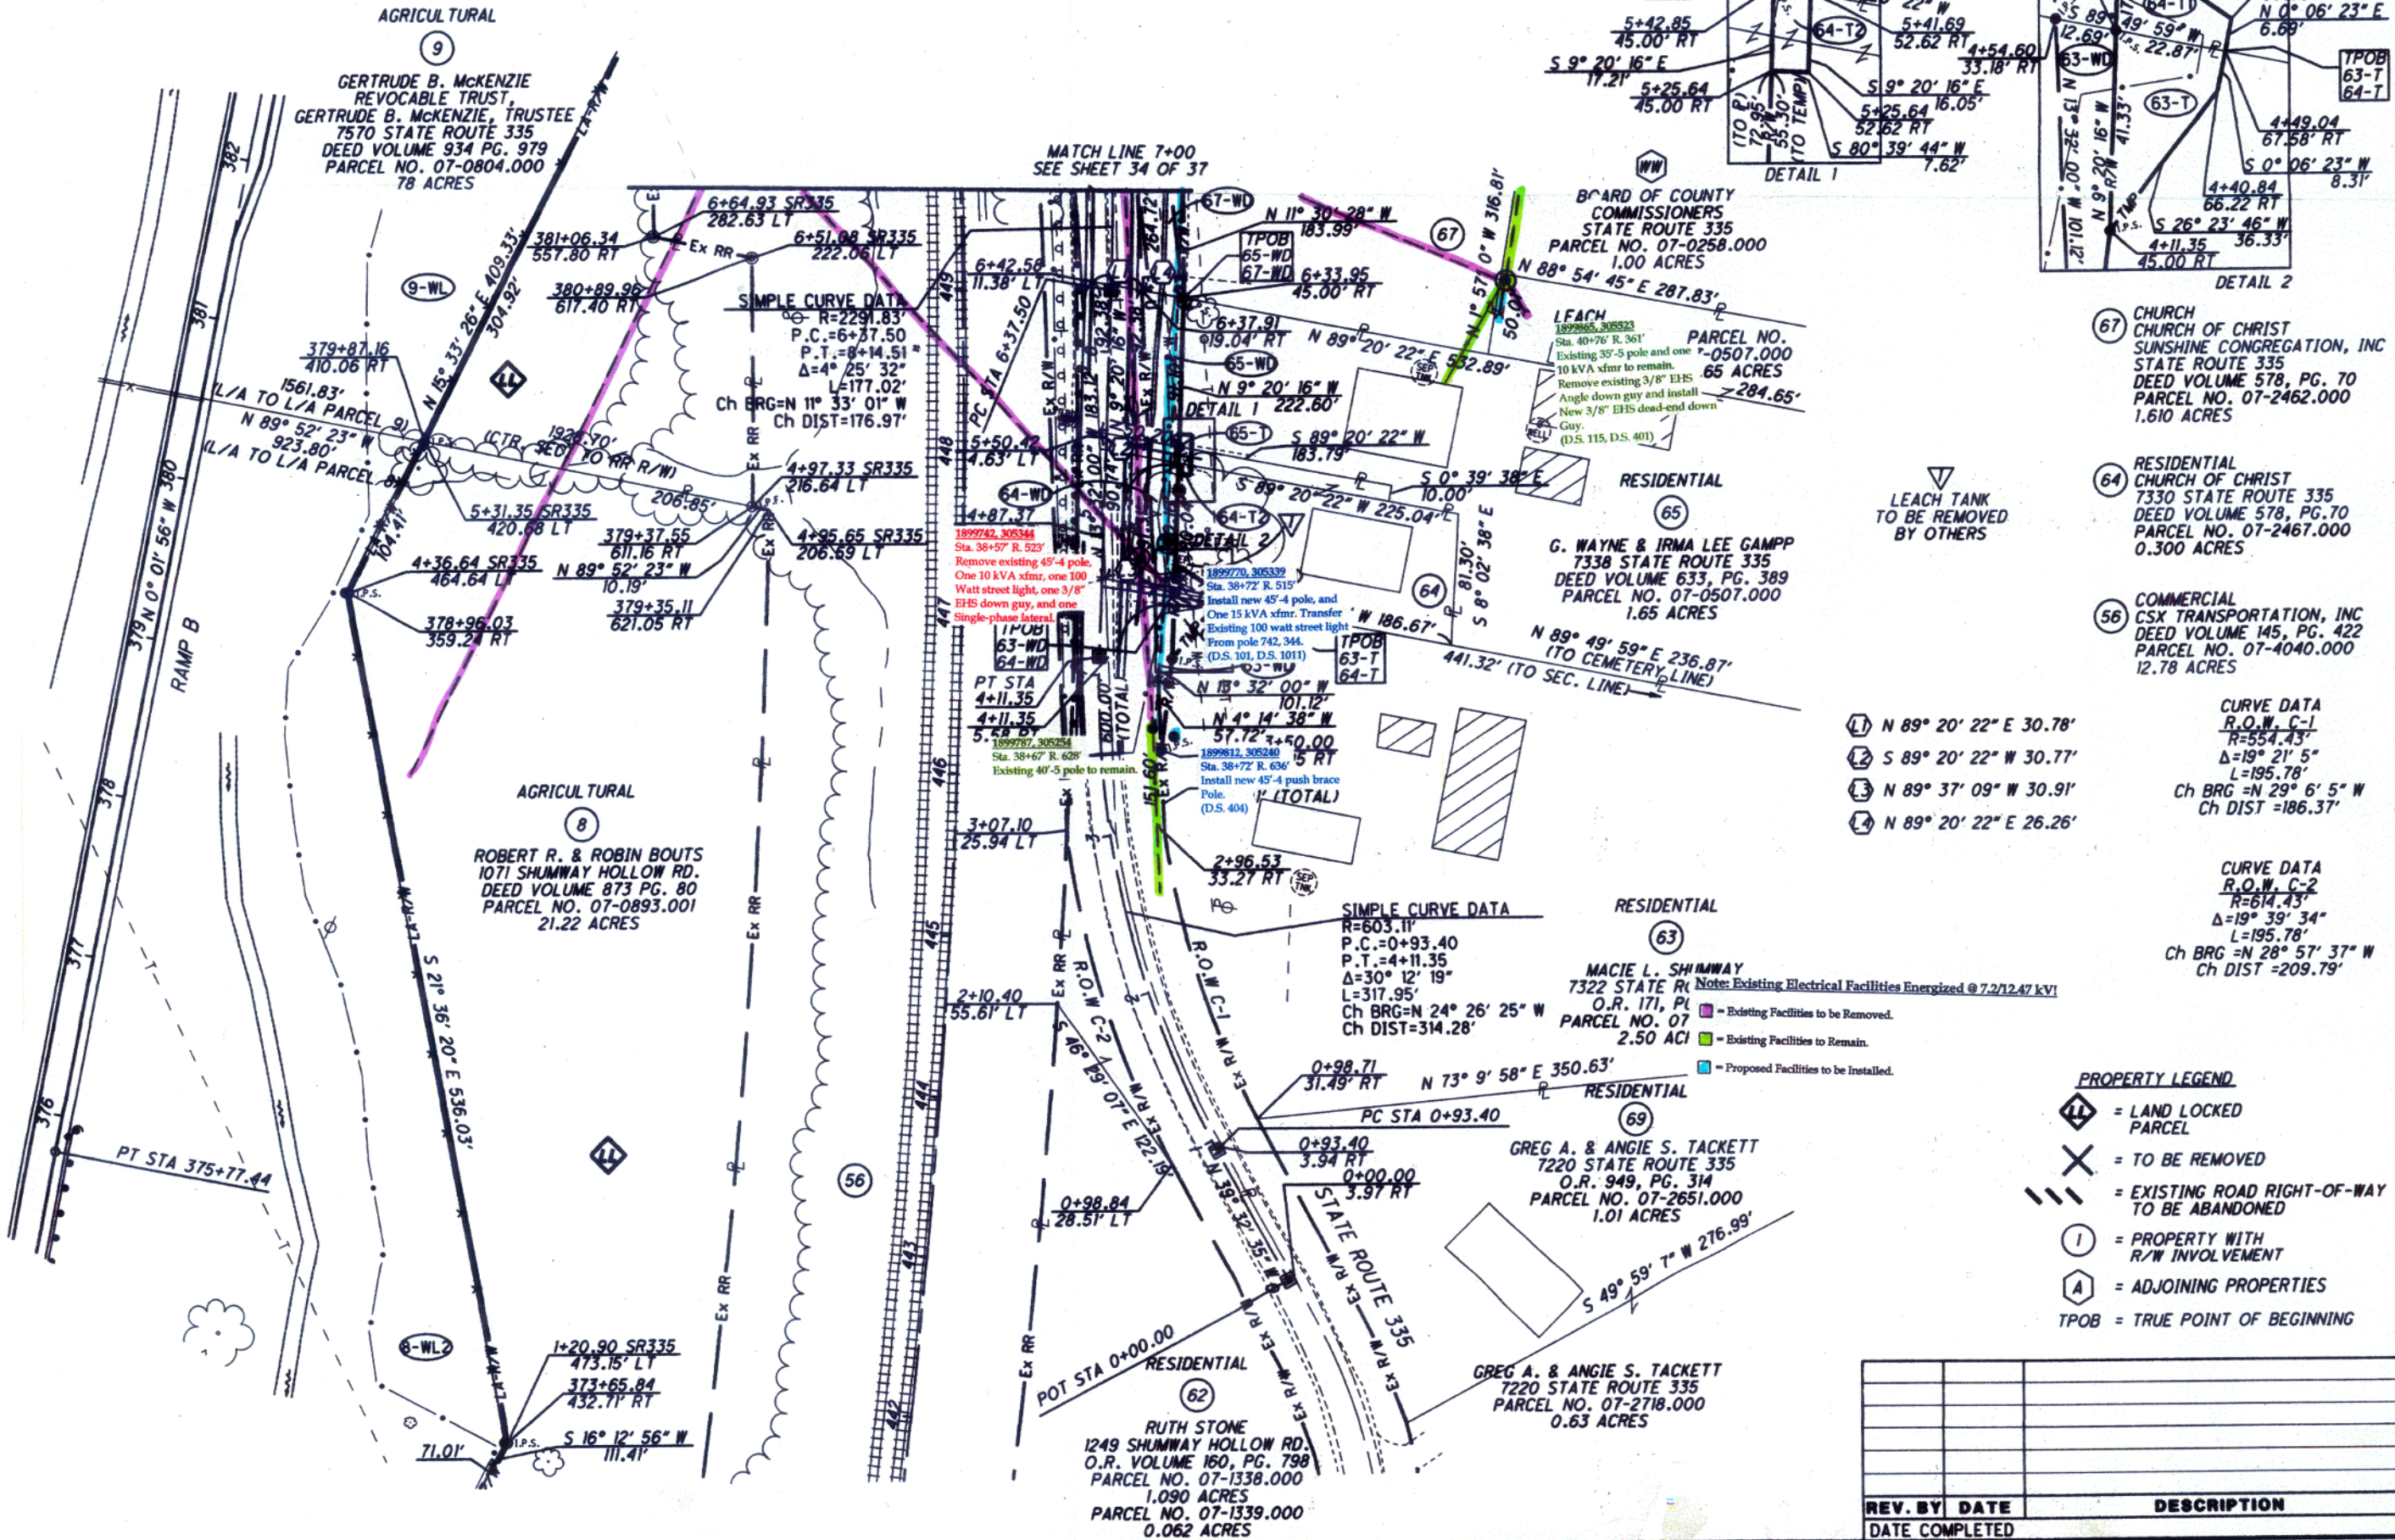

- 67 CHURCH OF CHRIST SUNSHINE CONGREGATION, INC STATE ROUTE 335 DEED VOLUME 578, PG. 70 PARCEL NO. 07-2462.000 1.610 ACRES
- 64 RESIDENTIAL CHURCH OF CHRIST 7330 STATE ROUTE 335 DEED VOLUME 578, PG. 70 PARCEL NO. 07-2467.000 0.300 ACRES
- 66 COMMERCIAL CSX TRANSPORTATION, INC DEED VOLUME 145, PG. 422 PARCEL NO. 07-4040.000 12.78 ACRES

- 1 N 89° 20' 22" E 30.78'
- 2 S 89° 20' 22" W 30.77'
- 3 N 89° 37' 09" W 30.91'
- 4 N 89° 20' 22" E 26.26'

CURVE DATA  
R.O.W. C-1  
R=554.43'  
Δ=19° 21' 5"  
L=195.78'  
Ch BRG = N 29° 6' 5" W  
Ch DIST = 186.37'

CURVE DATA  
R.O.W. C-2  
R=614.43'  
Δ=19° 39' 34"  
L=195.78'  
Ch BRG = N 28° 57' 37" W  
Ch DIST = 209.79'

LEACH TANK TO BE REMOVED BY OTHERS

- PROPERTY LEGEND
- = LAND LOCKED PARCEL
  - = TO BE REMOVED
  - = EXISTING ROAD RIGHT-OF-WAY TO BE ABANDONED
  - = PROPERTY WITH R/W INVOLVEMENT
  - = ADJOINING PROPERTIES
  - TPOB = TRUE POINT OF BEGINNING

REV. BY	DATE	DESCRIPTION

RIGHT OF WAY DETAIL PLAN  
SR 335 STA. 0+00 TO STA. 7+00

SCI-823-6.81





35 / 37

NOV 23 2010

J:\TS\07-07-320 SCI-823\SCIN19415\row\sheet\19415RD022.dgn 1/18/2010 8:26:06 AM srlindgren ODOT\_MS\_PDF\_FULL.plt ODOT\_MS\_PENTABLE\_Full\_M-E.tbl M-E Companies, Inc.

SCIOTO COUNTY  
HARRISON TOWNSHIP  
SECTION 9

68 RESIDENTIAL  
DONNA G. & JACK E. LESTER  
7496 STATE ROUTE 335  
DEED VOLUME 925, PG. 257  
PARCEL NO. 07-0802.000  
0.87 ACRES

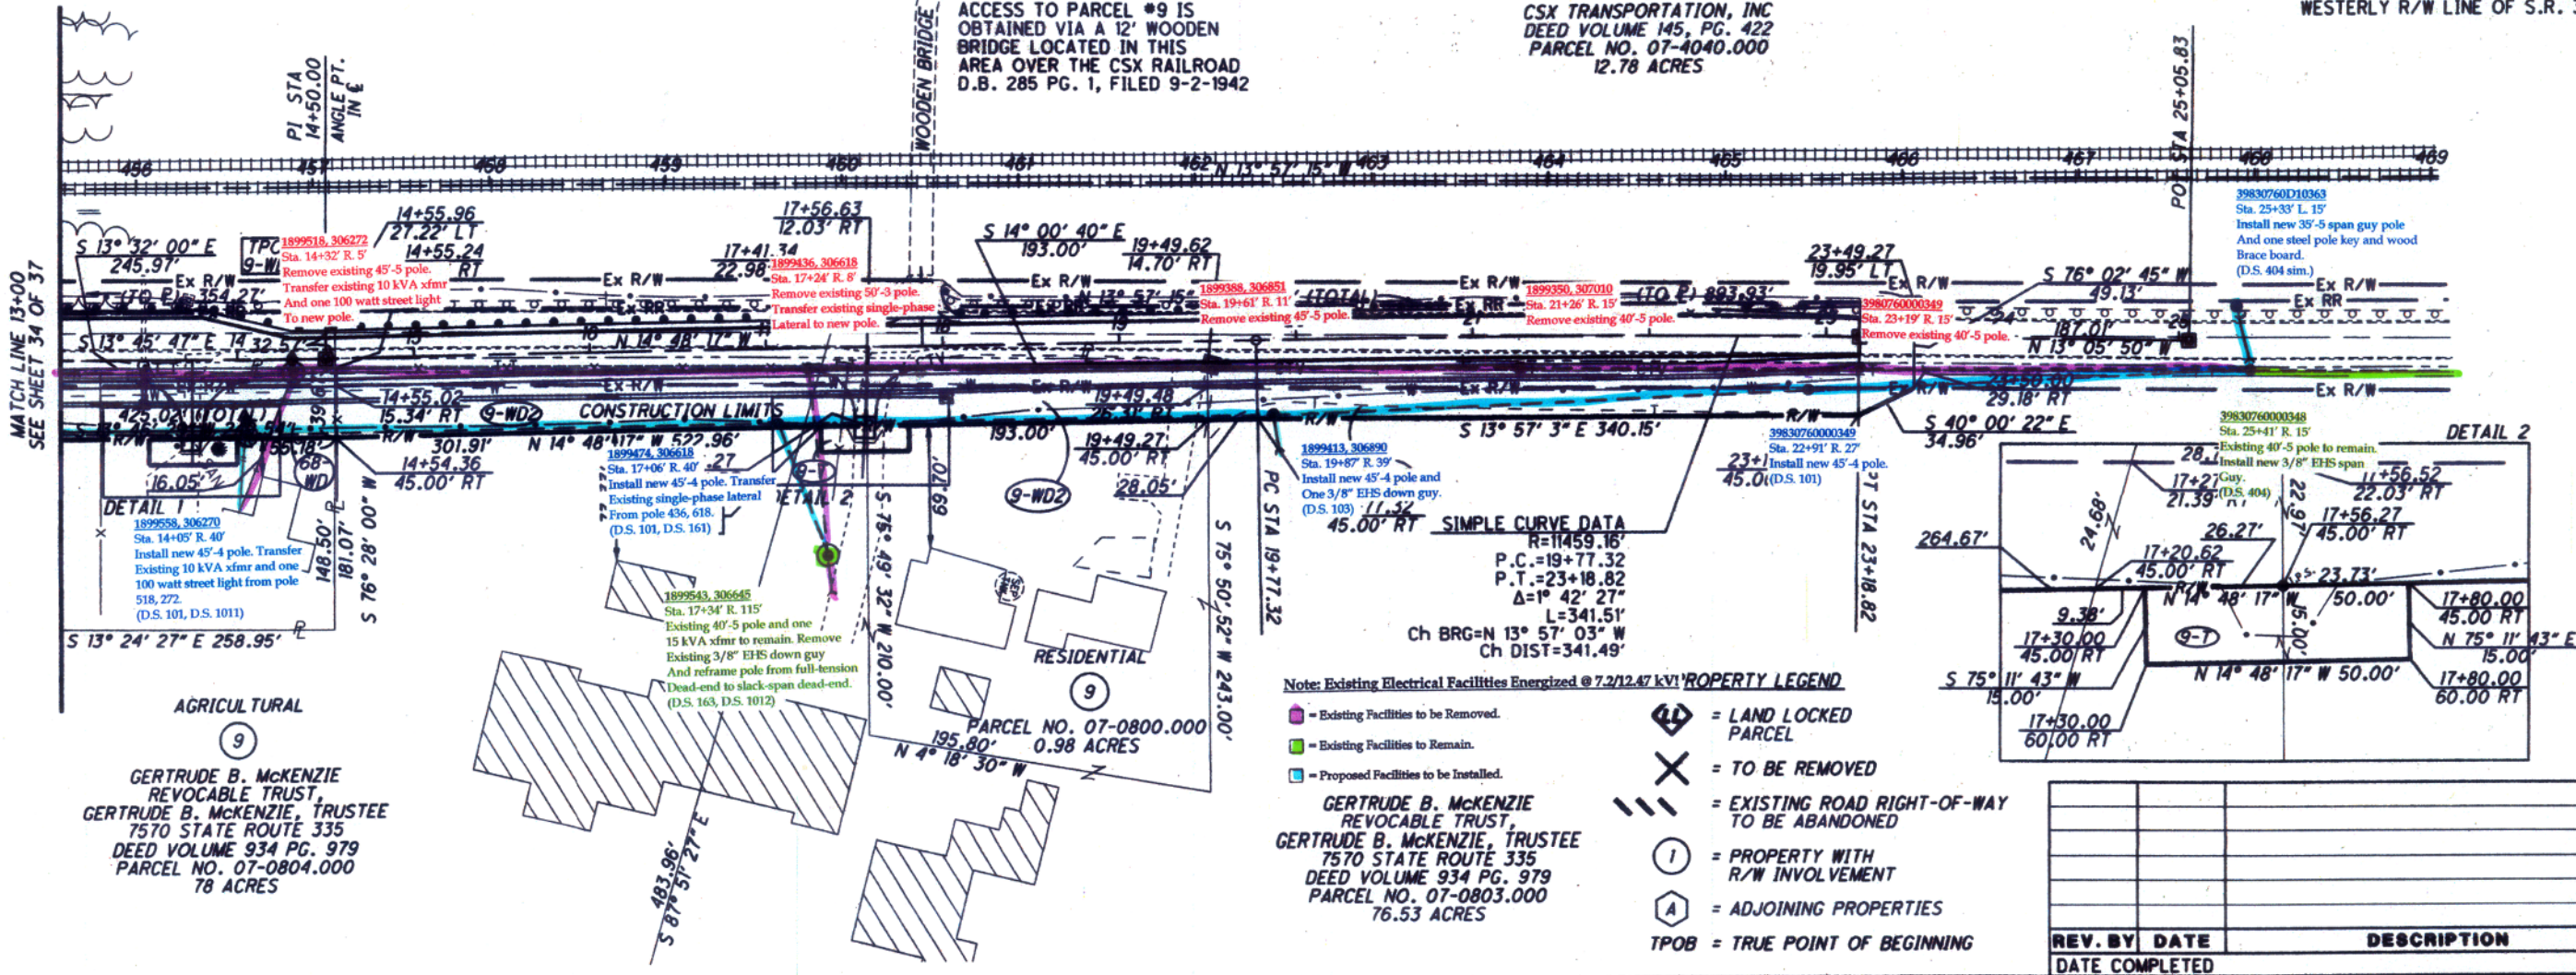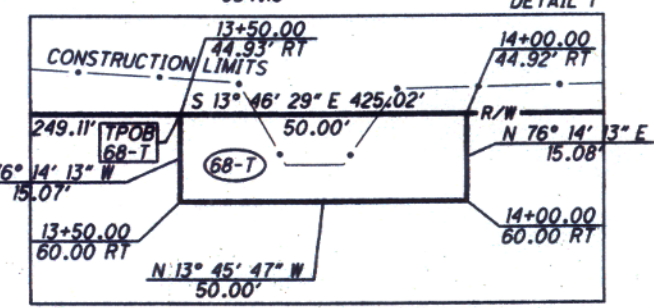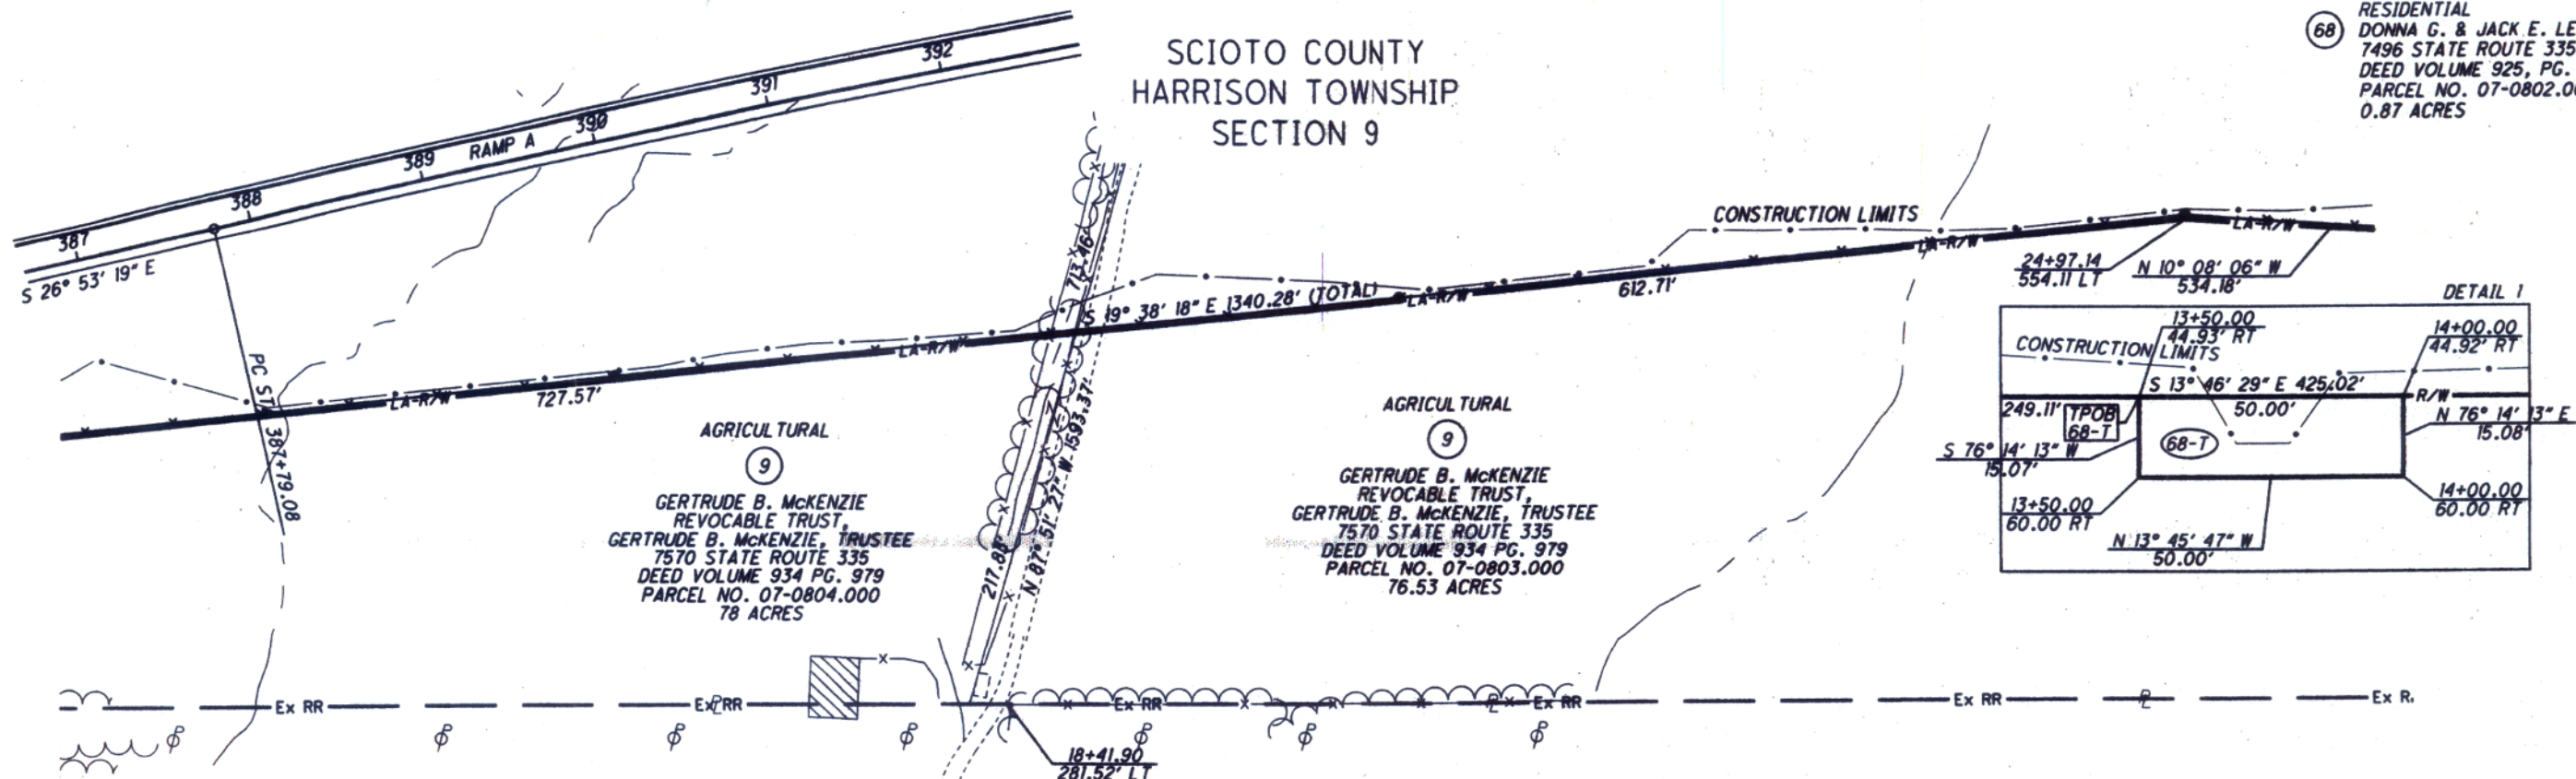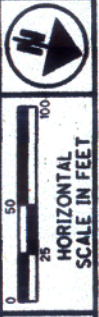

MATCH LINE 13+00  
SEE SHEET 34 OF 37

NOTE: THERE APPEARS TO BE AN OVERLAP OF APPROXIMATELY 20' BETWEEN THE EASTERLY R/W LINE OF THE CSX RAILROAD AND THE WESTERLY R/W LINE OF S.R. 335.

PID NO.  
19415

R/W DESIGNER  
R/JY  
R/W REVIEWER  
S/R

RIGHT OF WAY DETAIL PLAN  
SR335 STA 14+00 TO STA 25+05.83

SCI-823-6.81

36 / 37

NOV 23 2010