

REF NO.	SHEET NO.	STATION TO STATION			202 CURB REMOVED	204 SUBGRADE COMPACTION	304 AGGREGATE BASE (T = 6")	305 9" CONCRETE BASE, CLASS QC1, AS PER PLAN	609 CURB, TYPE 4-A	609 CURB, MISC.: TYPE 4-A RETROFIT	609 CURB, TYPE 4-C, AS PER PLAN
			TO		FT	SY	CY	SY	FT	FT	FT
C1	41	333+47		333+75		8.30	1.40	6.20	18		
C2	42	355+74		356+02		8.30	1.40	6.20	18		
C3	43	368+78		369+08	30					26	4
C4	43	368+84		369+08	26					22	4
C5	43	368+85		369+09	26					22	4
C6	43	368+78		369+09	30					26	4
C7	44	370+92		371+71	78					74	4
C8	44	370+92		371+17	26					22	4
C9	44	370+92		371+17	26					22	4
C10	44	370+92		371+71	79					75	4
C11	45	384+68		384+96		8.30	1.40	6.20	18		
C12	47	421+65		426+66	501					497	4
C13	47	426+43		426+70	27					23	4
C14	47	426+47		426+73	26					22	4
C15	47	426+16		426+77	61					57	4
C16	47	429+33		437+35	802					794	8
C17	47	429+36		429+63	26					22	4
C18	47	429+39		429+66	26					22	4
C19	47	429+43		437+35	791					783	8
C20	47	437+15		437+35	20					16	4
C21	47	437+15		437+35	20					16	4
C22	47	439+26		439+56	4	7.00	1.20	5.10	14		4
C23	47	439+26		439+53	26					22	4
C24	47	439+26		439+51	25					21	4
C25	49	460+38		461+02	64					60	4
C26	49	460+86		461+12	26					22	4
C27	49	460+94		461+21	27					23	4
C28	49	460+39		461+30	92					88	4
C29	49	462+92		463+15		8.30	1.40	6.20	18		
C30	49	463+02		460+25		8.30	1.40	6.20	18		
C31	52	519+97		520+25		8.30	1.40	6.20	18		
TOTALS CARRIED TO THE GENERAL SUMMARY					2885	57	10	43	122	2777	108

REF NO.	SHEET	SLM	DIRECTION (IR-75)	SIDE	611 CATCH BASIN ADJUSTED TO GRADE
					EACH
D-1	47	8.07	SB	LT	1
D-2	47	8.07	NB	RT	1
D-3	47	8.17	SB	LT	1
D-4	47	8.17	NB	RT	1
D-5	47	8.26	SB	LT	1
D-6	47	8.26	NB	RT	1
D-7	47	8.27	SB	LT	1
D-8	47	8.27	NB	RT	1
D-9	47	8.28	SB	LT	1
D-10	47	8.28	NB	RT	1
D-11	49	8.72	SB	LT	1
D-12	49	8.72	NB	RT	1
TOTALS CARRIED TO THE GENERAL SUMMARY					12

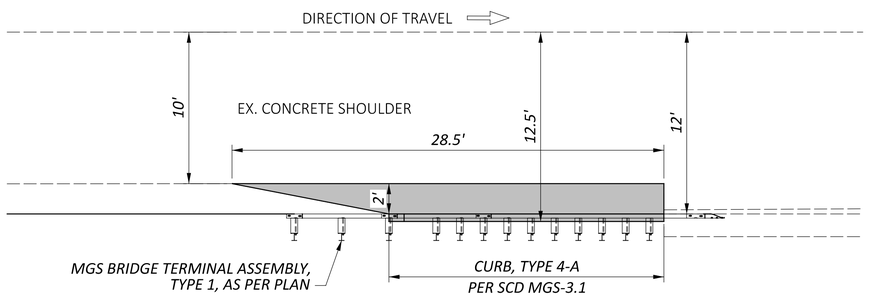

CURB TYPE 4-A @ MGS BRIDGE TERMINAL ASSEMBLY PLAN VIEW DETAIL

2 #3 BAR AT 24" CENTER TO CENTER LONGITUDINALLY (TYP.)

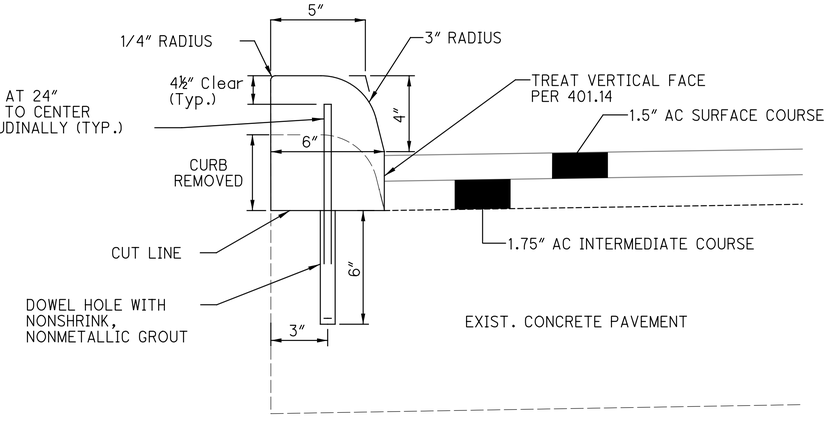

ITEM 609 - CURB, MISC.:
TYPE 4-A RETROFIT DETAIL
(EXISTING/PROPOSED GUARDRAIL NOT SHOWN)

CURB AND DRAINAGE SUBSUMMARIES

DESIGN AGENCY

DESIGNER AMD
REVIEWER LMD 08/05/26
PROJECT ID 116704
SHEET P.35 TOTAL 104

ALL/HAN-75/VAR-5.53/VAR

MODEL: Sheet_Sun/Fl PAPERSIZE: 34x22 (in.) DATE: 11/6/2026 TIME: 2:52:50 PM PLTDRV: OHDOT_PDF.pltcfg PENTBL: OHDOT_Pen.tbl USER: Logan.Davis@dot.ohio.gov WORKSPACE: OHDOTCEv02 WORKSET: 116704 PRODUCT: OpenRoadsDesigner 24.00.00.205
pw:\\ohiodot-pw.bentley.com:ohiodot-pw-02\Documents\01 Active Projects\District 01\Allen\116704\400-Engineering\Roadway\Sheets\116704_GS003.dgn