

ODOT District 4 No Passing Zone Log (ATB)

Page: 1 of 2

Route: 0193R (SATBSR00193**C)

Length: 1.000

Direction: North

From: 27.000 LEAVE TRU CO

To: 28.000 S0531R

Length Left C/L Right Length Control Points Scale: 1.00 mile/page

0.091

28.000

27.909

0.055

27.750

27.695

0.235

27.518

27.283

begin paving
SLM 27.23

C/L

Right

Length

27.959

27.956 ENTERE NORTH KINGSVILLE

27.919 RAILROAD

0.234

27.929

27.695

27.685

0.055

27.630

27.704

27.690 T0356 WRIGHT LT

27.390

27.390 T0442 PRIEST LT

C0443 CREEK RT

0.112

27.395

27.283

27.280 C0022 MAIN RT

27.280 S0084R - END OVERLAP LT

↑ 35mph

↑ 55mph

Sheet total equivalent length of solid line: 0.915

Accum. total: 0.915

© 2017 - MasterMind Systems, Inc. - Traffic Safety Suite

ODOT Dist 4 - Ashtabula County - FINAL No Passing Zone Log (ATB)


Page: 29 of 30

Route: 0193R (SATBSR00193**C)

From: 0.000 LEAVE TRU CO

Length: 29.979 Direction: North

To: 29.979 S0531R

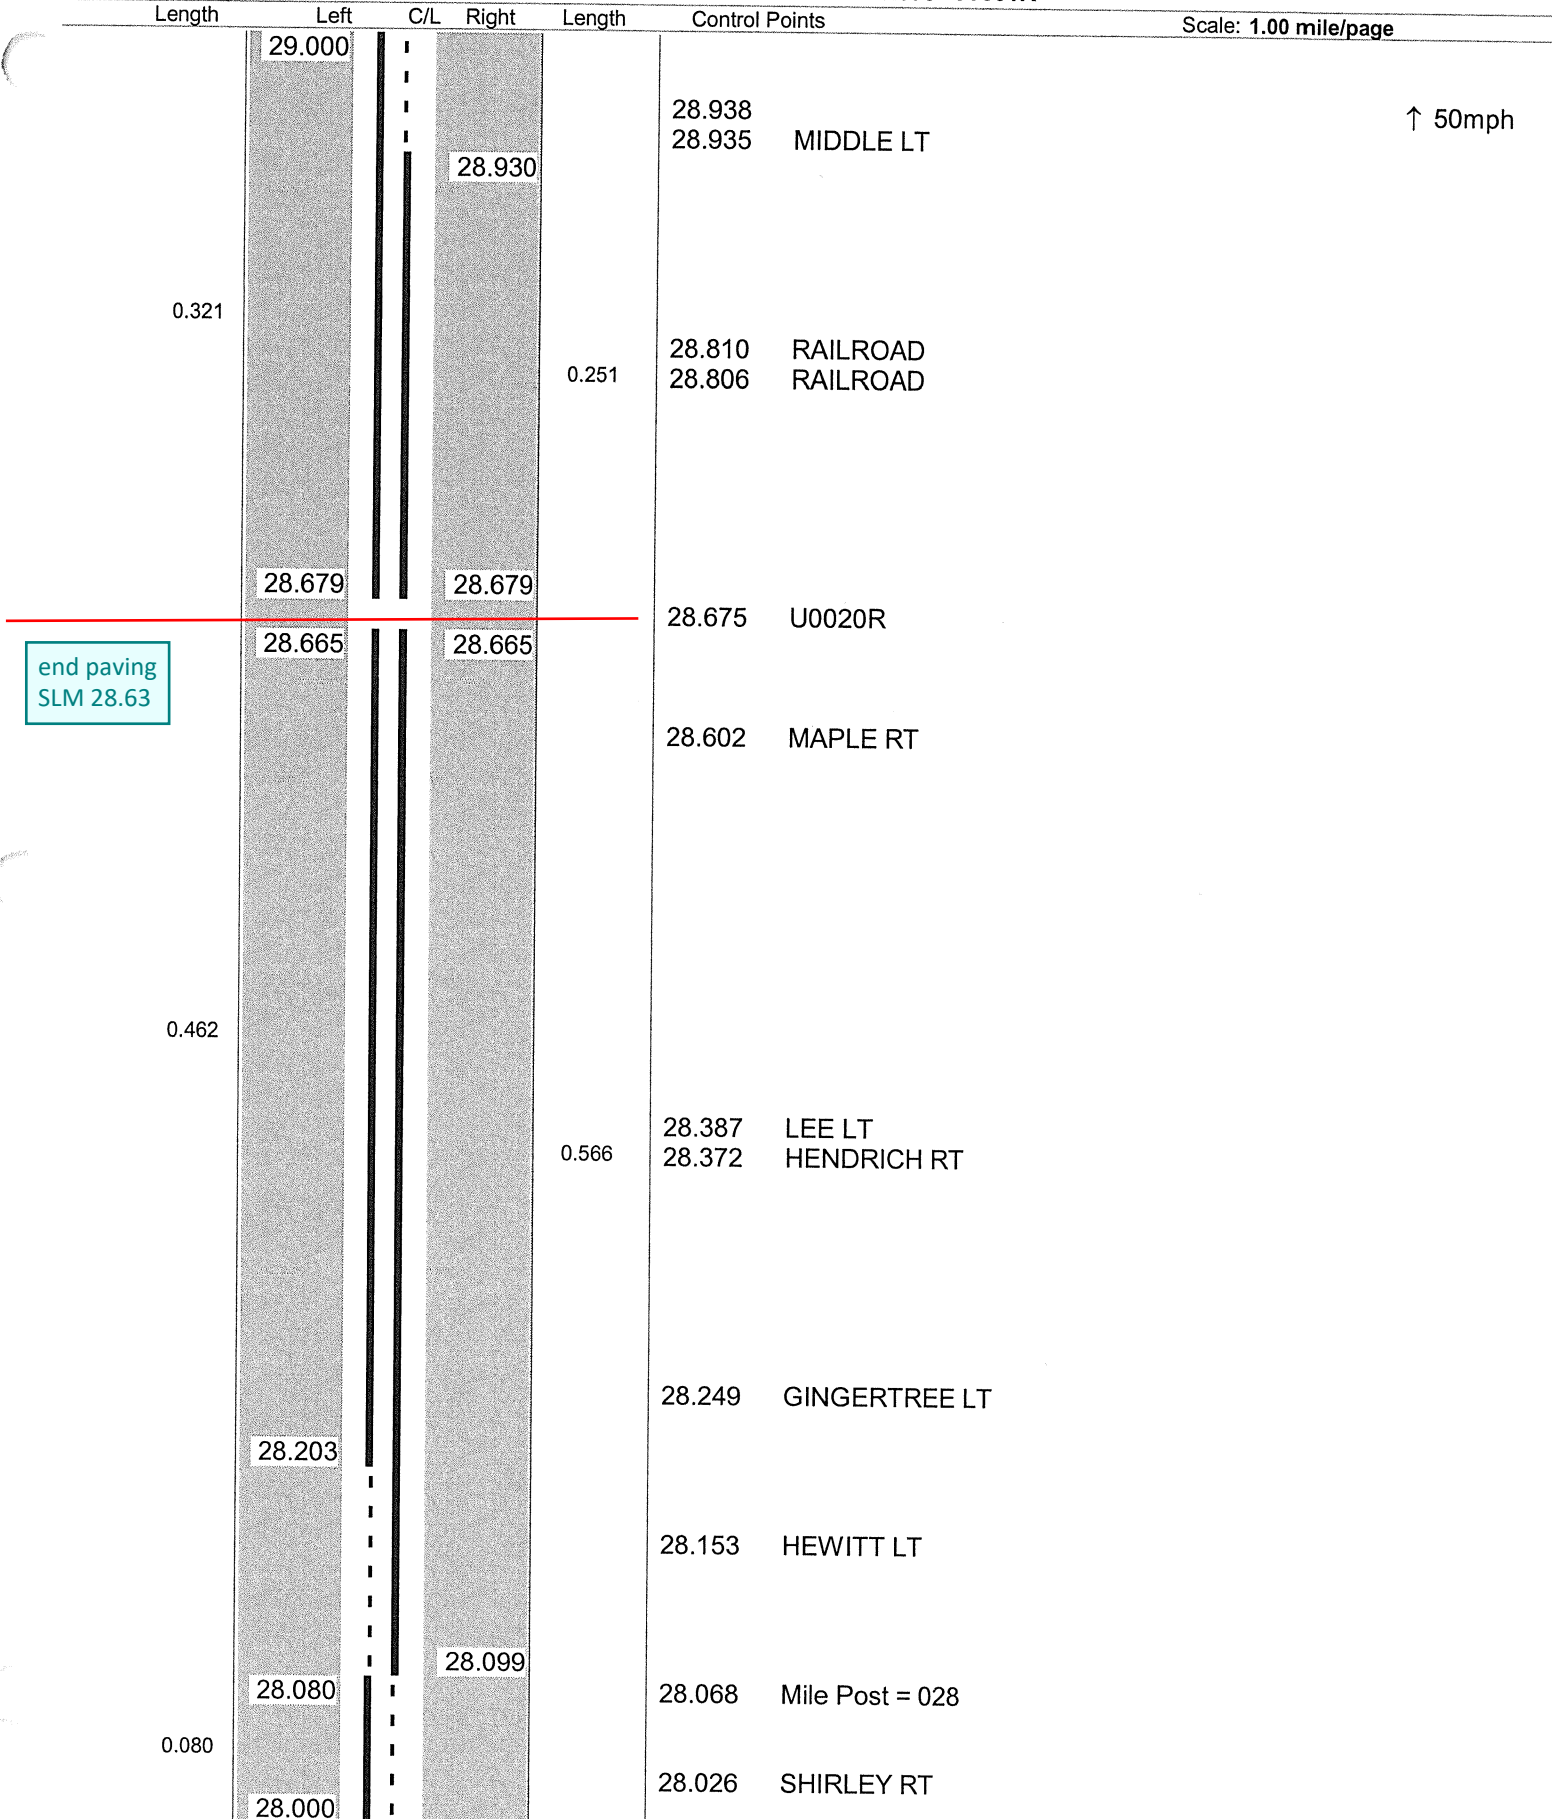

Sheet total equivalent length of solid line: 1.748

Accum. total: 27.338

© 2004 - MasterMind Systems, Inc. - Traffic Safety Suite

1.748-.321-.251-.0175 = 1.159