


LINE	BEARING	DISTANCE
L1	N 83°41'01" E	122.42'
L2	N 51°36'01" E	70.68'
L3	N 89°41'41" E	84.93'
L4	S 78°46'02" E	93.85'
L5	S 67°16'40" E	170.53'
L6	S 76°17'11" E	59.42'
L7	S 83°26'45" E	53.20'
L8	N 84°40'00" E	63.07'
L9	N 78°14'23" E	78.61'
L10	N 57°10'36" E	64.14'
L11	N 62°48'42" E	54.80'
L12	N 73°43'50" E	80.03'
L13	S 05°31'47" W	24.97'

- LEGEND**
- = 5/8" DIA. REBAR IRON PINS SET WITH CAPS STAMPED "JHA INC-KYER 6948"
 - = SOLID IRON PINS FOUND (NO CAPS)
 - ⊙ = 5/8" DIA. IRON PINS FOUND WITH CAPS STAMPED "CLAUS 6456"
 - ⊙ = 5/8" DIA. IRON PINS FOUND WITH CAPS STAMPED "McFARLAND 6221"
 - ⊙ = IRON PIPE FOUND

SOURCES OF DATA USED:
- ALL DEED RECORDS SHOWN HEREON
- VARIOUS PRIOR DEED RECORDS
- TAX & GIS MAPS
- SURVEY MAPS BY R. CLAUS, S. McFARLAND & G. BIEDENBACH

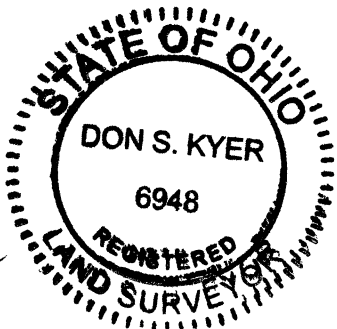

Don S. Kyer 9-17-15
DON S. KYER, P.S. NO. 6948

RETRACEMENT SURVEY FOR
HARRY D. WELLS & LINDA K. WELLS
LOCATED IN THE SE QTR. SECTION 3, T-6, R-4, SMITH TOWNSHIP,
BELMONT COUNTY, OHIO

JHA
Companies
SURVEYORS
ENGINEERS
ENVIRONMENTAL
GIS MAPPING
www.jhacompanies.com

68011 VINEYARD ROAD
ST. CLAIRSVILLE, OH 43950
(740) 695-6100
dkyer@jhacompanies.com

Scale: 1" = 100'
Survey Date: August 2015
Drawn by: cdw
File: 2015-284