

THIS DOCUMENT WAS ORIGINALLY ISSUED BY "JEFFREY A. VAUGHN" on Oct. 29, 2004. THIS DOCUMENT IS NOT CONSIDERED A SEALED DOCUMENT


FOR FORCE MAIN DWG'S SEE 2001 US-40 WEST SEWER FORCE MAIN SHT-17

WASTE WATER LINE 1667.35 FT. / .32 MI. (2-24-23) JGH  
DRAWINGS OF RECORD 10/04

NO.	DATE	REVISION

DRAWN BY:  
DAVID STEWART

CHECKED BY:  
ERNIE BURKY

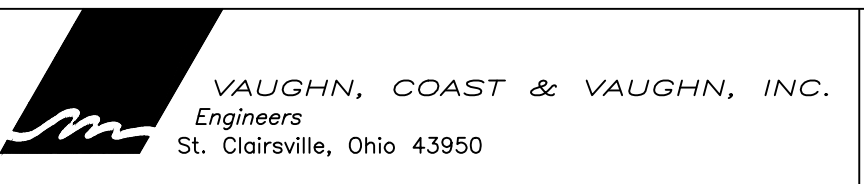

BELMONT COUNTY SANITARY SEWER DISTRICT  
EXIT 208/STATE ROUTE 149 WASTEWATER COLLECTION SYSTEM  
BELMONT COUNTY, OHIO

EXIT 208/STATE ROUTE 149 WASTEWATER COLLECTION SYSTEM  
LINE A (MH-A8 TO MH-A12)  
LINE F

SCALE: 1"=50' (22"x34")  
1"=100' (11"x17")

DATE: AUGUST 2003  
PROJECT NO. 03009

