

I:\ProjectData\CLE\10576_CLE-BikeTrailCulvert-FY21\Design\Drainage\Sheets\10576_GG001.dgn Sheet 5/20/2021 10:36:12 AM mbailey5


| SHEET NUM. | | | | | | | | | | | PART. | ITEM | ITEM | GRAND | UNIT | DESCRIPTION | SEE SHEET NO. | CALCULATED | MLB | CHECKED | TRB |
|-------------------------------|-----|------|----|--|--|--|--|--|--|--|------------|---------|----------|-------|------|-------------|---------------|------------|-----|---------|-----|
| 2 | 3 | 5 | 6 | | | | | | | | 01/STR/C V | | EXT | TOTAL | | | | | | | |
| ROADWAY | | | | | | | | | | | | | | | | | | | | | |
| LS | | | | | | | | | | | LS | 201 | 11001 | LS | | | | | | | 2 |
| | | 10 | | | | | | | | | 10 | 202 | 35100 | 10 | FT | | | | | | |
| | | 110 | | | | | | | | | 110 | 202 | 35200 | 110 | FT | | | | | | |
| | | 179 | | | | | | | | | 179 | SPECIAL | 20270000 | 179 | FT | | | | | | 5 |
| | | | | | | | | | | | LS | 503 | 11100 | LS | | | | | | | |
| EROSION CONTROL | | | | | | | | | | | | | | | | | | | | | |
| 3,872 | | | | | | | | | | | 3,872 | 659 | 10000 | 3,872 | SY | | | | | | |
| 0.52 | | | | | | | | | | | 0.52 | 659 | 20000 | 0.52 | TON | | | | | | |
| 0.8 | | | | | | | | | | | 0.8 | 659 | 31000 | 0.8 | ACRE | | | | | | |
| 20.9 | | | | | | | | | | | 20.9 | 659 | 35000 | 20.9 | MGAL | | | | | | |
| | | | | | | | | | | | LS | 832 | 15000 | LS | | | | | | | |
| | | | | | | | | | | | LS | 832 | 15002 | LS | | | | | | | |
| | | | | | | | | | | | LS | 832 | 15010 | LS | | | | | | | |
| | | | | | | | | | | | 2,500 | 832 | 30000 | 2,500 | EACH | | | | | | |
| | | | 15 | | | | | | | | 15 | 838 | 20700 | 15 | CY | | | | | | |
| DRAINAGE | | | | | | | | | | | | | | | | | | | | | |
| | | 1 | | | | | | | | | 1 | 202 | 58100 | 1 | EACH | | | | | | |
| | | 0.44 | | | | | | | | | 0.44 | 602 | 20000 | 0.44 | CY | | | | | | |
| | | 49 | | | | | | | | | 49 | 611 | 19600 | 49 | FT | | | | | | |
| | | 238 | | | | | | | | | 238 | 611 | 19904 | 238 | FT | | | | | | |
| | | 1 | | | | | | | | | 1 | 611 | 98230 | 1 | EACH | | | | | | |
| | | 1 | | | | | | | | | 1 | 611 | 99644 | 1 | EACH | | | | | | |
| | | | 1 | | | | | | | | 1 | 611 | 98300 | 1 | EACH | | | | | | |
| | | 5 | 21 | | | | | | | | 26 | 611 | 12100 | 26 | FT | | | | | | |
| | | 10 | | | | | | | | | 10 | 611 | 07600 | 10 | FT | | | | | | |
| MAINTENANCE OF TRAFFIC | | | | | | | | | | | | | | | | | | | | | |
| | 4 | | | | | | | | | | 4 | 614 | 13310 | 4 | EACH | | | | | | |
| | 4 | | | | | | | | | | 4 | 614 | 13350 | 4 | EACH | | | | | | |
| | 1 | | | | | | | | | | 1 | 614 | 12380 | 1 | EACH | | | | | | |
| | 200 | | | | | | | | | | 200 | 622 | 41100 | 200 | FT | | | | | | |
| INCIDENTALS | | | | | | | | | | | | | | | | | | | | | |
| | | | | | | | | | | | LS | 614 | 11000 | LS | | | | | | | |
| LS | | | | | | | | | | | LS | 614 | 18002 | LS | | | | | | | 3 |
| | | | | | | | | | | | LS | 624 | 10000 | LS | | | | | | | |

GENERAL SUMMARY

**CLE BIKE TRAIL
CULVERT FY21**


4
6

I:\ProjectData\CLE\0576_CLE_BikeTrailCulvert\FY21\Design\Drainage\Sheets\0576_DP001.dgn_Sheet 5/20/2021 10:08:22 AM mbailey5

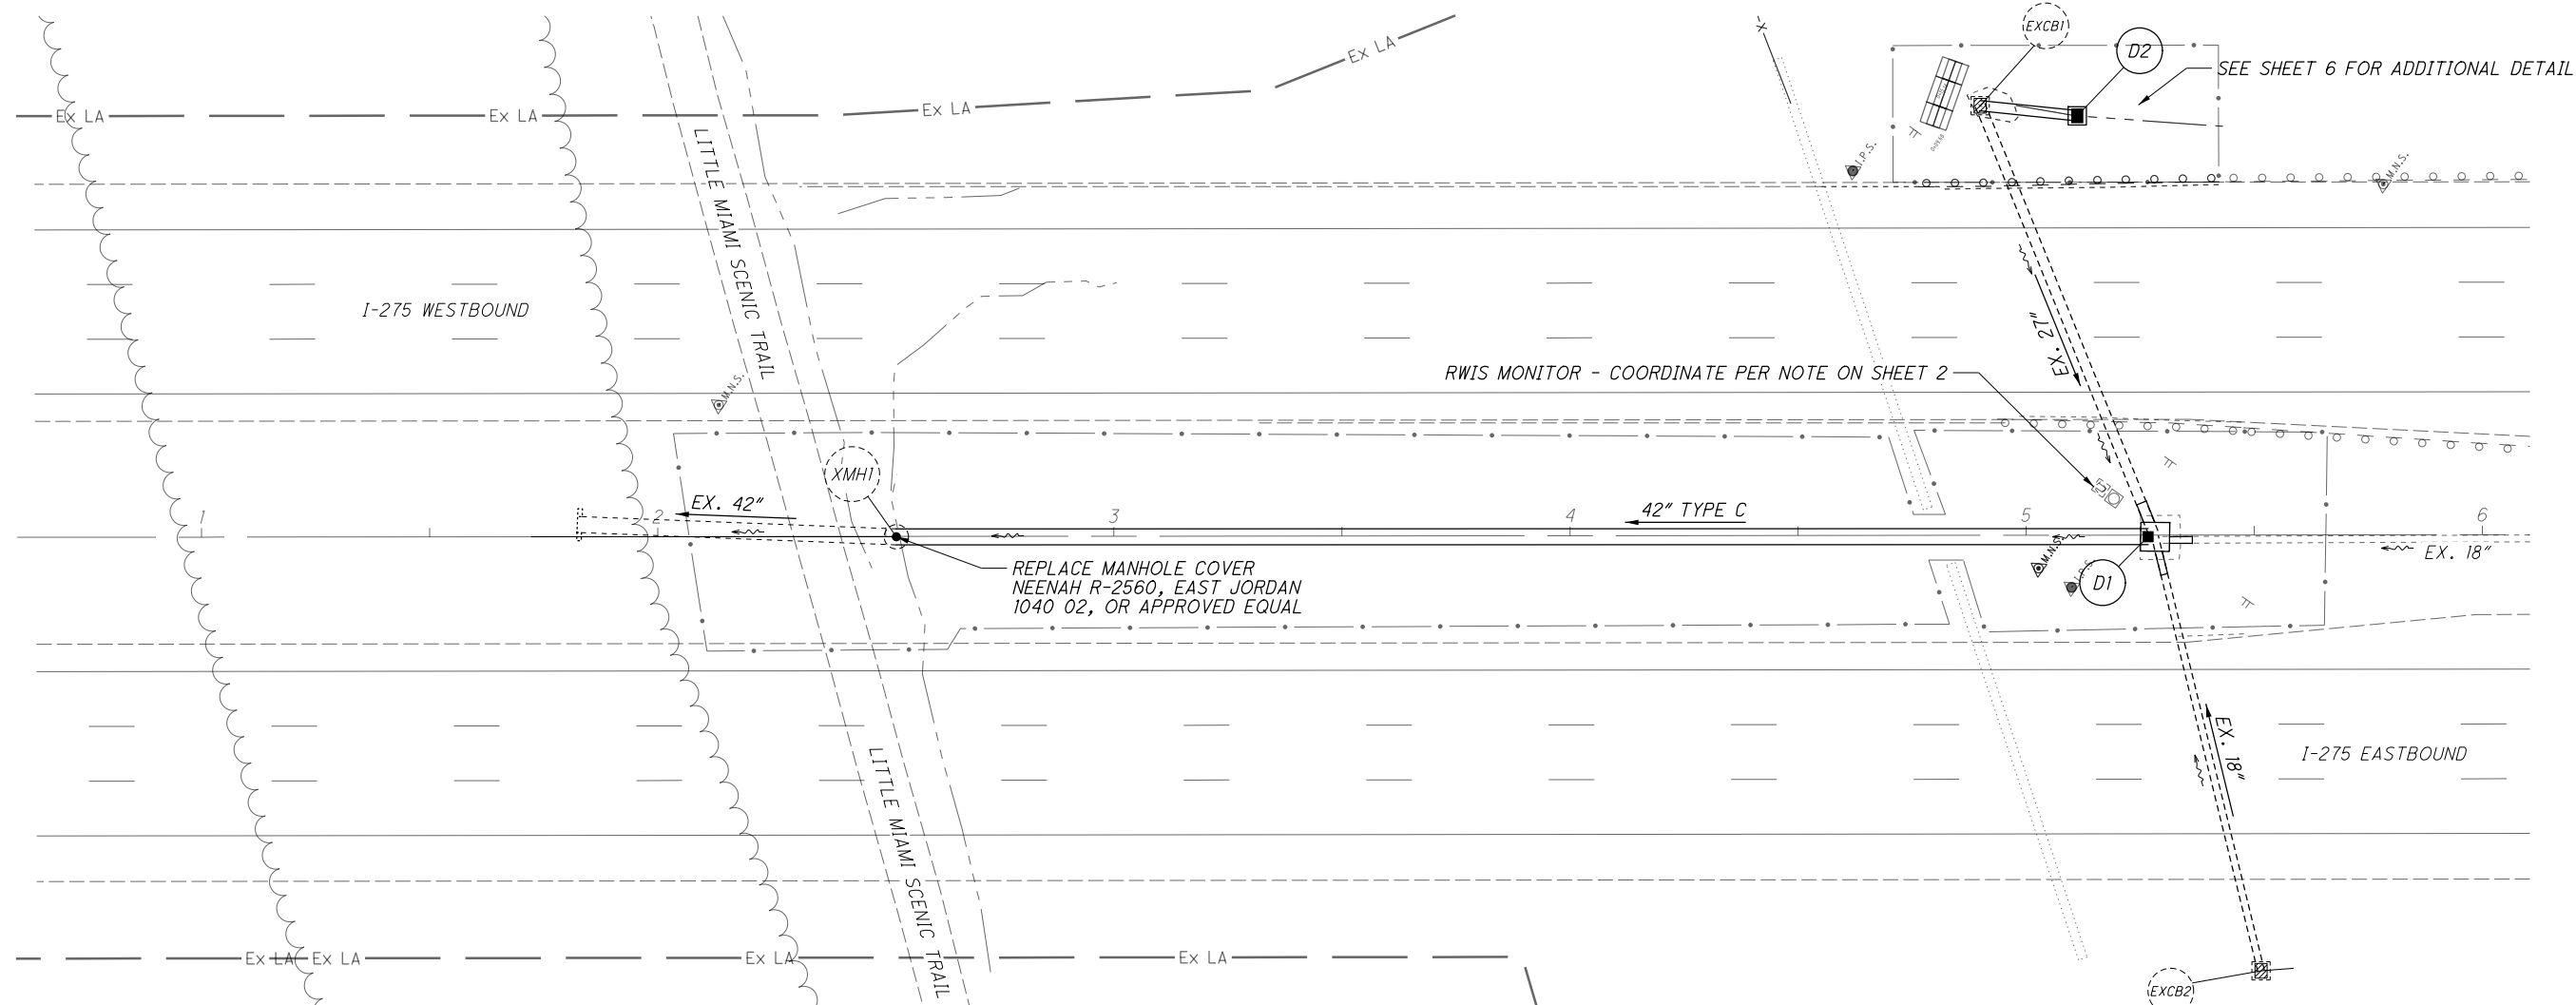

ESTIMATED QUANTITIES

| ITEM | GRAND TOTAL | UNIT | DESCRIPTION |
|------|-------------|------|---|
| 202 | 10 | FT | PIPE REMOVED, 24" AND UNDER |
| 202 | 110 | FT | PIPE REMOVED, OVER 24" |
| 202 | 179 | FT | SPECIAL - FILL AND PLUG EXISTING CONDUIT, 42" |
| 202 | 1 | EA | CATCH BASIN REMOVED |
| 602 | 0.44 | CY | CONCRETE MASONRY |
| 611 | 49 | FT | 42" CONDUIT, TYPE C |
| 611 | 238 | FT | 42" CONDUIT, TYPE F |
| 611 | 1 | EA | CATCH BASIN NO. 4 |
| 611 | 1 | EA | MANHOLE COVER |
| 611 | 10 | FT | 18" CONDUIT, TYPE C |
| 611 | 5 | FT | 27" CONDUIT, TYPE C |

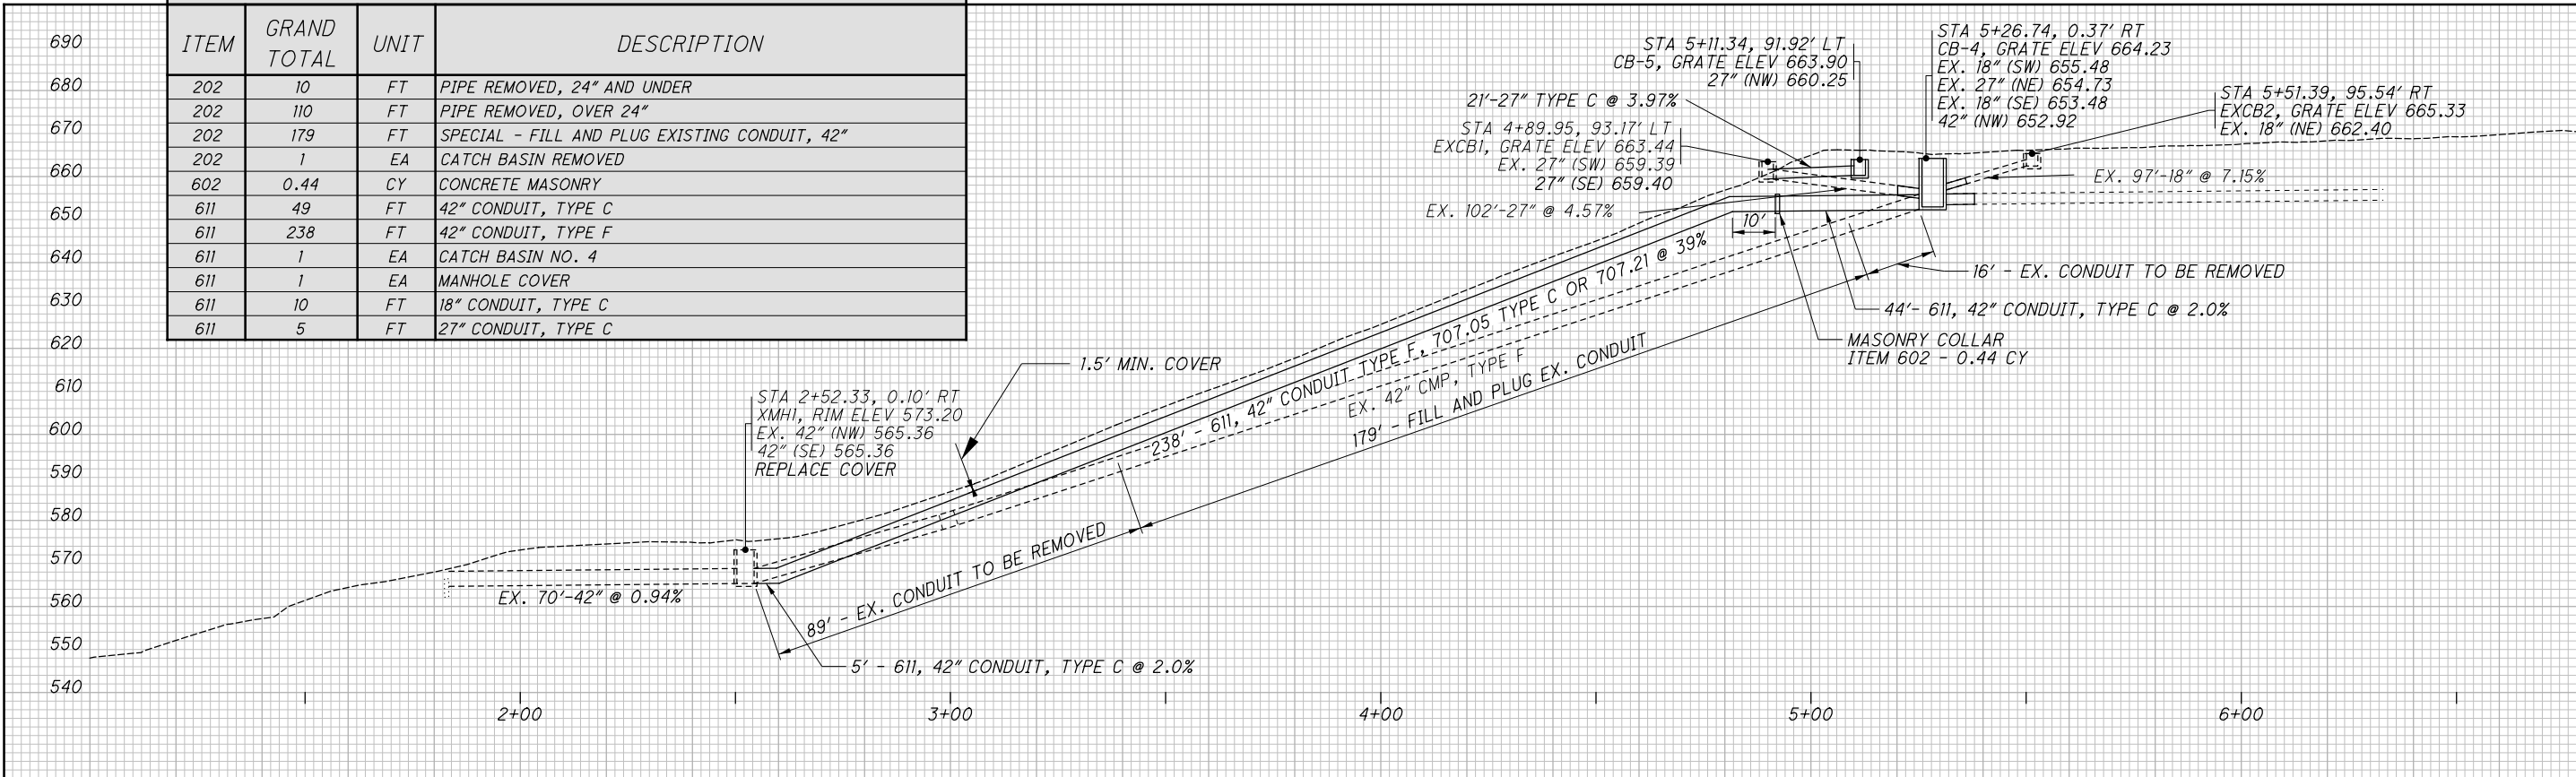

PLAN AND PROFILE

CLE BIKE TRAIL
CULVERT FY21