

ITEM 614 - MAINTAINING TRAFFIC

GENERALLY THE CONTRACTOR SHALL CONDUCT THEIR OPERATIONS AS TO MAKE THE PROPOSED CONSTRUCTION WITH A MINIMUM HAZARD, DELAY AND INCONVENIENCE TO THE MOTORISTS USING THE HIGHWAY. MAINTENANCE OF TRAFFIC INCLUDES ALL LOCATIONS FOR THIS PROJECT. THIS ITEM SHALL CONSIST OF THE MAINTENANCE OF TRAFFIC ON EXISTING ROADWAYS, RAMPS, AND SIDEWALKS IN ACCORDANCE WITH THE OHIO MANUAL OF UNIFORM TRAFFIC CONTROL DEVICES FOR STREETS AND HIGHWAY, CURRENT EDITION, LATEST REVISION, THE SPECIFICATIONS, AND THE FOLLOWING:

I. NOTIFICATION

SINCE FUNCTIONAL TRAFFIC CONTROL IS A MAJOR CONCERN ON THIS PROJECT, IT IS ESSENTIAL THAT THE MOTORING PUBLIC BE ADEQUATELY FOREWARNED OF FUTURE LANE CLOSURES AND TRAFFIC CONSTRUCTIONS. THEREFORE, THE CONTRACTOR MUST SUBMIT A WRITTEN SCHEDULE TO THE ODOT PUBLIC INFORMATION OFFICE (216-584-2007 OR D12.PUBLICINFORMATION@DOT.OHIO.GOV) INDICATING THE LOCATIONS AND DATES OF THE LANE CLOSURES AT LEAST 14 DAYS PRIOR TO THE IMPLEMENTATION OF ANY SUCH CLOSURES. ALSO, NOTIFY THE ENGINEER, RESPONSIBLE LAW ENFORCEMENT AGENCIES AND EMERGENCY SERVICES, AND LOCAL MUNICIPALITIES OF LANE CLOSURES OR OTHER RESTRICTIONS AT LEAST 2 WEEKS PRIOR TO IMPLEMENTATION. USE PORTABLE CHANGEABLE MESSAGE SIGNS TO ALERT MOTORISTS 3 DAYS PRIOR TO THE IMPLEMENTATION OF ANY CHANGES SUCH AS LANE CLOSURES OR OTHER RESTRICTIONS.

THE CONTRACTOR SHALL NOTIFY THE LOCAL MUNICIPALITIES OF PEDESTRIAN BRIDGE CLOSURES OR ANY OTHER PEDESTRIAN RESTRICTIONS AT LEAST 2 WEEKS PRIOR TO IMPLEMENTATION. USE ADVANCED WARNING SIGNS TO ALERT PEDESTRIANS 3 DAYS PRIOR TO THE IMPLEMENTATION OF PEDESTRIAN BRIDGE CLOSURES OR ANY OTHER PEDESTRIAN RESTRICTIONS. FOR LOCATION 2, THE BROOK PARK CITY ENGINEER SHALL BE NOTIFIED. FOR LOCATION 4, THE BEACHWOOD CITY ENGINEER SHALL BE NOTIFIED. FOR LOCATIONS 5 AND 6, THE NORTH OLMSTED CITY ENGINEER SHALL BE NOTIFIED. FOR LOCATION 7, THE NORTH OLMSTED CITY ENGINEER SHALL BE NOTIFIED. THE PEDESTRIAN BRIDGE CLOSURE FOR LOCATION 5 IS EXPECTED TO HAVE A 21 DAY DURATION. THE PEDESTRIAN BRIDGE CLOSURE FOR LOCATION 6 IS EXPECTED TO HAVE A 21 DAY DURATION. THE PEDESTRIAN BRIDGE CLOSURES FOR LOCATIONS 5 AND 6 SHALL NOT OCCUR CONCURRENTLY.

THE CONTRACTOR SHALL FURNISH, ERECT, MAINTAIN, AND SUBSEQUENTLY REMOVE ALL FLAGS, BARRICADES, SIGNS, SIGN SUPPORTS AND FURNISH AND MAINTAIN ALL FLAGGERS, WATCHERS AND INCIDENTALS RELATED THERETO.

II. LANE CLOSURE RESTRICTIONS

- LANE CLOSURES MAY ONLY BE IMPLEMENTED AT THE TIMES PERMITTED BY THE "DISTRICT 12 PERMITTED LANE CLOSURE TIMES" LIST WHICH IS LOCATED ON THE ODOT WEB SITE: [HTTP://WWW.DOT.STATE.OH.US/DISTRICTS/D12/HIGHWAYMANAGEMENT/PAGES/PERMITTEDLANECLOSURES.ASPX](http://www.dot.state.oh.us/districts/d12/highwaymanagement/pages/permittedlane closures.aspx). THE LATEST REVISION 14 DAYS PRIOR TO THE BID DATE SHALL BE IN EFFECT FOR THIS PROJECT. ALL NOTES ON THE PERMITTED LANE CLOSURE TIMES SHALL BE PART OF THIS PROJECT.
- UNLESS OTHERWISE NOTED, EXIT AND ENTRANCE RAMP LANES SHALL REMAIN OPEN AT ALL TIMES AND EXHIBIT A MINIMUM WIDTH OF ELEVEN (11) FEET.
- MAINTENANCE OF TRAFFIC SHALL FOLLOW THE INSTRUCTION OF THE STANDARD CONSTRUCTION DRAWINGS LISTED ON THE TITLE SHEET AND THE LATEST REVISION OF THE ODOT.
- PEDESTRIAN TRAFFIC SHALL BE PERMITTED AND ACCOMMODATED ON AT LEAST ONE SIDE AT ALL TIMES AT LOCATIONS WHERE PEDESTRIAN TRAFFIC IS CURRENTLY MAINTAINED EXCEPT THAT PEDESTRIAN TRAFFIC SHALL BE DETOURED FOR THE PEDESTRIAN BRIDGES AT ANOTHER LOCATION.
- ALL DRIVES AND SIDE STREETS SHALL BE MAINTAINED AT ALL TIMES.

**LOCATION 1 (CUY-71-0579)
I-71 OVER CR 299 (FOWLES ROAD):**

THE CONTRACTOR SHALL PERFORM THE DECK SEALING WORK IN TWO PHASES OF CONSTRUCTION FOR THE SOUTHBOUND STRUCTURE. THE FIRST PHASE SHALL CLOSE THE TWO OUTSIDE TRAVEL LANES AND THE DECELERATION LANE IN ACCORDANCE WITH MT-95.30 (CLOSING RIGHT OR LEFT LANE OF A MULTI-LANE DIVIDED HIGHWAY WITH DRUMS), MT-102.20 (LANE SHIFT ON A MULTI-LANE HIGHWAY USING DRUMS) AND MT-98.29 (EXIT RAMP CLOSURE) WHILE MAINTAINING THE INSIDE TRAVEL LANE AND MAINTAINING A SECOND LANE ON THE INSIDE SHOULDER. THE CONTRACTOR SHALL PERFORM WORK FOR PHASE ONE IN ONE WEEKEND. PHASE ONE MAINTENANCE OF TRAFFIC WILL REQUIRE MARKINGS TO SHIFT LANES AND MAINTAIN TWO LANES OF TRAFFIC. MARKING ITEMS HAVE BEEN INCLUDED IN THE MAINTENANCE OF TRAFFIC SUBSUMMARY. THE MARKING SHALL BE IN ACCORDANCE WITH MT-95.30 (CLOSING RIGHT OR LEFT LANE OF A MULTI-LANE HIGHWAY WITH DRUMS), MT-99.30 (WORK ZONE DELINEATION) AND MT-102.20 (LANE SHIFT ON A MULTI-LANE HIGHWAY USING DRUMS) EXCEPT THAT THE WORK ZONE RAISED PAVEMENT MARKERS ARE NOT REQUIRED FOR THE WEEKEND LANE CLOSURE. THE SECOND PHASE SHALL CLOSE THE INSIDE TRAVEL LANE IN ACCORDANCE WITH MT-95.30 (CLOSING RIGHT OR LEFT LANE OF A MULTI-LANE DIVIDED HIGHWAY WITH DRUMS) WHILE MAINTAINING TRAFFIC ON THE TWO OUTSIDE TRAVEL LANES AND THE RAMP DECELERATION LANE.

THE CONTRACTOR SHALL PERFORM THE DECK SEALING WORK IN TWO PHASES OF CONSTRUCTION FOR THE NORTHBOUND STRUCTURE. THE FIRST PHASE SHALL CLOSE THE TWO OUTSIDE TRAVEL LANES AND THE ACCELERATION LANE IN ACCORDANCE WITH MT-95.30 (CLOSING RIGHT OR LEFT LANE OF A MULTI-LANE DIVIDED HIGHWAY WITH DRUMS), MT-102.20 (LANE SHIFT ON A MULTI-LANE HIGHWAY USING DRUMS) AND MT-101.60 (ROAD CLOSURE USING TYPE 3 BARRICADES) WHILE MAINTAINING TRAFFIC ON THE INSIDE TRAVEL LANE AND MAINTAINING A SECOND LANE ON THE INSIDE SHOULDER. THE CONTRACTOR SHALL PERFORM WORK FOR PHASE ONE IN ONE WEEKEND. PHASE ONE MAINTENANCE OF TRAFFIC WILL REQUIRE MARKINGS TO SHIFT LANES AND MAINTAIN TWO LANES OF TRAFFIC. MARKING ITEMS HAVE BEEN INCLUDED IN THE MAINTENANCE OF TRAFFIC SUBSUMMARY. THE MARKING SHALL BE IN ACCORDANCE WITH MT-95.30 (CLOSING RIGHT OR LEFT LANE OF A MULTI-LANE HIGHWAY WITH DRUMS), MT-99.30 (WORK ZONE DELINEATION) AND MT-102.20 (LANE SHIFT ON A MULTI-LANE HIGHWAY USING DRUMS) EXCEPT THAT THE WORK ZONE RAISED PAVEMENT MARKERS ARE NOT REQUIRED FOR THE WEEKEND LANE CLOSURE. THE SECOND PHASE SHALL CLOSE THE INSIDE TRAVEL LANE IN ACCORDANCE WITH MT-95.30 (CLOSING RIGHT OR LEFT LANE OF A MULTI-LANE DIVIDED HIGHWAY WITH DRUMS) WHILE MAINTAINING THE TWO OUTSIDE TRAVEL LANES AND THE ACCELERATION LANE.

THE CONTRACTOR SHALL PERFORM THE COMPRESSION FLANGE RETROFIT, PIER PATCHING AND PIER SEALING WORK ON CR 299 (FOWLES ROAD) IN ACCORDANCE WITH ODOTCD FIGURE 6H-3 (TA-3 - WORK ON SHOULDERS) BY CLOSING THE SHOULDERS IN EACH DIRECTION AND PROVIDING FLAGGERS IN ACCORDANCE WITH MT-97.10 (FLAGGER CLOSING 1 LANE OF A 2-LANE HIGHWAY - STATIONARY OPERATION).

THE ABUTMENT PATCHING AND ABUTMENT SEALING WILL NOT REQUIRE MAINTENANCE OF TRAFFIC. THE CONTRACTOR CAN ACCESS THE ABUTMENTS FROM FOWLES ROAD AND PARK IN THE AREAS OUTSIDE OF THE TRAFFIC LANES.

LANE CLOSURES SHALL ONLY BE PERMITTED DURING THE PLCM HOURS FOR I-71 AT THE BRIDGE LOCATION. A MINIMUM OF ONE LANE OF TRAFFIC IN EACH DIRECTION SHALL BE MAINTAINED AT ALL TIMES ON FOWLES ROAD.

WHERE INTERSECTING ROADS OR DRIVES FALL WITHIN THE LANE CLOSURES, ADDITIONAL FLAGGERS, SIGNING, DRUMS, OTHER TRAFFIC CONTROL DEVICES AND TEMPORARY DRIVES SHALL BE USED TO SUPPLEMENT THE CLOSURE, AS DIRECTED BY THE ENGINEER TO ALLOW VEHICULAR INGRESS AND EGRESS AT ALL TIMES. DRUMS AT A MAXIMUM 5 FT. SPACING SHALL BE USED TO DELINEATE DRIVE OPENINGS WITHIN THE LANE CLOSURES THROUGH THIS SECTION.

**LOCATION 2 (CUY-71-0856)
I-71 OVER SYLVIA DRIVE:**

THE CONTRACTOR SHALL PERFORM THE PARAPET PATCHING AND SEALING WORK IN TWO PHASES. THE FIRST PHASE SHALL CLOSE THE INSIDE LANE ON I-71 (NORTHBOUND AND SOUTHBOUND) IN ACCORDANCE WITH MT-95.30 (CLOSING RIGHT OR LEFT LANE OF A MULTI-LANE DIVIDED HIGHWAY WITH DRUMS) WHILE MAINTAINING TWO LANES OF TRAFFIC IN EACH DIRECTION, THE SOUTHBOUND ACCELERATION LANE AND THE NORTHBOUND DECELERATION LANE. THE SECOND PHASE SHALL CLOSE THE SOUTHBOUND OUTSIDE SHOULDER AND THE ENTRANCE RAMP LANE ON THE SOUTHBOUND BRIDGE IN ACCORDANCE WITH MT-95.30 (CLOSING RIGHT OR LEFT LANE OF A MULTI-LANE DIVIDED HIGHWAY WITH DRUMS) AND MT-98.10 (LANE CLOSURE AT ENTRANCE RAMP) WHILE MAINTAINING ALL SOUTHBOUND LANES OF TRAFFIC INCLUDING ACCESS FROM THE ENTRANCE RAMP TO THE NORTH. THE SECOND PHASE SHALL ALSO CLOSE THE NORTHBOUND OUTSIDE SHOULDER AND THE EXIT RAMP LANE ON THE NORTHBOUND BRIDGE IN ACCORDANCE WITH MT-95.30 (CLOSING RIGHT OR LEFT LANE OF A MULTI-LANE DIVIDED HIGHWAY WITH DRUMS) WHILE MAINTAINING ALL NORTHBOUND LANES OF TRAFFIC INCLUDING ACCESS TO THE EXIT RAMP TO THE NORTH.

THE CONTRACTOR SHALL PERFORM THE COMPRESSION FLANGE RETROFIT, PIER SEALING AND PIER PATCHING WORK BY CLOSING ONE LANE ON SYLVIA DRIVE IN ACCORDANCE WITH MT-97.10 (FLAGGER CLOSING 1 LANE OF A 2-LANE HIGHWAY - STATIONARY OPERATION) WHILE MAINTAINING TWO WAY TRAFFIC IN THE OTHER LANE.

THE SIDEWALK ALONG SYLVIA DRIVE SHALL BE CLOSED DURING THE COMPRESSION FLANGE RETROFIT, PIER SEALING AND PIER PATCHING WORK AND DETOURED IN ACCORDANCE WITH MT-110.10 (PEDESTRIAN DETOUR METHODS).

THE ABUTMENT BEARING REPLACEMENT, ABUTMENT PATCHING, ABUTMENT SEALING AND CROSSFRAME REPAIR WILL NOT REQUIRE MAINTENANCE OF TRAFFIC. THE CONTRACTOR CAN GAIN ACCESS TO THE ABUTMENTS FROM SYLVIA DRIVE AND CAN PARK IN THE FENCED IN AREAS NEXT TO THE STRUCTURE BY USE OF THE GATES.

LANE CLOSURES SHALL ONLY BE PERMITTED DURING THE PLCM HOURS FOR I-71 AT THE BRIDGE LOCATION. A MINIMUM OF ONE LANE OF TRAFFIC IN EACH DIRECTION SHALL BE MAINTAINED AT ALL TIMES ON SYLVIA DRIVE EXCEPT AS REQUIRED TO PERFORM THE COMPRESSION FLANGE RETROFIT, PIER SEALING AND PIER PATCHING WORK AS DEFINED ABOVE. LANE CLOSURES ON SYLVIA DRIVE SHALL BE AS PERMISSIBLE BY THE CITY OF BROOK PARK AND SHALL NOT OCCUR DURING PEAK TRAFFIC HOURS.

WHERE INTERSECTING ROADS OR DRIVES FALL WITHIN THE LANE CLOSURES, ADDITIONAL FLAGGERS, SIGNING, DRUMS, OTHER TRAFFIC CONTROL DEVICES AND TEMPORARY DRIVES SHALL BE USED TO SUPPLEMENT THE CLOSURE, AS DIRECTED BY THE ENGINEER TO ALLOW VEHICULAR INGRESS AND EGRESS AT ALL TIMES. DRUMS AT A MAXIMUM 5 FT. SPACING SHALL BE USED TO DELINEATE DRIVE OPENINGS WITHIN THE LANE CLOSURES THROUGH THIS SECTION.

**LOCATION 3 (CUY-71-1007)
I-71 RAMP T OVER I-480 MAINLINE:**

THE CONTRACTOR SHALL PERFORM THE ABUTMENT AND PIER BEARING WORK BY CLOSING THE OUTSIDE SHOULDER OF IR 480 EASTBOUND IN ACCORDANCE WITH ODOTCD FIGURE 6H-3 (TA-3 - WORK ON SHOULDERS) WHILE MAINTAINING ALL EASTBOUND TRAVEL LANES. THE CONTRACTOR SHALL PERFORM THE ABUTMENT AND PIER BEARING WORK BY CLOSING THE OUTSIDE SHOULDER OF IR 480 WESTBOUND IN ACCORDANCE WITH ODOTCD FIGURE 6H-3 (TA-3 - WORK ON SHOULDERS) AND MT-98.10 (LANE CLOSURE AT ENTRANCE RAMP) WHILE MAINTAINING ALL WESTBOUND TRAVEL LANES AND ACCESS FROM THE ENTRANCE RAMP TO THE EAST.

LANE CLOSURES (INCLUDING SHOULDER CLOSURES) SHALL ONLY BE PERMITTED DURING THE PLCM HOURS FOR I-480 AT THE BRIDGE LOCATION.

**LOCATION 4 (CUY-271-0972 & 0974)
FAIRMOUNT BOULEVARD OVER I-271 & I-271X:**

THE CONTRACTOR SHALL PERFORM WORK IN SIX PHASES OF CONSTRUCTION FOR THE IR 271 MAINLINE AND IR 271 EXPRESS LANES. THE CONTRACTOR SHALL RESET THE ABUTMENT BEARINGS DURING PHASE 1. THE CONTRACTOR SHALL PERFORM PIER REPAIRS DURING PHASES 1 AND 4. THE CONTRACTOR SHALL PERFORM DECK HAUNCH CONCRETE REMOVAL AND VANDAL PROTECTION FENCE REPLACEMENT DURING ALL SIX PHASES OF CONSTRUCTION. THE FIRST PHASE SHALL CLOSE THE IR 271 MAINLINE (NORTHBOUND AND SOUTHBOUND) OUTSIDE SHOULDERS IN ACCORDANCE WITH ODOTCD FIGURE 6H-3 (TA-3 - WORK ON SHOULDERS) WHILE MAINTAINING THE THREE TRAVEL LANES. THE SECOND PHASE SHALL CLOSE THE IR 271 MAINLINE (NORTHBOUND AND SOUTHBOUND) OUTSIDE TRAVEL LANES IN ACCORDANCE WITH MT-95.30 (CLOSING RIGHT OR LEFT LANE OF A MULTI-LANE DIVIDED HIGHWAY WITH DRUMS) WHILE MAINTAINING THE TWO INSIDE TRAVEL LANES. THE THIRD PHASE SHALL CLOSE THE TWO INSIDE TRAVEL LANES OF IR 271 MAINLINE (NORTHBOUND AND SOUTHBOUND) IN ACCORDANCE WITH MT-95.30 (CLOSING RIGHT OR LEFT LANE OF A MULTI-LANE DIVIDED HIGHWAY WITH DRUMS) WHILE MAINTAINING ONE LANE OF TRAFFIC ON THE OUTSIDE TRAVEL LANE. THE THIRD PHASE SHALL ALSO MAINTAIN THE EXIT RAMP IN ACCORDANCE WITH MT-98.20 (LANE CLOSURE AT EXIT RAMP USING DRUMS). THE FOURTH PHASE SHALL CLOSE THE IR 271 MAINLINE (NORTHBOUND AND SOUTHBOUND) INSIDE SHOULDERS IN ACCORDANCE WITH ODOTCD FIGURE 6H-3 (TA-3 - WORK ON SHOULDERS) WHILE MAINTAINING THE THREE TRAVEL LANES. THE FOURTH PHASE SHALL ALSO CLOSE THE OUTSIDE SHOULDER OF IR 271 EXPRESS LANES (NORTHBOUND AND SOUTHBOUND) IN ACCORDANCE WITH ODOTCD FIGURE 6H-3 (TA-3 - WORK ON SHOULDERS) WHILE MAINTAINING THE THREE TRAVEL LANES. THE FIFTH PHASE SHALL CLOSE THE OUTSIDE LANE (SLIP RAMP) OF IR 271 EXPRESS LANES (NORTHBOUND AND SOUTHBOUND) AT THE BRIDGE IN ACCORDANCE WITH MT-95.30 (CLOSING RIGHT OR LEFT LANE OF A MULTI-LANE DIVIDED HIGHWAY WITH DRUMS) WHILE MAINTAINING TRAFFIC ON THE TWO INSIDE TRAVEL LANES. THE FIFTH PHASE SHALL ALSO MAINTAIN THE ENTRANCE RAMP IN ACCORDANCE WITH MT-98.11 (LANE CLOSURE AT ENTRANCE RAMP ACCELERATION LANE). THE SIXTH PHASE SHALL CLOSE THE TWO INSIDE TRAVEL LANES OF IR 271 EXPRESS LANES (NORTHBOUND AND SOUTHBOUND) IN ACCORDANCE WITH MT-95.30 (CLOSING RIGHT OR LEFT LANE OF A MULTI-LANE DIVIDED HIGHWAY WITH DRUMS) WHILE MAINTAINING TRAFFIC ON THE OUTSIDE TRAVEL LANE. THE SIXTH PHASE SHALL ALSO MAINTAIN THE ENTRANCE RAMP. PHASES 1 THRU 6 SHALL OCCUR CONCURRENTLY WITH PHASE 2 ON FAIRMOUNT BOULEVARD.

THE CONTRACTOR SHALL PERFORM WORK ON FAIRMOUNT BOULEVARD IN TWO PHASES OF CONSTRUCTION. THE CONTRACTOR SHALL PERFORM DECK AND SIDEWALK SEALING DURING PHASE 1. THE CONTRACTOR SHALL SEAL THE DECK AND REPLACE THE VANDAL PROTECTION FENCE DURING PHASE 2. PHASE TWO SHALL OCCUR CONCURRENTLY WITH PHASES 1 THRU 6 ON I-271. THE FIRST PHASE SHALL CLOSE THE OUTSIDE LANES (EASTBOUND AND WESTBOUND) IN ACCORDANCE WITH MT-95.30 (CLOSING RIGHT OR LEFT LANE OF A MULTI-LANE DIVIDED HIGHWAY WITH DRUMS) WHILE MAINTAINING TRAFFIC ON THE INSIDE LANES. THE FIRST PHASE SHALL ALSO CLOSE THE SIDEWALK ALONG FAIRMOUNT BOULEVARD AND PEDESTRIAN TRAFFIC SHALL BE DETOURED IN ACCORDANCE WITH MT-110.10 (PEDESTRIAN DETOUR METHODS). THE SECOND PHASE SHALL CLOSE THE INSIDE LANES (EASTBOUND AND WESTBOUND) IN ACCORDANCE WITH MT-95.30 (CLOSING RIGHT OR LEFT LANE OF A MULTI-LANE DIVIDED HIGHWAY WITH DRUMS) WHILE MAINTAINING TRAFFIC ON THE OUTSIDE LANES.

LANE CLOSURES SHALL ONLY BE PERMITTED DURING THE PLCM HOURS FOR THE I-271 MAINLINE AND THE I-271 EXPRESS LANES AT THE BRIDGE LOCATION. A MINIMUM OF ONE LANE OF TRAFFIC IN EACH DIRECTION SHALL BE MAINTAINED AT ALL TIMES ON FAIRMOUNT BOULEVARD. LANE CLOSURES ON FAIRMOUNT BOULEVARD SHALL BE COORDINATED WITH THE CITY OF BEACHWOOD.

WHERE INTERSECTING ROADS OR DRIVES FALL WITHIN THE LANE CLOSURES, ADDITIONAL FLAGGERS, SIGNING, DRUMS, OTHER TRAFFIC CONTROL DEVICES AND TEMPORARY DRIVES SHALL BE USED TO SUPPLEMENT THE CLOSURE, AS DIRECTED BY THE ENGINEER TO ALLOW VEHICULAR INGRESS AND EGRESS AT ALL TIMES. DRUMS AT A MAXIMUM 5 FT. SPACING SHALL BE USED TO DELINEATE DRIVE OPENINGS WITHIN THE LANE CLOSURES THROUGH THIS SECTION.

F:\2016\16041 D12 Bridge Rehab\12-BH-FY2021 Group 5\ProjectData\103162\Design\DOT\Sheets\103162\MN001.dgn 3/25/2021 2:18:10 PM smorr

CALCULATED
ALP
CHECKED
TJF

MAINTENANCE OF TRAFFIC NOTES - 1

D12-BH-FY2021(A) MISC
PID NO. 103162

LOCATION 5 (CUY-480-0126)
CHRISTMAN DRIVE PEDESTRIAN BRIDGE OVER I-480:

THE CONTRACTOR SHALL PERFORM WORK IN TWO PHASES OF CONSTRUCTION FOR IR 480. THE CONTRACTOR SHALL REPAIR THE PIERS DURING PHASES 1 AND 2. THE CONTRACTOR SHALL PATCH THE ABUTMENTS, REPAIR THE FENCE, PERFORM THE ABUTMENT DRAINAGE REPAIRS (DECK CORING AND INSTALLING PVC PIPE), PATCH THE ABUTMENT RAMP AND REPAIR THE ABUTMENT SLIDING PLATE JOINT DURING PHASE 1. THE FIRST PHASE SHALL CLOSE THE IR 480 (EASTBOUND) OUTSIDE SHOULDER IN ACCORDANCE WITH OMUTCD FIGURE 6H-3 (TA-3 - WORK ON SHOULDERS) AND MT-98.22 (LANE CLOSURE IN DECELERATION LANE) WHILE MAINTAINING THE THREE EASTBOUND TRAVEL LANES AND THE DECELERATION LANE. THE FIRST PHASE SHALL ALSO CLOSE THE IR 480 (WESTBOUND) OUTSIDE SHOULDER IN ACCORDANCE WITH OMUTCD FIGURE 6H-3 (TA-3 - WORK ON SHOULDERS) WHILE MAINTAINING THE THREE WESTBOUND TRAVEL LANES. THE SECOND PHASE SHALL CLOSE THE IR 480 (EASTBOUND AND WESTBOUND) INSIDE SHOULDERS IN ACCORDANCE WITH OMUTCD FIGURE 6H-3 (TA-3 - WORK ON SHOULDERS) WHILE MAINTAINING THE THREE WESTBOUND TRAVEL LANES, THE THREE EASTBOUND TRAVEL LANES AND THE DECELERATION LANE.

THE CONTRACTOR SHALL PERFORM THE ABUTMENT RAMP PATCHING AND ABUTMENT SLIDING PLATE REPAIR WORK ON THE CHRISTMAN DRIVE PEDESTRIAN BRIDGE BY CLOSING THE PEDESTRIAN BRIDGE DURING CONSTRUCTION AND DETOURING PEDESTRIAN TRAFFIC IN ACCORDANCE WITH MT-110.10 (PEDESTRIAN DETOUR METHODS). LOCATION 6 (CUY-480-0177) SHALL NOT BE CLOSED AT THE SAME TIME AS THIS LOCATION. THE EXPECTED PEDESTRIAN BRIDGE CLOSURE IS 21 DAYS.

THE ABUTMENT WALL PATCHING, FENCE REPAIRS AND THE ABUTMENT DRAINAGE REPAIRS (DECK CORING AND INSTALLING PVC PIPE) WILL NOT REQUIRE MAINTENANCE OF TRAFFIC FOR THE PEDESTRIAN BRIDGE.

LANE CLOSURES SHALL ONLY BE PERMITTED DURING THE PLCM HOURS FOR I-480 AT THE BRIDGE LOCATION. THE PEDESTRIAN BRIDGE CLOSURE ON CHRISTMAN DRIVE SHALL BE COORDINATED WITH THE CITY OF NORTH OLMSTED.



LOCATION 5 (CUY-480-0126)

LOCATION 6 (CUY-480-0177)
CYPRUS DRIVE PEDESTRIAN BRIDGE OVER I-480:

THE CONTRACTOR SHALL PERFORM WORK IN TWO PHASES OF CONSTRUCTION FOR IR 480. THE CONTRACTOR SHALL PERFORM THE PIER REPAIR AND PIER SEALING WORK DURING PHASES 1 AND 2. THE CONTRACTOR SHALL REPAIR THE APPROACH RAMPS, REPAIR THE FENCE, REPLACE THE VANDAL PROTECTION FENCE AND PATCH THE DECK DURING PHASE 1. THE FIRST PHASE SHALL CLOSE THE IR 480 (EASTBOUND) OUTSIDE SHOULDER IN ACCORDANCE WITH OMUTCD FIGURE 6H-3 (TA-3 - WORK ON SHOULDERS) WHILE MAINTAINING THE THREE EASTBOUND TRAVEL LANES AND THE ACCELERATION LANE. THE FIRST PHASE SHALL ALSO CLOSE THE IR 480 (WESTBOUND) OUTSIDE SHOULDER IN ACCORDANCE WITH OMUTCD FIGURE 6H-3 (TA-3 - WORK ON SHOULDERS) WHILE MAINTAINING THE THREE WESTBOUND TRAVEL LANES AND THE DECELERATION LANE. THE SECOND PHASE SHALL CLOSE THE IR 480 (EASTBOUND AND WESTBOUND) INSIDE SHOULDERS IN ACCORDANCE WITH OMUTCD FIGURE 6H-3 (TA-3 - WORK ON SHOULDERS) WHILE MAINTAINING THE THREE WESTBOUND TRAVEL LANES, THE DECELERATION LANE, THE THREE EASTBOUND TRAVEL LANES AND THE ACCELERATION LANE.

THE CONTRACTOR SHALL PERFORM THE APPROACH RAMP REPAIRS, FENCE REPAIRS, VANDAL PROTECTION FENCE REPLACEMENT, AND THE DECK PATCHING WORK ON THE CYPRUS DRIVE PEDESTRIAN BRIDGE BY CLOSING THE PEDESTRIAN BRIDGE DURING CONSTRUCTION AND DETOURING PEDESTRIAN TRAFFIC IN ACCORDANCE WITH MT-110.10 (PEDESTRIAN DETOUR METHODS). LOCATION 5 (CUY-480-0126) SHALL NOT BE CLOSED AT THE SAME AS THIS LOCATION. THE EXPECTED PEDESTRIAN BRIDGE CLOSURE IS 21 DAYS.

THE CONTRACTOR SHALL PROVIDE LANE CLOSURES ON I-480 IN ORDER TO REPLACE THE VANDAL PROTECTION FENCE ON THE CYPRUS DRIVE PEDESTRIAN BRIDGE. THE LANE CLOSURES SHALL BE IN ACCORDANCE WITH ODOT'S MAINTENANCE OF TRAFFIC STANDARD DRAWINGS AND SHALL ONLY BE PERMITTED DURING THE PLCM HOURS FOR I-480 AT THE BRIDGE LOCATION.

LANE CLOSURES SHALL ONLY BE PERMITTED DURING THE PLCM HOURS FOR I-480 AT THE BRIDGE LOCATION. THE PEDESTRIAN BRIDGE CLOSURE ON CYPRUS DRIVE SHALL BE COORDINATED WITH THE CITY OF NORTH OLMSTED.



LOCATION 6 (CUY-480-0177)

LOCATION 7 (CUY-480-0501)
I-480 OVER SR-17 (BROOKPARK ROAD):

THE CONTRACTOR SHALL PERFORM THE PARAPET PATCHING, PARAPET SEALING, PARAPET REPLACEMENT, SHOULDER EXCAVATION, BACKWALL REPAIR, FULL DEPTH PAVEMENT REPAIR, APPROACH SLAB PATCHING, DECK PATCHING AND BACKWALL REPLACEMENT WORK IN SIX PHASES ON IR 480.

DURING PHASE ONE, THE CONTRACTOR SHALL PATCH AND SEAL THE OUTSIDE WESTBOUND PARAPET, PERFORM THE SHOULDER EXCAVATION (WESTBOUND FORWARD ABUTMENT), REPAIR THE BACKWALL (WESTBOUND FORWARD ABUTMENT), REPAIR THE SHOULDER PAVEMENT BEHIND THE BACKWALL REPAIR (WESTBOUND FORWARD ABUTMENT), AND PATCH THE APPROACH SLAB AND BACKWALL IN THE OUTSIDE LANE (WESTBOUND FORWARD ABUTMENT). THE FIRST PHASE SHALL MAINTAIN THREE LANES OF TRAFFIC ON IR 480 (WESTBOUND) IN ACCORDANCE WITH THE MAINTENANCE OF TRAFFIC PLANS, AND MT-102.10 (LANE SHIFT ON A MULTI-LANE HIGHWAY USING PORTABLE BARRIER). THE EASTBOUND BRIDGE WILL NOT REQUIRE MAINTENANCE OF TRAFFIC DURING THIS PHASE AND ALL EASTBOUND LANES SHALL REMAIN OPEN.

DURING PHASE TWO, THE CONTRACTOR SHALL PATCH THE DECK AND APPROACH SLAB AT THE WESTBOUND FORWARD ABUTMENT. THE SECOND PHASE SHALL CLOSE THE NORTH PORTION OF THE IR 480 WESTBOUND BRIDGE IN ACCORDANCE WITH MT-95.30 (CLOSING RIGHT OR LEFT LANE OF A MULTI-LANE DIVIDED HIGHWAY WITH DRUMS) AND MT-102.20 (LANE SHIFT ON A MULTI-LANE HIGHWAY USING DRUMS) WHILE MAINTAINING TRAFFIC ON THE INSIDE WESTBOUND TRAVEL LANE AND THE INSIDE WESTBOUND SHOULDER. THE CONTRACTOR SHALL PERFORM WORK FOR PHASE TWO IN ONE WEEKEND. PHASE TWO MAINTENANCE OF TRAFFIC WILL REQUIRE MARKINGS TO SHIFT LANES AND MAINTAIN TWO LANES OF TRAFFIC. MARKING ITEMS HAVE BEEN INCLUDED IN THE MAINTENANCE OF TRAFFIC SUBSUMMARY. THE MARKING SHALL BE IN ACCORDANCE WITH MT-95.30 (CLOSING RIGHT OR LEFT LANE OF A MULTI-LANE HIGHWAY WITH DRUMS), MT-99.30 (WORK ZONE DELINEATION) AND MT-102.20 (LANE SHIFT ON A MULTI-LANE HIGHWAY USING DRUMS) EXCEPT THAT THE WORK ZONE RAISED PAVEMENT MARKERS ARE NOT REQUIRED.

DURING PHASE THREE, THE CONTRACTOR SHALL PATCH THE MEDIAN PARAPET, SEAL THE MEDIAN PARAPET AND REPLACE PORTIONS OF THE MEDIAN PARAPET. THE THIRD PHASE SHALL MAINTAIN THREE LANES OF TRAFFIC ON IR 480 (EASTBOUND AND WESTBOUND) IN ACCORDANCE WITH THE MAINTENANCE OF TRAFFIC PLANS, AND MT-102.10 (LANE SHIFT ON A MULTI-LANE HIGHWAY USING PORTABLE BARRIER).

DURING PHASE FOUR, THE CONTRACTOR SHALL PATCH THE DECK AT THE EASTBOUND FORWARD ABUTMENT. THE FOURTH PHASE SHALL CLOSE THE NORTH PORTION OF THE IR 480 EASTBOUND BRIDGE LANES IN ACCORDANCE WITH MT-95.30 (CLOSING RIGHT OR LEFT LANE OF A MULTI-LANE DIVIDED HIGHWAY WITH DRUMS) AND MT-102.20 (LANE SHIFT ON A MULTI-LANE HIGHWAY USING DRUMS) WHILE MAINTAINING TRAFFIC ON THE OUTSIDE EASTBOUND TRAVEL LANE AND THE OUTSIDE EASTBOUND SHOULDER. THE CONTRACTOR SHALL PERFORM WORK FOR PHASE FOUR IN ONE WEEKEND. PHASE FOUR MAINTENANCE OF TRAFFIC WILL REQUIRE MARKINGS TO SHIFT LANES AND MAINTAIN TWO LANES OF TRAFFIC. MARKING ITEMS HAVE BEEN INCLUDED IN THE MAINTENANCE OF TRAFFIC SUBSUMMARY. THE MARKING SHALL BE IN ACCORDANCE WITH MT-95.30 (CLOSING RIGHT OR LEFT LANE OF A MULTI-LANE HIGHWAY WITH DRUMS), MT-99.30 (WORK ZONE DELINEATION) AND MT-102.20 (LANE SHIFT ON A MULTI-LANE HIGHWAY USING DRUMS) EXCEPT THAT THE WORK ZONE RAISED PAVEMENT MARKERS ARE NOT REQUIRED.

DURING PHASE FIVE, THE CONTRACTOR SHALL PATCH THE DECK AT THE EASTBOUND FORWARD ABUTMENT. THE FIFTH PHASE SHALL CLOSE THE SOUTH PORTION OF THE IR 480 EASTBOUND BRIDGE IN ACCORDANCE WITH MT-95.30 (CLOSING RIGHT OR LEFT LANE OF A MULTI-LANE DIVIDED HIGHWAY WITH DRUMS) AND MT-102.20 (LANE SHIFT ON A MULTI-LANE HIGHWAY USING DRUMS) WHILE MAINTAINING TRAFFIC ON THE INSIDE EASTBOUND TRAVEL LANE AND THE INSIDE EASTBOUND SHOULDER. THE CONTRACTOR SHALL PERFORM WORK FOR PHASE FIVE IN ONE WEEKEND. PHASE FIVE MAINTENANCE OF TRAFFIC WILL REQUIRE MARKINGS TO SHIFT LANES AND MAINTAIN TWO LANES OF TRAFFIC. MARKING ITEMS HAVE BEEN INCLUDED IN THE MAINTENANCE OF TRAFFIC SUBSUMMARY. THE MARKING SHALL BE IN ACCORDANCE WITH MT-95.30 (CLOSING RIGHT OR LEFT LANE OF A MULTI-LANE HIGHWAY WITH DRUMS), MT-99.30 (WORK ZONE DELINEATION) AND MT-102.20 (LANE SHIFT ON A MULTI-LANE HIGHWAY USING DRUMS) EXCEPT THAT THE WORK ZONE RAISED PAVEMENT MARKERS ARE NOT REQUIRED.

DURING PHASE SIX, THE CONTRACTOR SHALL PATCH AND SEAL THE EASTBOUND OUTSIDE PARAPET. THE SIXTH PHASE SHALL CLOSE THE OUTSIDE LANE OF IR 480 (EASTBOUND) IN ACCORDANCE WITH MT-95.30 (CLOSING RIGHT OR LEFT LANE OF A MULTI-LANE DIVIDED HIGHWAY WITH DRUMS) WHILE MAINTAINING TRAFFIC ON THE TWO INSIDE EASTBOUND TRAVEL LANES.

THE CONTRACTOR SHALL PERFORM WORK IN THREE PHASES ON BROOKPARK ROAD. THE CONTRACTOR SHALL PERFORM DRILLING OUT THE WEB CRACKS, PATCHING THE PIER, REPAIRING THE PIER AND SEALING THE PIER DURING PHASES 1, 2 AND 3. THE CONTRACTOR SHALL REPAIR ABUTMENT BEARINGS, RESET ABUTMENT BEARINGS, PATCH THE ABUTMENTS, SEAL THE ABUTMENTS AND REMOVE THE TREE DURING PHASES 2 AND 3. PORTIONS OF THE FENCE SHALL BE REMOVED TO PROVIDE ACCESS TO THE ABUTMENTS DURING CONSTRUCTION (SEE GENERAL NOTE ITEM 607 - FENCE, MISC.: FENCE REMOVED AND REERECTED). THE FIRST PHASE SHALL CLOSE THE INSIDE LANES ON BROOKPARK ROAD (EASTBOUND AND WESTBOUND) IN ACCORDANCE WITH MT-95.30 (CLOSING RIGHT OR LEFT LANE OF A MULTI-LANE DIVIDED HIGHWAY WITH DRUMS) WHILE MAINTAINING TRAFFIC ON THE OUTSIDE LANES (EASTBOUND AND WESTBOUND). THE SECOND PHASE SHALL CLOSE THE OUTSIDE LANE ON BROOKPARK ROAD (EASTBOUND) IN ACCORDANCE WITH MT-95.30 (CLOSING RIGHT OR LEFT LANE OF A MULTI-LANE DIVIDED HIGHWAY WITH DRUMS) WHILE MAINTAINING TRAFFIC ON THE INSIDE LANE (EASTBOUND). THE SECOND PHASE SHALL ALSO CLOSE THE SIDEWALK (EASTBOUND) IN ACCORDANCE WITH MT-110.10 (PEDESTRIAN DETOUR METHODS). THE THIRD PHASE SHALL CLOSE THE OUTSIDE LANE ON BROOKPARK ROAD (WESTBOUND) IN ACCORDANCE WITH MT-95.30 (CLOSING RIGHT OR LEFT LANE OF A MULTI-LANE DIVIDED HIGHWAY WITH DRUMS) WHILE MAINTAINING TRAFFIC ON THE INSIDE LANE (WESTBOUND). THE THIRD PHASE SHALL ALSO CLOSE THE SIDEWALK (WESTBOUND) IN ACCORDANCE WITH MT-110.10 (PEDESTRIAN DETOUR METHODS).

THE WORK CONSTRUCTED FROM IR 480 MAY OCCUR CONCURRENTLY WITH THE WORK CONSTRUCTED FROM BROOKPARK ROAD.

A MINIMUM OF ONE LANE OF TRAFFIC IN EACH DIRECTION SHALL BE MAINTAINED AT ALL TIMES ON BROOKPARK ROAD. LANE CLOSURES ON SR-17 (BROOKPARK ROAD) SHALL BE COORDINATED WITH THE CITY OF NORTH OLMSTED AND SHALL NOT OCCUR DURING PEAK TRAFFIC HOURS. LANE CLOSURES SHALL OCCUR DURING NIGHTTIME HOURS AS APPROVED BY THE ENGINEER.

WHERE INTERSECTING ROADS OR DRIVES FALL WITHIN THE LANE CLOSURES, ADDITIONAL FLAGGERS, SIGNING, DRUMS, OTHER TRAFFIC CONTROL DEVICES AND TEMPORARY DRIVES SHALL BE USED TO SUPPLEMENT THE CLOSURE, AS DIRECTED BY THE ENGINEER TO ALLOW VEHICULAR INGRESS AND EGRESS AT ALL TIMES. DRUMS AT A MAXIMUM 5 FT. SPACING SHALL BE USED TO DELINEATE DRIVE OPENINGS WITHIN THE LANE CLOSURES THROUGH THIS SECTION.

F:\2016\116041 D12 Bridge Rehab\12-BH-FY2021 Group 5\ProjectData\103162\Design\WOT\Sheets\103162MN001.dgn 3/25/2021 2:23:09 PM smorr

F:\2016\116041 D12 Bridge Rehab\12-BH-FY2021 Group 5\ProjectData\103162\Design\Roadway\Sheets\103162GG001.dgn 3/25/2021 3:28:47 PM smorr

| SHEET NUMBER | | | | | | | | | | ITEM | ITEM EXT. | PARTICIPATION | | GRAND TOTAL | UNIT | DESCRIPTION | SEE SHEET NO. | CALCULATED | TJF | CHECKED | MS | | | | |
|--------------|------|-------|-------|-------|-------|-------|-------|-------|-----------|---------|-----------|---|-------|-------------|---|-------------|---------------|------------|-----|---------|----|--|--|--|--|
| 5-7 | 8-20 | 27-35 | 36-48 | 49-50 | 51-57 | 58-63 | 64-69 | 70-96 | 01/NFP/BR | | | | | | | | | | | | | | | | |
| | | | | | | | | | | | | ROADWAY | | | | | | | | | | | | | |
| LS | | | | | | | | | | 201 | 11001 | LS | LS | | CLEARING AND GRUBBING, AS PER PLAN | 7 | | | | | | | | | |
| 140 | | | | | | | | | | 202 | 75000 | 140 | 140 | FT | FENCE REMOVED | | | | | | | | | | |
| 25 | | | | | | | | | | 203 | 10000 | 25 | 25 | CY | EXCAVATION | | | | | | | | | | |
| 38 | | | | | | | | | | 203 | 20000 | 38 | 38 | CY | EMBANKMENT | | | | | | | | | | |
| 140 | | | | | | | | | | 607 | 20000 | 140 | 140 | FT | FENCE, TYPE CL | | | | | | | | | | |
| 90 | | | | | | | | | | 607 | 98000 | 90 | 90 | FT | FENCE, MISC.: FENCE REMOVED AND REERECTED | 7 | | | | | | | | | |
| LS | | | | | | | | | | SPECIAL | 69098400 | LS | LS | | SITE ACCESS | 7 | | | | | | | | | |
| | | | | | | | | | | | | EROSION CONTROL | | | | | | | | | | | | | |
| 8 | | | | | | | | | | 659 | 00300 | 8 | 8 | CY | TOPSOIL | | | | | | | | | | |
| 65 | | | | | | | | | | 659 | 10000 | 65 | 65 | SY | SEEDING AND MULCHING | | | | | | | | | | |
| 4 | | | | | | | | | | 659 | 14000 | 4 | 4 | SY | REPAIR SEEDING AND MULCHING | | | | | | | | | | |
| 0.01 | | | | | | | | | | 659 | 20000 | 0.01 | 0.01 | TON | COMMERCIAL FERTILIZER | | | | | | | | | | |
| 1 | | | | | | | | | | 659 | 35000 | 1 | 1 | MGAL | WATER | | | | | | | | | | |
| 10000 | | | | | | | | | | 832 | 30000 | 10000 | 10000 | EACH | EROSION CONTROL | | | | | | | | | | |
| | | | | | | | | | | | | PAVEMENT | | | | | | | | | | | | | |
| 16 | | | | | | | | | | 255 | 10010 | 16 | 16 | SY | FULL DEPTH PAVEMENT REMOVAL AND RIGID REPLACEMENT, CLASS QCI | | | | | | | | | | |
| 82 | | | | | | | | | | 255 | 20000 | 82 | 82 | FT | FULL DEPTH PAVEMENT SAWING | | | | | | | | | | |
| | | | | | | | | | | | | TRAFFIC CONTROL | | | | | | | | | | | | | |
| | | | | | | | | | | 621 | 00300 | 118 | 118 | EACH | RPM REFLECTOR | | | | | | | | | | |
| | | | | | | | | | | 621 | 54001 | 118 | 118 | EACH | RAISED PAVEMENT MARKER REMOVED, AS PER PLAN | | | | | | 12 | | | | |
| 0.01 | | | | | | | | | | 642 | 00104 | 0.01 | 0.01 | MILE | EDGE LINE, 6", TYPE 1 | | | | | | | | | | |
| | | | | | | | | | | | | STRUCTURE REPAIR (CUY-71-0579, SFN 1804081 SB SFN 1804111 NB - LOCATION 1) | | | | | | | | | | | | | |
| | | | LS | | | | | | | 202 | 11203 | LS | LS | | PORTIONS OF STRUCTURE REMOVED, OVER 20 FOOT SPAN, AS PER PLAN | 24 | | | | | | | | | |
| | | | 2405 | | | | | | | 512 | 10050 | 2405 | 2405 | SY | SEALING OF CONCRETE SURFACES (NON-EPOXY) | | | | | | | | | | |
| | | | 1072 | | | | | | | 512 | 10101 | 1072 | 1072 | SY | SEALING OF CONCRETE SURFACES (EPOXY-URETHANE), AS PER PLAN | 24 | | | | | | | | | |
| | | | 539 | | | | | | | 512 | 74001 | 539 | 539 | SY | REMOVAL OF EXISTING COATINGS FROM CONCRETE SURFACES, AS PER PLAN | 24 | | | | | | | | | |
| | | | 12887 | | | | | | | 513 | 21600 | 12887 | 12887 | LB | STRUCTURAL STEEL FOR REHABILITATION, AS PER PLAN (BOTTOM FLANGE RETROFITS) | 26 | | | | | | | | | |
| | | | LS | | | | | | | 514 | 00100 | LS | LS | | SURFACE PREPARATION OF EXISTING STRUCTURAL STEEL | | | | | | | | | | |
| | | | LS | | | | | | | 514 | 00200 | LS | LS | | FIELD PAINTING OF EXISTING STRUCTURAL STEEL, PRIME COAT | | | | | | | | | | |
| | | | LS | | | | | | | 514 | 00300 | LS | LS | | FIELD PAINTING STRUCTURAL STEEL, INTERMEDIATE COAT | | | | | | | | | | |
| | | | LS | | | | | | | 514 | 00401 | LS | LS | | FIELD PAINTING STRUCTURAL STEEL, FINISH COAT, AS PER PLAN | 26 | | | | | | | | | |
| | | | 556 | | | | | | | SPECIAL | 51900100 | 556 | 556 | SF | COMPOSITE FIBER WRAP SYSTEM | 25 | | | | | | | | | |
| | | | 284 | | | | | | | 519 | 11101 | 284 | 284 | SF | PATCHING CONCRETE STRUCTURE, AS PER PLAN | 24 | | | | | | | | | |
| | | | 9 | | | | | | | 844 | 10001 | 9 | 9 | SF | CONCRETE PATCHING WITH GALVANIC ANODE PROTECTION, AS PER PLAN | 25 | | | | | | | | | |
| | | | | | | | | | | | | STRUCTURE REPAIR (CUY-71-0856, SFN 1804359 - LOCATION 2) | | | | | | | | | | | | | |
| | | | LS | | | | | | | 202 | 11203 | LS | LS | | PORTIONS OF STRUCTURE REMOVED, OVER 20 FOOT SPAN, AS PER PLAN | 24 | | | | | | | | | |
| | | | 298 | | | | | | | 512 | 10101 | 298 | 298 | SY | SEALING OF CONCRETE SURFACES (EPOXY-URETHANE), AS PER PLAN | 24 | | | | | | | | | |
| | | | 6 | | | | | | | 512 | 74001 | 6 | 6 | SY | REMOVAL OF EXISTING COATINGS FROM CONCRETE SURFACES, AS PER PLAN | 24 | | | | | | | | | |
| | | | 639 | | | | | | | 513 | 21501 | 639 | 639 | LB | REPLACEMENT OF DETERIORATED END CROSSFRAMES, AS PER PLAN | 24 | | | | | | | | | |
| | | | 10100 | | | | | | | 513 | 21600 | 10100 | 10100 | LB | STRUCTURAL STEEL FOR REHABILITATION, AS PER PLAN (BOTTOM FLANGE RETROFITS) | 26 | | | | | | | | | |
| | | | LS | | | | | | | 514 | 00100 | LS | LS | | SURFACE PREPARATION OF EXISTING STRUCTURAL STEEL | | | | | | | | | | |
| | | | LS | | | | | | | 514 | 00200 | LS | LS | | FIELD PAINTING OF EXISTING STRUCTURAL STEEL, PRIME COAT | | | | | | | | | | |
| | | | LS | | | | | | | 514 | 00300 | LS | LS | | FIELD PAINTING STRUCTURAL STEEL, INTERMEDIATE COAT | | | | | | | | | | |
| | | | LS | | | | | | | 514 | 00401 | LS | LS | | FIELD PAINTING STRUCTURAL STEEL, FINISH COAT, AS PER PLAN | 26 | | | | | | | | | |
| | | | 38 | | | | | | | 516 | 44101 | 38 | 38 | EACH | ELASTOMERIC BEARING WITH INTERNAL LAMINATES AND LOAD PLATE (NEOPRENE), (2.190"x8"x12" WITH 2-7/8" OR 2-1/2" LOAD PLATE WITH SHIMS), AS PER PLAN | 47 | | | | | | | | | |
| | | | LS | | | | | | | 516 | 47001 | LS | LS | | JACKING AND TEMPORARY SUPPORT OF SUPERSTRUCTURE, AS PER PLAN | 24 | | | | | | | | | |
| | | | 629 | | | | | | | SPECIAL | 51900100 | 629 | 629 | SF | COMPOSITE FIBER WRAP SYSTEM | 25 | | | | | | | | | |
| | | | 93 | | | | | | | 519 | 11101 | 93 | 93 | SF | PATCHING CONCRETE STRUCTURE, AS PER PLAN | 24 | | | | | | | | | |
| | | | 13 | | | | | | | 844 | 10001 | 13 | 13 | SF | CONCRETE PATCHING WITH GALVANIC ANODE PROTECTION, AS PER PLAN | 25 | | | | | | | | | |
| | | | | | | | | | | | | STRUCTURE REPAIR (CUY-71-1007, 1814257 - LOCATION 3) | | | | | | | | | | | | | |
| | | | 10 | | | | | | | 516 | 46701 | 10 | 10 | EACH | RESET BEARING, AS PER PLAN | 24 | | | | | | | | | |
| | | | LS | | | | | | | 516 | 47001 | LS | LS | | JACKING AND TEMPORARY SUPPORT OF SUPERSTRUCTURE, AS PER PLAN | 24 | | | | | | | | | |

GENERAL SUMMARY

**D12-BH-FY2021(A) MISC
PID NO. 103162**

21
96

F:\2016\116041 D12 Bridge Rehab\12-BH-FY2021 Group 5\ProjectData\103162\Design\Structures\103162GN001.dgn 3/25/2021 4:03:19 PM smorr

ITEM 513 - STRUCTURAL STEEL, MISC.: DRILLING STRUCTURAL STEEL, GRINDING, AND NDT

FOR LOCATION 7 (CUY-480-0501), THIS WORK CONSISTS OF DRILLING CRACKS AND ENDS OF CRACKS, GRINDING TO ENLARGE DRILLED HOLES, AND NON-DESTRUCTIVE TESTING AS SHOWN IN THE PLANS AND AS DIRECTED BY THE ENGINEER. DISTRICT PRODUCTION DEPARTMENT (BRIDGE SECTION) APPROVAL MUST BE OBTAINED BEFORE DRILLING ANY HOLES IN THE FLANGES UNDER THIS PAY ITEM.

DRILL HOLES TO REMOVE ENTIRE CRACKS OR THE APPARENT ENDS OF THE CRACK REVEALED BY THE INITIAL NDT AND/OR VISUAL INSPECTION. GRIND SMOOTH THE EXPOSED CIRCUMFERENCE OF EACH DRILLED HOLE AND CAREFULLY INSPECT FOR CRACKS USING MAGNETIC PARTICLE EXAMINATION AND/OR DYE PENETRATION. CONTINUE DRILLING, GRINDING, AND TESTING UNTIL ALL CRACK ENDS ARE REMOVED. WHEN NO CRACKS ARE DETECTED AT A LOCATION NO HOLES SHALL BE DRILLED UNDER THIS ITEM.

SINCE ANY OF THESE CRACKS COULD PROPAGATE INTO A TENSION ZONE, REMOVING THEIR ENDS IS IMPERATIVE. CRACKS LESS THAN 1/2" LONG AND CRACKED AREAS OR DEFECTS LESS THAN 1/2" IN DIAMETER SHALL BE REMOVED BY A SINGLE HOLE WHEN PRACTICAL.

ENDS OF CRACKS LONGER THAN 1/2" AND DEFECTS SMALLER THAN 1/2" SHALL BE DRILLED WITH A 1" DIAMETER DRILL BIT. HOLES SHALL BE CAREFULLY EXAMINED FOR CRACKS IN THE PLANE OF THE PLATE. 1/2" OR 2" DIAMETER HOLES MAY BE DRILLED WHERE THE PROXIMITY OF THE CRACK END TO ADJACENT STEEL PRECLUDES DRILLING 1" DIAMETER HOLES.

CLEAN AND PAINT AREAS PER ITEM 514 - PAINTING OF STRUCTURAL STEEL (PAINTING SHALL BE CONSIDERED INCIDENTAL WITH THIS ITEM).

THE LOCATION OF ALL HOLES SHALL BE DETERMINED BY AND DRILLED UNDER THE DIRECTION OF THE ENGINEER.

THE ACCEPTABLE NUMBER OF HOLES DRILLED IN THE STRUCTURAL STEEL AS DETAILED ABOVE WILL BE PAID FOR AT THE CONTRACT PRICE FOR EACH HOLE. PRICE AND PAYMENT SHALL BE FULL COMPENSATION FOR FURNISHING ALL MATERIAL, LABOR, AND EQUIPMENT NECESSARY FOR DRILLING THE HOLES, GRINDING TO ENLARGE HOLES, AND NDT.

THE FOLLOWING HAS BEEN CARRIED TO THE ESTIMATED QUANTITIES:

ITEM 513 - STRUCTURAL STEEL, MISC.: DRILLING STRUCTURAL STEEL, GRINDING, AND NDT.....13 EACH

ITEM 514 - FIELD PAINTING STRUCTURAL STEEL, FINISH COAT, AS PER PLAN

FOR LOCATIONS 1 (CUY-71-0579 AND 2 (CUY-71-0856), THE FINAL PAINT COLOR SHALL CLOSELY MATCH THE EXISTING BRIDGE COLOR, AS APPROVED BY THE ENGINEER.

ITEM 519 - PATCHING CONCRETE BRIDGE DECK - TYPE B (FOR OVERNIGHT REPAIRS)

FOR LOCATION 7 (CUY-480-0501)

A. DESCRIPTION:

THIS ITEM SHALL CONSIST OF FURNISHING THE NECESSARY LABOR, MATERIALS AND EQUIPMENT TO REPAIR CONCRETE BRIDGE DECKS, INCLUDING THE REMOVAL OF ALL LOOSE AND UNSOUND CONCRETE, BITUMINOUS PATCHES, SURFACE PREPARATION, BONDING COAT AND THE MIXING, PLACING, FINISHING AND CURING OF THE MORTAR OR CONCRETE PATCHES.

B. MATERIALS:

MATERIALS SHALL CONFORM TO THE FOLLOWING REQUIREMENTS:

| | |
|--|------------------------|
| FINE AGGREGATE (NATURAL SAND) | 703.02 |
| COARSE AGGREGATE (NO. 8) | 703.02 |
| PORTLAND CEMENT | 701.05 |
| QUICK SETTING CONCRETE MORTAR, TYPE 1 OR 2 | 705.21 |
| AIR-ENTRAINING ADMIXTURE | 705.10 |
| CURING MATERIALS - TYPE A OR B PATCHES | 705.07 |
| CURING MATERIALS - TYPE C PATCHES | MFGR'S RECOMMENDATIONS |

C. REMOVAL OF UNSOUND CONCRETE:

THE ENGINEER SHALL SOUND AND OUTLINE THE AREAS TO BE REMOVED PER DIRECTION OF THE ENGINEER. SOUNDING MAY HAVE TO BE DELAYED UNTIL THE DECK IS SUFFICIENTLY DRY TO PERMIT DETECTION OF ALL AREAS OF DELAMINATION. THE PERIMETER OF ALL REMOVAL AREAS SHALL BE SAWS TO A DEPTH OF 1 INCH TO PRODUCE A VERTICAL OR SLIGHTLY UNDERCUT FACE. ADDITIONAL SAWCUTS MAY BE REQUIRED TO FACILITATE REMOVAL. ALL UNSOUND CONCRETE INCLUDING ALL PATCHES OTHER THAN SOUND PORTLAND CEMENT CONCRETE, AND ALL LOOSE AND DISINTEGRATED CONCRETE SHALL BE REMOVED. THE UNSOUND CONCRETE MAY BE REMOVED BY CHIPPING OR HAND DRESSING. CHIPPING HAMMERS SHALL NOT BE HEAVIER THAN THE NOMINAL 35 POUND CLASS AND SHALL BE OPERATED AT AN ANGLE OF LESS THAN 45 DEGREES MEASURED FROM THE SURFACE OF THE DECK. CONCRETE SHALL BE REMOVED IN A MANNER THAT PREVENTS CUTTING, ELONGATING OR DAMAGING REINFORCING STEEL. WHERE THE BOND BETWEEN CONCRETE AND A PRIMARY REINFORCING BAR HAS BEEN DESTROYED, OR WHERE MORE THAN ONE HALF OF THE PERIPHERY OF SUCH A BAR HAS BEEN EXPOSED, THE ADJACENT CONCRETE SHALL BE REMOVED

TO A DEPTH THAT WILL PROVIDE A MINIMUM 3/4 INCH CLEARANCE AROUND THE BAR EXCEPT WHERE OTHER REINFORCING BARS MAKE THIS IMPRACTICABLE. REINFORCEMENT WHICH HAS BECOME LOOSE SHALL BE ADEQUATELY SUPPORTED AND TIED BACK INTO PLACE. AFTER COMPLETION OF THE SECONDARY REMOVAL OPERATIONS, THE ENGINEER WILL RE-SOUND THE DECK TO ENSURE THAT ONLY SOUND CONCRETE REMAINS. MINIMIZE CONSTRUCTION JOINTS. CONSTRUCTION JOINTS SHALL ONLY BE PLACED ON THE PERIMETER OF THE REMOVAL AREAS.

D. SURFACE PREPARATION:

CLEANING SHALL CLOSELY PRECEDE APPLICATION OF THE BONDING GROUT AND/OR THE PATCHING MATERIAL. THE SURFACE TO BE PATCHED AND THE EXPOSED REINFORCING STEEL SHALL BE THOROUGHLY CLEANED BY SANDBLASTING FOLLOWED BY AN AIR BLAST. IT MAY BE NECESSARY TO USE HAND TOOLS TO REMOVE SCALE FROM THE REINFORCING STEEL. FOR TYPE A AND TYPE B PATCHES AND TYPE C PATCHES WHICH DO NOT USE WATER AS THE ACTIVATOR, THE PREPARED SURFACE SHALL BE SURFACE DRY. FOR TYPE C PATCHES WHICH REQUIRE WATER AS THE ACTIVATOR, THE PREPARED SURFACE SHALL BE LEFT IN THE CONDITION AS RECOMMENDED BY THE MANUFACTURER. ANY ADDITIONAL SURFACE PREPARATION SHALL BE IN ACCORDANCE WITH THE MANUFACTURER'S RECOMMENDATIONS FOR THE PATCHING MATERIAL WHICH IS USED.

E. BONDING GROUT:

THE GROUT FOR BONDING TYPE A PATCHES SHALL CONSIST OF EQUAL PARTS BY VOLUME OF PORTLAND CEMENT AND SAND, MIXED WITH SUFFICIENT WATER TO FORM A STIFF SLURRY. THE CONSISTENCY OF THIS SLURRY SHALL BE SUCH THAT IT CAN BE APPLIED WITH A STIFF BRUSH OR BROOM TO THE EXISTING SURFACE IN A THIN, UNIFORM COATING. THE COATING OF GROUT SHALL BE SCRUBBED ONTO THE DRY SURFACE IMMEDIATELY BEFORE PLACING THE CONCRETE. CARE SHALL BE EXERCISED TO ENSURE THAT NO EXCESS GROUT IS PERMITTED TO COLLECT IN LOW SPOTS. IN NO CASE SHALL THE GROUT BE PERMITTED TO DRY BEFORE PLACING THE NEW CONCRETE. THINNED GROUT SHALL BE PAINTED OVER ALL JOINTS BETWEEN THE NEW AND EXISTING CONCRETE IMMEDIATELY AFTER THE FINISHING HAS BEEN COMPLETED. TYPE B AND TYPE C PATCHES SHALL BE BONDED ACCORDING TO THE MANUFACTURER'S RECOMMENDATIONS.

F. PATCHING:

THE MORTAR OR CONCRETE SHALL BE PLACED AS TYPE A, B, OR C.

1. TYPE A - THE MIXTURE SHALL CONSIST OF 1 PART HIGH-EARLY-STRENGTH PORTLAND CEMENT, 1/2 PARTS FINE AGGREGATE AND 1/2 PARTS COARSE AGGREGATE BY VOLUME. SUFFICIENT AIR-ENTRAINING AGENT SHALL BE ADDED TO MAINTAIN AN AIR CONTENT OF 8 PLUS OR MINUS 2 PERCENT. THE SLUMP SHALL BE THE MINIMUM PRACTICAL FOR PLACING AND IN NO CASE SHALL IT EXCEED 2 INCHES. THE MATERIALS SHALL BE MIXED AT THE SITE. READY-MIXED CONCRETE SHALL NOT BE PERMITTED. THE MIX SHALL BE PLACED IN THE AREA TO BE PATCHED WHILE THE BONDING GROUT IS STILL WET, A SLIGHTLY OVERFILLED AND STRUCK OFF WITH A VIBRATING SCREED DRAWN SLOWLY ACROSS THE AREA. HAND FINISHING WITH A WOOD FLOAT MAY BE REQUIRED TO PRODUCE A TIGHT, UNIFORM SURFACE.
2. TYPE B - PATCHING MATERIAL SHALL BE MADE USING QUICK SETTING CONCRETE MORTAR, TYPE 1 OR 2, 705.21, AND SUITABLE FOR TRAFFIC AFTER OVERNIGHT CLOSURES WITH LIMITED CURING TIME. THE MORTAR SHALL BE MIXED AND PLACED AS PER MANUFACTURER'S RECOMMENDATIONS. COARSE AGGREGATE MAY BE ADDED IN ACCORDANCE WITH THE MANUFACTURER'S INSTRUCTIONS WHEN THE DEPTH OF THE PATCH EXCEEDS 1 INCH.
3. TYPE C - PATCHING MATERIAL SHALL BE MADE USING A BLEND OF 705.21 TYPE 2 MATERIAL AND SELECTED AGGREGATES WITH AN ACTIVATOR. THESE MATERIALS SHALL BE MIXED AND PLACED AS PER MANUFACTURER'S RECOMMENDATIONS. COARSE AGGREGATE MAY BE ADDED IN ACCORDANCE WITH THE MANUFACTURER'S INSTRUCTIONS WHEN THE DEPTH OF THE PATCH EXCEEDS 1 INCH.

G. CURING:

TYPE A PATCHES SHALL BE CURED IN ACCORDANCE WITH SECTION 511.17, METHOD (A), FOR NOT LESS THAN 24 HOURS IF MEMBRANE WATERPROOFING IS TO BE APPLIED IMMEDIATELY. IF NOT, METHOD (A) SHALL BE USED FOR 48 HOURS, AFTER WHICH THE MEMBRANE CURING MATERIAL SHALL BE APPLIED AT A RATE OF NOT LESS THAN ONE GALLON PER 200 SQUARE FEET. MEMBRANE CURING MATERIAL SHALL BE REMOVED PRIOR TO PLACING WATERPROOFING. TYPE B AND TYPE C PATCHES SHALL BE CURED IN ACCORDANCE WITH THE MANUFACTURER'S RECOMMENDATIONS.

H. METHOD OF MEASUREMENT:

THE QUANTITY SHALL BE THE ACTUAL AREA IN SQUARE YARDS OF THE EXPOSED SURFACE OF ALL PATCHES, IRRESPECTIVE OF THE DEPTH OF THE PATCH, COMPLETE, IN PLACE AND ACCEPTED.

I. BASIS OF PAYMENT:

PAYMENT SHALL BE MADE AT THE CONTRACT PRICE BID FOR:

| ITEM | UNIT | DESCRIPTION |
|---------|-------------|--|
| SPECIAL | SQUARE YARD | PATCHING CONCRETE BRIDGE DECKS, TYPE B (FOR OVERNIGHT REPAIRS) |

LOCATION 1

CUY-071-0579 (IR-71 OVER FOWLES ROAD)

ITEM 513- STRUCTURAL STEEL FOR REHABILITATION, AS PER PLAN (BOTTOM FLANGE RETROFITS)

THE BRIDGE REPAIRS REQUIRE THE INSTALLATION OF NEW BOLTED COMPRESSION SPLICE PLATES TO THE BOTTOM FLANGE NEAR THE PIERS. THE SKEW OF THE BRIDGE WILL LIKELY CAUSE SOME LOCATIONS OF INTERFERENCE WITH THE PERPENDICULAR CROSS FRAMES WITH THIS RETROFIT WORK. THE CLOSENESS OF THE LOWER CHORD OF THE CROSS FRAMES TO THE TOP OF THE BOTTOM FLANGE WILL CAUSE DIFFICULTIES INSTALLING THE SPLICE PLATES, DRILLING THE BOLT HOLES, AND INSTALLING BOLTS. IN THESE LOCATIONS THE CONTRACTOR CAN EITHER REMOVE THE BOTTOM CROSS FRAME CHORD (AND MODIFY THE ENDS OF THE DIAGONALS) AND EVENTUALLY RELOCATED IT TO A HIGHER LEVEL OR REPLACE THE CROSS FRAMES WITH SMALLER MEMBERS. THE CONTRACTOR IS FREE TO MODIFY AND REUSE THE EXISTING CROSS FRAME MEMBERS PROVIDED THAT THERE ARE QUALITY WELD CONNECTIONS TO THE BEAM WEB AND AMONG THE CROSS FRAME MEMBERS. THIS WORK SHALL BE INCIDENTAL TO THE INSTALLATION OF THE RETROFITS.

LOCATION 2


CUY-071-0856 (IR-71 OVER SYLVIA ROAD)

ITEM 513- STRUCTURAL STEEL FOR REHABILITATION, AS PER PLAN (BOTTOM FLANGE RETROFITS)

THE BRIDGE REPAIRS REQUIRE THE INSTALLATION OF NEW BOLTED COMPRESSION SPLICE PLATES TO THE BOTTOM FLANGE NEAR THE PIERS. THE SKEW OF THE BRIDGE WILL LIKELY CAUSE SOME LOCATIONS OF INTERFERENCE WITH THE PERPENDICULAR CROSS FRAMES WITH THIS RETROFIT WORK. THE CLOSENESS OF THE LOWER CHORD OF THE CROSS FRAMES TO THE TOP OF THE BOTTOM FLANGE WILL CAUSE DIFFICULTIES INSTALLING THE SPLICE PLATES, DRILLING THE BOLT HOLES, AND INSTALLING BOLTS. IN THESE LOCATIONS THE CONTRACTOR CAN EITHER REMOVE THE BOTTOM CROSS FRAME CHORD (AND MODIFY THE ENDS OF THE DIAGONALS) AND EVENTUALLY RELOCATED IT TO A HIGHER LEVEL OR REPLACE THE CROSS FRAMES WITH SMALLER MEMBERS. THE CONTRACTOR IS FREE TO MODIFY AND REUSE THE EXISTING CROSS FRAME MEMBERS PROVIDED THAT THERE ARE QUALITY WELD CONNECTIONS TO THE BEAM WEB AND AMONG THE CROSS FRAME MEMBERS. THIS WORK SHALL BE INCIDENTAL TO THE INSTALLATION OF THE RETROFITS.


| | |
|---|----------------------------------|
| RICHLAND ENGINEERING LIMITED 29 NORTH PARK STREET MANSFIELD, OHIO 44902 | |
| DATE 8/2020 | REVIEWED DLR |
| FILE NUMBER VARIOUS | STRUCTURE FILE NUMBER VARIOUS |
| DESIGNED BLN | DRAWN JLS |
| CHECKED dht | REVISED |
| STRUCTURE GENERAL NOTES - 3 | |
| D12-BH-FY2021(A) MISC | |
| PID No. 103162 | |
| 3 / 3 | |
| 26 96 | |

F:\2016\116041 D12 Bridge Rehab\12-BH-FY2021 Group 5\ProjectData\103162\Design\Structures\CUY071_0579\Sheets\071_0579GP001.dgn 3/25/2021 2:30:19 PM smorr

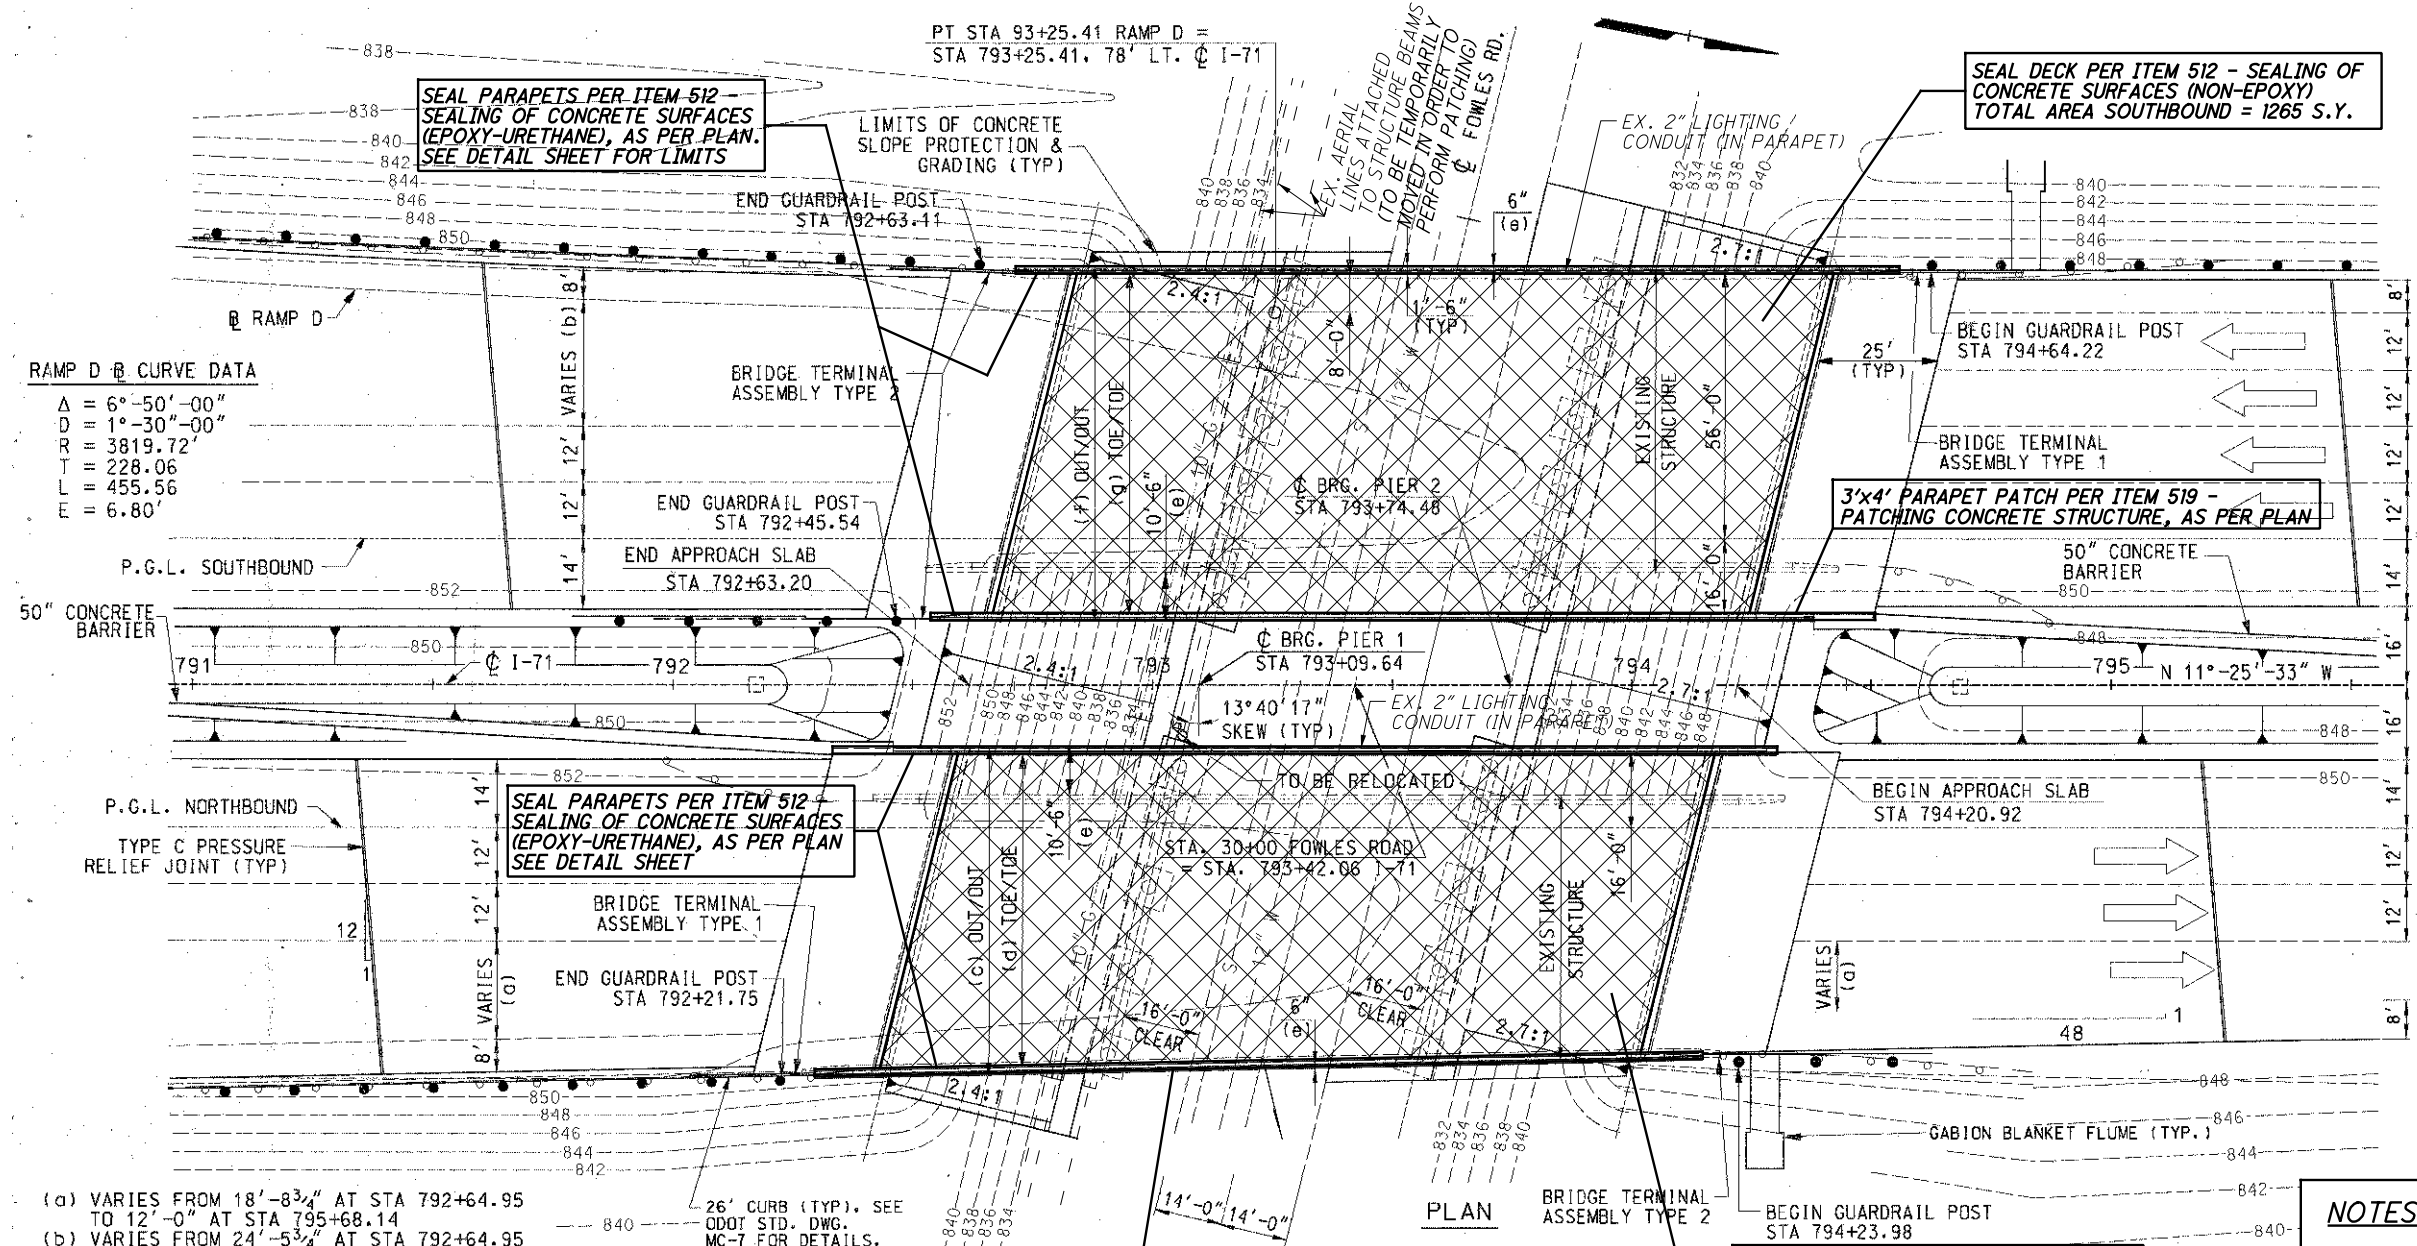

- (a) VARIES FROM 18'-8 3/4" AT STA 792+64.95 TO 12'-0" AT STA 795+68.14
- (b) VARIES FROM 24'-5 3/4" AT STA 792+64.95 TO 24'-0" AT STA 793+25.41
- (c) VARIES FROM 69'-9 1/2" AT STA. 792+44.93 TO 66'-5 1/4" AT STA 794+06.05
- (d) VARIES FROM 66'-9 1/2" AT STA. 792+44.93 TO 63'-5 1/4" AT STA 794+06.05
- (e) WIDENING, OUT. EXISTING TO OUT. PROPOSED
- (f) VARIES FROM 75'-5 3/4" AT STA 792+64.95 TO 75'-0" AT STA 793+25.41, 75'-0" STA AHEAD
- (g) VARIES FROM 72'-5 3/4" AT STA 792+64.95 TO 72'-0" AT STA 793+25.41, 72'-0" STA AHEAD

- NOTES:**
1. DETAILS ON THIS SHEET ARE TAKEN FROM EXISTING PLANS AND SHOULD BE USED FOR INFORMATION PURPOSES ONLY.
 2. PERFORM ONLY THE WORK AS INDICATED IN THE STRUCTURE DATA SHEET, FRAMED TEXT, AND/OR DESCRIBED IN THE GENERAL NOTES.
 3. FOR ESTIMATED QUANTITIES SEE SHEET [2/9].
 4. THE CONTRACTOR SHALL CONTACT VERIZON PRIOR TO CONSTRUCTION TO COORDINATE THE TEMPORARY RELOCATION OF VERIZON'S AERIAL LINES THAT ARE ATTACHED TO THE BRIDGE. VERIZON WILL BE RESPONSIBLE FOR THE AERIAL LINE RELOCATION. SEE THE GENERAL NOTES FOR CONTACT INFORMATION.

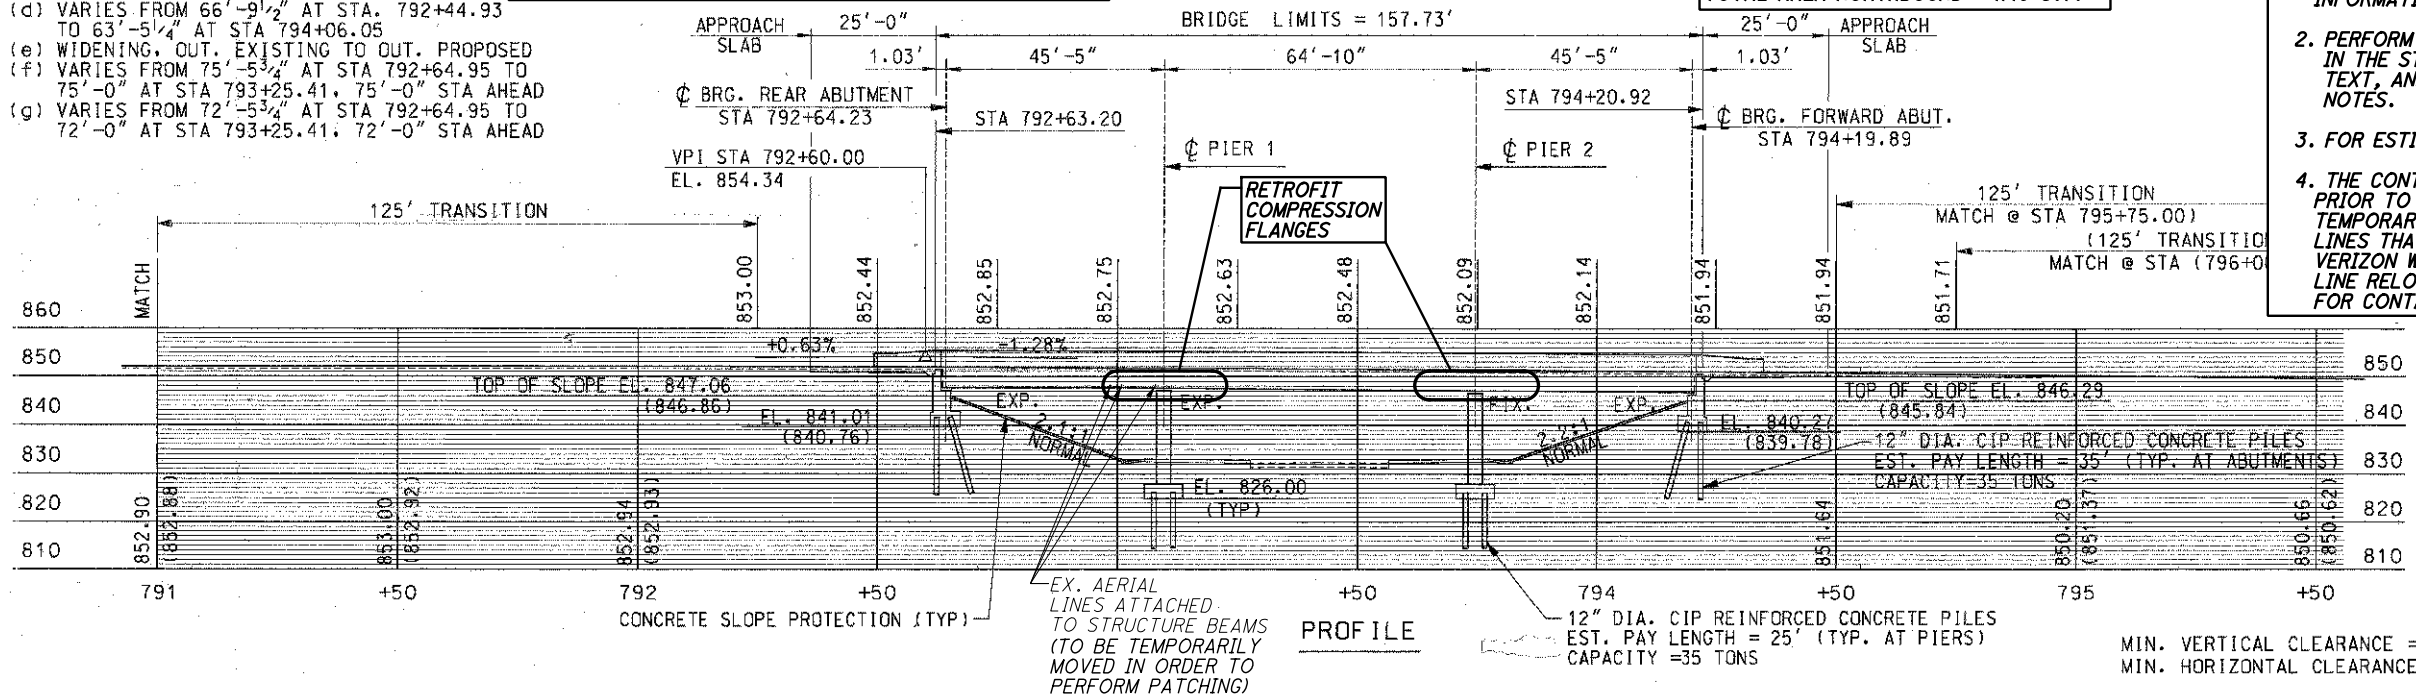


ESTIMATED QUANTITIES



CALCULATED JLS DATED 6/2020
 CHECKED dht DATED 6/2020

| ITEM | ITEM EXT. | TOTAL | UNIT | DESCRIPTION | SUPER. | PIERS | ABUTS. | GEN'L | REF. SHEET |
|---------|-----------|--------|------|--|--------|-------|--------|-------|------------|
| 202 | 11203 | LS | | PORTIONS OF STRUCTURE REMOVED, OVER 20 FOOT SPAN, AS PER PLAN | | | | LS | 24 |
| 512 | 10050 | 2405 | SY | SEALING OF CONCRETE SURFACES (NON-EPOXY) | 2405 | | | | |
| 512 | 10101 | 1072 | SY | SEALING OF CONCRETE SURFACES (EPOXY-URETHANE), AS PER PLAN | 512 | 537 | 23 | | 24 |
| 512 | 74001 | 539 | SY | REMOVAL OF EXISTING COATINGS FROM CONCRETE SURFACES, AS PER PLAN | | 527 | 12 | | 24 |
| 513 | 21600 | 12,887 | LB | STRUCTURAL STEEL FOR REHABILITATION, AS PER PLAN (BOTTOM FLANGE RETROFITS) | 12,887 | | | | 26 |
| 514 | 00100 | LS | | SURFACE PREPARATION OF EXISTING STRUCTURAL STEEL | | | | LS | |
| 514 | 00200 | LS | | FIELD PAINTING OF EXISTING STRUCTURAL STEEL, PRIME COAT | | | | LS | |
| 514 | 00300 | LS | | FIELD PAINTING STRUCTURAL STEEL, INTERMEDIATE COAT | | | | LS | |
| 514 | 00401 | LS | | FIELD PAINTING STRUCTURAL STEEL, FINISH COAT, AS PER PLAN | | | | LS | 26 |
| SPECIAL | 51900100 | 556 | SF | COMPOSITE FIBER WRAP SYSTEM | | 556 | | | 25 |
| 519 | 11101 | 284 | SF | PATCHING CONCRETE STRUCTURE, AS PER PLAN | 92 | 87 | 105 | | 24 |
| 844 | 10001 | 9 | SF | CONCRETE PATCHING WITH GALVANIC ANODE PROTECTION, AS PER PLAN | | 9 | | | 25 |

F:\2016\116041 D12 Bridge Rehab\12-BH-FY2021 Group 5\ProjectData\103162\Design\Structures\CUY071_0579\Sheets\071_0579SD001.dgn 3/25/2021 3:31:44 PM smorr

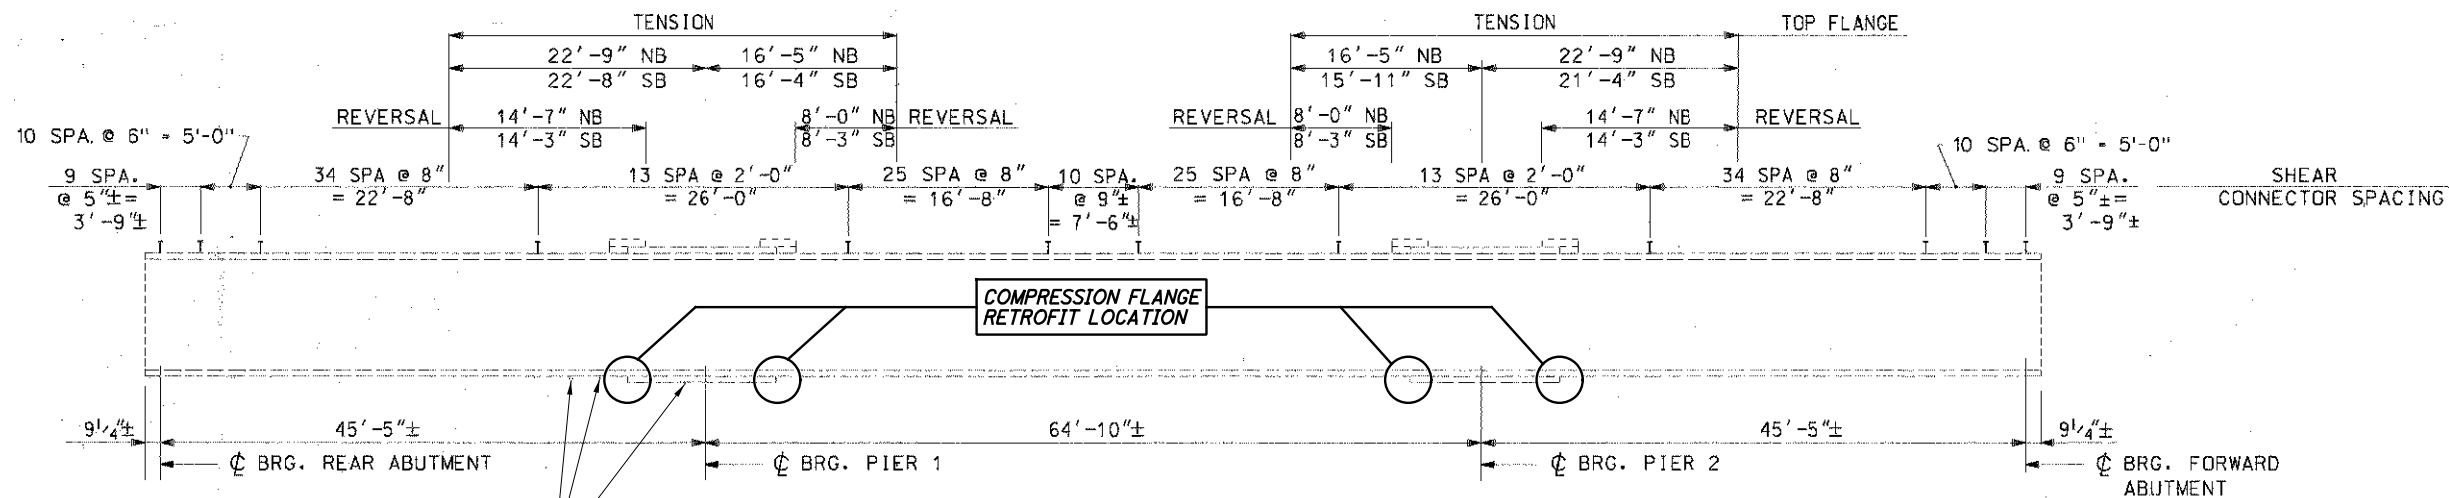

EX. AERIAL LINES ATTACHED TO STRUCTURE BEAMS (TO BE TEMPORARILY MOVED IN ORDER TO INSTALL RETROFIT PLATES)

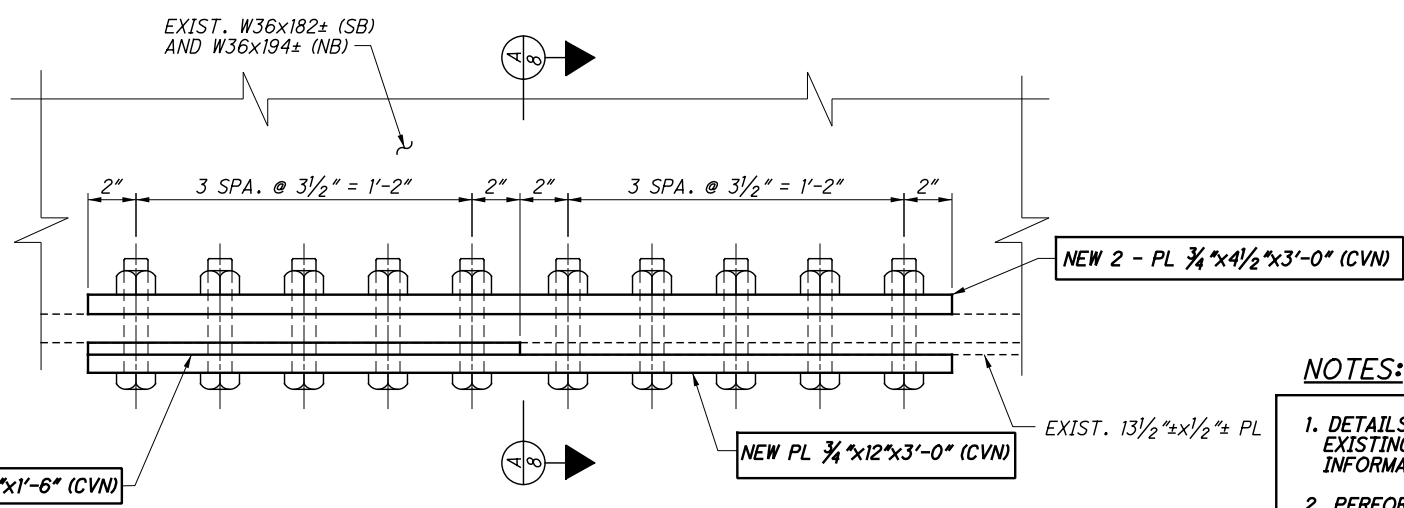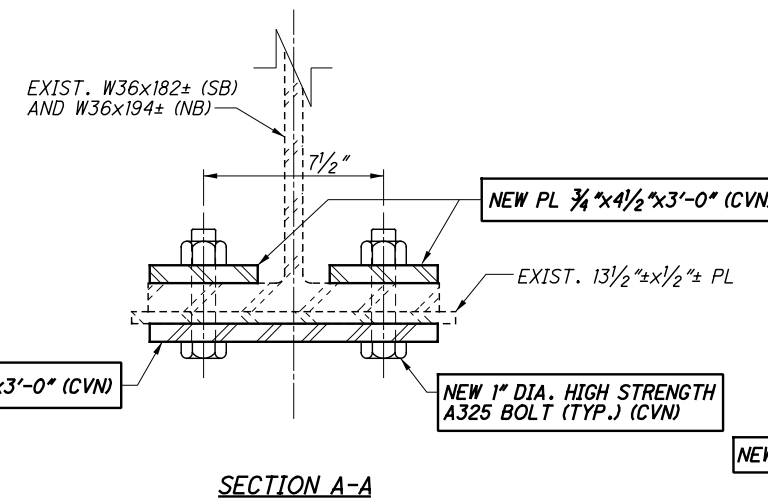

COMPRESSION FLANGE RETROFIT DETAILS

NOTES:

1. DETAILS ON THIS SHEET ARE TAKEN FROM EXISTING PLANS AND SHOULD BE USED FOR INFORMATION PURPOSES ONLY.
2. PERFORM ONLY THE WORK AS INDICATED IN THE STRUCTURE DATA SHEET, FRAMED TEXT, AND/OR DESCRIBED IN THE GENERAL NOTES.
3. MATERIALS SHOWN ARE EXISTING UNLESS OTHERWISE NOTED.
4. FOR ESTIMATED QUANTITIES SEE SHEET 2/9.
5. EXISTING STEEL SURFACES DAMAGED BY THE CONTRACTOR'S OPERATIONS DURING CONSTRUCTION SHALL BE REPAIRED. THE REPAIRS SHALL BE INCLUDED FOR PAYMENT WITH THE FOLLOWING ITEMS:
 - ITEM 514 - SURFACE PREPARATION OF EXISTING STRUCTURAL STEEL
 - ITEM 514 - FIELD PAINTING OF EXISTING STRUCTURAL STEEL, PRIME COAT
 - ITEM 514 - FIELD PAINTING STRUCTURAL STEEL, INTERMEDIATE COAT
 - ITEM 514 - FIELD PAINTING STRUCTURAL STEEL, FINISH COAT, AS PER PLAN
6. ALL NEW STEEL SURFACES SHALL BE PAINTED AND INCLUDED FOR PAYMENT WITH THE FOLLOWING ITEMS:
 - ITEM 514 - FIELD PAINTING STRUCTURAL STEEL, INTERMEDIATE COAT
 - ITEM 514 - FIELD PAINTING STRUCTURAL STEEL, FINISH COAT, AS PER PLAN

CVN: WHERE A SHAPE OR PLATE IS DESIGNATED (CVN), FURNISH MATERIAL THAT MEETS THE MINIMUM NOTCH TOUGHNESS REQUIREMENTS OF C&MS 711.01.

| | |
|--|---|
| RICHLAND ENGINEERING LIMITED 29 NORTH PARK STREET MANSFIELD, OHIO 44902 | |
| DATE 8/2020 | STRUCTURE FILE NUMBER 1804081(L) 1804111(R) |
| REVIEWED DLR | DESIGNED BLN |
| DRAWN JLS | CHECKED dnt |
| RETROFIT DETAILS - LOCATION 1 BRIDGE NO. CUY-71-0579 OVER CR 299 (FOWLES ROAD) | |
| D12-BH-FY2021(A) MISC PID No. 103162 | |
| 8 / 9 | |
| 34 96 | |

ESTIMATED QUANTITIES

CALCULATED JLS DATED 6/2020
 CHECKED dht DATED 6/2020

| ITEM | ITEM EXT. | TOTAL | UNIT | DESCRIPTION | SUPER. | PIERS | ABUTS. | GEN'L | REF. SHEET |
|---------|-----------|--------|------|---|--------|-------|--------|-------|-------------|
| 202 | 11203 | LS | | PORTIONS OF STRUCTURE REMOVED, OVER 20 FOOT SPAN, AS PER PLAN | | | | LS | 24 |
| 512 | 10101 | 298 | SY | SEALING OF CONCRETE SURFACES (EPOXY-URETHANE), AS PER PLAN | 287 | 6 | 5 | | 24 |
| 512 | 74001 | 6 | SY | REMOVAL OF EXISTING COATINGS FROM CONCRETE SURFACES, AS PER PLAN | | 3 | 3 | | 24 |
| 513 | 21501 | 639 | LB | REPLACEMENT OF DETERIORATED END CROSSFRAMES, AS PER PLAN | 639 | | | | 24, 45 & 46 |
| 513 | 21600 | 10,100 | LB | STRUCTURAL STEEL FOR REHABILITATION, AS PER PLAN (BOTTOM FLANGE RETROFITS) | 10,100 | | | | 26 |
| 514 | 00100 | LS | | SURFACE PREPARATION OF EXISTING STRUCTURAL STEEL | | | | LS | |
| 514 | 00200 | LS | | FIELD PAINTING OF EXISTING STRUCTURAL STEEL, PRIME COAT | | | | LS | |
| 514 | 00300 | LS | | FIELD PAINTING STRUCTURAL STEEL, INTERMEDIATE COAT | | | | LS | |
| 514 | 00401 | LS | | FIELD PAINTING STRUCTURAL STEEL, FINISH COAT, AS PER PLAN | | | | LS | 26 |
| 516 | 44101 | 38 | EACH | ELASTOMERIC BEARING WITH INTERNAL LAMINATES AND LOAD PLATE (NEOPRENE), (2.190"x8"x12" WITH 2 7/8" OR 2 1/2" LOAD PLATE WITH SHIMS), AS PER PLAN | 38 | | | | 47 |
| 516 | 47001 | LS | | JACKING AND TEMPORARY SUPPORT OF SUPERSTRUCTURE, AS PER PLAN | | | | LS | 24 |
| SPECIAL | 51900100 | 629 | SF | COMPOSITE FIBER WRAP SYSTEM | | 629 | | | 25 |
| 519 | 11101 | 93 | SF | PATCHING CONCRETE STRUCTURE, AS PER PLAN | 43 | 31 | 19 | | 24 |
| 844 | 10001 | 13 | SF | CONCRETE PATCHING WITH GALVANIC ANODE PROTECTION, AS PER PLAN | | 13 | | | 25 |

F:\2016\16041 D12 Bridge Rehab\D12-BH-FY2021 Group 5\ProjectData\103162\Design\Structures\CUY071_0856\Sheets\071_0856EQ001.dgn 3/25/2021 2:56:22 PM smorr

RICHLAND ENGINEERING LIMITED
 29 NORTH PARK STREET
 MANSFIELD, OHIO 44902

REVIEWED DATE 8/2020
 DLR 8/2020
 STRUCTURE FILE NUMBER 1804359

DESIGNED BLN
 CHECKED dht



ESTIMATED QUANTITY - LOCATION 2
 BRIDGE NO. CUY-71-0856
 OVER SYLVIA DRIVE

D12-BH-FY2021(A) MISC
 PID No. 103162

2 / 13

37
96

F:\2016\116041 D12 Bridge Rehab\12-BH-FY2021 Group 5\ProjectData\103162\Design\Structures\CUY071_0856\Sheets\071_0856SD001.dgn 3/25/2021 3:34:06 PM smorr

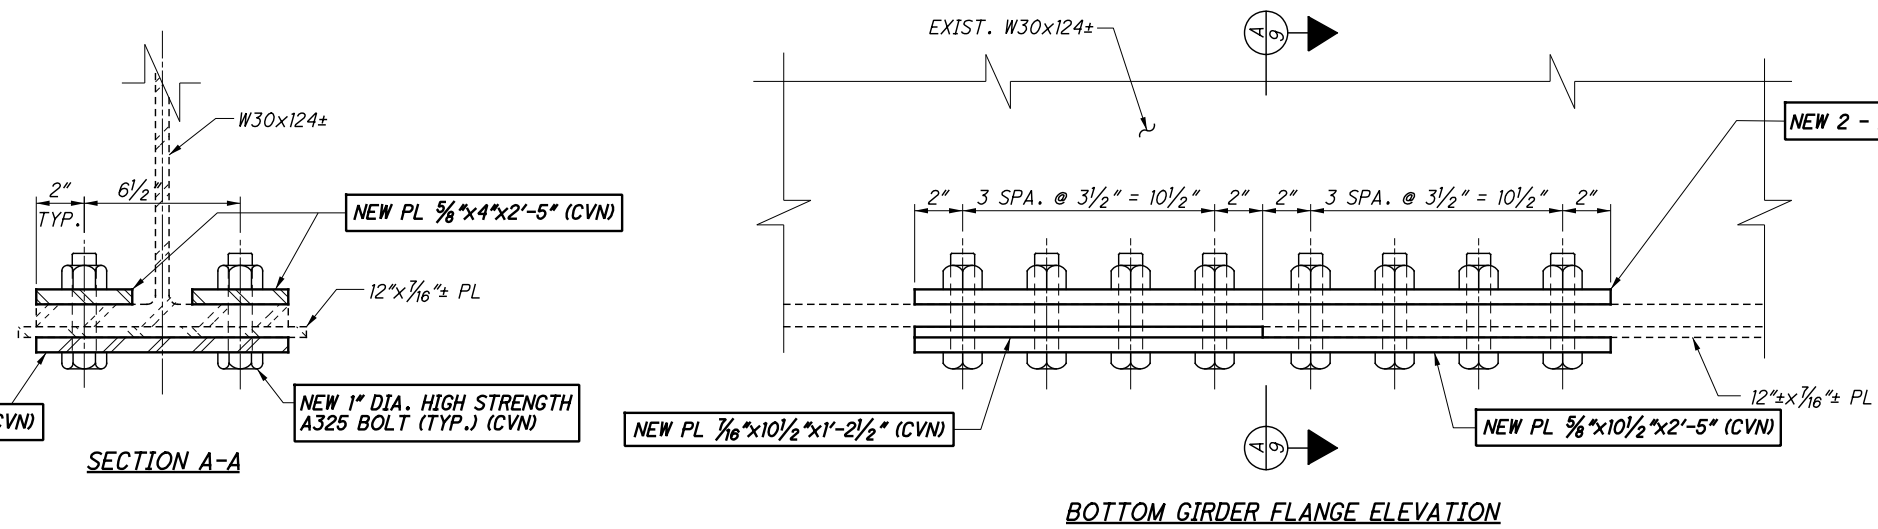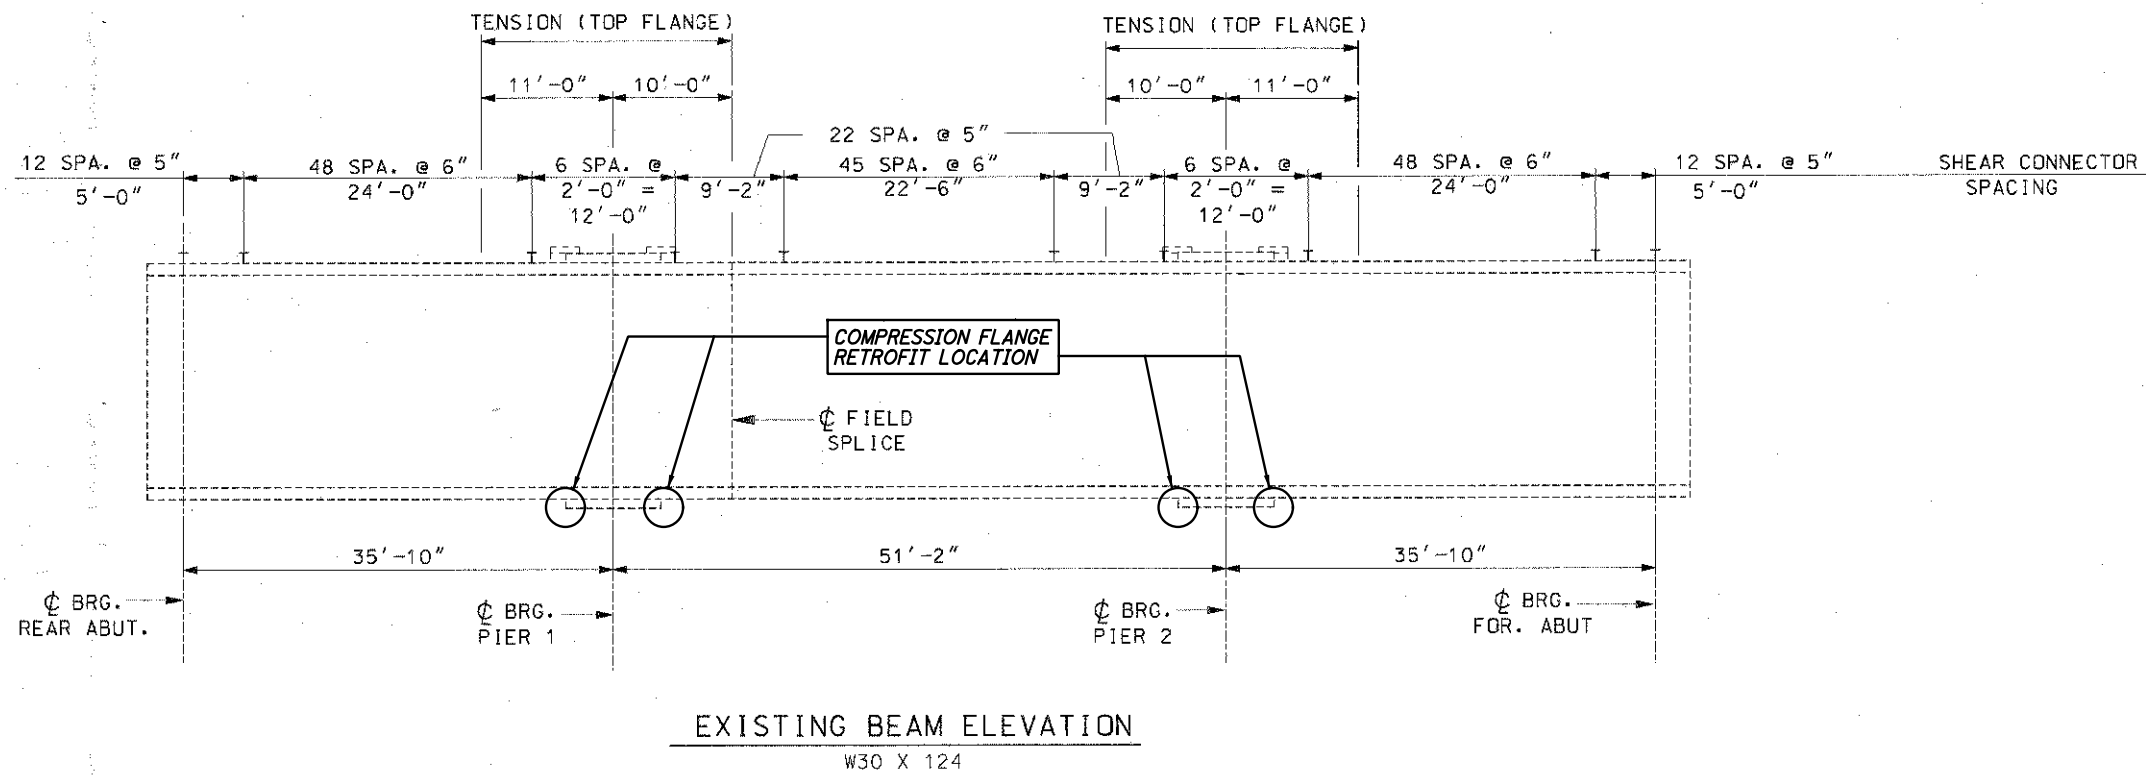

- NOTES:**
1. DETAILS ON THIS SHEET ARE TAKEN FROM EXISTING PLANS AND SHOULD BE USED FOR INFORMATION PURPOSES ONLY.
 2. PERFORM ONLY THE WORK AS INDICATED IN THE STRUCTURE DATA SHEET, FRAMED TEXT, AND/OR DESCRIBED IN THE GENERAL NOTES.
 3. MATERIALS SHOWN ARE EXISTING UNLESS OTHERWISE NOTED.
 4. FOR ESTIMATED QUANTITIES SEE SHEET [2/13].
 5. EXISTING STEEL SURFACES DAMAGED BY THE CONTRACTOR'S OPERATIONS DURING CONSTRUCTION SHALL BE REPAIRED. THE REPAIRS SHALL BE INCLUDED FOR PAYMENT WITH THE FOLLOWING ITEMS:
 - ITEM 514 - SURFACE PREPARATION OF EXISTING STRUCTURAL STEEL
 - ITEM 514 - FIELD PAINTING OF EXISTING STRUCTURAL STEEL, PRIME COAT
 - ITEM 514 - FIELD PAINTING STRUCTURAL STEEL, INTERMEDIATE COAT
 - ITEM 514 - FIELD PAINTING STRUCTURAL STEEL, FINISH COAT, AS PER PLAN
 6. ALL NEW STEEL SURFACES SHALL BE PAINTED AND INCLUDED FOR PAYMENT WITH THE FOLLOWING ITEMS:
 - ITEM 514 - FIELD PAINTING STRUCTURAL STEEL, INTERMEDIATE COAT
 - ITEM 514 - FIELD PAINTING STRUCTURAL STEEL, FINISH COAT, AS PER PLAN
- CVN:** WHERE A SHAPE OR PLATE IS DESIGNATED (CVN), FURNISH MATERIAL THAT MEETS THE MINIMUM NOTCH TOUGHNESS REQUIREMENTS OF C&MS 711.01.


STATE OF OHIO

DEPARTMENT OF TRANSPORTATION

D12-BH-FY2021(A) MISC(8-10) PART 2

FOR PART 1, SEE D12-BH-FY2021(A) MISC (1-7)

| LOCATION | BRIDGE NUMBER | STRUCTURAL FILE NUMBER | CITY | TOWNSHIP | VILLAGE |
|----------|---------------|------------------------|---------------|----------|---------|
| 8 | CUY-480-0612 | 1814168 | FAIRVIEW PARK | | |
| 9 | CUY-480-0616 | 1814176 | FAIRVIEW PARK | | |
| 10 | CUY-480-1075 | 1812912 | CLEVELAND | | |

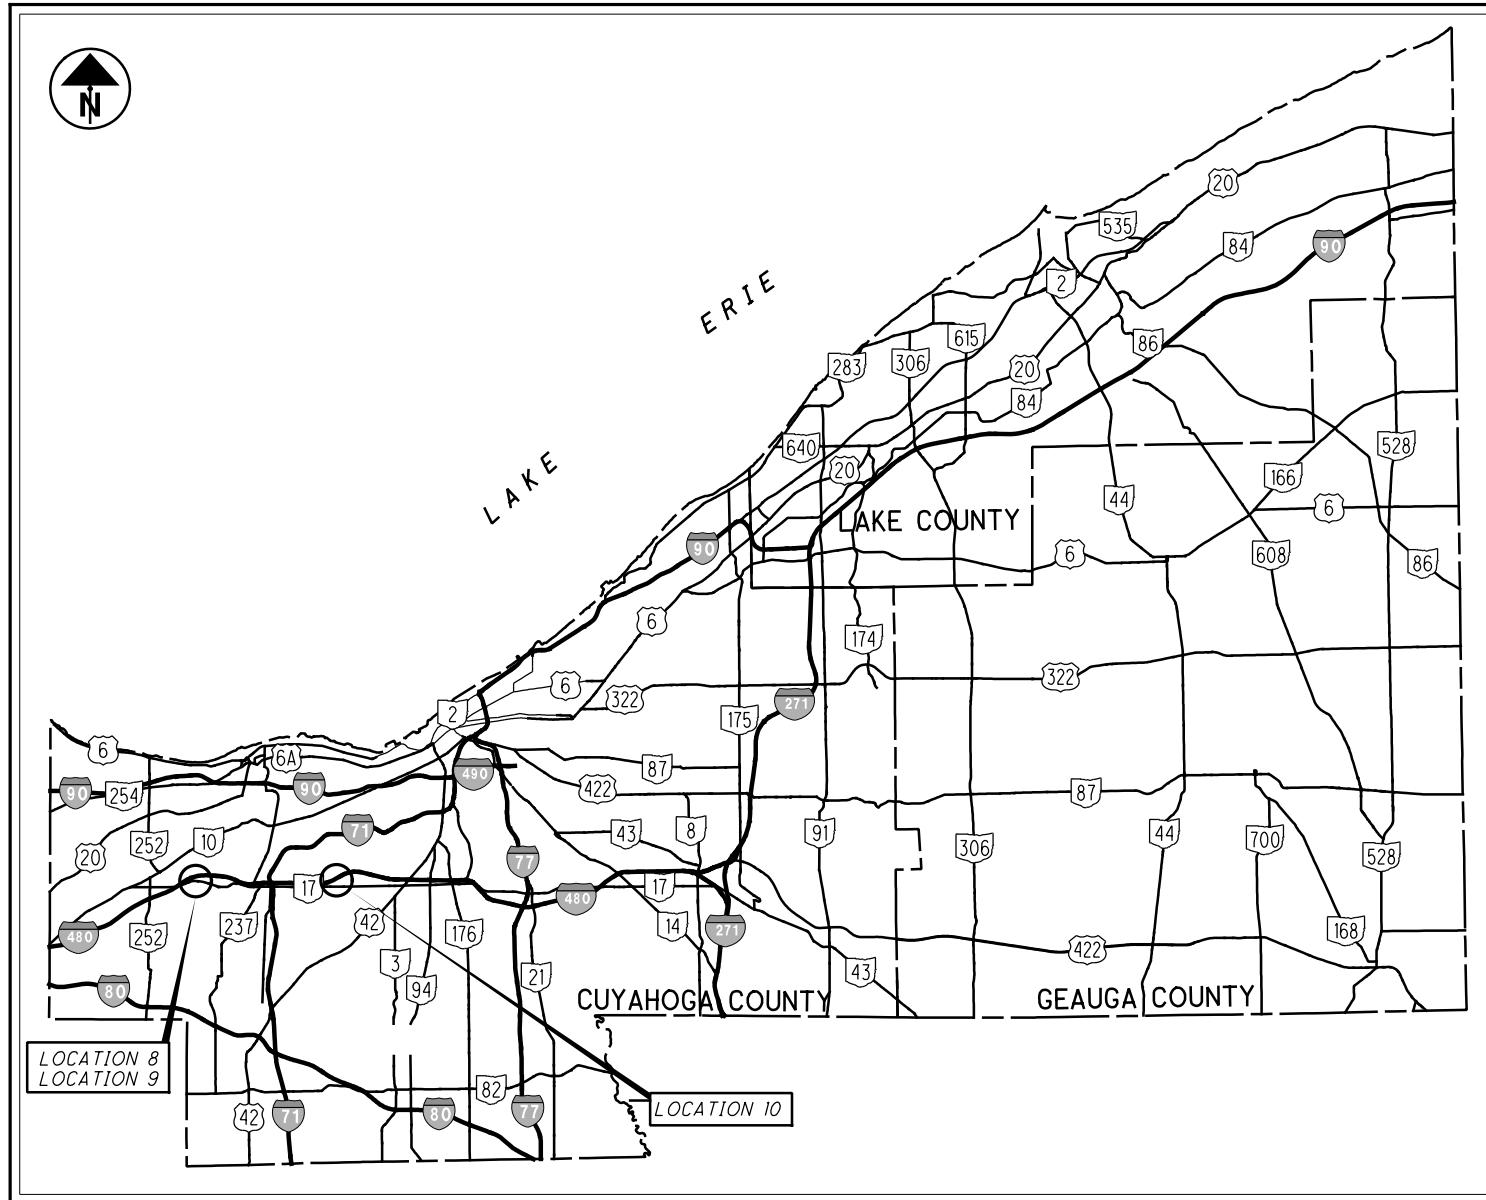

LOCATION MAP
 LATITUDE: 41°24'54" N LONGITUDE: 81°36'54" W
 (NOTE: FOR COORDINATES PER LOCATION, SEE SHEET 2)

INDEX OF SHEETS:

| | |
|--------------------------------|-------|
| TITLE | 1 |
| LOCATION MAP | 2 |
| GENERAL NOTES | 3-4 |
| MAINTENANCE OF TRAFFIC | 5-21 |
| GENERAL SUMMARY | 22-23 |
| STRUCTURE DATA TABLE AND NOTES | 24-25 |
| LOCATION 8 - CUY-480-0612 | 26-33 |
| LOCATION 9 - CUY-480-0616 | 34-40 |
| LOCATION 10 - CUY-480-1075 | 41-74 |

PROJECT DESCRIPTION

THIS PROJECT CONSISTS OF VARIOUS REPAIRS INCLUDING VANDAL FENCE REPLACEMENT, BEARING REPAIRS, CONCRETE REPAIRS AND STEEL REPAIRS.

THIS IS A MAINTENANCE PROJECT.

PROJECT EARTH DISTURBED AREA: N/A
 ESTIMATED CONTRACTOR EARTH DISTURBED AREA: N/A
 NOTICE OF INTENT EARTH DISTURBED AREA: N/A

2019 SPECIFICATIONS

THE STANDARD SPECIFICATIONS OF THE STATE OF OHIO, DEPARTMENT OF TRANSPORTATION, INCLUDING SUPPLEMENTAL SPECIFICATIONS LISTED IN THE PLANS AND CHANGES LISTED IN THE PROPOSAL SHALL GOVERN THIS IMPROVEMENT.

I HEREBY APPROVE THESE PLANS AND DECLARE THAT THE MAKING OF THIS IMPROVEMENT WILL NOT REQUIRE THE CLOSING TO TRAFFIC OF THE HIGHWAY EXCEPT FOR THE SIDE ROADS AS DESCRIBED ON SHEETS AND THAT PROVISIONS FOR THE MAINTENANCE AND SAFETY OF TRAFFIC WILL BE AS SET FORTH ON THE PLANS AND ESTIMATES.

APPROVED _____
 DATE _____ DISTRICT DEPUTY DIRECTOR

APPROVED _____
 DATE _____ DIRECTOR, DEPARTMENT OF TRANSPORTATION

UNDERGROUND UTILITIES

Contact Two Working Days
Before You Dig



OHIO811, 8-1-1, or 1-800-362-2764
 (Non-members must be called directly)

PLAN PREPARED BY:



ENGINEERS SEAL:
 FOR STRUCTURES OVER 20' SPAN

SIGNED: *Shane Kalinoski*
 DATE: 10/29/2020

ENGINEERS SEAL:
 FOR ENTIRE PLAN EXCEPT STRUCTURES OVER 20' SPAN


SIGNED: *Tony W. Grieshop*
 DATE: 10/29/2020

| STANDARD CONSTRUCTION DRAWINGS | SUPPLEMENTAL SPECIFICATIONS | SPECIAL PROVISIONS |
|--------------------------------|-----------------------------|--------------------|
| SEE PART 1 | SEE PART 1 | SEE PART 1 |

FEDERAL PROJECT NO. NON-FEDERAL
 PID NO. 103162
 CONSTRUCTION PROJECT NO.
 RAILROAD INVOLVEMENT CSX
 D12-BH-FY2021(A) MISC PID NO. 103162
 1/74

P:\DDT\12\0008_CUY_BH_FY2021(A)\103162_Design\Roadway\Sheets\103162_GTI001.dgn Sheet 3/24/2021 1:52:59 PM CMT026

P:\DDT\12\0008_CUY_BH_FY2021(A)\103162\Design\Structures\CUY480\1075C_Sheets\480_1075C_SP001.dgn Sheet 3/24/2021 2:23:27 PM CMT026

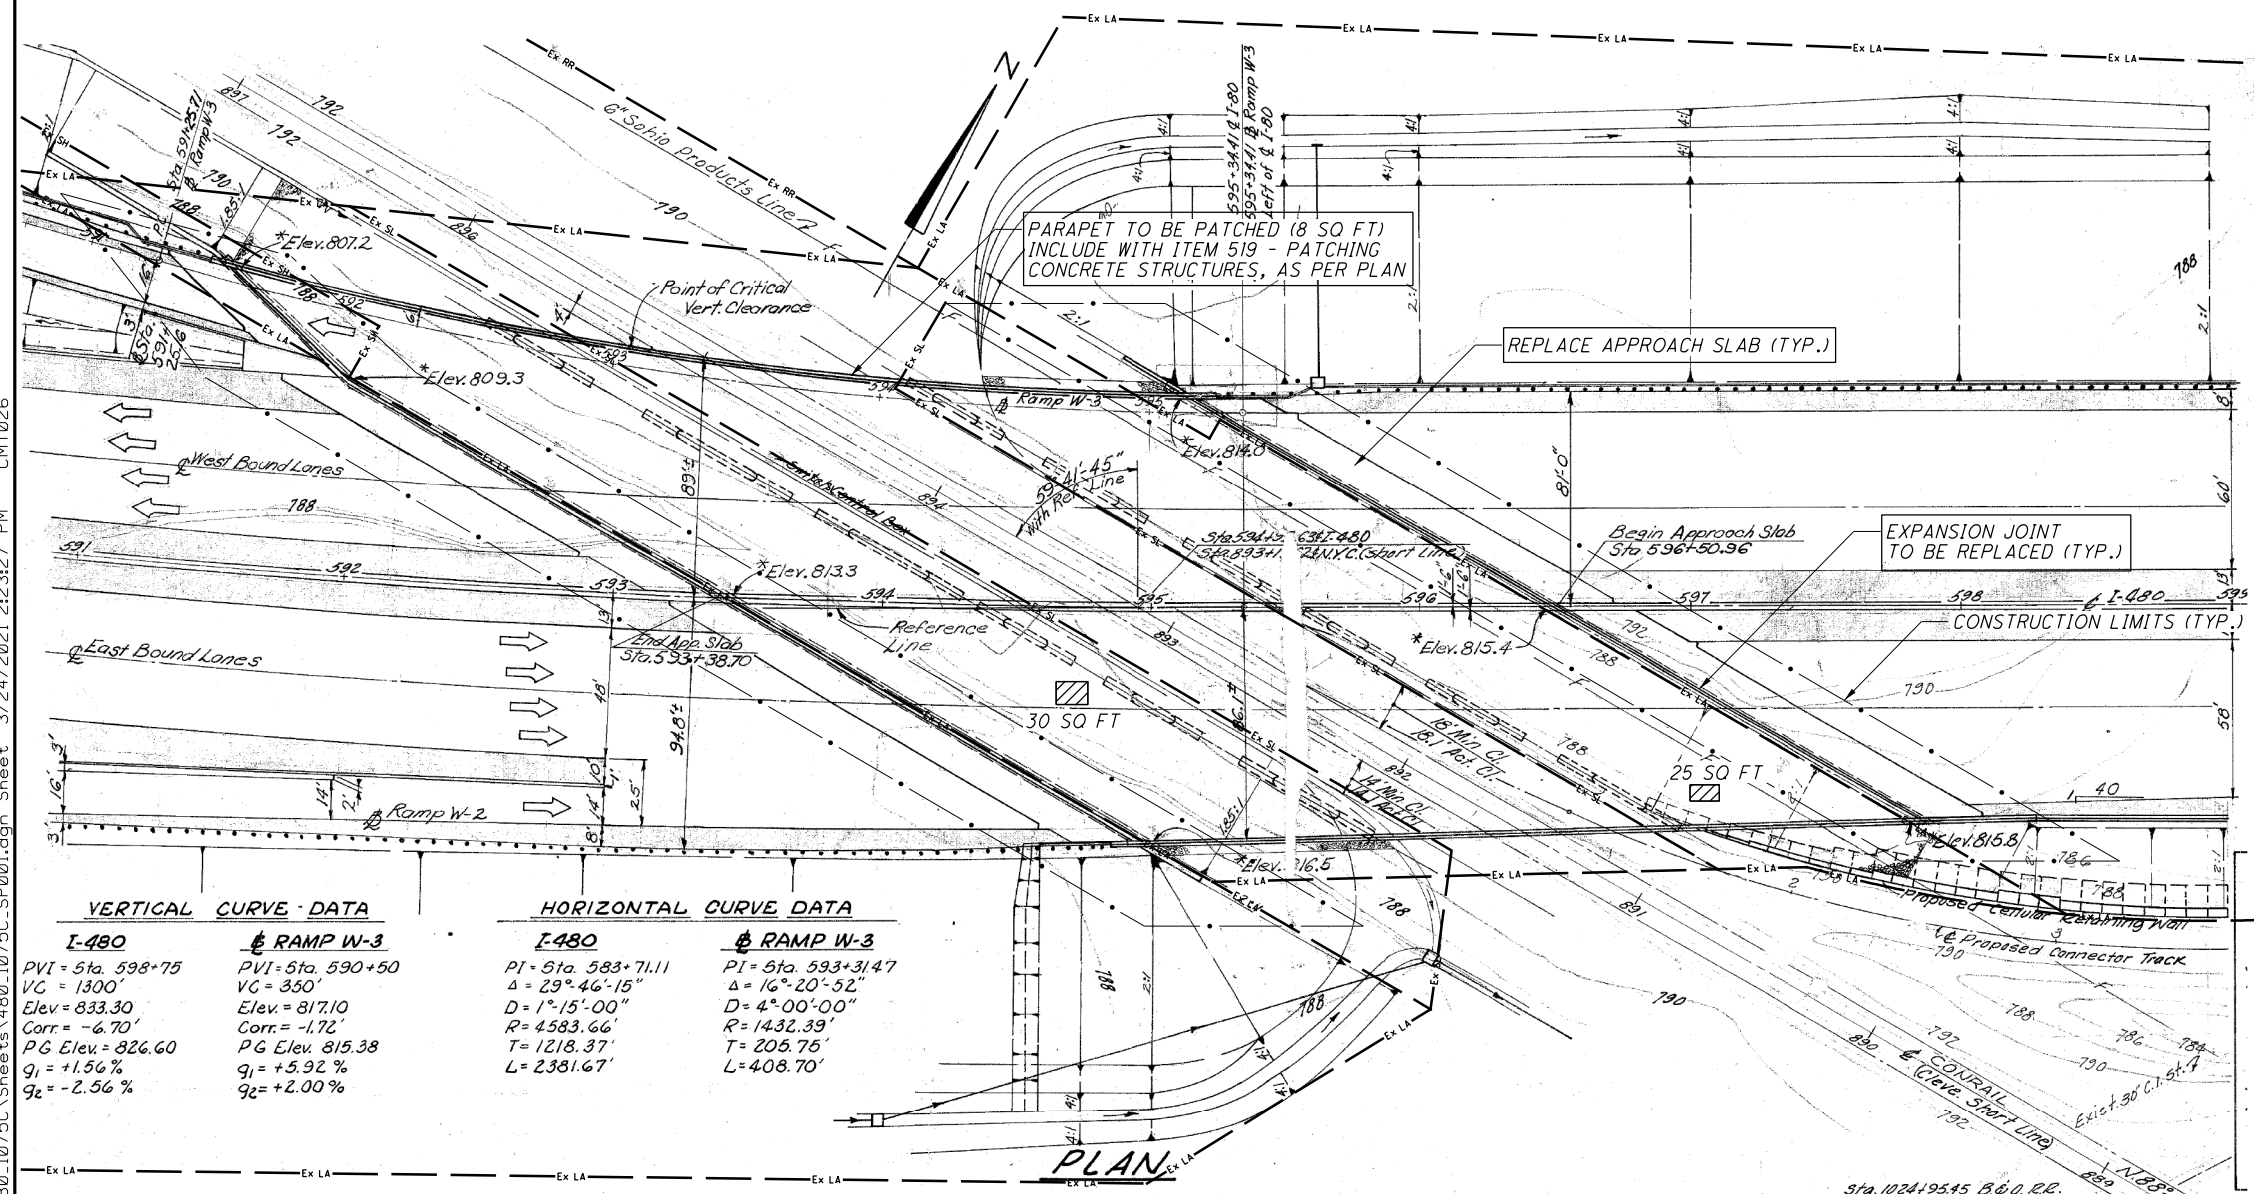

| VERTICAL CURVE DATA | | HORIZONTAL CURVE DATA | |
|-------------------------|-------------------------|-----------------------|---------------------|
| I-480 | RAMP W-3 | I-480 | RAMP W-3 |
| PVI = Sta. 598+75 | PVI = Sta. 590+50 | PI = Sta. 583+71.11 | PI = Sta. 593+31.47 |
| VC = 1300' | VC = 350' | Δ = 29° 46' 15" | Δ = 16° 20' 52" |
| Elev = 833.30 | Elev = 817.10 | D = 1° 15' 00" | D = 4° 00' 00" |
| Corr = -6.70' | Corr = -1.72' | R = 4583.66' | R = 1432.39' |
| PG Elev = 826.60 | PG Elev = 815.38 | T = 1218.37' | T = 205.75' |
| g ₁ = +1.56% | g ₁ = +5.92% | L = 2381.67' | L = 408.70' |
| g ₂ = -2.56% | g ₂ = +2.00% | | |

LEGEND

INDICATES CONCRETE REPAIR PER ITEM 519 - PATCHING CONCRETE BRIDGE DECKS, TYPE B. TOTAL AREA THIS SHEET = 55 S.F.

- NOTES:**
1. DETAILS ON THIS SHEET ARE TAKEN FROM EXISTING PLANS AND SHOULD BE USED FOR INFORMATION PURPOSES ONLY.
 2. PERFORM ONLY THE WORK AS INDICATED IN THE STRUCTURE DATA SHEET, FRAMED TEXT, AND/OR DESCRIBED IN THE GENERAL NOTES.
 3. FOR ESTIMATED QUANTITIES SEE SHEET 2/34.
 4. PATCH THE WEARING SURFACE PER PROPOSAL NOTE 512, TYPE B PATCH. PATCH ONLY THE AREAS SHOWN IN THE PLANS TO BE REPAIRED AS DIRECTED BY THE ENGINEER. AREAS THAT ARE DESIGNATED FOR REPAIR ARE AREAS THAT ARE PATCHED WITH ASPHALT, SPALLED, OR HEAVILY CRACKED. DELAMINATED AREAS IMMEDIATELY CONTIGUOUS TO THE DESIGNATED REPAIR AREAS SHALL BE REMOVED AND REPAIRED WITH THE SAME PATCH. AREAS OF THE WEARING SURFACE ARE KNOWN TO EXIST THAT ARE DELAMINATED WHEN SOUNDED BUT ARE NOT SHOWING VISIBLE SIGNS OF DISTRESS. THESE AREAS SHALL NOT BE REPAIRED UNLESS DIRECTED TO DO SO BY THE PROJECT ENGINEER AND DISTRICT BRIDGE ENGINEER. PAYMENT WILL BE BASED UPON THE ACTUAL QUANTITIES REPAIRED AND ACCEPTED BY THE ENGINEER. PATCHING ESTIMATED QUANTITIES HAVE BEEN INCREASED BY 50% OVER MEASURED QUANTITIES TO ACCOUNT FOR ADDITIONAL DETERIORATION.
 5. THE PARAPET PATCH SHALL BE SEALED 6" BEYOND THE PATCHING LIMITS USING EPOXY-URETHANE AND SHALL BE PAID WITH ITEM 512 - SEALING OF CONCRETE SURFACES (EPOXY-URETHANE), AS PER PLAN. TOTAL SEALING AREA THIS SHEET = 12 S.F.
 6. CONTRACTOR ACCESS SHALL BE RESTRICTED WITHIN THE CSX RAILROAD R/W.

