


CUY-17-14.99
CUYAHOGA COUNTY

COMPL: - Dec. 16, 1954
REV: - JAN. 13, 1955
REV: -

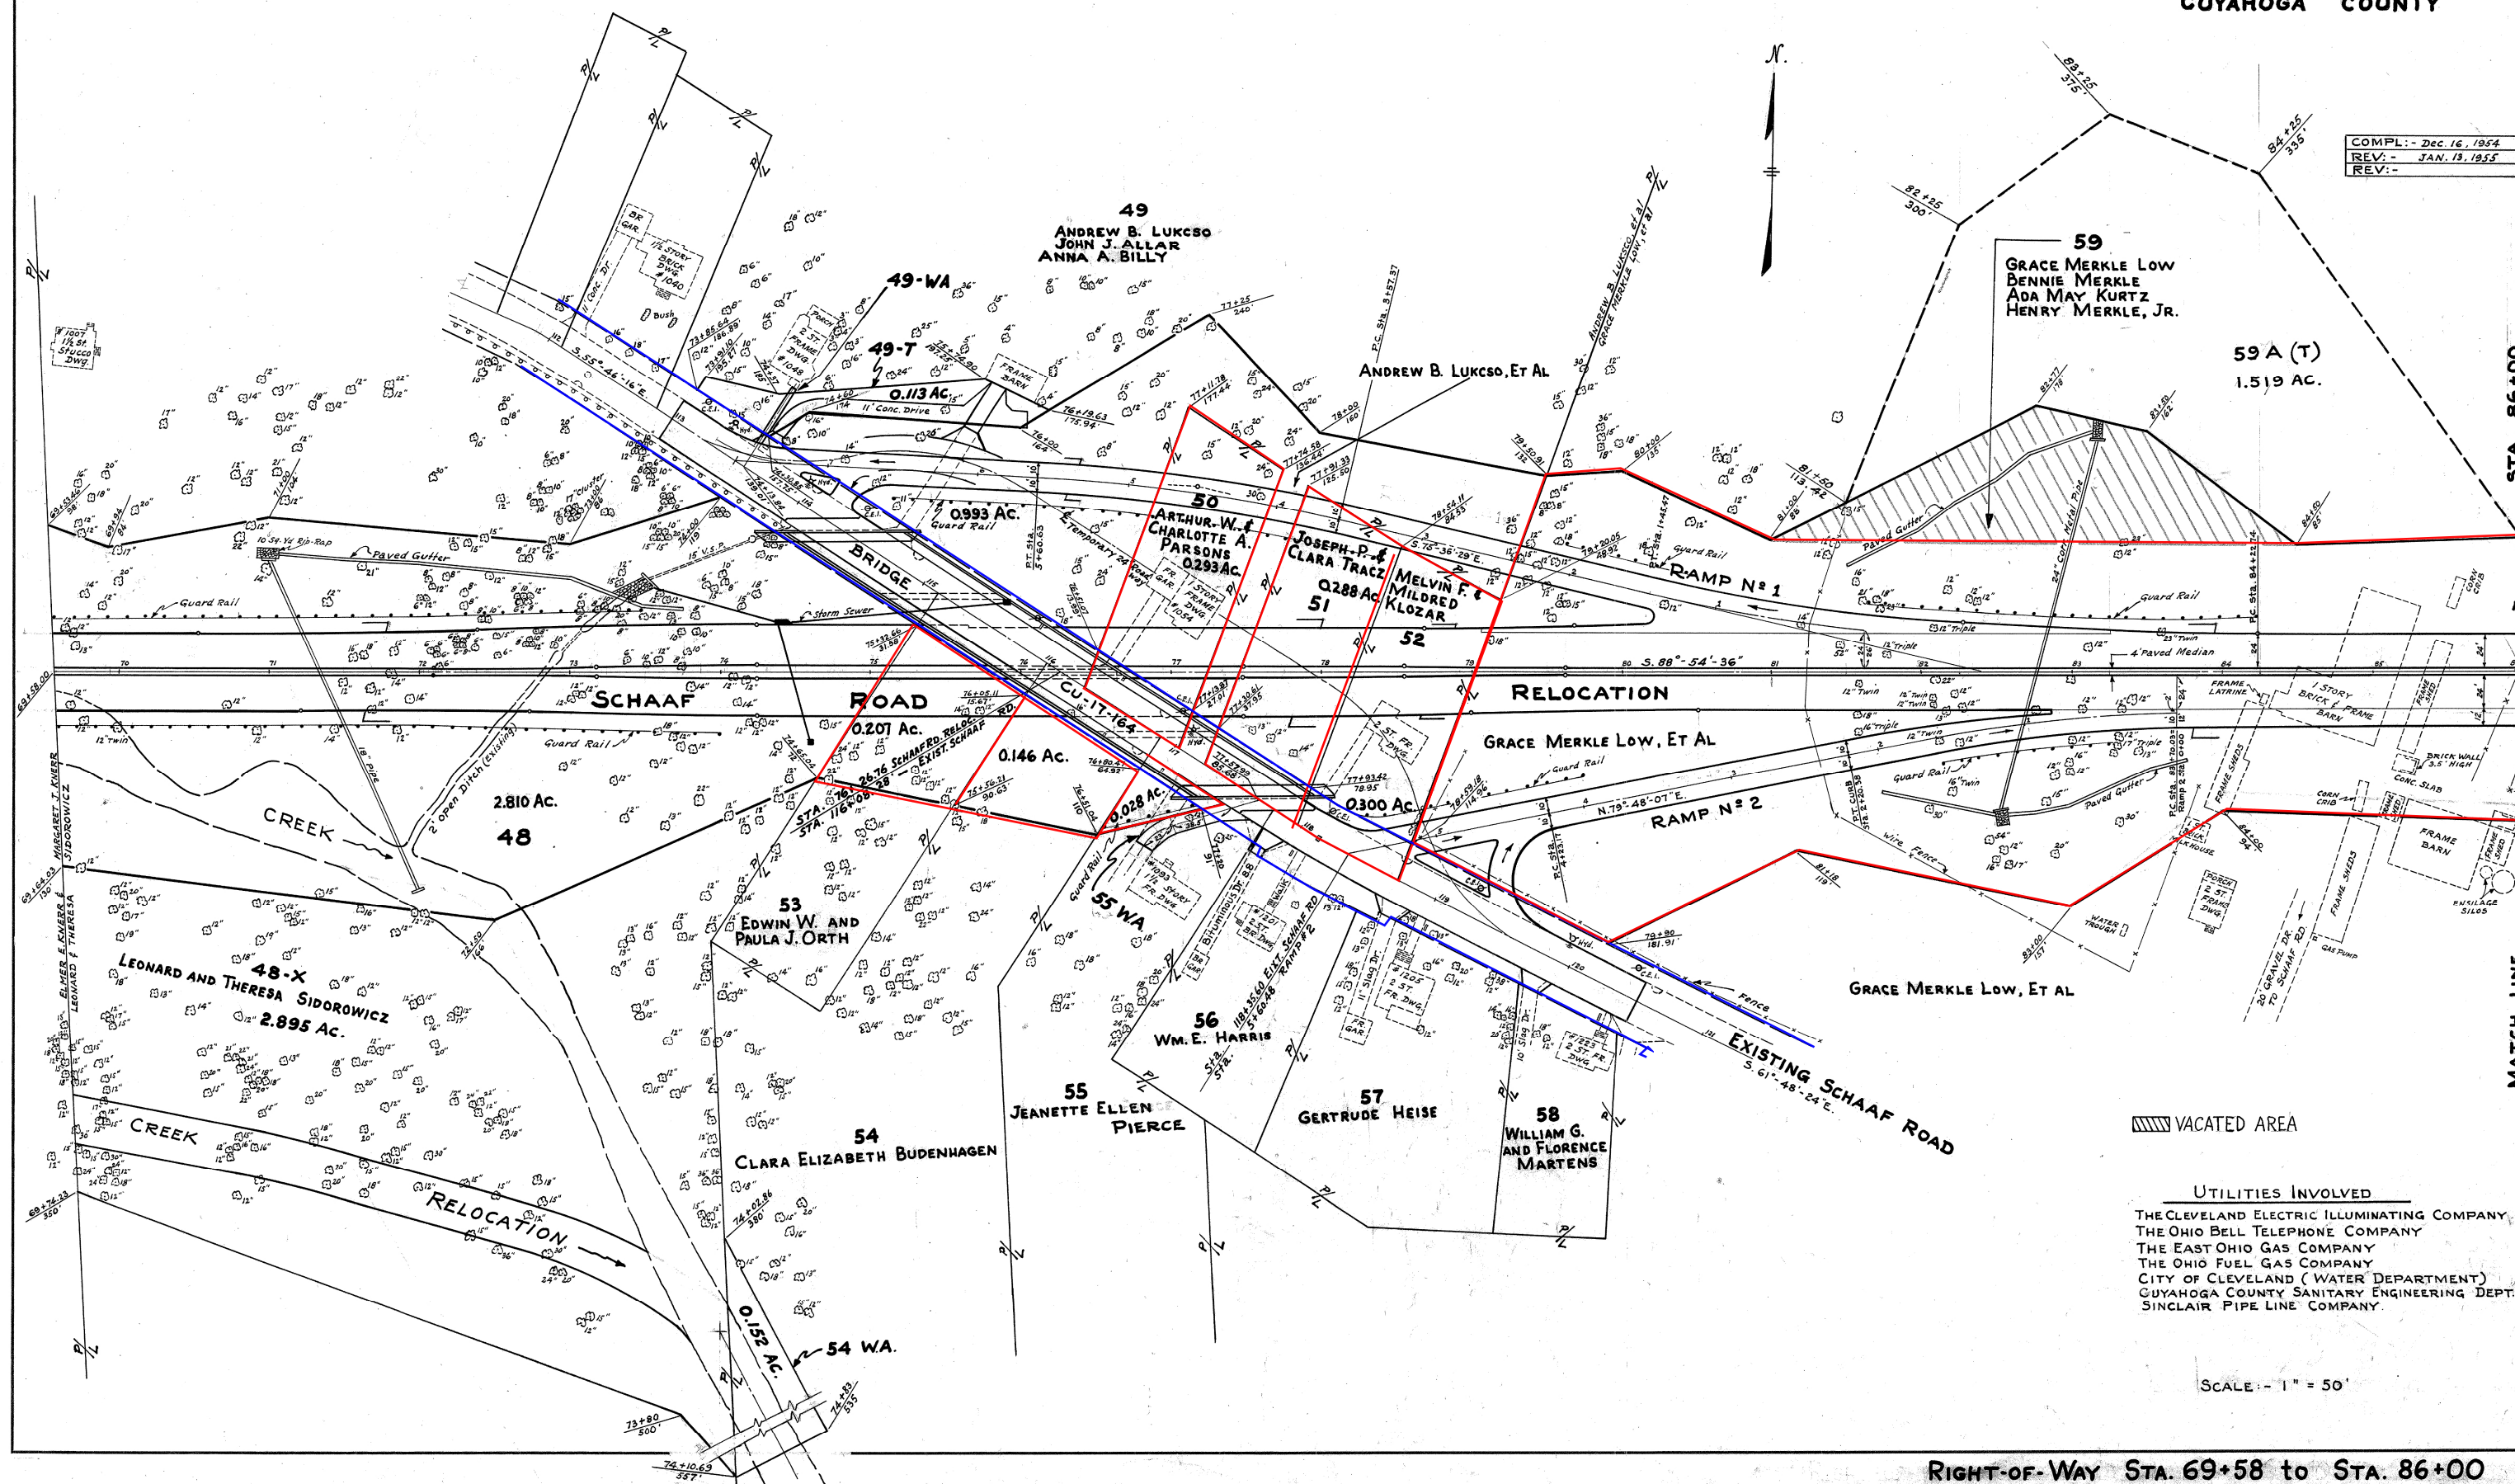

VACATED AREA

UTILITIES INVOLVED
 THE CLEVELAND ELECTRIC ILLUMINATING COMPANY
 THE OHIO BELL TELEPHONE COMPANY
 THE EAST OHIO GAS COMPANY
 THE OHIO FUEL GAS COMPANY
 CITY OF CLEVELAND (WATER DEPARTMENT)
 CUYAHOGA COUNTY SANITARY ENGINEERING DEPT.
 SINCLAIR PIPE LINE COMPANY

SCALE: - 1" = 50'

RIGHT-OF-WAY STA. 69+58 to STA. 86+00