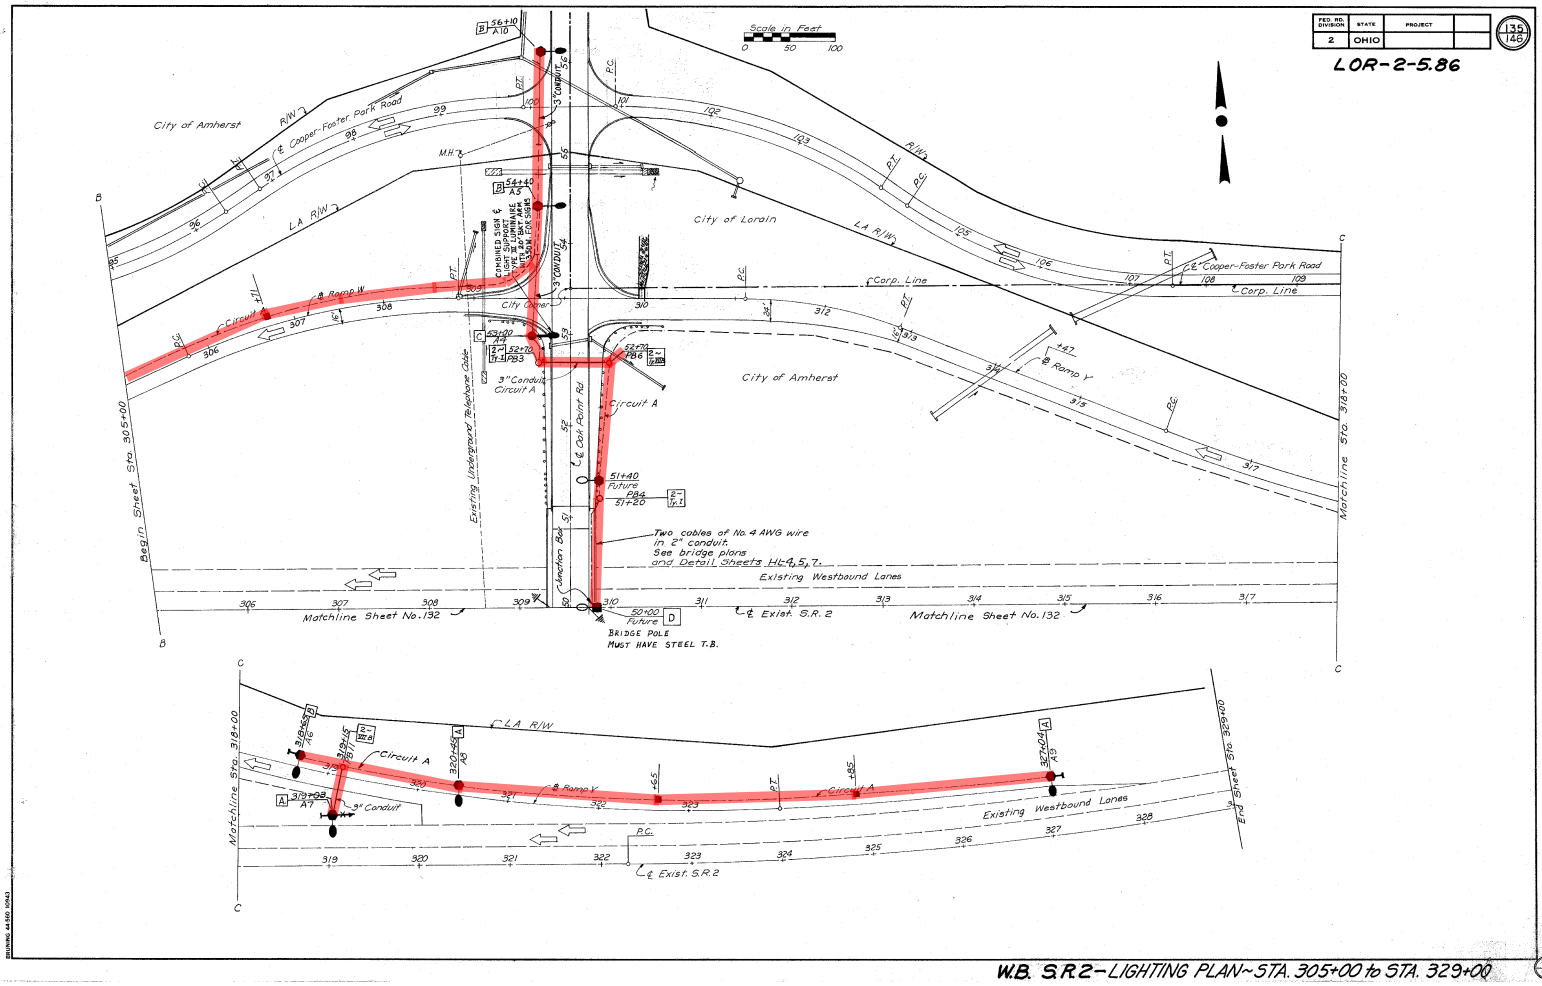

FED. RD. DIVISION 2 | STATE OHIO | PROJECT

135 / 146

LOR-2-5.86

W.B. S.R.2 – LIGHTING PLAN ~ STA. 305+00 to STA. 329+00