

ODOT Dist 4 - Portage Co - FINAL No Passing Zone Log (POR)

Page: 1 of 8


Route: 0305R (SPORSR00305**C)

From: 0.000 S0082R

Length: 7.333

Direction: East

To: 7.333 ENTER TRU CO

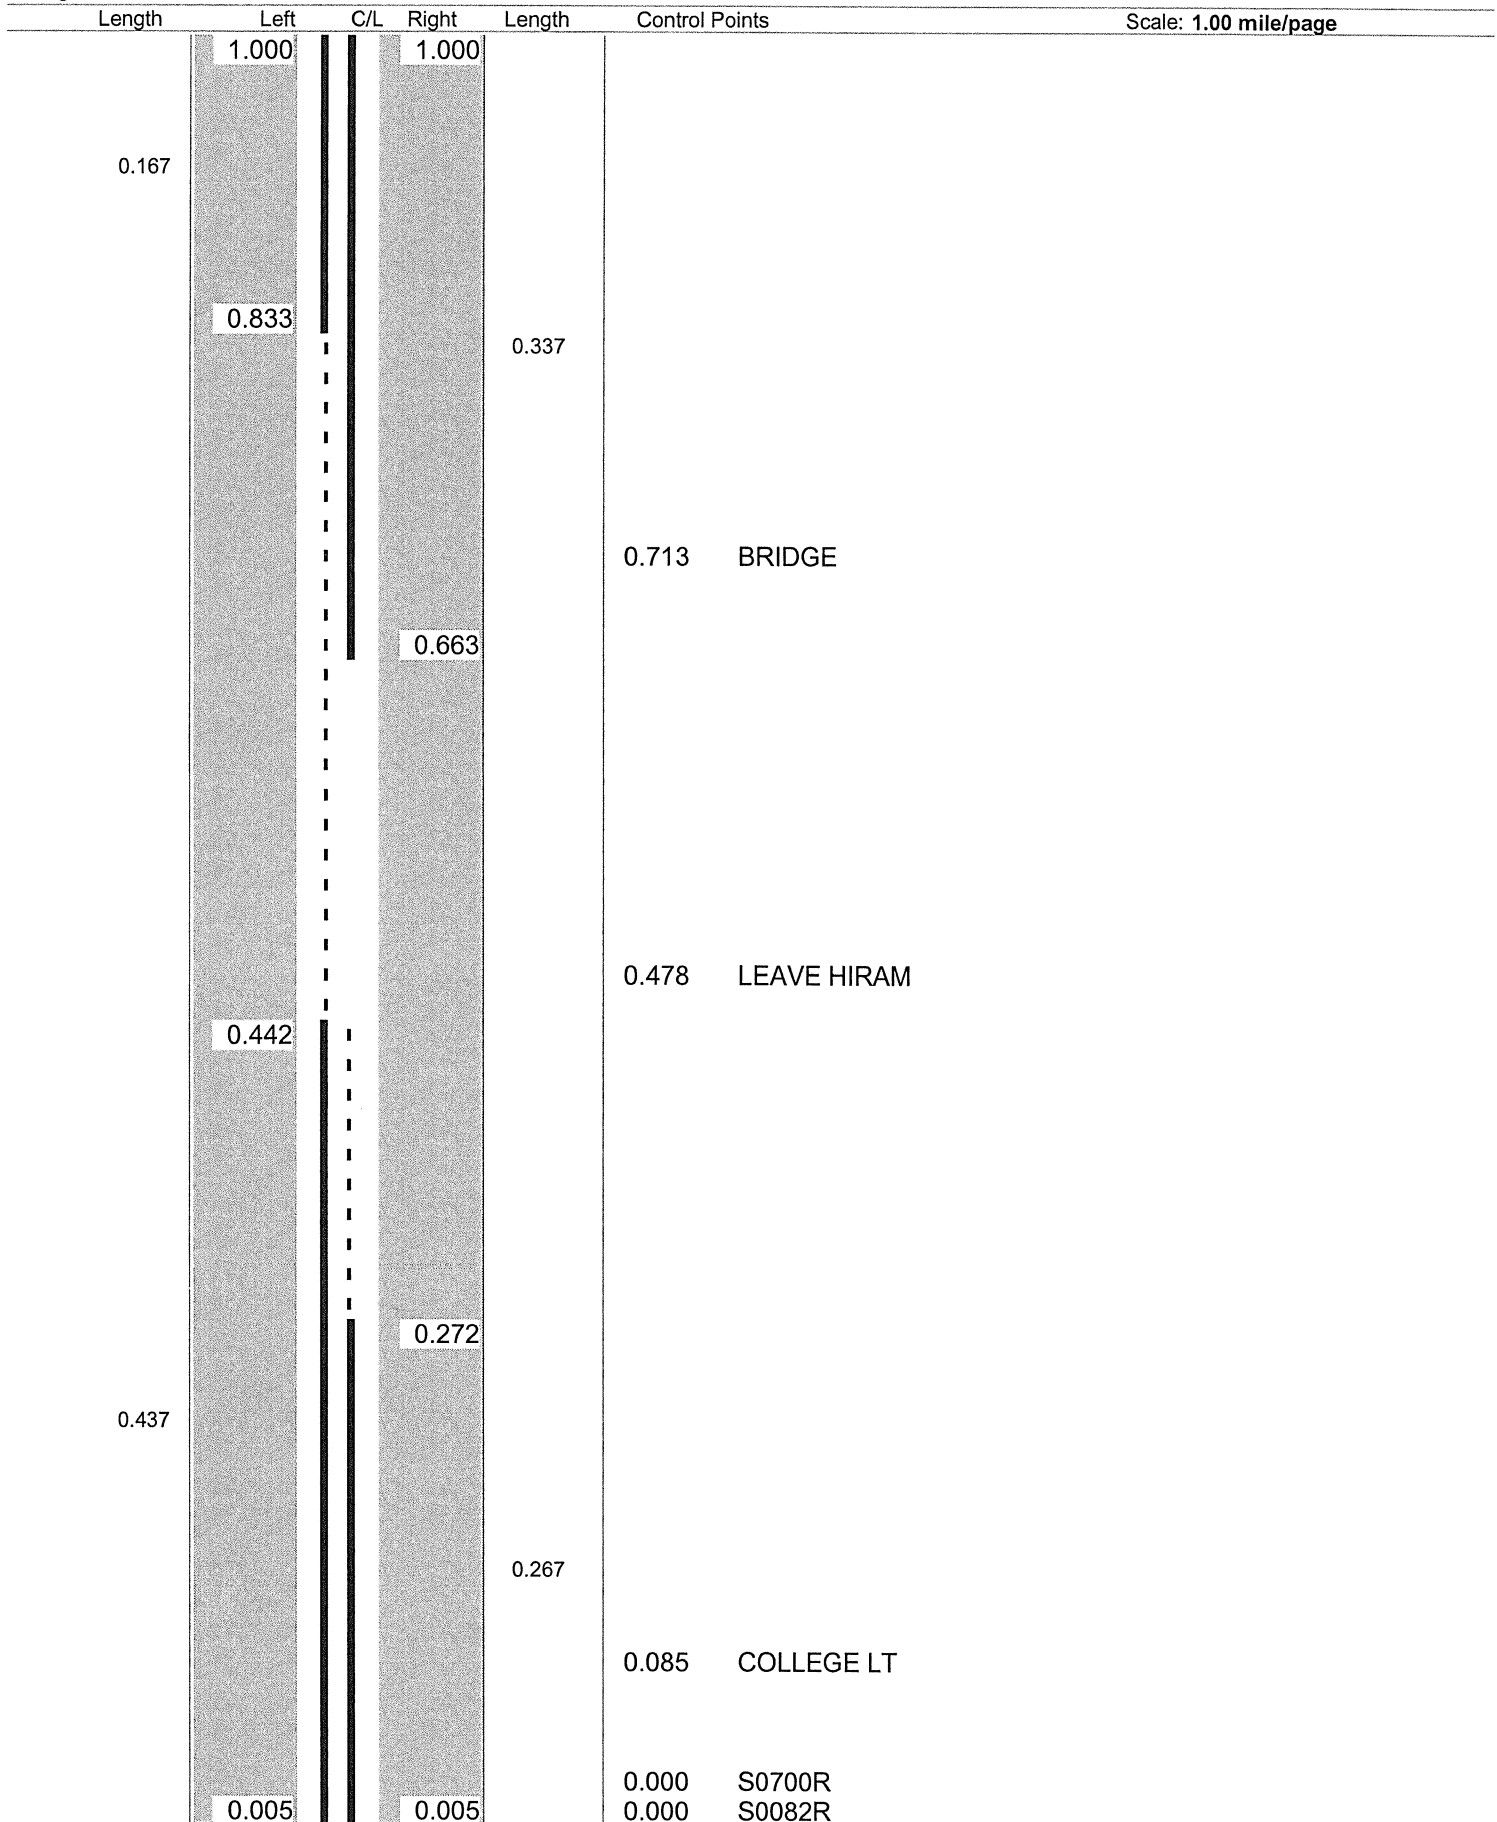

Sheet total equivalent length of solid line: 1.350

Accum. total: 1.350

© 2004 - MasterMind Systems, Inc. - Traffic Safety Suite

ODOT Dist 4 - Portage Co - FINAL No Passing Zone Log (POR)

Page: 2 of 8


Route: 0305R (SPORSR00305**C)

From: 0.000 S0082R

Length: 7.333

Direction: East

To: 7.333 ENTER TRU CO

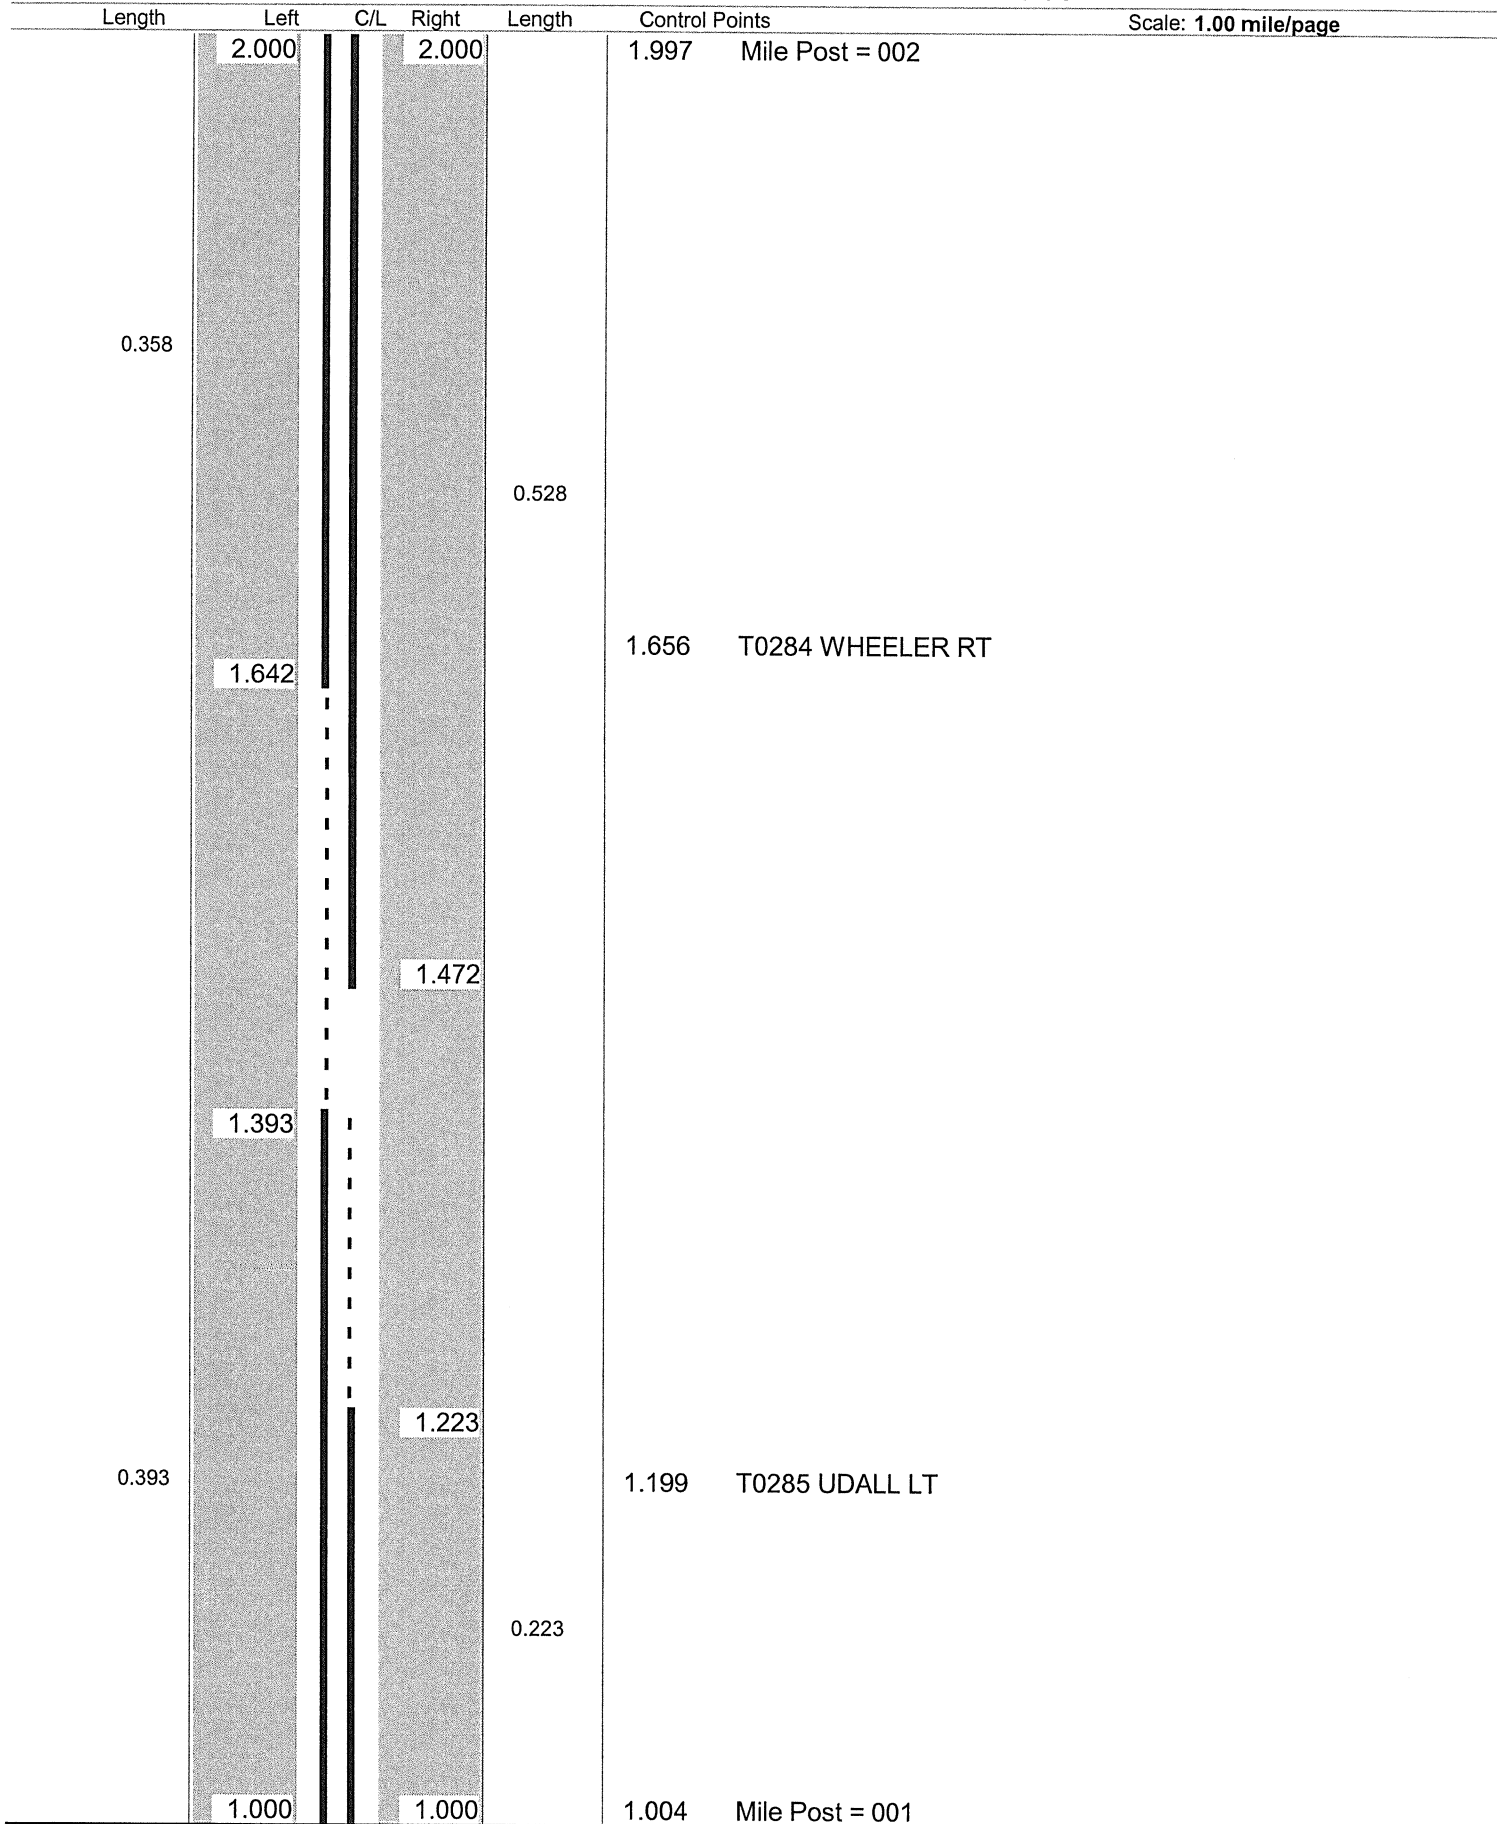

Sheet total equivalent length of solid line: 1.607

Accum. total: 2.957

© 2004 - MasterMind Systems, Inc. - Traffic Safety Suite

ODOT Dist 4 - Portage Co - FINAL
No Passing Zone Log (POR)

Page: 3 of 8


Route: 0305R (SPORSR00305**C)

From: 0.000 S0082R

Length: 7.333

Direction: East

To: 7.333 ENTER TRU CO

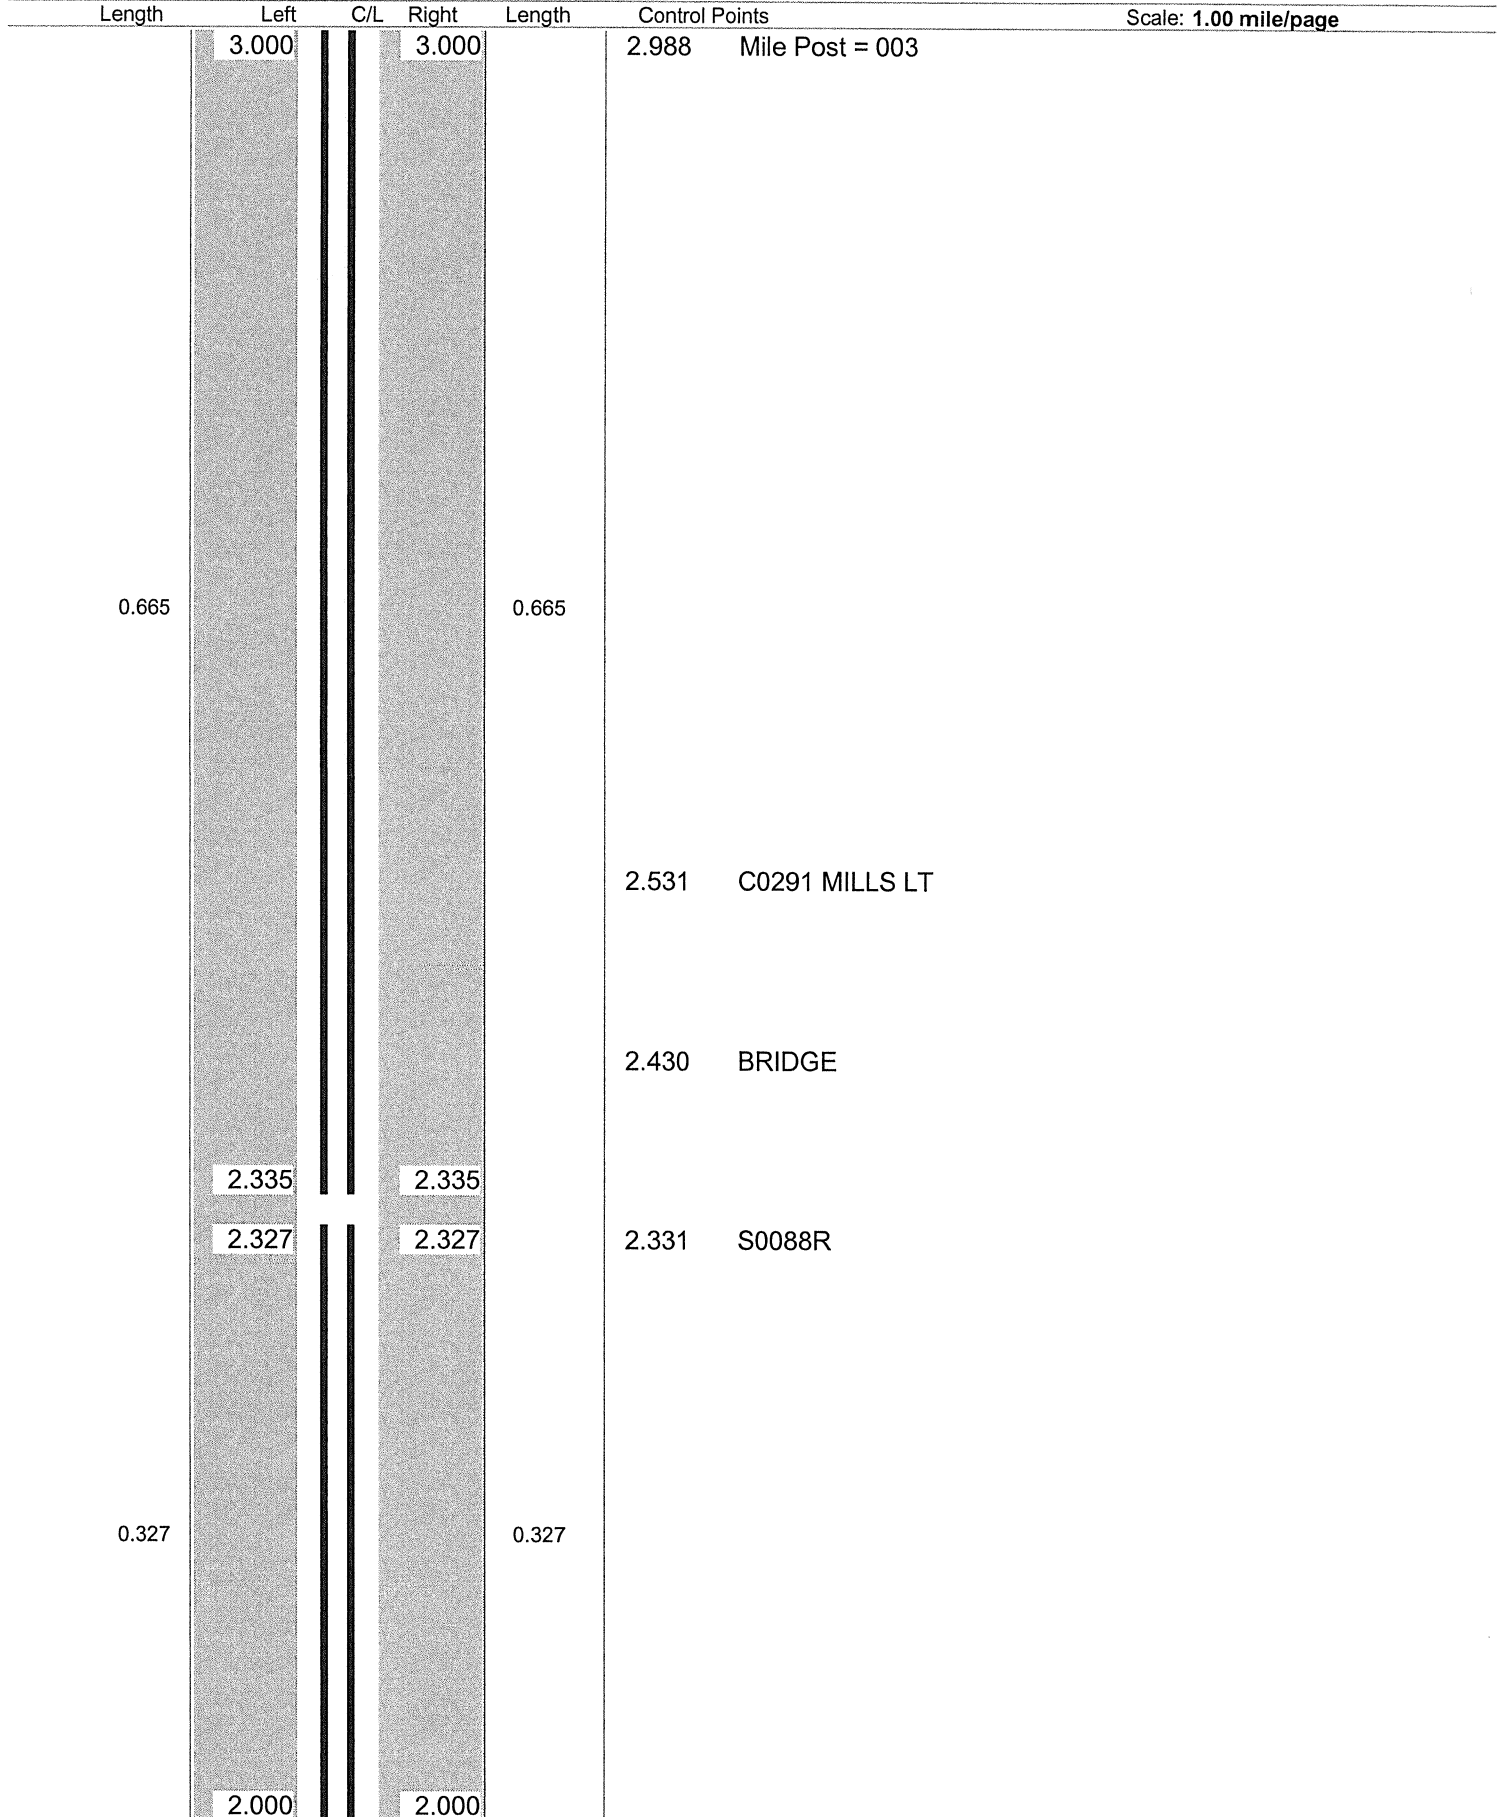

Sheet total equivalent length of solid line: 1.984

Accum. total: 4.941


© 2004 - MasterMind Systems, Inc. - Traffic Safety Suite

ODOT District 4
No Passing Zone Log (POR)

Page: 1 of 1
 4 8

Route: **0305R (SPORSR00305**C)**
 Length: **0.999** Direction: **East**

From: **3.000 S0082R**
 To: **3.999 ENTER TRU CO**

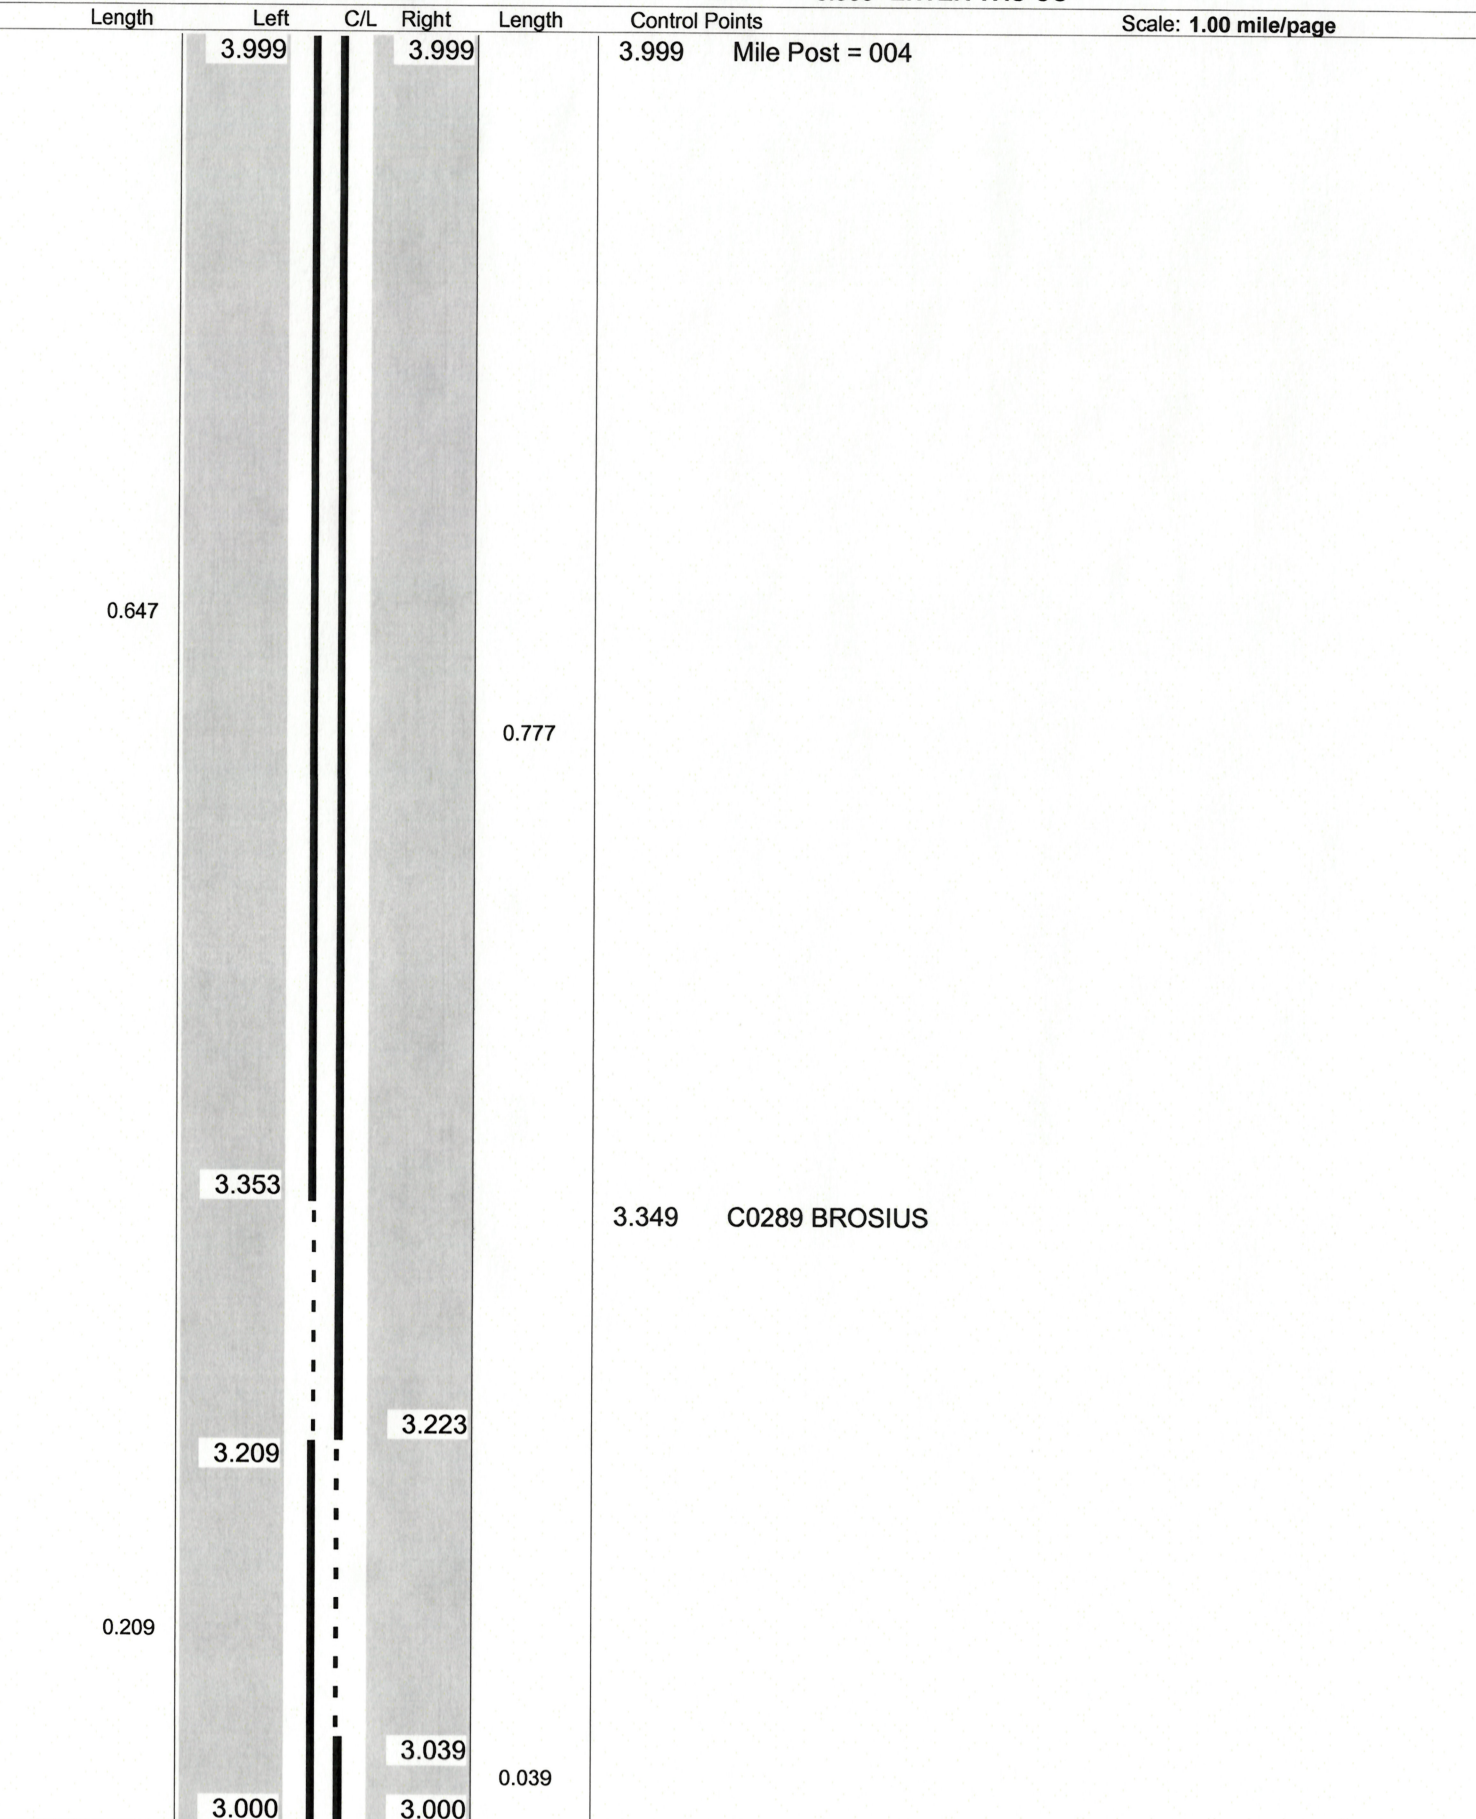

Sheet total equivalent length of solid line: 1.749

Accum. total: 1.749

ODOT Dist 4 - Portage Co - FINAL
No Passing Zone Log (POR)

Page: 5 of 8


Route: **0305R (SPORSR00305**C)**

From: **0.000 S0082R**

Length: **7.333**

Direction: **East**

To: **7.333 ENTER TRU CO**

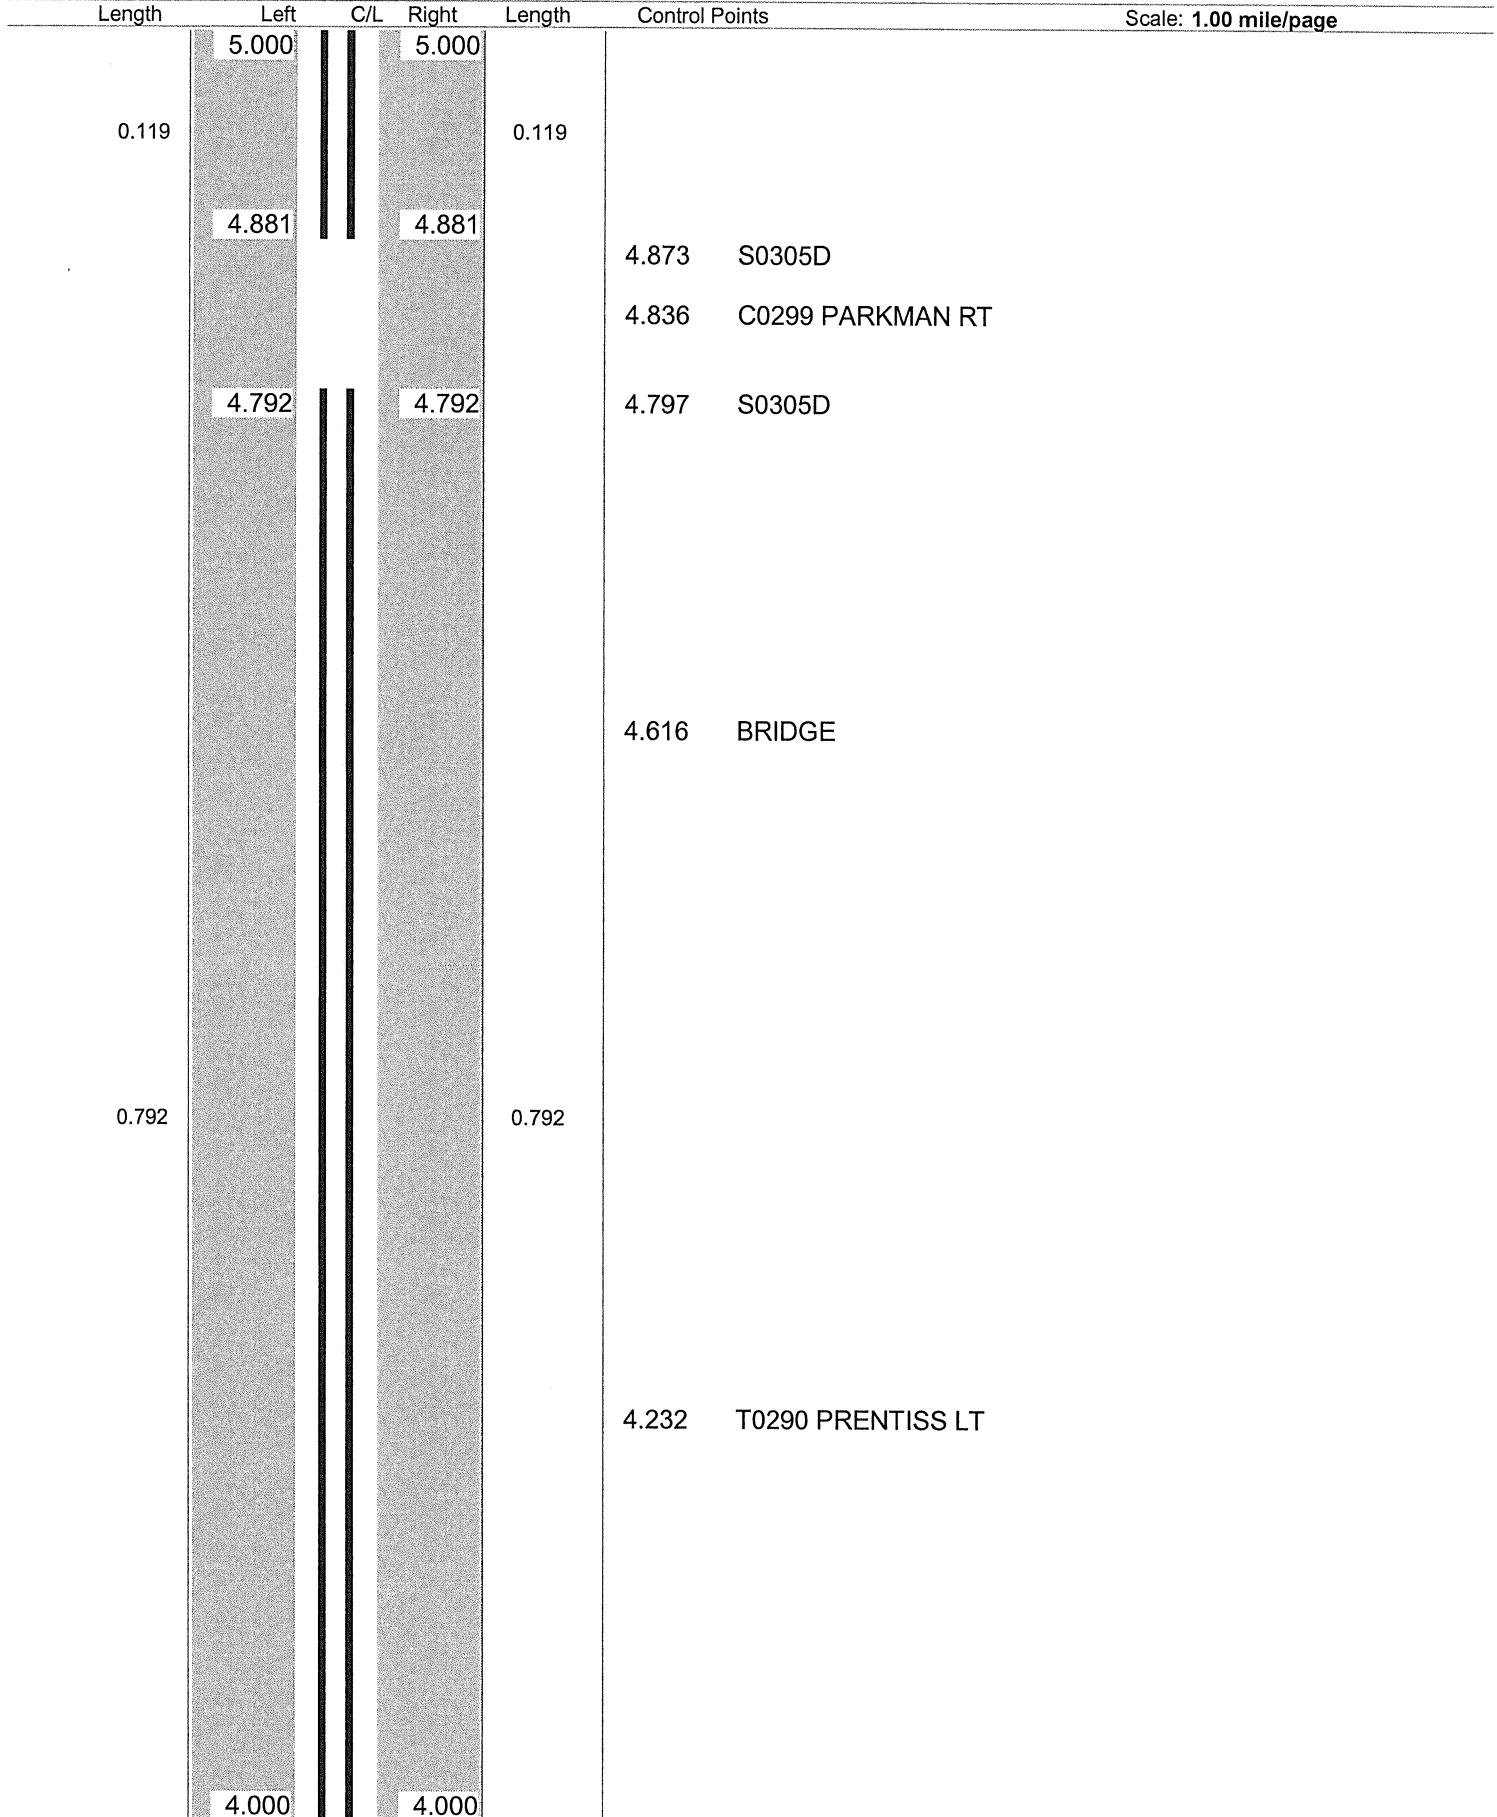

Sheet total equivalent length of solid line: 1.822

Accum. total: 8.341

© 2004 - MasterMind Systems, Inc. - Traffic Safety Suite

ODOT Dist 4 - Portage Co - FINAL **No Passing Zone Log (POR)**

Page: 6 of 8


Route: 0305R (SPORSR00305**C)

From: 0.000 S0082R

Length: 7.333

Direction: East

To: 7.333 ENTER TRU CO

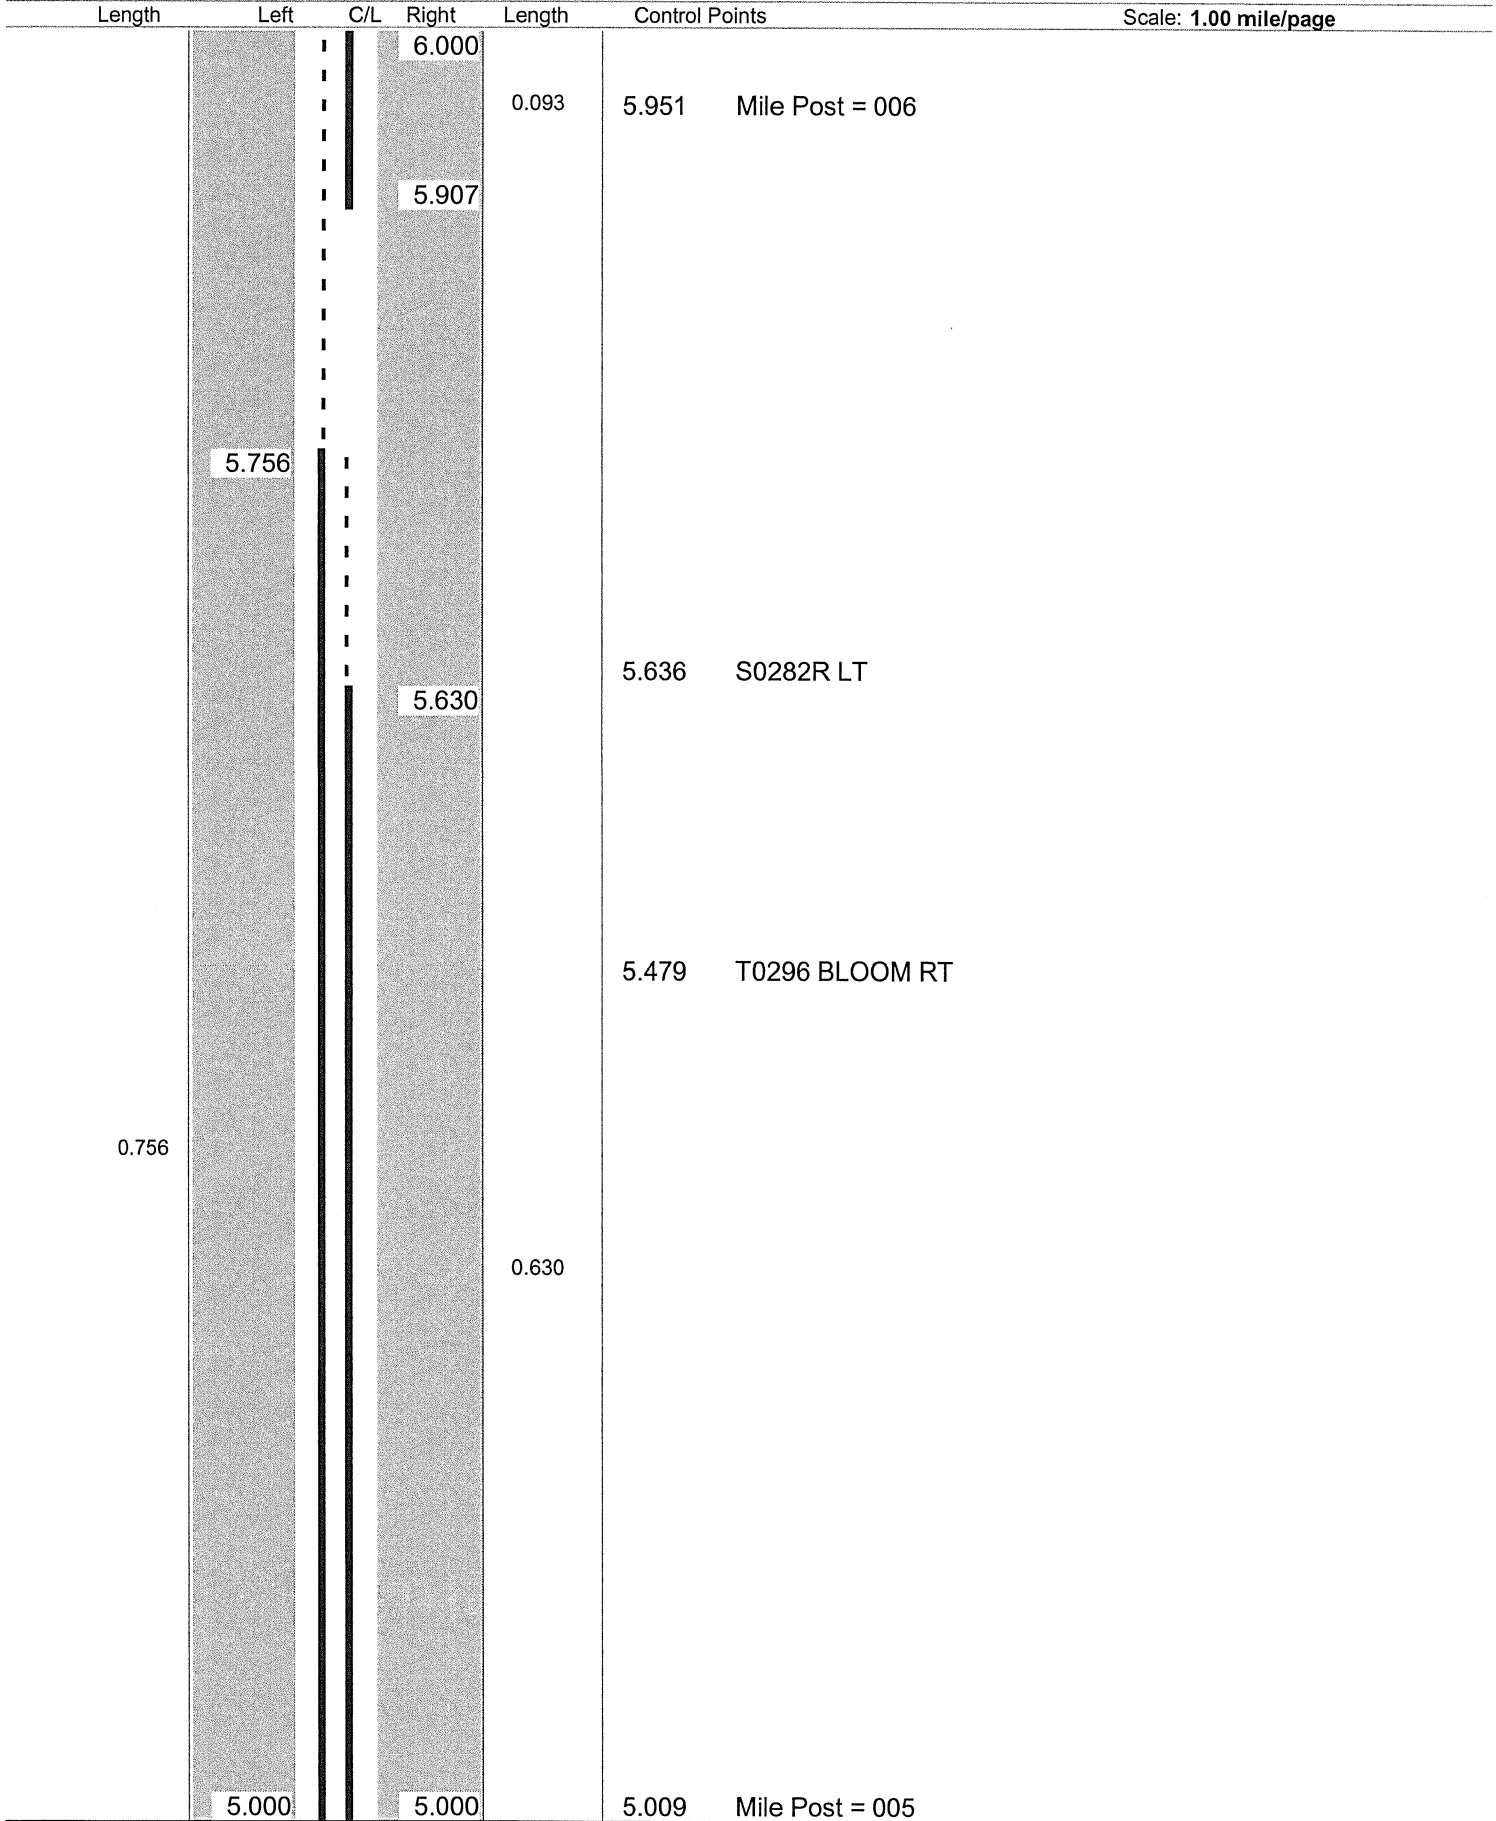

Sheet total equivalent length of solid line: 1.572

Accum. total: 9.913

© 2004 - MasterMind Systems, Inc. - Traffic Safety Suite

No Passing Zone Log (POR)

Page: 7 of 8

Route: 0305R (SPORSR00305**C)

Length: 7.333

Direction: **East**

From: 0.000 *S0082R*

To: **7.333 ENTER TRU CO**

Length	Left	C/L	Right	Length	Control Points	Scale: 1.00 mile/page
0.160	7.000		6.887	0.123	6.995 Mile Post = 007	
	6.840		6.764		6.892 T0307 FENSTERMAKER LT	
					6.837 T0298 NICHOLSON RT	
0.295	6.372		6.202	0.202	6.161 T0311 KYLE RT	
	6.077		6.000			

ODOT Dist 4 - Portage Co - FINAL No Passing Zone Log (POR)

Page: 8 of 8

Route: 0305R (SPORSR00305**C)

From: 0.000 S0082R

Length: 7.333

Direction: East

To:

7.333 ENTER TRU CO

Length

Left


C/L

Right

Length

Control Points

Scale: 1.00 mile/page

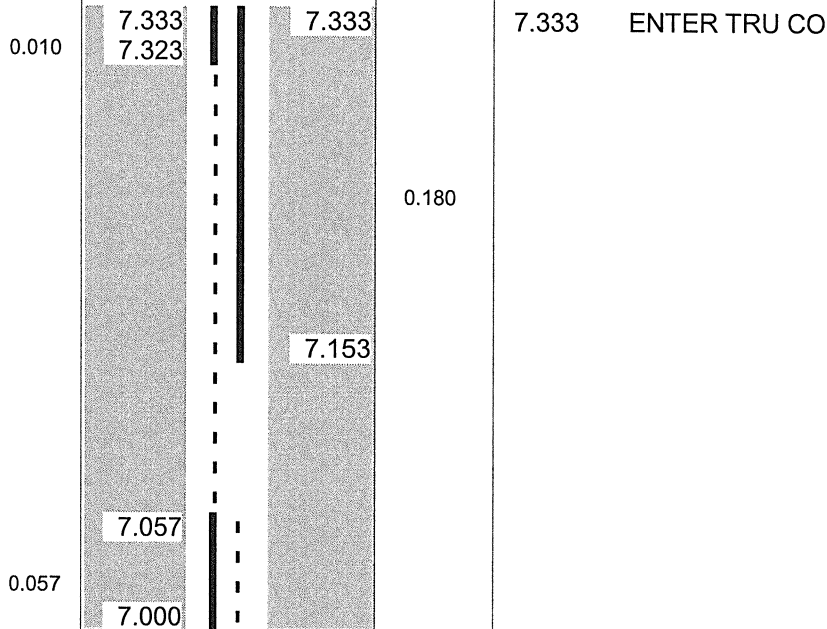

Sheet total equivalent length of solid line: 0.328

Accum. total: 11.228

© 2004 - MasterMind Systems, Inc. - Traffic Safety Suite