



Cleveland + Remington

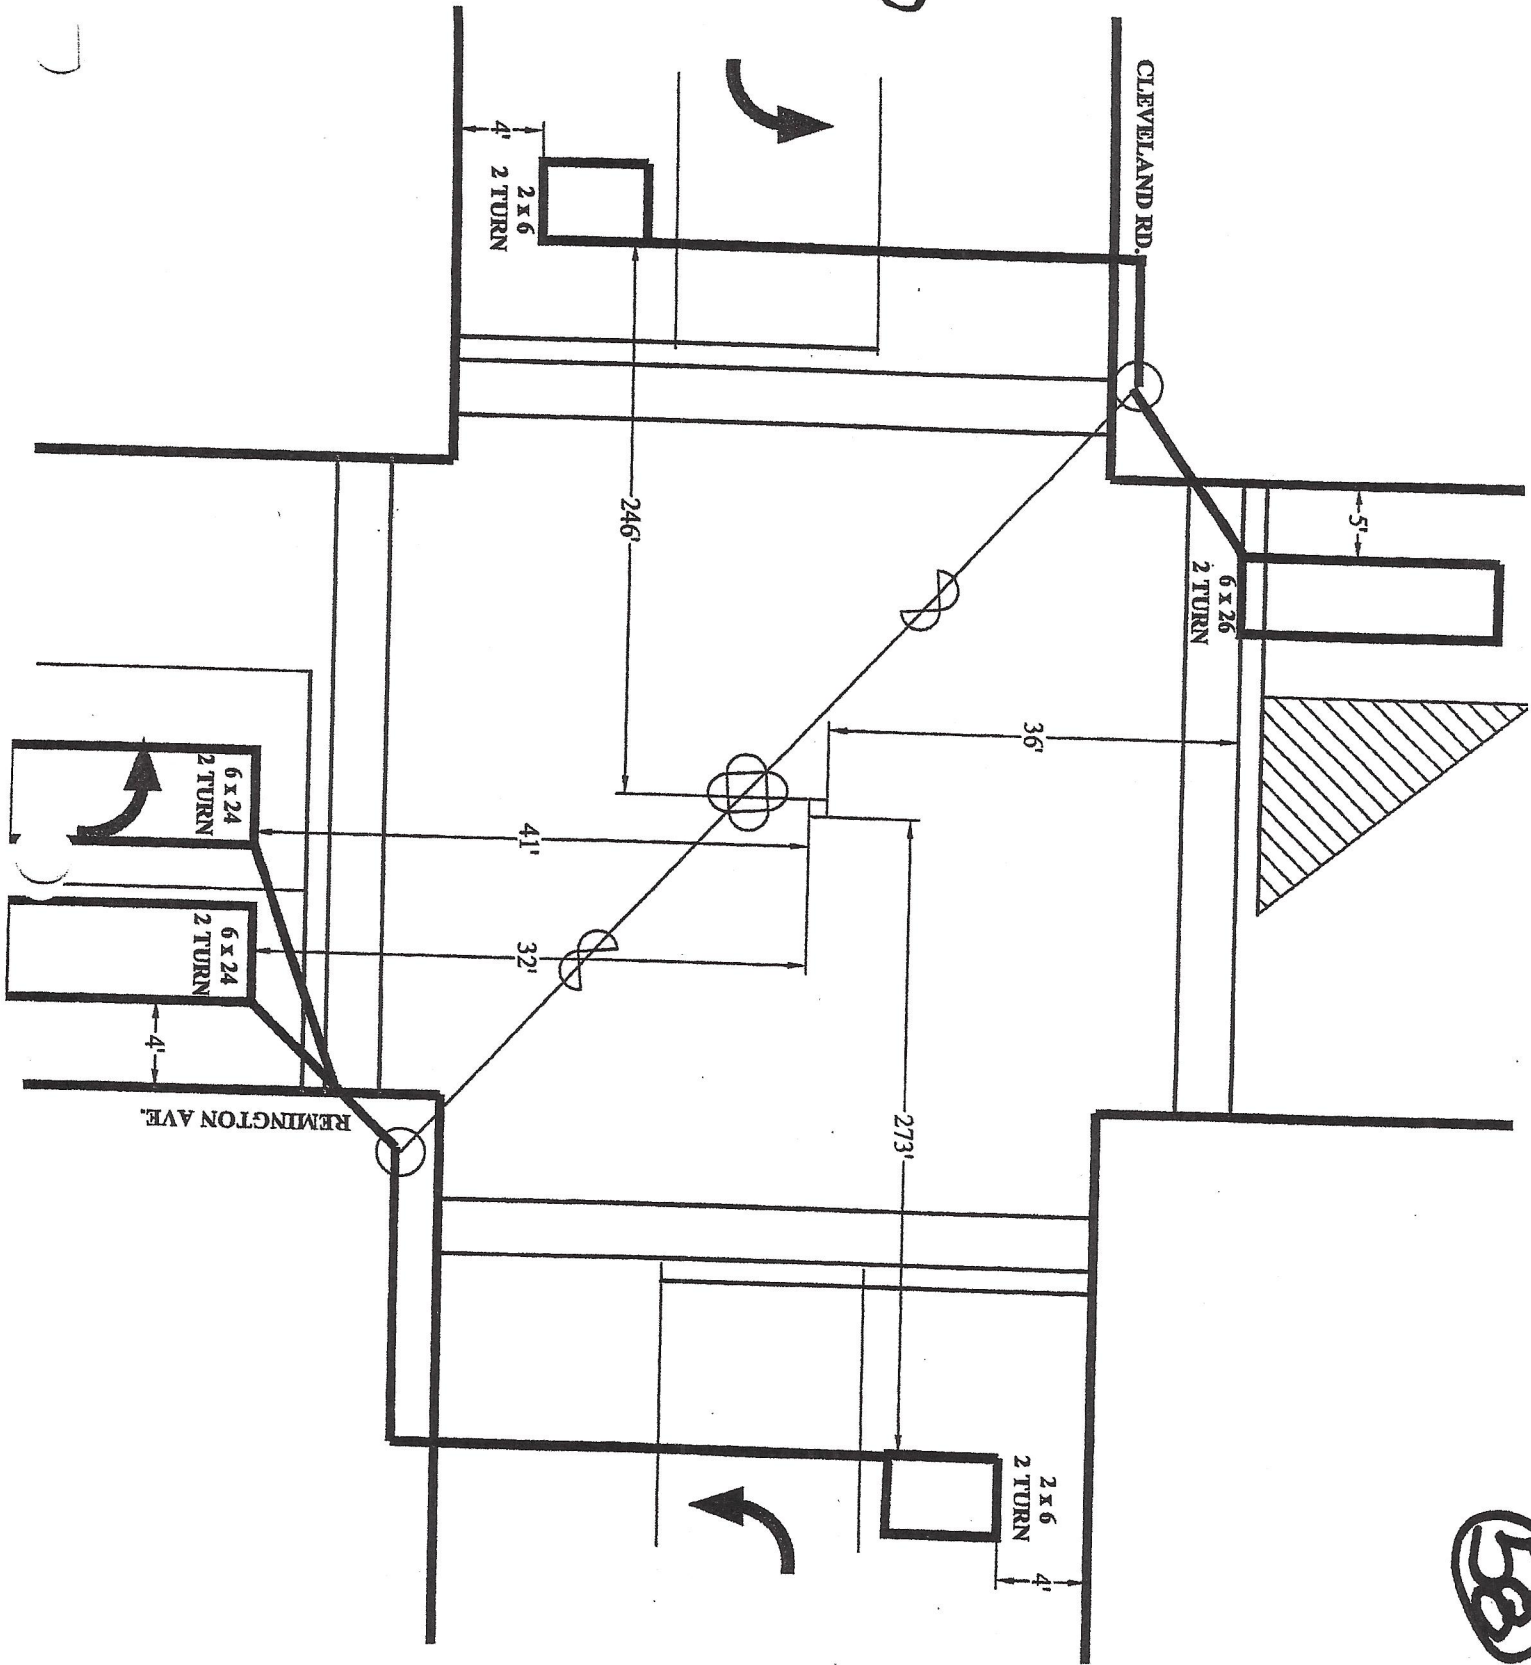

(58)


Cleveland + Harbour

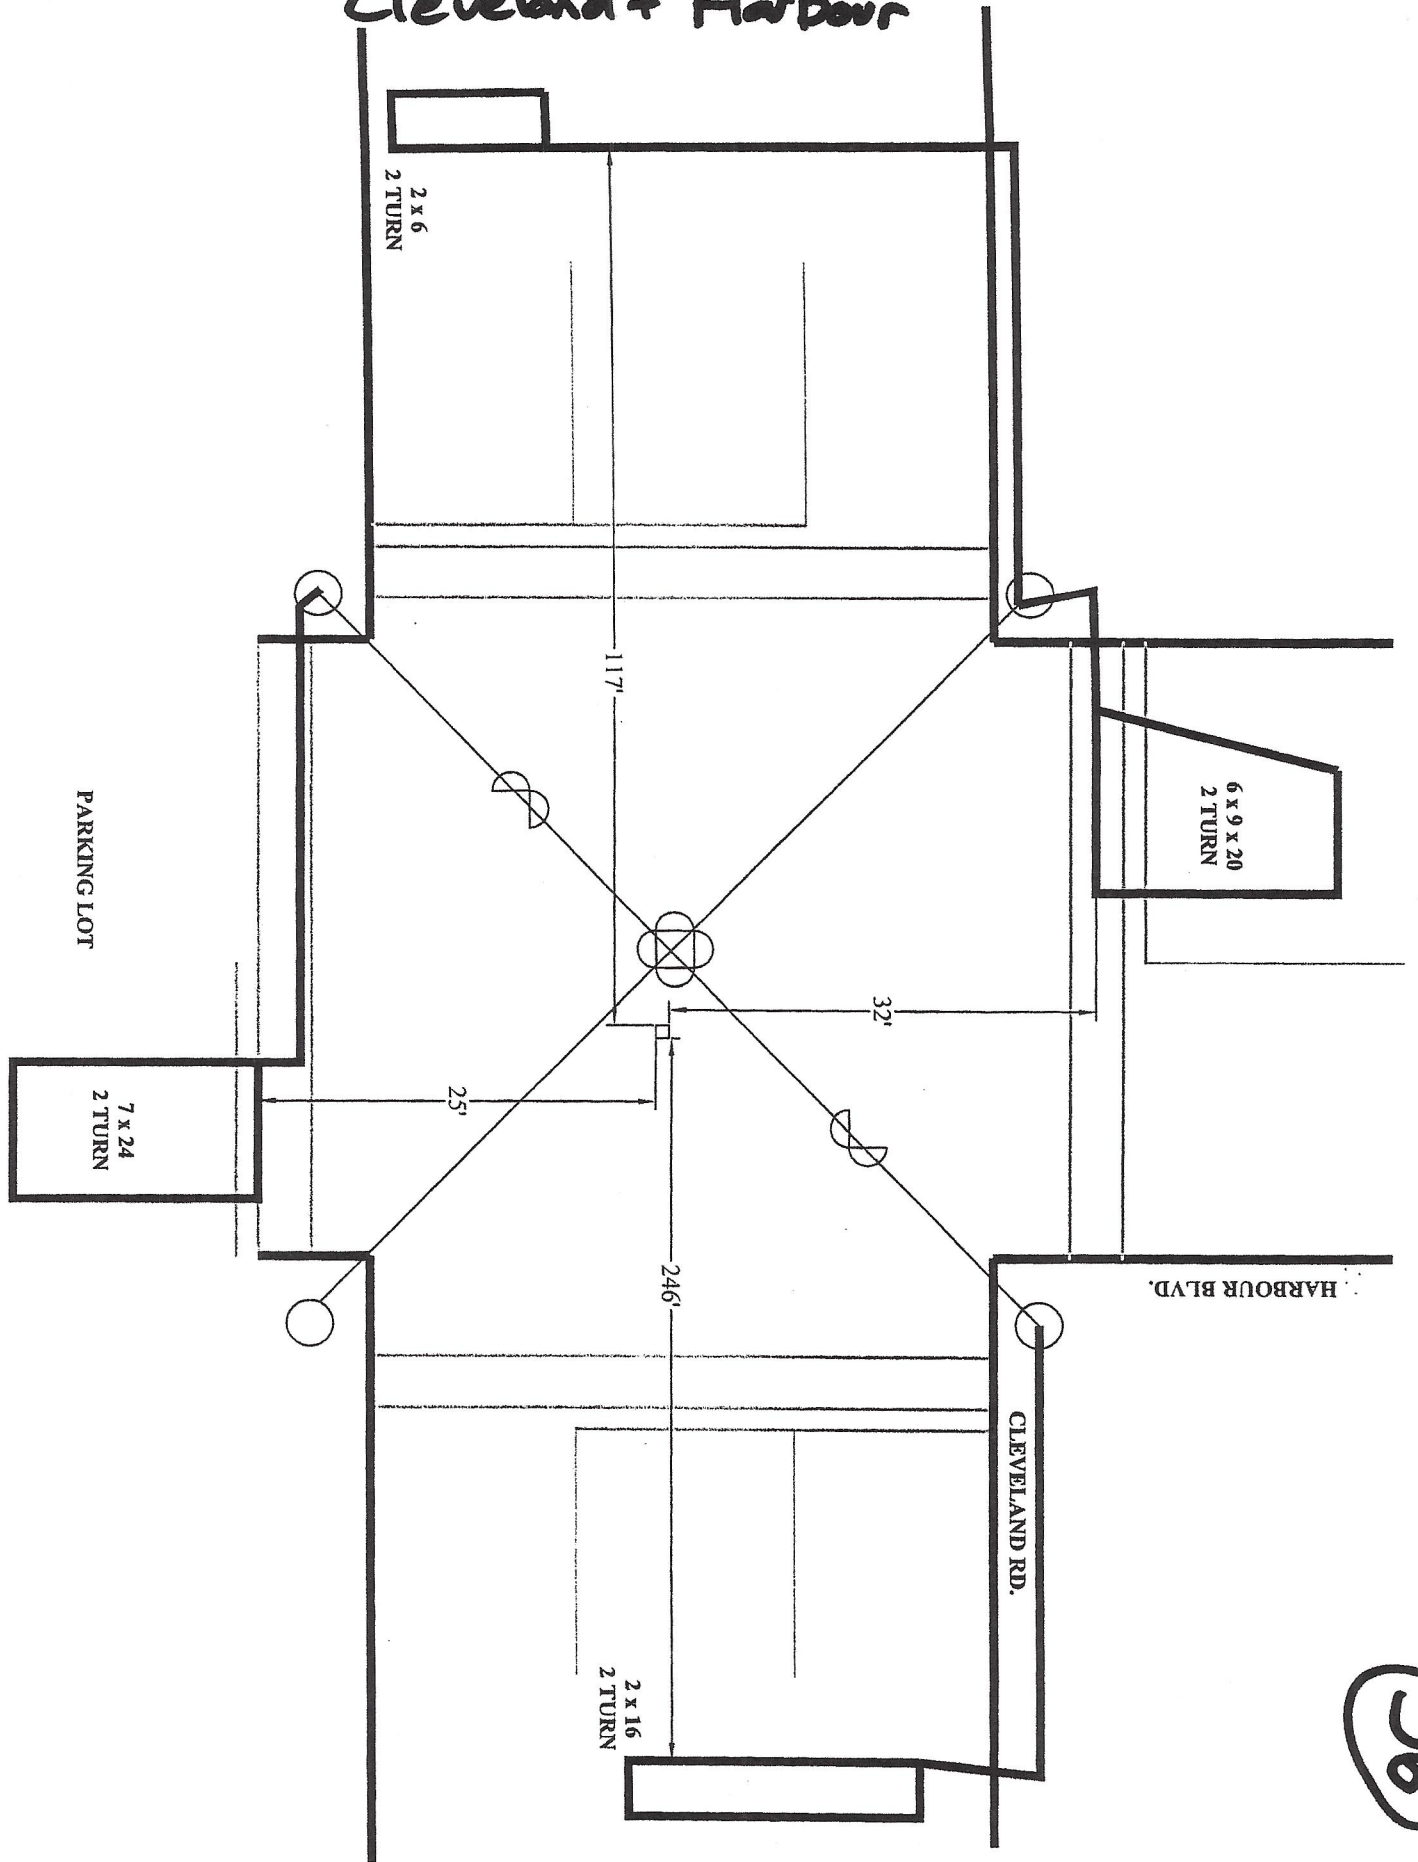

(56)




Cleveland + CP Drive

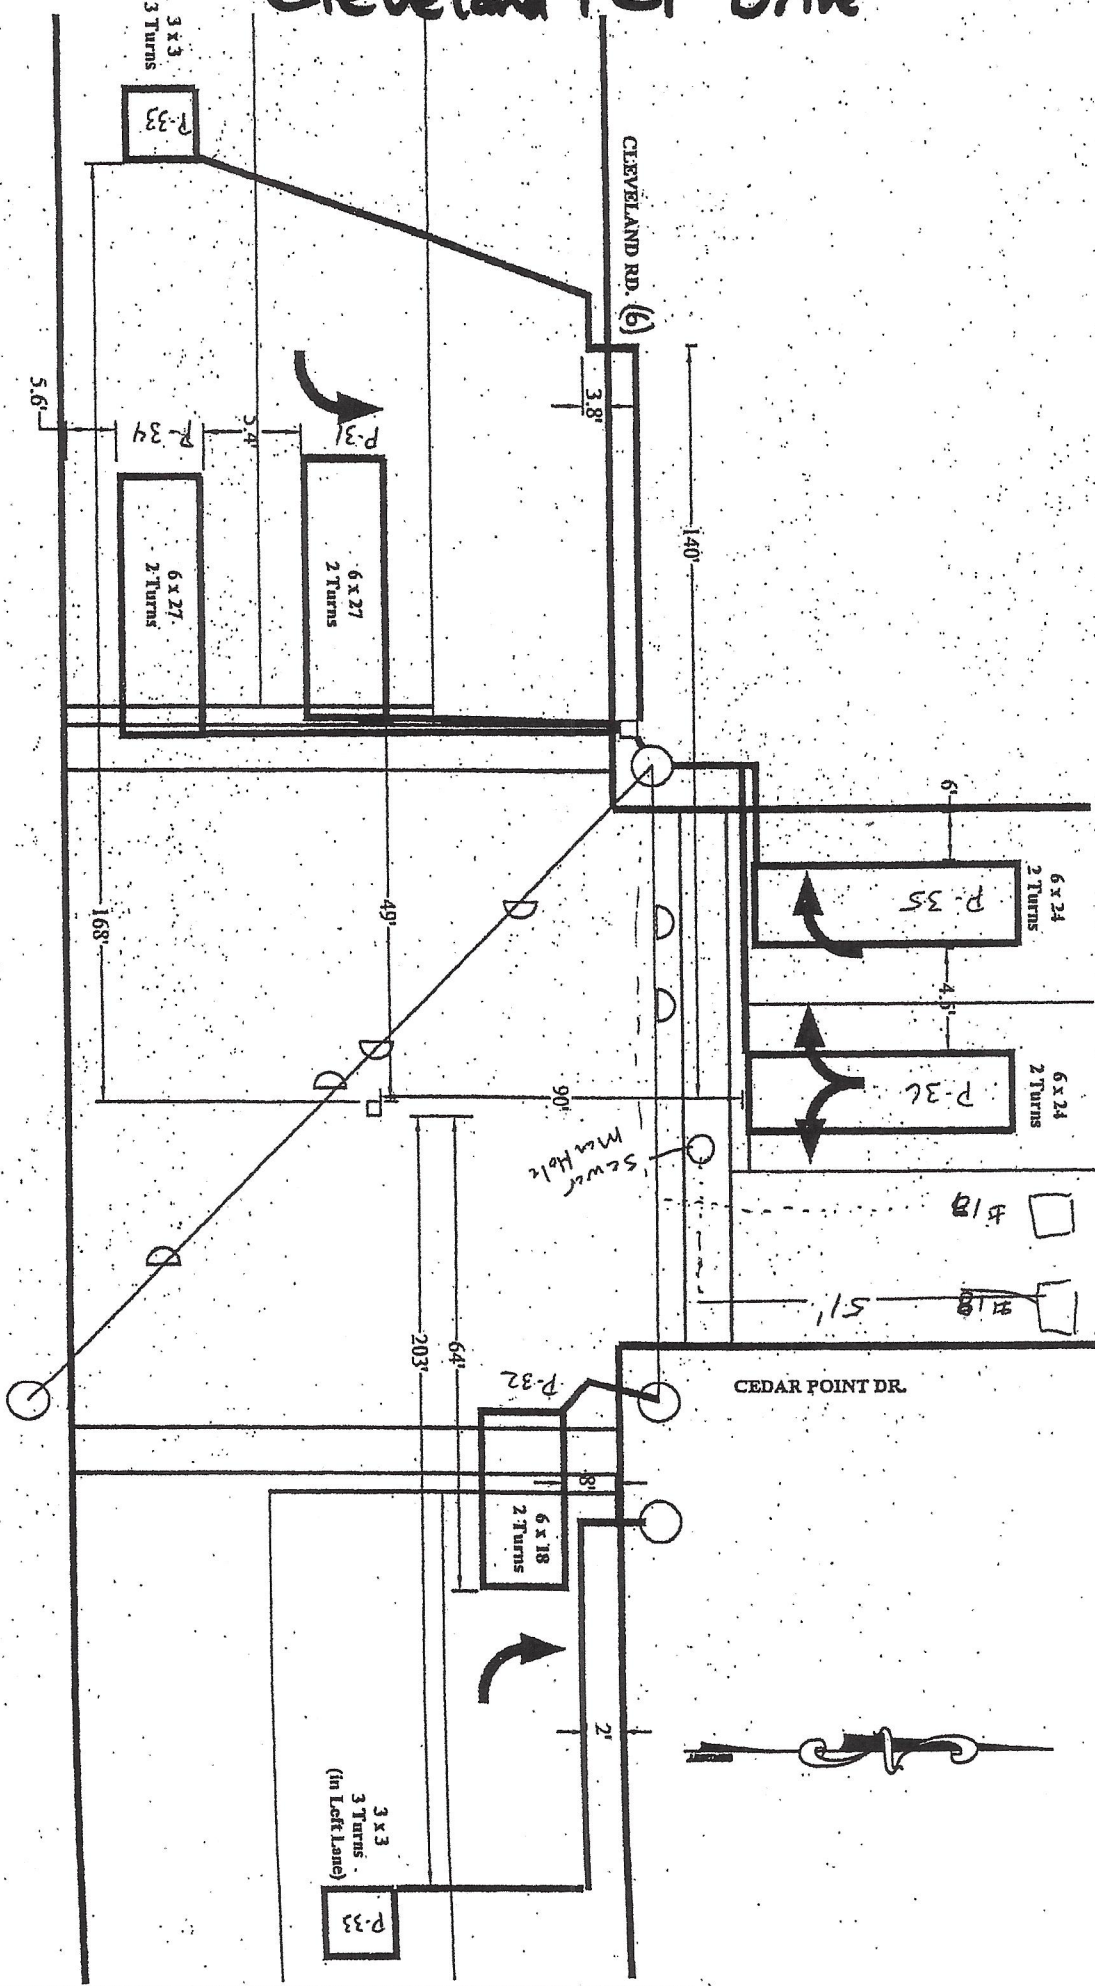

174

Cleveland + Cowdery

419-281-9463

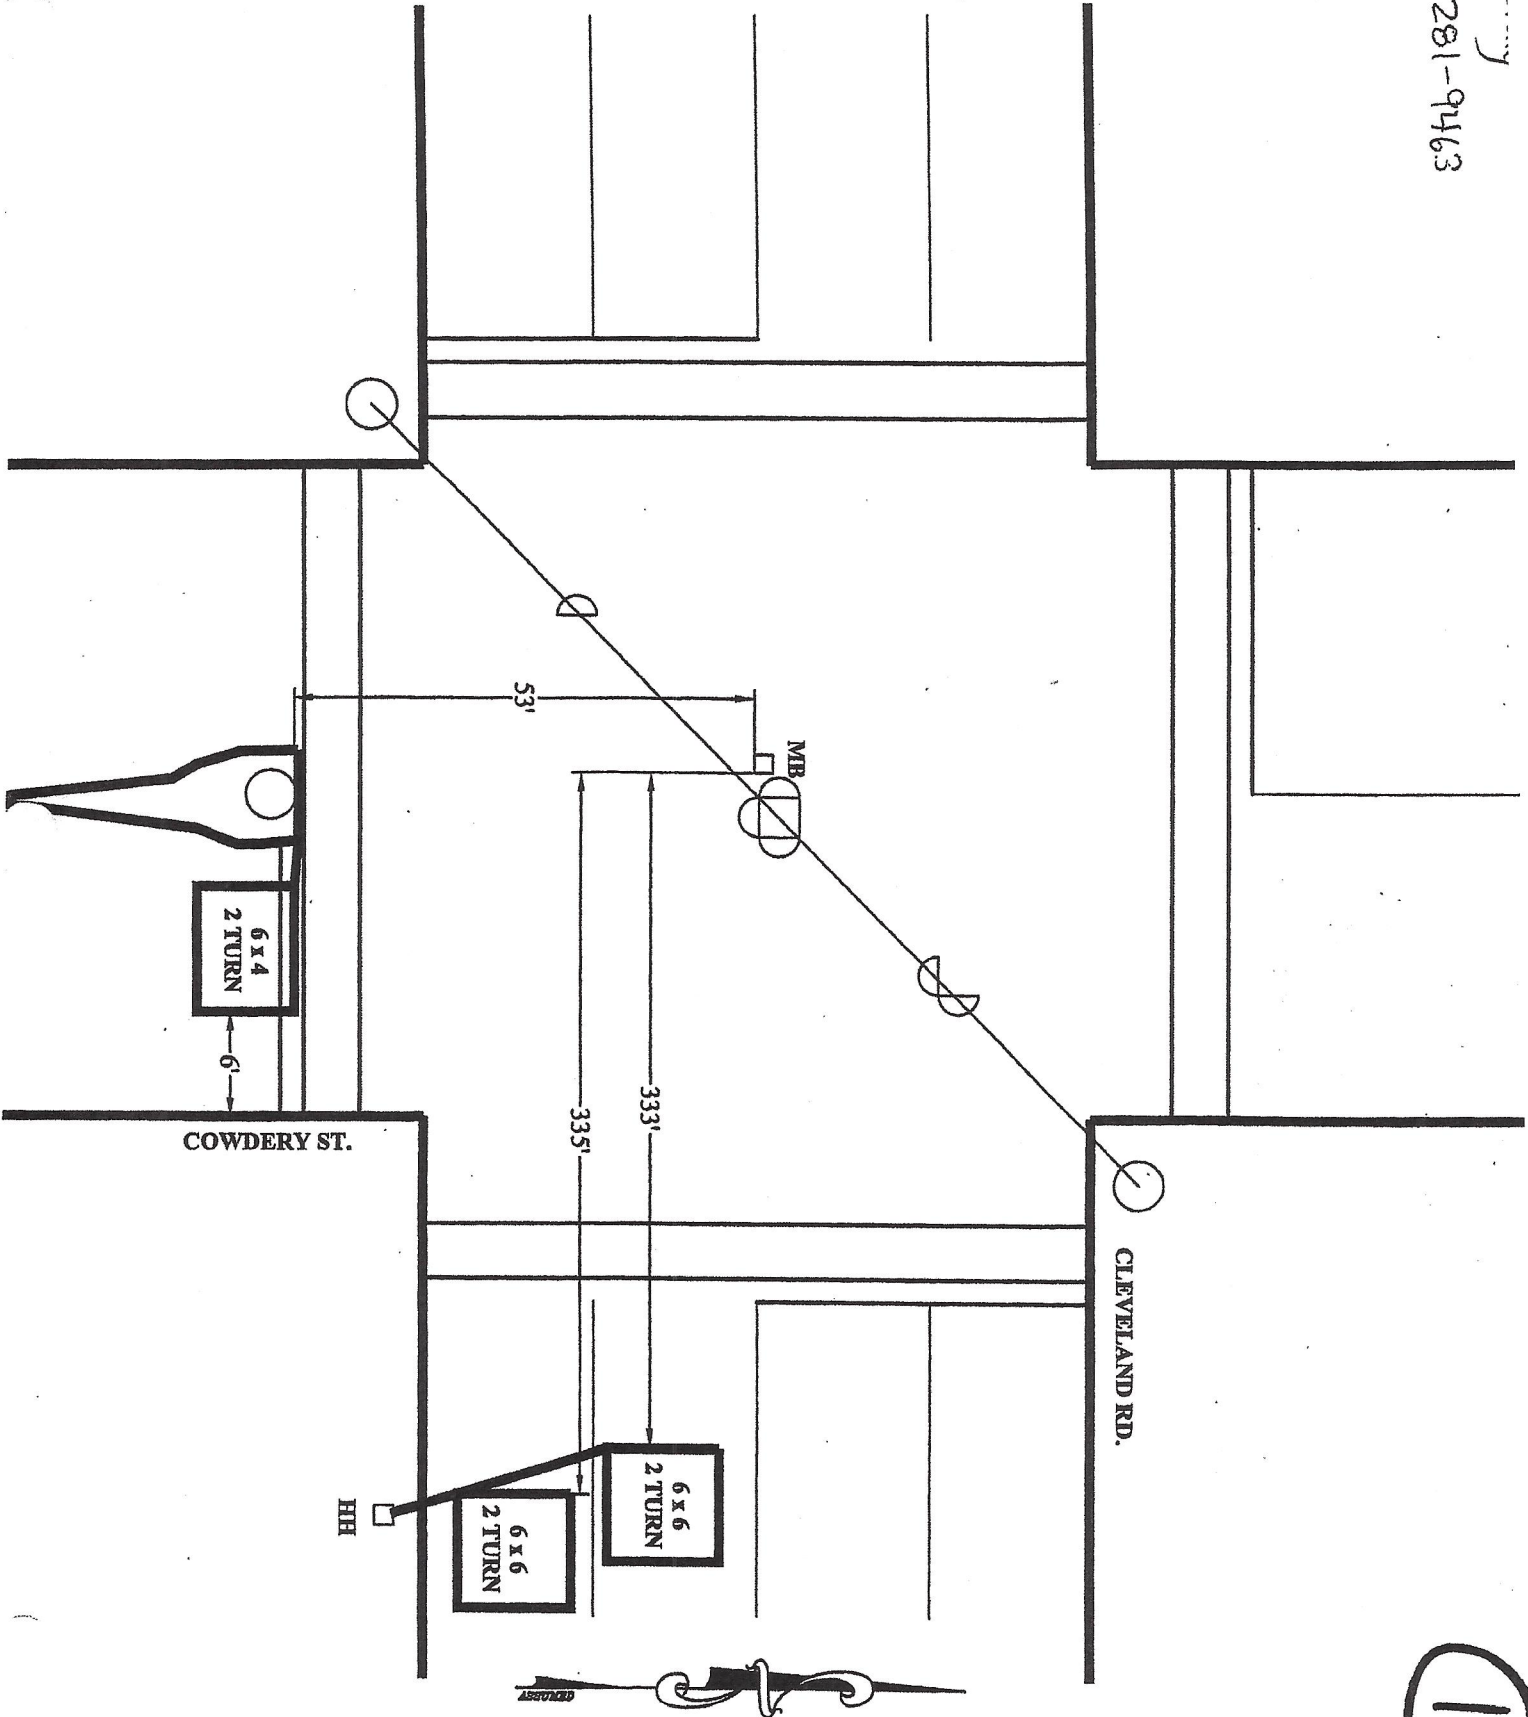

13

SCOTT + WARREN

SCOTT ST.

6 x 6
2 Turns

5'

M.B.

41'

40'

6 x 6
2 Turns

2'


WARREN ST.

(34)

ASSUMED




Monroe + Huron Ave + Warren St.

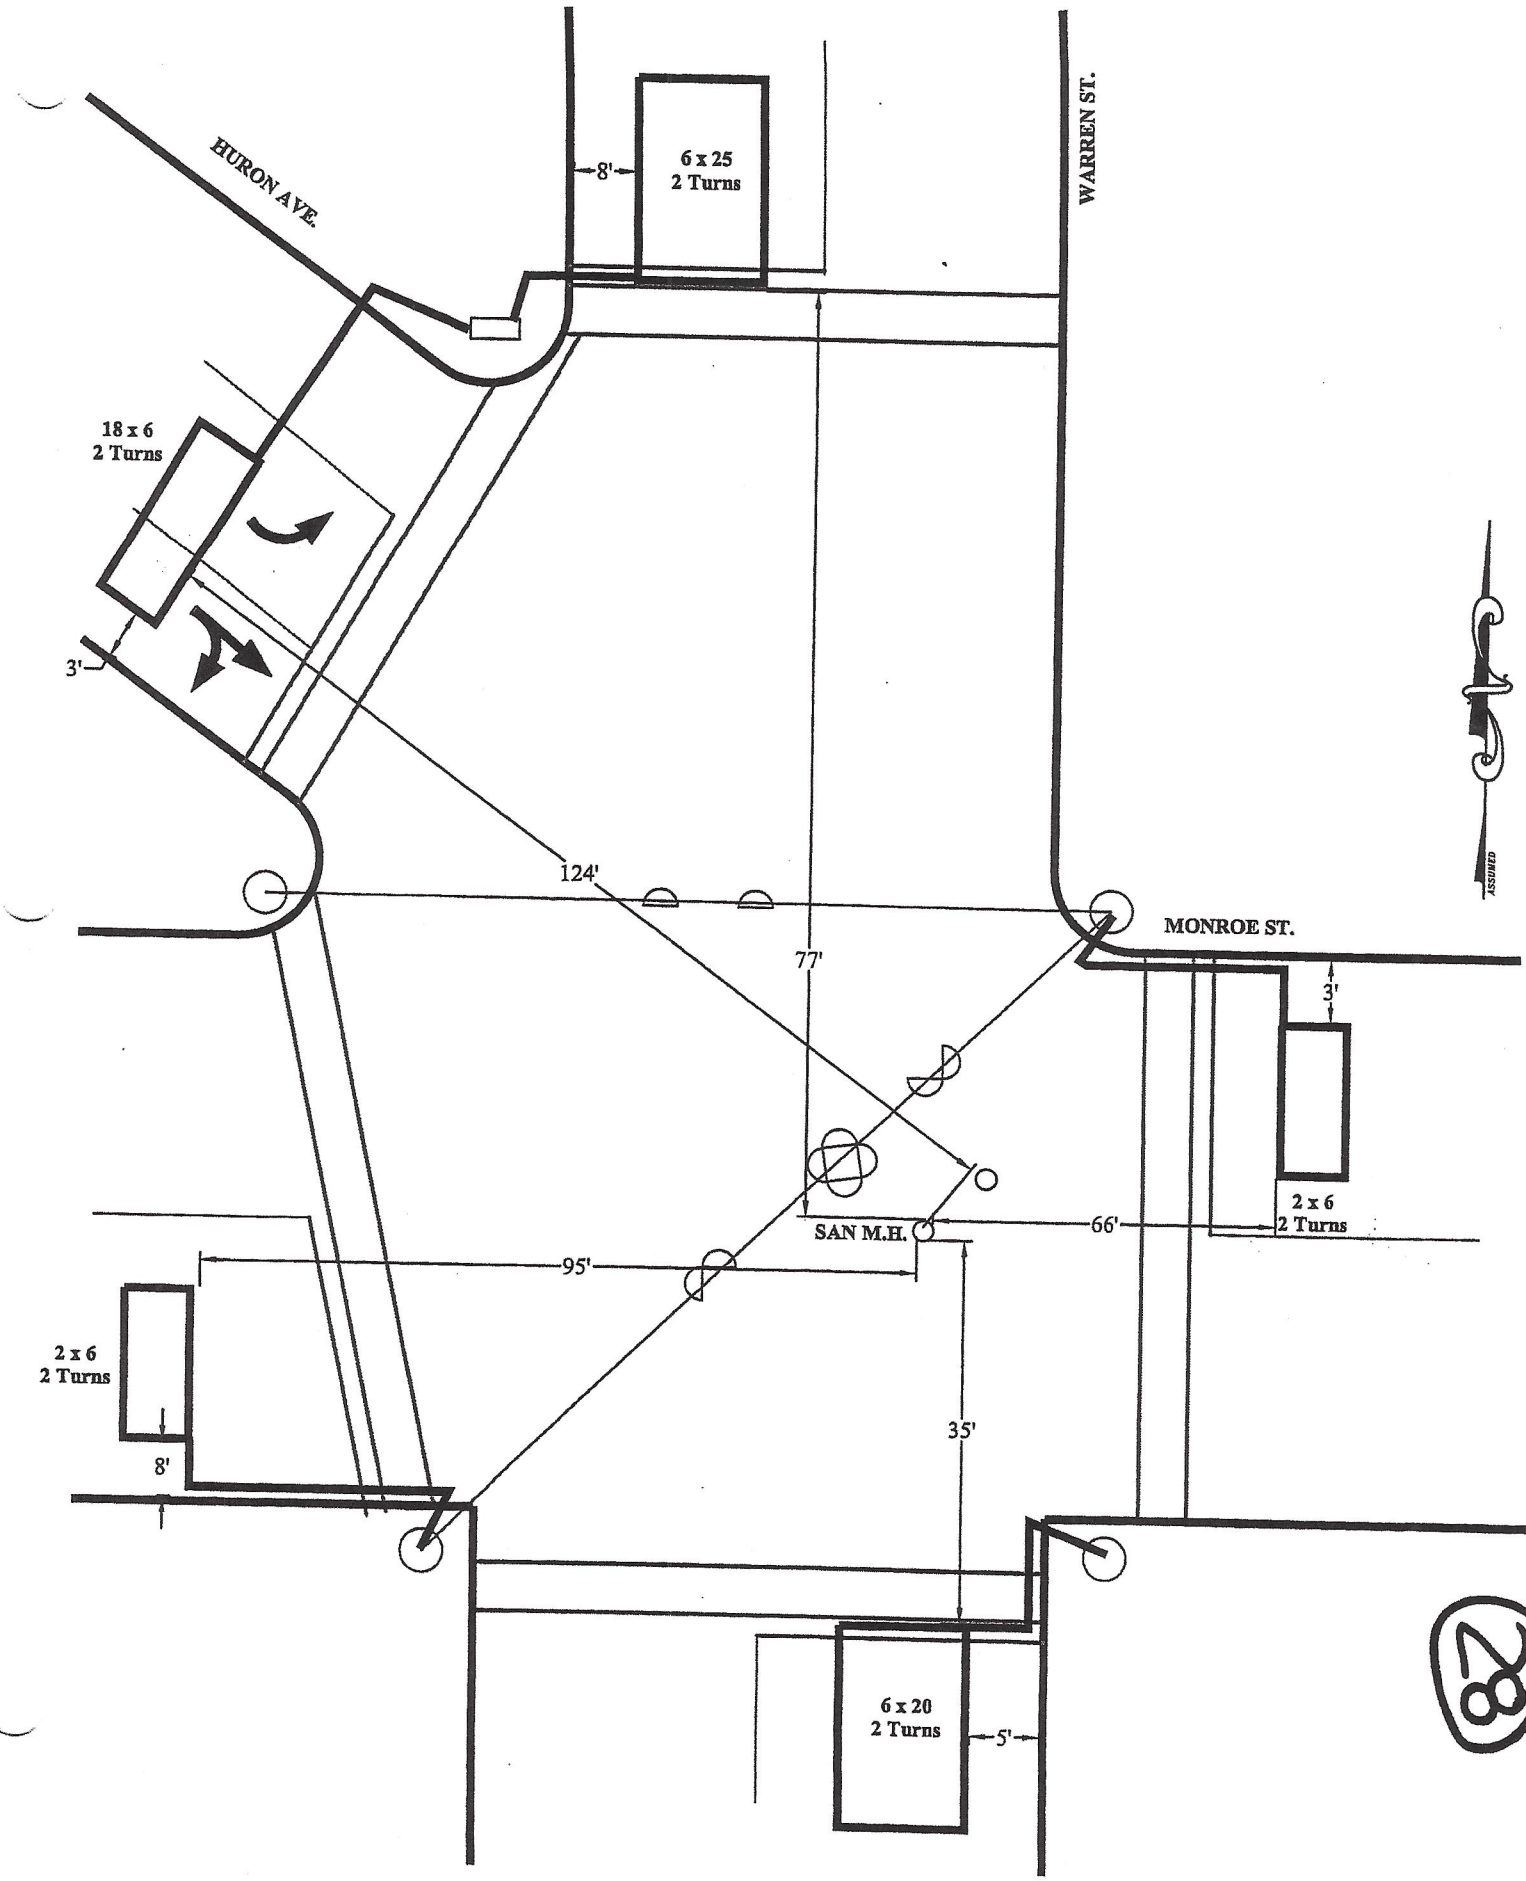

28


Washington + Wayne

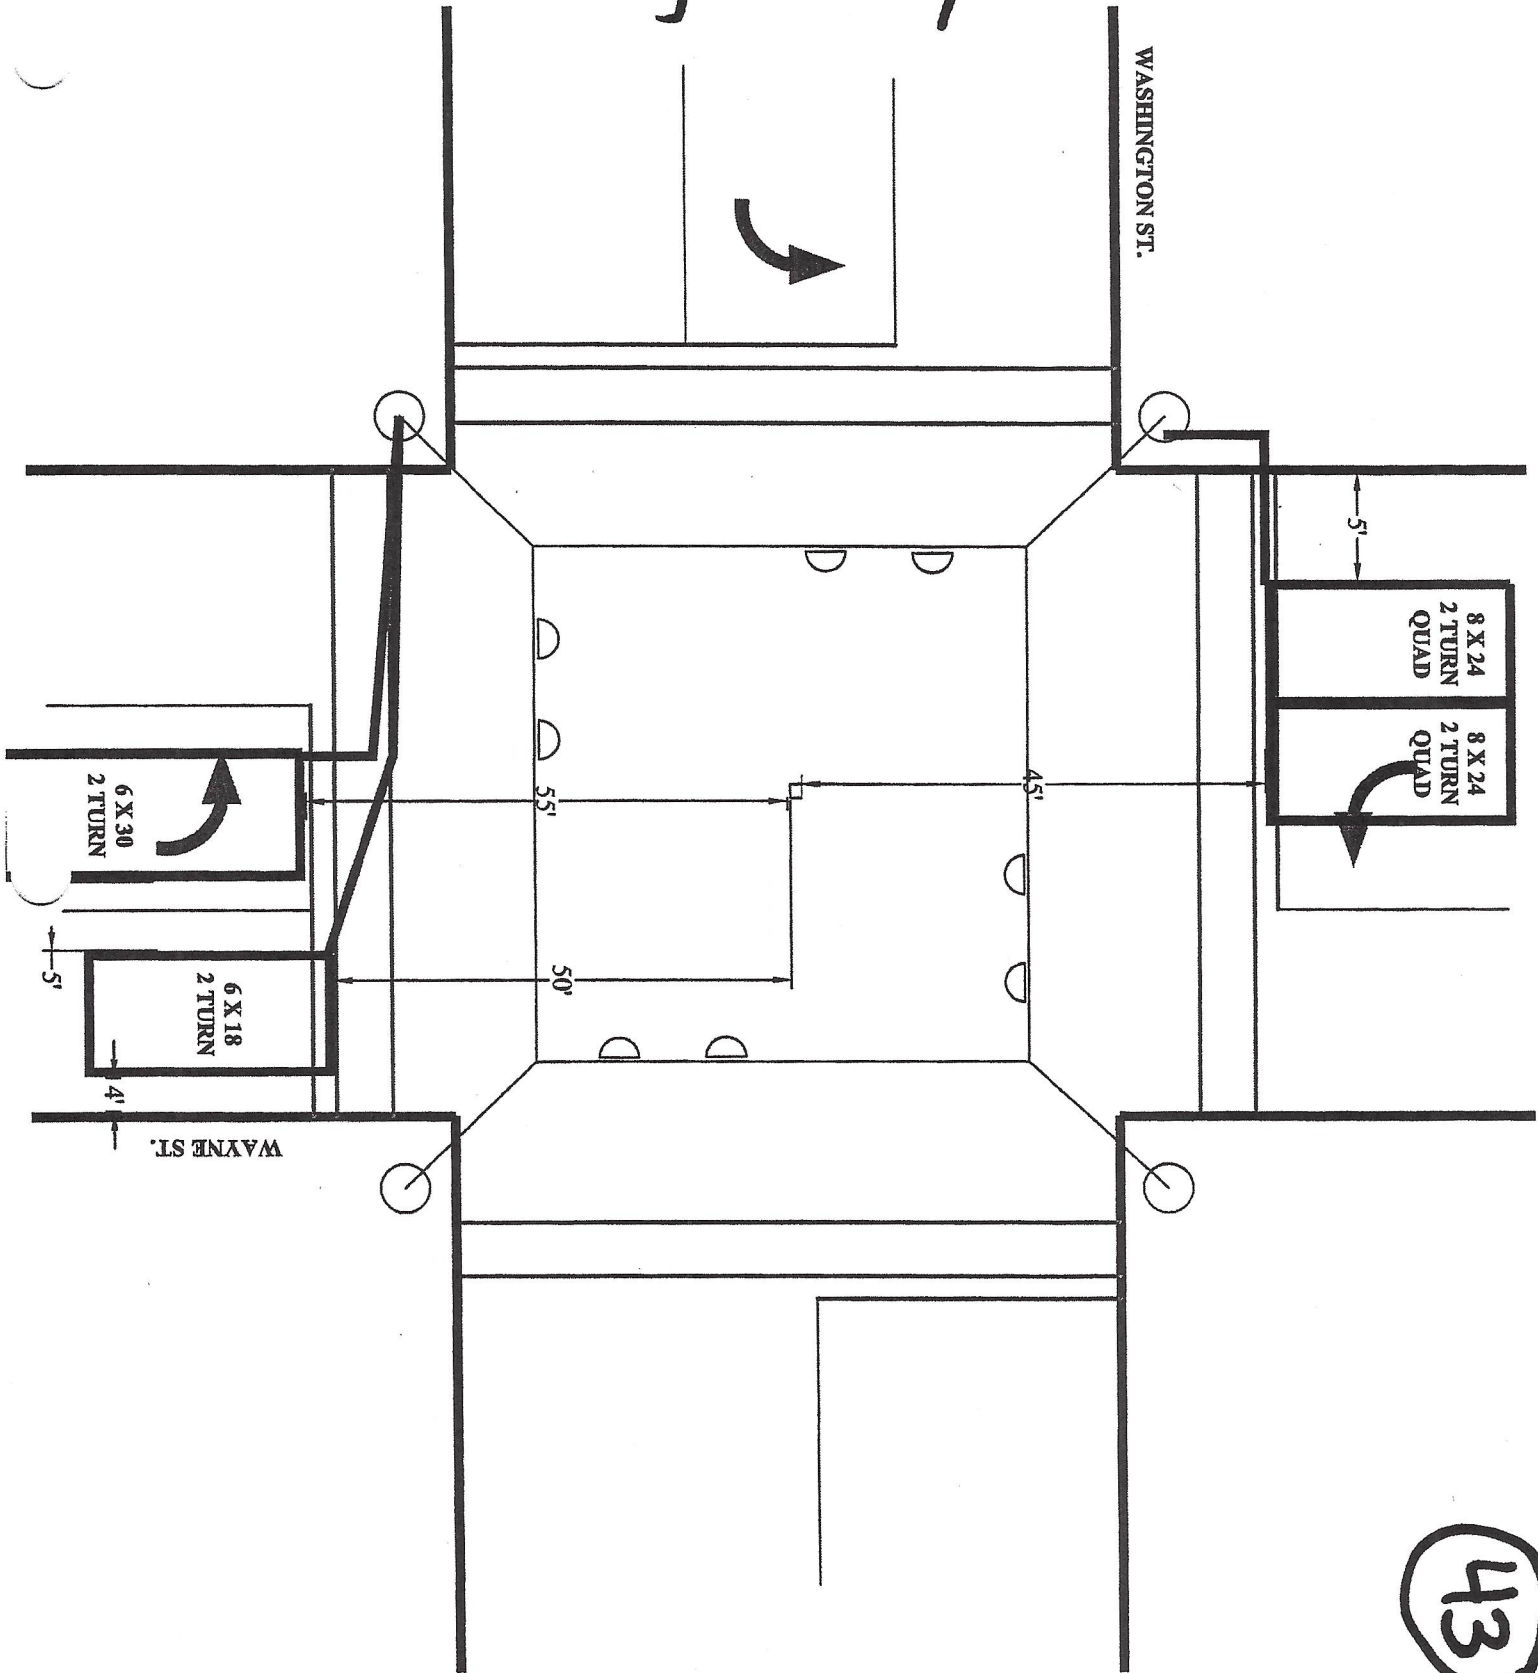

43




Washington + Columbus

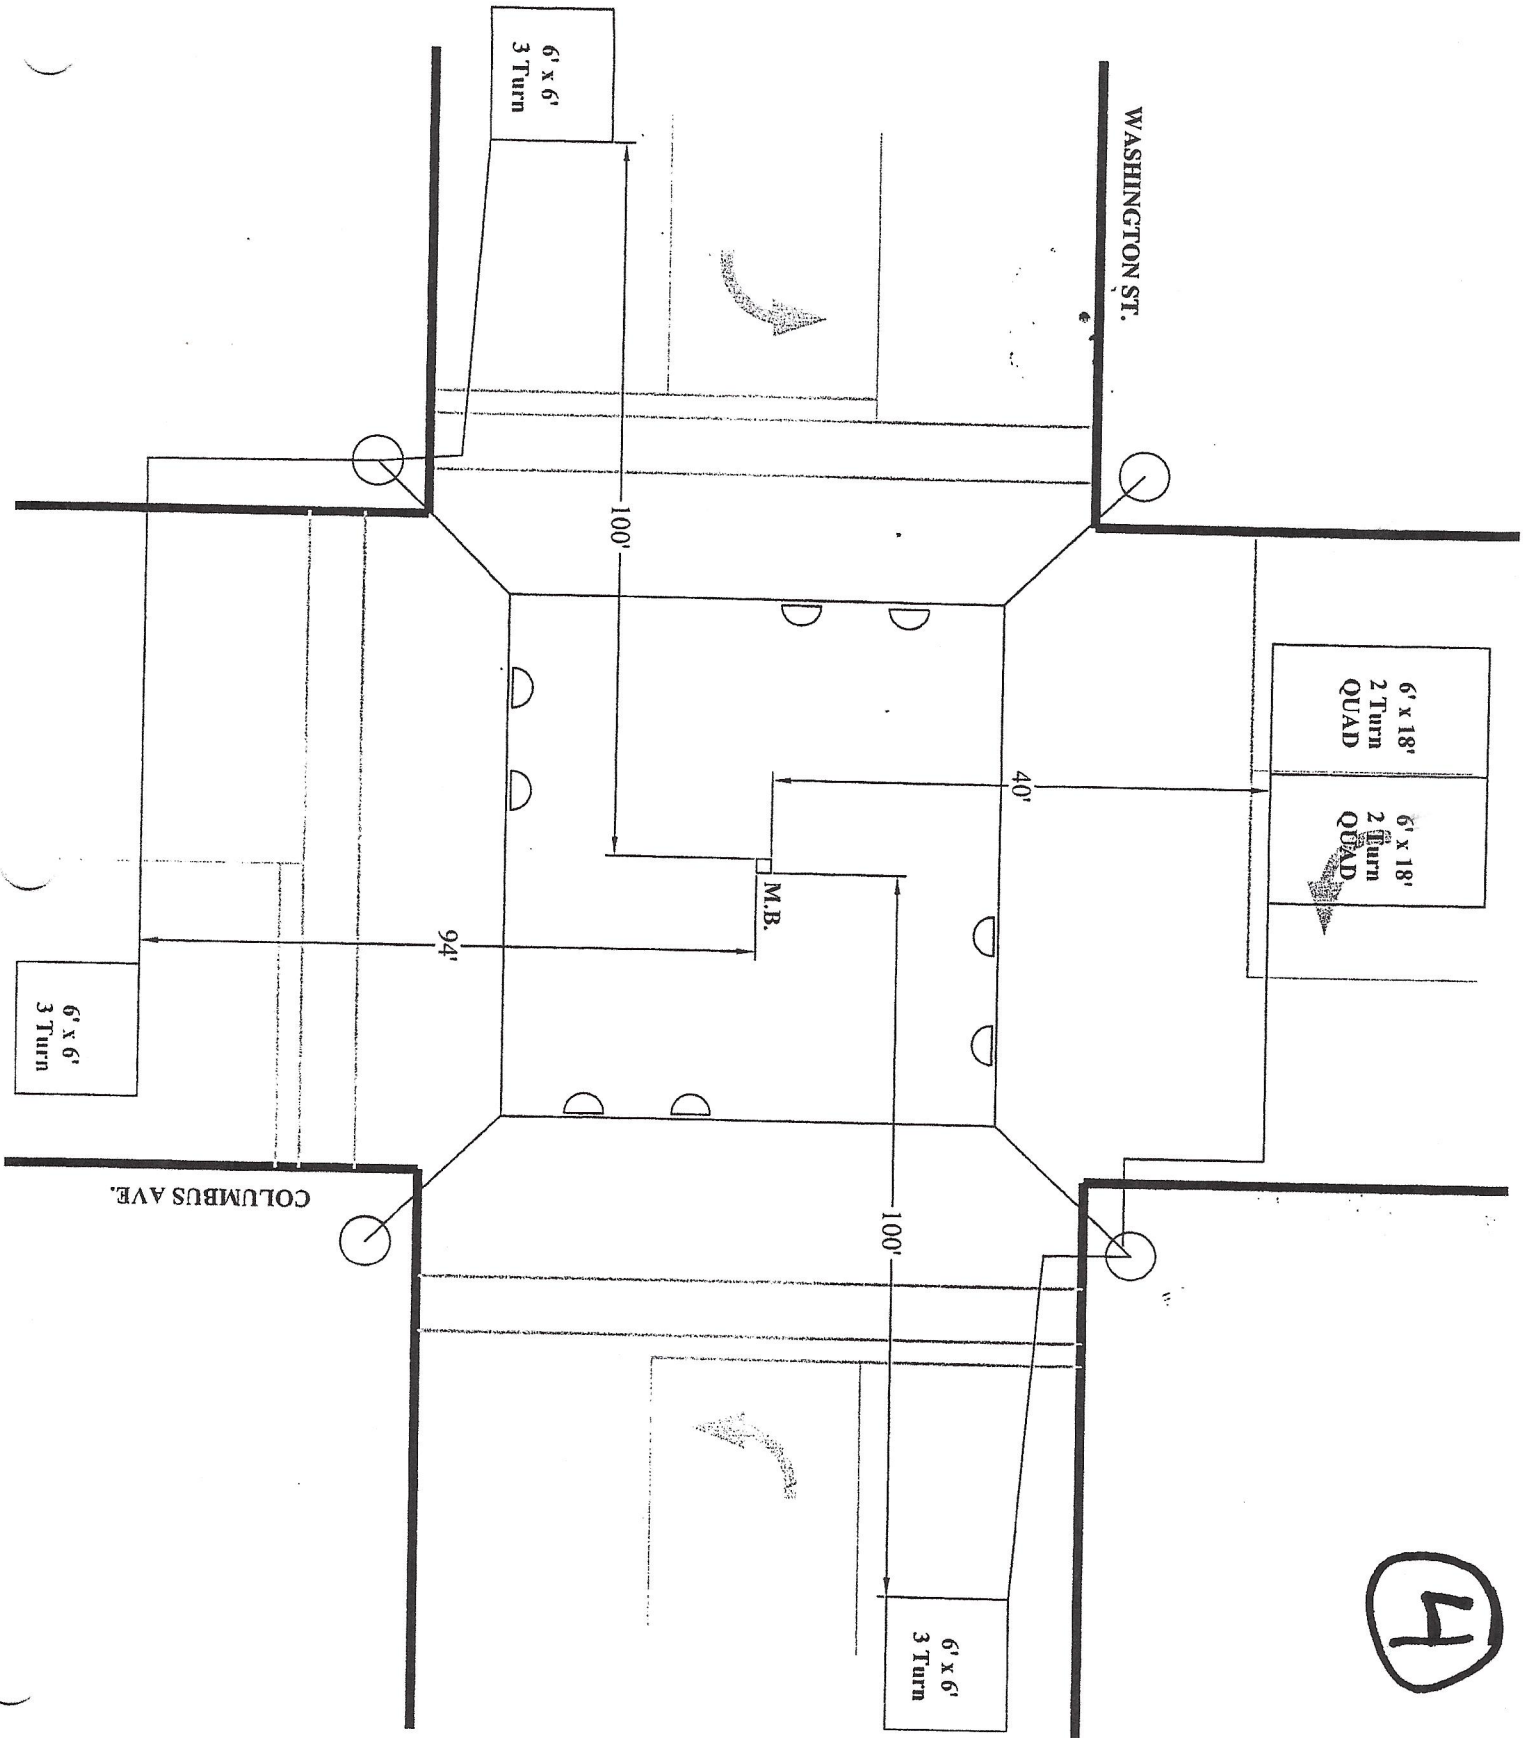

4




WASHINGTON + Jackson

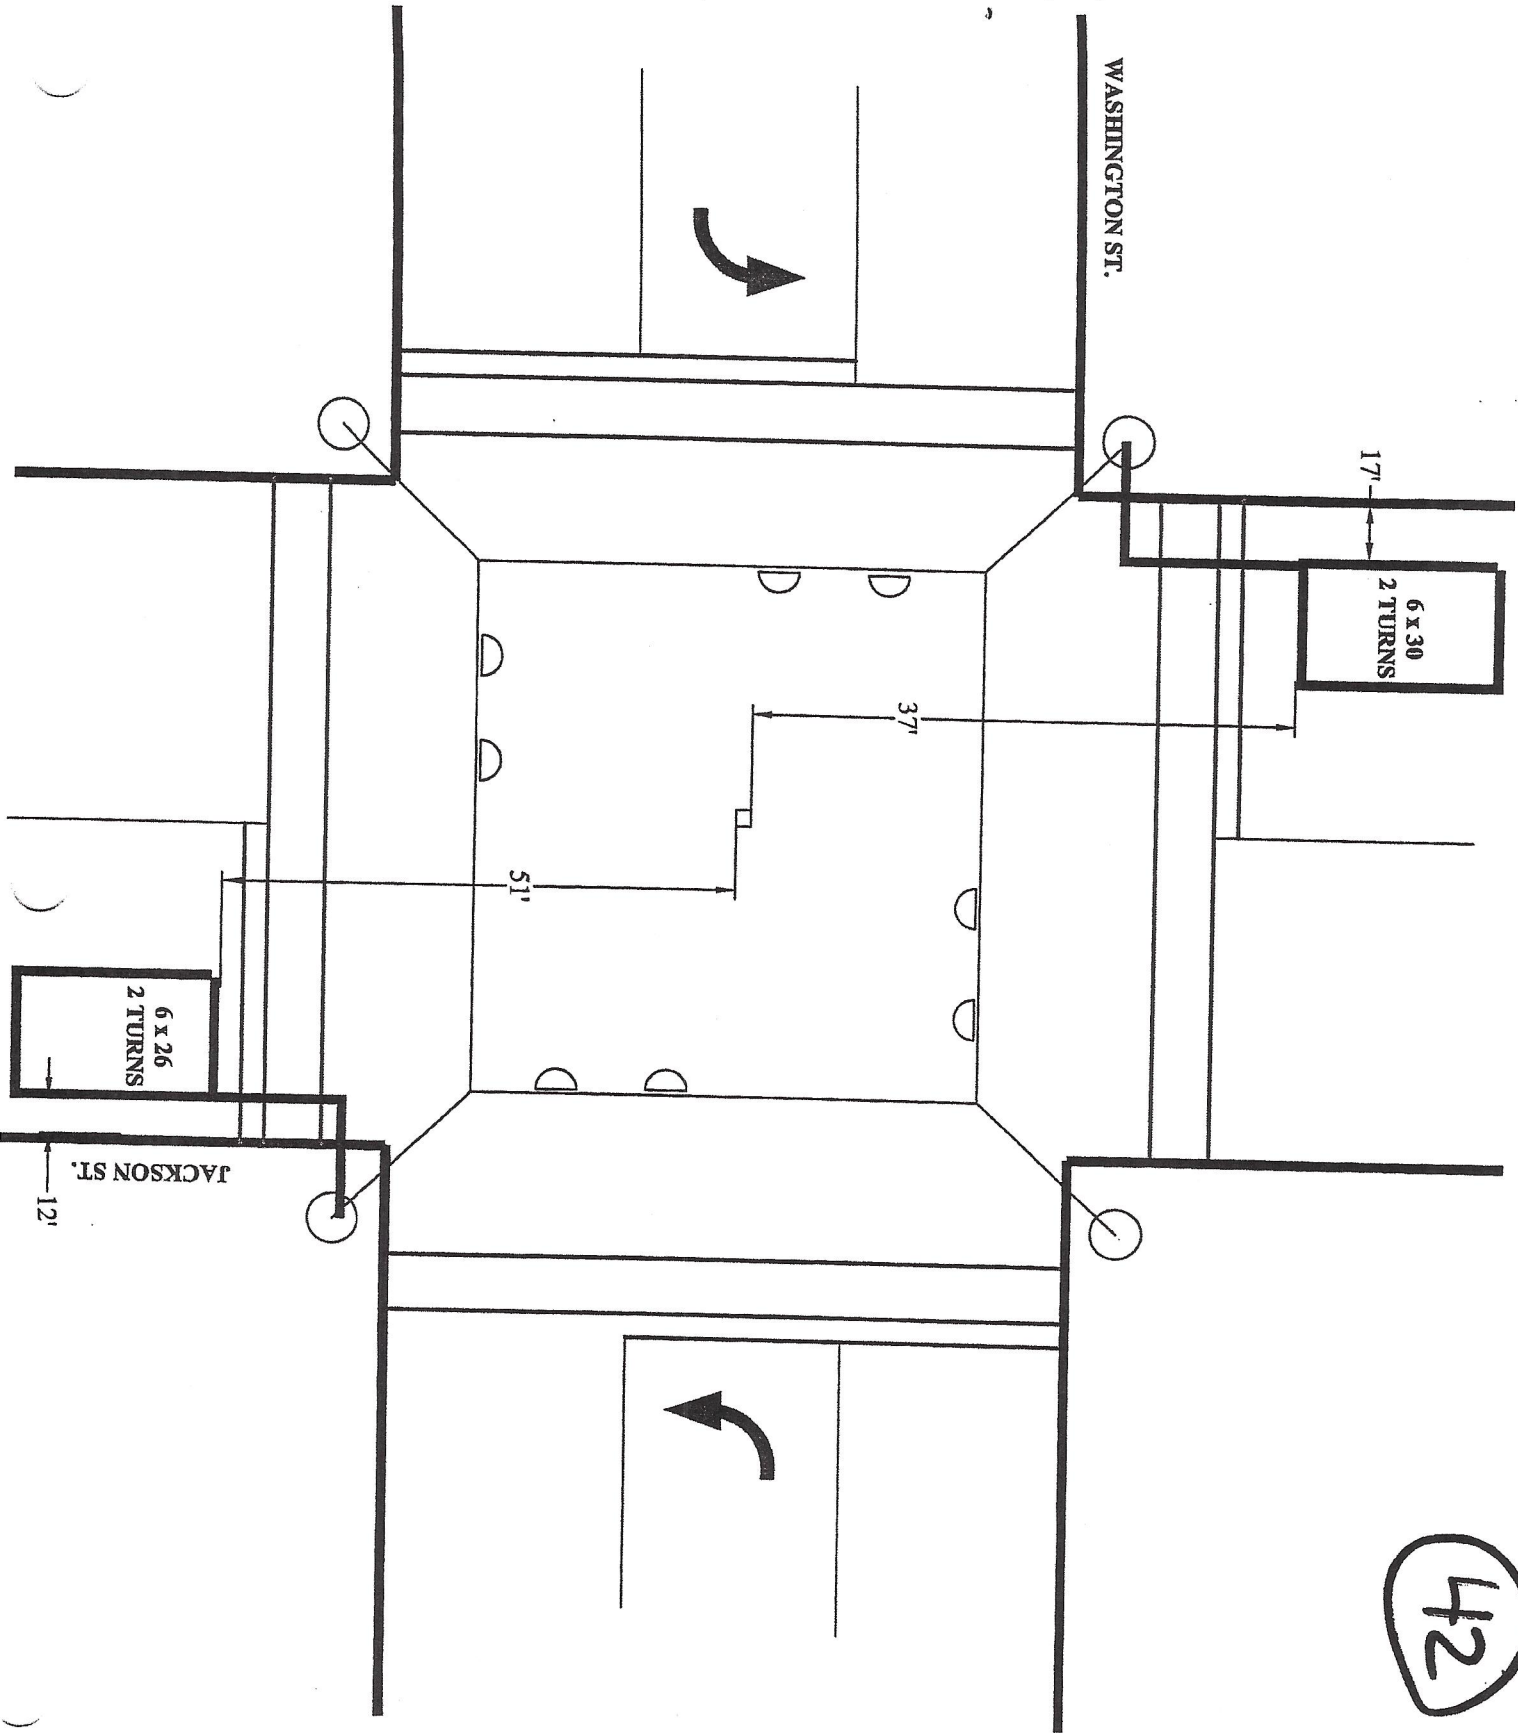

42




WASHINGTON + Decatur

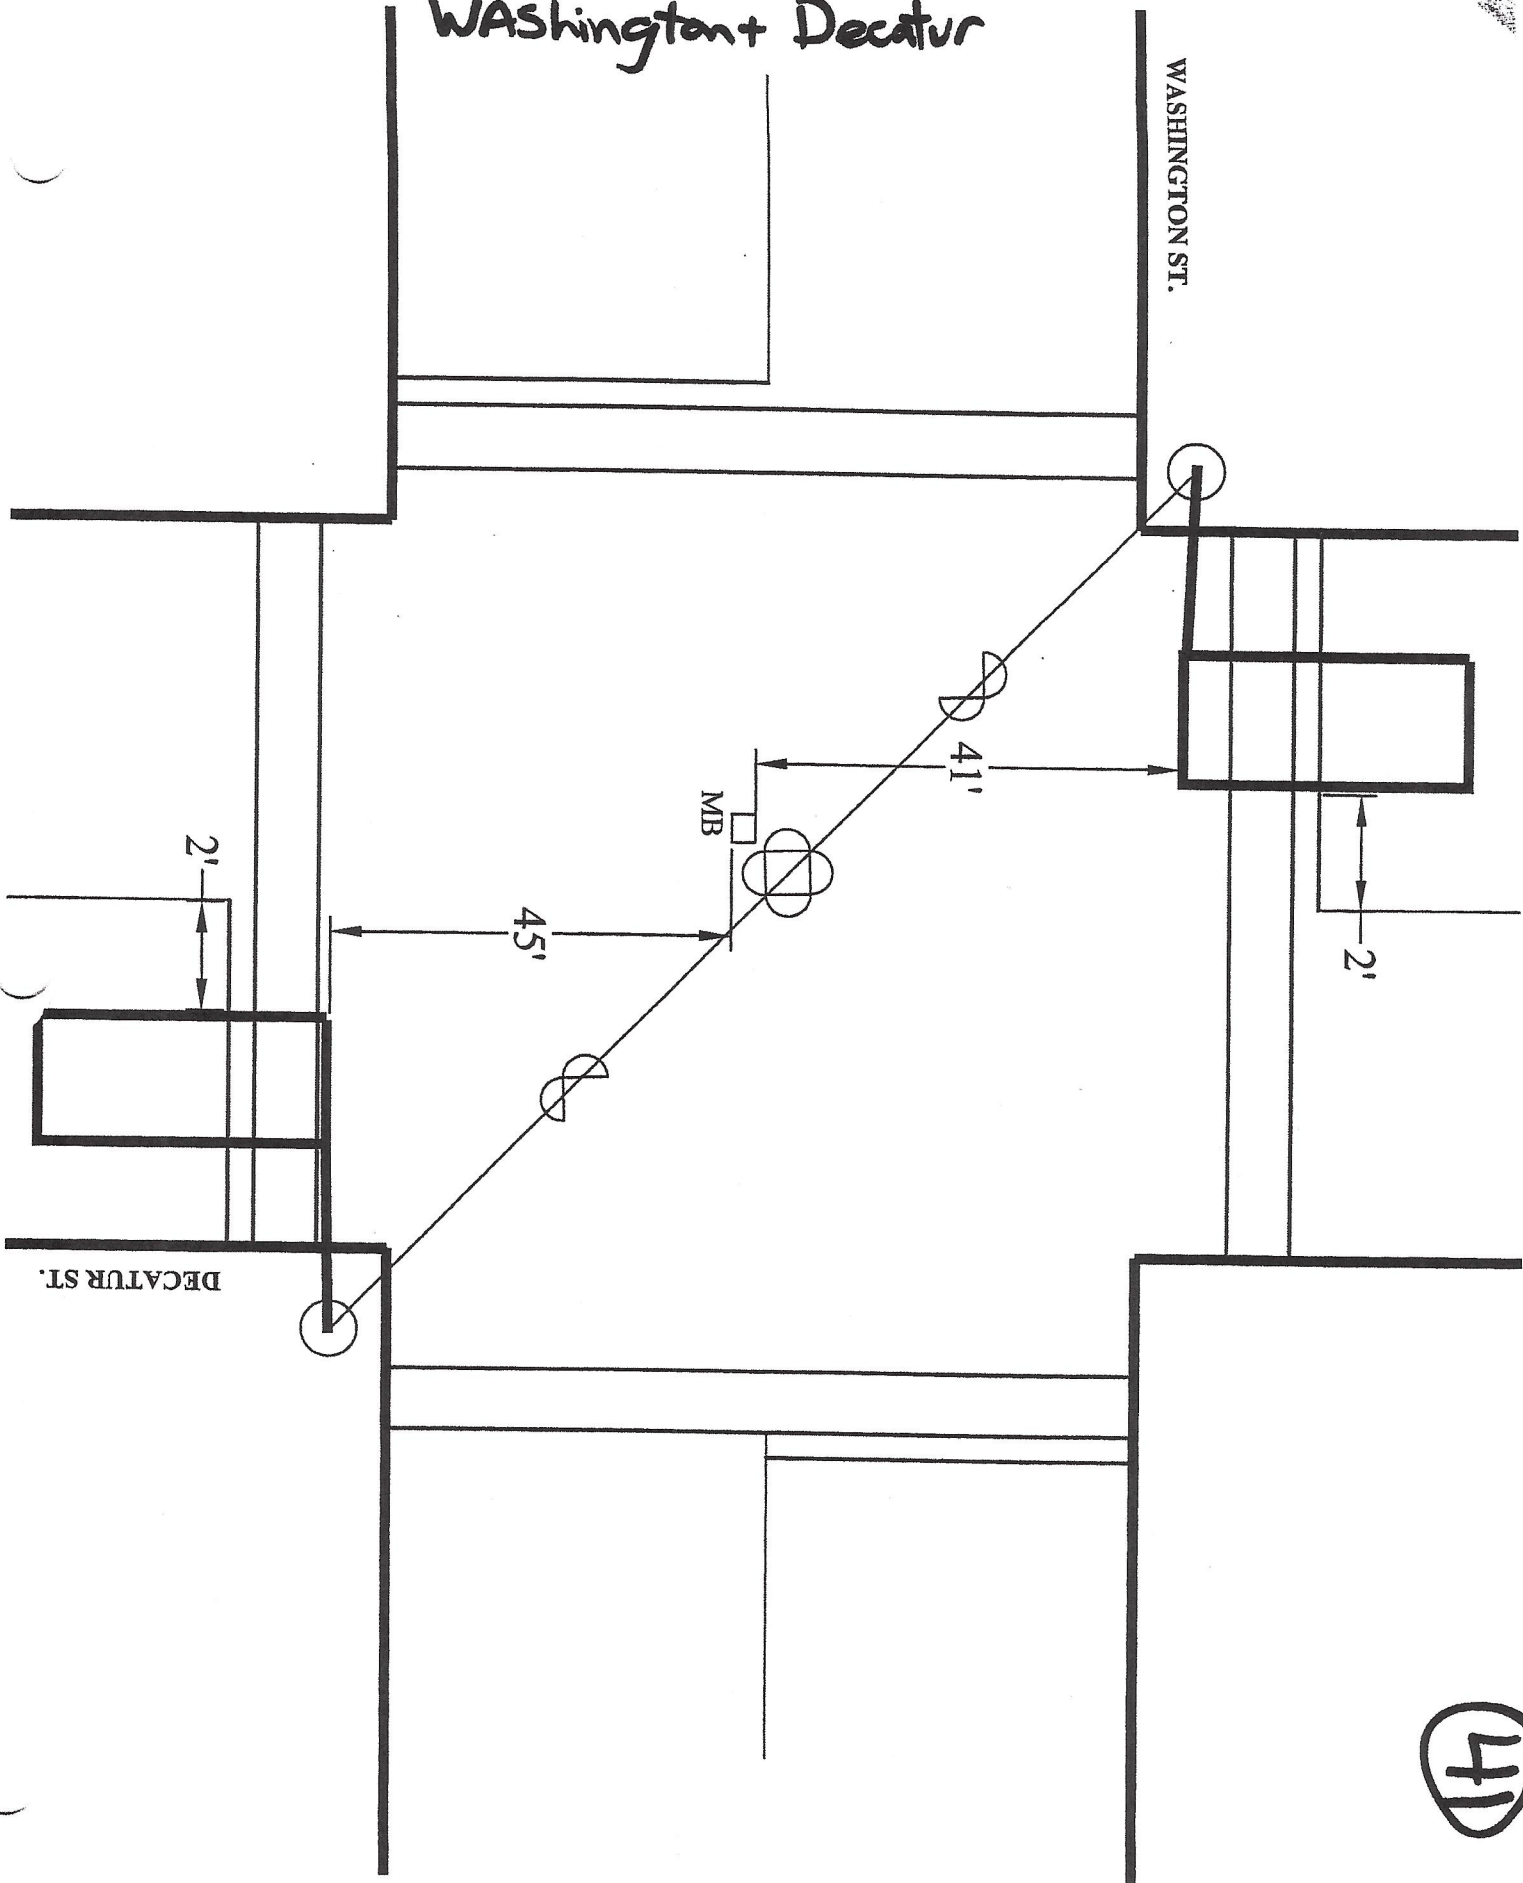

(41)




Washington Camp Shelby

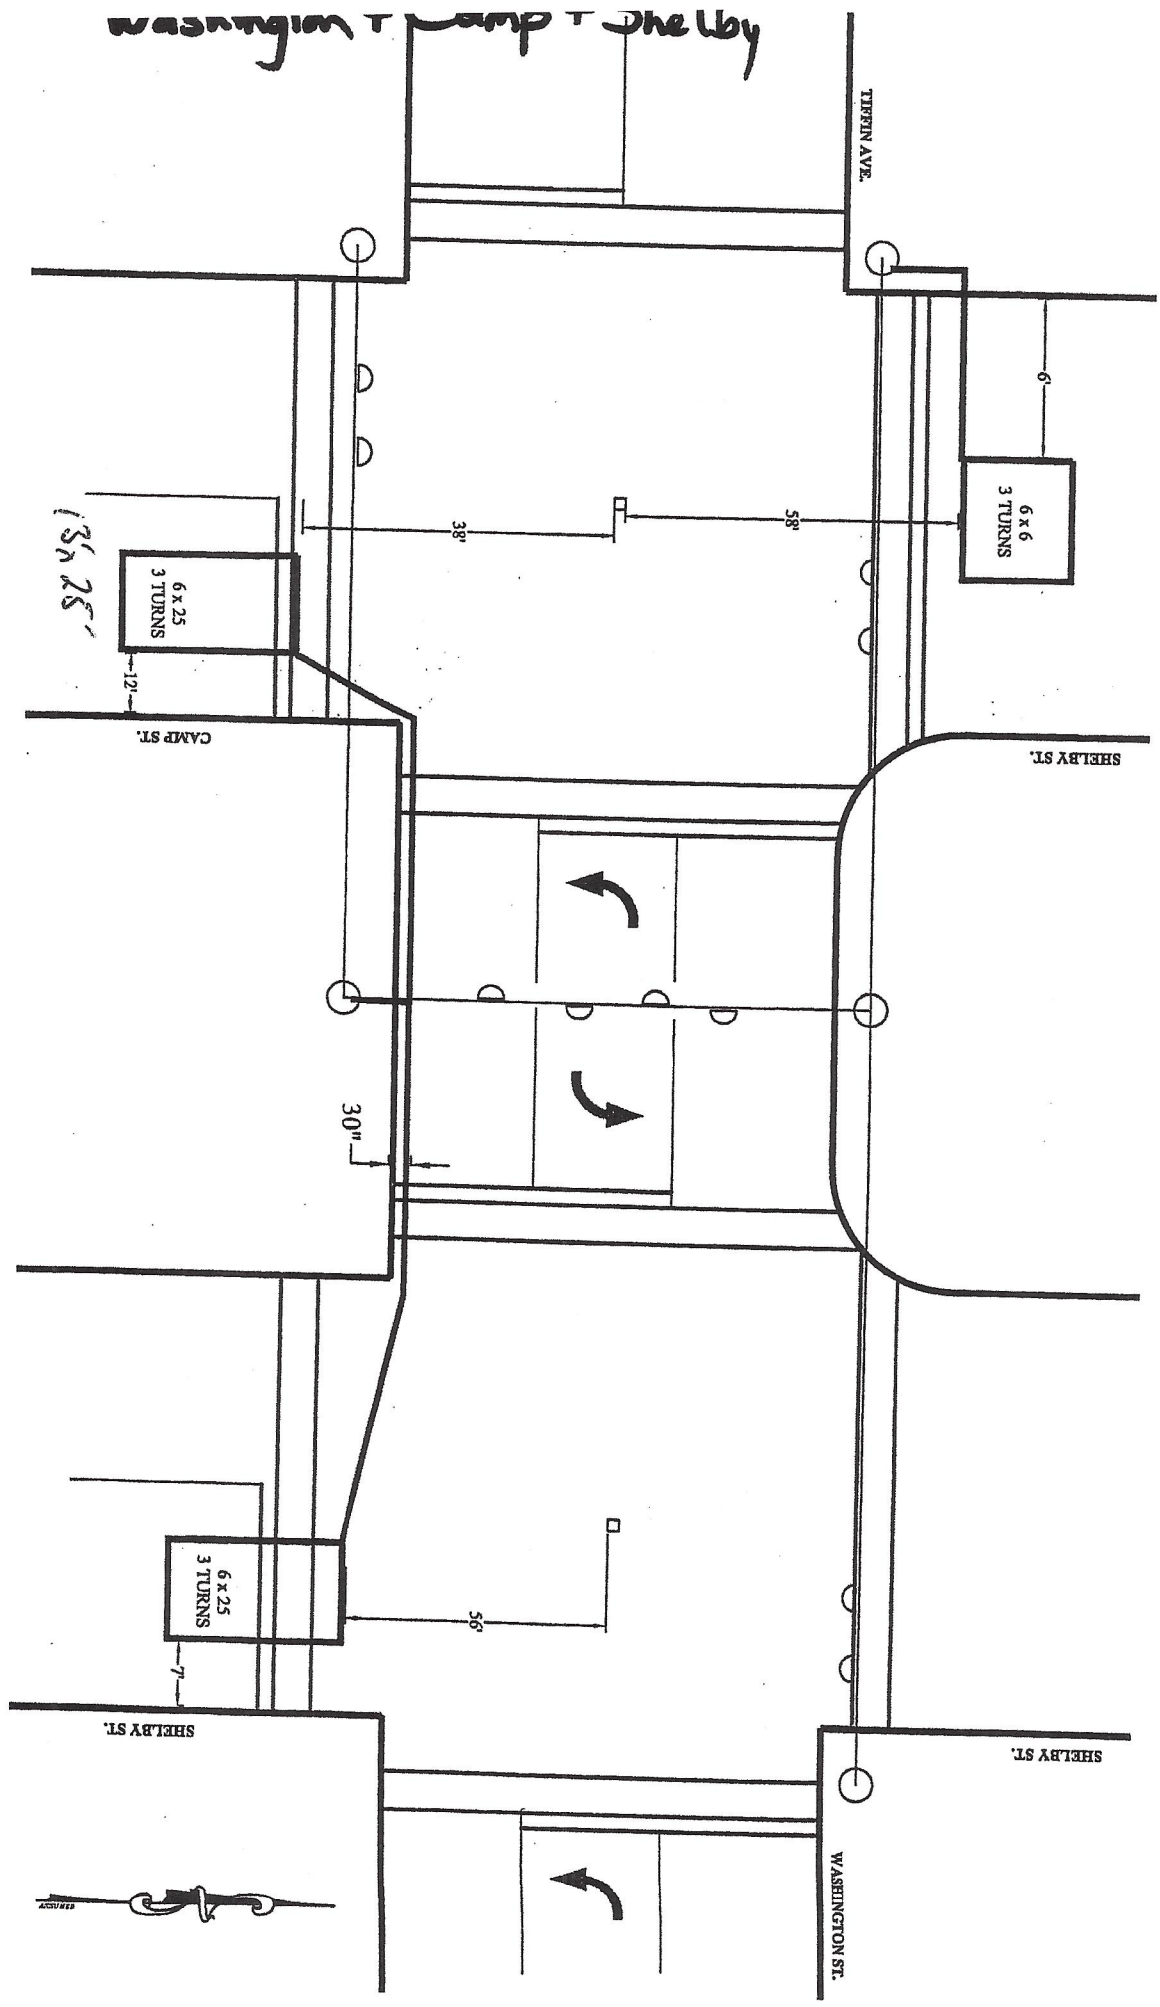


39

Tiffin + Monroe + Mills

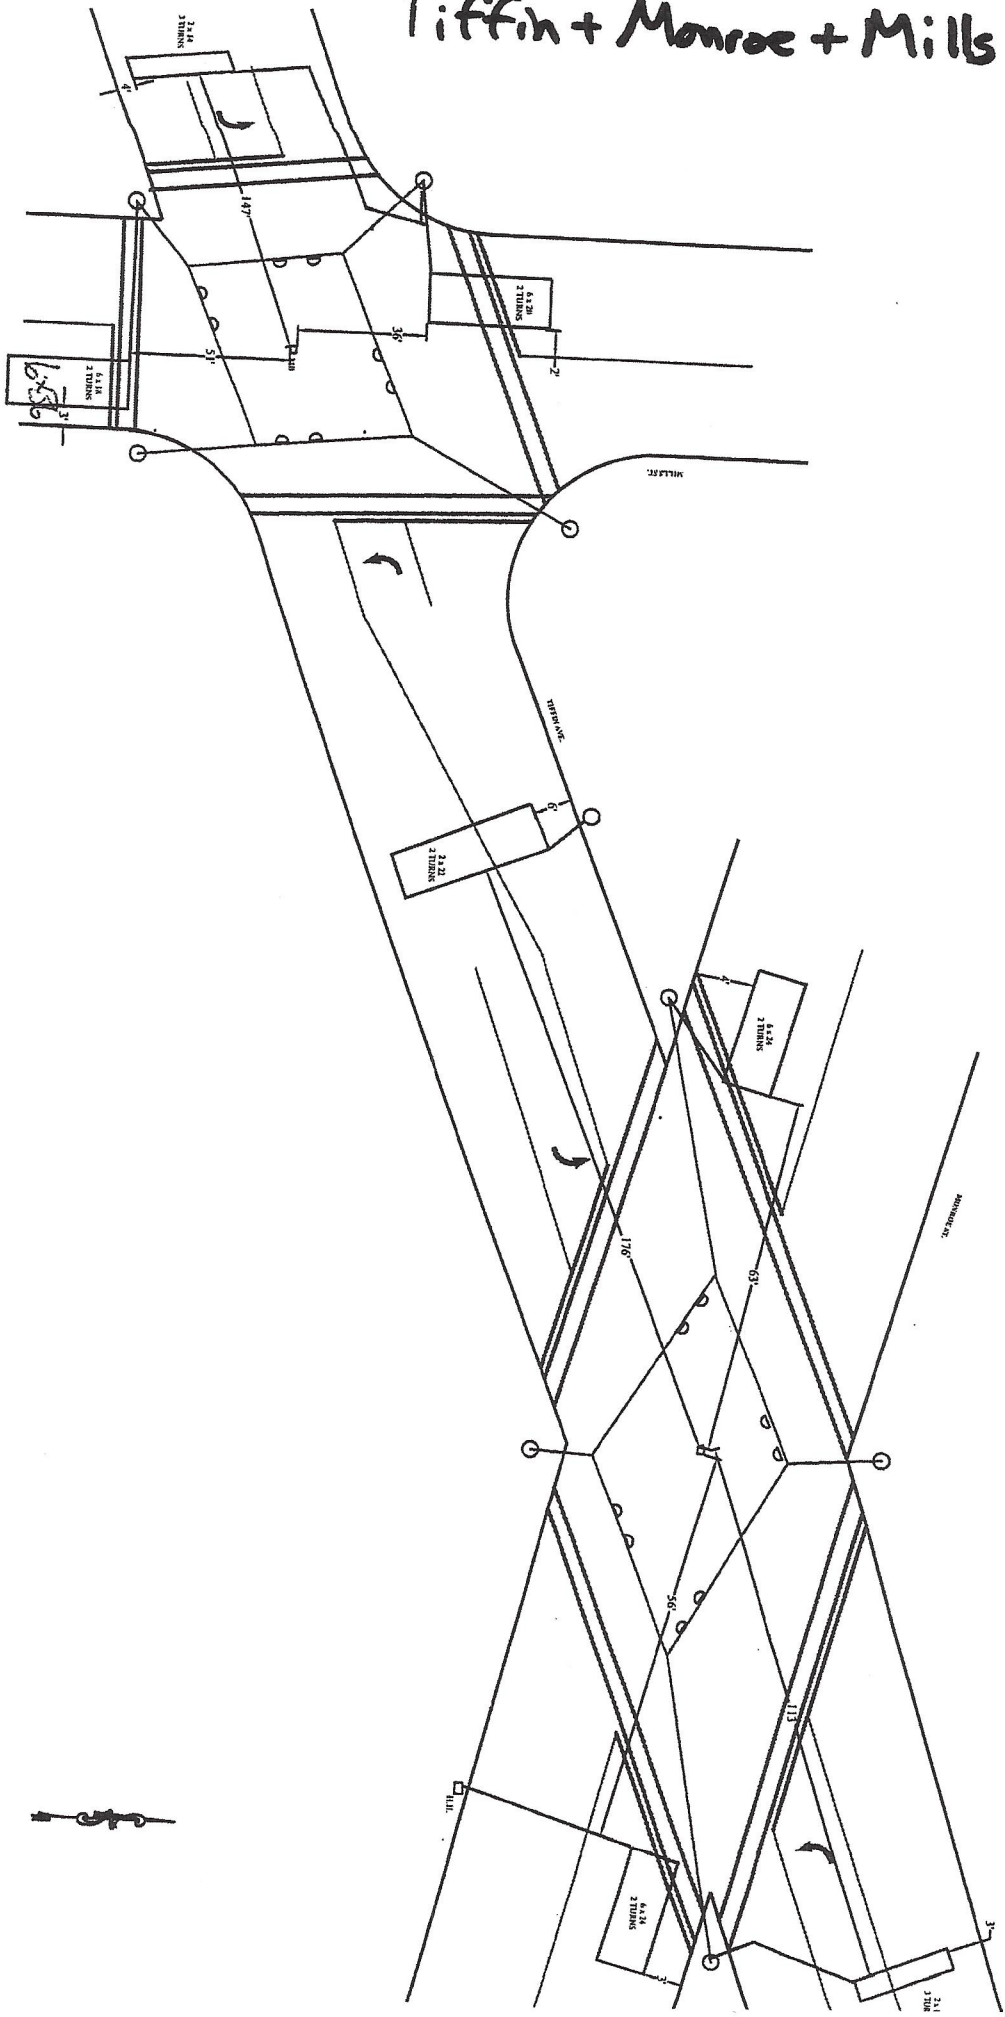

22

Tiffin Ave + Venice Rd / Sanford St.

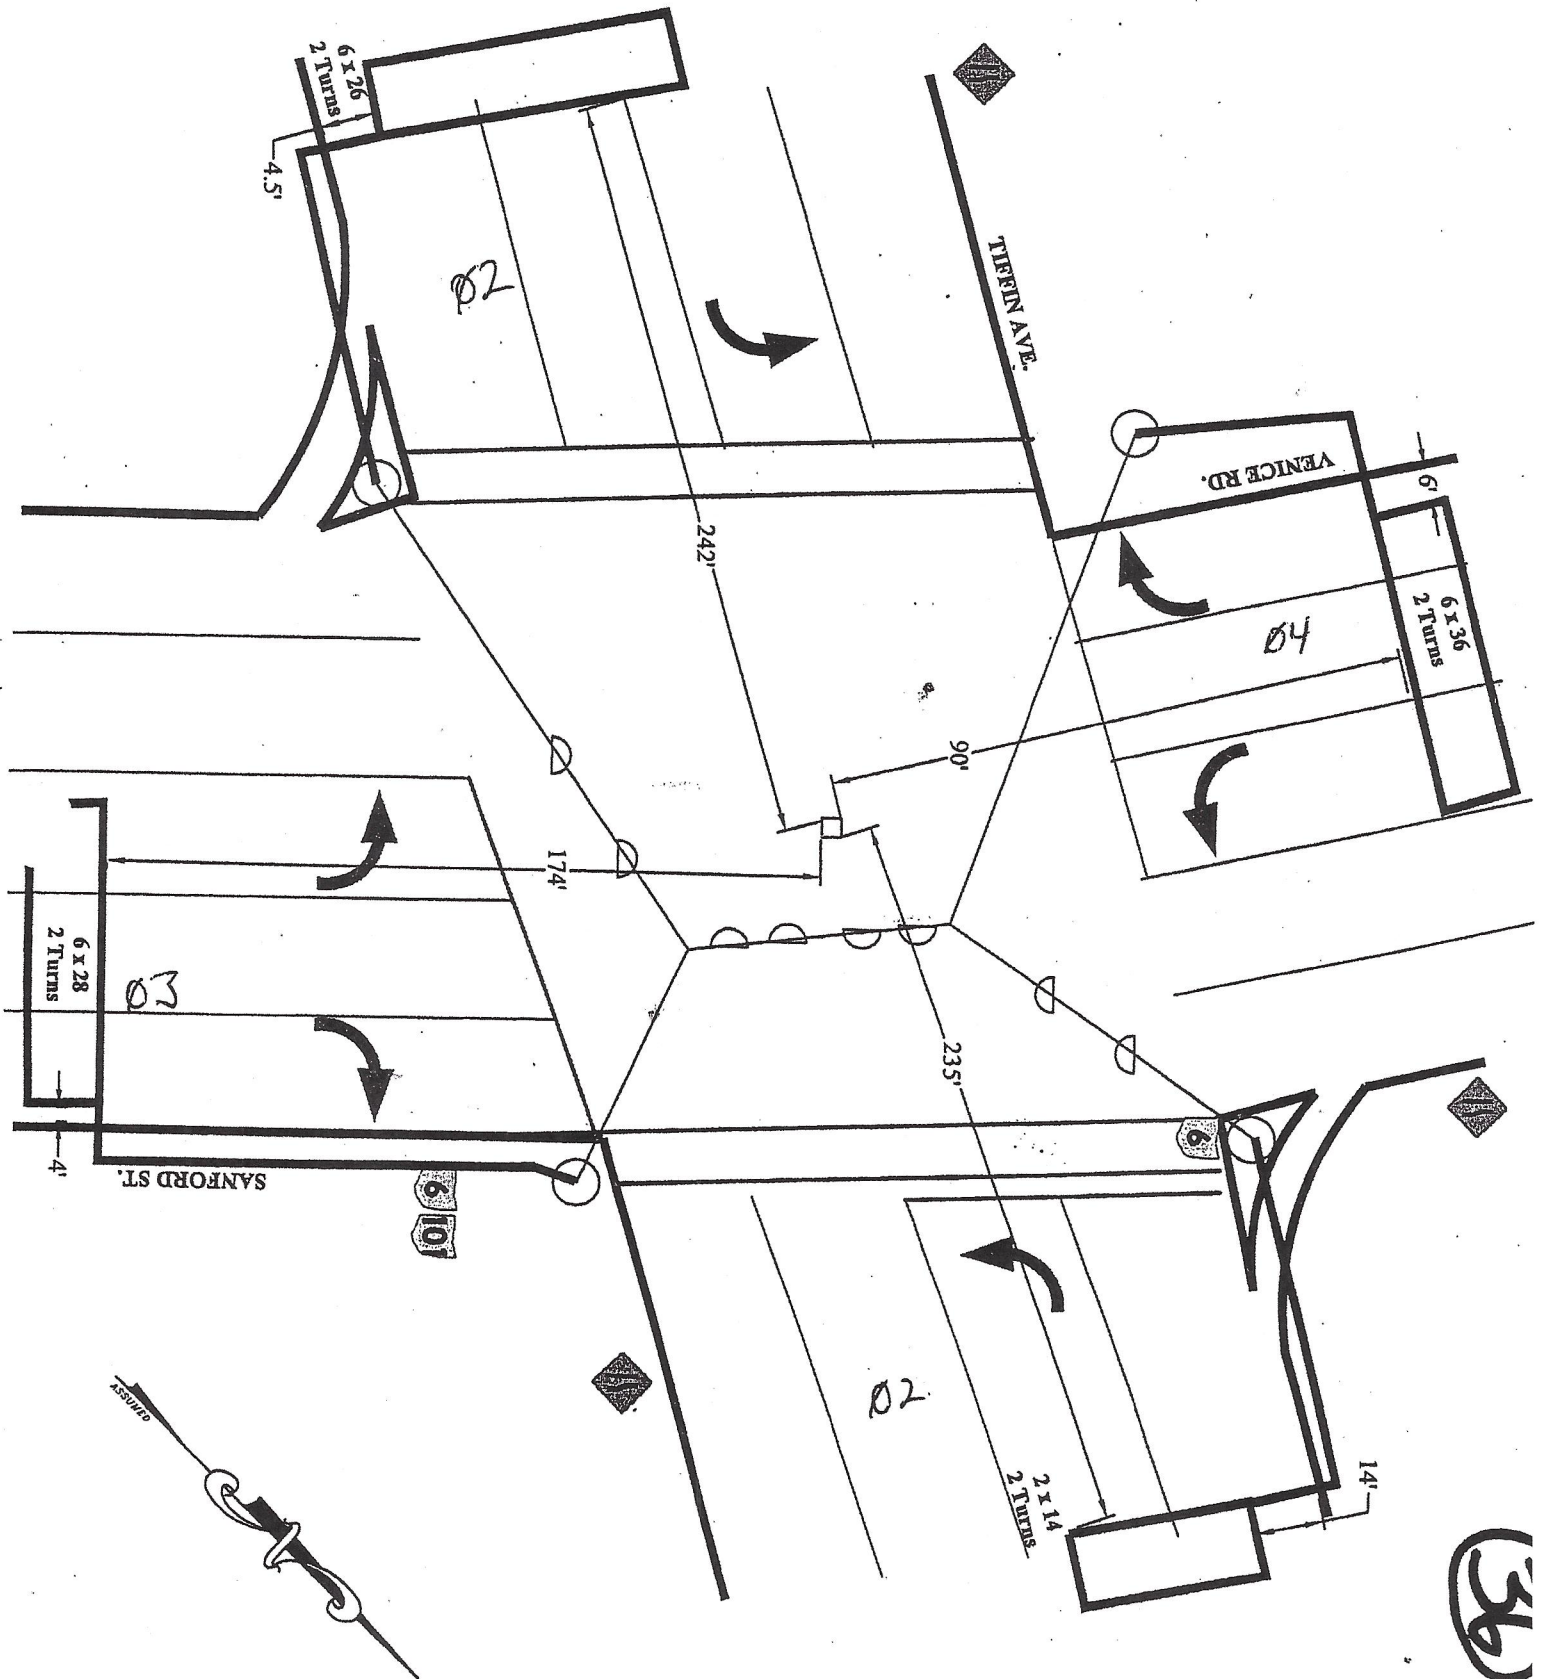

(36)

