

9	2	3
8	1	4
7	6	5

- |                             |                                 |
|-----------------------------|---------------------------------|
| <b>Sewer Manhole</b>        | <b>Sewer Pump Station</b>       |
| ● Combined                  | PS Sanitary                     |
| ● Sanitary                  | PS Storm                        |
| ● Storm                     |                                 |
| ● Storm Inlet               | <b>Sewer Structure</b>          |
| ● Flow Monitor              | ▲ Sewer Structure               |
|                             | ○ Sewer Sluice Gate             |
| <b>Sewer Blind Connect</b>  | ⊠ Sewer Flap Gate               |
| ○ Combined                  | ○ Sewer Outfall                 |
| ○ Sanitary                  | ● Sewer Bulkhead                |
| ○ Storm                     | ● Sewer Treatment Plant         |
| <b>Sewer Main Change</b>    | — WCLPP Line Of Protection      |
| ○ Combined                  | <b>Sewer Main</b>               |
| ○ Sanitary                  | — Sewer, Unclassified           |
| ○ Storm                     | — Combined                      |
| <b>Sewer Pipe End</b>       | — Combined, Abandoned           |
| □ Headwall                  | — Sanitary                      |
| ✈ Not Delivered             | — Sanitary, Abandoned           |
| △ Plain                     | — Storm                         |
| △ Unknown                   | — Storm, Abandoned              |
| <b>Sewer Clean Out</b>      | — Suburb Sanitary Lines         |
| ● Combined                  | ● Suburb Sanitary Manholes      |
| ● Sanitary                  |                                 |
| ● Storm                     | <b>Open Channel</b>             |
| <b>Sewer Flow Regulator</b> | ▭ Sewer Sheds                   |
| ○ Combined                  | ▭ Columbus Corporation Boundary |
| ○ Sanitary                  | ▭ NOT City of Columbus          |
| ○ Storm                     | ▭ County Boundaries             |


**Scale**  
0 100 200  
Feet



Every reasonable effort has been made to assure the accuracy of these maps and associated data. The City of Columbus assumes no liability arising from use of these maps or data. THE MAPS ARE PROVIDED WITHOUT WARRANTY OF ANY KIND, either expressed or implied, including, but not limited to, the implied warranties of merchantability and fitness for a particular purpose.

DEPARTMENT OF PUBLIC UTILITIES GIS MAPPING SECTION

CREATED: 10/23/2012

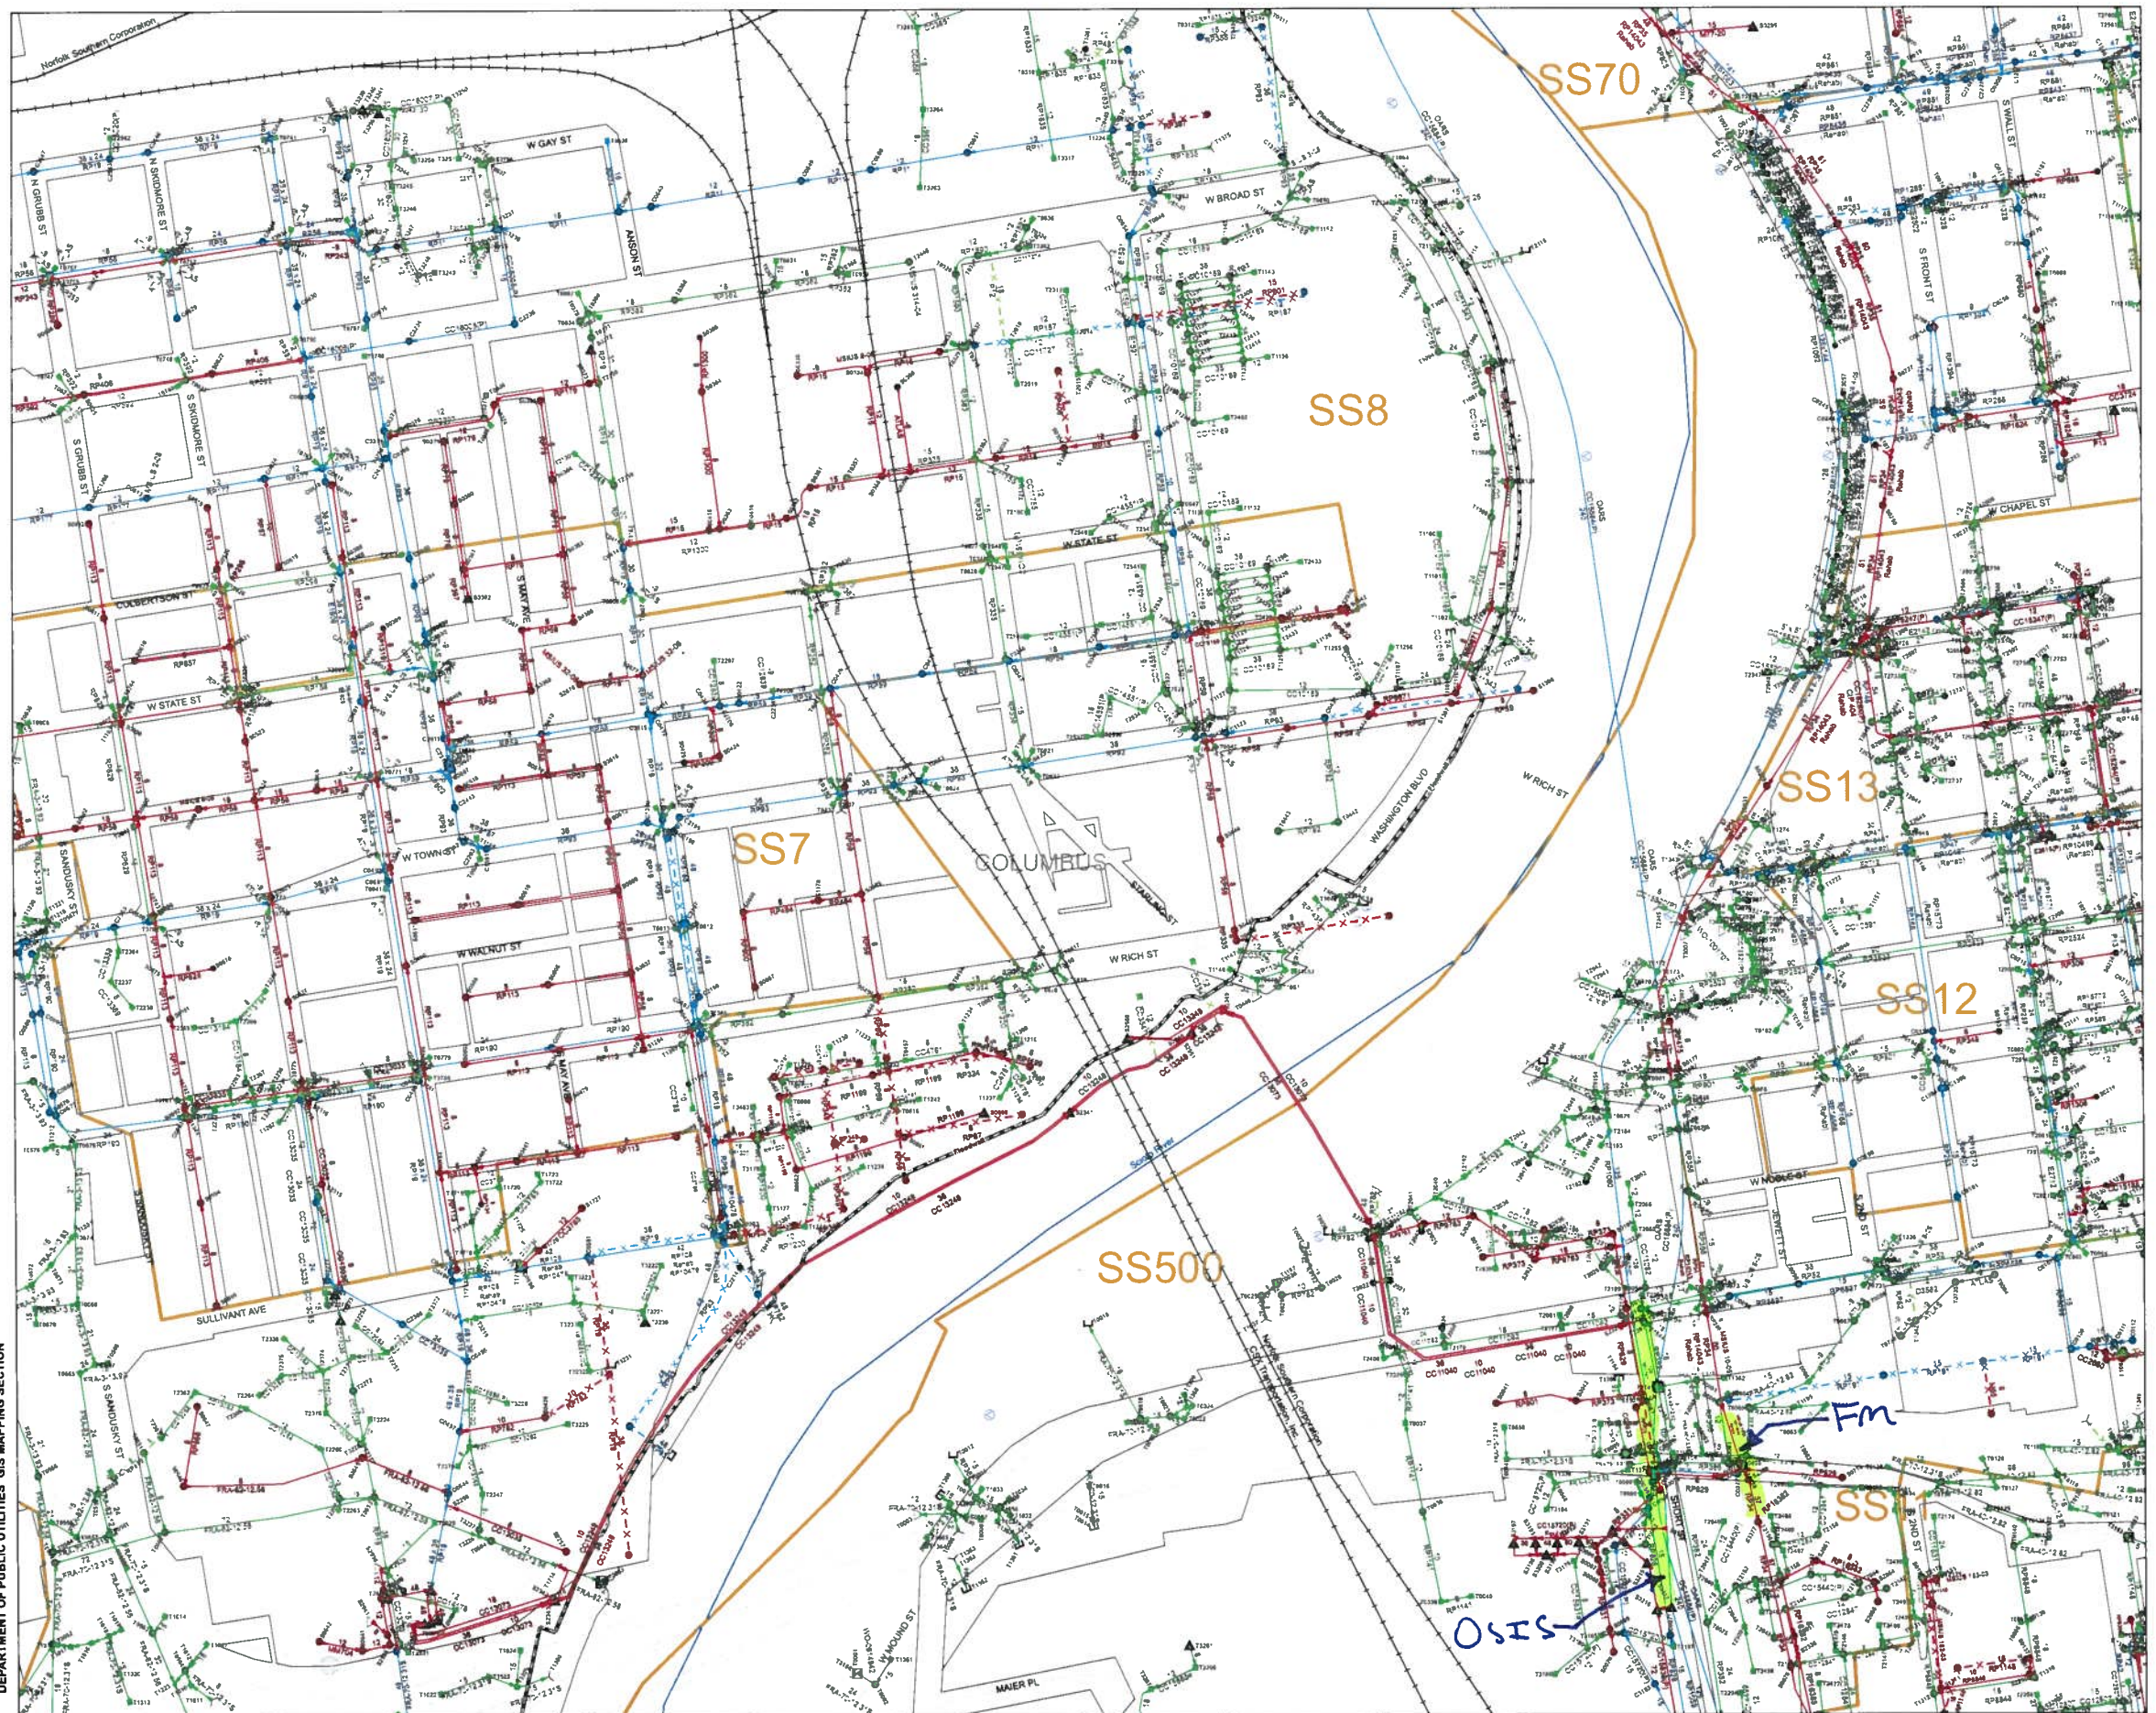

# Sewer Atlas 1



8	1	4
7	6	5
20	19	18

- |                            |                                 |
|----------------------------|---------------------------------|
| <b>Sewer Main</b>          | <b>Sewer Clean Out</b>          |
| — Sewer: Other             | ● Combined                      |
| — Combined: Existing       | ● Sanitary                      |
| — Combined: Proposed       | ● Storm                         |
| — Combined: Abandoned      | <b>Sewer Flow Regulator</b>     |
| — Sanitary: Existing       | □ Combined                      |
| — Sanitary: Proposed       | □ Sanitary                      |
| — Sanitary: Abandoned      | □ Storm                         |
| — Storm: Existing          | <b>Sewer Pump Station</b>       |
| — Storm: Proposed          | PS Sanitary                     |
| — Storm: Abandoned         | PS Storm                        |
| <b>Sewer Manhole</b>       | <b>DOSD BMP Locations</b>       |
| ● Combined                 | ● DOSD BMP Locations            |
| ● Sanitary                 | <b>Sewer Structure</b>          |
| ● Storm                    | ▲ Sewer Structure               |
| ● Storm Inlet              | ⊙ Sewer Sluice Gate             |
| ● Flow Monitor             | ⊙ Sewer Flap Gate               |
| <b>Sewer Blind Connect</b> | ⊙ Sewer Outfall                 |
| ○ Combined                 | ● Sewer Bulkhead                |
| ○ Sanitary                 | ⊙ Sewer Treatment Plant         |
| ○ Storm                    | — WCLPP Line Of Protection      |
| <b>Sewer Main Change</b>   | <b>Open Channel</b>             |
| ○ Combined                 | — Sewer Sheds                   |
| ○ Sanitary                 | — Columbus Corporation Boundary |
| ○ Storm                    | — NOT City of Columbus          |
| <b>Sewer Pipe End</b>      | — County Boundaries             |
| ⌋ Headwall                 |                                 |
| ⌋ Not Delivered            |                                 |
| ⌋ Plain                    |                                 |
| ⌋ Unknown                  |                                 |

**Scale**  
0 100 200  
Feet



While every reasonable effort has been made to ensure the accuracy of this information, it is provided without warranty of any kind, whether expressed or implied. The City of Columbus assumes no liability arising from any use of this information and is not responsible for its accuracy or completeness. Those using this information for any reason are solely responsible for its use and do so at their own risk.

DEPARTMENT OF PUBLIC UTILITIES GIS MAPPING SECTION

CREATED: 7/23/2019



# Sewer Atlas 6