


# STATE OF OHIO DEPARTMENT OF TRANSPORTATION

## FRA-670-0.87

CITY OF COLUMBUS  
FRANKLIN COUNTY

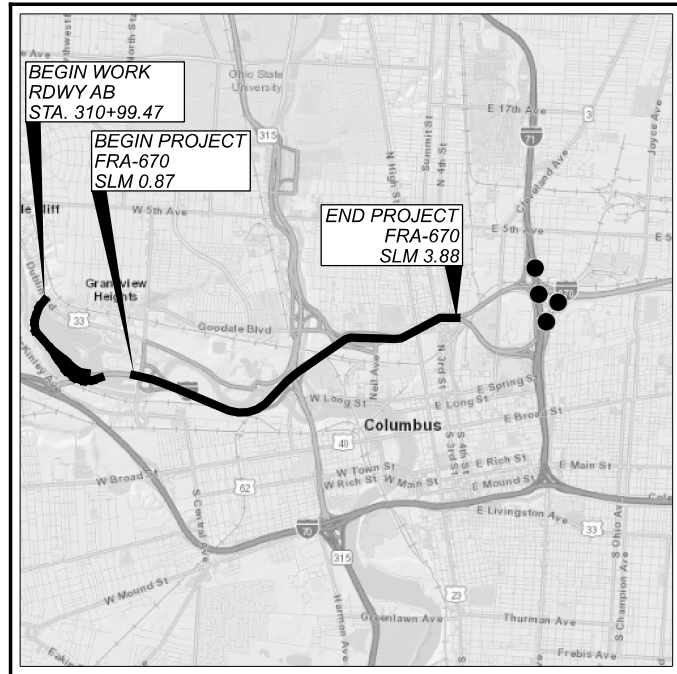

**LOCATION MAP**

LATITUDE: 39°58'5" LONGITUDE: 83°01'25"



|   |       |
|---|-------|
| PORTION TO BE IMPROVED                    | ----- |
| VARIOUS BRIDGES OUTSIDE OF PROJECT LIMITS | ----- |
| INTERSTATE HIGHWAY                        | ===== |
| FEDERAL ROUTES                            | ===== |
| STATE ROUTES                              | ===== |
| COUNTY & TOWNSHIP ROADS                   | ===== |
| OTHER ROADS                               | ----- |

**DESIGN DESIGNATION**

|                                   |                                       |
|-----------------------------------|---------------------------------------|
| CURRENT ADT (2023)                | 129,000                               |
| DESIGN YEAR ADT (2035)            | 152,000                               |
| DESIGN HOURLY VOLUME (2035)       | 15,000                                |
| DIRECTIONAL DISTRIBUTION          | 50%                                   |
| TRUCKS (24 HOUR B&C)              | 8%                                    |
| DESIGN SPEED                      | 65 MPH                                |
| LEGAL SPEED                       | 65 MPH (0.00-2.11)/55 MPH (2.11-4.00) |
| DESIGN FUNCTIONAL CLASSIFICATION: | 01 INTERSTATES (URBAN)                |
| NHS PROJECT                       | YES                                   |

**DESIGN EXCEPTIONS**

NONE REQUIRED

**ADA DESIGN WAIVERS**

NONE REQUIRED

**UNDERGROUND UTILITIES**  
Contact Two Working Days  
Before You Dig

**OHIO811.org**  
Before You Dig

OHIO 811, 8-1-1, or 1-800-362-2764  
(Non members must be called directly)

PLAN PREPARED BY:  
  
IN HOUSE DESIGN

ENGINEER'S SEAL:

SIGNED: *Katherine L. Montoya*  
DATE: 1/6/2022

**INDEX OF SHEETS:**

|  |              |
|--|--------------|
| TITLE  | P.1          |
| SCHEMATIC PLAN                                 | P.2 - P.8    |
| TYPICAL SECTIONS                               | P.9 - P.10   |
| TYPICAL DETAILS                                | P.11 - P.12  |
| GUARDRAIL PLAN INSERT SHEETS                   | P.13 - P.17  |
| GENERAL NOTES                                  | P.18 - P.21  |
| MAINTENANCE OF TRAFFIC NOTES                   | P.22 - P.26  |
| BIKE LANE CLOSURE DETAIL                       | P.27         |
| MAINTENANCE OF TRAFFIC QUANTITIES              | P.28         |
| MAINTENANCE OF TRAFFIC PLAN                    | P.29         |
| RAMP DETOUR PLANS                              | P.30 - P.38  |
| GENERAL SUMMARY                                | P.39 - P.40  |
| PAVEMENT REPAIR CALCULATIONS                   | P.41         |
| PAVEMENT CALCULATIONS                          | P.42 - P.44  |
| ROADWAY SUBSUMMARY                             | P.45         |
| I-670 PLAN                                     | P.46 - P.52  |
| I-670 AND US 33T INTERCHANGE PLAN              | P.53 - P.57  |
| I-670 AND SR 315 INTERCHANGE PLAN              | P.58 - P.59  |
| I-670 AND GOODALE ST/NEIL AVE INTERCHANGE PLAN | P.60 - P.61  |
| I-670 AND US 23D/US 23 INTERCHANGE PLAN        | P.62 - P.63  |
| CONCRETE BARRIER REPLACEMENTS                  | P.64 - P.65  |
| DRAINAGE CLEANOUT PLAN                         | P.66 - P.68  |
| TRAFFIC CONTROL SUBSUMMARY                     | P.69         |
| TRAFFIC CONTROL CALCULATIONS                   | P.70 - P.78  |
| STRUCTURE REHABILITATION SCHEDULE              | P.79         |
| STRUCTURE NOTES                                | P.80         |
| STRUCTURE ESTIMATED QUANTITIES                 | P.81 - P.82  |
| STRUCTURE PLAN                                 | P.83 - P.104 |

NO FILL WILL BE ADDED TO THE 100-YEAR FLOODPLAIN

| STANDARD CONSTRUCTION DRAWINGS        |          |          |          |           |          |          | SUPPLEMENTAL SPECIFICATIONS                       |     |          |
|---------------------------------------|----------|----------|----------|-----------|----------|----------|---|-----|----------|
| BP-2.3                                | 07/18/14 | MT-95.30 | 07/19/19 | MT-98.30  | 07/16/21 | TC-41.20 | 10/18/13  | 800 | 10/15/21 |
| BP-2.4                                | 07/19/13 | MT-95.45 | 01/17/20 | MT-99.20  | 04/19/19 | TC-42.20 | 10/18/13  | 807 | 7/16/21  |
| BP-2.5                                | 07/19/13 | MT-95.50 | 07/21/17 | MT-101.60 | 01/17/20 | TC-52.10 | 10/18/13  | 809 | 10/15/21 |
| BP-3.1                                | 01/17/20 | MT-98.10 | 01/17/20 | MT-101.70 | 01/17/20 | TC-52.20 | 01/15/21  | 821 | 4/20/12  |
| BP-5.1                                | 07/16/21 | MT-98.11 | 01/17/20 | MT-101.75 | 01/17/20 | TC-61.10 | 01/17/20  | 832 | 10/19/18 |
|                                       |          | MT-98.20 | 04/19/19 | MT-101.90 | 07/17/20 | TC-65.10 | 01/17/14  | 850 | 4/16/21  |
| RM-4.2                                | 04/17/20 | MT-98.22 | 01/17/20 | MT-102.10 | 01/17/20 | TC-65.11 | 07/21/17  | 872 | 04/17/20 |
| RM-4.3                                | 07/18/14 | MT-98.28 | 01/17/20 | MT-105.10 | 01/17/20 | TC-71.10 | 07/16/21  | 875 | 01/18/19 |
|                                       |          | MT-98.29 | 01/17/20 |           |          | TC-72.20 | 07/20/18  | 897 | 01/16/15 |
| I-3C                                  | 07/16/21 |          |          |           |          | TC-73.20 | 01/17/20  | 921 | 04/20/12 |
| BR-1-13                               | 01/17/14 |          |          |           |          |          |   |     |          |
| PCB-91                                | 07/17/20 |          |          |           |          |          |   |     |          |
| TVPF-1-18                             | 07/20/18 |          |          |           |          |          |   |     |          |
| VPF-1-90                              | 07/20/18 |          |          |           |          |          |   |     |          |
| <b>SPECIAL PROVISIONS</b>             |          |          |          |           |          |          |   |     |          |
| CSX TRANSPORTATION, INC.<br>JULY 2017 |          |          |          |           |          |          | PAVER MOUNTED THERMAL PROFILING<br>MARCH 16, 2022 |     |          |

DOW# 21-144

**FEDERAL PROJECT NUMBER**

E191(328)

**RAILROAD INVOLVEMENT**

CSX TRANSPORTATION, INC.

**PROJECT DESCRIPTION**

RESURFACING 3.01 MILES OF INTERSTATE 670 IN FRANKLIN COUNTY FROM SLM 0.87 (280' WEST OF GRANDVIEW BRIDGE) TO SLM 3.88 (238' EAST OF FRA-670-3.81 BRIDGE).

RESURFACING VARIOUS RAMPS WITHIN WORK LIMITS.

MINOR REHAB WORK ON VARIOUS STRUCTURES.

**EARTH DISTURBED AREAS**

|  |                              |
|--|------------------------------|
| PROJECT EARTH DISTURBED AREA:              | 0.03                         |
| ESTIMATED CONTRACTOR EARTH DISTURBED AREA: | 0.00                         |
| NOTICE OF INTENT EARTH DISTURBED AREA:     | N/A (NOI NOT REQUIRED)*      |
|  | *ROUTINE MAINTENANCE PROJECT |

**LIMITED ACCESS**

THIS IMPROVEMENT IS ESPECIALLY DESIGNED FOR THROUGH TRAFFIC AND HAS BEEN DECLARED A LIMITED ACCESS HIGHWAY OR FREEWAY BY ACTION OF THE DIRECTOR IN ACCORDANCE WITH THE PROVISIONS OF SECTION 5511.02 OF THE OHIO REVISED CODE.

**2019 SPECIFICATIONS**

THE STANDARD SPECIFICATIONS OF THE STATE OF OHIO, DEPARTMENT OF TRANSPORTATION, INCLUDING SUPPLEMENTAL SPECIFICATIONS LISTED IN THE PLANS AND CHANGES LISTED IN THE PROPOSAL SHALL GOVERN THIS IMPROVEMENT.

I HEREBY APPROVE THESE PLANS AND DECLARE THAT THE MAKING OF THIS IMPROVEMENT WILL NOT REQUIRE THE CLOSING TO TRAFFIC OF THE HIGHWAY AND THAT PROVISIONS FOR THE MAINTENANCE AND SAFETY OF TRAFFIC WILL BE AS SET FORTH ON THE PLANS AND ESTIMATES.

APPROVED: *[Signature]*  
DATE: 1/7/22 DISTRICT DEPUTY DIRECTOR

APPROVED: \_\_\_\_\_  
DATE: \_\_\_\_\_ DIRECTOR, DEPARTMENT OF TRANSPORTATION

DESIGN AGENCY



DESIGNER

KLM

REVIEWER

XXX MM-DD-YY

PROJECT ID

110051

SHEET

P.1

TOTAL

104

FRA-670-0.87

MODEL: 110051\_G1001.PAPER(SIZE: TX11 (in.) DATE: 3/24/2022 TIME: 6:57:45 AM USER: kbowman pwc:\ohio\dot-pw\benley.com\shahdo\pww-02\Documents\01 Active Projects\Distict 06\Franklin\110051\400-Engineering\Roadway\Sheets\110051\_G1001.dgn

FRA-670-0.87 PID#110051

**ITEM 611 - INLET ADJUSTED TO GRADE:**  
THE FOLLOWING CONTINGENCY QUANTITY HAS BEEN PROVIDED AND CARRIED TO THE GENERAL SUMMARY FOR USE WHEN ENCOUNTERING INLET(S) THAT REQUIRE ADJUSTMENT TO GRADE:

ITEM 611 - INLET ADJUSTED TO GRADE = 4 EACH

**DRAINAGE AT INTERSECTING STREETS:**  
AT INTERSECTING STREETS (ROADS) WHERE THE DRAINAGE IS TOWARD OR INTO THE PROJECT, SPECIAL CARE SHALL BE TAKEN BY THE CONTRACTOR TO MAINTAIN PROPER GRADE ALONG THE EDGE OF PAVEMENT SO THAT WATER WILL NOT POND. AT INTERSECTING STREETS (ROADS), WHERE THE EDGE OF PAVEMENT CONTINUES ACROSS THE STREET (ROAD), CARE SHALL BE TAKEN TO TRANSITION DOWN AND FORM A NEAT SEAM WITH THE PROPER GRADE.

**ITEM 251 - PARTIAL DEPTH PAVEMENT REPAIR (ASPHALT CONCRETE BASE), AS PER PLAN, 4.0":**  
REPAIR AREAS SHALL BE DETERMINED BY THE PROJECT ENGINEER BEFORE THE BEGINNING OF WORK. REPAIRS SHALL CONSIST OF REMOVING 4" OF PAVEMENT AND PLACING 4" OF ITEM 301 - ASPHALT CONCRETE BASE, PG64-22. SEE SHEET P.12 FOR DETAILS. WORK SHALL BE PERFORMED PRIOR TO RESURFACING. NO MORE PARTIAL DEPTH PAVEMENT REPAIR SHALL BE STARTED AND PERFORMED THAN CAN BE COMPLETED IN THE SAME WORKING DAY.

IN ADDITION TO SPECIFIC LOCATIONS FOUND ON SHEET P.41, THE FOLLOWING QUANTITY HAS BEEN PROVIDED FOR USE AS DIRECTED BY THE ENGINEER AND CARRIED TO THE GENERAL SUMMARY:

ITEM 251 - PARTIAL DEPTH PAVEMENT REPAIR (ASPHALT CONCRETE BASE), AS PER PLAN, 4.0" = 718 SY

**ITEM 254 - PAVEMENT PLANING, ASPHALT CONCRETE:**  
**ITEM 897- PAVEMENT PLANING, ASPHALT CONCRETE, CLASS A:**  
THE CONTRACTOR SHALL BE TOTALLY RESPONSIBLE FOR ANY AND ALL DAMAGE TO THE CONTRACTORS EQUIPMENT THAT MAY RESULT FROM THE PLANING OPERATION, INCLUDING DAMAGE CAUSED BY CASTINGS AND LOOP DETECTORS. THE DEPTH OF PLANING CLOSE TO THE CASTINGS SHALL BE AS DIRECTED; TO ACHIEVE A SMOOTH RIDING FINISHED PAVEMENT. GREAT CARE SHALL BE TAKEN TO PREVENT THE REMOVAL OF THE EXISTING PAVEMENT CROSS SLOPES (CROWN) DURING THE PLANING OPERATION.

BUTT JOINTS SHALL BE PROVIDED AT THE BEGINNING AND END OF PAVING LIMITS AND AT THE APPROACH SLABS OF ALL STRUCTURES NOT BEING PAVED OVER.

AT NO TIME SHALL TRAFFIC BE EXPOSED TO PLANED PAVEMENT WITHIN THE TRAVELED WAY/LANE(S). AT NO TIME OUTSIDE OF THE WORK SHIFT SHALL THE SHOULDERS BE LEFT AT A HIGHER ELEVATION THAN THE DRIVING LANES. PLACED OUTSIDE SHOULDERS MAY BE EXPOSED TO TRAFFIC FOR FIVE (5) CALENDAR DAYS.

FAILURE TO COMPLY SHALL SUBJECT THE CONTRACTOR TO LIQUIDATED DAMAGES AS PER SECTION 108.07 OF CMS.

THE 3.5" PLANING DEPTH INCLUDES APPROXIMATELY 0.5" OF EXISTING MICROSURFACE COURSE ON TOP OF 3.0" OF ASPHALT CONCRETE. THE INTENT IS TO PLANE DOWN TO THE TOP OF EXISTING CONCRETE (BASE).

**ITEM 254 - PATCHING PLANED SURFACE:**  
**ITEM 897 - PATCHING PLANED SURFACE:**  
THESE ITEMS HAVE BEEN PROVIDED FOR USE AS DETERMINED BY THE PROJECT ENGINEER FOR PATCHING PLANED PAVEMENT.

| ROUTE                                   | BEG SLM | END SLM | 254<br>PATCHING<br>SY | 897<br>PATCHING<br>SY |
|---|---------|---------|-----------------------|-----------------------|
| I-670                                   | 0.870   | 1.077   |                       | 191                   |
| I-670                                   | 3.165   | 3.886   |                       | 637                   |
| US 33T RAMPS                            |         |         | 388                   |                       |
| GOODALE ST/NEIL AVE RAMPS               |         |         | 54                    |                       |
| US 23D(N. THIRD)/US 23(N. FOURTH) RAMPS |         |         | 89                    |                       |
| TOTAL                                   |         |         | 531                   | 828                   |

THE FOLLOWING CONTINGENCY QUANTITIES HAVE BEEN PROVIDED AND CARRIED TO THE GENERAL SUMMARY:

ITEM 254 - PATCHING PLANED SURFACE = 531 SY  
ITEM 897 - PATCHING PLANED SURFACE = 828 SY

**ITEM 255 - FULL DEPTH PAVEMENT SAWING:**  
THIS ITEM OF WORK SHALL BE USED IN CONJUNCTION WITH ITEM 255 - FULL DEPTH PAVEMENT REMOVAL AND RIGID REPLACEMENT, CLASS QC MS.

THE FOLLOWING QUANTITY HAS BEEN PROVIDED FOR USE AS DIRECTED BY THE ENGINEER AND CARRIED TO THE GENERAL SUMMARY:

ITEM 255 - FULL DEPTH PAVEMENT SAWING = 1716 FT

**ITEM 255 - FULL DEPTH PAVEMENT REMOVAL AND RIGID REPLACEMENT, CLASS QC MS, 11.00":**  
REPAIR AREAS SHALL BE DETERMINED BY THE PROJECT ENGINEER BEFORE THE BEGINNING OF WORK. REPAIRS SHALL CONSIST OF REMOVING 11.00" OF PAVEMENT. REPLACEMENT SHALL INCLUDE PLACING 11.00" OF CLASS QC MS CONCRETE. SEE SHEET P.12 FOR DETAILS.

IN ADDITION TO SPECIFIC LOCATIONS FOUND ON SHEET P.41, THE FOLLOWING QUANTITY HAS BEEN PROVIDED FOR USE AS DIRECTED BY THE ENGINEER AND CARRIED TO THE GENERAL SUMMARY:

ITEM 255 - FULL DEPTH PAVEMENT REMOVAL AND RIGID REPLACEMENT, CLASS QC MS, 11.00" = 415 SY

**ITEM 257 - DIAMOND GRINDING PORTLAND CEMENT CONCRETE PAVEMENT:**  
THIS ITEM OF WORK SHALL BE USED IN CONJUNCTION WITH BOTH ITEM 255 - FULL DEPTH PAVEMENT REMOVAL AND RIGID REPLACEMENT, CLASS QC MS ITEMS. PLANING ON EDGE ABUTTING SHOULDER SHALL EXTEND ONTO SHOULDER FAR ENOUGH TO ENSURE PROPER DRAINAGE OFF OF THE PAVEMENT. THE ENGINEER IS TO DETERMINE THE EXTENT OF GRINDING TO ENSURE PROPER DRAINAGE.

THE FOLLOWING QUANTITY HAS BEEN PROVIDED FOR USE AS DIRECTED BY THE ENGINEER AND CARRIED TO THE GENERAL SUMMARY:

ITEM 257 - DIAMOND GRINDING PORTLAND CEMENT CONCRETE PAVEMENT = 415 SY

**ITEM 304 - AGGREGATE BASE, AS PER PLAN:**  
THE SUBGRADES OF THE EXISTING ABUTTING PAVEMENT AND PROPOSED PAVEMENT SHOULD MEET AT THE SAME ELEVATION. IF NECESSARY, THE AGGREGATE BASE UNDER THE REPLACEMENT SHOULD BE THICKENED SO THE SUBGRADE ELEVATIONS WILL MATCH.

**ITEM 424 - FINE GRADED ASPHALT CONCRETE SURFACE COURSE, TYPE B, AS PER PLAN:**  
LOCATE LONGITUDINAL JOINTS IN THE SURFACE COURSE SUBJECT TO THE FOLLOWING REQUIREMENTS:

- FOR PAVEMENT SECTIONS WITH 2 LANES IN A SINGLE DIRECTION, PLACE A SINGLE COLD LONGITUDINAL JOINT BETWEEN THE 2 LANES.

- FOR PAVEMENT SECTIONS WITH 3 OR 4 LANES IN A SINGLE DIRECTION, PLACE A SINGLE COLD LONGITUDINAL JOINT BETWEEN THE SECOND AND THIRD LANE FROM THE MEDIAN.

- FOR PAVEMENT SECTIONS WITH 5 OR 6 LANES IN A SINGLE DIRECTION, PLACE 2 COLD LONGITUDINAL JOINTS. THE FIRST WILL BE PLACED BETWEEN THE SECOND AND THIRD LANE FROM THE MEDIAN. THE SECOND WILL BE PLACED BETWEEN THE FOURTH AND FIFTH LANE FROM THE MEDIAN.

- WHEN LANES BECOME IN CONTACT WITH THE STRIPED GORE THEY ARE CONSIDERED TO BE ON THE RAMP AND COUNTED SEPARATELY FROM THE MAINLINE.

A COLD LONGITUDINAL JOINT IS PERMITTED BETWEEN THE MAINLINE AND SHOULDER FOR THIS PROJECT. THIS INCLUDES ONE JOINT ALONG ONE OF THE TWO LINES THAT MAKE UP THE STRIPED GORE. ITEM 872 VRAM QUANTITIES DO NOT INCLUDE THESE LOCATIONS AND IT IS NOT TO BE PLACED THERE.

**ITEM 442 - ASPHALT CONCRETE SURFACE COURSE, 12.5 MM, TYPE A (447), AS PER PLAN:**  
ALL REQUIREMENTS OF ITEM 442 APPLY EXCEPT:  
THE PG BINDER SHALL BE PG76-22M.  
THE 3" SHALL BE PLACED AS A SINGLE LIFT

THE CONTRACTOR SHALL BE PREPARED FOR THE LONGER COOLING TIME (DUE TO THE INCREASED LIFT THICKNESS). PAVEMENT SHALL NOT BE OPENED TO TRAFFIC UNTIL THE MAT SURFACE TEMPERATURE IS LESS THAN 140 DEGREES FAHRENHEIT. VERIFICATION OF THE TEMPERATURE SHALL BE AT A METHOD APPROVED BY THE ENGINEER.

BOTH ITEM 875 AND 705.04 JOINT SEALER ARE INCIDENTAL TO THIS ITEM.

**ITEM 442 - ANTI-SEGREGATION EQUIPMENT:**  
PROVIDE ANTI-SEGREGATION EQUIPMENT FOR ALL COURSES OF UNIFORM THICKNESS IN ACCORDANCE WITH C&MS 401.12. THE QUANTITY FOR THIS ITEM IS IN CUBIC YARDS AND IS EQUAL TO THE AMOUNT OF SURFACE (AND INTERMEDIATE) COURSES ON THE MAINLINE (EXCLUDING SHOULDERS) AND RAMPS (INCLUDING SHOULDERS).

**ITEM 617 - WATER:**  
THE FOLLOWING QUANTITY HAS BEEN PROVIDED AND CARRIED TO THE GENERAL SUMMARY:

ITEM 617 - WATER = 1 MGAL

**ITEM SPECIAL - PAVER MOUNTED THERMAL PROFILING (PMTP):**  
THIS ITEM CONSISTS OF PROVIDING A PAVER MOUNTED THERMAL PROFILING (PMTP) SYSTEM TO IDENTIFY THE PRESENCE OF ANY THERMAL SEGREGATION OF AN UNCOMPACTED MAT OF HOT MIX ASPHALT. METHODS AND PROCEDURES FOR DETERMINING THE THERMAL PROFILE USING A PAVER MOUNTED THERMAL IMAGING SYSTEM SHALL CONFORM TO THE SPECIFICATIONS FOUND IN THE SPECIAL PROVISIONS.

THE CONTRACTOR SHALL NOTIFY ODOT OFFICE OF PAVEMENT ENGINEERING AT LEAST TWO (2) WEEKS PRIOR TO THE START OF PMTP DATA COLLECTION.  
CRAIG LANDEFELD  
614.644.6622  
[CRAIG.LANDEFELD@DOT.OHIO.GOV](mailto:CRAIG.LANDEFELD@DOT.OHIO.GOV)

ALL LABOR, EQUIPMENT, SOFTWARE, AND INCIDENTALS NECESSARY TO INSTALL THE EQUIPMENT AND ANALYZE THE DATA SHALL BE INCLUDED FOR PAYMENT WITH THE LUMP SUM BID FOR ITEM SPECIAL, PAVER MOUNTED THERMAL PROFILING (PMTP).

THE FOLLOWING QUANTITY HAS BEEN PROVIDED AND CARRIED TO THE GENERAL SUMMARY:  
ITEM SPECIAL - PAVER MOUNTED THERMAL PROFILING = LUMP SUM

**ITEM 638 - VALVE BOX ADJUSTED TO GRADE:**  
THE FOLLOWING CONTINGENCY QUANTITY HAS BEEN PROVIDED AND CARRIED TO THE GENERAL SUMMARY FOR USE WHEN ENCOUNTERING VALVE BOX(ES) THAT REQUIRE ADJUSTMENT TO GRADE:  
ITEM 638 - VALVE BOX ADJUSTED TO GRADE = 4 EACH

**ITEM 626 - BARRIER REFLECTOR, TYPE 1, ONE-WAY:**  
THIS ITEM IS PROVIDED TO REPLACE BROKEN OR MISSING BARRIER REFLECTORS ON CONCRETE BARRIER WITHIN THE PROJECT LIMITS. THE EXISTING BARRIER REFLECTORS ARE TRIPLE STACKED.

THE FOLLOWING CONTINGENCY QUANTITY HAS BEEN PROVIDED AND CARRIED TO THE GENERAL SUMMARY:  
ITEM 626 - BARRIER REFLECTOR, TYPE 1, ONE-WAY = 12 EACH

**ITEM 644 - THERMOPLASTIC PAVEMENT MARKINGS:**  
**ITEM 646 - EPOXY PAVEMENT MARKINGS:**  
**ITEM 807 - WET REFLECTIVE LIQUID APPLIED PAVEMENT MARKINGS:**  
THE LOCATIONS, SIZES AND SHAPES OF PROPOSED PAVEMENT MARKINGS WILL BE THE SAME AS EXISTING ON THE MAJORITY OF THIS PROJECT. ANY DEVIATION FROM EXISTING WILL BE IDENTIFIED WITHIN THIS PLAN.

ENTRANCE AND EXIT RAMP PAVEMENT MARKINGS WILL BE UPDATED TO THE CURRENT STANDARDS (CHEVRON AND DOTTED LINE MARKINGS) PER SCD TC-72.20 AND AS DETAILED IN THE PLAN SHEETS. TRANSVERSE/DIAGONAL LINE AND CHEVRON MARKINGS SHALL BE SPACED AS DETAILED PER TEM 301-14 AND SCD TC-72.20.

IT IS THE CONTRACTOR'S RESPONSIBILITY TO VERIFY THE LOCATION, SIZE AND SHAPE OF THESE EXISTING PAVEMENT MARKINGS BEFORE THE PAVEMENT PLANING AND RESURFACING OBLITERATES THEM. ANY PAVEMENT MARKING WHICH IS PLACED AT THE WRONG LOCATION SHALL BE REMOVED AND REPLACED AT THE CONTRACTORS EXPENSE.

THE FOLLOWING QUANTITIES HAVE BEEN PROVIDED TO PERMANENTLY STRIPE FULL DEPTH CONCRETE REPAIR LOCATIONS AND HAVE BEEN CARRIED TO THE GENERAL SUMMARY:  
ITEM 646 - EDGE LINE, 6" = 0.40 MILE  
ITEM 646 - LANE LINE, 6" = 0.20 MILE



**GENERAL:**

ALL TRAFFIC CONTROL DEVICES SHALL BE FURNISHED, ERECTED, MAINTAINED, AND REMOVED BY THE CONTRACTOR IN ACCORDANCE WITH THE OHIO MANUAL OF UNIFORM TRAFFIC CONTROL DEVICES (CURRENT EDITION). COPIES ARE AVAILABLE FROM:

THE OHIO DEPARTMENT OF TRANSPORTATION  
 BUREAU OF TRAFFIC,  
 1980 WEST BROAD STREET  
 COLUMBUS, OHIO 43223.

LENGTH AND DURATION OF LANE CLOSURES AND RESTRICTIONS SHALL BE AT THE APPROVAL OF THE ENGINEER. IT IS THE INTENT TO MINIMIZE THE IMPACT TO THE TRAVELING PUBLIC. LANE CLOSURES OR RESTRICTIONS OVER SEGMENTS OF THE PROJECT IN WHICH NO WORK IS ANTICIPATED WITHIN A REASONABLE TIME FRAME, AS DETERMINED BY THE ENGINEER, SHALL NOT BE PERMITTED. THE LEVEL OF UTILIZATION OF MAINTENANCE OF TRAFFIC DEVICES SHALL BE COMMENSURATE WITH THE WORK IN PROGRESS.

ALL WORK AND TRAFFIC CONTROL DEVICES SHALL BE IN ACCORDANCE WITH CMS 614 AND OTHER APPLICABLE PORTIONS OF THE SPECIFICATIONS, AS WELL AS THE OHIO MANUAL OF UNIFORM TRAFFIC CONTROL DEVICES.

ALL PERMANENT TRAFFIC CONTROLS NOT IN CONFLICT WITH THE TEMPORARY TRAFFIC CONTROLS SHALL BE MAINTAINED THROUGHOUT THIS PROJECT BY THE CONTRACTOR. PERMANENT TRAFFIC CONTROLS MAY BE TEMPORARILY RELOCATED BY THE ENGINEER. THE CONTRACTOR SHALL ASSUME ALL LIABILITY FOR MISSING, DAMAGED, AND PROPERLY PLACED SIGNS.

PAYMENT FOR ALL LABOR, EQUIPMENT AND MATERIALS SHALL BE INCLUDED IN THE LUMP SUM CONTRACT PRICE FOR ITEM 614, MAINTAINING TRAFFIC, UNLESS SEPARATELY ITEMIZED IN THE PLAN.

TRAFFIC CONTROL DEVICES SHALL BE FURNISHED, ERECTED, MAINTAINED, AND REMOVED BY THE CONTRACTOR IN ACCORDANCE WITH THE OHIO MANUAL OF UNIFORM TRAFFIC CONTROL DEVICES.

**PUBLIC OUTREACH AND NOTIFICATION:**

THE CONTRACTOR SHALL BE RESPONSIBLE FOR CONTACTING THE DISTRICT 6 PUBLIC INFORMATION OFFICE VIA EMAIL AT [d06.pio@dot.ohio.gov](mailto:d06.pio@dot.ohio.gov) TO COORDINATE EFFORTS TO NOTIFY ADJACENT RESIDENTS, BUSINESSES, AND EMERGENCY SERVICES OF THE UPCOMING RESURFACING PROJECT. ADVANCE NOTIFICATION SHALL OCCUR NO LATER THAN FOURTEEN (14) DAYS PRIOR TO A NEW LOCATION. ALL NOTIFICATIONS SHALL BE MAKE UTILIZING THE TEMPLATE PROVIDED BY THE DISTRICT 6 PUBLIC INFORMATION OFFICE.

**DROPOFFS IN WORK ZONES:**

THE DROPOFF ADJACENT TO THE TRAVELED LANE SHALL MEET THE CRITERIA OUTLINED IN STANDARD DRAWING MT-101.90. NO ADDITIONAL COMPENSATION SHALL BE MADE FOR MATERIALS, LABOR, OR EQUIPMENT NECESSARY TO MET THE REQUIREMENTS OF MT-101.90.

**RIGHT OF WAY PERMITS:**

THE CONTRACTOR SHALL BE RESPONSIBLE FOR OBTAINING ALL APPLICABLE RIGHT OF WAY USE PERMITS TO INSTALL MAINTENANCE OF TRAFFIC SIGNING.

**CITY OF COLUMBUS OCCUPANCY PERMIT:**

TO WORK WITHIN THE CITY OF COLUMBUS, THE APPLICANT MUST ALSO OBTAIN AN OCCUPANCY PERMIT FROM THE CITY OF COLUMBUS PERMIT DEPARTMENT.

**NOTIFICATION OF TRAFFIC RESTRICTIONS:**

THROUGHOUT THE DURATION OF THE PROJECT, THE CONTRACTOR SHALL NOTIFY THE PROJECT ENGINEER IN WRITING OF ALL TRAFFIC RESTRICTIONS AND UPCOMING MAINTENANCE OF TRAFFIC CHANGES. THE CONTRACTOR SHALL ENSURE THE WRITTEN NOTIFICATION IS SUBMITTED IN A TIMELY MANNER TO ALLOW THE PROJECT ENGINEER TO MEET THE REQUIRED TIME FRAMES SET FORTH IN THE TABLE BELOW TO INFORM SPECIAL HAULING PERMITS SECTION ([HAULING.PERMITS@DOT.OHIO.GOV](mailto:HAULING.PERMITS@DOT.OHIO.GOV)) AND THE DISTRICT PUBLIC INFORMATION OFFICE (PIO). THIS NOTIFICATION SHALL BE RECEIVED BY THE PROJECT ENGINEER PRIOR TO THE PHYSICAL SETUP OF ANY APPLICABLE SIGNS OR MESSAGE BOARDS.

INFORMATION SHOULD INCLUDE BUT IS NOT LIMITED TO ALL CONSTRUCTION ACTIVITIES THAT IMPACT OR INTERFERE WITH TRAFFIC AND SHALL LIST THE SPECIFIC LOCATION, TYPE OF WORK, ROAD STATUS, DATE AND TIME OF RESTRICTION, DURATION OF RESTRICTION, NUMBER OF LANES MAINTAINED, NUMBER OF LANES CLOSED, MINIMUM VERTICAL CLEARANCE, MINIMUM WIDTH OF DRIVABLE PAVEMENT, DETOUR ROUTES IF APPLICABLE, AND ANY OTHER INFORMATION REQUESTED BY THE PROJECT ENGINEER.

| Notification Time Frame Table                   |                        |  |                                   |
|---|------------------------|--|-----------------------------------|
| Item  | Duration of Closure    | Notification due to District 6 Communications Office | Sign Displayed to Public          |
| Ramp & Road Closures                            | >= 2 weeks             | 21 calendar days prior to closure                    | 14 calendar days prior to closure |
|   | > 12 hours & < 2 weeks | 14 calendar days prior to closure                    | 7 calendar days prior to closure  |
|   | <= 12 hours            | 4 business days prior to closure                     | 2 business days prior to closure  |
| Lane Closures & Restrictions                    | >= 2 weeks             | 14 calendar days prior to closure                    |                                   |
|   | < 2 weeks              | 5 business days prior to closure                     |                                   |
| Start of Construction & Traffic Pattern Changes | N/A                    | 14 calendar days prior to implementation             |                                   |

ANY UNFORESEEN CONDITIONS NOT SPECIFIED IN THE PLANS REQUIRING TRAFFIC RESTRICTIONS SHALL ALSO BE REPORTED TO THE PROJECT ENGINEER USING THE NOTIFICATION TIME FRAME TABLE.

**LANES OPEN DURING HOLIDAYS AND SPECIAL EVENTS:**

NO WORK SHALL BE PERFORMED AND THE SAME NUMBER OF LANES AS WERE AVAILABLE AT THE START OF THE PROJECT SHALL BE OPEN TO TRAFFIC DURING THE FOLLOWING DESIGNATED HOLIDAYS OR EVENTS:

HOLIDAYS

CHRISTMAS                      FOURTH OF JULY  
 NEW YEARS                      LABOR DAY  
 MEMORIAL DAY                      THANKSGIVING

THE PERIOD OF TIME THAT THE LANES ARE TO BE OPEN DEPENDS ON THE DAY OF THE WEEK ON WHICH THE HOLIDAY FALLS. THE FOLLOWING SCHEDULE SHALL BE USED TO DETERMINE THIS PERIOD:

| DAY OF HOLIDAY | TIME ALL LANES MUST BE OPEN TO TRAFFIC   |
|----------------|--|
| SUNDAY         | 12:00N FRIDAY THROUGH 6:00 AM MONDAY     |
| MONDAY         | 12:00N FRIDAY THROUGH 6:00 AM TUESDAY    |
| TUESDAY        | 12:00N MONDAY THROUGH 6:00 AM WEDNESDAY  |
| WEDNESDAY      | 12:00N TUESDAY THROUGH 6:00 AM THURSDAY  |
| THURSDAY       | 12:00N WEDNESDAY THROUGH 6:00 AM FRIDAY  |
| THANKSGIVING   | 6:00 AM WEDNESDAY THROUGH 6:00 AM MONDAY |
| FRIDAY         | 12:00N THURSDAY THROUGH 6:00 AM MONDAY   |
| SATURDAY       | 12:00N FRIDAY THROUGH 6:00 AM MONDAY     |

SPECIAL EVENT

OSU HOME FOOTBALL GAME DAYS - LANE, RAMP OR SHOULDER CLOSURES ARE NOT PERMITTED FROM 3 HOURS PRIOR TO KICKOFF TO 3 HOURS FOLLOWING THE CONCLUSION OF THE GAME.

NO EXTENSIONS OF TIME SHALL BE GRANTED FOR DELAYS IN MATERIAL DELIVERIES, UNLESS SUCH DELAYS ARE INDUSTRY WIDE, OR FOR LABOR STRIKES, UNLESS SUCH STRIKES ARE AREA WIDE.

SHOULD THE CONTRACTOR FAIL TO MEET ANY OF THESE REQUIREMENTS, THE CONTRACTOR SHALL BE ASSESSED A DISINCENTIVE PER THE LANE VALUE CONTRACT TABLE FOR EACH MINUTE THE ABOVE DESCRIBED LANE CLOSURE RESTRICTIONS ARE VIOLATED.

**NOTIFICATION OF CONSTRUCTION INITIATION:**

AT LEAST FOURTEEN DAYS PRIOR TO STARTING INITIAL CONSTRUCTION ACTIVITIES, THE CONTRACTOR SHALL ADVISE THE DISTRICT OFFICE OF COMMUNICATIONS VIA EMAIL AT [d06.pio@dot.ohio.gov](mailto:d06.pio@dot.ohio.gov), THE DISTRICT WORK ZONE TRAFFIC MANAGER VIA EMAIL AT [d06.mot@dot.ohio.gov](mailto:d06.mot@dot.ohio.gov), AND THE CENTRAL OFFICE SPECIAL HAUL PERMITS SECTION BY EMAIL AT [hauling.permits@dot.ohio.gov](mailto:hauling.permits@dot.ohio.gov) OF THE ANTICIPATED START DATE OF ANY CONSTRUCTION ACTIVITIES INCLUDING BUT NOT LIMITED TO THE PLACING OF WORK ZONE SIGNS. THE NOTIFICATION SHALL ALSO INCLUDE THE PROJECT NUMBER, PID, NAME AND PHONE NUMBER OF THE CONTRACTOR, A POINT OF CONTACT AND THE ANTICIPATED IMPACT ON TRAFFIC. THE CONTRACTOR WILL IMMEDIATELY INFORM THE DISTRICT OFFICE OF COMMUNICATIONS AND THE DISTRICT WORK ZONE TRAFFIC MANAGER OF ANY AND ALL DELAYS AND/OR CHANGES REGARDING THE CONSTRUCTION INITIATION DATE.

**WORK ZONE LIGHTING:**

FLOODLIGHTING OF THE WORK SITE FOR OPERATIONS CONDUCTED DURING NIGHTTIME PERIODS SHALL BE ACCOMPLISHED SO THAT THE LIGHTS DO NOT CAUSE GLARE TO THE DRIVERS ON THE ROADWAY. TO ENSURE THE ADEQUACY OF THE FLOODLIGHT PLACEMENT, THE CONTRACTOR AND THE ENGINEER SHALL DRIVE THROUGH THE WORK SITE EACH NIGHT WHEN THE LIGHTING IS IN PLACE AND OPERATIVE PRIOR TO COMMENCING ANY WORK. IF GLARE IS DETECTED, THE LIGHT PLACEMENT AND SHIELDING SHALL BE ADJUSTED TO THE SATISFACTION OF THE ENGINEER BEFORE WORK PROCEEDS.

PAYMENT FOR ALL LABOR, EQUIPMENT AND MATERIALS SHALL BE INCLUDED IN THE LUMP SUM CONTRACT PRICE FOR ITEM 614, MAINTAINING TRAFFIC.

**USE OF STANDARD DRAWINGS:**

FOR THE PURPOSE OF THIS PROJECT, "MOVING OPERATION" SHALL BE LIMITED TO PAVEMENT MARKING STRIPING.

IT MAY BE NECESSARY TO EXTEND THE ADVANCE WARNING AND BUFFER ZONES BEYOND THE MINIMUM DISTANCES SHOWN ON THE STANDARD DRAWINGS. THIS MAY BE DUE TO HORIZONTAL ALIGNMENT, VERTICAL ALIGNMENT, RAMP LOCATIONS, OR OTHER SIGHT OBSTRUCTIONS. LOCATIONS OF THE TAPER ZONES MAY BE ADJUSTED AS DIRECTED BY THE ENGINEER, BUT TAPER LENGTHS MUST MEET THE MINIMUM STANDARDS. TAPERS SHOULD BE PLACED IN TANGENT SECTIONS WHENEVER POSSIBLE. ADDITIONAL YIELD SIGNS MAY BE REQUIRED FOR RAMPS WITHIN 1,000 FEET OF A WORK ZONE. PAYMENT SHALL BE INCLUDED IN THE LUMP SUM CONTRACT PRICE FOR ITEM 614 - MAINTAINING TRAFFIC.

FOR ANY MULTILANE HIGHWAY, DEVICE SPACING SHALL BE A MAXIMUM OF 40' CENTER ON CENTER IN THE TAPERS AND 80' CENTER ON CENTER IN THE TANGENT SECTIONS.

**COORDINATION WITH ADJACENT PROJECTS:**

THE CONTRACTOR SHALL COORDINATE WORK WITH ODOT AND THE CONTRACTORS ON ADJACENT PROJECTS, LISTED BELOW:

- FRA-670-0.18, PID 111641
- LIGHTING OPTIMIZATION SE OHIO, PID 112676
- FRA-670-3.12 BRIDGE RETROFIT, PID 115831
- FRA-670-3.31, PID 111340
- FRA-70/71 PART 1 (4R), PID 105523; PART 2 (6R), PID 105588

COORDINATION SHALL BE MADE TO PREVENT CONFLICTING ADVANCE WARNING SIGNS, CONFLICTING DETOUR ROUTES, OVERLAPPING/CONFLICTING LANE CLOSURES, AND TO ENSURE THAT A MINIMUM DISTANCE OF 2 MILES BETWEEN ADJACENT LANE CLOSURES IS MAINTAINED. THIS IS NOT AN EXHAUSTIVE LIST OF COORDINATION ITEMS THAT MAY NEED TO BE RESOLVED BETWEEN PROJECTS. THE DEPARTMENT RESERVES THE RIGHT TO DECIDE WHICH PROJECT'S ACTIVITIES TAKE PRECEDENCE. PROJECTS THAT HAVE ACTIVITIES DELAYED DUE TO CONFLICTS WILL CONSIDER THIS AN EXCUSABLE, NON-COMPENSABLE DELAY PER 108.06.B. ON PROJECTS THAT HAVE ACTIVITIES DELAYED DUE TO CONFLICTS WHERE THE CONTRACTOR FAILED TO MEET THE NOTIFICATION REQUIREMENTS, THE DELAYS SHALL NOT BE CONSIDERED EXCUSABLE OR COMPENSABLE.

ATTENDANCE AT DEPARTMENT ORDERED TRAFFIC COORDINATION MEETINGS BETWEEN ADJACENT PROJECTS SHALL BE CONSIDERED MANDATORY FOR EACH PROJECT'S SUPERINTENDENT AND WORKSITE TRAFFIC SUPERVISOR (WTS)\*, AND INCIDENTAL TO THE LUMP SUM MAINTENANCE OF TRAFFIC PAYMENT ITEM.

\*IF REQUIRED BY THE PROJECT.

DESIGN AGENCY



DESIGNER  
KLM

REVIEWER  
GF MM-DD-YY

PROJECT ID  
110051

SHEET TOTAL  
P.22 | 104

**MAINTENANCE OF TRAFFIC SEQUENCE:**

THE FOLLOWING MOT PHASES DESCRIBE THE MULTIPLE MOT SET-UPS TO BE USED FOR THIS PROJECT. THE PHASES MAY OCCUR IN ANY ORDER OR SIMULTANEOUSLY, WHILE ALSO FOLLOWING THE INTERIM COMPLETION DATE, EXCEPT THAT PHASE II AND THE 251 REPAIRS OF PHASE I MUST BE COMPLETED BEFORE PHASE III.

**PHASE I (PAVEMENT REPAIRS):**

ITEM 251 AND ITEM 255 PAVEMENT REPAIRS ON I-670 MAINLINE AND INTERCHANGE RAMPS. THIS WORK WILL BE PERFORMED DURING ALLOWABLE LANE AND RAMP CLOSURE TIMES IN ACCORDANCE WITH THE LANE VALUE CONTRACT TABLE AND RAMP CLOSURE RESTRICTION TABLE, EXCEPT AS FOLLOWS:  
 - GRANDVIEW AVE RAMPS A AND D MAY EACH BE CLOSED FOR 1 WEEKEND FRIDAY 7P TO MONDAY 5A (58 HOURS MAX.)  
 - GRANDVIEW AVE RAMP B MAY BE CLOSED FOR 1 WEEKEND FRIDAY 7P TO MONDAY 5A (58 HOURS MAX.) FOR PAVEMENT REPAIRS AND ONE ADDITIONAL TIME FROM FRIDAY 7P TO SUNDAY 8A OR SATURDAY 7P TO MONDAY 5A FOR BRIDGE WORK.

**PHASE II (CONCRETE BARRIER REPLACEMENT):**

REPLACEMENT OF CONCRETE BARRIER AND ADJACENT EASTBOUND PAVEMENT FROM STA. 173+81.69 TO STA. 174+56.69. THIS WORK WILL BE PERFORMED BY SHIFTING ALL LANES TO THE RIGHT FOR 7 DAYS. SEE SHEET P.29 FOR DETAILS.

**PHASE III (RESURFACING):**

ASPHALT CONCRETE PAVEMENT PLANING & RESURFACING ON I-670 MAINLINE AND INTERCHANGE RAMPS. THIS WORK WILL BE PERFORMED DURING ALLOWABLE LANE AND RAMP CLOSURE TIMES IN ACCORDANCE WITH THE LANE VALUE CONTRACT TABLE AND RAMP CLOSURE RESTRICTION TABLE.

**PHASE IV (STRUCTURE WORK):**

DECK PATCHING, CONCRETE SEALING, PRESSURE RELIEF JOINT REPAIR, PARAPET REPAIR, AND VANDAL FENCE REPLACEMENT WILL BE PERFORMED DURING ALLOWABLE LANE AND RAMP CLOSURE TIMES IN ACCORDANCE WITH THE LANE VALUE CONTRACT TABLE AND RAMP CLOSURE RESTRICTION TABLE, EXCEPT AS FOLLOWS:  
 - GRANDVIEW AVE RAMP C MAY BE CLOSED ONE TIME FROM FRIDAY 7P TO SUNDAY 8A OR SATURDAY 7P TO MONDAY 5A.  
 - GRANDVIEW AVE RAMP B, SEE ABOVE IN PAVEMENT REPAIR SECTION.  
 - US-33 RAMP S-E MAY BE CLOSED ONE TIME FROM FRIDAY 7P TO SUNDAY 8A OR SATURDAY 7P TO MONDAY 5A.  
 - W GOODALE ST RAMP ND MAY BE CLOSED ONE TIME FROM FRIDAY 8P TO SUNDAY 8A OR SATURDAY 7P TO MONDAY 6A.  
 - NEIL AVE RAMP NC MAY BE CLOSED ONE TIME FROM FRIDAY 8P TO SUNDAY 8A OR SATURDAY 7P TO MONDAY 6A.  
 - STRUCTURE US-23D (N 3RD ST) OVER 670 WEEKEND LANE CLOSURES, INCLUDING THE CLOSURE OF THE BIKE LANE, SHALL BE COORDINATED WITH CITY OF COLUMBUS.  
 - US-23D (N 3RD ST) RAMP NO MAY BE CLOSED ONE TIME FROM FRIDAY 8P TO SUNDAY 8A OR SATURDAY 7P TO MONDAY 6A.

**WELDING OF MANHOLE COVERS:**

PRIOR TO PHASE II WHEN TRAFFIC WILL BE SHIFTED ONTO THE OUTSIDE SHOULDER OF I-670 EASTBOUND, THE COVERS OF MANHOLES AT STA. 169+75.40 AND STA. 172+03.18 SHALL BE WELDED SHUT TO PREVENT THE COVERS FROM COMING OFF UNDER LIVE TRAFFIC.

ALL LABOR, EQUIPMENT, MATERIALS, AND INCIDENTALS NECESSARY TO ADEQUATELY WELD THE MANHOLE COVER SHUT SHALL BE INCLUDED IN THE LUMP SUM CONTRACT PRICE FOR ITEM 614, MAINTAINING TRAFFIC.

**USE OF WEIGHTED CHANNELIZERS:**

THE WEIGHTED CHANNELIZERS MAY BE USED IN ACCORDANCE WITH THIS SECTION. THE WEIGHTED CHANNELIZERS SHALL BE PREDOMINANTLY ORANGE IN COLOR AND SHALL BE MADE OF LIGHTWEIGHT, FLEXIBLE, AND DEFORMABLE MATERIAL. THEY SHALL BE AT LEAST 42 INCHES IN HEIGHT WITH A WEIGHTED BASE. THEY MAY HAVE A HANDLE OR LIFTING DEVICE, WHICH EXTENDS ABOVE THE 42" MINIMUM HEIGHT.

THE MARKINGS ON THE WEIGHTED CHANNELIZERS SHALL BE HORIZONTAL, CIRCUMFERENTIAL, ALTERNATING ORANGE AND WHITE RETRO REFLECTIVE STRIPES 6 INCHES WIDE. EACH WEIGHTED CHANNELIZER SHALL HAVE A MINIMUM OF TWO ORANGE AND TWO WHITE STRIPES. ANY NON-RETRO REFLECTIVE SPACES BETWEEN THE HORIZONTAL ORANGE AND WHITE STRIPES SHALL NOT EXCEED 2 INCHES WIDE. THE WEIGHTED CHANNELIZERS SHALL HAVE A 4-INCH MINIMUM WIDTH, REGARDLESS OF ORIENTATION.

USE OF THE WEIGHTED CHANNELIZERS ON FREEWAYS AND MULTILANE HIGHWAYS SHALL BE LIMITED TO SHORT-TERM OPERATION FOR EITHER DAY OR NIGHT. UPON COMPLETION OF WORK, THE WEIGHTED CHANNELIZERS MAY AGAIN BE PLACED ON THE HIGHWAY WHEN THE WORK IS TO RESUME ON THE FOLLOWING DAY OR NIGHT. ANY LANE CLOSURE USING CHANNELIZATION DEVICES, EXPECTED TO REMAIN FOR MORE THAN TWELVE HOURS, SHALL REQUIRE THE USE OF DRUMS OR BARRIERS.

WHEN USED AT NIGHT, WEIGHTED CHANNELIZERS SHALL ONLY BE PLACED IN THE TANGENT AREA. THE TANGENT AREA IS DEFINED AS THE AREA AFTER THE TRANSITION TAPER WHERE THE WORK TAKES PLACE. DRUMS SHALL BE USED IN THE TRANSITION TAPERS FOR NIGHT OPERATIONS. MAXIMUM SPACING OF THE WEIGHTED CHANNELIZERS SHALL BE 40 FEET.

STEPS SHOULD BE TAKEN TO ENSURE THAT THE WEIGHTED CHANNELIZERS WILL NOT BE BLOWN OVER OR DISPLACED BY WIND OR MOVING TRAFFIC. BALLASTS SHOULD NOT PRESENT A HAZARD IF THE WEIGHTED CHANNELIZERS ARE INADVERTENTLY STRUCK, NOR SHOULD THEY AFFECT THE VISIBILITY OF THE WEIGHTED CHANNELIZERS. ALL BALLASTS USED SHOULD BE IN ACCORDANCE WITH THE MANUFACTURER'S SPECIFICATIONS.

PAYMENT SHALL BE INCLUDED IN THE LUMP SUM CONTRACT PRICE FOR ITEM 614, MAINTAINING TRAFFIC.

**MAINTENANCE OF TRAFFIC FOR MARKING PAVEMENT REPAIRS:**

PROVIDE LANE CLOSURES AS PER THE MAINTENANCE OF TRAFFIC NOTES IN THESE PLANS A MINIMUM OF 24 HOURS PRIOR TO PERFORMING PAVEMENT REPAIRS TO ALLOW THE ENGINEER TO IDENTIFY AND MARK THE AREAS OF THE PAVEMENT IN NEED OF REPAIRS.

PAYMENT FOR ALL LABOR, EQUIPMENT, LAW ENFORCEMENT OFFICERS AND MATERIALS SHALL BE INCLUDED IN THE LUMP SUM CONTRACT PRICE FOR ITEM 614, MAINTAINING TRAFFIC.

**INTERSTATE ENTRANCE RAMP CLOSURES (FRANKLIN COUNTY ONLY):**

IF THE INTERSTATE IS REDUCED TO ONE THROUGH LANE, ALL NON INTERSTATE ENTRANCE RAMPS ENTERING DIRECTLY INTO THE WORK ZONE TRANSITION AREA, ACTIVITY AREA, OR TERMINATION AREA AS DEFINED BY THE OHIO MANUAL OF UNIFORM TRAFFIC CONTROL DEVICES (OMUTCD) OR ENTERING WITHIN 1000 FEET OF THE FIRST ARROW BOARD SHALL BE CLOSED IN ACCORDANCE WITH THE SHORT DURATION RAMP CLOSURES NOTE.

**SHORT DURATION RAMP CLOSURES:**

FOR THE PURPOSE OF PERFORMING THE REQUIRED WORK OR WHEN REQUIRED BY THE INTERSTATE ENTRANCE RAMP CLOSURE NOTE, RAMPS MAY BE CLOSED FOR SHORT DURATIONS AND DETOURED IN ACCORDANCE WITH THE RAMP CLOSURE TABLE IF APPROVED BY THE ENGINEER. RAMP CLOSURES ARE SUBJECT TO DISINCENTIVES.

FOR ALL SERVICE RAMP CLOSURES LASTING MORE THAN 12 HOURS BUT LESS THAN 60 HOURS AND/OR, FOR ALL SYSTEM RAMP CLOSURES LASTING MORE THAN 12 HOURS BUT LESS THAN 24 HOURS

THE CONTRACTOR SHALL PROVIDE THE FOLLOWING:

- A MINIMUM OF TWO PORTABLE CHANGEABLE MESSAGE SIGNS (PCMS) PLACED, AS DIRECTED BY THE ENGINEER, TO WARN DRIVERS OF THE CLOSURE AND TO PROVIDE THE DESIGNATED DETOUR ROUTE.
- POSITIVE GUIDANCE ALONG THE DETOUR ROUTE WITH DETOUR SIGNS (M4-9 SERIES) IN ACCORDANCE WITH THE DETOUR SIGNS NOTE.

FOR ALL RAMP CLOSURES LASTING LESS THAN 12 HOURS, THE CONTRACTOR SHALL PROVIDE THE FOLLOWING:

- A MINIMUM OF TWO PORTABLE CHANGEABLE MESSAGE SIGNS (PCMS) PLACED, AS DIRECTED BY THE ENGINEER, TO WARN DRIVERS OF THE CLOSURE AND TO PROVIDE THE DESIGNATED DETOUR ROUTE.

WHEN CLOSING ENTRANCE RAMPS, CORRESPONDING LEAD-IN LANES AND TURN LANES SHALL ALSO BE CLOSED.

IF A DESIGNATED DETOUR ROUTE IS NOT PROVIDED IN THE PLANS, TRAFFIC SHALL BE DIRECTED TO THE NEXT INTERCHANGE, IF AVAILABLE, TO TURN AROUND. IF THE USE OF THE NEXT INTERCHANGE IS NOT POSSIBLE, AN ALTERNATIVE DETOUR SHALL BE PROVIDED BY THE ENGINEER.

SERVICE RAMP: INTERCHANGE RAMPS BETWEEN FREEWAYS (OR EXPRESSWAYS) AND NON-FREEWAYS (OR NONEXPRESSWAYS). THESE RAMPS PROVIDE ACCESS (CONNECTIONS) BETWEEN FREEWAYS/EXPRESSWAYS AND OTHER PRINCIPAL/MINOR ARTERIALS, COLLECTORS OR LOCAL ROADS.

SYSTEM RAMP: INTERCHANGE RAMPS (OR CONNECTORS) BETWEEN FREEWAYS (OR EXPRESSWAYS) AND FREEWAYS (OR EXPRESSWAYS).

**DETOUR SIGNING :**

THE CONTRACTOR SHALL PROVIDE, ERECT, AND MAINTAIN SIGNS, SIGN SUPPORTS, TYPE III BARRICADES, AND LIGHTS, AS DETAILED IN THE OHIO MANUAL OF UNIFORM TRAFFIC CONTROL DEVICES AND SCD MT-101.60. SIZE AND PLACEMENT OF DETOUR SIGNS (M4-9) SHOULD FOLLOW THE REQUIREMENTS OF THE OMUTCD SECTION 6F.03, SECTION 2A.11 AND TABLE 6F.01.

DETOUR SIGNING SHALL PROVIDE DRIVERS ADEQUATE TIME TO CLEARLY READ THE SIGNS AND MAKE THE PROPER DECISIONS AT EACH REQUIRED TURNING MOVEMENT. THE DESIGNATED DETOUR ROUTE SHALL BE SIGNED IN ACCORDANCE WITH THE REQUIREMENTS BELOW:

- APPROXIMATELY 1500 FEET PRIOR TO TIP OF THE PAINTED GORE AT AN INTERCHANGE WHEN EXITING A HIGH SPEED (45 MPH OR HIGHER) FACILITY.
- AT OR NEAR THE EXISTING SIGN IN THE GORE OF AN INTERCHANGE RAMP.
- AT OR NEAR THE FIRST EXISTING LANE ASSIGNMENT SIGN ON AN INTERCHANGE EXIT RAMP.
- AT OR NEAR THE EXISTING LANE ASSIGNMENT SIGN OR EXISTING ROUTE MARKER AT THE END OF AN EXIT RAMP.
- APPROXIMATELY 500 FEET PRIOR TO A REQUIRED TURN AT AN INTERSECTION NOT CONTROLLED BY A STOP SIGN (FOR 45 MPH OR HIGHER ONLY).
- AT OR NEAR THE EXISTING LANE ASSIGNMENT SIGN OR EXISTING ROUTE MARKER AT AN INTERSECTION.
- EVERY TWO MILES ALONG A TANGENT SECTION BETWEEN TURNING MOVEMENTS OUTSIDE A CITY.
- EVERY TWO BLOCKS ALONG A TANGENT SECTION BETWEEN TURNING MOVEMENTS WITHIN A CITY.
- AT ANY OTHER INTERSECTION OR DECISION POINT WHERE THE DETOUR ROUTE IS CONTRARY TO THE NORMAL, EXPECTED TURNING MANEUVER OR OTHERWISE UNCLEAR.

DETOUR SIGNS SHALL BE PLACED, WHEN POSSIBLE, NEXT TO BUT NOT BLOCKING EXISTING ROUTE MARKERS OR LANE ASSIGNMENT SIGNS. DETOUR SIGNS SHALL NOT OBSCURE OR BE OBSCURED BY OTHER EXISTING OR TEMPORARY SIGNS.

DETOUR SIGNS SHALL BE ERECTED AND/OR UNCOVERED PRIOR TO THE ROAD OR RAMP BEING CLOSED TO TRAFFIC BUT NO EARLIER THAN FOUR HOURS PRIOR TO THE CLOSURE. DETOUR SIGNS SHALL BE COVERED AND/OR REMOVED NO LATER THAN FOUR HOURS FOLLOWING THE ROAD OR RAMP RE-OPENING TO TRAFFIC.

THIS ITEM SHALL BE USED TO DETOUR RAMPS ON THE PRIMARY ROUTES DESCRIBED ON SHEET P.26.

PAYMENT FOR ACCEPTED QUANTITIES WILL BE MADE AT THE CONTRACT UNIT PRICE. PAYMENT SHALL BE FOR ALL MATERIALS, LABOR, INCIDENTALS AND EQUIPMENT FOR FURNISHING, PROPER SIGN PLACEMENT AND SIZING, TIMELY ERECTING AND/OR UNCOVERING OF SIGNS, MAINTAINING SIGNS, AND TIMELY COVERING AND/OR REMOVING SIGNS AND SUPPORTS.

THE FOLLOWING ESTIMATED QUANTITY HAS BEEN CARRIED TO THE GENERAL SUMMARY:

ITEM 614 - DETOUR SIGNING, AS PER PLAN = LUMP SUM

DESIGN AGENCY



DESIGNER

KLM

REVIEWER

GF MM-DD-YY

PROJECT ID

110051

SHEET TOTAL

P.23 104

**ITEM 614 - WORK ZONE PAVEMENT MARKING, CLASS III, 642 PAINT:**  
 WORK ZONE PAVEMENT MARKINGS SHALL BE PLACED TO REFLECT THE PROPOSED PAVEMENT MARKINGS AS DETERMINED FROM THE PROPOSED MARKINGS WITHIN THE PROJECT LIMITS. IT SHALL BE THE CONTRACTOR'S RESPONSIBILITY TO VERIFY THE LOCATION, SIZE, AND TYPE OF WORK ZONE MARKINGS NEEDED MEETING THE REQUIREMENTS OF ITEM 614 BEFORE THE REMOVAL OR RESURFACING OBLITERATES THE EXISTING.

| LOCATION           | LANE LINE         | EDGE LINE         | CHANNELIZING LINE | DOTTED LINE    | STOP LINE    |
|--------------------|-------------------|-------------------|-------------------|----------------|--------------|
| I-670 EASTBOUND    | 7.49 MILE         | 6.10 MILE         | 7924 FT           | 4806 FT        |              |
| I-670 WESTBOUND    | 7.85 MILE         | 6.06 MILE         | 12037 FT          | 2954 FT        |              |
| RAMP B (US 33T)    |                   | 0.08 MILE         |                   |                |              |
| RDWY AB (US 33 T)  | 0.70 MILE         | 1.65 MILE         | 623 FT            | 23 FT          | 34 FT        |
| RDWY A (US 33T)    | 0.50 MILE         | 1.00 MILE         |                   |                |              |
| RDWY B (US 33T)    | 0.62 MILE         | 1.24 MILE         |                   |                |              |
| RAMP C (GRANDVIEW) |                   | 0.34 MILE         |                   |                |              |
| RAMP B (GRANDVIEW) |                   | 0.08 MILE         |                   |                |              |
| RAMP S-C (US 33T)  | 0.23 MILE         | 0.46 MILE         |                   |                |              |
| RAMP S-E (US 33T)  | 0.21 MILE         | 0.63 MILE         | 570 FT            |                | 30 FT        |
| ROAD S-G (SR 315)  |                   | 0.42 MILE         |                   |                |              |
| ROAD S-L (SR 315)  |                   | 0.52 MILE         |                   |                |              |
| ROAD S-K (SR 315)  |                   | 0.12 MILE         |                   |                |              |
| RAMP NC (NEIL)     |                   | 0.46 MILE         |                   | 265 FT         |              |
| RAMP ND (GOODALE)  |                   | 0.38 MILE         |                   |                |              |
| RAMP NE (NEIL)     |                   | 0.20 MILE         |                   |                |              |
| RAMP NF (GOODALE)  | 0.09 MILE         | 0.18 MILE         |                   |                |              |
| RAMP NI (N 3RD)    |                   | 0.28 MILE         | 400 FT            | 136 FT         |              |
| RAMP NJ (GOODALE)  |                   | 0.10 MILE         | 97 FT             |                | 31 FT        |
| RAMP NL (N 3RD)    |                   | 0.24 MILE         | 224 FT            |                |              |
| RAMP NM (N 4TH)    |                   | 0.26 MILE         |                   |                |              |
| PAVEMENT REPAIRS   | 0.20 MILE         | 0.40 MILE         |                   |                |              |
| <b>TOTAL</b>       | <b>17.89 MILE</b> | <b>21.20 MILE</b> | <b>21875 FT</b>   | <b>8184 FT</b> | <b>95 FT</b> |

THE FOLLOWING QUANTITIES HAVE BEEN PROVIDED AND THE TOTALS HAVE BEEN CARRIED TO THE GENERAL SUMMARY:

- ITEM 614 - WORK ZONE LANE LINE, CLASS III, 6", 642 PAINT = 17.89 MILE
- ITEM 614 - WORK ZONE EDGE LINE, CLASS III, 6", 642 PAINT = 21.20 MILE
- ITEM 614 - WZ CHANNELIZING LINE, CLASS III, 12", 642 PAINT = 21875 FT
- ITEM 614 - WORK ZONE DOTTED LINE, CLASS III, 6", 642 PAINT = 8184 FT
- ITEM 614 - WORK ZONE STOP LINE, CLASS III, 642 PAINT = 95 FT

WORK ZONE PAVEMENT MARKINGS ARE NOT TO BE SUBSTITUTED FOR PERMANENT PAVEMENT MARKINGS.

**INTERIM COMPLETION DATE:**

THE CONTRACTOR SHALL HAVE AN INTERIM COMPLETION DATE IN ACCORDANCE WITH THE INCENTIVE/DISINCENTIVE CONTRACT TABLE BELOW:

| DESCRIPTION OF CRITICAL WORK  | INTERIM COMPLETION DATE | TIME PERIOD | DISINCENTIVE \$ PER TIME PERIOD | INCENTIVE \$ PER TIME PERIOD | MAXIMUM DISINCENTIVE |
|---|-------------------------|-------------|---------------------------------|------------------------------|----------------------|
| PAVEMENT REPAIRS, FINAL PERMANENT PAVEMENT, STRIPING, AND RPM INSTALLATION ON MAINLINE I-670 FROM STRUCTURE FRA-670-0107 FORWARD APPROACH (SLM 1.148EB/1.149WB) TO STRUCTURE FRA-670-0312 REAR APPROACH (SLM 3.132EB/3.128WB) | 10/15/2022              | DAYS        | \$3,000                         | \$0                          | \$90,000             |

**PASSING AND DRIVING LANES:**

LANE CLOSURES SHALL BE COMMENSURATE WITH THE WORK IN PROGRESS. SEE THE LANE VALUE CONTRACT TABLE.  
 - DURING TIMES WHEN NO WORK IS BEING PERFORMED, ONLY DRUMS SHALL BE USED TO DELINEATE THE WORK ZONE AND SHALL NOT ENCROACH ON AN OPEN LIVE LANE OF TRAFFIC.  
 - DURING TIMES WHEN WORK IS IN PROGRESS, WEIGHTED CHANNELIZERS MAY BE USED TO DELINEATE THE IMMEDIATE WORK AREA. AVAILABLE LANE WIDTH FOR THE ADJACENT LIVE LANE SHALL BE NO LESS THAN 11 FEET. WHEN WORK IS SUSPENDED, ALL WEIGHTED CHANNELIZERS SHALL BE REMOVED AND REPLACED WITH DRUMS AS DESCRIBED ABOVE.  
 - DURING PEAK HOURS OF 6AM-8AM AND 4PM-6PM, ANY WORK WITHIN 3 FEET OF AN OPEN LIVE LANE OF TRAFFIC SHALL BE SUSPENDED. THIS INCLUDES BUT IS NOT LIMITED TO CONSTRUCTION RELATED VEHICLES ENTERING OR LEAVING THE WORK ZONE. THE REMAINING OPEN LANES OF LIVE TRAFFIC SHALL HAVE THE EXISTING 12 FOOT WIDTHS AVAILABLE DURING THIS TIME.

DESIGN AGENCY





DESIGNER  
KLM

REVIEWER  
GF MM-DD-YY


PROJECT ID  
110051

SHEET TOTAL  
P.25 | 104

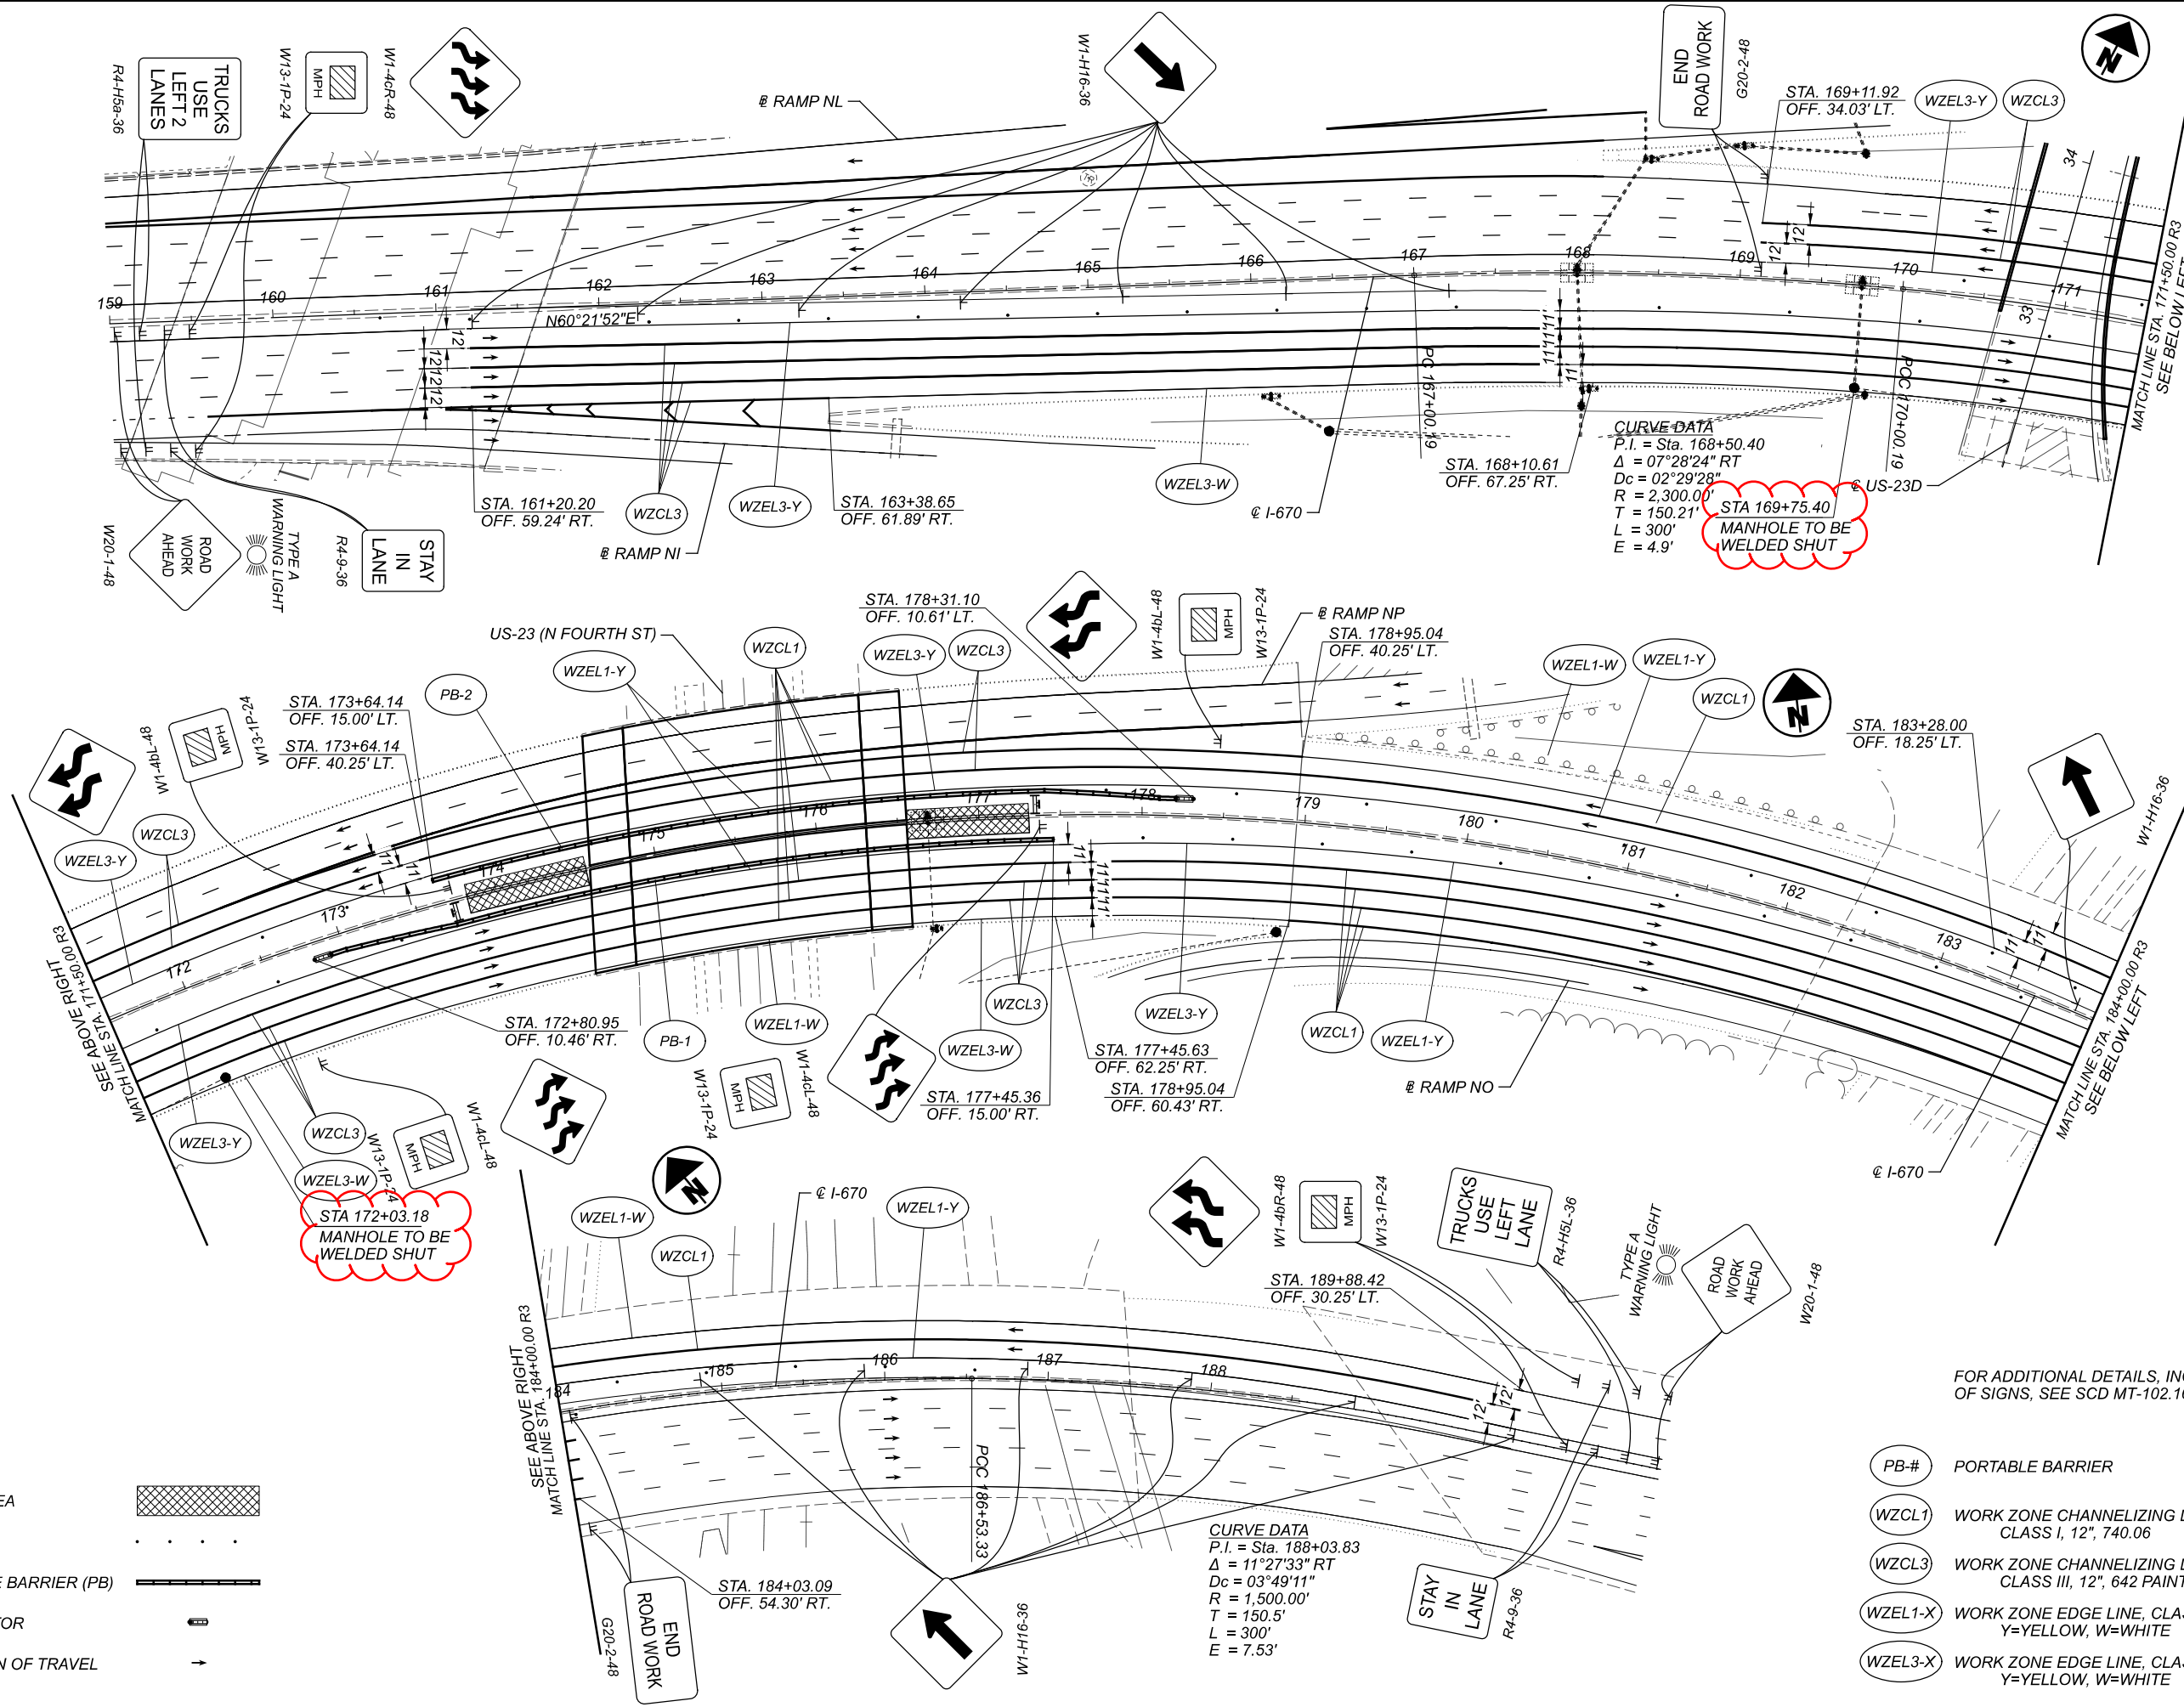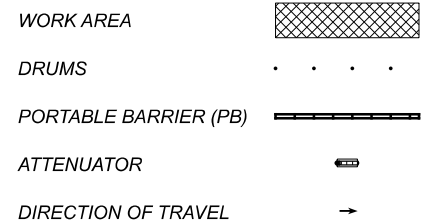

FOR ADDITIONAL DETAILS, INCLUDING SPACING OF SIGNS, SEE SCD MT-102.10

- PB-# PORTABLE BARRIER
- WZCL1 WORK ZONE CHANNELIZING LINE, CLASS I, 12", 740.06
- WZCL3 WORK ZONE CHANNELIZING LINE, CLASS III, 12", 642 PAINT
- WZEL1-X WORK ZONE EDGE LINE, CLASS I, 6", 740.06  
Y=YELLOW, W=WHITE
- WZEL3-X WORK ZONE EDGE LINE, CLASS III, 6", 642 PAINT  
Y=YELLOW, W=WHITE

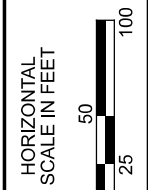


MAINTENANCE OF TRAFFIC PLAN  
CONCRETE BARRIER REPLACEMENT

|               |              |
|---------------|--------------|
| DESIGN AGENCY |              |
| DESIGNER      | KLM          |
| REVIEWER      | XXX MM-DD-YY |
| PROJECT ID    | 110051       |
| SHEET         | TOTAL        |
| P.29          | 104          |

| SHEET NO.              |           |      |      |       |       |       |       |       |      |    |     |  | PARTICIPATION |           | ITEM    | EXT      | TOTAL | UNIT                                  | DESCRIPTION  | SEE SHEET NO. |
|------------------------|-----------|------|------|-------|-------|-------|-------|-------|------|----|-----|--|---------------|-----------|---------|----------|-------|---------------------------------------|--|---------------|
| P.18-P.21              | P.22-P.26 | P.28 | P.41 | P.42  | P.43  | P.44  | P.45  | P.69  | P.80 |    |     |  | 01/IMS/PV     | 02/IMS/BR |         |          |       |                                       |  |               |
| <b>ROADWAY</b>         |           |      
| LS                     |           |      |      |       |       |       |       |       |      |    |     |  | LS            |           | 201     | 11000    | LS    | CLEARING AND GRUBBING                 |  |               |
|                        |           |      |      |       |       |       | 150   |       |      |    |     |  | 150           |           | 202     | 23000    | 150   | SY                                    | PAVEMENT REMOVED   |               |
|                        |           |      |      |       |       |       | 150   |       |      |    |     |  | 150           |           | 202     | 30700    | 150   | FT                                    | CONCRETE BARRIER REMOVED   |               |
|                        |           |      |      |       |       |       | 20    |       |      |    |     |  | 20            |           | 202     | 32500    | 20    | FT                                    | CURB AND GUTTER REMOVED  |               |
|                        |           |      |      |       |       |       | 87.5  |       |      |    |     |  | 87.5          |           | 202     | 38001    | 87.5  | FT                                    | GUARDRAIL REMOVED, AS PER PLAN   | P.18          |
|                        |           |      |      |       |       |       | 1     |       |      |    |     |  | 1             |           | 202     | 42041    | 1     | EACH                                  | ANCHOR ASSEMBLY REMOVED, TYPE T, AS PER PLAN                                 | P.18          |
| 750                    |           |      |      |       |       |       |       |       |      |    |     |  | 750           |           | SPECIAL | 20270110 | 750   | FT                                    | PIPE CLEANOUT, 24" AND UNDER   | P.18          |
| 10                     |           |      |      |       |       |       |       |       |      |    |     |  | 10            |           | SPECIAL | 20270120 | 10    | FT                                    | PIPE CLEANOUT, 27" TO 48"  | P.18          |
|                        |           |      |      |       |       |       |       |       | 289  |    |     |  |               |           | 202     | 75267    | 289   | FT                                    | VANDAL PROTECTION FENCE REMOVED AND RESET, AS PER PLAN                       | P.80          |
|                        |           |      |      |       |       |       | 36    |       |      |    |     |  | 36            |           | 203     | 20001    | 36    | CY                                    | EMBANKMENT, AS PER PLAN  | P.18          |
| 2                      |           |      |      |       |       |       |       |       |      |    |     |  | 2             |           | 209     | 15001    | 2     | STA                                   | RESHAPING UNDER GUARDRAIL, AS PER PLAN                                       | P.18          |
|                        |           |      |      |       |       |       | 293   |       |      |    |     |  | 293           |           | 512     | 10100    | 293   | SY                                    | SEALING OF CONCRETE SURFACES (EPOXY-URETHANE)                                |               |
|                        |           |      |      |       |       |       | 75    |       |      |    |     |  | 75            |           | 606     | 13000    | 75    | FT                                    | GUARDRAIL, TYPE 5  |               |
|                        |           |      |      |       |       |       | 130   |       |      |    |     |  | 130           |           | 622     | 10141    | 130   | FT                                    | CONCRETE BARRIER, SINGLE SLOPE, TYPE C1, AS PER PLAN                         | P.64          |
|                        |           |      |      |       |       |       | 20    |       |      |    |     |  | 20            |           | 622     | 90000    | 20    | FT                                    | BARRIER, MISC.: REINFORCED CONCRETE, SINGLE SLOPE, TYPE C1, OVER I-3C1 INLET | P.65          |
|                        |           |      |      |       |       |       | 1     |       |      |    |     |  | 1             |           | 623     | 39500    | 1     | EACH                                  | MONUMENT BOX ADJUSTED TO GRADE   |               |
| <b>EROSION CONTROL</b> |           |      
| 22                     |           |      |      |       |       |       |       |       |      |    |     |  | 22            |           | 659     | 00300    | 22    | CY                                    | TOPSOIL  |               |
| 156                    |           |      |      |       |       |       |       |       |      |    | 150 |  | 306           |           | 659     | 10000    | 306   | SY                                    | SEEDING AND MULCHING   |               |
| 8                      |           |      |      |       |       |       |       |       |      |    |     |  | 8             |           | 659     | 14000    | 8     | SY                                    | REPAIR SEEDING AND MULCHING  |               |
| 8                      |           |      |      |       |       |       |       |       |      |    |     |  | 8             |           | 659     | 15000    | 8     | SY                                    | INTER-SEEDING  |               |
| 0.02                   |           |      |      |       |       |       |       |       |      |    |     |  | 0.02          |           | 659     | 20000    | 0.02  | TON                                   | COMMERCIAL FERTILIZER  |               |
| 0.03                   |           |      |      |       |       |       |       |       |      |    |     |  | 0.03          |           | 659     | 31000    | 0.03  | ACRE                                  | LIME   |               |
| 1                      |           |      |      |       |       |       |       |       |      |    |     |  | 1             |           | 659     | 35000    | 1     | MGAL                                  | WATER  |               |
|                        |           |      |      |       |       |       |       |       |      |    |     |  | 1000          |           | 832     | 30000    | 1000  | EACH                                  | EROSION CONTROL  |               |
| <b>DRAINAGE</b>        |           |      
|                        |           |      |      |       |       |       |       |       | 200  |    |     |  | 200           |           | 605     | 31100    | 200   | FT                                    | AGGREGATE DRAINS   |               |
|                        |           |      |      |       |       |       | 1     |       |      |    |     |  | 1             |           | 611     | 98630    | 1     | EACH                                  | CATCH BASIN ADJUSTED TO GRADE  |               |
| 4                      |           |      |      |       |       |       |       |       |      |    |     |  | 4             |           | 611     | 99150    | 4     | EACH                                  | INLET ADJUSTED TO GRADE  |               |
|                        |           |      |      |       |       |       | 2     |       |      |    |     |  | 2             |           | 611     | 99654    | 2     | EACH                                  | MANHOLE ADJUSTED TO GRADE  |               |
| 9                      |           |      |      |       |       |       |       |       |      |    |     |  | 9             |           | SPECIAL | 69098000 | 9     | EACH                                  | DRAINAGE STRUCTURE CLEANOUT  | P.18          |
| <b>PAVEMENT</b>        |           |      
| 718                    |           |      | 282  |       |       |       |       |       |      |    |     |  | 1000          |           | 251     | 01041    | 1000  | SY                                    | PARTIAL DEPTH PAVEMENT REPAIR (ASPHALT CONCRETE BASE), AS PER PLAN, 4.0"     | P.19          |
|                        |           |      |      |       |       |       | 53154 |       |      |    |     |  | 53154         |           | 254     | 01000    | 53154 | SY                                    | PAVEMENT PLANING, ASPHALT CONCRETE, 1.5"                                     |               |
|                        |           |      |      | 42033 | 41709 | 13074 |       |       |      |    |     |  | 96816         |           | 254     | 01000    | 96816 | SY                                    | PAVEMENT PLANING, ASPHALT CONCRETE, 3.5"                                     |               |
| 531                    |           |      |      |       |       |       |       |       |      |    |     |  | 531           |           | 254     | 01600    | 531   | SY                                    | PATCHING PLANED SURFACE  |               |
| 1716                   |           |      | 380  |       |       |       |       |       |      |    |     |  | 2096          |           | 255     | 20000    | 2096  | FT                                    | FULL DEPTH PAVEMENT SAWING   |               |
| 415                    |           |      | 139  |       |       |       |       |       |      |    |     |  | 554           |           | 255     | 10160    | 554   | SY                                    | FULL DEPTH PAVEMENT REMOVAL AND RIGID REPLACEMENT, CLASS QC MS, 11.00"       |               |
| 415                    |           |      | 139  |       |       |       |       |       |      |    |     |  | 554           |           | 257     | 10000    | 554   | SY                                    | DIAMOND GRINDING PORTLAND CEMENT CONCRETE PAVEMENT                           |               |
|                        |           |      |      |       |       |       | 66    |       |      |    |     |  | 66            |           | 301     | 46000    | 66    | CY                                    | ASPHALT CONCRETE BASE, PG64-22   |               |
|                        |           |      |      |       |       |       | 26    |       |      |    |     |  | 26            |           | 304     | 20001    | 26    | CY                                    | AGGREGATE BASE, AS PER PLAN  | P.19          |
|                        |           |      |      | 2942  | 2919  | 915   |       |       |      |    |     |  | 6776          |           | 407     | 13900    | 6776  | GAL                                   | TACK COAT, 702.13  |               |
|                        |           |      |      |       |       |       | 3338  | 3693  | 4518 | 24 |     |  | 11573         |           | 407     | 20000    | 11573 | GAL                                   | NON-TRACKING TACK COAT   |               |
|                        |           |      |      |       |       |       | 25219 | 25027 | 7843 |    |     |  | 58089         |           | 409     | 30000    | 58089 | FT                                    | SAWING AND SEALING ASPHALT CONCRETE PAVEMENT JOINTS                          |               |
|                        |           |      |      |       |       |       | 1092  | 1207  |      |    |     |  | 2299          |           | 424     | 12001    | 2299  | CY                                    | FINE GRADED POLYMER ASPHALT CONCRETE, TYPE B, AS PER PLAN                    | P.19          |
|                        |           |      |      |       |       |       | 4326  | 4408  | 3307 |    |     |  | 12041         |           | 442     | 00100    | 12041 | CY                                    | ANTI-SEGREGATION EQUIPMENT   |               |
|                        |           |      |      |       |       |       | 3502  | 3477  | 3307 |    |     |  | 10286         |           | 442     | 10301    | 10286 | CY                                    | ASPHALT CONCRETE SURFACE COURSE, 12.5 MM, TYPE A (447), AS PER PLAN          | P.19          |
|                        |           |      |      |       |       |       |       |       | 20   |    |     |  | 20            |           | 609     | 23000    | 20    | FT                                    | COMBINATION CURB AND GUTTER, TYPE 4  |               |
|                        |           |      |      |       |       |       | 48    | 48    | 10   |    |     |  | 106           |           | 617     | 10100    | 106   | CY                                    | COMPACTED AGGREGATE  |               |
| 1                      |           |      |      |       |       |       |       |       |      |    |     |  | 1             |           | 617     | 25000    | 1     | MGAL                                  | WATER  |               |
| LS                     |           |      |      |       |       |       | 6926  | 7466  |      |    |     |  | 14392         |           | SPECIAL | 69098400 | LS    | PAVER MOUNTED THERMAL PROFILING (PMP) | P.19   |               |
|                        |           |      |      |       |       |       |       |       |      |    |     |  |               |           | 672     | 10000    | 74302 | FT                                    | VOID REDUCING ASPHALT MEMBRANE (VRAM)  |               |
|                        |           |      |      |       |       |       | 39264 | 43455 |      |    |     |  | 82719         |           | 897     | 01010    | 82719 | SY                                    | PAVEMENT PLANING, ASPHALT CONCRETE, CLASS A, 1.0"                            |               |
| 828                    |           |      |      |       |       |       |       |       |      |    |     |  | 828           |           | 897     | 02000    | 828   | SY                                    | PATCHING PLANED SURFACE  |               |
| <b>WATER WORK</b>      |           |      
| 4                      |           |      |      |       |       |       |       |       |      |    |     |  | 4             |           | 638     | 10800    | 4     | EACH                                  | VALVE BOX ADJUSTED TO GRADE  |               |

GENERAL SUMMARY

DESIGN AGENCY



DESIGNER  
KLM

REVIEWER  
XXX MM-DD-YY

PROJECT ID  
110051

SHEET TOTAL  
P.39 | 104