

PROPERTY MAP

FRANKLIN COUNTY, FRANKLIN TWP.


CITY OF COLUMBUS

VMS 530 & VMS 2668


FED. RD. DIVISION	STATE	PROJECT	623 654
2	OHIO	I-70-3(31)92 U-233(10)	

FRANKLIN COUNTY
 FRA-70-760 I-70-3(4)92
 FRA-33-1296 U-233(10)
 LIMITED ACCESS

8
39

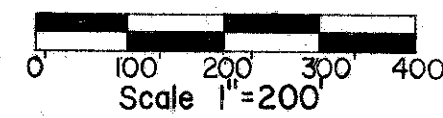

Parcels 167B-EL, 167C-EL, 167D-EL1 & 167D-EL2 have been acquired in the name of "State of Ohio, Department of Highways" in Volume 3160 page 663 - as per RDM on 4-24-18

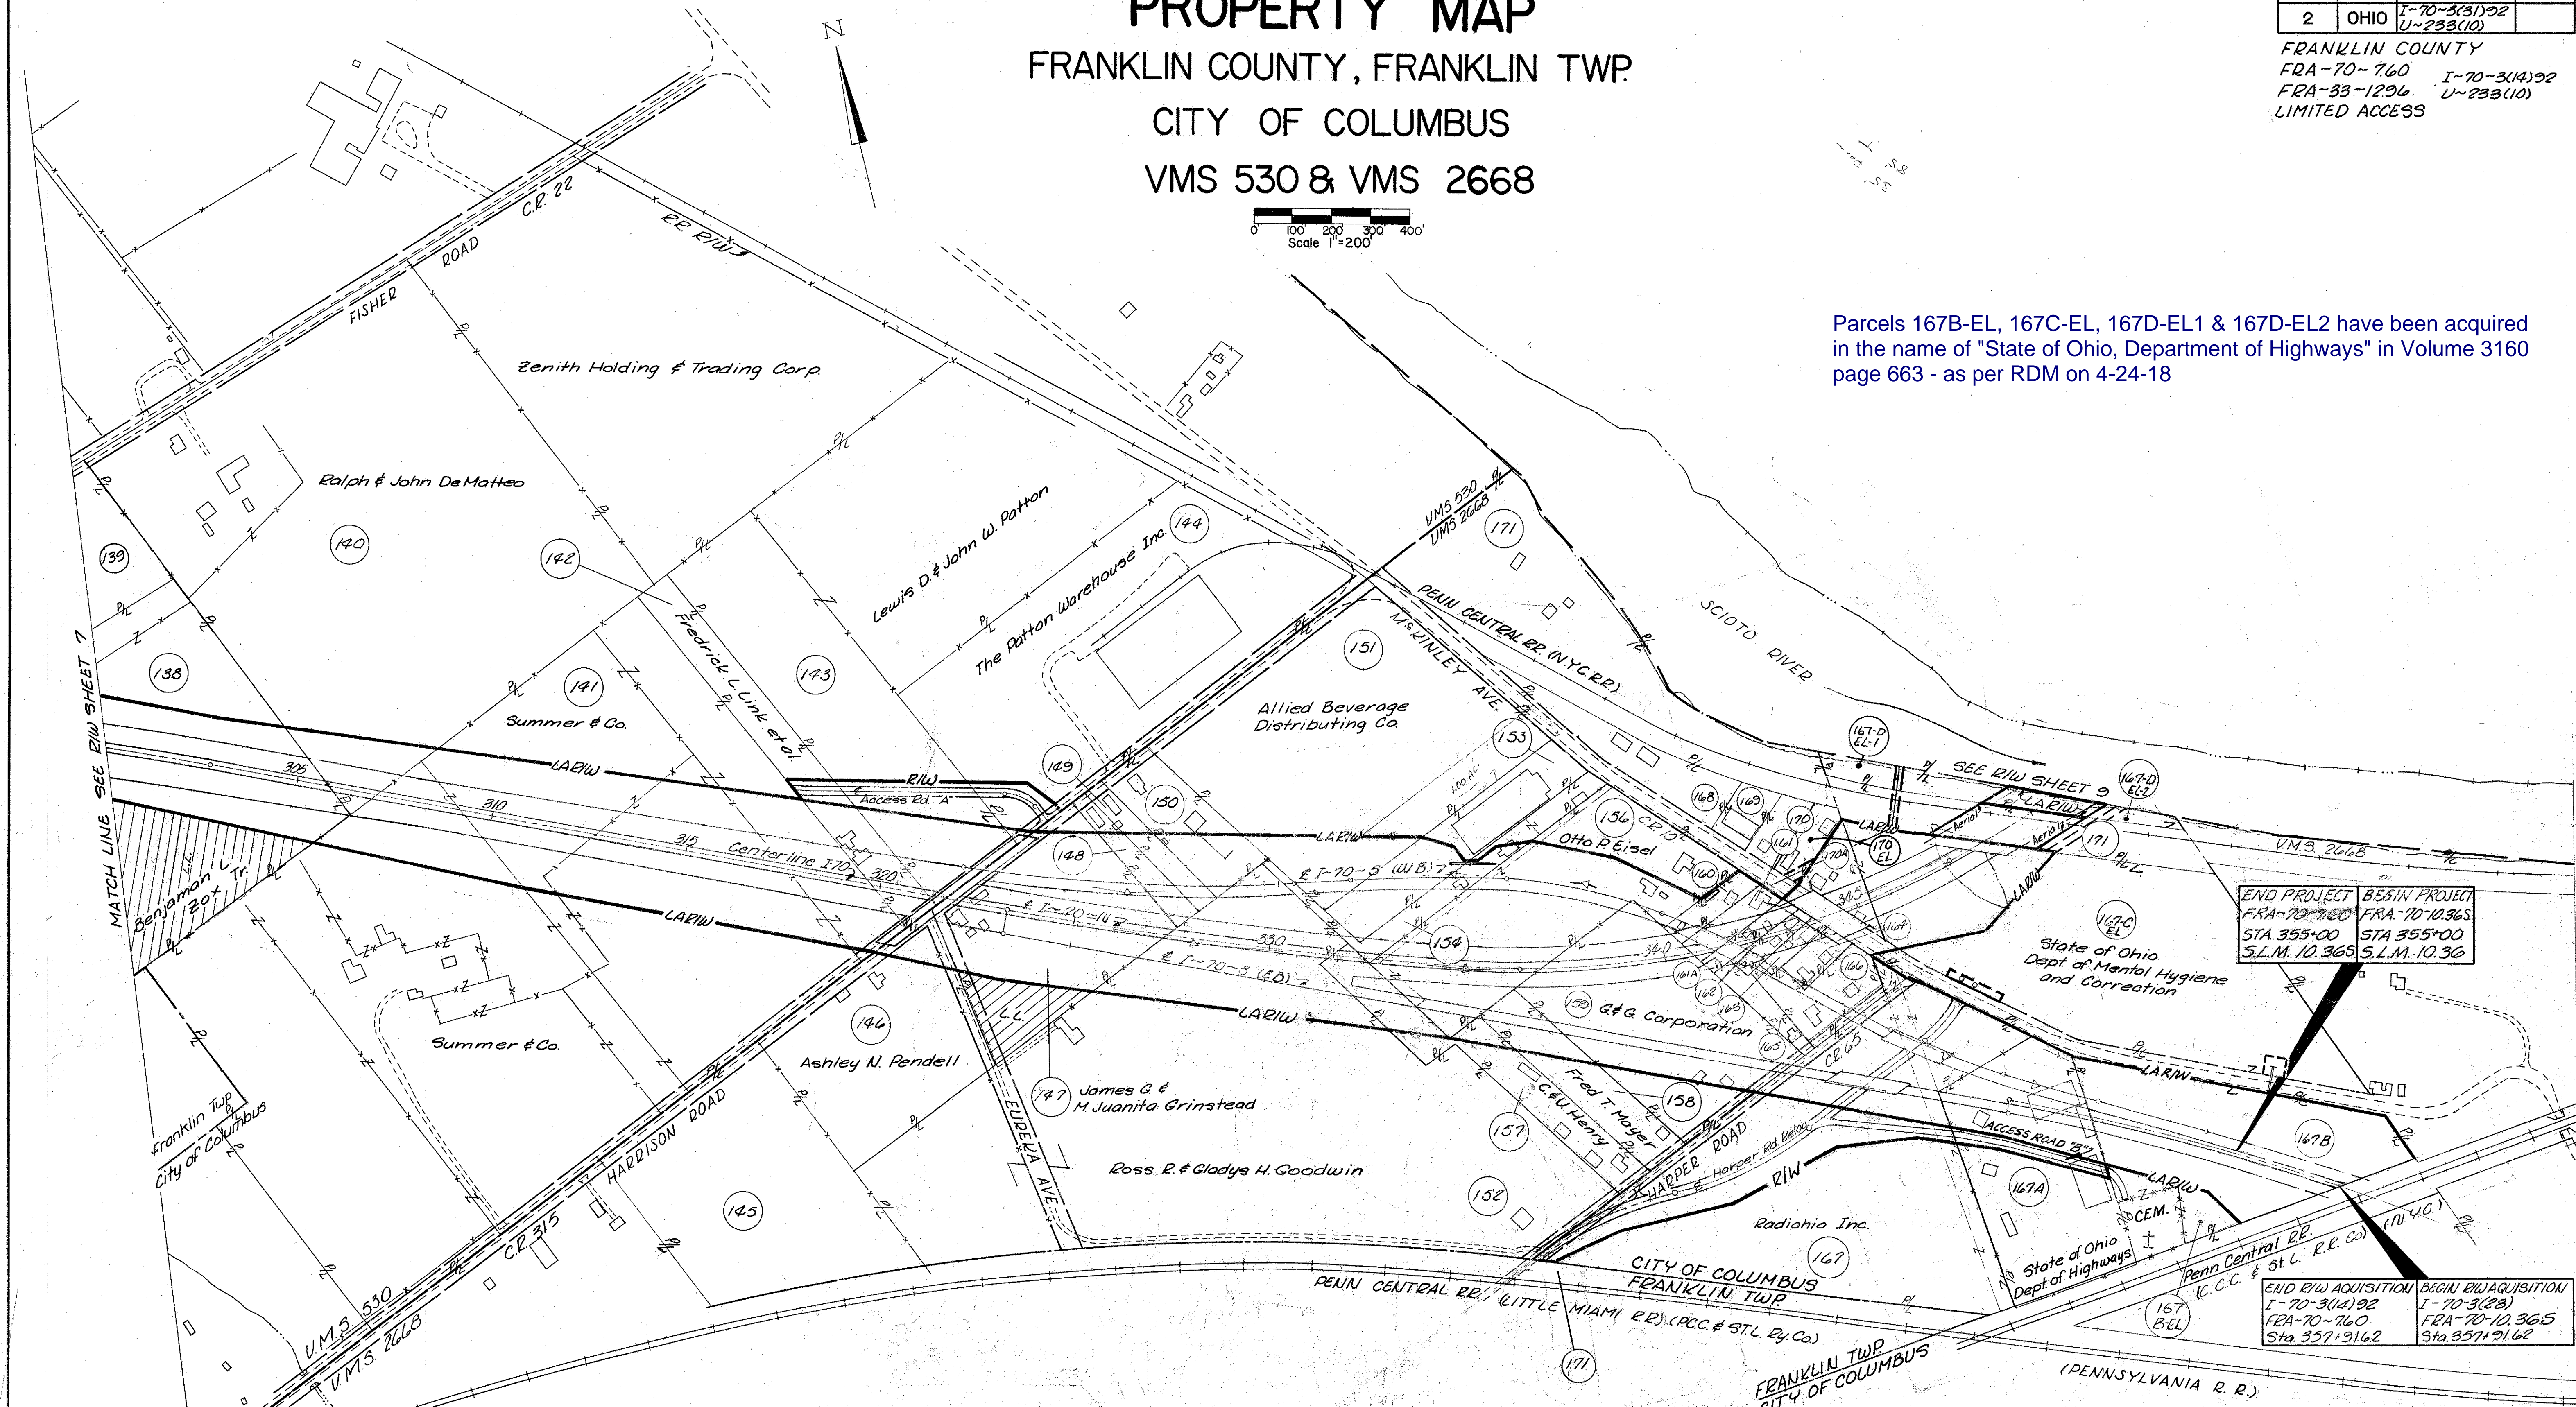

END PROJECT	BEGIN PROJECT
FRA-70-760	FRA-70-10.365
STA 355+00	STA 355+00
S.L.M. 10.365	S.L.M. 10.36

END ROW ACQUISITION	BEGIN ROW ACQUISITION
I-70-3(14)92	I-70-3(28)
FRA-70-760	FRA-70-10.365
Sta 357+91.62	Sta 357+91.62

1	M.T.J.	Revise LARIW Parcels 153+154	1-9-70
2	M.T.J.	Add Channel Eas. Parcel 167C	4-10-70
3		Added PARCEL 170 EL	8-12-74

REV. BY	DESCRIPTION	DATE
---------	-------------	------

LAND LOCKED RESIDUE