


FED. RD. DIVISION	STATE	PROJECT	
2	OHIO		

647A
654

FRA 70 - 7.60
FRA 33 - 12.96
LIMITED ACCESS

32A
39

FRANKLIN CO., CITY OF COLUMBUS
V.M.S. 2668

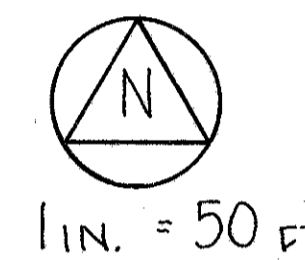


STATE OF OHIO, DEPT OF MENTAL
HYGIENE AND CORRECTION

167
C-EL

8.54 AC

Parcels 167B-EL, 167C-EL, 167D-EL1 & 167D-EL2 have been acquired
in the name of "State of Ohio, Department of Highways" in Volume 3160
page 663 - as per RDM on 4-24-18

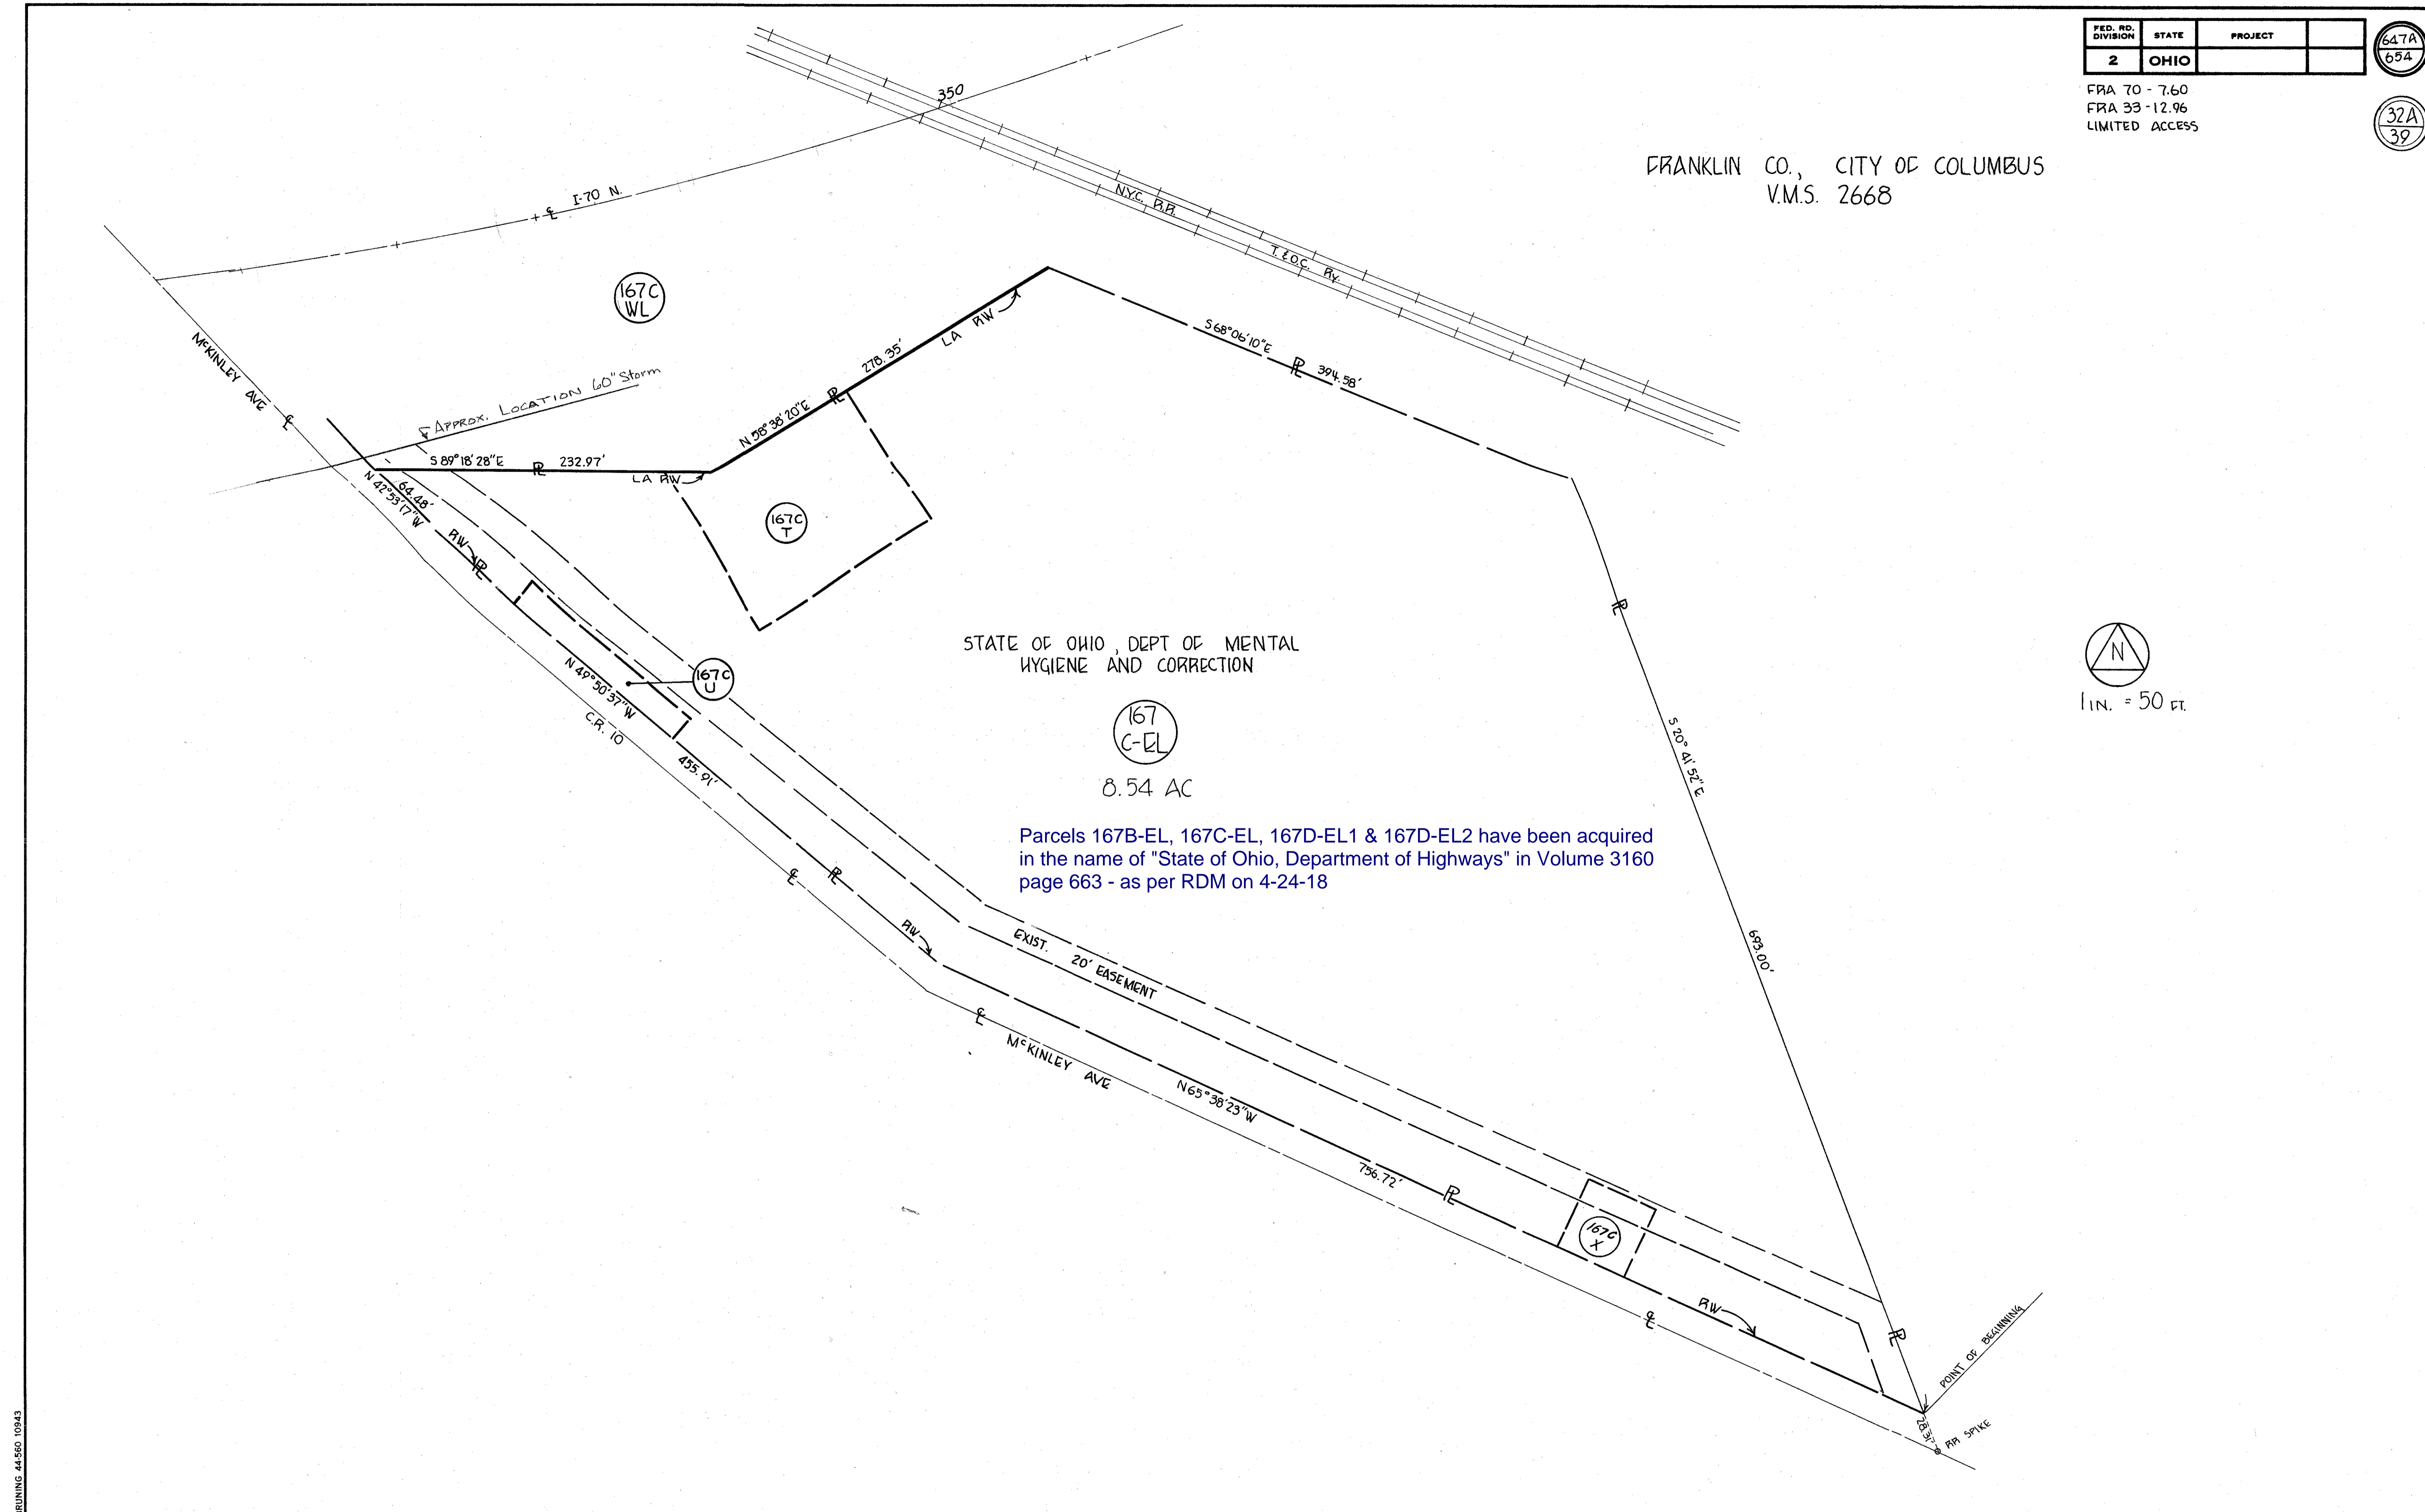

BRUNING 44,560 10943

EXCESS LAND