

MATCH LINE STA. CDS-1399+75

CROSS REFERENCES			
SHEET NO.	DESCRIPTION	CURVE INFO.	
4	C10, C19		
132	ROADWAY PROFILE		
67	UNDERDRAIN DATA AND QUANTITIES		
362	LIGHTING PLAN		
STATION TO STATION		SIDE	
* STATIONING REFERS TO RAMP B ALIGNMENT			
B1	1395+75 ~ 1399+75	L.T.	380
F1	* 78+40 ~ 82+21	R.T.	353
R1	1395+75 ~ 1399+75	R.T.	400
D1	1396+00	L-R	78
G1	1397+80.56 ~ 1399+73.73	L.T.	175
SHEET TOTALS			1
STATION TO STATION		SIDE	
* STATIONING REFERS TO RAMP B ALIGNMENT			
D2	1395+00	R.T.	1
D3	1395+83 ~ 1396+00	L.T.	24
D4	* 78+63	L-R	99
EC1	* 78+40 ~ 78+63	L.T.	18
SHEET TOTALS			164

FRA-270-32.46


PLAN
CDS-1395+75 TO STA. CDS-1399+75

CALC BY: GJW
DATE: 2/2/94
CHKD BY: MFE
DATE: 12/5/94

20
10
HORIZONTAL
SCALE IN FEET



131
593

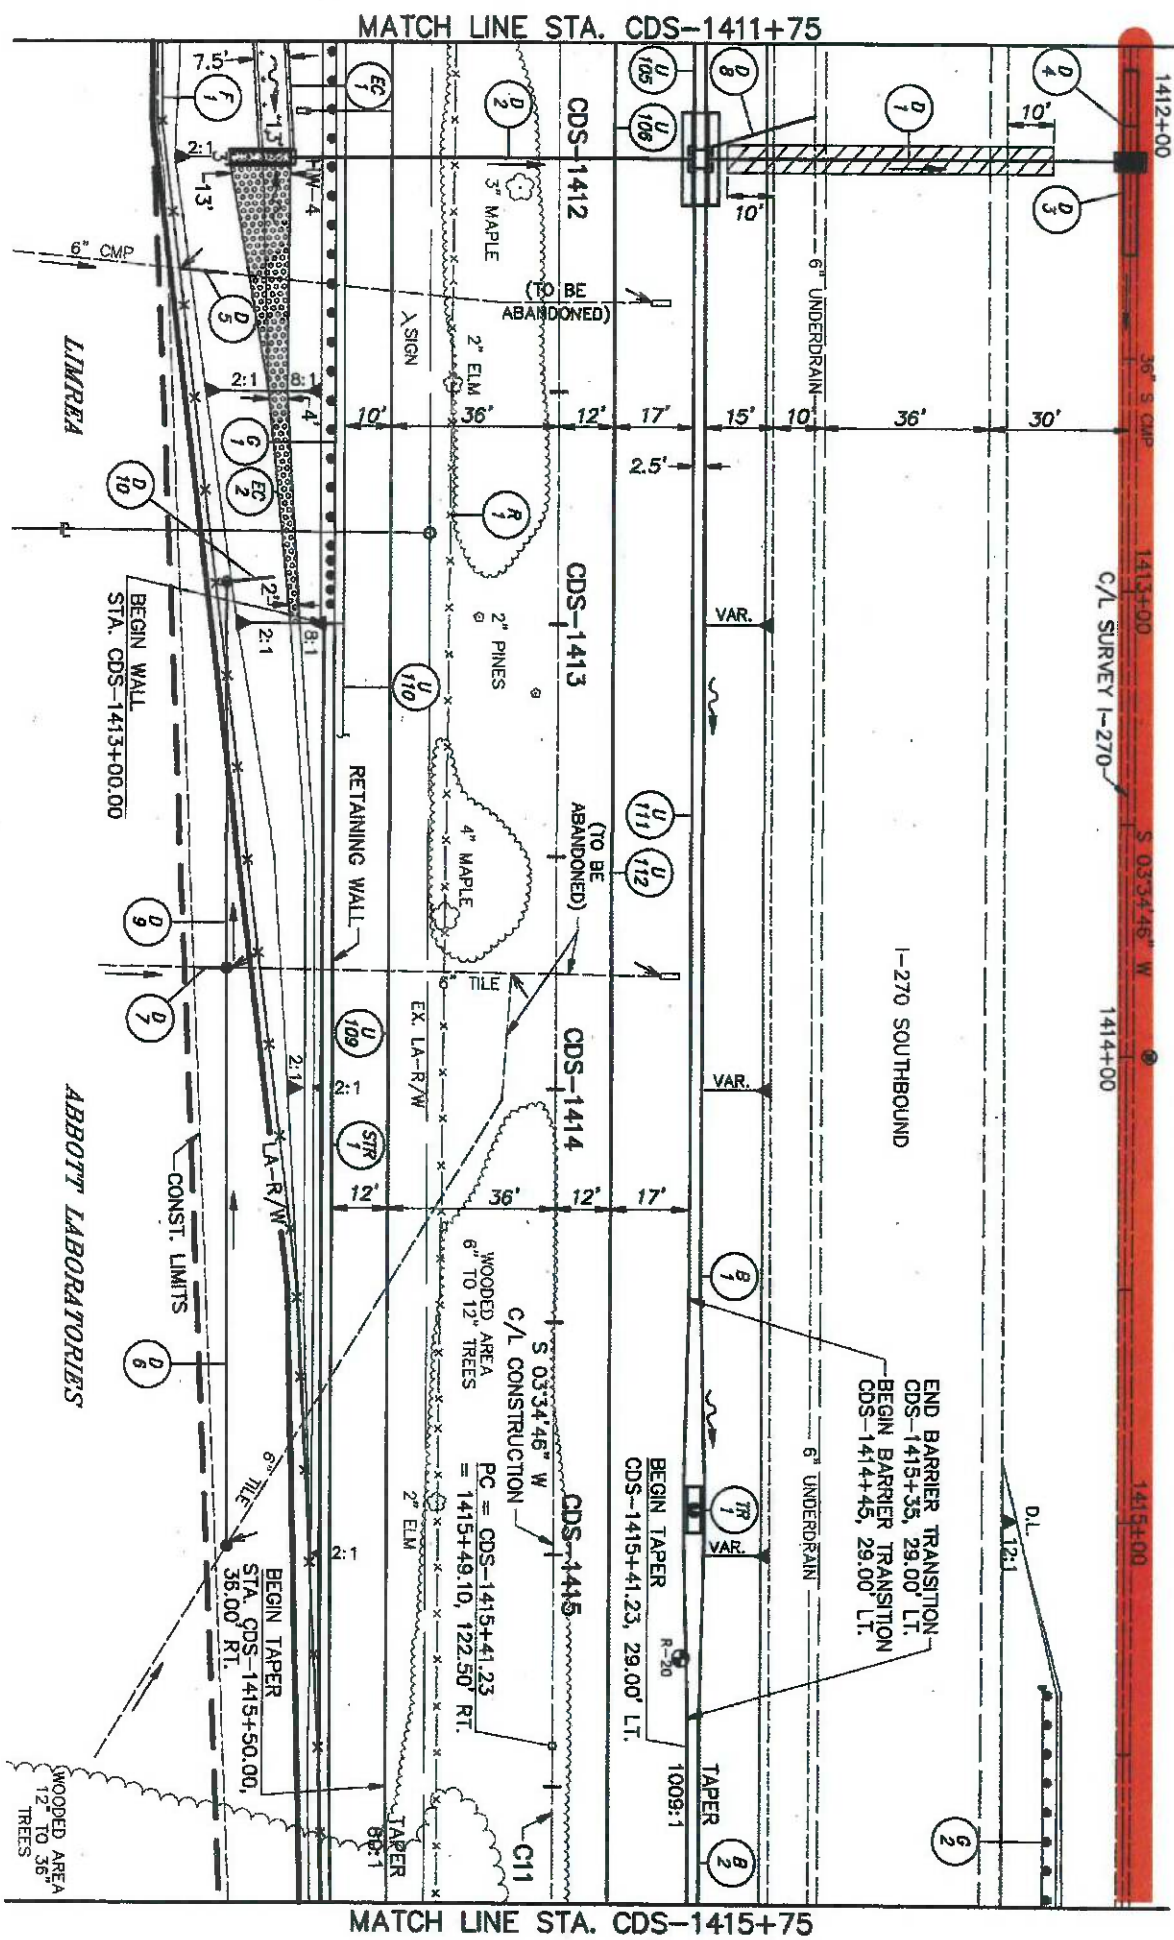

850	845	840	835	830	825
837.64					841.0 837.51
					+29.52, 6" TILE INV. 838.54
837.53					841.0 837.38
837.42					840.7 837.25
					EX. GRND. EX. EOP
837.31					840.1 837.13
					+75.07, 6" TILE INV. 837.57
837.20					840.1 837.00
837.09					840.5 836.89
836.98					840.3 836.77
836.87					840.1 836.63
850	845	840	835	830	825

CROSS REFERENCES									
SHEET NO.	DESCRIPTION	SHEET NO.	DESCRIPTION						
4	C11 CURVE INFO.	362	⊙ LIGHTING PLAN						
67	U UNDERDRAIN DATA AND QUANTITIES	315	DRAINAGE PROFILE						
524	SR RETAINING WALL								
342	TP TRAFFIC CONTROL PLAN								

REFERENCE No.										
STATION TO STATION				SIDE						
ALL STATIONING REFERS TO CDS ALIGNMENT				CONCRETE BARRIER, TYPE B	FENCE, TYPE CL	FENCE, TYPE CL AS PER PLAN	GUARDRAIL, TYPE 5	BRIDGE TERMINAL ASSEMBLY, TYPE 1	FENCE REMOVED	ANCHOR ASSEMBLY, TYPE E
B1	1411+75 ~ 1414+85	L.T.	280	L.F.	L.F.	L.F.	L.F.	E.A.	L.F.	E.A.
B2	1414+95 ~ 1415+75		80							
G1	1411+70.85 ~ 1413+00	R.T.					112.5	1		
G2	1415+29.62 ~ 1415+79.80	L.T.					25			1
F1	1411+75 ~ 1415+75	R.T.		377	26					
R1	1411+75 ~ 1415+75	R.T.						400		
SHEET TOTALS			370	377	26	137.5	1	400	1	

REFERENCE No.									
STATION TO STATION				SIDE					
ALL STATIONING REFERS TO CDS ALIGNMENT				INLET, NO. 3D	CONDUIT, BORED OR JACKED, 21", TYPE B	18" CONDUIT, TYPE B	21" CONDUIT, TYPE B	CONCRETE MASONRY	RIPRAP USING 6" REIN. CONCRETE SLAB
D1	1412+00	L.T.	1	E.A.	L.F.	L.F.	L.F.	C.Y.	C.Y.
D2	1412+00	L-R				88	22	0.44	2.17
SHEET TOTALS			1	70	88	22	0.44	2.17	

REFERENCE No.										
STATION TO STATION				SIDE						
ALL STATIONING REFERS TO CDS ALIGNMENT				CATCH BASIN, NO. 4A AS PER PLAN	8" CONDUIT, TYPE F	36" CONDUIT, TYPE C 707.13	DITCH EROSION PROTECTION	ROCK CHANNEL PROTECTION, TYPE C WITH FILTER, T = 18"	INSPECTION WELL	6" CONDUIT, TYPE B, 707.17
D3	1412+00 ~ 1412+10	L.T.	1	E.A.	L.F.	L.F.	S.Y.	C.Y.	E.A.	L.F.
D4	1413+90 ~ 1412+00	L.T.				20				
D5	1412+25	R.T.			10					
D6	1413+74 ~ 1415+00	R.T.			124				1	
D7	1413+74	R.T.			6					
D8	1411+90 ~ 1412+00	L.T.								26
D9	1412+91 ~ 1413+74	R.T.	83						1	
D10	1412+90 ~ 1412+91	R.T.	10							
EC1	1411+75 ~ 1412+00	R.T.			21					
EC2	1412+00 ~ 1413+00	R.T.			31					
SHEET TOTALS			1	233	40	21	31	3	26	

138

593

FRA-270-32.46

PLAN & PROFILE

STA CDS-1411+75 TO STA. CDS-1415+75

DATE: G.J.W.
DATE: 2/2/84
BY: M.F.U.
DATE: 12/5/84

0

20

40

10

HORIZONTAL SCALE IN FEET

0

10

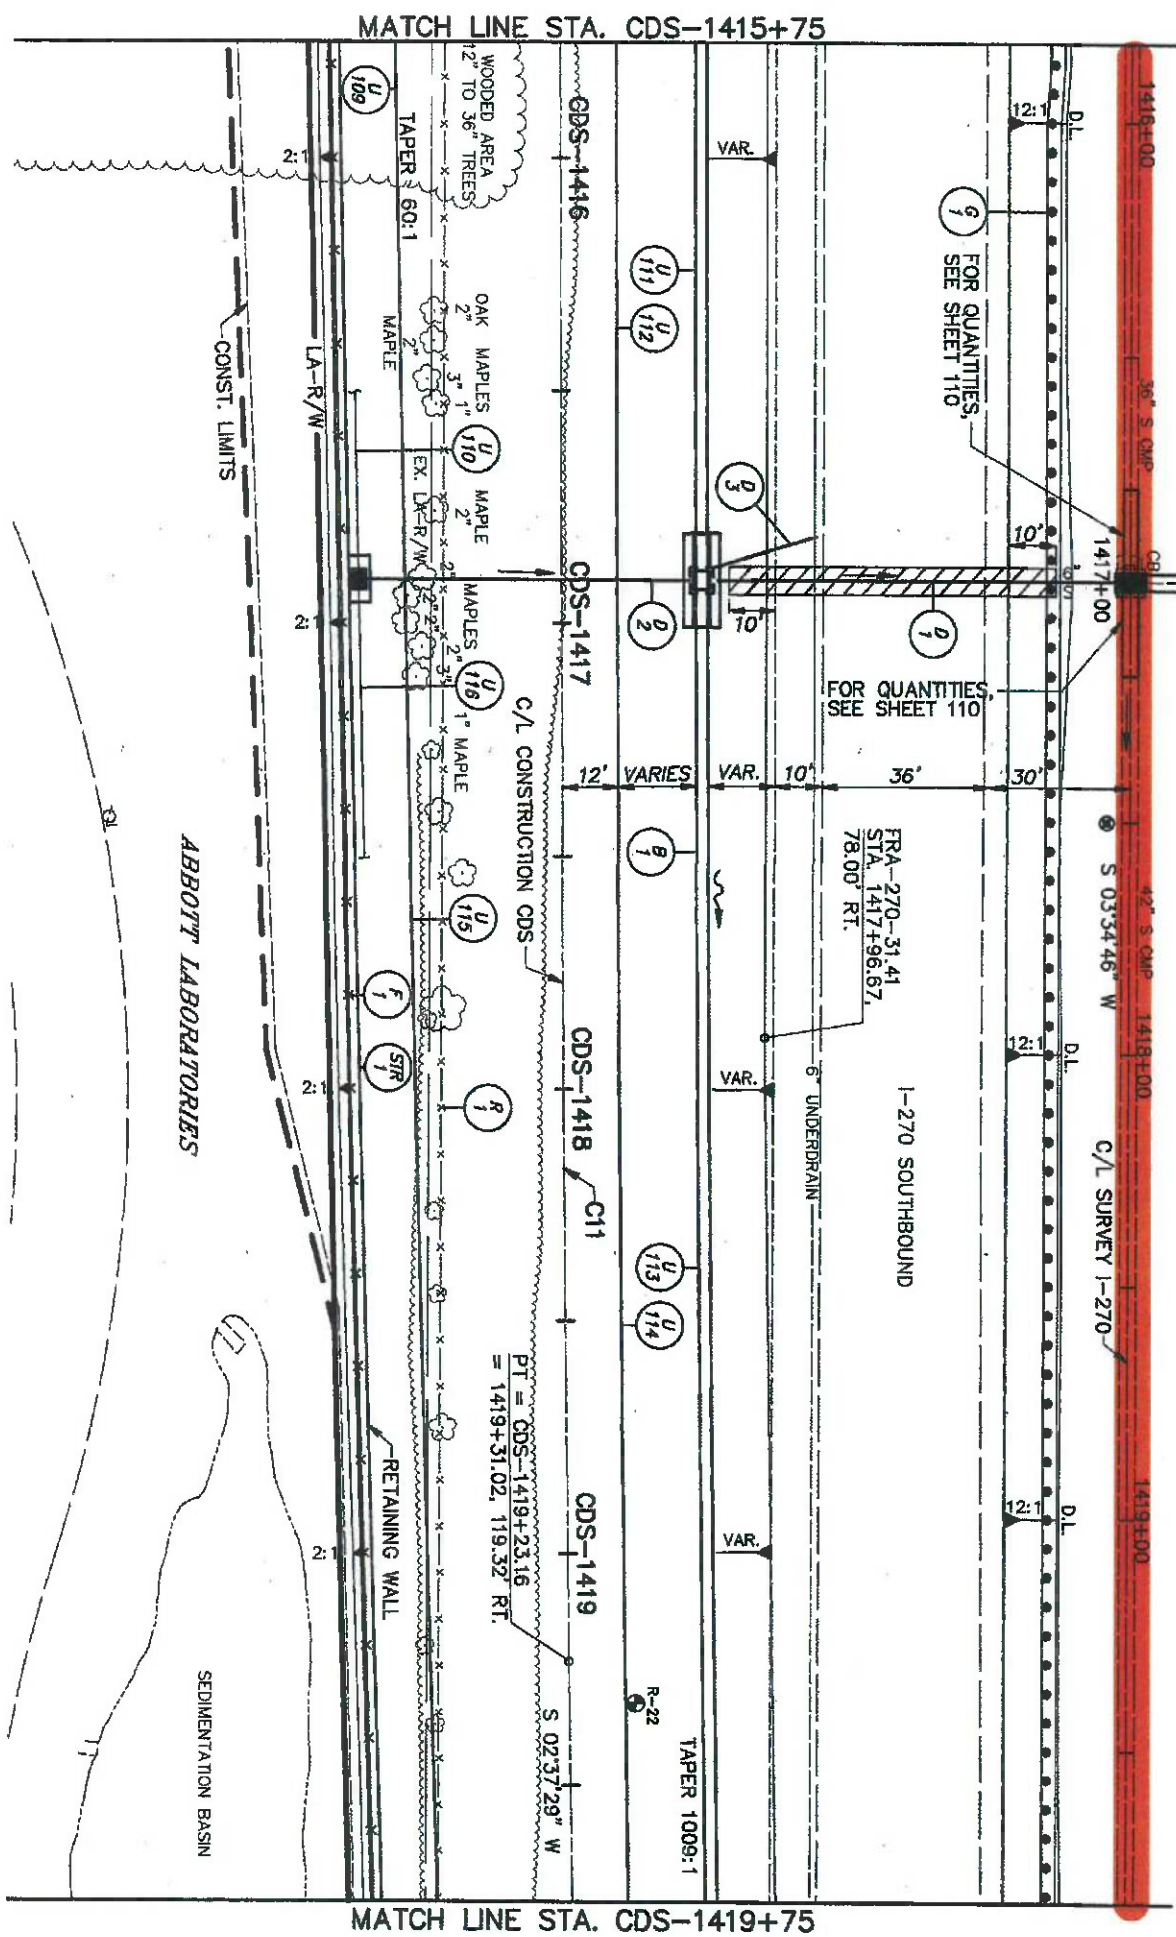

850	845	840	835	830	825
					840.0 836.50
					840.1 836.40
					840.8 836.29
					EX. GRND. EX. BOP
					840.2 836.19
					840.2 836.08
					840.0 835.95
					839.2 835.82
					838.5 835.68

CROSS REFERENCES									
SHEET NO.	DESCRIPTION								
4	C11	CURVE INFO.							
67	1	UNDERDRAIN DATA AND QUANTITIES							
524	1	RETAINING WALL							
362	LIGHTING PLAN								
REFERENCE No.			622	607	202	606			
STATION TO STATION									
ALL STATIONING REFERS TO CDS ALIGNMENT									
B1	1415+75 ~ 1419+75	LT.	380						
F1	1415+75 ~ 1419+75	RT.		400					
R1	1415+75 ~ 1419+75	RT.			400				
G1	1415+79.80 ~ 1419+81.32	LT.				400			
SIDE									
CONCRETE BARRIER, TYPE B			L.F.	L.F.	L.F.	L.F.			
FENCE, TYPE CL AS PER PLAN			L.F.						
FENCE REMOVED			L.F.						
GUARDRAIL, TYPE 5			L.F.						
STATION TO STATION									
ALL STATIONING REFERS TO CDS ALIGNMENT									
D1	1416+90.50	LT.	1						
D2	1416+90.50	L-R		1	75				
D3	1416+80 ~ 1416+90	LT.					26		
SIDE									
INLET, NO. 3D			EA.						
INLET, NO. 3E			EA.						
15" CONDUIT, TYPE B			L.F.						
18" CONDUIT, TYPE B			L.F.	22					
6" CONDUIT, TYPE B 707.17			L.F.						
CONDUIT, BORED OR JACKED, 18", TYPE B			L.F.		70				
STATION TO STATION									
ALL STATIONING REFERS TO CDS ALIGNMENT									
REFERENCE No.			604	604	603	603	603	603	
STATION TO STATION									
ALL STATIONING REFERS TO CDS ALIGNMENT									
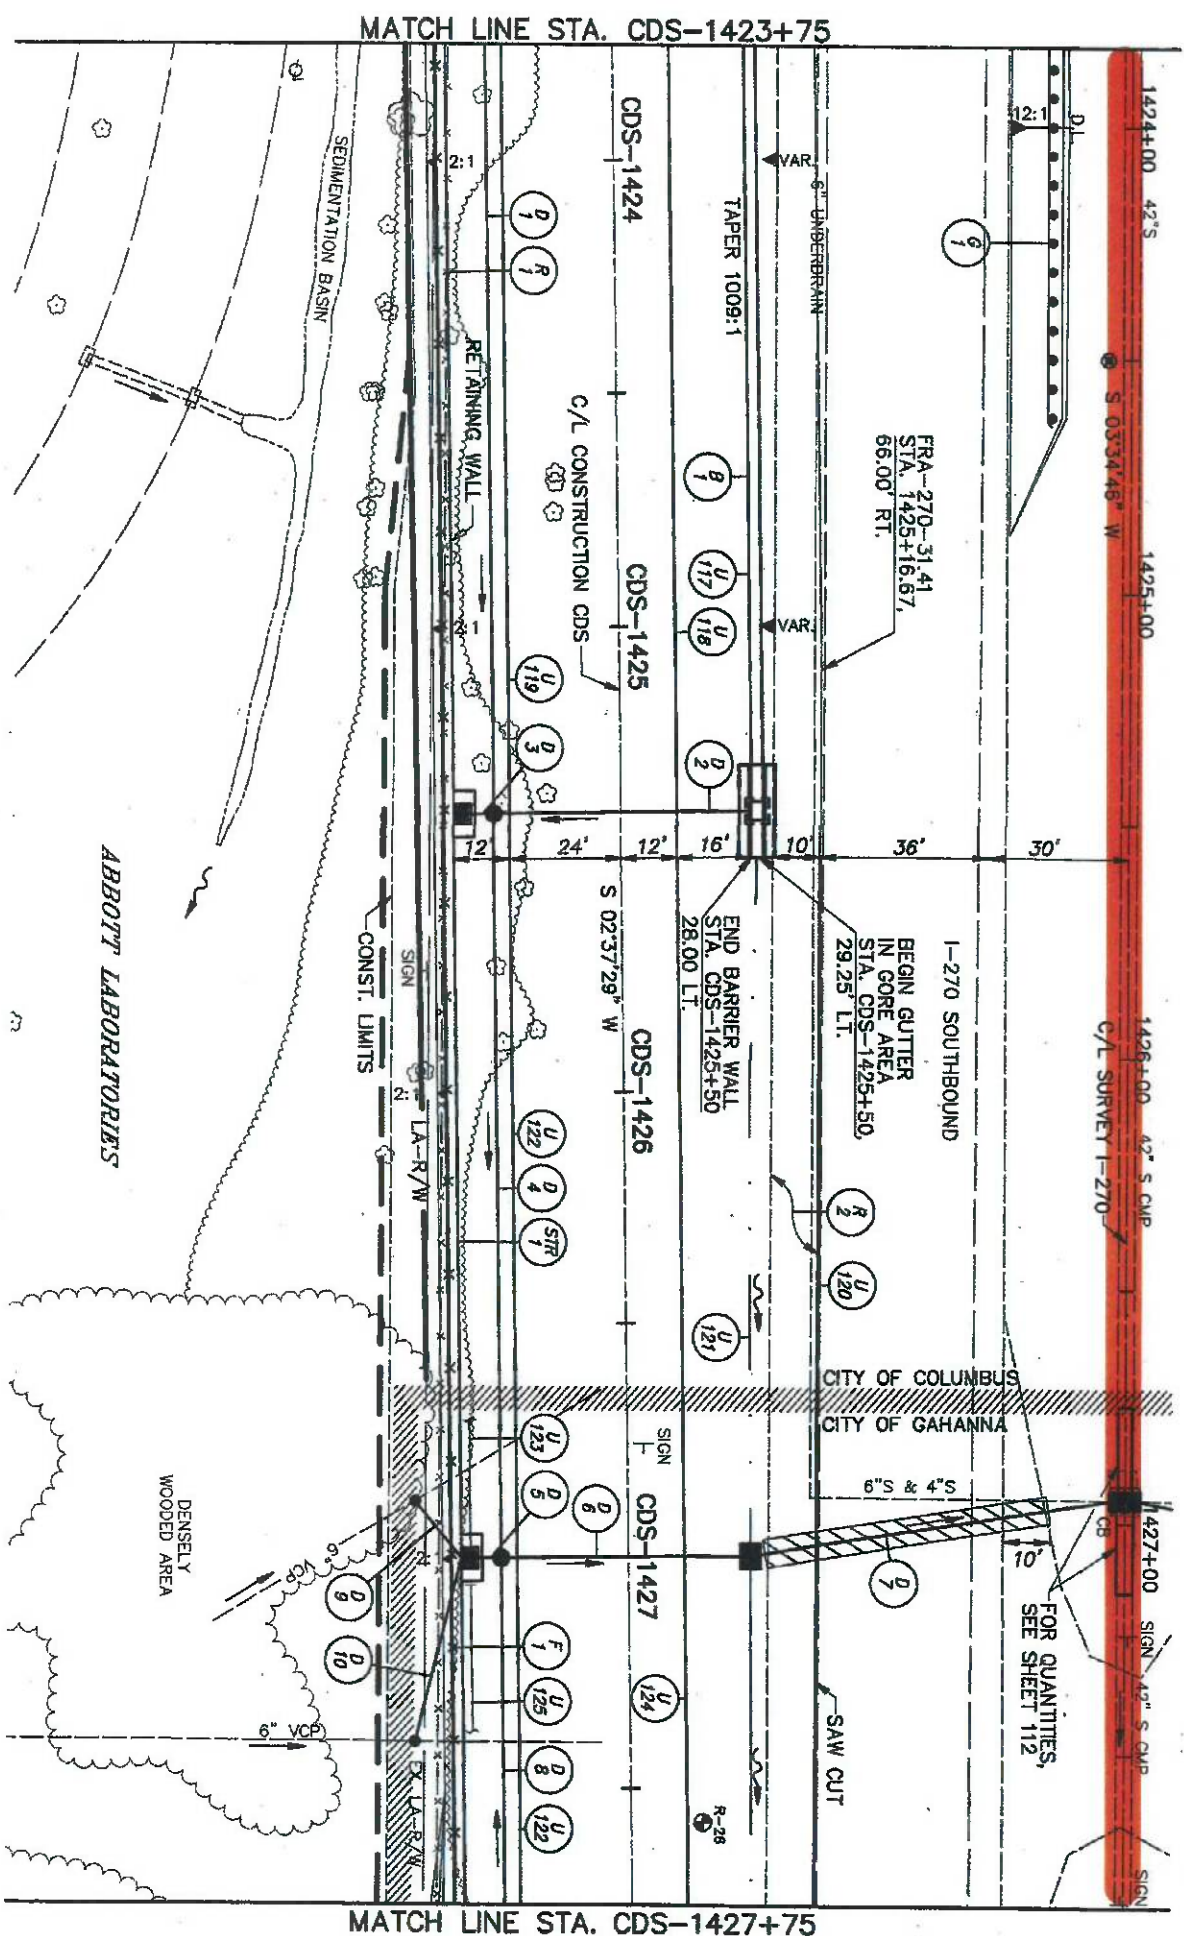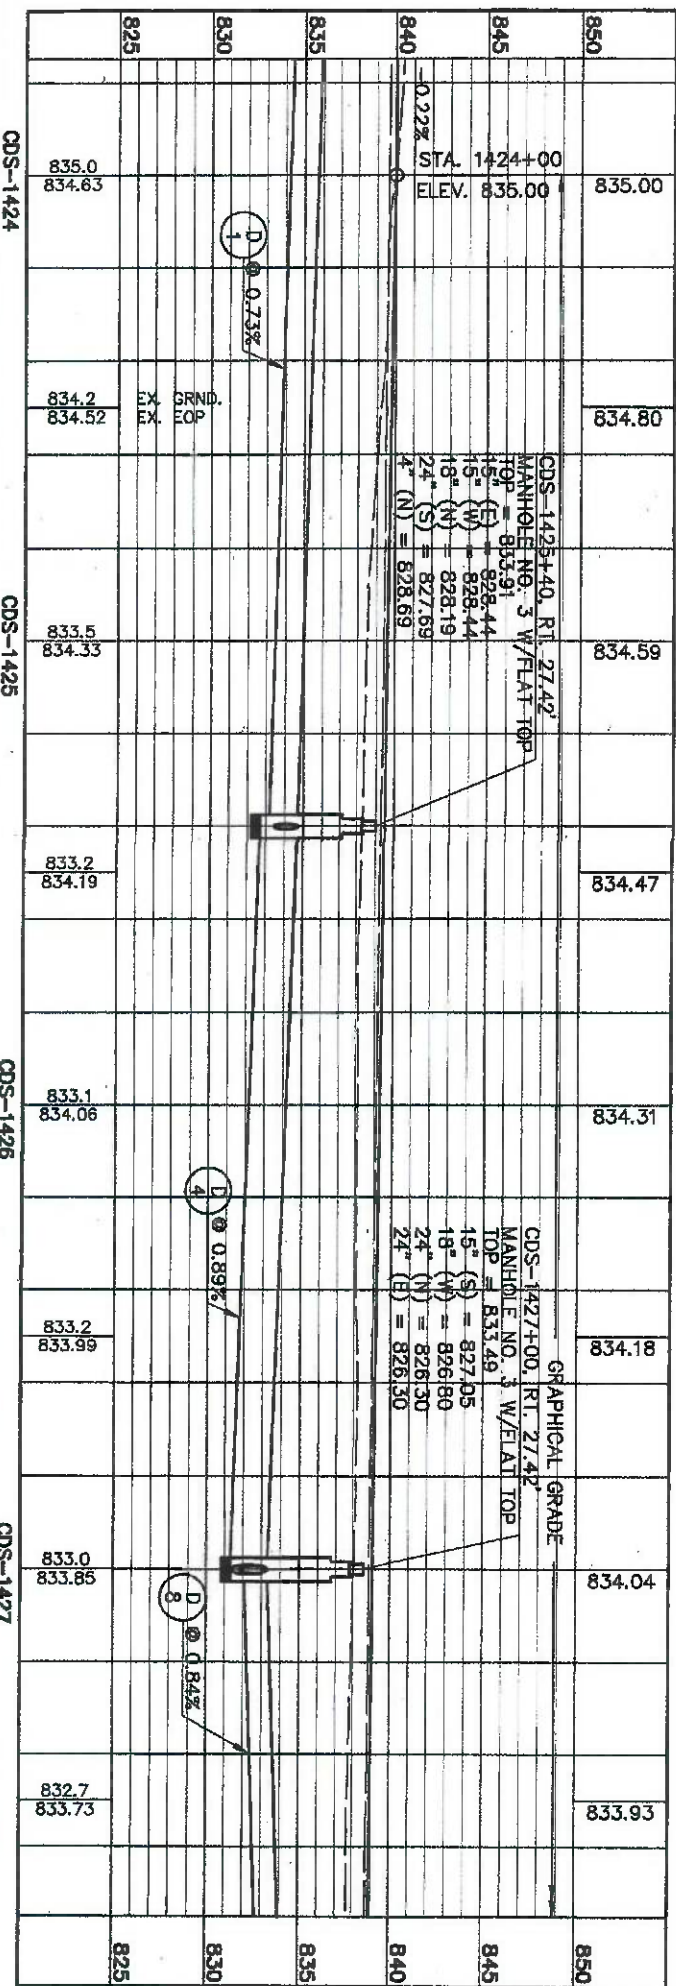

REFERENCE No.		STATION TO STATION		SIDE	
D9	1426+86 ~ 1427+00	RT.	16	L.F.	EA.
D10	1427+00 ~ 1427+40	RT.	42	L.F.	EA.
SHEET TOTALS			58	2	

REFERENCE No.		STATION TO STATION		SIDE	
D2	1425+40	L-R	1	EA.	EA.
D3	1425+40	RT.	1	EA.	EA.
D4	1425+40 ~ 1427+00	RT.	8	L.F.	L.F.
D5	1427+00	RT.	1	EA.	EA.
D6	1427+00	L-R	1	EA.	EA.
D7	1426+87 ~ 1427+00	L.T.	1	EA.	EA.
D8	1427+00 ~ 1427+75	RT.	75	L.F.	L.F.
SHEET TOTALS			1	2	2



REFERENCE No.		STATION TO STATION		SIDE	
B1	1423+75 ~ 1425+50	L.T.	155	L.F.	L.F.
F1	1423+75 ~ 1427+75	RT.	400	L.F.	L.F.
R1	1423+75 ~ 1427+75	RT.	400	L.F.	L.F.
R2	1425+50 ~ 1427+75	RT.	400	L.F.	L.F.
G1	1423+81.27 ~ 1424+50.28	L.T.	62.5	L.F.	L.F.
D1	1423+75 ~ 1425+40	RT.	165	L.F.	L.F.
SHEET TOTALS			155	400	400


FRA-270-32.46

PLAN & PROFILE
STA CDS-1423+75 TO STA. CDS-1427+75



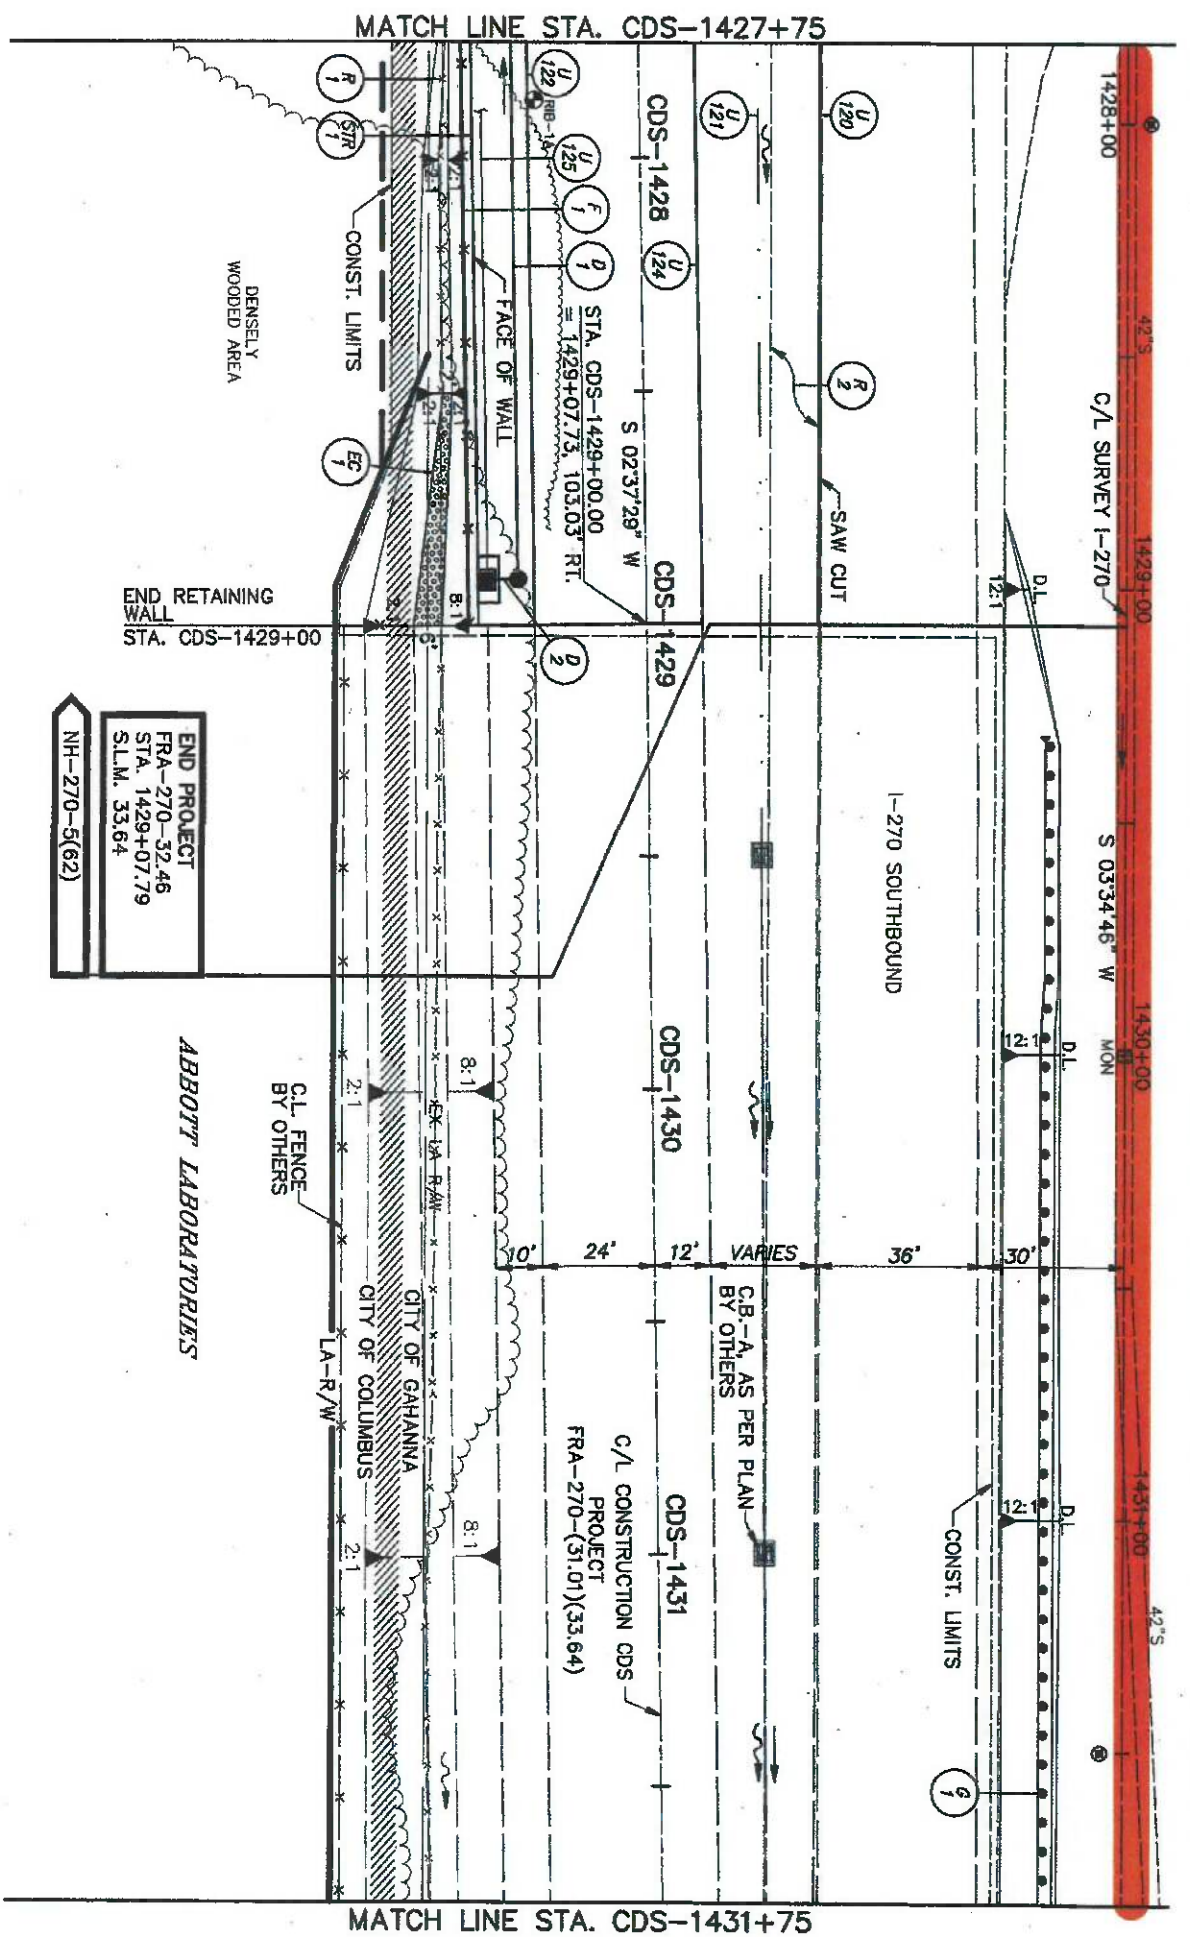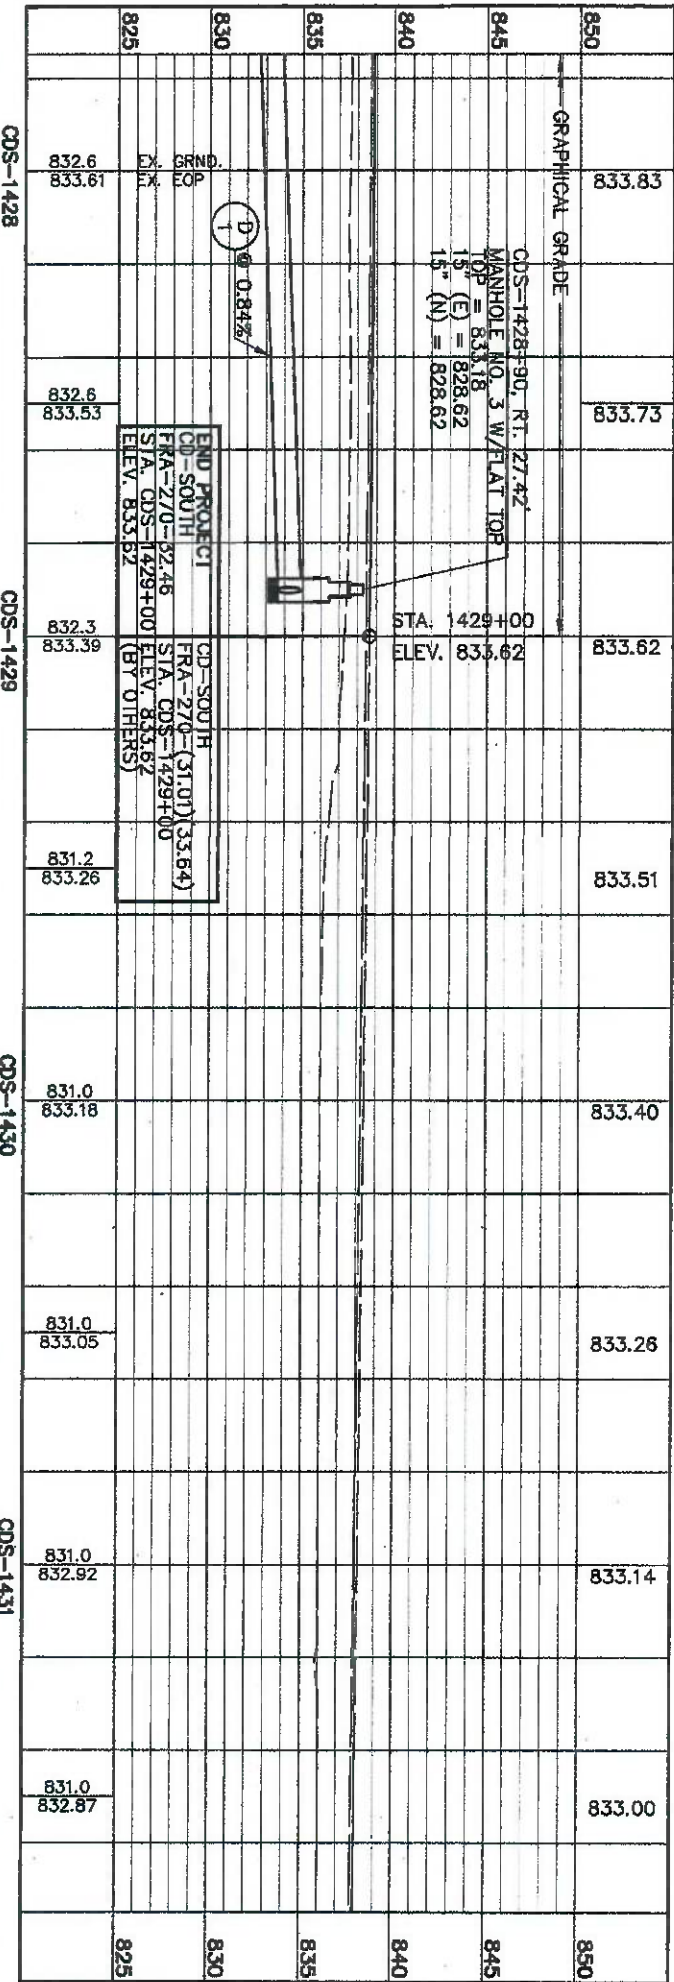

CROSS REFERENCES			
SHEET NO.	DESCRIPTION	STATION	REFERENCE No.
67	UNDERDRAIN DATA AND QUANTITIES	1427+75 ~ 1429+00	RT.
524	RETAINING WALL	1427+75 ~ 1429+00	RT.
362	LIGHTING PLAN	1427+75 ~ 1429+00	RT.
607	FENCE, TYPE C1	1427+75 ~ 1429+00	RT.
607	FENCE, TYPE C1 AS PER PLAN	1427+75 ~ 1429+00	RT.
604	INLET, NO. 3E	1427+75 ~ 1429+00	RT.
604	MANHOLE, NO. 3 WITH FLAT TOP	1427+75 ~ 1429+00	RT.
603	15" CONDUIT, TYPE B	1427+75 ~ 1429+00	RT.
202	FENCE REMOVED	1427+75 ~ 1429+00	RT.
601	ROCK CHANNEL PROTECTION, TYPE C WITH FILTER, T = 18"	1427+75 ~ 1429+00	RT.
606	GUARDRAIL, TYPE 5	1427+75 ~ 1429+00	RT.
606	ANCHOR ASSEMBLY, TYPE E	1427+75 ~ 1429+00	RT.
202	PAVEMENT REMOVED	1427+75 ~ 1429+00	RT.
27	TOTALS	1427+75 ~ 1429+00	RT.



FRA-270-32.46

PLAN & PROFILE
STA CDS-1427+75 TO STA. CDS-1429+00

CALC. BY: GJW
DATE: 2/2/94
CHKD. BY: MFCJ
DATE: 12/5/94

0 20 40
10
HORIZONTAL
SCALE IN FEET



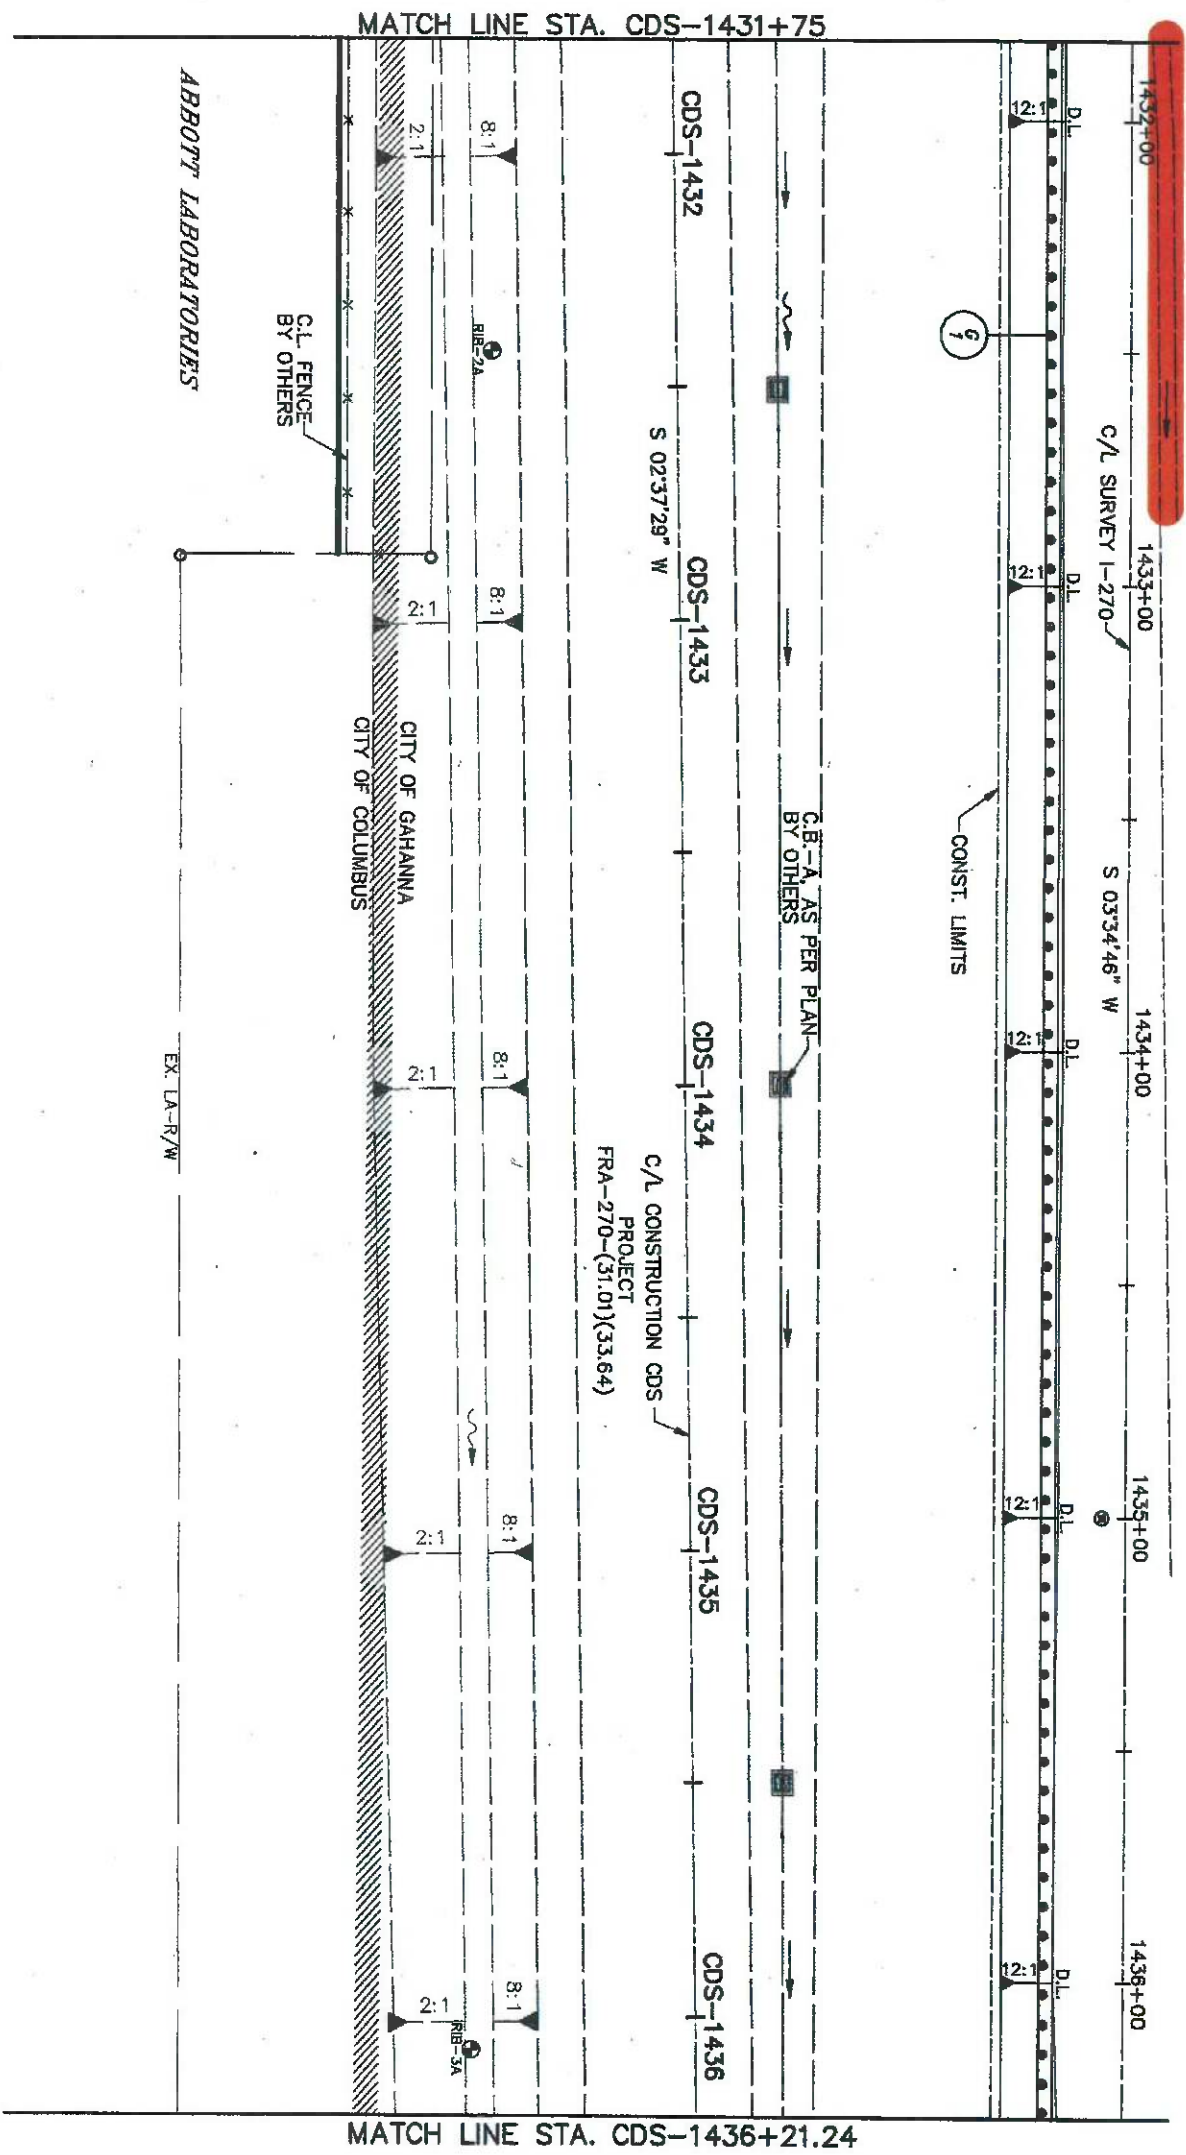

CROSS REFERENCES		REFERENCE No.	
SHEET NO.	DESCRIPTION	STATION TO STATION	SIDE
362	● LIGHTING PLAN	ALL STATIONING REFERS TO CDS ALIGNMENT	L.F.
		G1 1431+77.32 ~ 1436+21.25	L.T. 450
SHEET TOTALS		450	



PLAN
STA. CDS-1431+75 TO STA. CDS-1436+21.24

FRA-270-32.46

143
593





2	OHIO
---	------




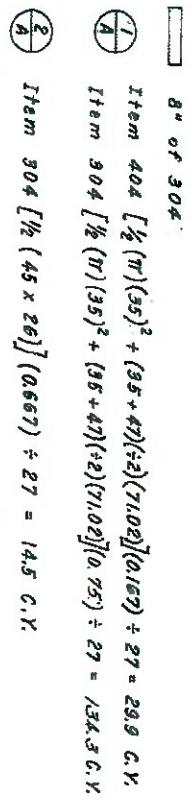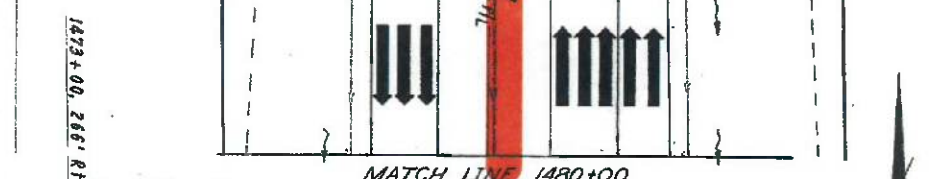

CALC: SAS 1-70
ONE W.O.L. 2-70

[illegible]

STATION TO STATION	SIDE	404		403		405		Bonds of Bonds of Ditto
		Agre- gates Bonds	Asphalt Concrete Type	6" Type	6" Type	6" Type	6" Type	
0-00 to 412-71	LT							
0-00 to 412-75	LT							
2379 to 480-00	LT							
2379 to 480-00	RT							
31-28	RT							
2-85	RT							
TOTALS		150	30	76	10	2000		



FRA-62-20.83

CHK: W.D.R. 2-70

1. For Ramp "D" Plan See Sheet No. 90-91.

4. For Ramp "B" & I.R. 270 Pavement Details, See Sheet No. _____

* Quantities Carried on Next Sheet.

RURAL TOTALS	124	1000	1	1	34	125
--------------	-----	------	---	---	----	-----

RURAL TOTALS	10	1804	
--------------	----	------	--

FRANKLIN COUNTY
FRA-270-25.39N
FRA-22-20.63


CALC: S.A.S. L-70
CHK: JUD.B. P-70

CALCULATIONS


(120 x 25) + (10 x 4) = 30 S.F.
[(76 ÷ 2) (45 + 55) ÷ 2] x 1.04 ÷ 9 = 220.0 S.Y.
[(84 ÷ 2) (50 + 54) ÷ 2] x 1.04 ÷ 9 = 252.4 S.Y.

NOTES:

1. For Ramp "D" Plan, See Sheet No. 90-91
2. For Ramp "D" Profile, See Sheet No. 98
3. For Ramp "G" Plan, See Sheet No. 94
4. For Ramp "G" Profile, See Sheet No. 101
5. For Ramp "G" & I.R. 270 Turnout Details, See Sheet No. 151
6. For Agler Road Plan & Profile, See Sheet No. 234, 235 & 2
7. For Storm Sewer Profile, See Sheet No. 251-252
8. For Interchange Geometrics See Sheet 82, 83 & 84

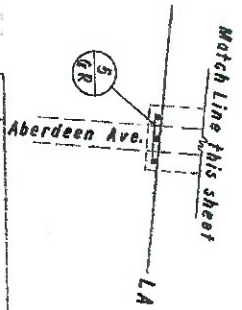

REF. STATION TO STATION	SIDE	603		604		605										
		Type B	Type C	Type A	Type B	Type C	Type A									
1-0 1430+00 to 1430+60																
2-0 1430+60	Rt.	102														
3-0 P-1430+60 to P-1438+04	Lt.	744														
4-0 1438+00	Rt.	164														
5-0 1438+00	Lt.	30														
6-0 P-1438+04 to P-1500+00	Lt.		196													
1-6R 1431+00 to 1434+06																
2-6R 1430+84 to 1433+03	Rt.															
3-6R 1432+56 to 1434+06	Lt.															
4-6R 1435+39 to 1435+64	Rt.															
5-6R 1438+88 to 5-1438+93	Rt.															
RURAL TOTAL		164	192	744	60	196	1	1	2	1	50	925	50	2	6	2

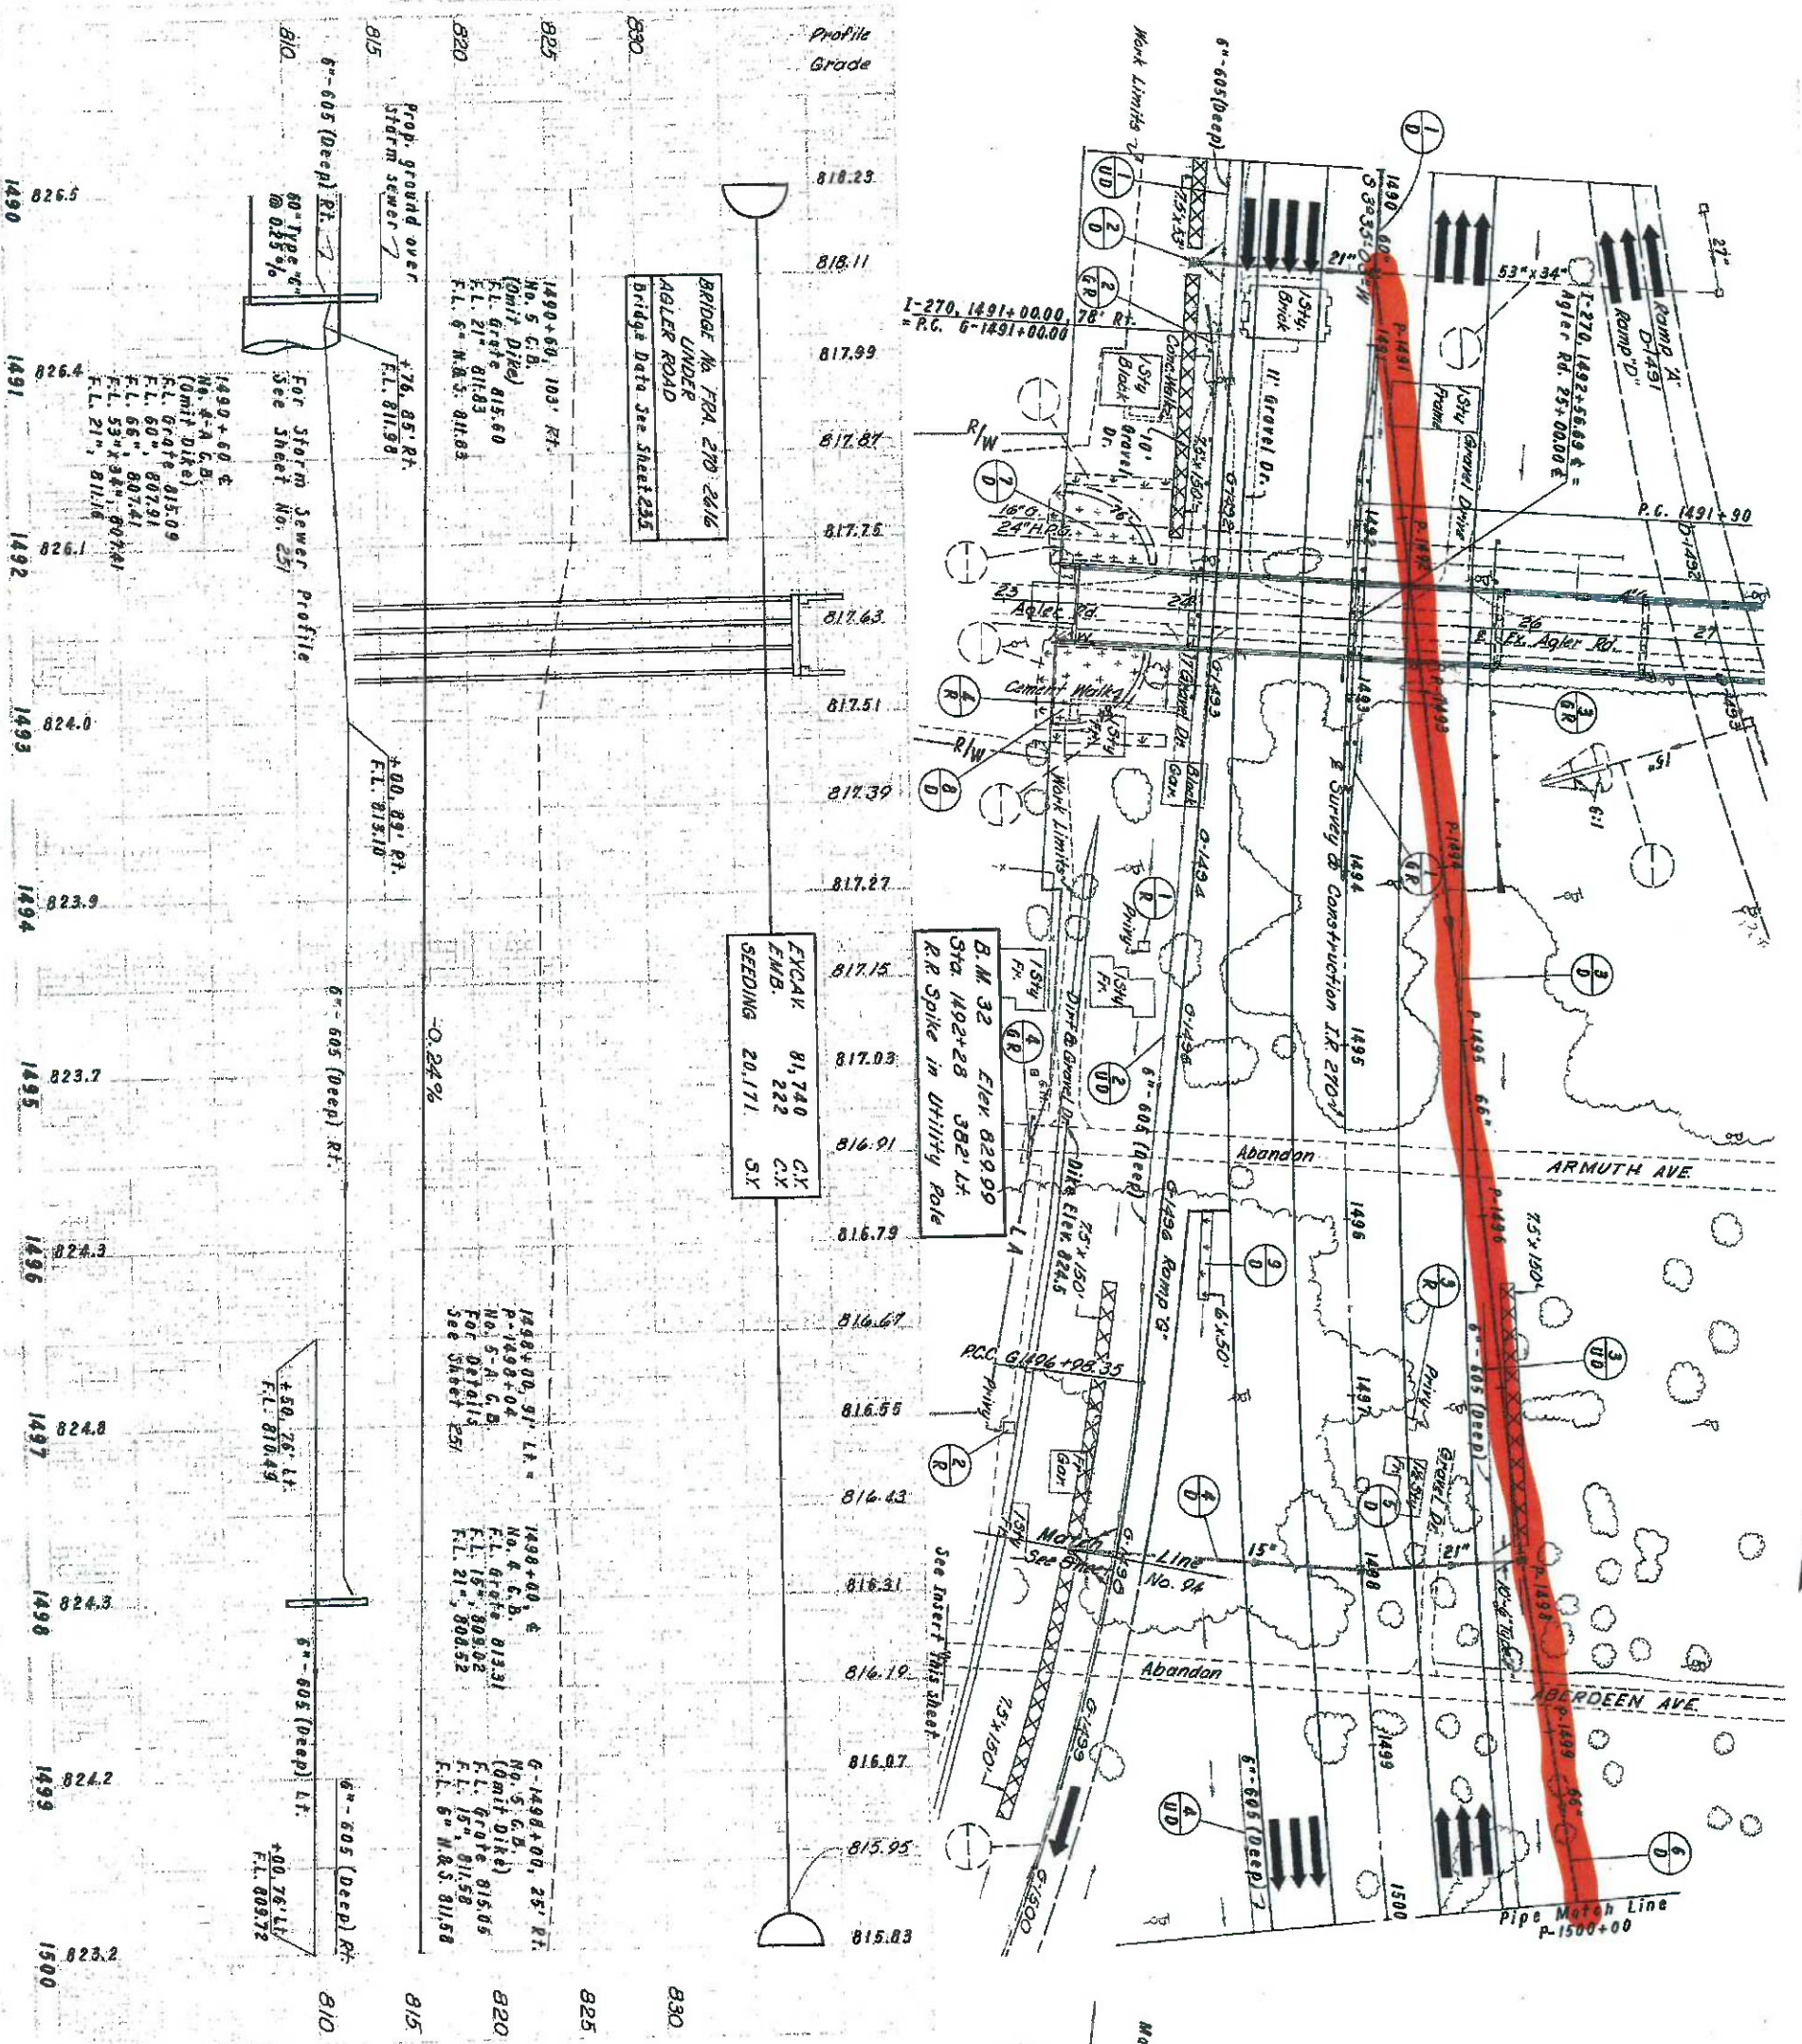

REF.	STATION TO STATION	SIDE	202	603	605	660	830	Special	Bends & Branches	Und
			Ex. Walk Remov. & Type "F"	6"	6"	Sodding	Excising Mowing	Cloving Privy Vaults	6"	Den
			Disp. of S.F.	L.F.	L.F.	S.Y.	S.Y.	Eg.		
T-R	1494+48	Rt.						1		
2-R	1497+5	Rt.						1		
3-R	1497+5	Lt.						1		
4-R	1493+15	Rt.	90							
7-0	1491+90 to 1492+35	Rt.					250			
8-0	1492+02 to 1493+32	Rt.				34	253			
9-0	1495+92 to 1496+42	Rt.		10	68				1	
F-0	1498+00 to 1499+56	Rt.		20	757				2	
5-0	1499+64 to 6-1497+93	Rt.		10	940					
6-0	1499+90 to 1500+00	Lt.			100					
2-0	1499+00 to 1500+00	Rt.	90	40	1205	34	473	3		
	RURAL TOTAL									

1490+00 TO 1500+00

1490+00 TO 1500+00

345 1-70
2402.2-70


NOTES:

1. For Storm Sewer Profile See Sheet No. 251-232
2. For US.R. 62 S.B. Plan & Profile, See Sheet No. 176-177
3. For Ramp "H" Plan, See Sheet No. 94
4. For Ramp "H" Profile, See Sheet No. 102
5. For Ramp "H" & I.R.-270 Pavement Details, See Sheet No. 192
6. For Interchange Geometrics, See Sheet No. 82, 83 & 84

* 70602 Class III or 70713

REF	STATION TO STATION	SIDE	66'	603	604	667	Bends & Branches
		Type	Type	Type	Type	Type	For Details See Sheet
1-0	P-1500+00 to P-1501+78	L.F.	178				
2-0	P-1501+78 to P-1505+78	L.F.	400				
3-0	P-1505+78 to P-1506+22	L.F.		128			
4-0	P-1506+22 to P-1508+22	R.T.				225	
5-0	P-1508+22 to P-1509+20	L.F.					74
6-0	P-1509+20 to P-1509+83	L.F.	193				
RURAL TOTALS			933	116 128	1	1	225


REF	STATION TO STATION	SIDE	603	605	606	Bends & Branches
		Type	Type	Type	Type	Under Drain Detail
1-0	P-1500+00 to P-1501+80	L.F.	10	207		
2-0	P-1501+80 to P-1505+00	L.F.	10	806		
3-0	P-1505+00 to P-1505+50	R.T.	10	555		
4-0	P-1505+50 to P-1510+00	R.T.		260		
5-0	P-1510+00 to P-1510+01.5	L.F.			50 3250	
6-0	P-1510+01.5 to P-1510+74	R.T.			1073 1	
7-0	P-1510+74 to P-1510+83	R.T.			823 1	
RURAL TOTALS			30	1026 50 1754	2 2	2

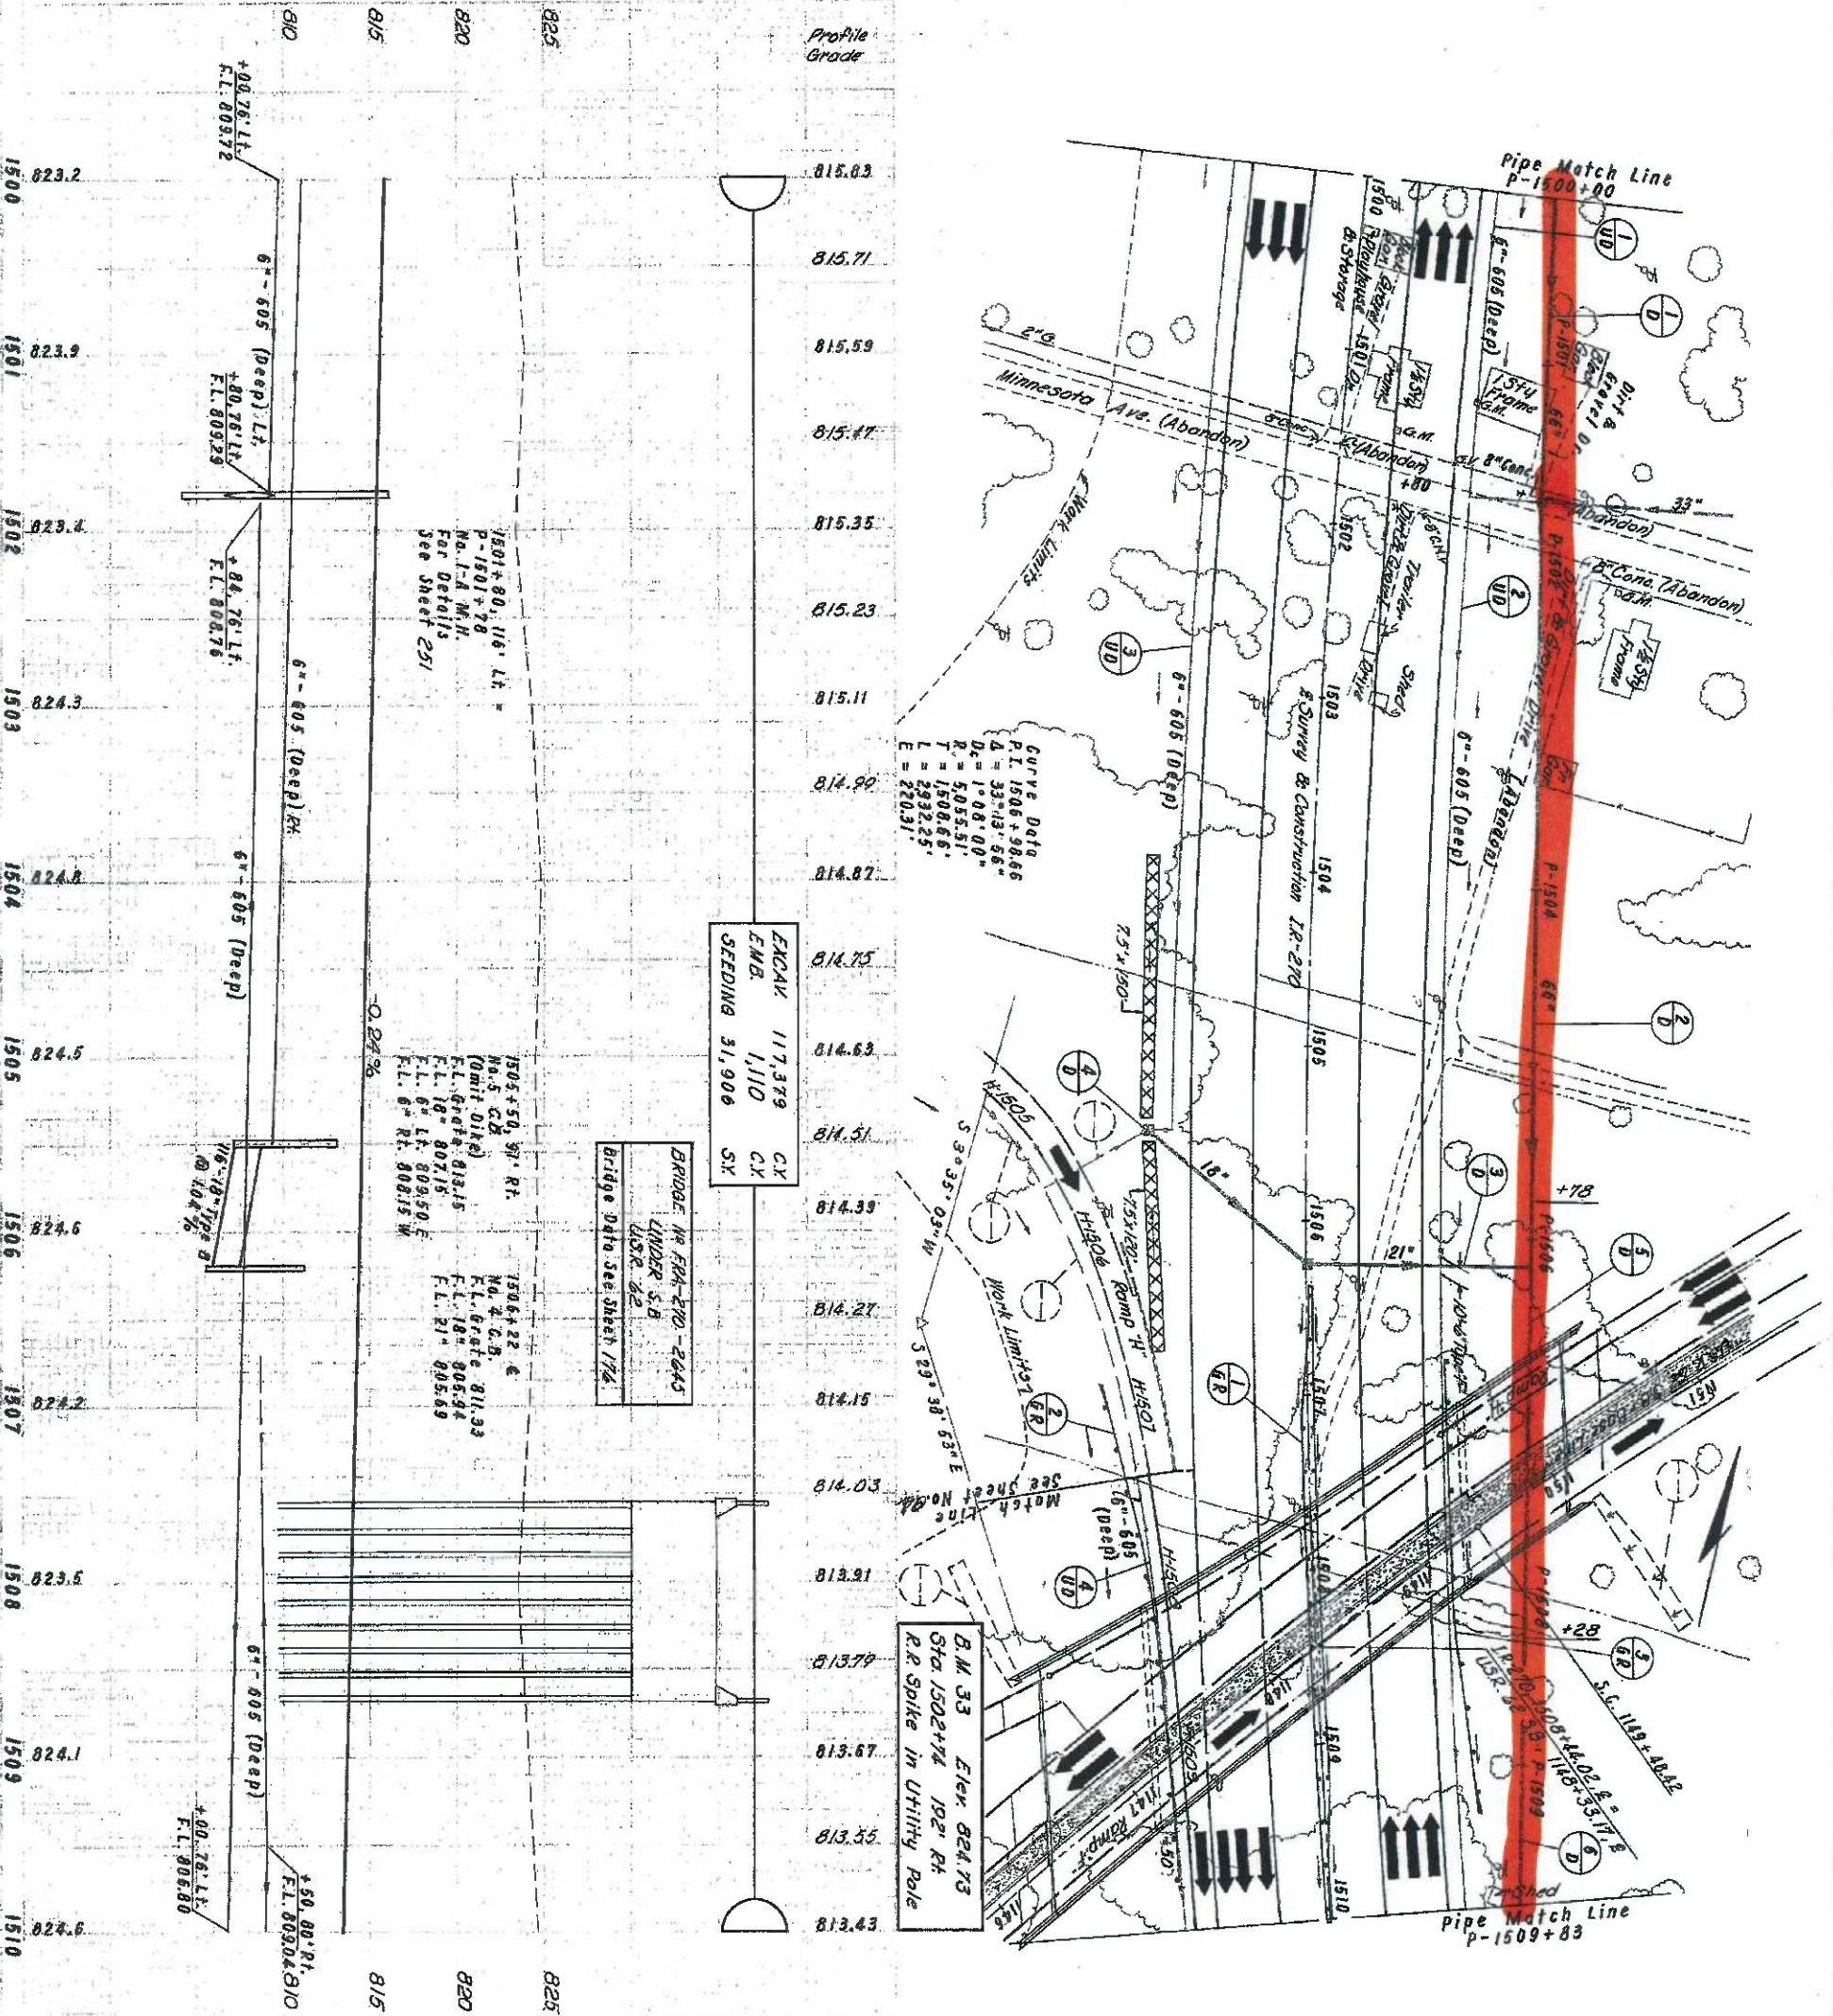

CD 54.5
CN 40.0
L-70
2-70

NOTES:


1. For USR-62 N.B. Plan & Profile, See Sheet No. 214
2. For Ramp "F" Plan, See Sheet No. 93
3. For Ramp "F" Profile, See Sheet No. 100
4. For Ramp "F" & I.R. 270 Pavement Details, See Sheet No. 153
5. For Ramp "I" Plan, See Sheet No. 89 & 93
6. For Ramp "I" Profile, See Sheet No. 103
7. ** Jute Matting carried to next sheet
8. For Interchange Geometrics, See Sheet No. 82, 83 & 84

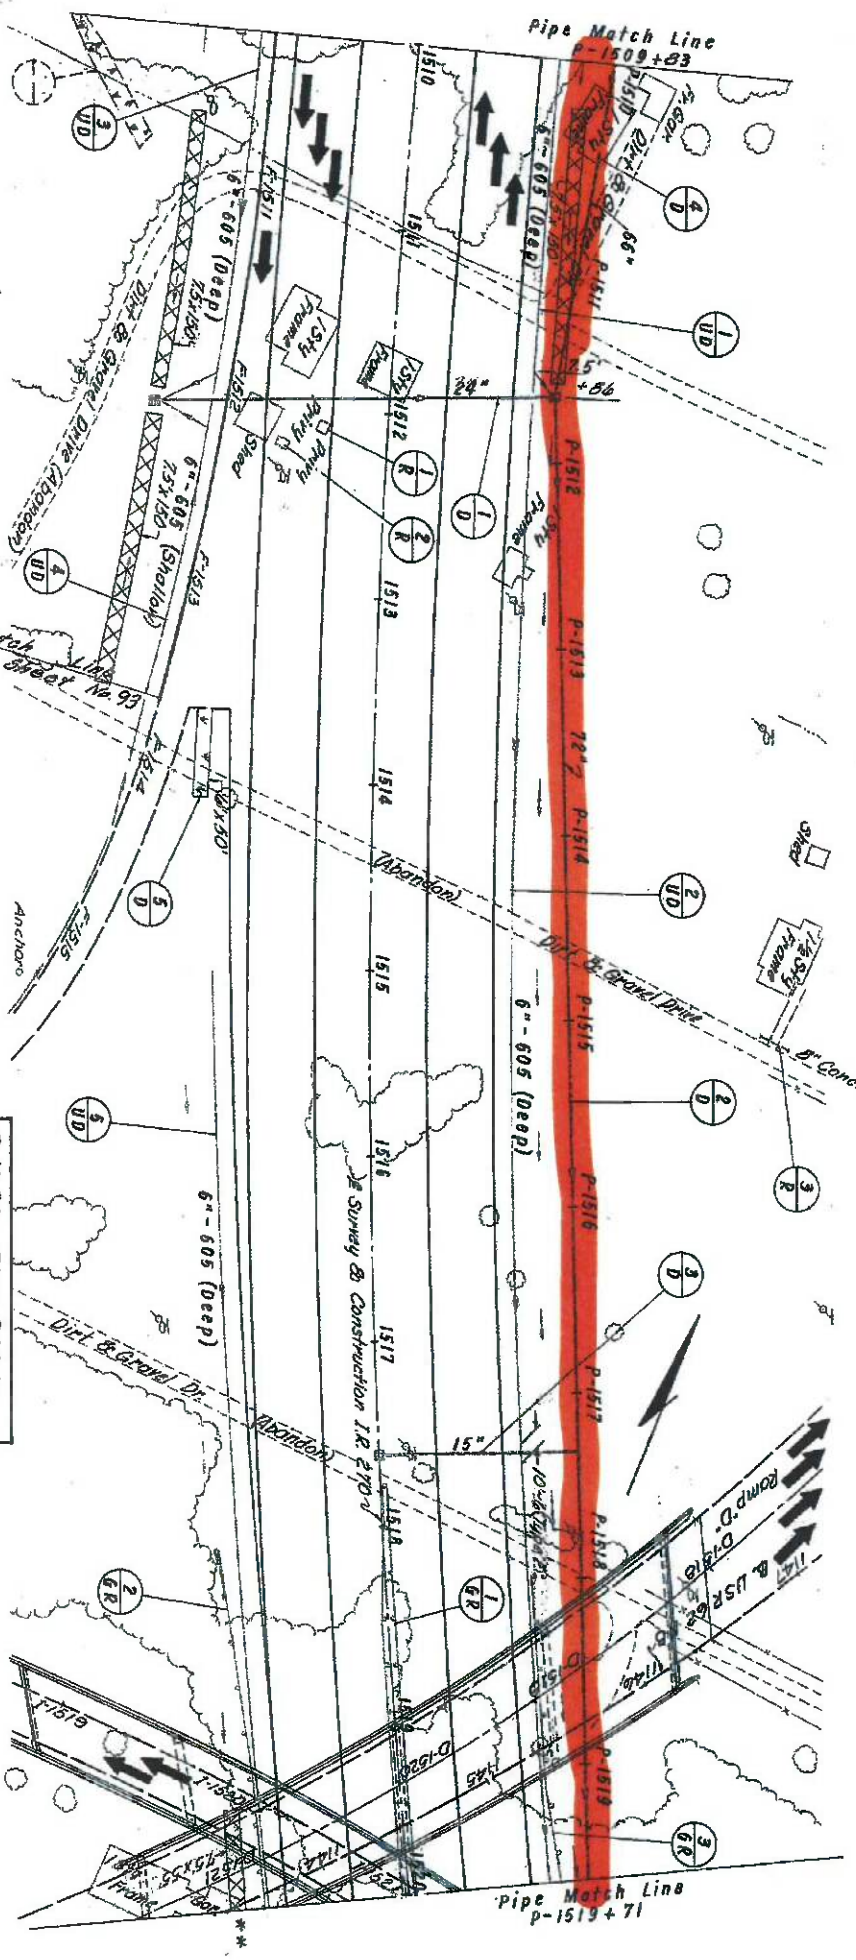

B.M. 34 Elev. 826.12
Sta. 1510+03 374' L.H.
R.R. Spike in Utility Pole

EXCAV. 118,087 C.Y.
EMB. 39 C.Y.
SEEDING 28,068 S.Y.

BRIDGE NO. 104-62-2160
UNDER USR-62 N.B. &
RAMP "I"

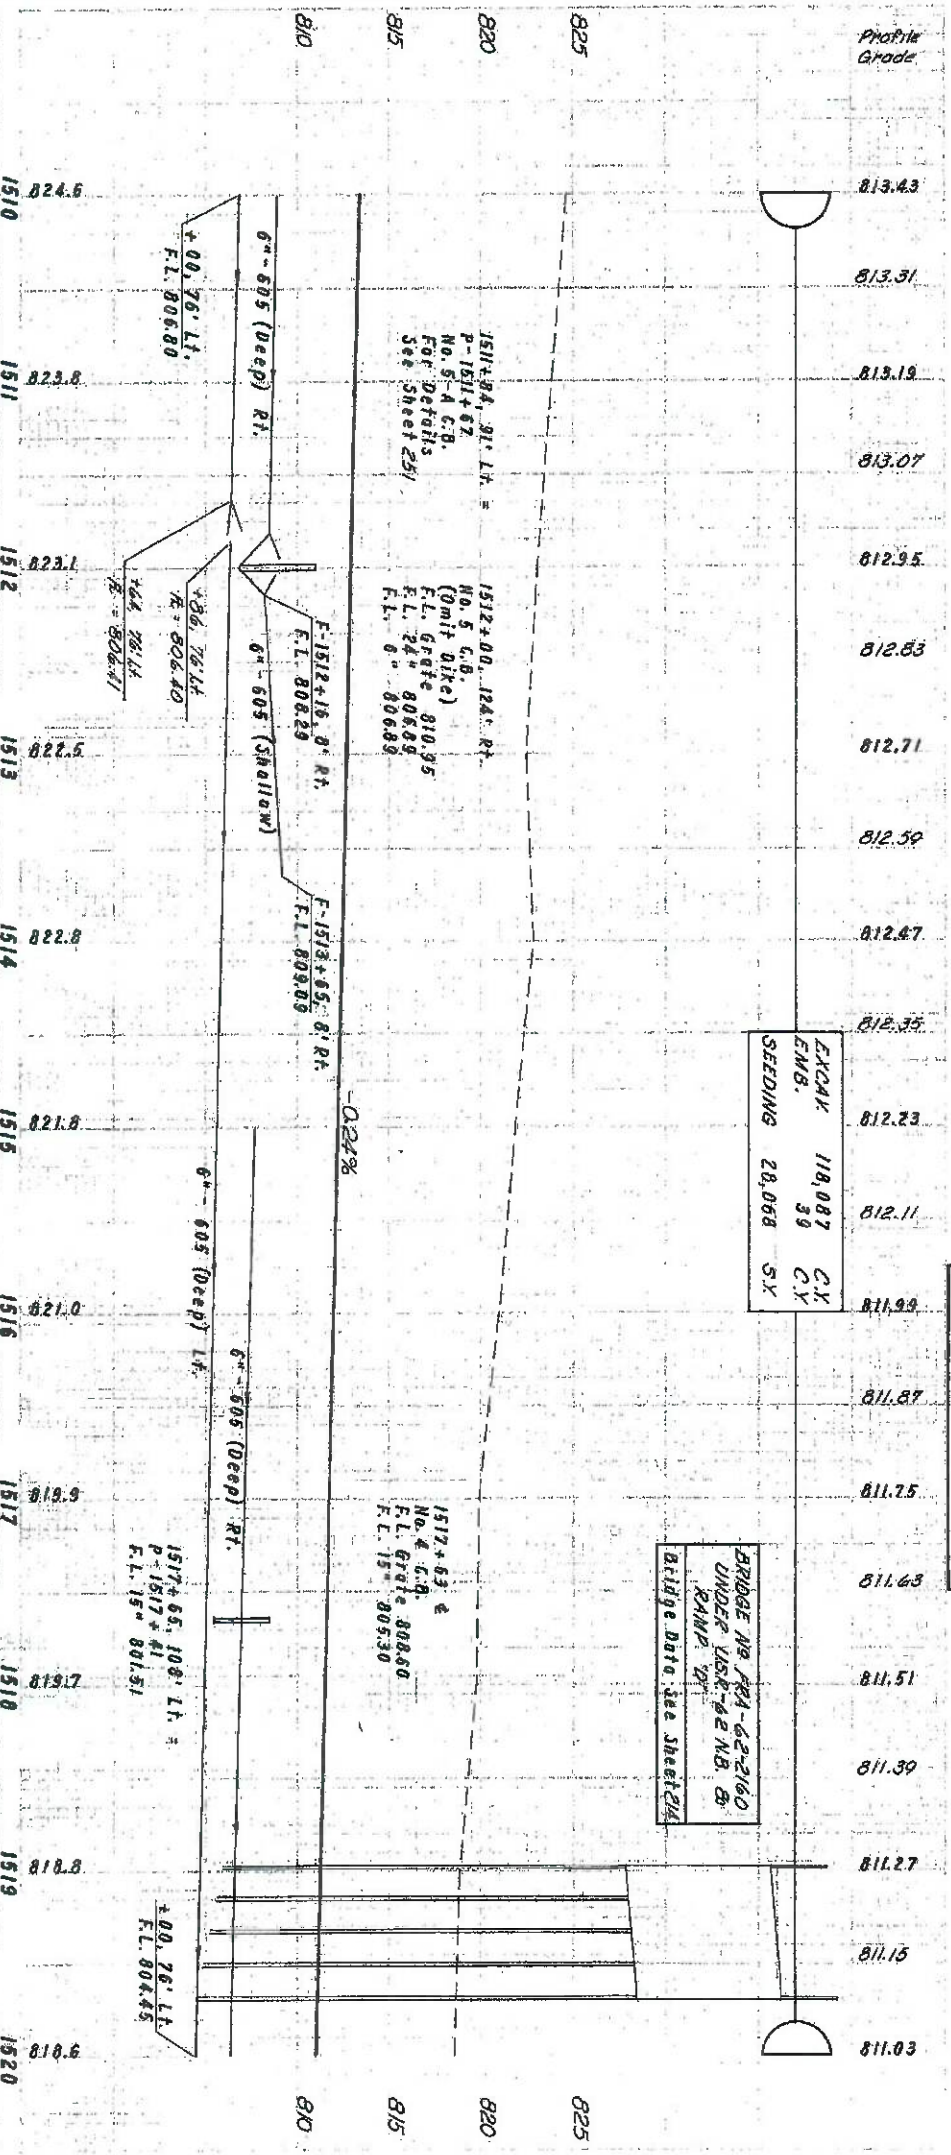

REF. STATION TO STATION		SIDE		* 706.02 CL III or 707.13		603		604		606		607		Bends & Branches		For Details See Sheet	
						15° 24' 68" 72"		No. 4		No. 5		No. 6		No. 7		No. 8	

FRANKLIN COUNTY
FRA-270-25.30N
FRA-02-20.83

CH
SAS
44.0 ft. 2-70

LEGEND

Existing Concrete Walk removed under Item 203 Excavation

NOTES:

1. For Ramp "I" Plan, See Sheet No. 80 & 83
 2. For Ramp "I" Profile, See Sheet No. 103 & 104
 3. For USR 62 N.B. Plan & Profile, See Sheet No. 214
 4. For Storm Sewer Profile, See Sheet No. 251 & 252
 5. Typical Section on adjacent Project will be similar to FRA-270-25.30N
 6. For Interchange Geometrics, See Sheet No. 82, 83 & 84
- * Jute Matting carried from previous sheet.
* Guard Rail carried on previous sheet.

CURVE DATA
P.T. 1524+51.89
D=5000'-07" 25"
Dc=2000'-00"
R=2664.79'
T=1339.66'
L=2506.19'
E=297.75'

B.M. 36 Elev 818.01.
Sta. 1524+67 241' L.H.
R.R. Spike in Utility Pole

B.M. 35 Elev 822.16
Sta. 1520+85 276' L.H.
R.R. Spike in Utility Pole

BRIDGE No. FRA-270-26.67
UNDER
RAMP "I"
Bridge Data see sheet 80

EXCAV. 28,592 C.Y.
EMB. 33 C.Y.
SEEDING 7,095 S.Y.

1524+00, 99' L.H. =
P-1523+55.
End Pipe
For Details
See Sheet 252

1521+00, 91' L.H. =
P-1520+72
No. 5-A.C.B.
For Details
See Sheet 252

6"-605 (Deep) R.T.
F.L. 805.37

6"-605 (Deep) R.T.
F.L. 805.87

6"-605 (Deep) R.T.
F.L. 805.17


6"-605 (Deep) L.H.
F.L. 803.83

6"-605 (Deep) L.H.
F.L. 803.83

REF	STATION TO STATION	SIDE	603	604	605	606	607
1-D	P-1519+71 to P-1520+72	L.T.	L.F.	L.F.	L.F.	L.F.	L.F.
2-D	P-1520+72 to P-1524+00	L.T.	L.F.	L.F.	L.F.	L.F.	L.F.
3-D	1521+00	L.R.	184	428	1	1	300
RURAL TOTALS			184	428	1	1	300

REF	STATION TO STATION	SIDE	603	605	606	607
1-D	1520+00 to 1520+96	L.T.	L.F.	L.F.	L.F.	L.F.
2-D	1521+00 to 1524+00	L.T.	L.F.	L.F.	L.F.	L.F.
3-D	1521+00 to 1524+00	R.T.	10	107	1	1
4-D	1521+00 to 1524+00	R.T.	10	307	1	1
RURAL TOTALS			30	817		

PROPOSED STRUCTURE	
FRA-270-2685N	
TYPE: 3 span continuous reinforced concrete slab with reinforced concrete substructure	
SPANS: 43.0', 51.75', 43.0'	
LOADING: HS20-44	
SKEW: 18°13'37" L.R.	
WEARING SURFACE: 1" Monolithic	
APPROACH SLAB: 45'-1'-67" (23' long)	
ALIGNMENT: Left spiral	
SUPERELEVATION: None	
PROPOSED STRUCTURE	
FRA-270-2680N	
TYPE: 4 span continuous steel girder with reinforced concrete deck and substructure	
SPANS: 115.00', 115.00', 84.25', 54.75'	
LOADING: HS 20-44	
ROADWAY: 44'-0" to parapets	
SKEW: 13°57'46" R.F.	
WEARING SURFACE: 1" Monolithic	
APPROACH SLAB: 80'-4'-7' (25' long)	
ALIGNMENT: Tangent	
SUPERELEVATION: None	

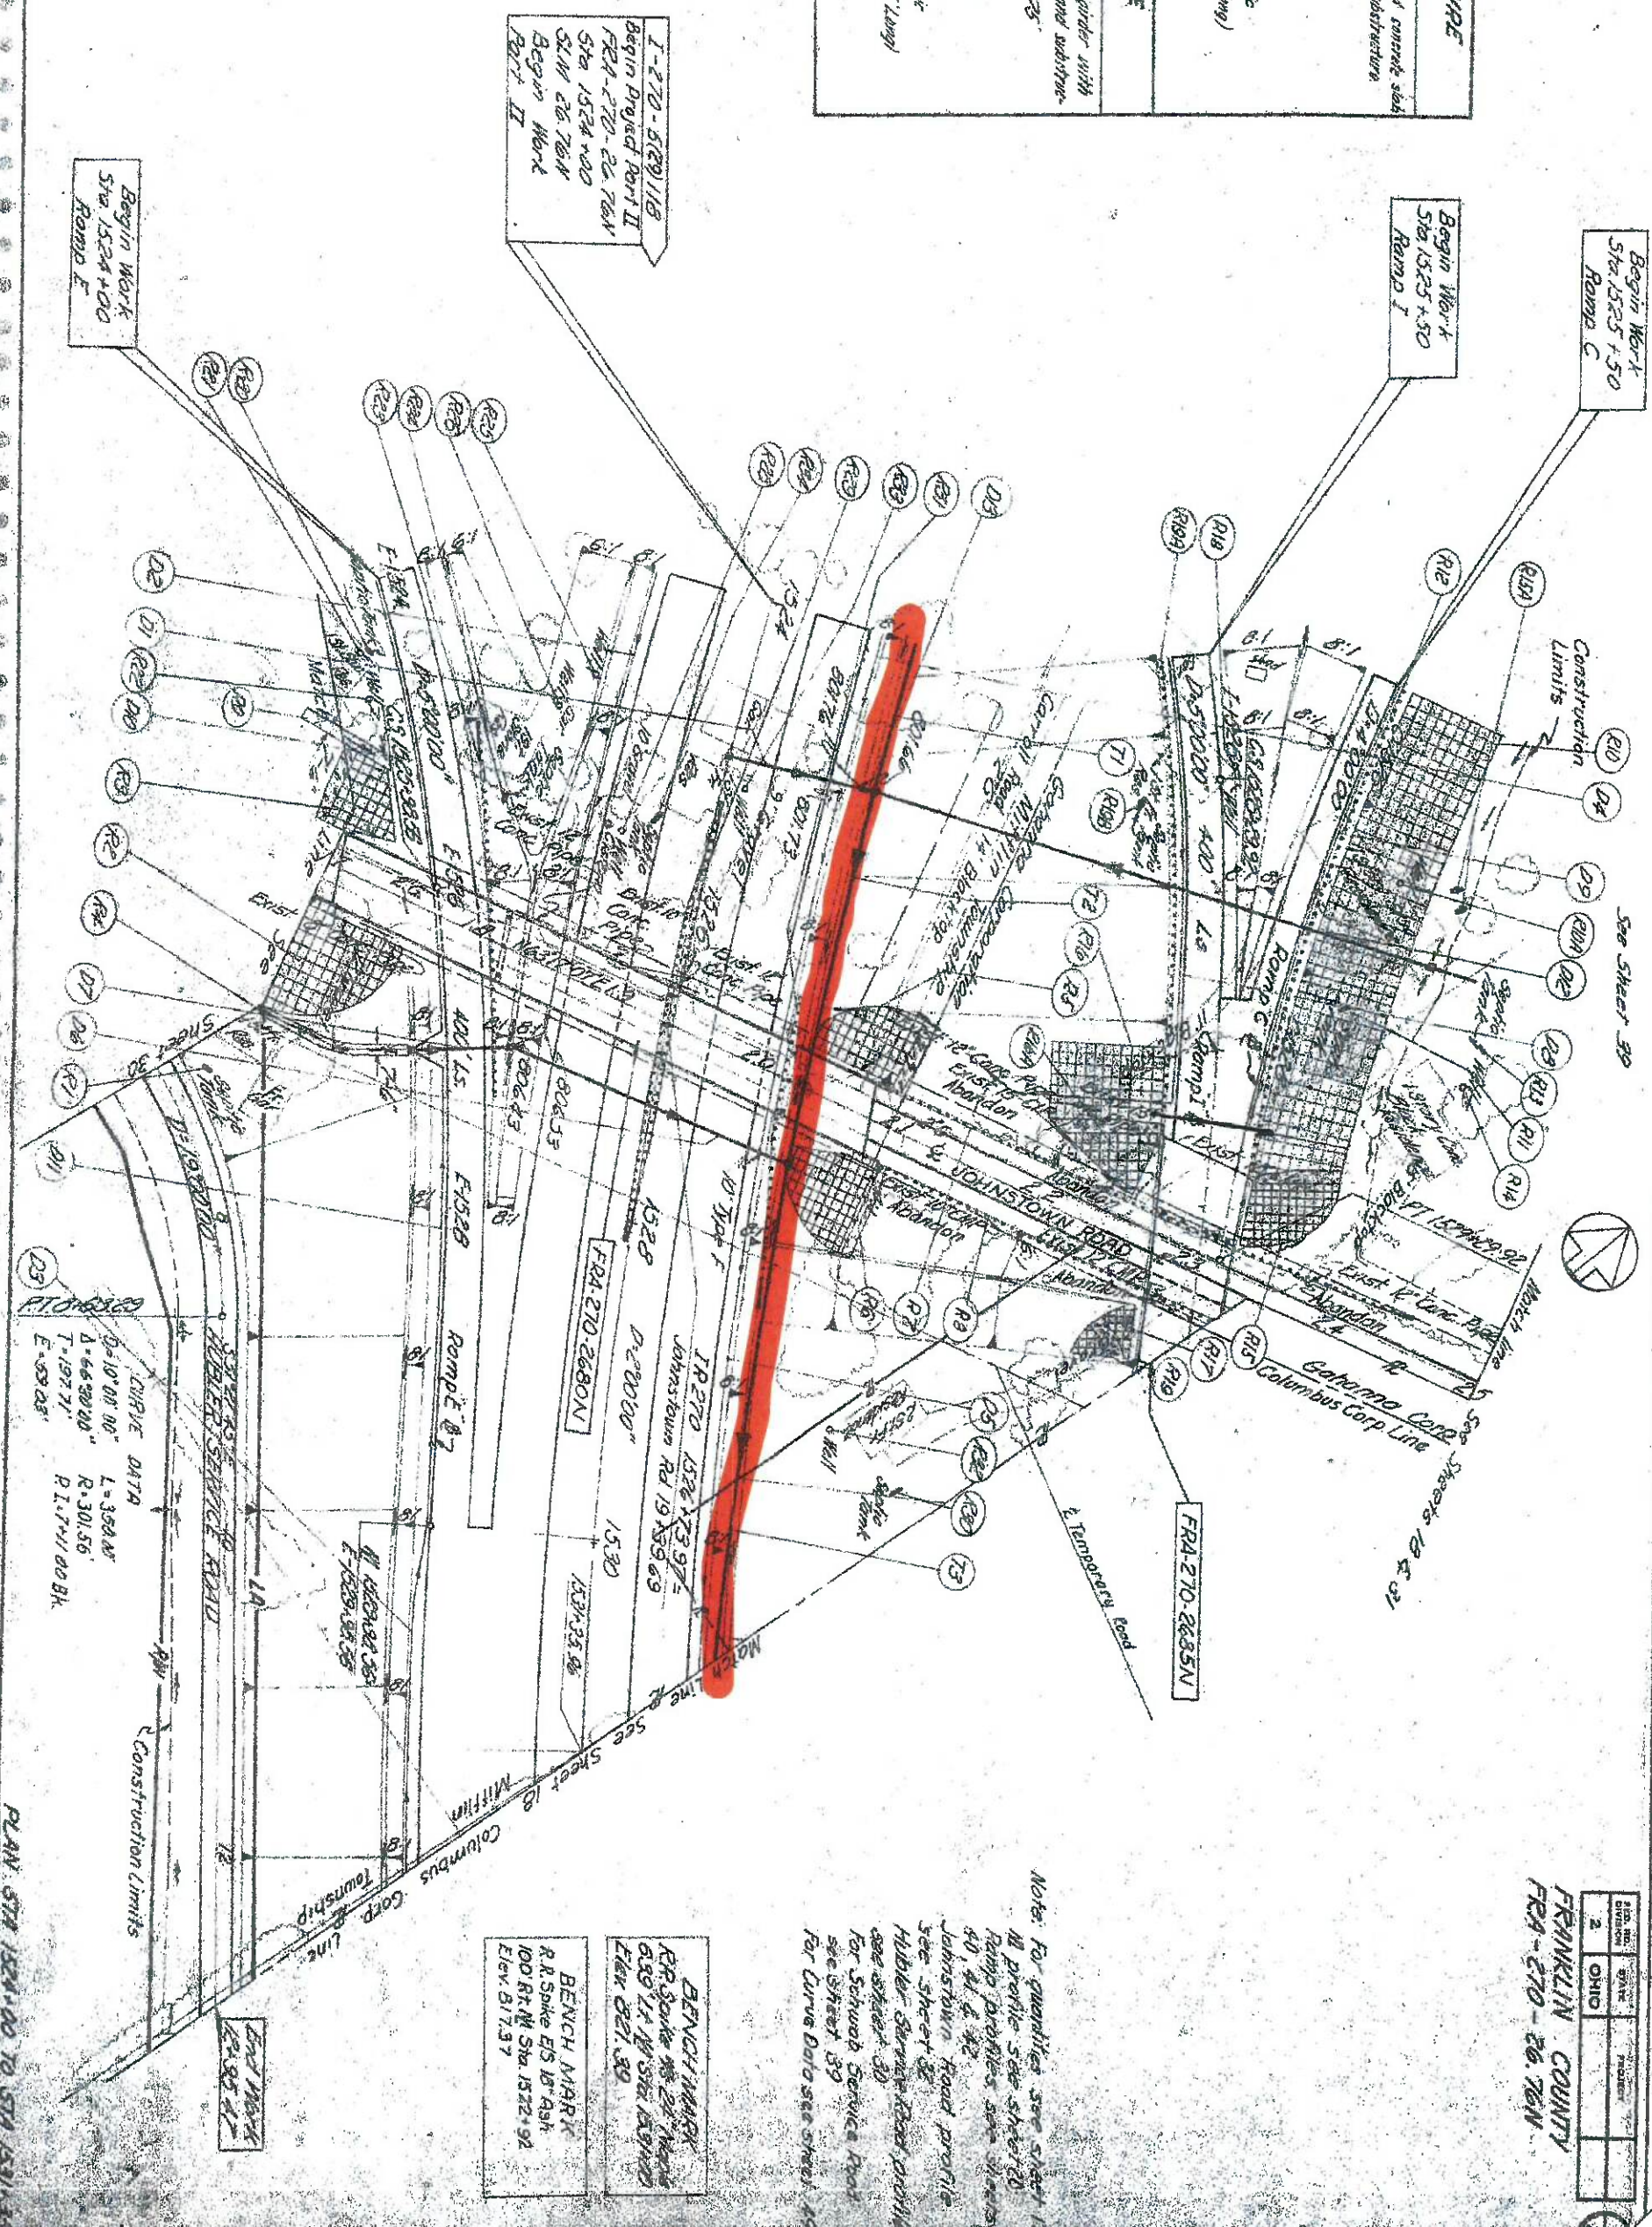

FRANKLIN COUNTY
FRA-270-26.76N


NO.	DATE	BY	PROJECT
2	OHIO		

Note: For quantities see sheet 15.
In profile see sheet 16.
Ramp profiles see sheets 40, 41 & 42.
Johnstown Road profile see sheet 33.
Huber Service Road profile see sheet 39.
For Schuch Service Road see sheet 39.
For Curve Data see sheet 40.

BENCH MARK	
R.R. Spike #8 23' High	
6.89' 14' W. Side (ASPH)	
Elev 621.30	
BENCH MARK	
R.R. Spike EIS 10' Ash	
100 Rt N Sta 1522+92	
Elev 617.57	

PLAN STA 1524+00 TO STA 1524+50


FIG. NO.	STATE	PROJECT	SHEET
2	OHIO		247

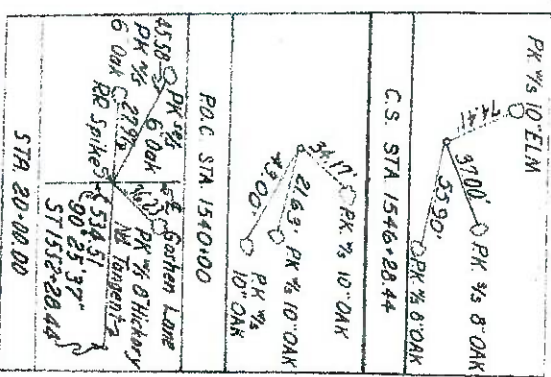


Note: For Curve Data see sheet 49
For quantities see sheet 22
Ramp Profile see sheet 42

PROPOSED STRUCTURE

TYPE: 3 span continuous steel girder with reinforced concrete deck and substructure
SPANS: 75.00', 07.00', 109.00'
LOADING: HS 20-44
ROADWAY: 44'-0" Parapets
SKEW: 4°20'35" L.F.
WEARING SURFACE: 1" Marshallite
APPROACH SLABS: AS-1-G750 10' long
ALIGNMENT: Tangent
SUPERELEVATION: None

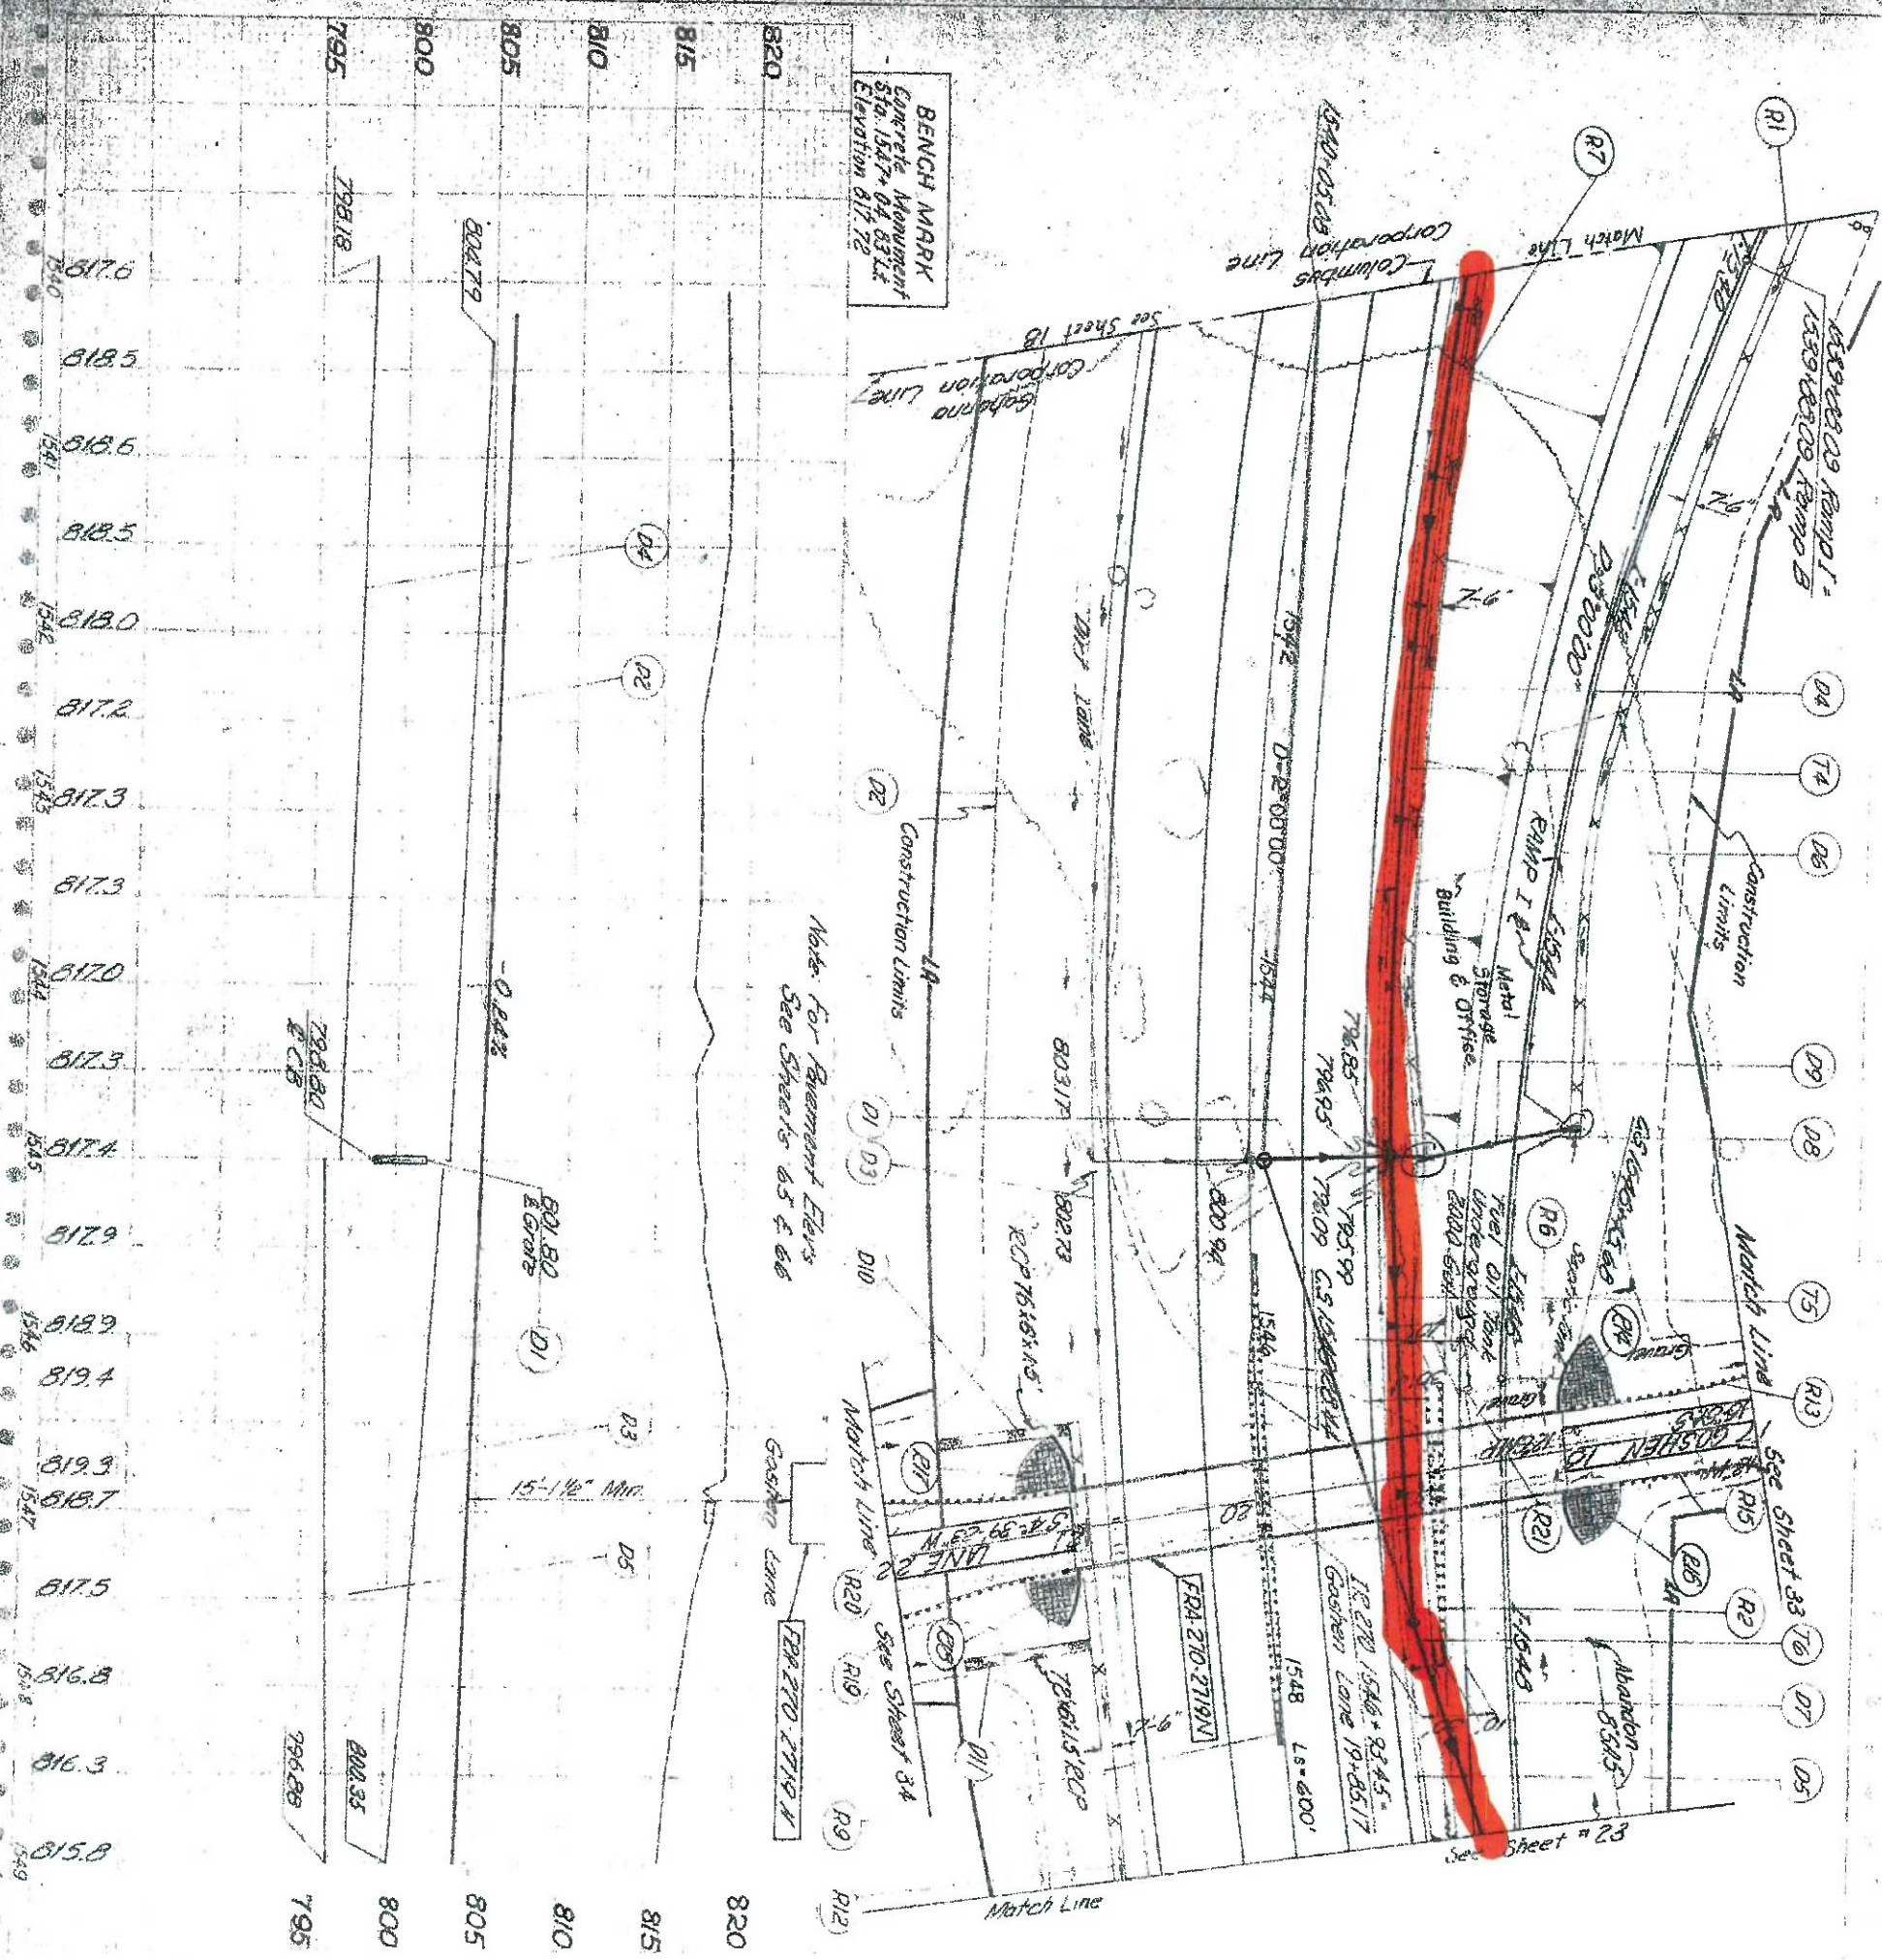

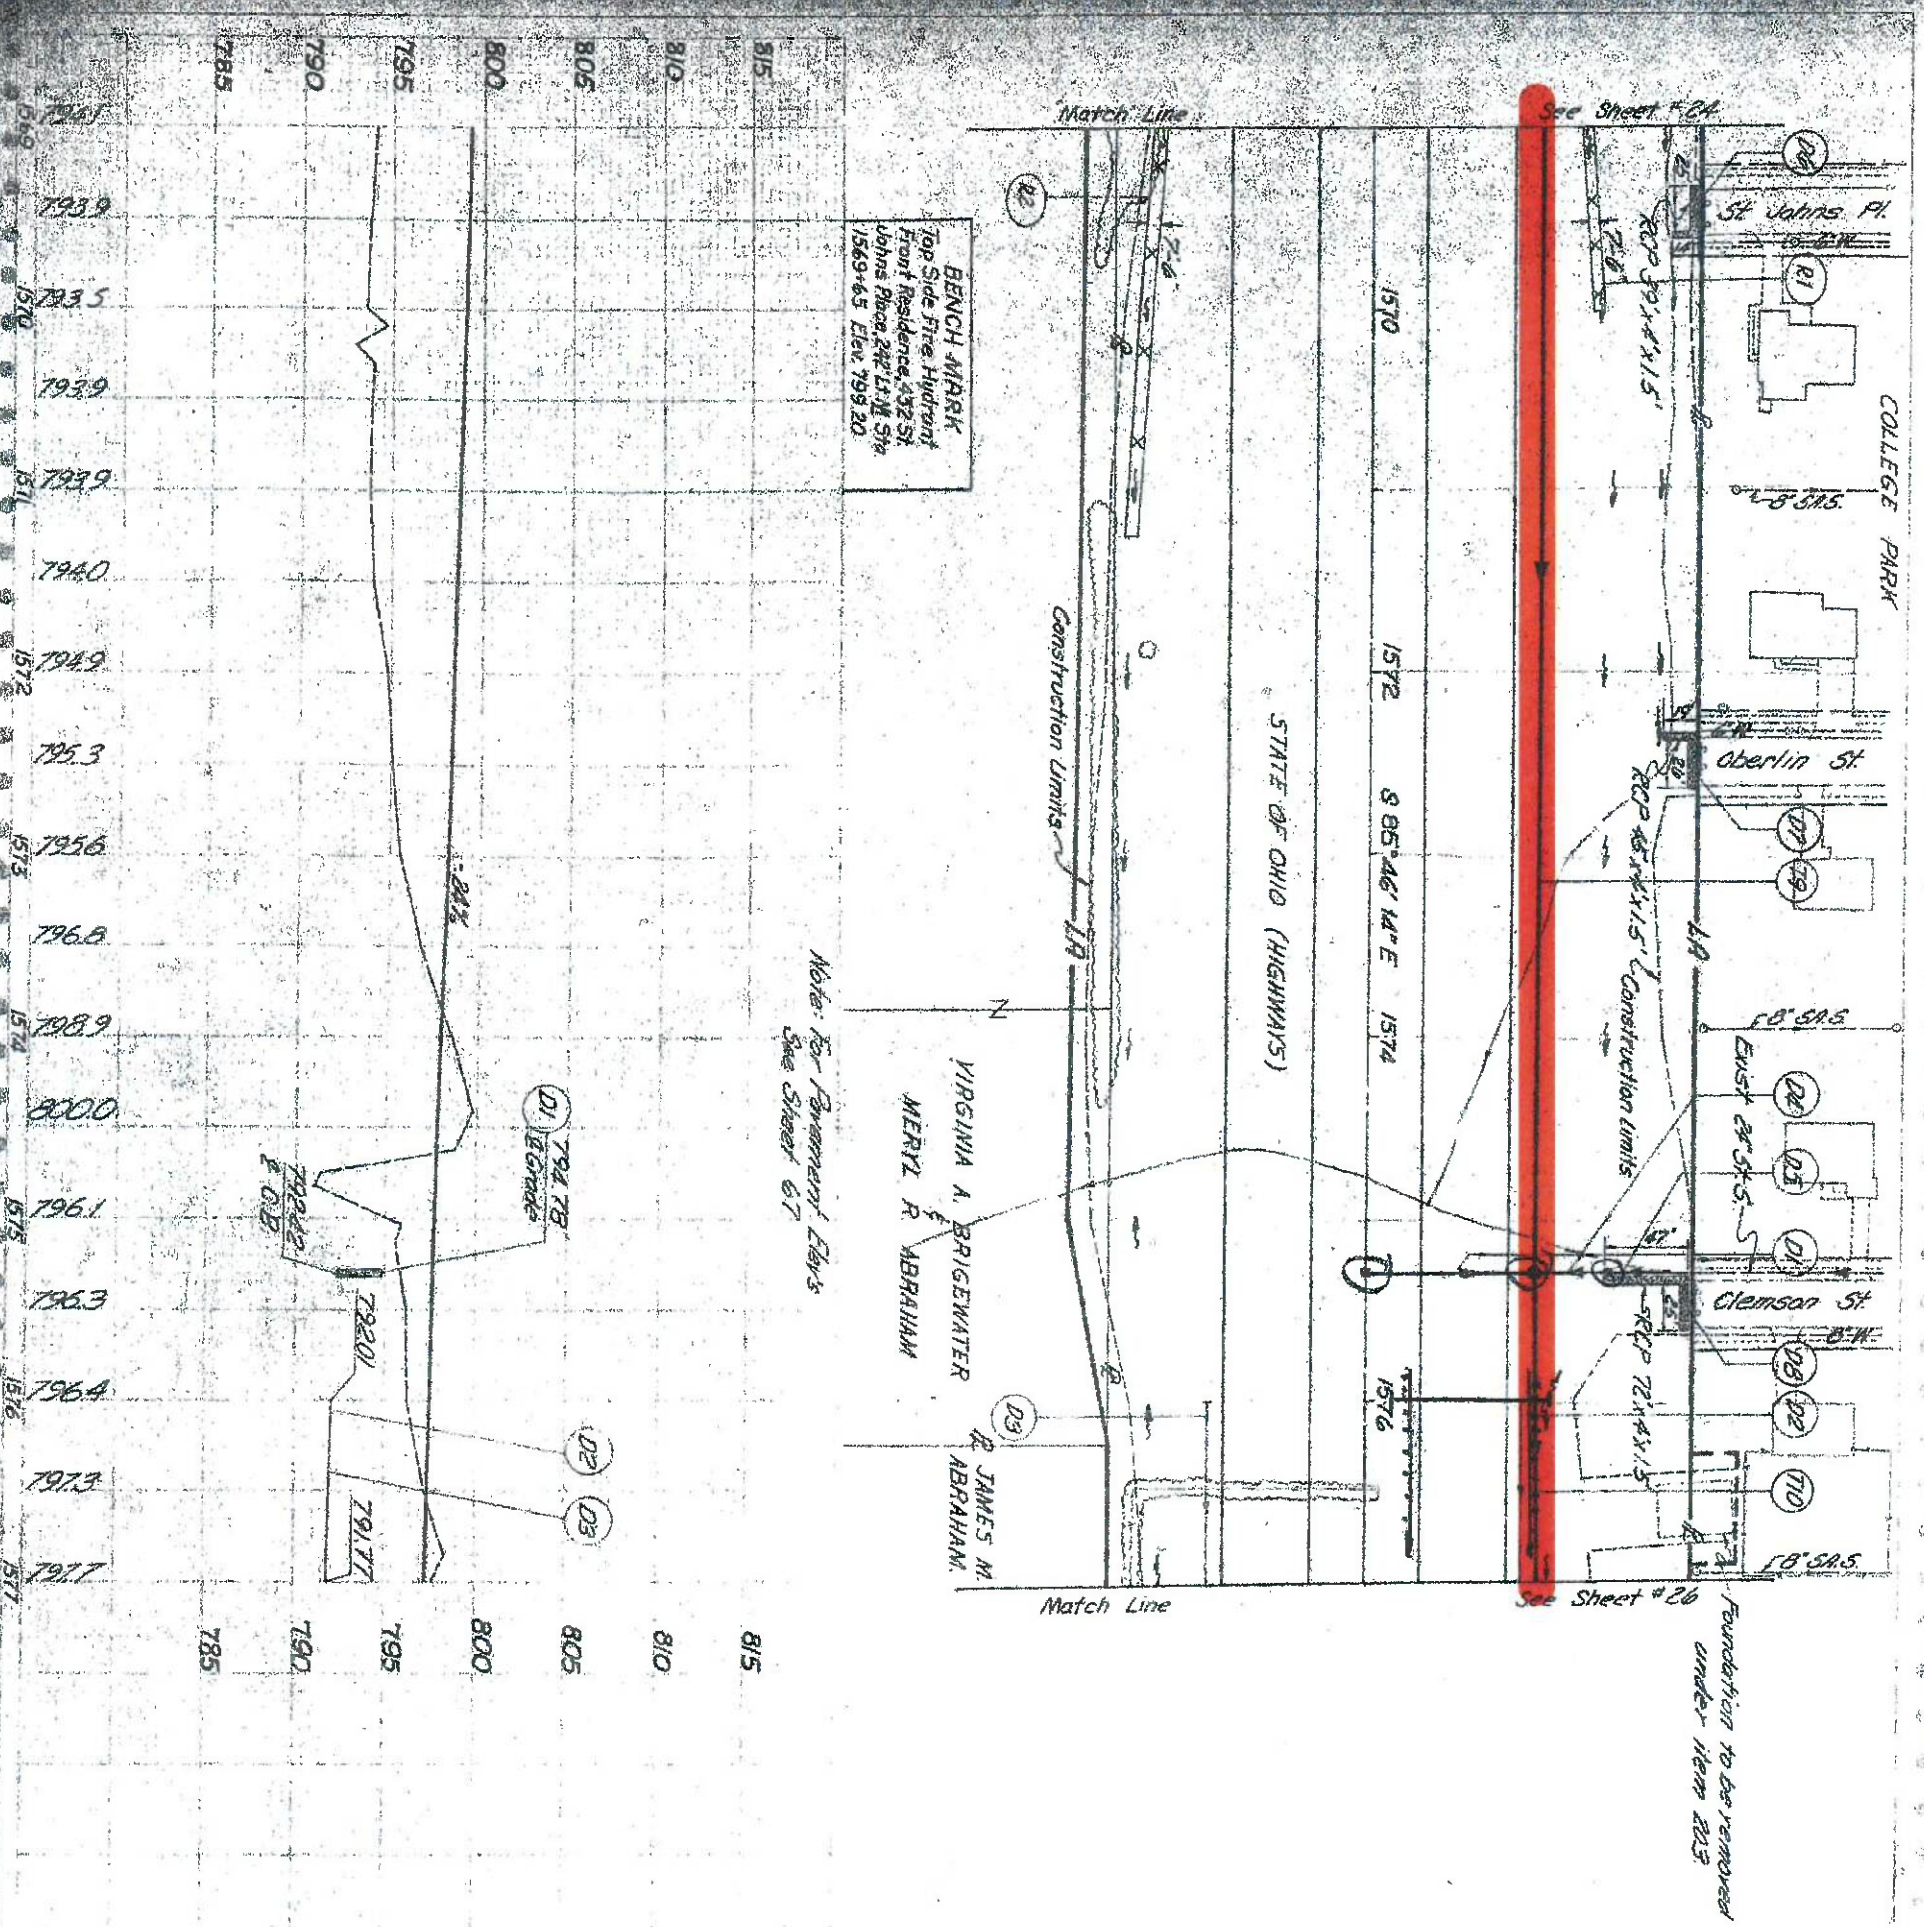

FRANKLIN COUNTY
FRA-270-26.76N



PR 76.6 WILD CHERRY
POT STA 1570+82.70

2 OHIO

24

ROADWAY		667
CODE	LOCATION	SY
R1	1569+00 to 1570+00	82
R2	1570+00 to 1571+00	188
TOTALS		270

DRAINAGE										603	604	605	606
CODE	LOCATION	See Sheet No.	15" Conduit Type B	24" Conduit Type C	24" Conduit Type C	Std. No. 5A Catch Basin	Std. No. 4 Catch Basin	Std. No. 1A Manhole	6" Pipe - Deep Underdrain	Rock Char. Prot. Type B as per plan			

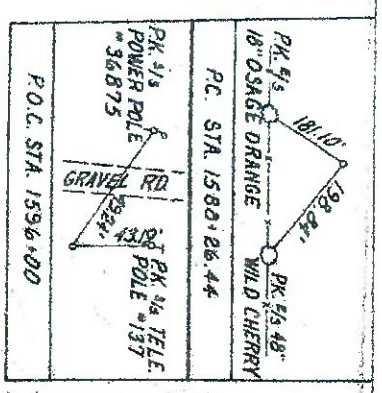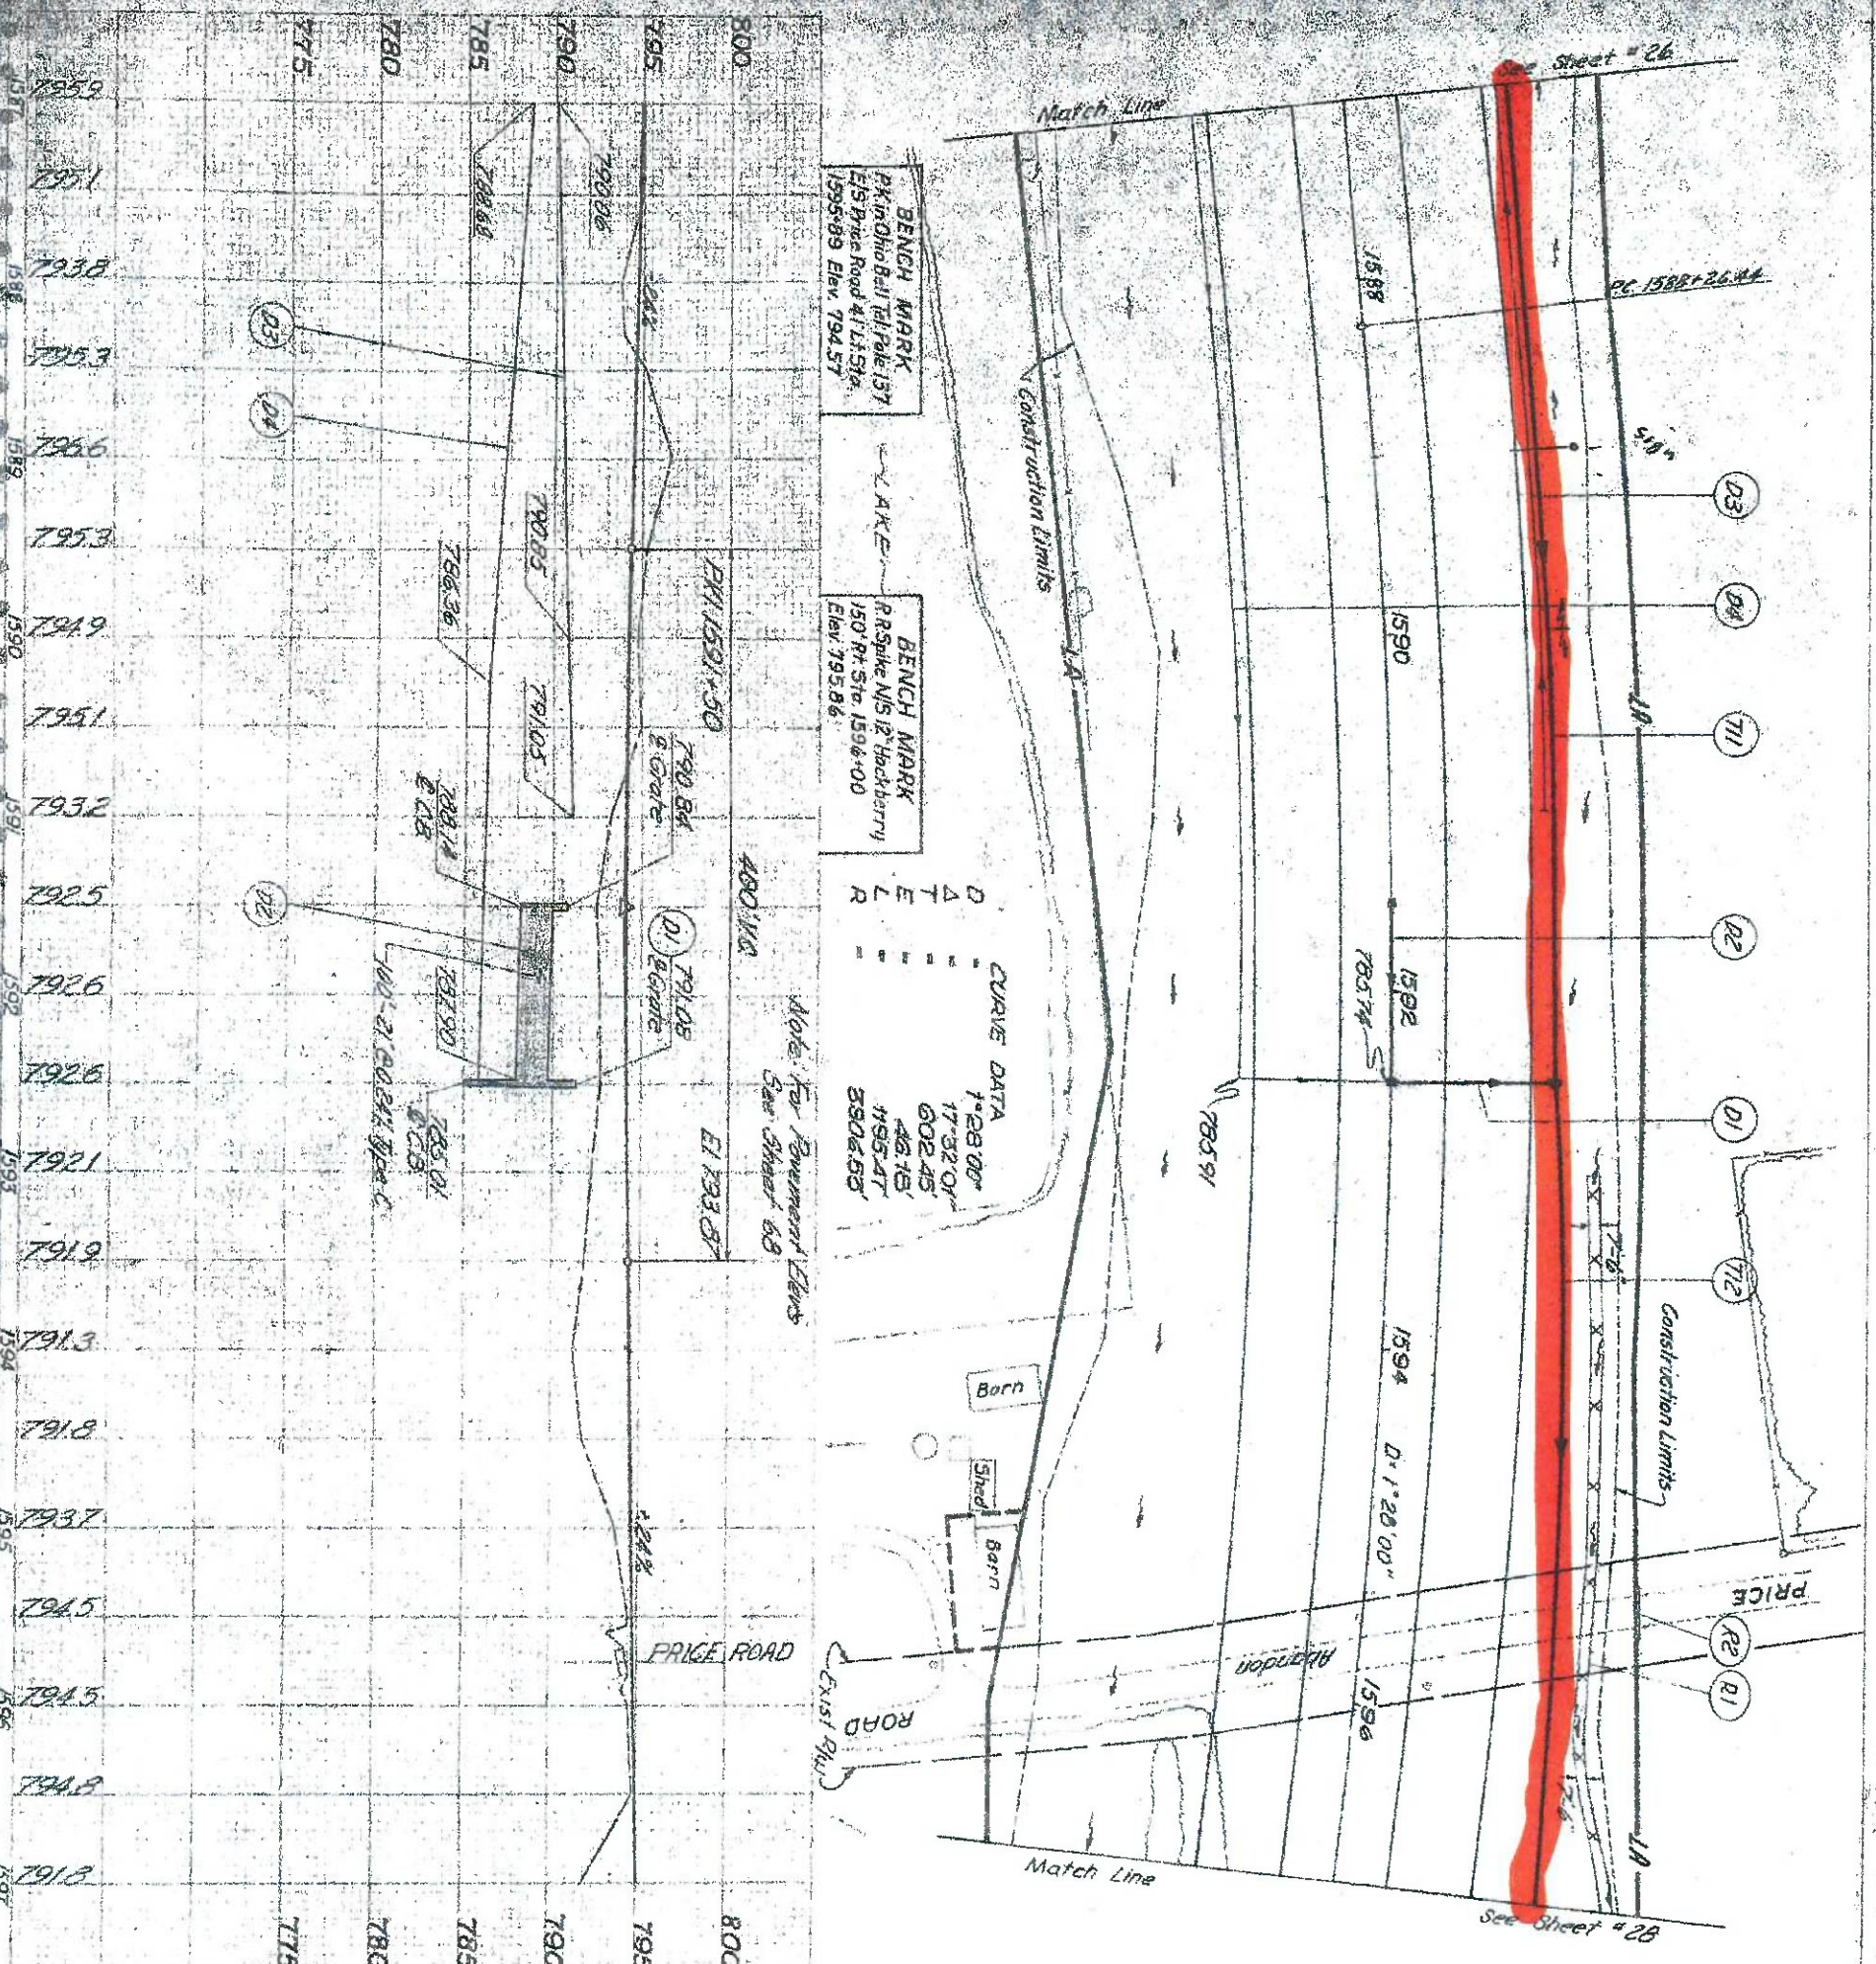

FRANKLIN COUNTY		FRA-270-26.76N	




