


PROJECT DATA			
TOTAL AREA RIGHT OF WAY	TBD BY DESIGN BUILD TEAM	RUNOFF COEFFICIENT FOR PRE-CONSTRUCTION SITE	0.5-0.9
PROJECT EARTH DISTURBED AREA	2.24 ACRES	RUNOFF COEFFICIENT FOR POST CONSTRUCTION SITE	TBD BY DESIGN BUILD TEAM
ESTIMATED CONTRACTOR EARTH DISTURBED AREA	0.25 ACRES	POST CONSTRUCTION BMP	Required
NOTICE OF INTENT EARTH DISTURBED AREA	2.49 ACRES		
IMPERVIOUS (PAVED) AREA FOR PRE-CONSTRUCTION SITE	TBD BY DESIGN BUILD TEAM	IMMEDIATE RECEIVING WATERS	OLDTOWN CREEK
IMPERVIOUS (PAVED) AREA FOR POST CONSTRUCTION SITE	TBD BY DESIGN BUILD TEAM	SUBSEQUENT RECEIVING WATER	LITTLE MIAMI RIVER

LEGEND

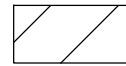



FLOODPLAIN



ZONE AE REGULATORY FLOODWAY



Switch back not shown correctly. Refer to "Switchback Exit Ramp Design"

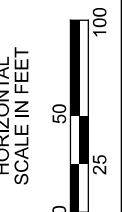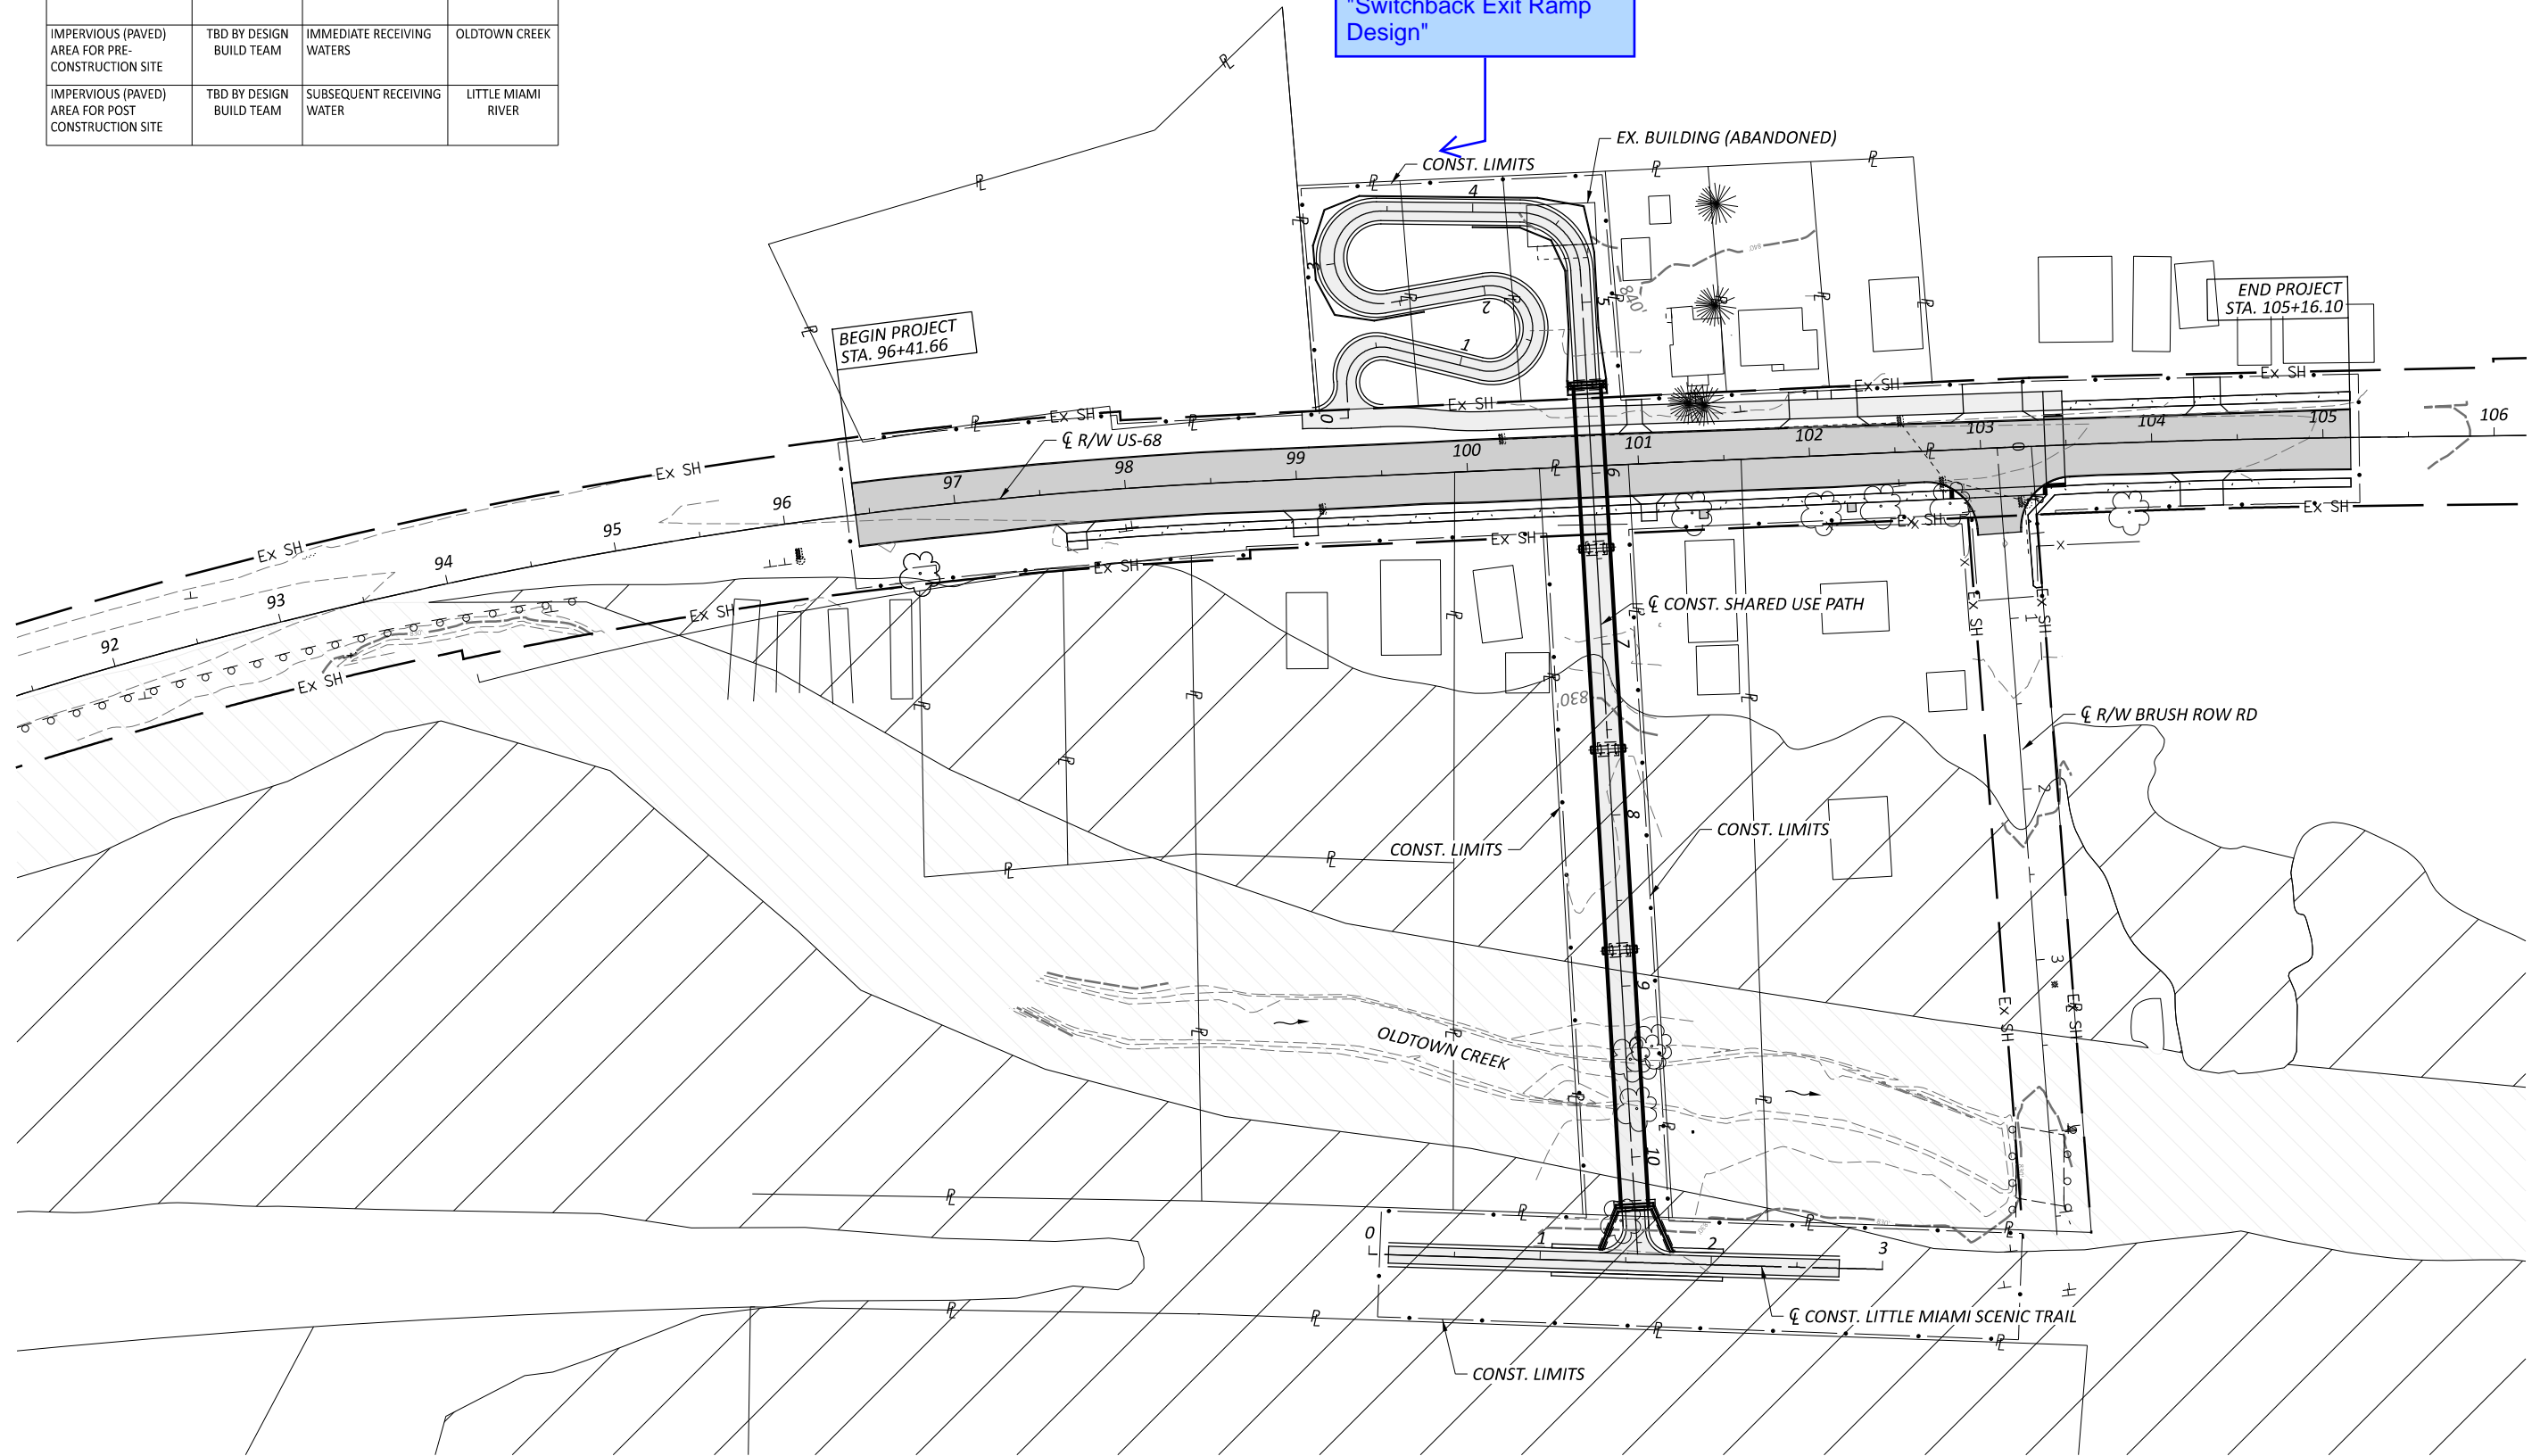

PROJECT SITE PLAN

DESIGN AGENCY



DESIGNER	JBT
REVIEWER	JAH 11/20/23
PROJECT ID	115388
SHEET TOTAL	P.09 22