

Request: A218903323

Gas Map

Gas

- ↘ Pipe Change
- Large Gas Service
- ← Dimensioning Line
- ⊗ Gas Valve
- Syphon
- ⊙ Drip
- × Coupling
- ⊕ Flow Control Device
- HVT High Volume Tee
- ◀ Reducer
- ⇄ Sleeve
- Telemeter
- ⊖ Vent
- || Flange
- Gas Regulating Station Site
- EXP Expansion Joint
- ||||| Exposed Pipe
- Casing
- Gas Detail Area

Gas Main

Pressure



- ||||| Feeder
- ◆ High Pressure
- Intermediate Pressure
- Medium Pressure
- Standard Pressure
- Transmission
- Unknown Pressure
- Foreign Pipe

Current Request

- Input Geometry

Land

- Edge of Pavement

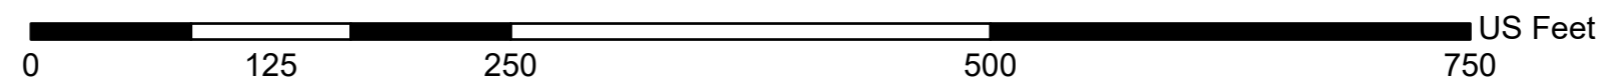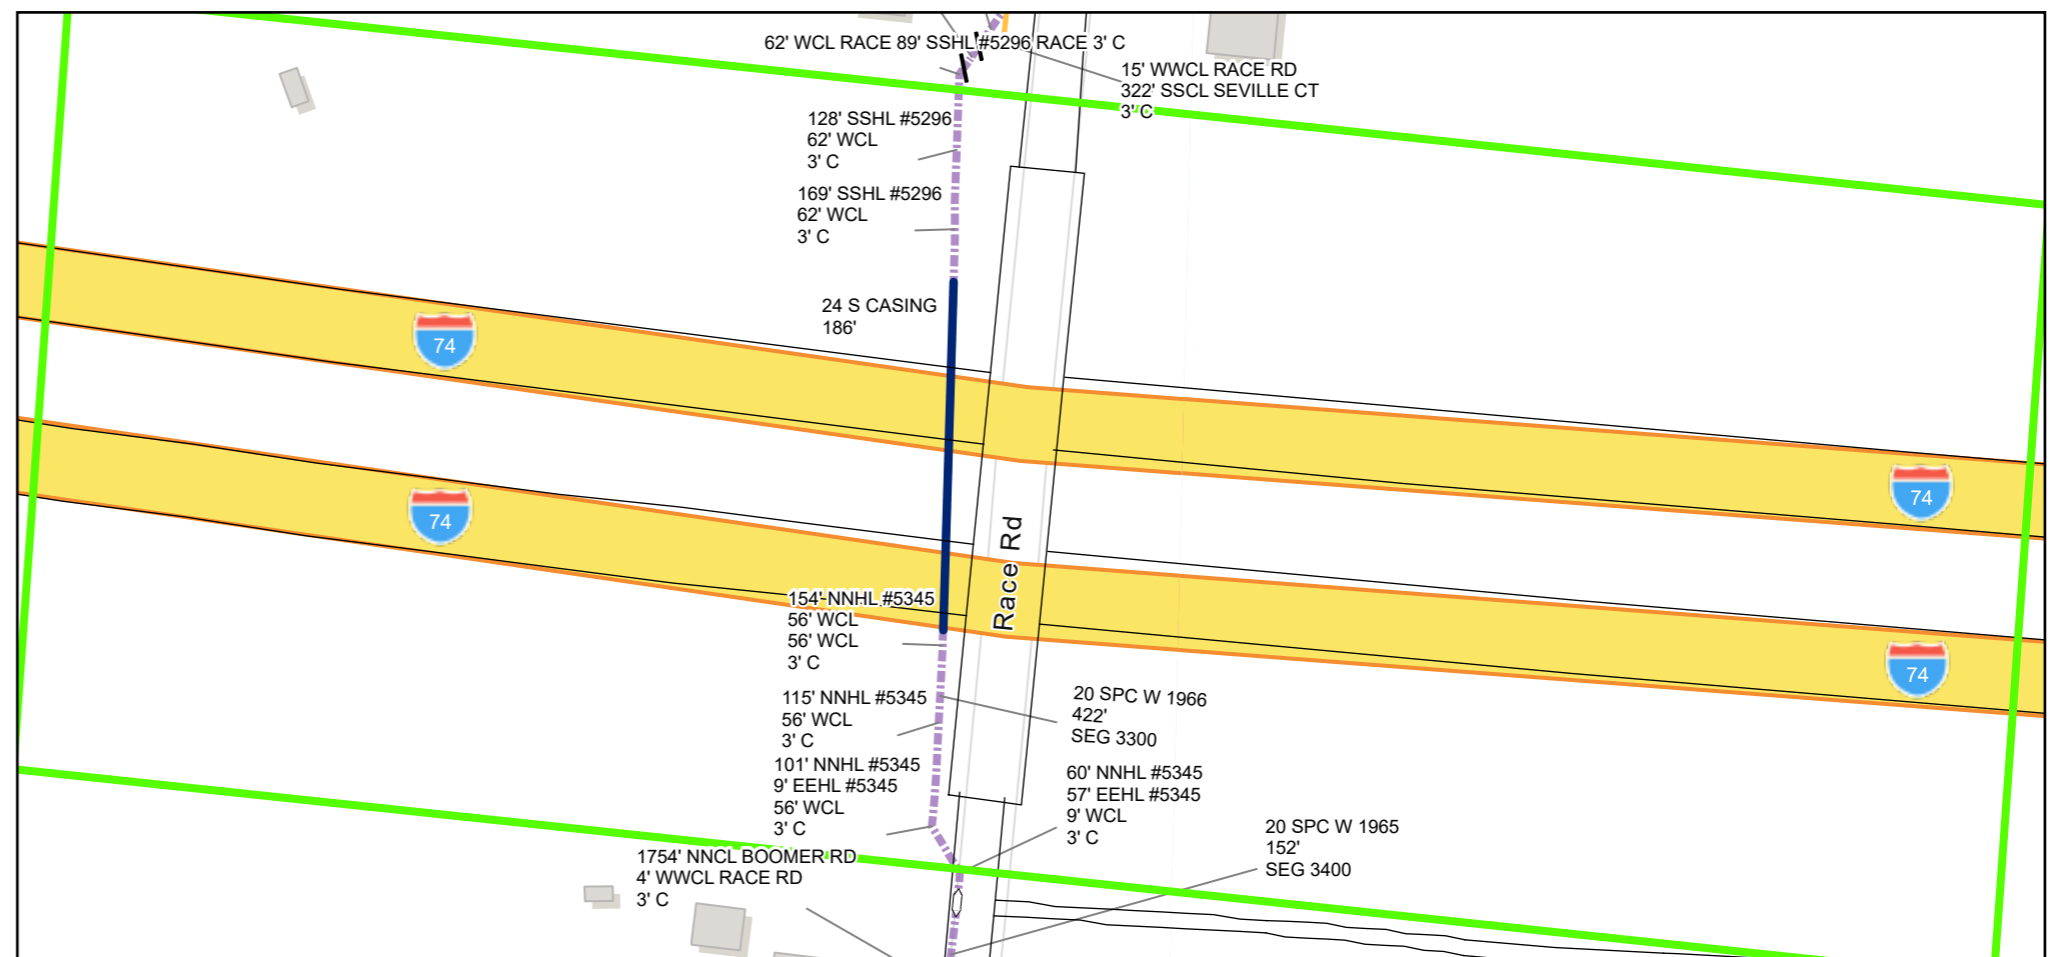

DISCLAIMER - This document was not prepared by a land surveyor, and should not be used for any survey, engineering, or legal purposes. All facility lines and equipment locations are approximate. The information on this document does not include secondary services. Equipment owned by others or other utility infrastructure may be otherwise incomplete.

