STATE OF OHIO
DEPARTMENT OF TRANSPORTATION

HAN - MCCOMB PEDESTRIAN IMPROVEMENTS

VILLAGE OF MCCOMB
HANCOCK COUNTY

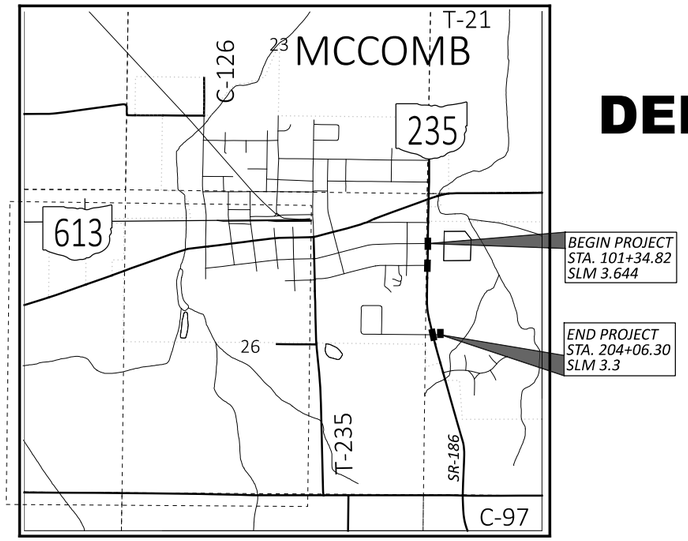

LOCATION MAP

LATITUDE: N41°34'42" LONGITUDE: W83°35'47"

SCALE IN MILES

0 4 8 12 16

PORTION TO BE IMPROVED
INTERSTATE HIGHWAY
FEDERAL ROUTES
STATE ROUTES
COUNTY & TOWNSHIP ROADS
OTHER ROADS

DESIGN DESIGNATION

CURRENT ADT (2024)	3010
DESIGN YEAR ADT (20)	N/A
DESIGN HOURLY VOLUME (20)	N/A
DIRECTIONAL DISTRIBUTION	N/A
TRUCKS (24 HOUR B&C)	N/A
DESIGN SPEED	35 MPH
LEGAL SPEED	35 MPH

DESIGN FUNCTIONAL CLASSIFICATION:

NHS PROJECT ..... NO

DESIGN EXCEPTIONS

NONE

ADA DESIGN WAIVERS

NONE

UNDERGROUND UTILITIES
Contact Two Working Days Before You Dig
OHIO811.org Before You Dig
OHIO811, 8-1-1, or 1-800-362-2764
(Non members must be called directly)

PLAN PREPARED BY:

KLEINFELDER Bright People. Right Solutions.
5201 LEVIS COMMONS BOULEVARD
PERRYSBURG, OH 43551
419.352.7537

INDEX OF SHEETS:

TITLE SHEET	1
SCHEMATIC PLAN	2
GENERAL NOTES	3 - 4
GENERAL SUMMARY	5
SUBSUMMARIES	6 - 7
PLAN SHEET	8 - 10
INTERSECTION DETAILS	11 - 14
DETAILS	15 - 16

FEDERAL PROJECT NUMBER

E250470

RAILROAD INVOLVEMENT

N/A

PROJECT DESCRIPTION

PEDESTRIAN IMPROVEMENTS ALONG S PARK DR/SR-186/SR-235 AT SOUTH STREET, AT BOND-PREBLE STREET, AND AT SOUTHCREST DRIVE INCLUDING INSTALLATION OF SOLAR POWERED RRFB ASSEMBLIES AT EACH LOCATION, NEW CURB RAMPS, SIDEWALK, PAVEMENT MARKINGS, AND INSTALLATION OF A CURB BUMPOUT AT SOUTH STREET IN A FORMER PARKING AREA. INCLUDES MINOR GRADING, TOPSOIL AND SEEDING RESTORATION.

EARTH DISTURBED AREAS

PROJECT EARTH DISTURBED AREA:	0.13 ACRES
ESTIMATED CONTRACTOR EARTH DISTURBED AREA:	0 ACRES
NOTICE OF INTENT EARTH DISTURBED AREA:	N/A

2023 SPECIFICATIONS

THE STANDARD SPECIFICATIONS OF THE STATE OF OHIO, DEPARTMENT OF TRANSPORTATION, INCLUDING SUPPLEMENTAL SPECIFICATIONS LISTED IN THE PLANS, CHANGES LISTED IN THE PROPOSAL, AND THE SUPPLEMENTAL SPECIFICATION 800 VERSION INDICATED ON THE PROPOSAL SHALL GOVERN THIS IMPROVEMENT.

I HEREBY APPROVE THESE PLANS AND DECLARE THAT THE MAKING OF THIS IMPROVEMENT WILL NOT REQUIRE THE CLOSING TO TRAFFIC OF THE HIGHWAY AND THAT PROVISIONS FOR THE MAINTENANCE AND SAFETY OF TRAFFIC WILL BE AS SET FORTH ON TH EPLANS AND ESTIMATES.

Christopher A. Hughes
Christopher A. Hughes, P.E.
District 01 Deputy Director

Pamela Boratyn
Pamela Boratyn
Director, Department of Transportation

ENGINEER'S SEAL:

STATE OF OHIO
JEFFREY L. WEAVER
E-65362
REGISTERED
PROFESSIONAL ENGINEER

SIGNED:
DATE: 11/17/25

STANDARD CONSTRUCTION DRAWINGS								SUPPLEMENTAL SPECIFICATIONS		SPECIAL PROVISIONS
BP-3.1	1/19/24	MT-97.10	7/18/25	TC-41.20	10/18/13			800-2023	7/18/25	
BP-5.1	7/18/25	MT-101.90	7/17/20	TC-41.30	4/21/23			832	7/18/25	
BP-7.1	7/18/25	~~MT-105.10~~	~~1/17/20~~	TC-42.10	10/18/13					
		MT-110-10	7/19/13	TC-42.20	10/18/13					
				TC-52.10	10/18/13					
				TC-52.20	1/15/21					
				TC-71.10	7/18/25					
				TC-74.10	7/21/23					
				TC-87.10	7/18/25					

01

TITLE SHEET

DESIGN AGENCY
KLEINFELDER Bright People. Right Solutions.

DESIGNER GC
REVIEWER BCS 11-17-25
PROJECT ID 123348
SHEET 1 TOTAL 16

HAN - MCCOMB PEDESTRIAN IMPROVEMENTS

MODEL: Sheet_SurvFt PAPERSIZE: 34x22 (in.) DATE: 11/7/2025 TIME: 8:37:01 AM USER: wclough
pw:\\kleinfelder-pw.bentley.com:3\kleinfelder-pw\Documents\Village of McComb, OH\26000676.001A_McComb - SR 235 Park Drive Safety\123348\400-Engineering\Roadway\Sheets\26000676_GT001.dgn