


CTY-RTE-SECTION

MODEL: Plan 1 [Sheet] PAPER SIZE: 34x22 (in.) DATE: 6/3/2024 TIME: 3:58:21 PM USER: tadams
J:\20230339\ODOT\07_D11 Bridge St_Bowerston\120494\400-Engineering\Structures\SFN_3431790\EngData\06_ODOT Coordination\120494_SF_N_3431790_SP001.dgn

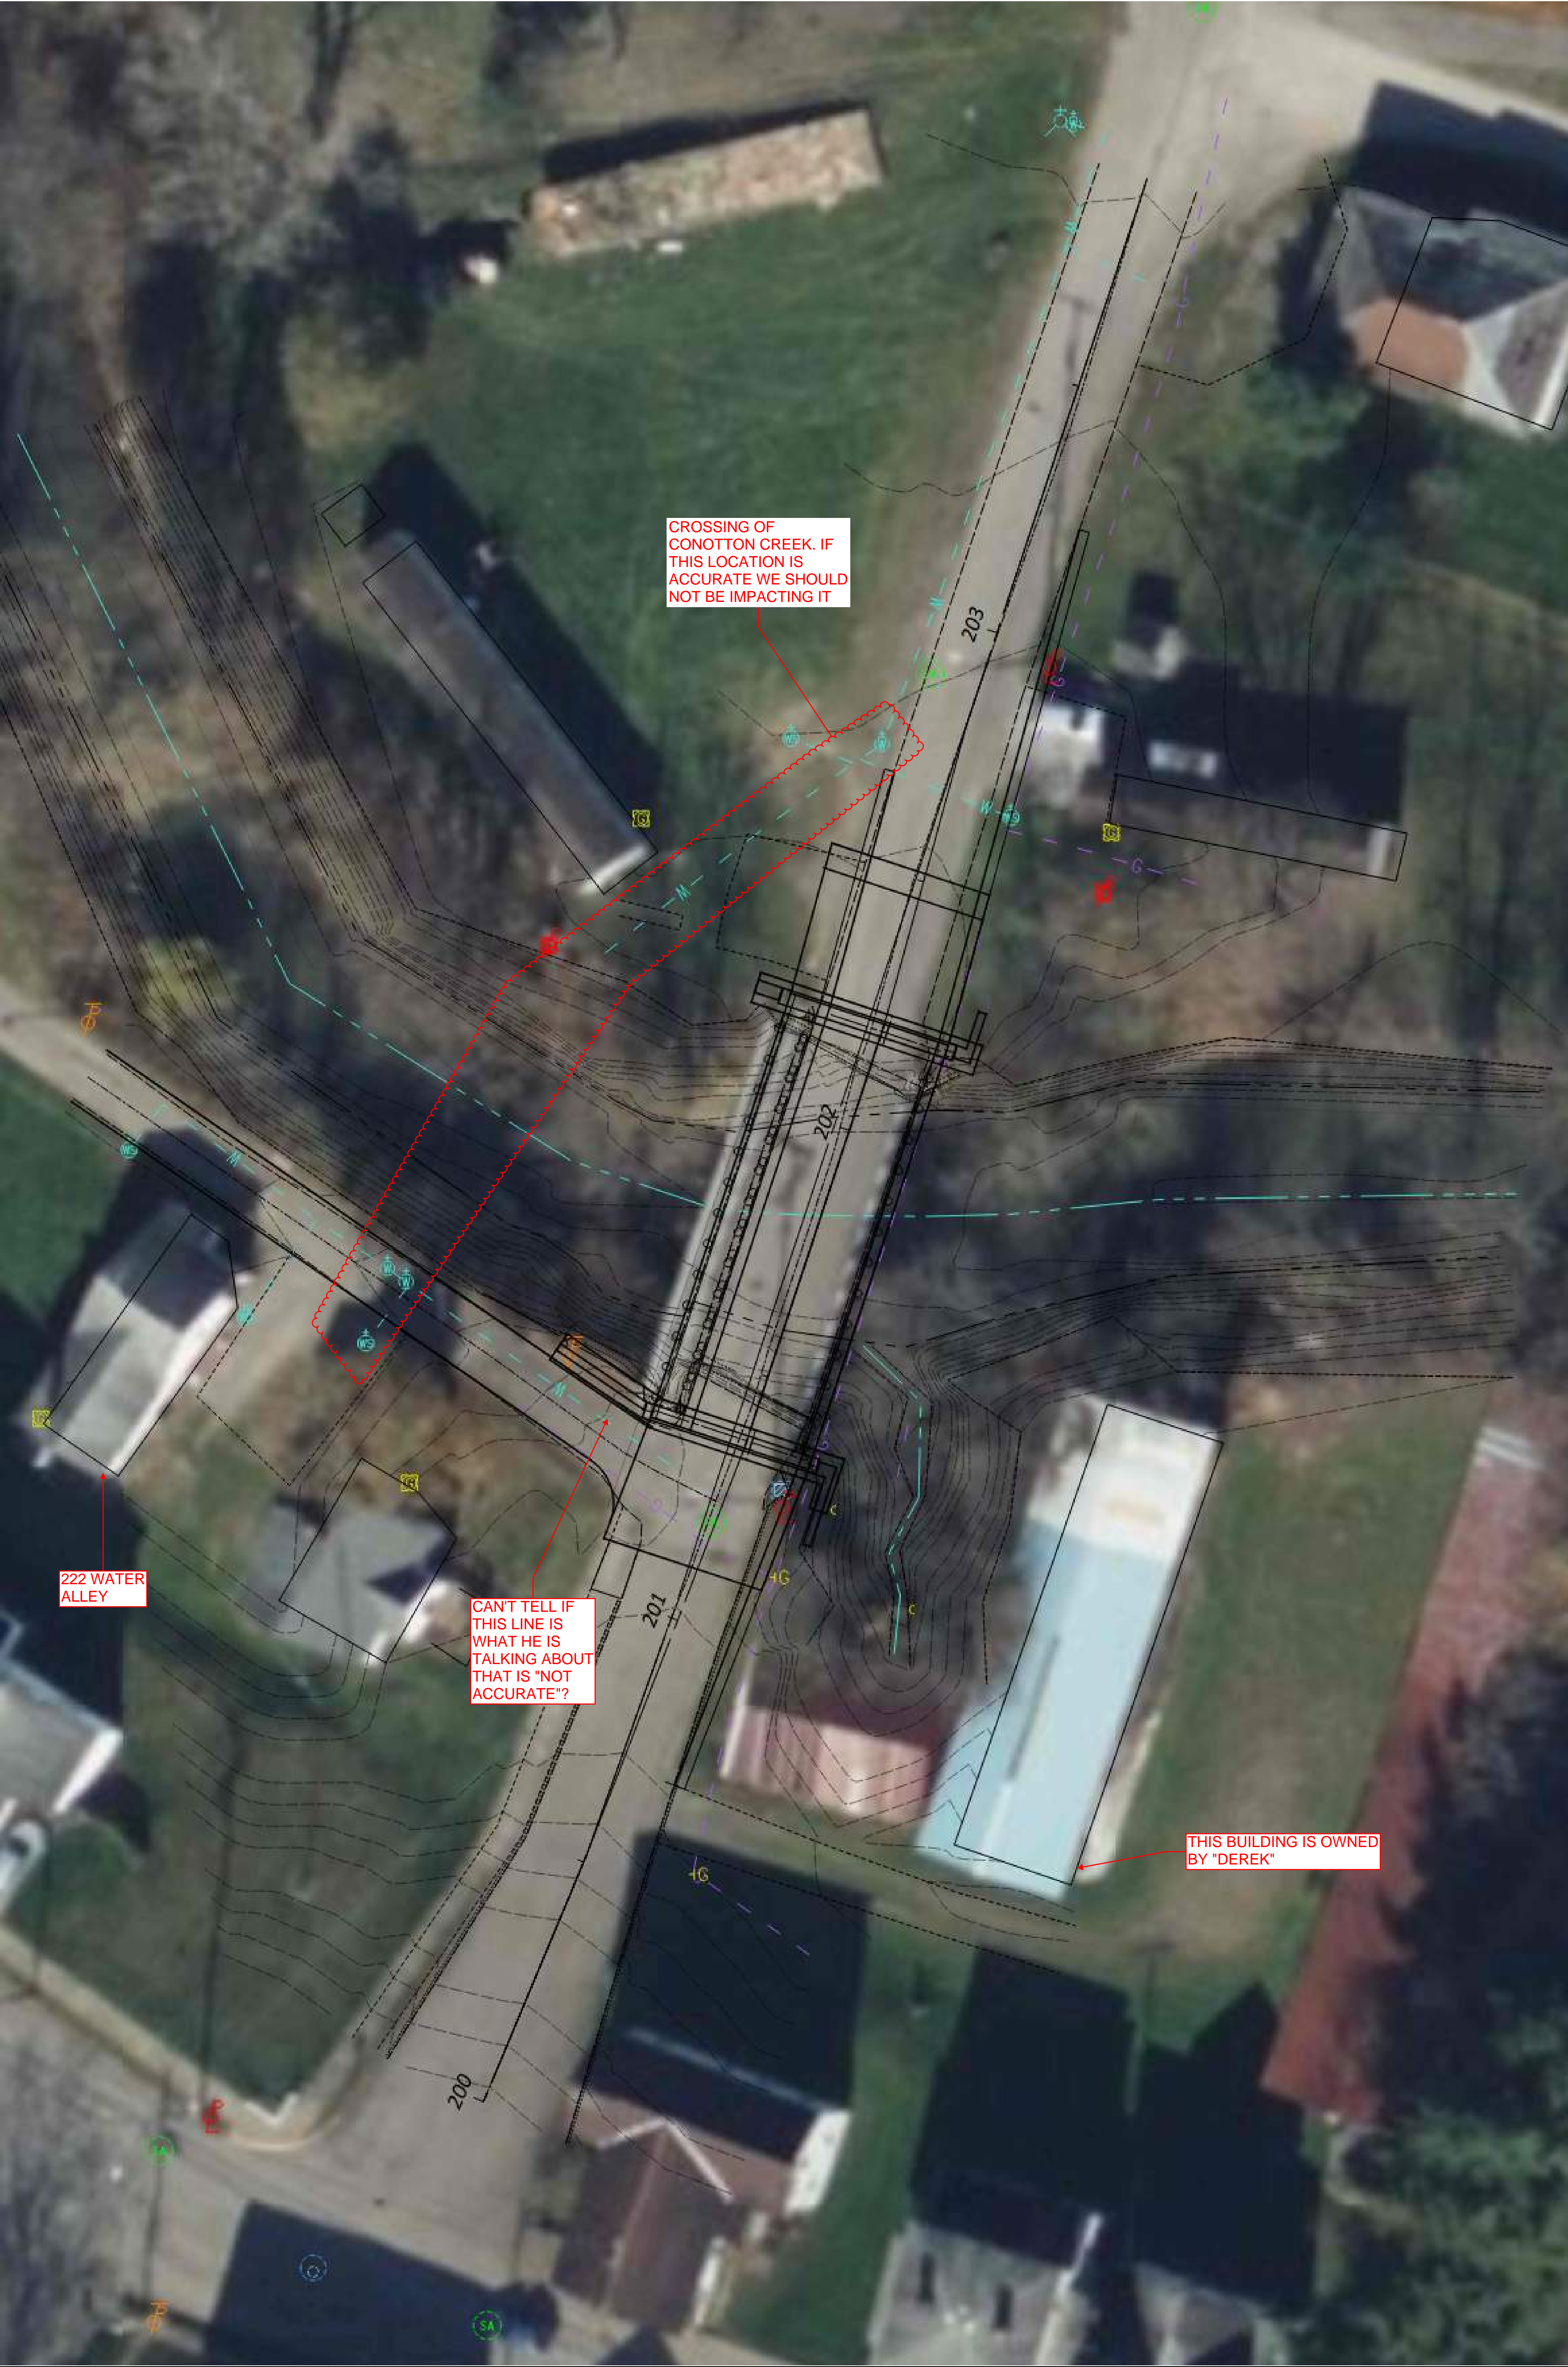

SHEET TOTAL		P.0 0	
SUBSET TOTAL		0 0	
PROJECT ID		120494	
REVIEWER		CAS MM-DD-YY	
DESIGNER		AI TDA	
CHECKER			
DESIGN AGENCY			
SFN		0	

EMH&T

UTILITY EXHIBIT
BRIDGE NO. HAS 00027 00045
OVER CONOTTON CREEK