
HEN-281-05.71-1935 USED

FOR ANY QUESTIONS PLEASE CONTACT ODOT DIST. 2 REAL ESTATE AT 419-353-8131

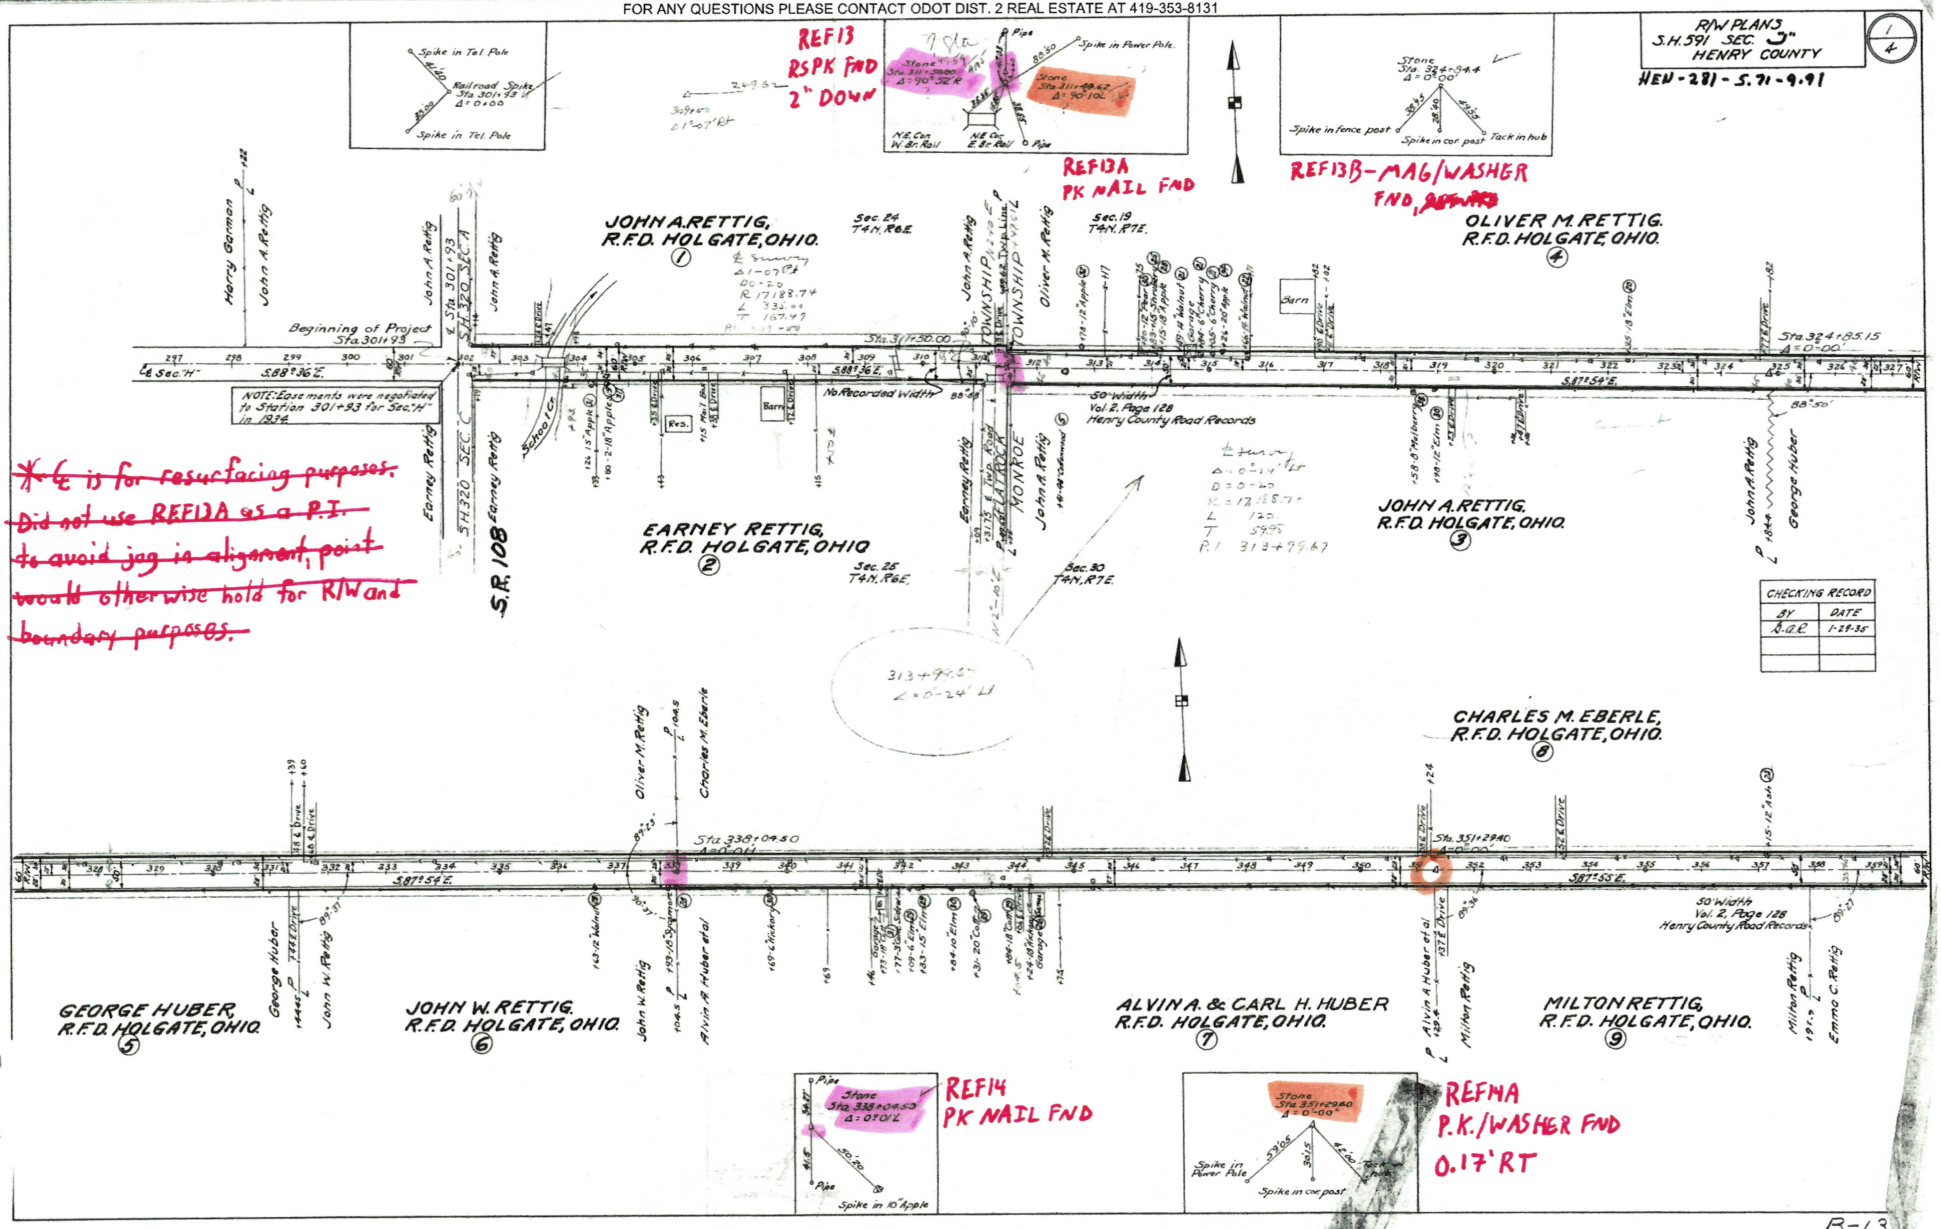

* ℄ is for resurfacing purposes. Did not use REF13A as a P.I. to avoid jag in alignment, point would otherwise hold for R/W and boundary purposes.

REF15-REF16
PLAN: 2629.21'
MEAS: 2628.41'

FOR ANY QUESTIONS PLEASE CONTACT ODOT DIST. 2 REAL ESTATE AT 419-353-8131

Meas Δ = 0°52'11" RT

R/W PLANS
S.H. 591 SEC. J"
HENRY COUNTY
2/4

REF14-REF15
Plan: 2649.89'
Meas: 2649.90'

REF15
Large RSPK FND
2½" DOWN

MEAS Δ = 0°32'52" LT

REF15A
P.K./WASHER
FND
0.02' LT

REF16
P.K. SHANK
FND AT SURFACE

LULU C. RODDY ET AL
NAPOLEON, OHIO.
13 & 16

CHARLES M. HARRISON ET AL,
NAPOLEON, OHIO.
12

JOSEPH BABCOCK,
R.F.D. HOLGATE, OHIO.
18

REF15 → REF15A → REF16

PLAN:	1314.71'	1314.50'
MEAS:	1314.23'	1314.17'

EMMA C. RETTIG.
R.F.D. HOLGATE, OHIO.
10

EMMA C. RETTIG
R.F.D. HOLGATE, OHIO.
11

NEW YORK, CHICAGO & ST. LOUIS RAILROAD CO.,
CLEVELAND, OHIO.
15

ARTHUR KOPPENHOFER ET AL
R.F.D. HOLGATE, OHIO.
14 & 17

CHECKING RECORD

BY	DATE
M.A.E.	1-29-15

HARVEY KOPPENHOFER, ET AL
R.F.D. HOLGATE, OHIO.
19

LEWIS W. HOFF
R.F.D. HOLGATE, OHIO.
21

ALBERT & HELEN SCHLIESSER
R.F.D. MALINTA, OHIO.
22

REF16-REF17
PLAN: 2657.70'
MEAS: 2657.90'

MARY R. SCHNEIDER
HOLGATE, OHIO.
20

% G. W. RETTIG

Meas Δ = 0°23'32" LT

REF17
SMALL RSPK FND
2" DOWN

HARVEY KOPPENHOFER ET AL

	REF16 → P.O.T.	→ REF17
PLAN:	1328.65'	1329.05'
REF16AA MEAS:	1328.94'	1328.96'
REF16A MEAS:	1330.06'	1327.90'


ALBERT U. BRUBAKER
& FLORA E. BRUBAKER
23

REF16AA - FND MAG NAIL, 0.05' LT


REF16A - FND P.K. NAIL, 0.01' LT

R-1.2

FOR ANY QUESTIONS PLEASE CONTACT ODOT DIST. 2 REAL ESTATE AT 419-353-8131

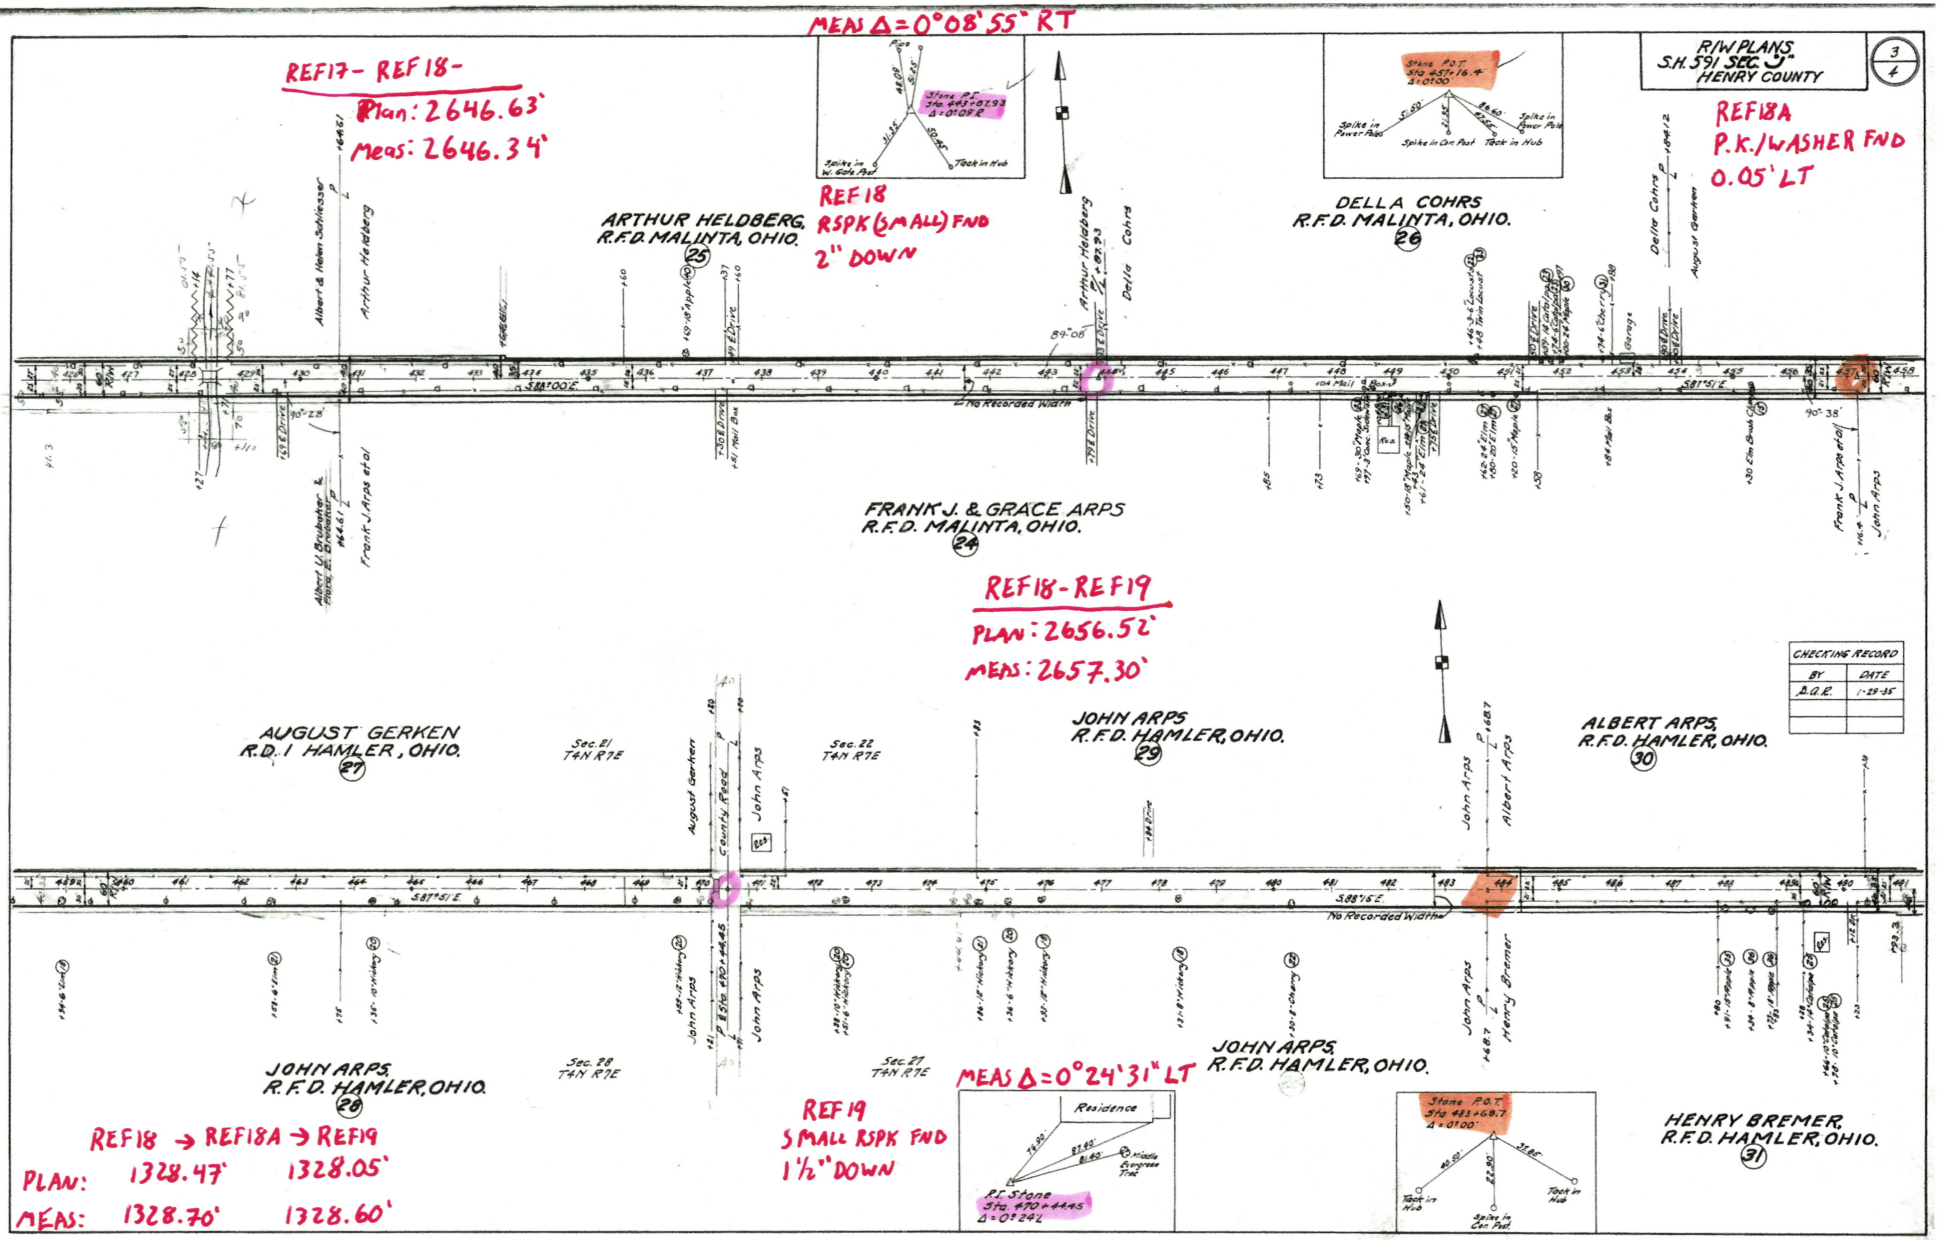

FOR ANY QUESTIONS PLEASE CONTACT ODOT DIST. 2 REAL ESTATE AT 419-353-8131

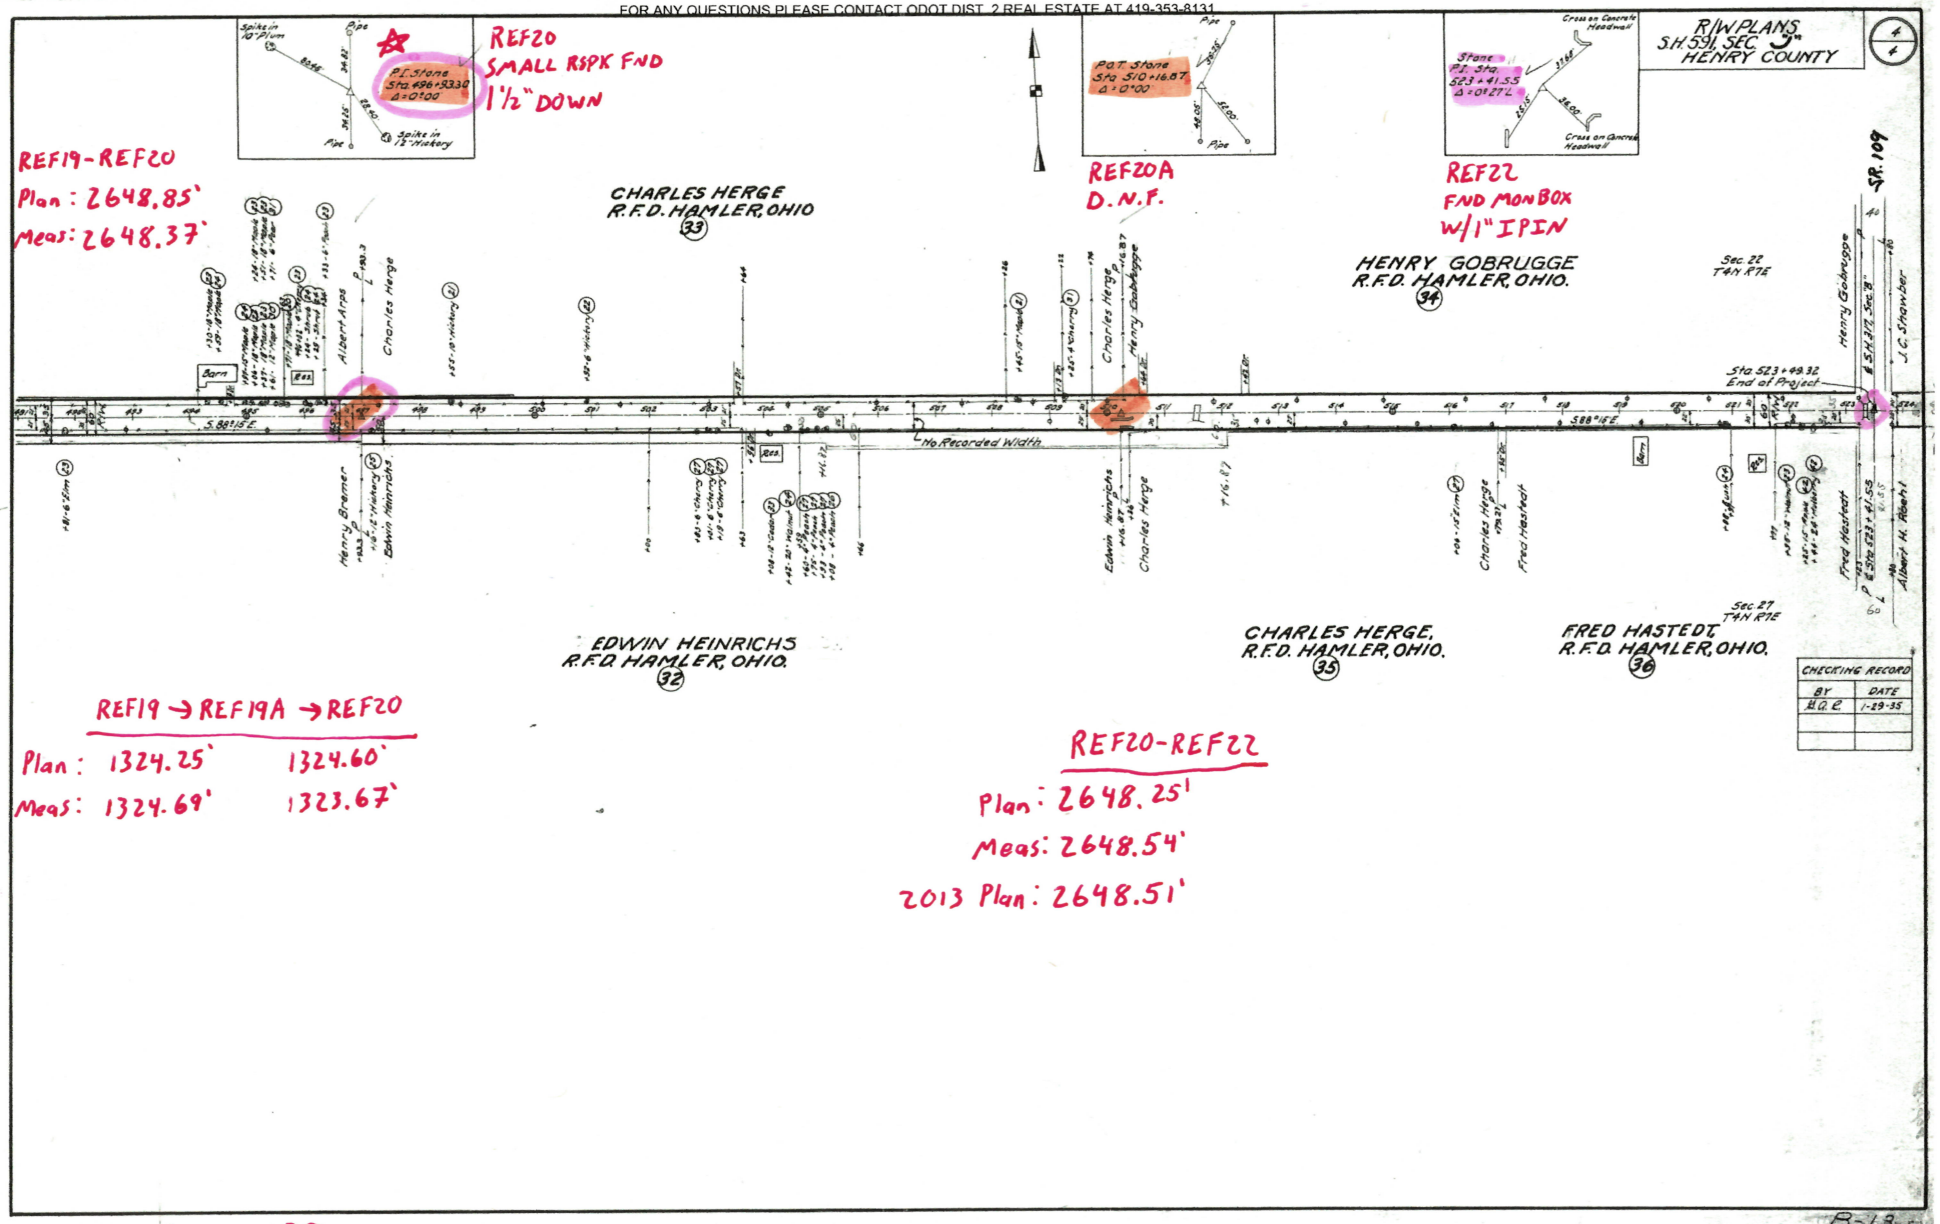

REF19-REF20
Plan: 2648.85'
Meas: 2648.37'

REF19 → REF19A → REF20

Plan:	1324.25'	1324.60'
Meas:	1324.69'	1323.67'

REF20-REF22
Plan: 2648.25'
Meas: 2648.54'
2013 Plan: 2648.51'

★ Held REF20 as a P.I.
per HEN-281-9.67-2013


FOR ANY QUESTIONS PLEASE CONTACT ODOT DIST. 2 REAL ESTATE AT 419-353-8131

HENRY COUNTY
S.H. 591 SEC. J-BR.
RIGHT/WAY PLAN

Date June 2, 1936. Drawn By A. P.

Revisions

Length of Project 0.03 Mi.

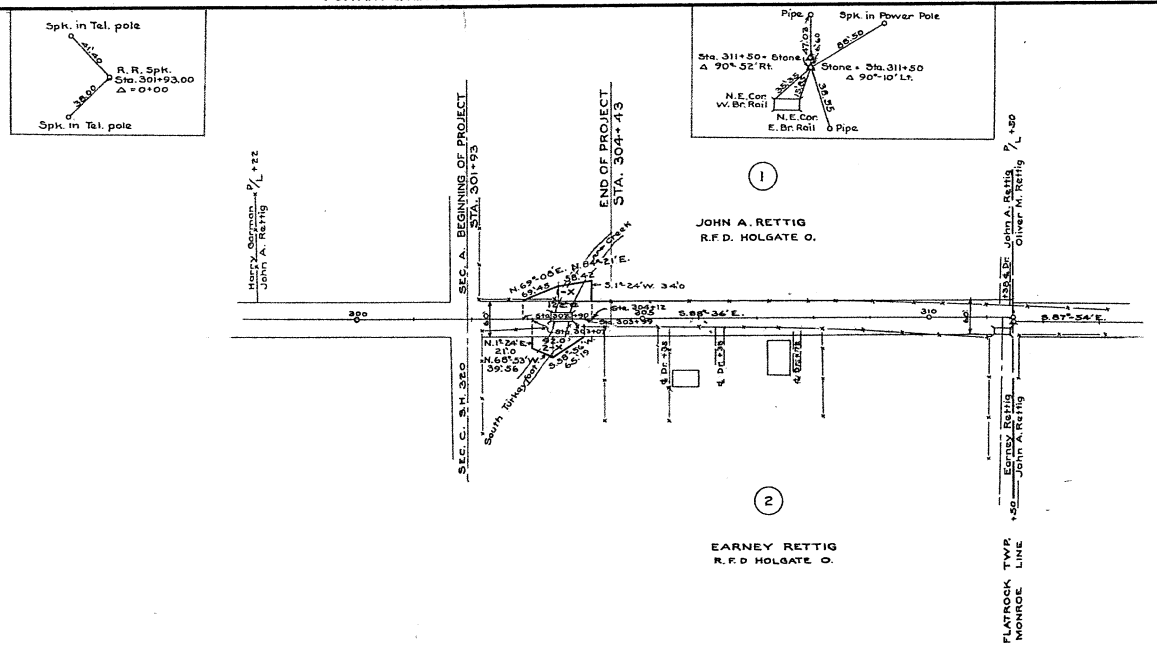

R/W not obtained

B-15