NESEC25	592582.143	1556668.244	694.8924	IPIN	Size	5/8IN	Depth	6IN					
PL1	592285.423	1587180.572	689.2533	IPID	Size	5/8IN	Name	NIESE	Number	8727	Depth		0
PL2	592273.573	1587177.593	689.6622	IPID	Name	H BEHRMAI	Number	5778	Depth	UP 1IN			
PL3	592273.537	1587180.590	689.8703	IPID	Name	H BEHRMAI	Number	5778	Depth	2IN			
PL4	592585.587	1556065.902	694.104	IPIN	Size	5/8IN	Depth	0					
PL5	592323.391	1587180.774	690.5294	MAG	Depth	0	Note	MAG NAIL					
PL6	592396.876	1576534.237	693.0599	MAG	Depth	0	Note	MAG NAIL					
REF12	592915.487	1522260.496	695.6764	MAG	Depth	0	Note	MAG/WASHER					
REF12A	592911.500	1523949.772	695.1633	MAG	Depth	0	Note	MAG/WASHER					
REF12B	592978.670	1523934.658	694.5975	MONBOX	Size	1IN IPIN	Note	CROSS CUT ON PIN					
REF13	592909.253	1524915.126	696.4515	RSPK	Depth	2IN	Note	RSPK					
REF13A	592902.482	1524914.799	696.5295	PK	Depth	0	Note	PK NAIL					
REF13B	592882.898	1526249.458	697.0494	MAG	Depth	0	Note	MAG/WASHER					
REF14	592863.500	1527569.334	697.0067	PK	Depth	0	Note	PK NAIL					
REF14A	592844.103	1528893.771	697.1697	PK	Depth	0	Note	PK/WASHER					
REF15	592825.038	1530218.741	696.6911	RSPK	Depth	2-1/2IN	Note	LARGE RSPK					
REF15A	592818.542	1531532.852	697.8168	PK	Depth	0	Note	PK/WASHER					
REF16	592812.011	1532846.904	697.0332	PK	Depth	0	Note	PK SHANK					
REF16A	592785.241	1534176.524	697.053	PK	Depth	0	Note	PK NAIL					
REF16AA	592785.308	1534175.466	697.0807	MAG	Depth	0	Note	MAG NAIL					
REF17	592758.495	1535504.051	696.6559	RSPK	Depth	2IN	Note	SMALL RSPK					
REF18	592723.315	1538149.941	695.4387	RSPK	Depth	2IN	Note	SMALL RSPK					
REF18A	592702.251	1539478.365	695.023	PK	Depth	0	Note	PK/WASHER					
REF19	592681.097	1540806.688	695.2772	RSPK	Depth	1-1/2IN	Note	SMALL RSPK					
REF19A	592670.718	1542131.228	694.9931	PK	Depth	0	Note	PK NAIL					
REF20	592657.907	1543454.745	695.0853	RSPK	Depth	1-1/2IN	Note	SMALL RSPK					
REF22	592634.222	1546102.965	695.0573	MONBOX	Size	1IN							
REF22A	592631.770	1548748.982	695.123	PK	Depth	0	Note	PK NAIL					
REF22AB	592611.677	1551393.755	695.6638	PK	Depth	0	Note	PK NAIL					
REF22B	592613.520	1551394.048	695.3214	CNPT	Note	HARROW T	4-1/2IN DOWN						
REF23	592604.272	1552718.838	694.8299	RSPK	Depth	5 1/2IN	Note	SMALL RSPK					
REF25	592526.006	1556668.834	695.8106	RSPK	Depth	3IN	Note	SMALL RSPK					
REF26	592500.470	1559252.129	696.3704	PK	Depth	0	Note	PK NAIL					
REF27	592470.586	1561893.368	695.7856	RSPK	Depth	3IN	Note	SMALL RSPK					
REF28	592460.627	1564562.086	695.922	MAG	Depth	0	Note	SHANK AND WASHER					
REF29	592440.148	1567230.232	696.4446	RSPK	Depth	3 1/2IN	Note	SMALL RSPK					
REF30	592437.673	1569889.556	698.008	RSPK	Depth	1/2IN	Note	SMALL RSPK					
REF31	592437.943	1572551.453	697.2949	MAG	Depth	0	Note	MAG/WASHER					
REF32	592410.476	1575206.605	692.2022	IPIN	Size	5/8IN	Depth	4IN					
REF33	592383.303	1577861.731	693.1824	PK	Depth	0	Note	PK/WASHER					
REF34	592370.590	1580527.014	693.4834	MAG	Depth	0	Note	MAG/WASHER					
REF35	592359.102	1583189.693	692.8335	RSPK	Depth	2IN	Note	SMALL RSPK					
REF36	592334.597	1585845.737	692.0741	RSPK	Depth	TOP-3IN	BASE-4IN	Note	BENT EAST	MEASURED TO BASE			
REF36A	592318.256	1587371.039	689.8926	MONBOX	Size	1IN IPIN							
REF36AA	592323.526	1587177.770	690.341	PK	Depth	2IN	Note	PK NAIL					
REF36B	592316.786	1587651.077	690.0939	MONBOX	Size	1IN IPIN							
REF37	592312.283	1588509.728	691.5681	MAG	Depth	0	Note	MAG SHANK					

HEN-281-5.72 CONTROL
Ohio State Plane, North Zone
Datum: NAD83(2011)
Geoid: 18

NESEC25	449418.024	191924.232	694.8924	IPIN	Size	5/8IN	Depth	6IN						
PL1	449681.346	222439.398	689.2533	IPID	Size	5/8IN	Name	NIESE	Number	8727	Depth	0		
PL2	449669.442	222436.638	689.6622	IPID	Name	H BEHRMAI	Number	5778	Depth	UP 1IN				
PL3	449669.462	222439.635	689.8703	IPID	Name	H BEHRMAI	Number	5778	Depth	2IN				
PL4	449410.414	191321.879	694.104	IPIN	Size	5/8IN	Depth	0						
PL5	449719.315	222438.904	690.5294	MAG	Depth	0	Note	MAG NAIL						
PL6	449597.370	211791.917	693.0599	MAG	Depth	0	Note	MAG NAIL						
REF12	449120.029	157513.370	695.6764	MAG	Depth	0	Note	MAG/WASHER						
REF12A	449147.032	159202.572	695.1633	MAG	Depth	0	Note	MAG/WASHER						
REF12B	449213.919	159186.227	694.5975	MONBOX	Size	1IN IPIN	Note	CROSS CUT ON PIN						
REF13	449162.495	160167.883	696.4515	RSPK	Depth	2IN	Note	RSPK						
REF13A	449155.719	160167.680	696.5295	PK	Depth	0	Note	PK NAIL						
REF13B	449160.622	161502.581	697.0494	MAG	Depth	0	Note	MAG/WASHER						
REF14	449165.439	162822.698	697.0067	PK	Depth	0	Note	PK NAIL						
REF14A	449170.342	164147.375	697.1697	PK	Depth	0	Note	PK/WASHER						
REF15	449175.587	165472.579	696.6911	RSPK	Depth	2-1/2IN	Note	LARGE RSPK						
REF15A	449193.200	166786.694	697.8168	PK	Depth	0	Note	PK/WASHER						
REF16	449210.778	168100.751	697.0332	PK	Depth	0	Note	PK SHANK						
REF16A	449208.405	169430.746	697.053	PK	Depth	0	Note	PK NAIL						
REF16AA	449208.452	169429.687	697.0807	MAG	Depth	0	Note	MAG NAIL						
REF17	449206.017	170758.647	696.6559	RSPK	Depth	2IN	Note	SMALL RSPK						
REF18	449219.386	173404.952	695.4387	RSPK	Depth	2IN	Note	SMALL RSPK						
REF18A	449222.697	174733.646	695.023	PK	Depth	0	Note	PK/WASHER						
REF19	449225.917	176062.241	695.2772	RSPK	Depth	1-1/2IN	Note	SMALL RSPK						
REF19A	449239.842	177386.856	694.9931	PK	Depth	0	Note	PK NAIL						
REF20	449251.316	178710.493	695.0853	RSPK	Depth	1-1/2IN	Note	SMALL RSPK						
REF22	449276.226	181358.916	695.0573	MONBOX	Size	1IN								
REF22A	449322.326	184004.747	695.123	PK	Depth	0	Note	PK NAIL						
REF22AB	449350.766	186649.659	695.6638	PK	Depth	0	Note	PK NAIL						
REF22B	449352.615	186649.919	695.3214	CNPT	Note	HARROW T	4-1/2IN DOWN							
REF23	449367.677	187974.763	694.8299	RSPK	Depth	5 1/2IN	Note	SMALL RSPK						
REF25	449361.902	191925.852	695.8106	RSPK	Depth	3IN	Note	SMALL RSPK						
REF26	449383.776	194509.392	696.3704	PK	Depth	0	Note	PK NAIL						
REF27	449402.366	197150.951	695.7856	RSPK	Depth	3IN	Note	SMALL RSPK						
REF28	449441.385	199819.622	695.922	MAG	Depth	0	Note	SHANK AND WASHER						
REF29	449469.875	202487.914	696.4446	RSPK	Depth	3 1/2IN	Note	SMALL RSPK						
REF30	449516.207	205147.055	698.008	RSPK	Depth	1/2IN	Note	SMALL RSPK						
REF31	449565.332	207808.719	697.2949	MAG	Depth	0	Note	MAG/WASHER						
REF32	449586.601	210464.148	692.2022	IPIN	Size	5/8IN	Depth	4IN						
REF33	449608.164	213119.548	693.1824	PK	Depth	0	Note	PK/WASHER						
REF34	449644.373	215784.838	693.4834	MAG	Depth	0	Note	MAG/WASHER						
REF35	449681.761	218447.503	692.8335	RSPK	Depth	2IN	Note	SMALL RSPK						
REF36	449706.013	221103.773	692.0741	RSPK	Depth	TOP-3IN	BASE-4IN	Note	BENT EAST	MEASURED TO BASE				
REF36A	449717.673	222629.247	689.8926	MONBOX	Size	1IN IPIN								
REF36AA	449719.395	222435.898	690.341	PK	Depth	2IN	Note	PK NAIL						
REF36B	449721.344	222909.289	690.0939	MONBOX	Size	1IN IPIN								
REF37	449732.603	223767.950	691.5681	MAG	Depth	0	Note	MAG SHANK						

HEN-281-5.72 CONTROL
HENRY OCCS
Datum: NAD83(2011)
Geoid: 18

O.D.O.T. DISTRICT 2 SURVEY OFFICE (USE ONLY)

PERSONNEL

NOTES HAGEMEYER
H.C. LEU
R.C. HAGEMEYER


DWG BY JAMES

REFERENCE NO. 12
DATE 6-7-18
WEATHER CLOUDY
TEMP. 63°

PID 102763


SHEET 16 OF 20
ROUTE SR 281
COUNTY HENRY
TOWNSHIP FLAT ROCK
SECTION 25
T 4 N R 6 E

TYPE MONUMENT MAG/WASHER
ON SURFACE - ~~BELOW~~ ON
OFFSET ℄ PAVEMENT 1.4' ~~LT~~ : RT
8.6' TO RT EDGE PAVEMENT
STATION: 285+00.24

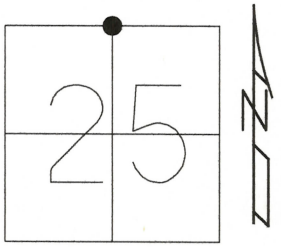

HORZ.DATUM: NAD83 2011
GEOID: NAVD88 2012A
GRID: NORTHING: 592915.493
EASTING: 1522260.506

RECORD:
FD P.K./WASHER
1985
SET P.K./WASHER
8-28-95, KPM
FD P.K./WASHER
8-20-09, KPM
SET MAG/WASHER
10-26-09, KPM
FD MAG/WASHER
REF12
11-2-16, JFO
6-7-18, JLL
SET MAG/WASHER
11-16-18, JLL
FD MAG/WASHER
REF12
4-30-26, TDN

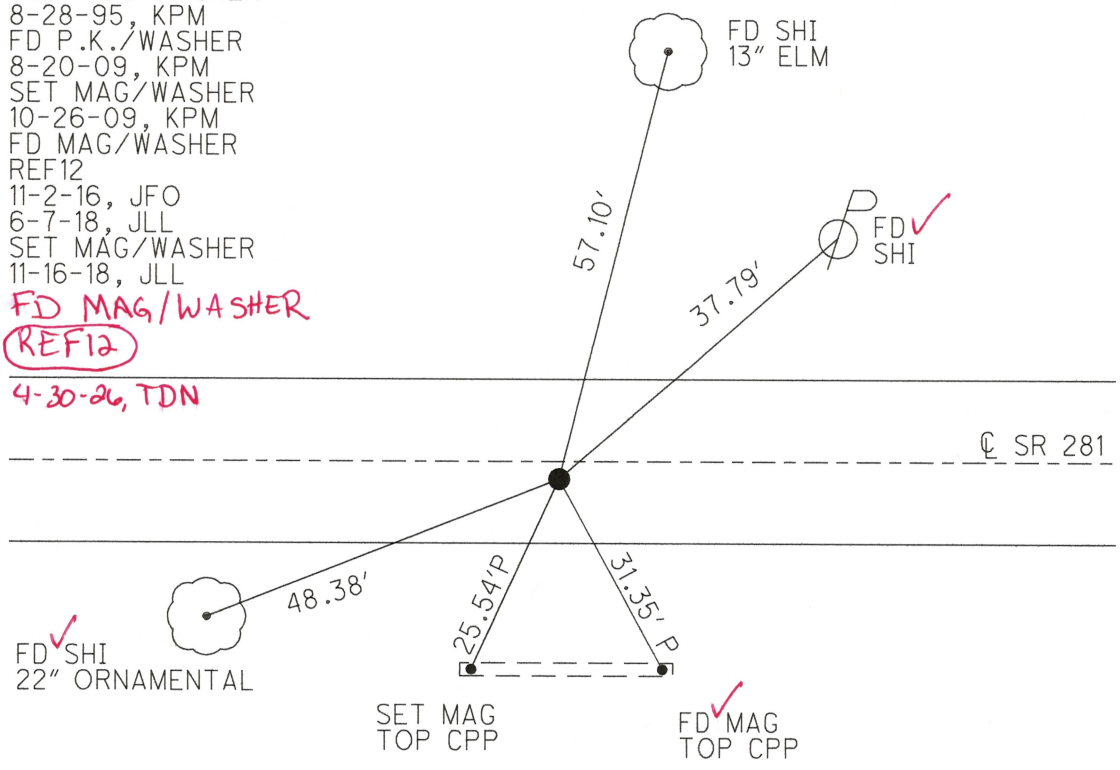

O.D.O.T. DISTRICT 2 SURVEY OFFICE (USE ONLY)

PERSONNEL

NOTES CANTERBURY
H.C. ROUSOS
R.C. HUSS

DWG BY JAMES

REFERENCE NO. 12 A


DATE 5-19-98
WEATHER SUNNY
TEMP. +80°

PID 102763

SHEET 17 OF 20

ROUTE SR 281
COUNTY HENRY
TOWNSHIP FLAT ROCK
SECTION 25
T 4 N R 6 E


TYPE MONUMENT P.K./WASHER
ON SURFACE - ~~BELOW~~ ON
OFFSET ℄ PAVEMENT ON, 15.4' SR 108 LT : ~~RT~~
- TO - EDGE PAVEMENT
STATION: 301+48.8

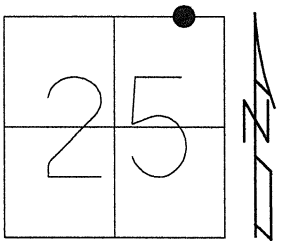

HORZ.DATUM: NAD83 2011 GEOID: NAVD88 2012A
GRID: NORTHING: 592911.473 EASTING: 1523949.701

RECORD: P.I.
SR 108
STA 444+96.06
P.K./WASHER SET
9-17-92, MDB
FD P.K./WASHER
5-19-98, TMR
DNF
8-20-09, KPM
9/4/18, JFO
SET MAG/WASHER
REFA35
11/6/18, JLL

NOTE: REF 35A SR 108

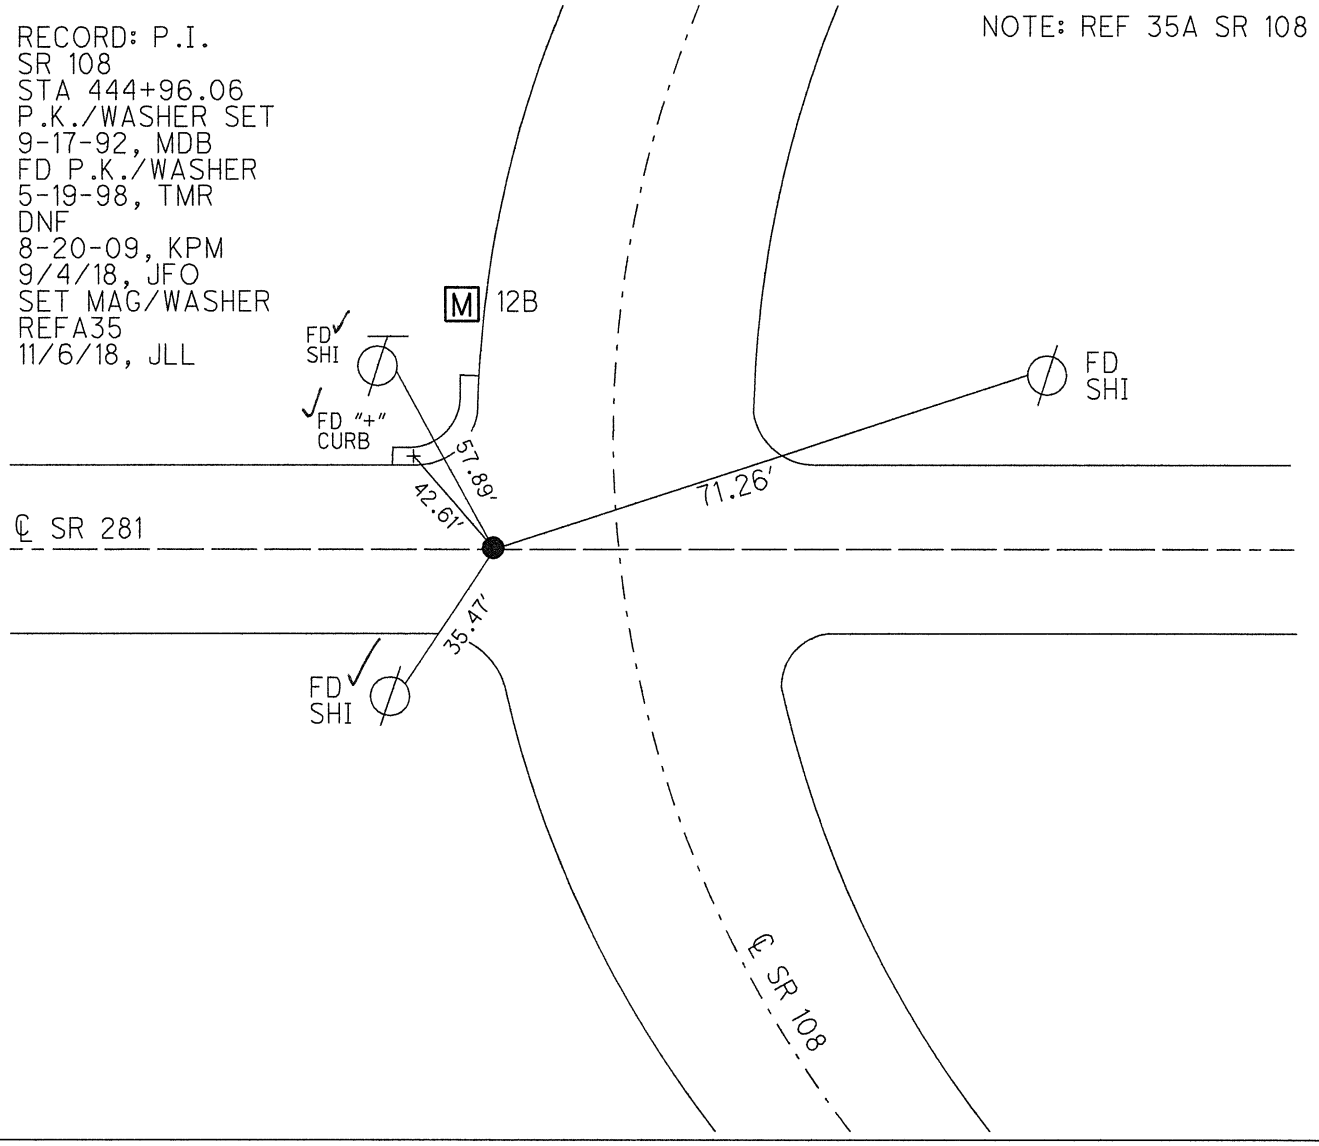

O.D.O.T. DISTRICT 2 SURVEY OFFICE (USE ONLY)

PERSONNEL

REFERENCE NO. 12 B

SHEET 18 OF 20

NOTES CANTERBURY
H.C. ROUSOS
R.C. HUSS

DATE 5-19-98
WEATHER SUNNY
TEMP. +80°


ROUTE SR 281
COUNTY HENRY
TOWNSHIP FLAT ROCK
SECTION 25

DWG BY JAMES

PID 102763

T 4 N R 6 E

TYPE MONUMENT MONBOX
ON SURFACE - ~~BELOW~~ ON
OFFSET ℄ PAVEMENT - ~~LT~~ : ~~RT~~
- TO - EDGE PAVEMENT
STATION: 301+48.8

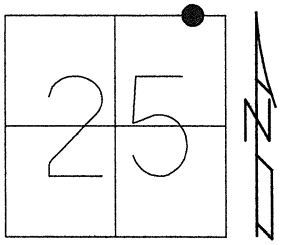


HORZ.DATUM: NAD83 2011

GEOID: NAVD88 2012A

GRID: NORTHING: 592978.643

EASTING: 1523934.676

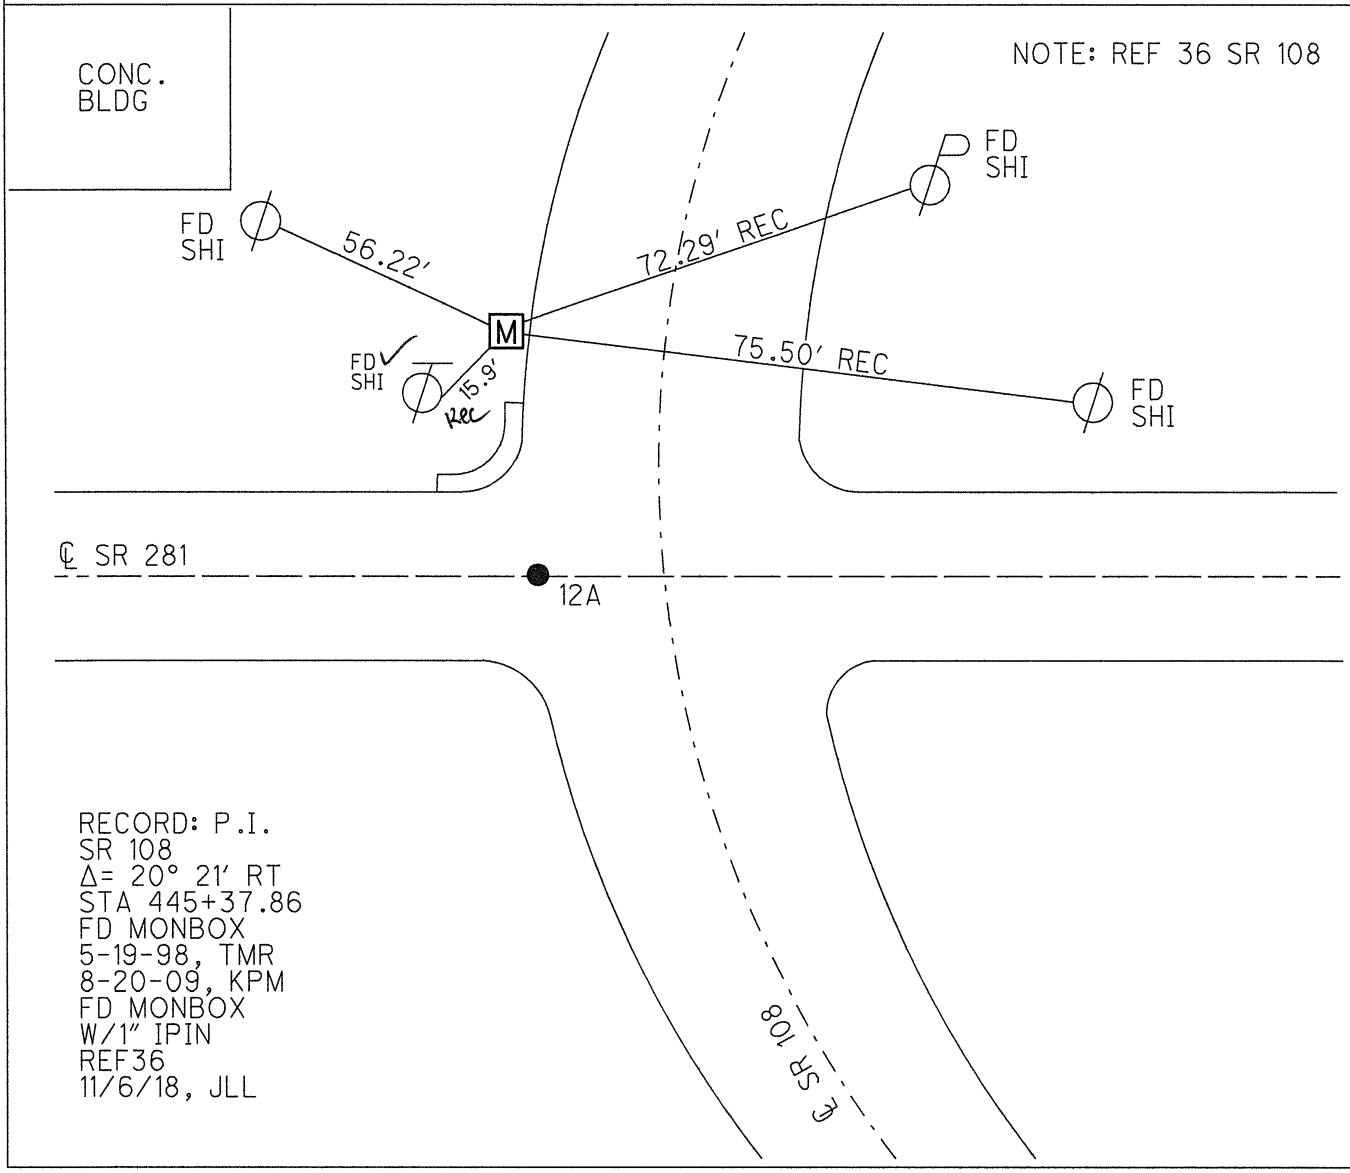

RECORD: P.I.
SR 108
Δ= 20° 21' RT
STA 445+37.86
FD MONBOX
5-19-98, TMR
8-20-09, KPM
FD MONBOX
W/1" IPIN
REF36
11/6/18, JLL

O.D.O.T. DISTRICT 2 SURVEY OFFICE (USE ONLY)

PERSONNEL

REFERENCE NO. 13

SHEET 19 OF 20


NOTES ASTON
H.C. NEISE
R.C. PRESTON-COLVIN

DATE 11/26/24
WEATHER WINDY
TEMP. 40°

ROUTE SR 281
COUNTY HENRY
TOWNSHIP FLATROCK
SECTION 25
T 4 N R 7 E


DWG BY PRESTON-COLVIN PID PAVING TRAIN

TYPE MONUMENT SM R.R. SPIKE
ON SURFACE - BELOW 2"
OFFSET ℄ PAVEMENT ON LT : RT
10.4' TO LT EDGE PAVEMENT
STATION: 311+54.80

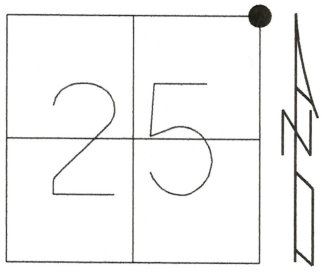

HORZ.DATUM: NAD83 2011 GEOID: 18
GRID: NORTHING: 592909.261 EASTING: 1524915.154
LDP: NORTHING: 449162.5 EASTING: 160167.9

RECORD:
FD SM RR SPK
8-18-98, MB
SET P.K./WASHER
9-28-98, MB
FD MAG/WASHER
REF13
11-2-16
2" DOWN
9/4/18, JFO
FD SM RRSPK
2" DOWN
7/2/24, TDN
REF13
FD SM RRSPK
11/26/24, TDN
FD SM RR SPIKE
REF 13
4-30-26, TDN

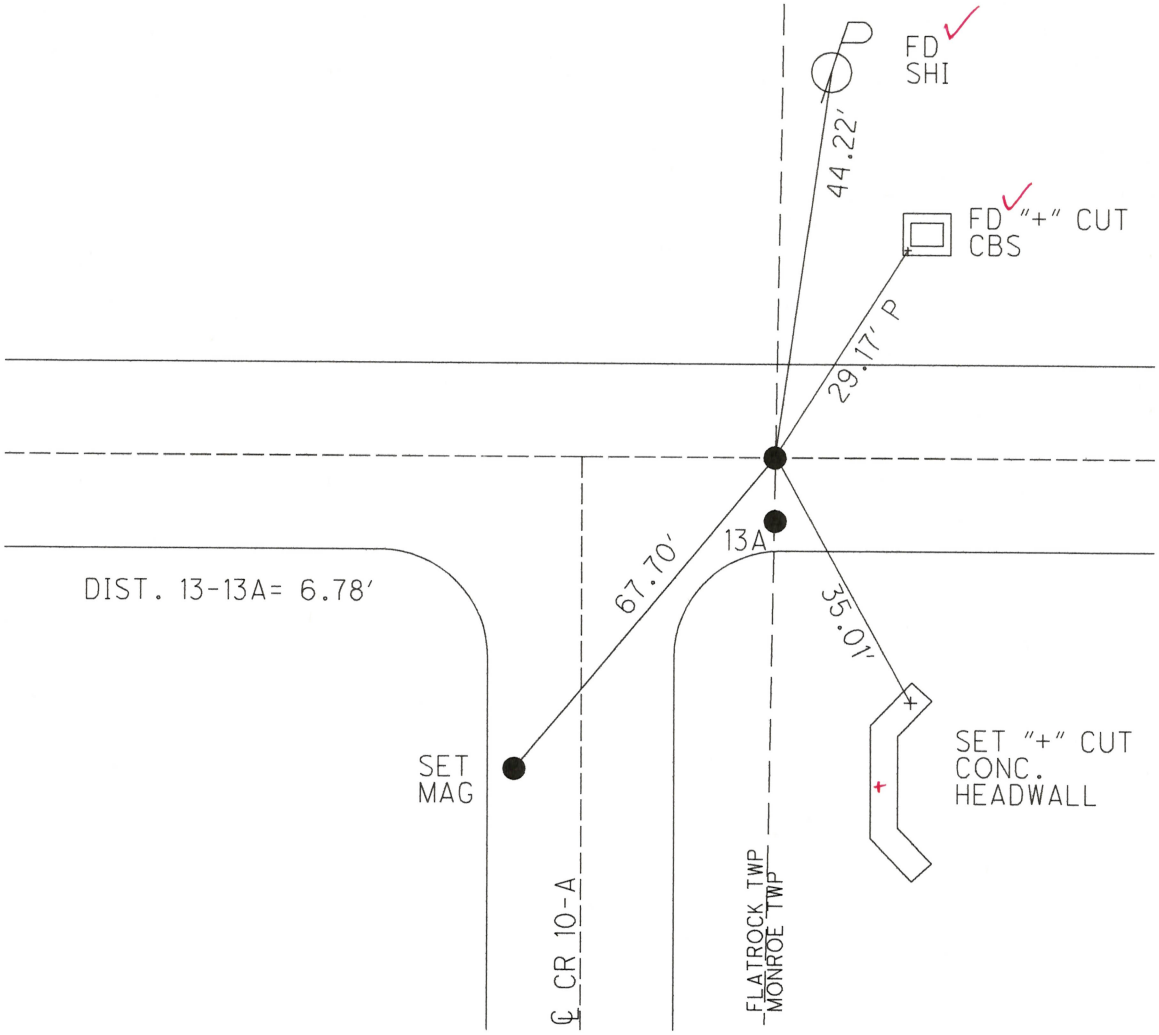

O.D.O.T. DISTRICT 2 SURVEY OFFICE (USE ONLY)

PERSONNEL

REFERENCE NO. 13 A

SHEET 20 OF 20


NOTES PRESTON-COLVIN
H.C. NEISE
R.C. PRESTON-COLVIN

DATE 11/26/24
WEATHER WINDY
TEMP. 40°

ROUTE SR 281
COUNTY HENRY
TOWNSHIP FLATROCK
SECTION 25
T 4 N R 7 E

DWG BY PRESTON-COLVIN PID PAVING TRAIN


TYPE MONUMENT P.K. NAIL
ON SURFACE - ~~BELOW~~ ON
OFFSET ℄ PAVEMENT 6.8' ~~LT~~ : RT
4.3' TO RT EDGE PAVEMENT
STATION: 311+54.55

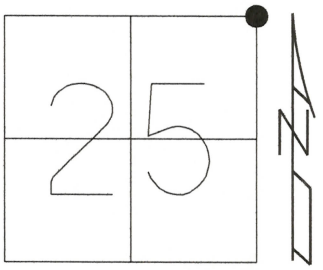

HORZ.DATUM: NAD83 2011 GEOID: 18
GRID: NORTHING: 592902.470 EASTING: 1524914.835
LDP: NORTHING: 449155.7 EASTING: 160167.7

RECORD:
FD SM RR SPK
8-18-98, TMR
SET P.K./WASHER
9-28-98, MB
FD MAG/WASHER
REFA13
11-2-16, JFO
FD P.K.NAIL
REFA13
9/4/18, JFO
FD PK NAIL
7/2/24, TDN
REF13A
FD PK NAIL
11/26/24, TDN

FD PK NAIL
REF13A
4-30-26, TDN

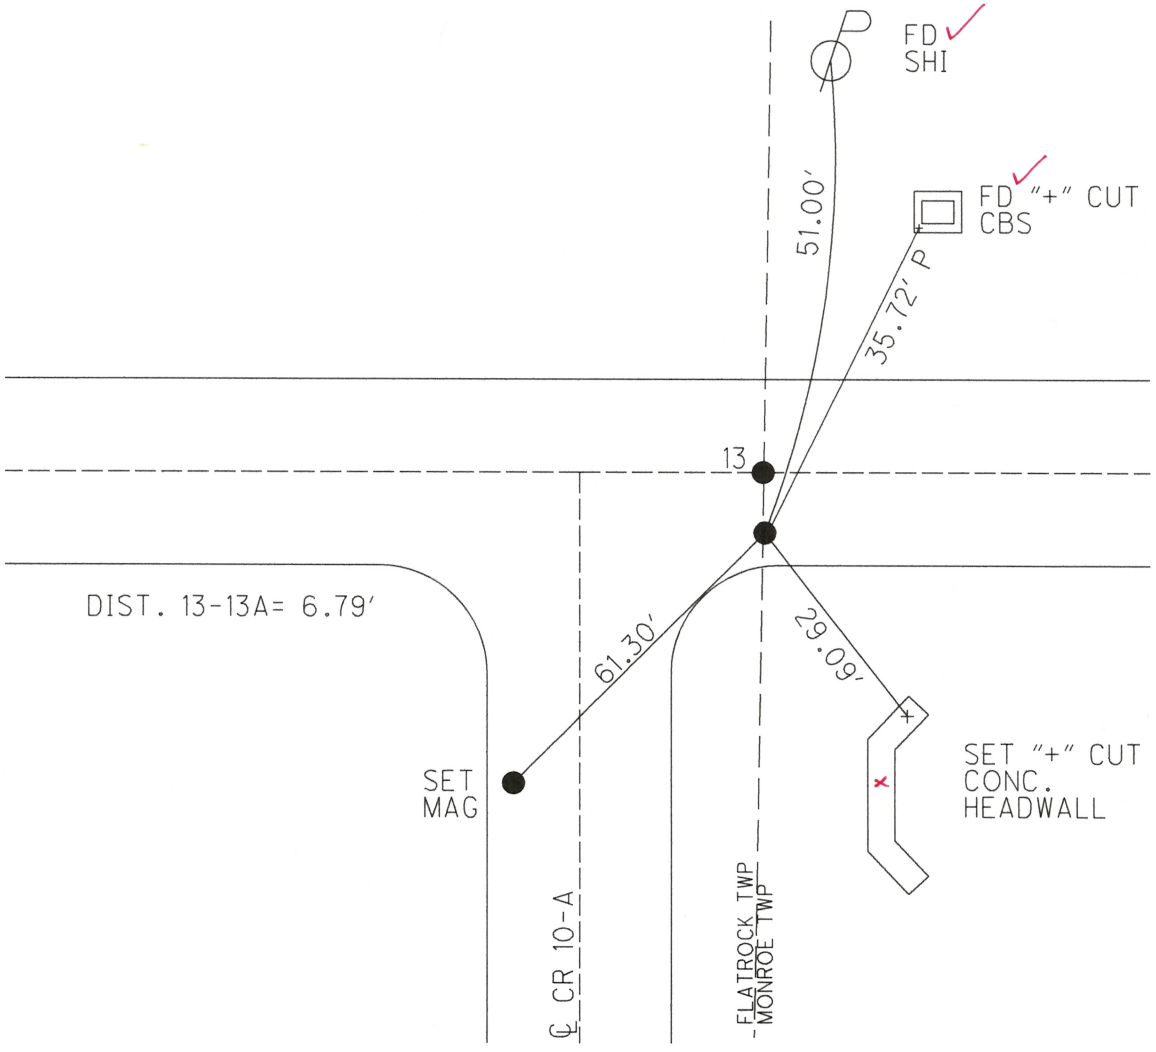

O.D.O.T. DISTRICT 2 SURVEY OFFICE (USE ONLY)

PERSONNEL

REFERENCE NO. 13 B

SHEET 1 OF 34

NOTES PRESTON-COLVIN
H.C. NEISE
R.C. PRESTON-COLVIN


DATE 11/26/24
WEATHER WINDY
TEMP. 40°

ROUTE SR 281
COUNTY HENRY
TOWNSHIP MONROE
SECTION 19

DWG BY PRESTON-COLVIN PID PAVING TRAIN

T 4 N R 7 E


TYPE MONUMENT MAG/WASHER
ON SURFACE - ~~BELOW~~ ON
OFFSET ℄ PAVEMENT 8.4' ~~LT~~ : RT
1.93' TO RT EDGE PAVEMENT
STATION: 324+54

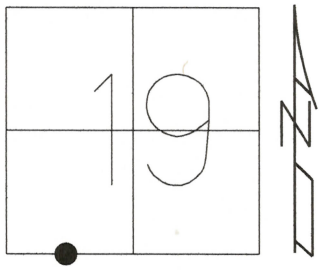

HORZ.DATUM: NAD83 2011 GEOID: 18
GRID: NORTHING: 592882.933 EASTING: 1526249.468
LDP: NORTHING: 449160.6 EASTING: 161502.6

RECORD:
STA 324+84.4
1/4-1/4 SEC 19
FD SM R.R. SPIKE
1 1/2" DOWN
8/18/98, MB
SET P.K./WASHER
9/28/98, MB
FD SM.R.R.SPIKE
5" DOWN
REFB13
9/4/18, JFO
7/25/19, JMR
FD SM RSPK
2" DOWN
REF13B
7/2/24, TDN
SET MAG/WASHER
11/26/24, TDN

FD MAG WASHER
REF 13B
4-30-26, TDN

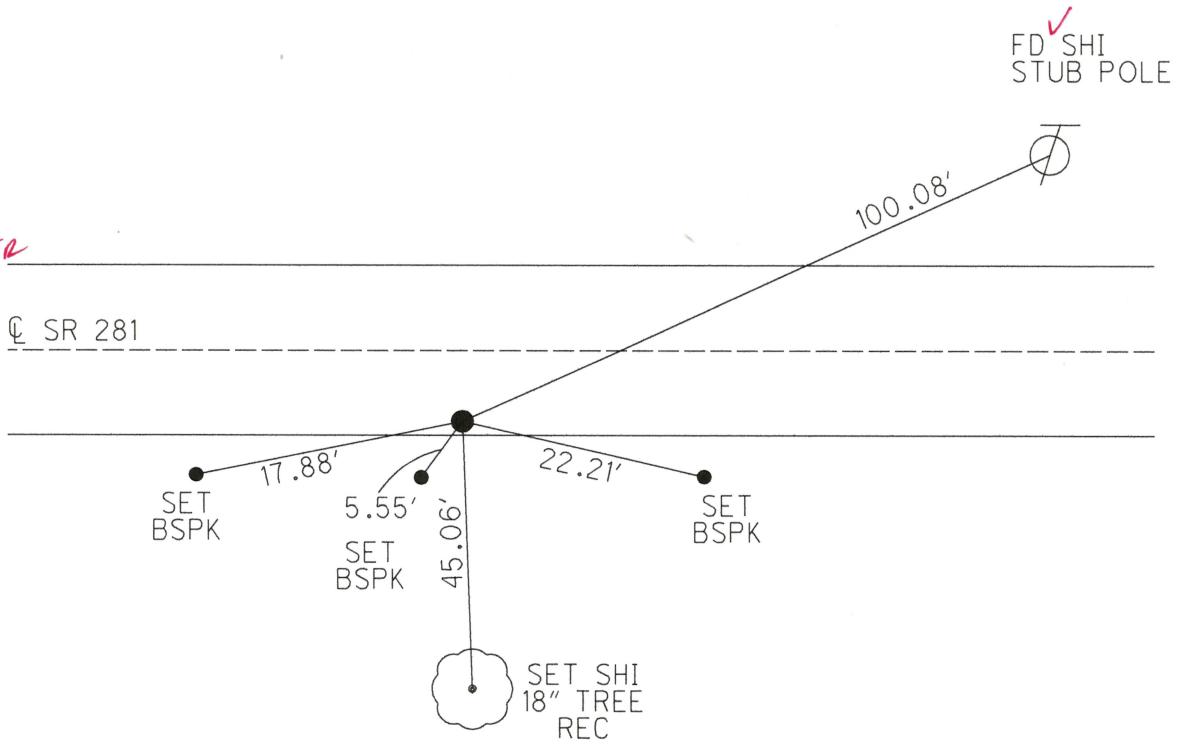

O.D.O.T. DISTRICT 2 SURVEY OFFICE (USE ONLY)

PERSONNEL

REFERENCE NO. 14

SHEET 2 OF 34


NOTES PRESTON-COLVIN
H.C. NEISE
R.C. PRESTON-COLVIN

DATE 11/26/24
WEATHER WINDY
TEMP. 40°

ROUTE SR 281
COUNTY HENRY
TOWNSHIP MONROE
SECTION 19
T 4 N R 7 E


DWG BY PRESTON-COLVIN PID PAVING TRAIN

TYPE MONUMENT P.K WASHER
ON SURFACE - ~~BELOW~~ ON
OFFSET ℄ PAVEMENT 7.8' ~~LT~~ : RT
2.9' TO RT EDGE PAVEMENT
STATION: 337+74

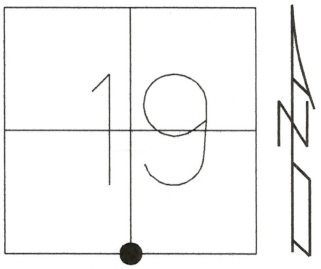

HORZ.DATUM: NAD83 2011 GEOID: 18
GRID: NORTHING: 592863.468 EASTING: 1527569.321
LDP: NORTHING: 449165.5 EASTING: 162822.7

RECORD:
STA 338+04.5
FD SM.R.R.SPIKE
8/18/98, MB
SET P.K./WASHER
9/29/98, MB
FD P.K./WASHER
REF14
9/4/18, JFO
7/25/19, JMR
FD PK/WASHER
REF14
7/2/24, TDN
FD PK/WASHER
11/26/24, TDN
FD PK WASHER
REF14
4-30-26, TDN

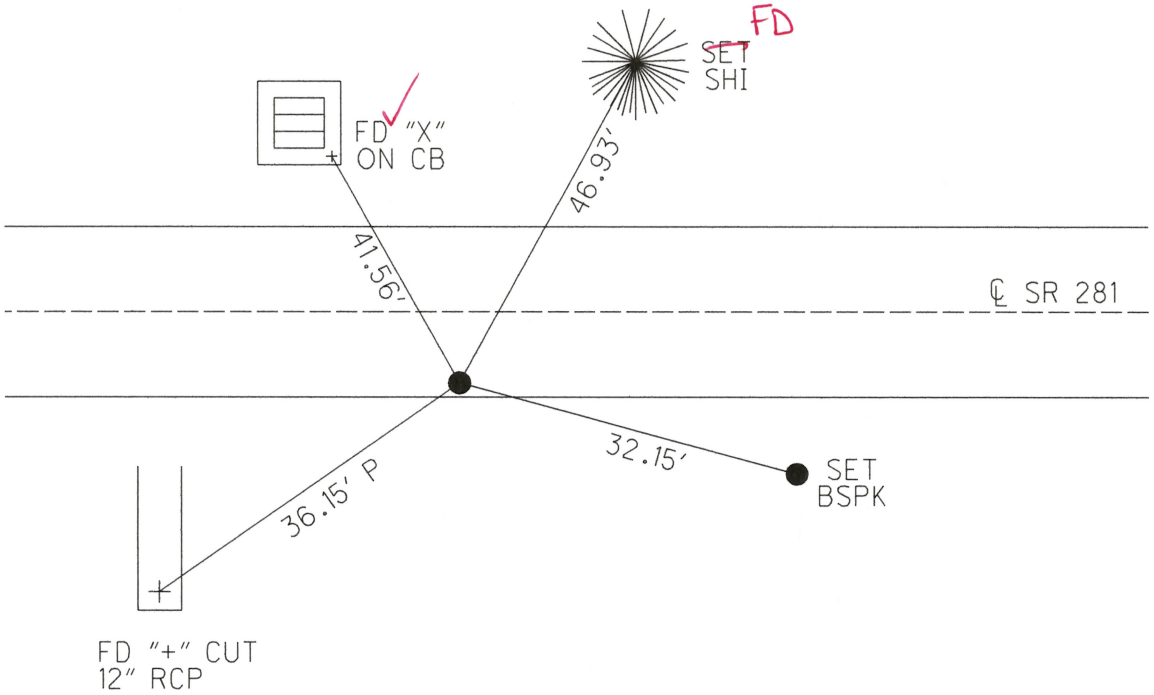

O.D.O.T. DISTRICT 2 SURVEY OFFICE (USE ONLY)

PERSONNEL

REFERENCE NO. 14 A

SHEET 3 OF 34

NOTES PRESTON-COLVIN
H.C. NEISE
R.C. PRESTON-COLVIN


DATE 11/26/24
WEATHER WINDY
TEMP. 40°

ROUTE SR 281
COUNTY HENRY
TOWNSHIP MONROE
SECTION 19

DWG BY PRESTON-COLVIN PID PAVING TRAIN


T 4 N R 7 E

TYPE MONUMENT P.K WASHER
ON SURFACE - ~~BELOW~~ ON
OFFSET ℄ PAVEMENT 6.5' ~~LT~~ : RT
4.1' TO RT EDGE PAVEMENT
STATION: 350+99

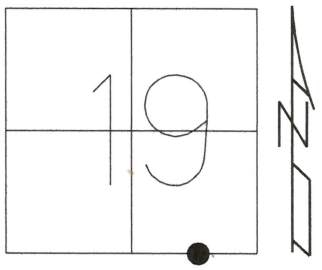

HORZ.DATUM: NAD83 2011 GEOID: 18
GRID: NORTHING: 592844.073 EASTING: 1528893.769
LDP: NORTHING: EASTING:

RECORD:
351+29.4
1/4-1/4 SEC 19
FD P.K./WASHER
REFA14
9/4/18, JFO
7/25/19, JMR
FD PK/WASHER
7/19/24,TDN
FD PK/WASHER
REF14A
11/26/24, TDN
FD PK WASHER
REF 14A
4-30-26, TDN

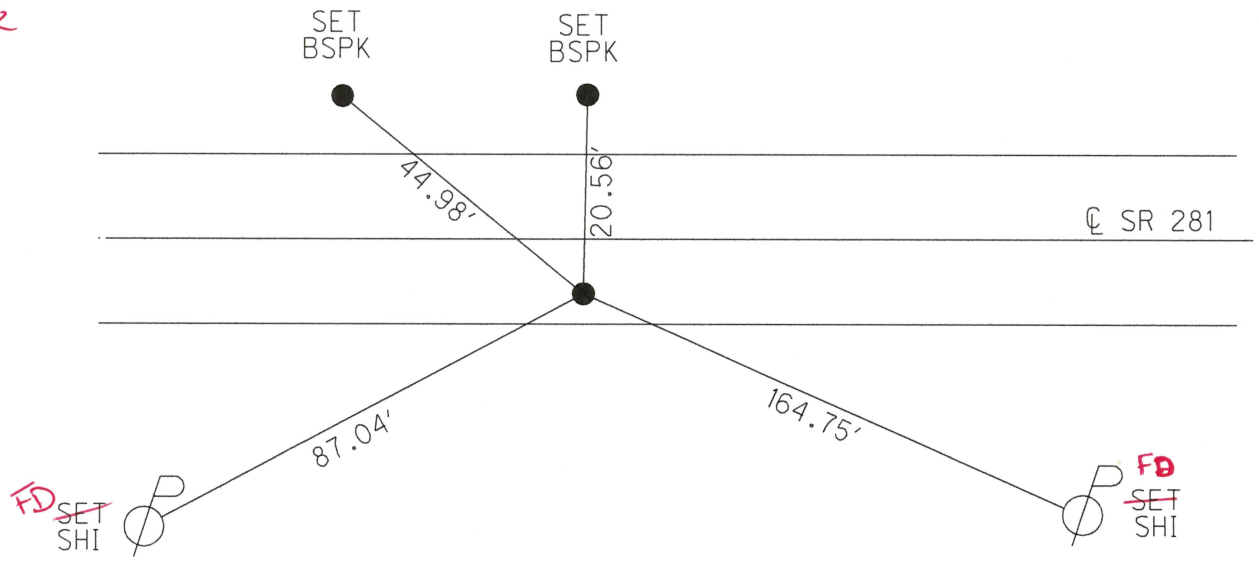

O.D.O.T. DISTRICT 2 SURVEY OFFICE (USE ONLY)

PERSONNEL

REFERENCE NO. 15

SHEET 4 OF 34


NOTES PRESTON-COLVIN
H.C. NEISE
R.C. PRESTON-COLVIN

DATE 11/26/24
WEATHER WINDY
TEMP. 40°

ROUTE SR 281
COUNTY HENRY
TOWNSHIP MONROE
SECTION 19
T 4 N R 7 E


DWG BY PRESTON-COLVIN PID PAVING TRAIN

TYPE MONUMENT LG RR SPIKE
~~ON SURFACE~~ - BELOW 2.5"
OFFSET ℄ PAVEMENT 5.4' ~~LT~~ : RT
- TO - EDGE PAVEMENT
STATION: 364+24

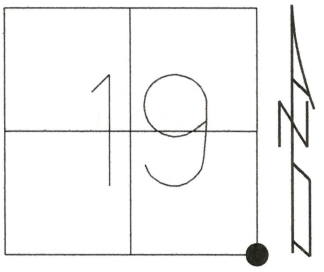

HORZ.DATUM: NAD83 2011 GEOID: 18
GRID: NORTHING: 592825.025 EASTING: 1530281.756
LDP: NORTHING: 449175.6 EASTING: 165472.6

RECORD:
STA 364+54.39
FD SM.R.R.SPIKE
8/18/98, MB
SET P.K./WASHER
9/28/98, MB
FD LG.R.R.SPIKE
REF15
9/4/18, JFO
7/25/19, JMR
FD LG RR SPIKE
2.5" DOWN
REF15
7/22/24, TDN
FD LG RR SPIKE
11/26/24, TDN
FD LG RR SPIKE
REF15
4-30-26, TDN

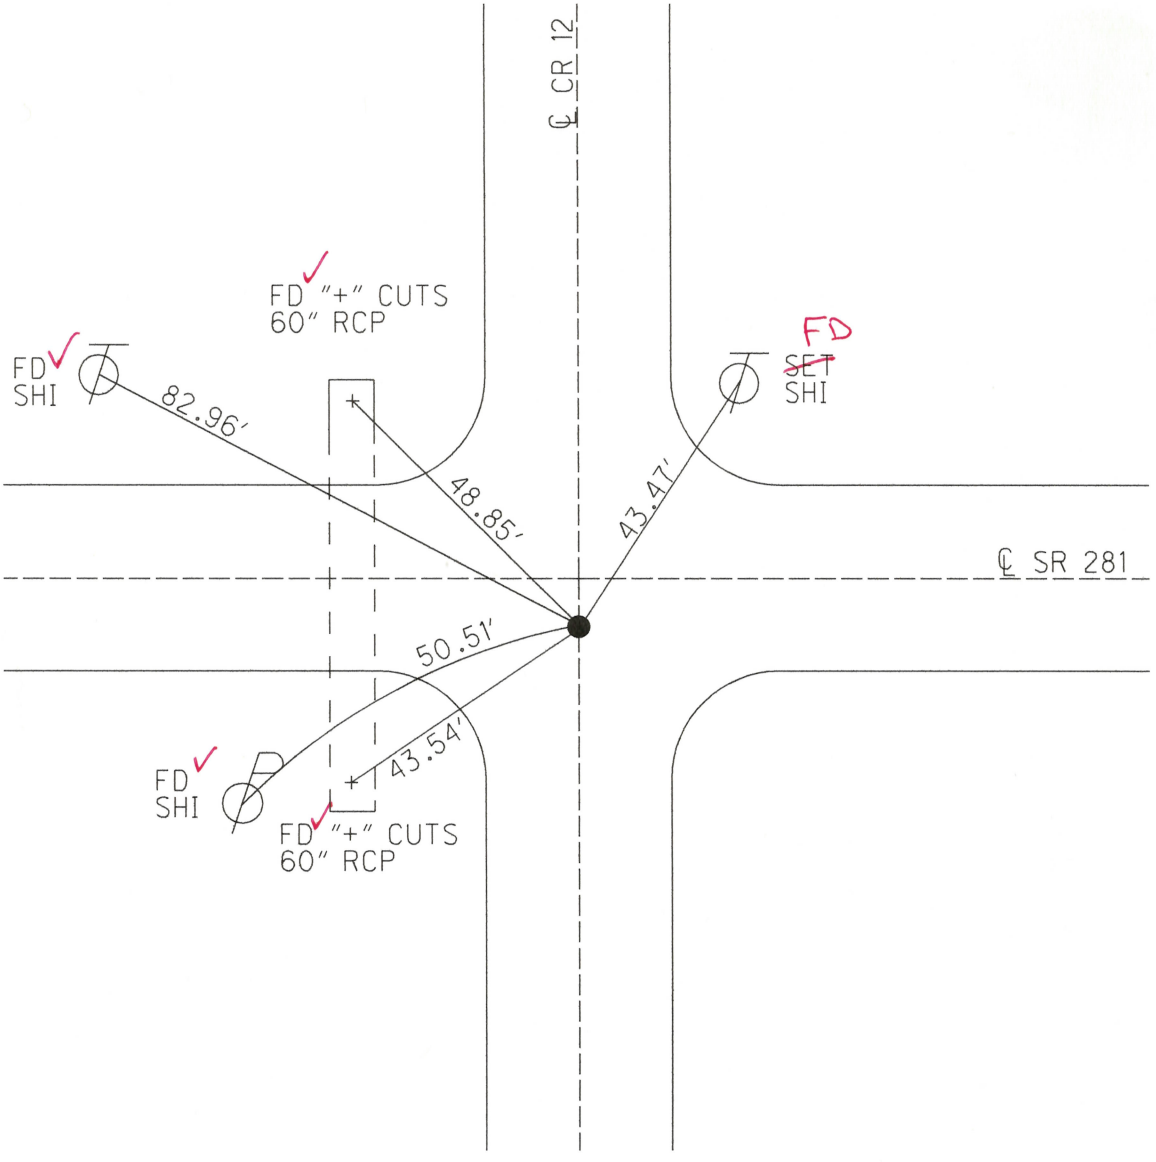

O.D.O.T. DISTRICT 2 SURVEY OFFICE (USE ONLY)

PERSONNEL

REFERENCE NO. 15 A

SHEET 5 OF 34


NOTES PRESTON-COLVIN
H.C. NEISE
R.C. PRESTON-COLVIN

DATE 11/26/24
WEATHER WINDY
TEMP. 40°

ROUTE SR 281
COUNTY HENRY
TOWNSHIP MONROE
SECTION 20
T 4 N R 7 E


DWG BY PRESTON-COLVIN PID PAVING TRAIN

TYPE MONUMENT PK/WASHER
ON SURFACE - ~~BELOW~~ ON
OFFSET ℄ PAVEMENT 4.6' ~~LT~~ : RT
5.8' TO RT EDGE PAVEMENT
STATION: 377+38

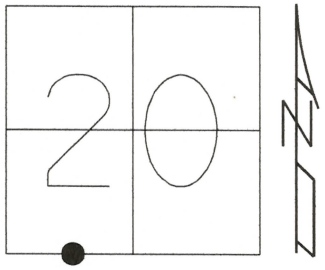

HORZ.DATUM: NAD83 2011 GEOID: 18
GRID: NORTHING: 592818.577 EASTING: 1531532.834
LDP: NORTHING: 449193.3 EASTING: 166786.7

RECORD:
STA 377+69.10
1/4-1/4 PT SEC 20
FD SM.R.R.SPIKE
8/18/98, MB
SET P.K./WASHER
9/28/98, MB
FD P.K./WASHER
REFA15
9/4/18, JFO
7/25/19, JFO
FD PK/WASHER
REF15A
7/22/24, TDN
FD PK/WASHER
11/26/24, TDN
FD PK/WASHER
REF22A
4-30-26, TDN

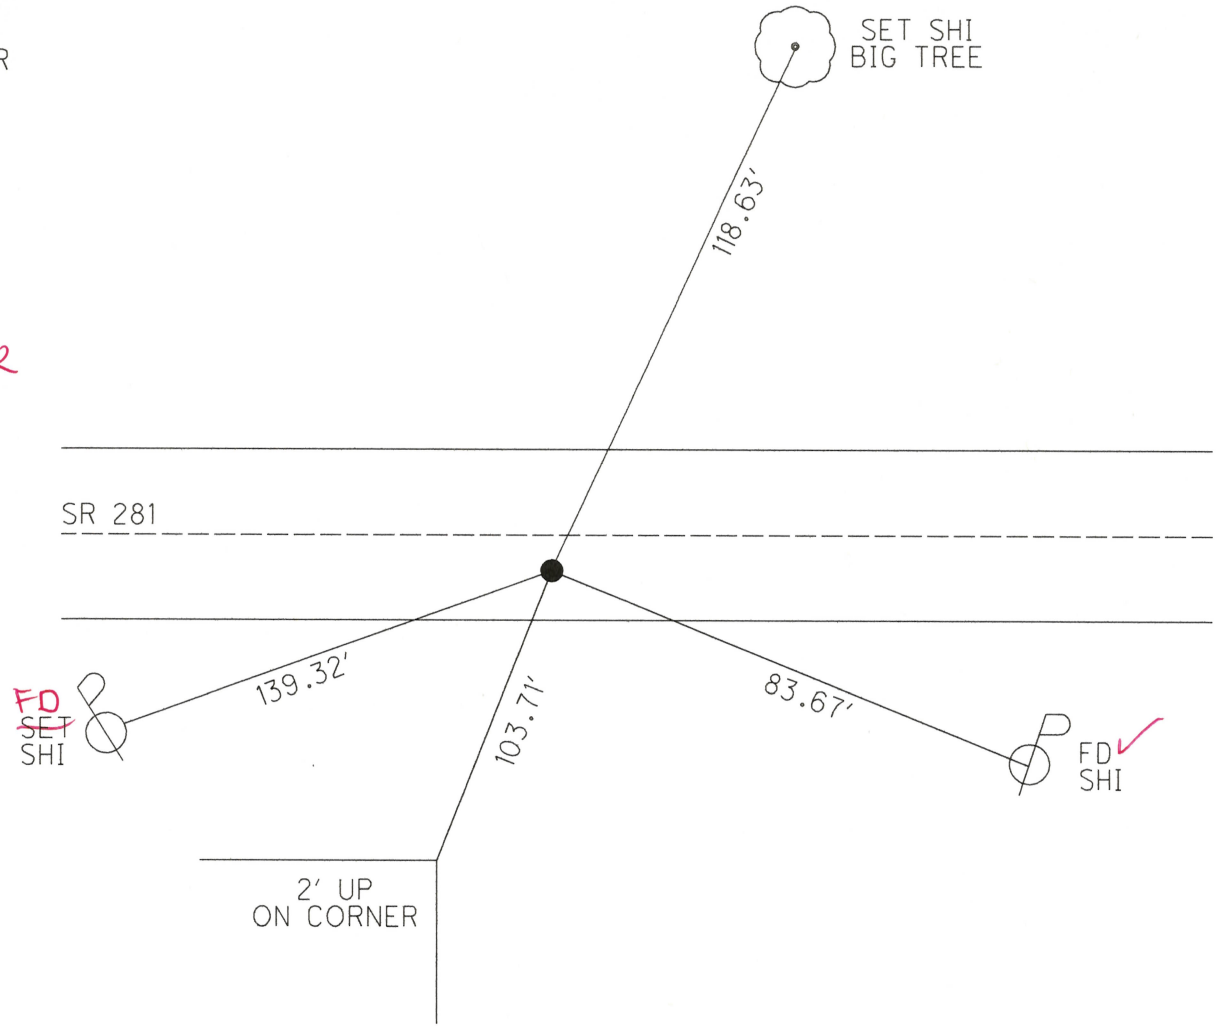

O.D.O.T. DISTRICT 2 SURVEY OFFICE (USE ONLY)

PERSONNEL

REFERENCE NO. 16

SHEET 6 OF 34


NOTES PRESTON-COLVIN
H.C. NEISE
R.C. PRESTON-COLVIN

DATE 11/26/24
WEATHER WINDY
TEMP. 40°

ROUTE SR 281
COUNTY HENRY
TOWNSHIP MONROE
SECTION 20
T 4 N R 7 E


DWG BY PRESTON-COLVIN PID PAVING TRAIN

TYPE MONUMENT SHANK
ON SURFACE - ~~BELOW~~ ON
OFFSET ℄ PAVEMENT 2.7' ~~LT~~ : RT
8.4' TO RT EDGE PAVEMENT
STATION: 390+54

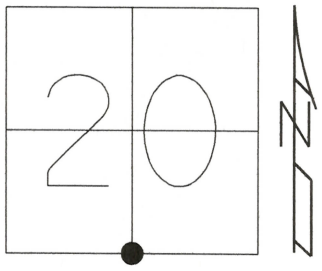

HORZ.DATUM: NAD83 2011 GEOID: 18
GRID: NORTHING: 592812.011 EASTING: 1532846.974
LDP: NORTHING: 449210.8 EASTING: 168100.8

RECORD:
STA 390+83.6
FD SM.R.R.SPIKE
8/18/98, MB
SET P.K./WASHER
9/28/98, MB
FD P.K./WASHER
REF16
9/4/18, JFO
7/26/19, JMR
FD SHANK
REF16
7/22/24, TDN
FD SHNAK
11/26/24, TDN
FD SHANK
REF 16
4-30-26, TDN

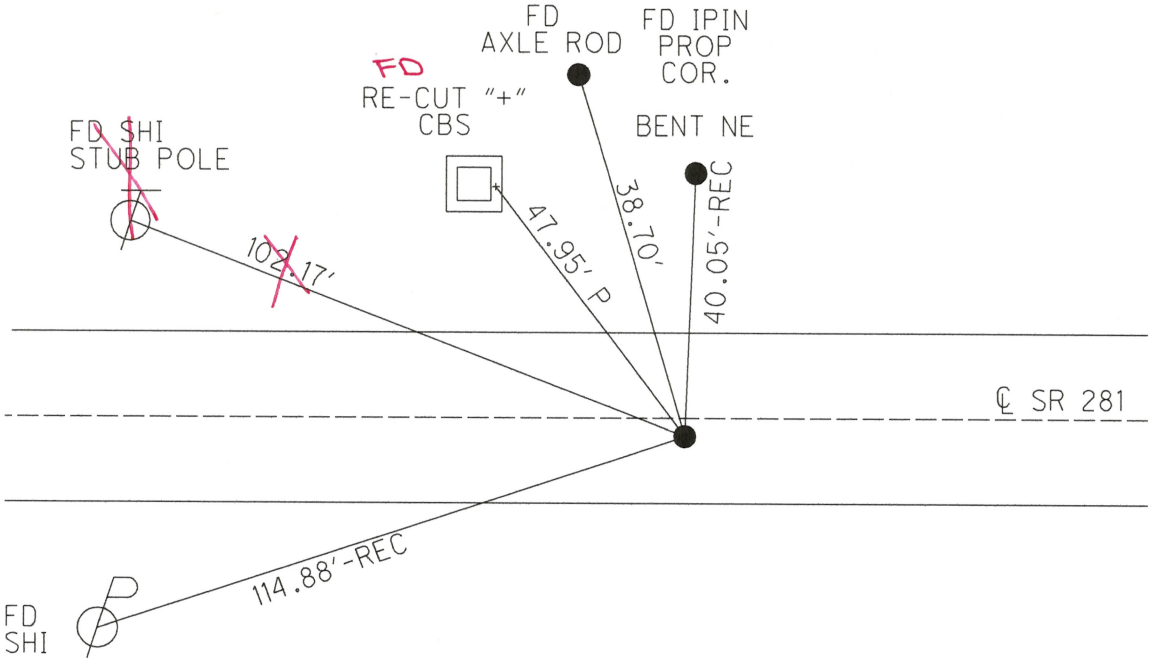

O.D.O.T. DISTRICT 2 SURVEY OFFICE (USE ONLY)

PERSONNEL

REFERENCE NO. 16 AA

SHEET 7 OF 34


NOTES PRESTON-COLVIN
H.C. NEISE
R.C. PRESTON-COLVIN

DATE 11/26/24
WEATHER WINDY
TEMP. 40°

ROUTE SR 281
COUNTY HENRY
TOWNSHIP MONROE
SECTION 20
T 4 N R 7 E

DWG BY PRESTON-COLVIN PID PAVING TRAIN


TYPE MONUMENT ~~PK NAIL~~ MAG NAIL
ON SURFACE - ~~BELOW~~ ON
OFFSET ℄ PAVEMENT 4.4' ~~LT~~ : RT
6.9' TO RT EDGE PAVEMENT
STATION: 403+83

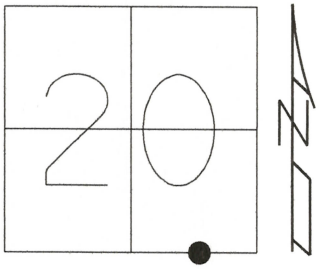

HORZ.DATUM: NAD83 2011 GEOID: 18
GRID: NORTHING: 592785.291 EASTING: 1534175.495
LDP: NORTHING: 449208.4 EASTING: 169429.7

NOTE:
FD MAG NAIL
ORIGIN UNKNOWN
REFAA16
FD MAG NAIL
REF 16AA
7/22/24, TDN
FD MAG NAIL
11/26/24, TDN
FD MAG NAIL
REF 16AA
4-30-26, TDN

DIST. 16AA-16A= 1.06'

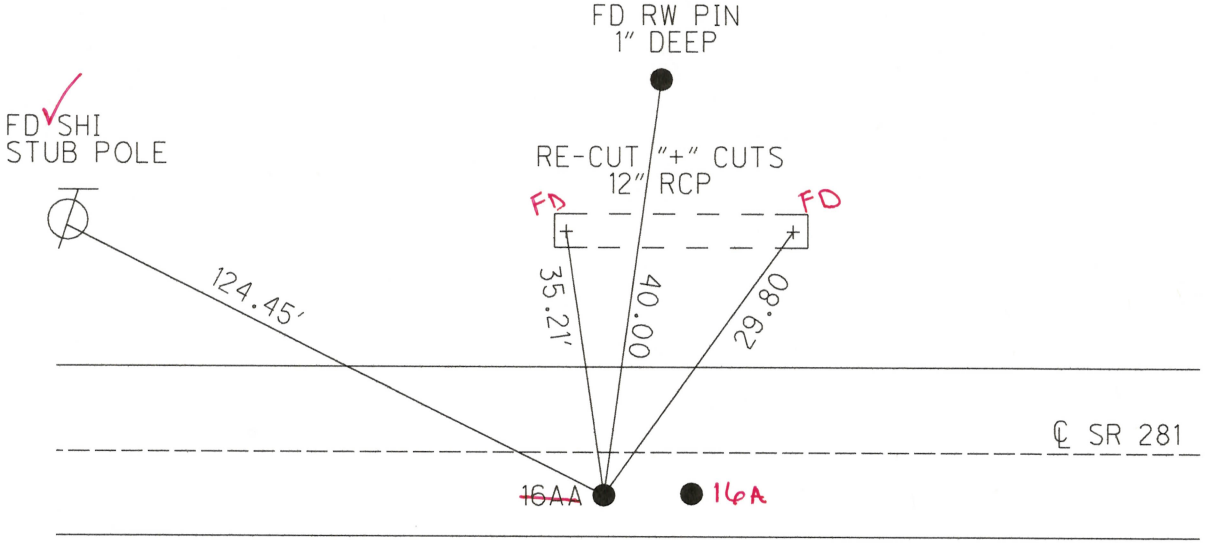

Will need to pull points and locate RSPK in Procon

O.D.O.T. DISTRICT 2 SURVEY OFFICE (USE ONLY)

PERSONNEL

REFERENCE NO. 16 A

SHEET 7 OF 34


NOTES PRESTON-COLVIN
H.C. NEISE
R.C. PRESTON-COLVIN

DATE 11/26/24
WEATHER WINDY
TEMP. 40°

ROUTE SR 281
COUNTY HENRY
TOWNSHIP MONROE
SECTION 20
T 4 N R 7 E

DWG BY PRESTON-COLVIN PID PAVING TRAIN


TYPE MONUMENT PK NAIL ✓
ON SURFACE - ~~BELOW~~ ON
OFFSET ℄ PAVEMENT 4.4' ~~LT~~ : RT
6.9' TO RT EDGE PAVEMENT
STATION: 403+83

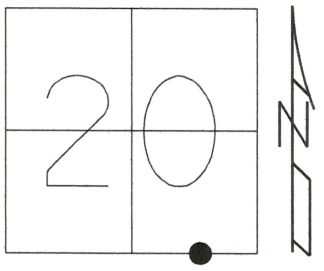

HORZ.DATUM: NAD83 2011 GEOID: 18
GRID: NORTHING: 592785.261 EASTING: 1534176.568
LDP: NORTHING: 449208.4 EASTING: 169430.8

RECORD:
STA 404+12.25
1/4-1/4 SEC 20
FD SM.R.R.SPIKE
8/18/98, MB
SET P.K./WASHER
9/28/98, MB
FD P.K.NAIL
REF16A
9/4/18, JFO
7/25/19, JMR
FD PK NAIL
REF 16A
7/22/24, TDN
FD PK NAIL
11/26/24, TDN
FD PK NAIL
REF16A
4-30-26, TDN

DIST. 16AA-16A= 1.06'

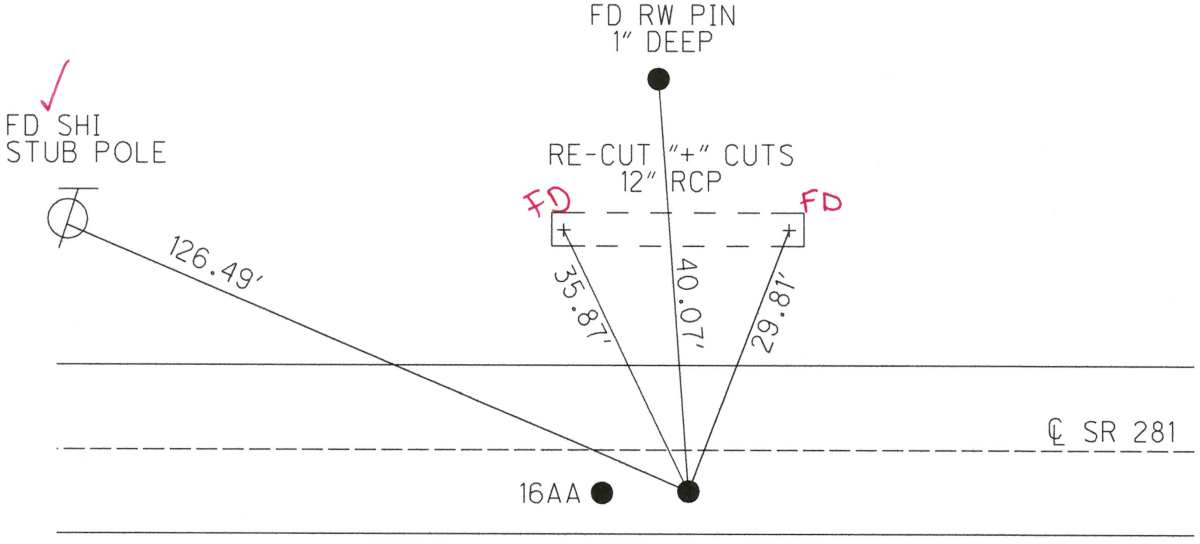

O.D.O.T. DISTRICT 2 SURVEY OFFICE (USE ONLY)

PERSONNEL

REFERENCE NO. 17

SHEET 8 OF 34


NOTES PRESTON-COLVIN
H.C. NEISE
R.C. PRESTON-COLVIN

DATE 11/26/24
WEATHER WINDY
TEMP. 40°

ROUTE SR 281
COUNTY HENRY
TOWNSHIP MONROE
SECTION 20
T 4 N R 7 E

DWG BY PRESTON-COLVIN PID PAVING TRAIN


TYPE MONUMENT RR SPIKE
~~ON SURFACE~~ - BELOW 2"
OFFSET ℄ PAVEMENT 5.8' ~~LT~~ : RT
- TO - EDGE PAVEMENT
STATION: 417+12

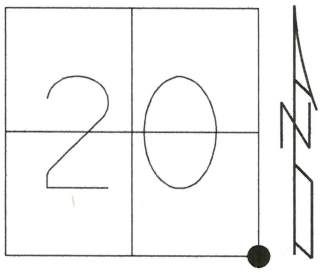

HORZ.DATUM: NAD83 2011 GEOID: 18
GRID: NORTHING: 592785.291 EASTING: 1534175.495
LDP: NORTHING: 449208.4 EASTING: 169429.7

RECORD:
STA 417+41.3
FD SM.R.R.SPIKE
8/18/98, TMR
SET P.K./WASHER
9/28/98, MB
FD RR SPIKE
3" DOWN
REF17
9/4/18, JFO
7/25/19, JMR
FD RR SPIKE
2" DOWN
REF 17
7/22/24, TDN
FD RR SPIKE
2" DOWN
11/26/24, TDN

FD RR SPIKE
REF17
4-30-26, TDN

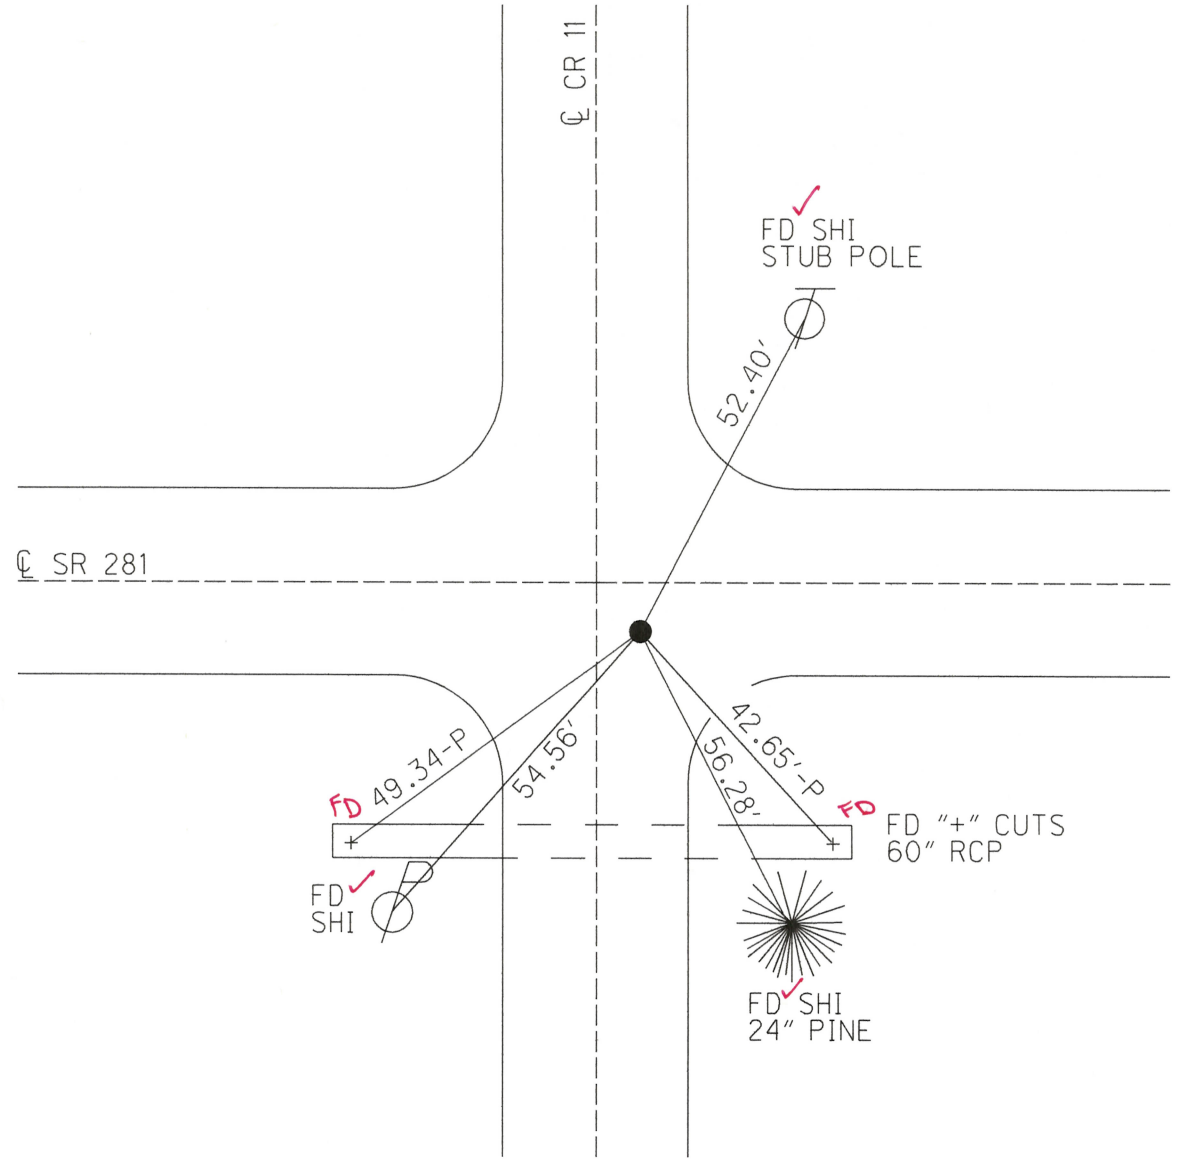

O.D.O.T. DISTRICT 2 SURVEY OFFICE (USE ONLY)

PERSONNEL

REFERENCE NO. 18

SHEET 9 OF 34


NOTES PRESTON-COLVIN
H.C. NEISE
R.C. PRESTON-COLVIN

DATE 11/26/24
WEATHER WINDY
TEMP. 40°

ROUTE SR 281
COUNTY HENRY
TOWNSHIP MONROE
SECTION 21
T 4 N R 7 E

DWG BY PRESTON-COLVIN PID PAVING TRAIN


TYPE MONUMENT SM RR SPIKE
~~ON SURFACE~~ - BELOW 2"
OFFSET ℄ PAVEMENT 5.3' ~~LT~~ : RT
5.4' TO RT EDGE PAVEMENT
STATION: 443+59

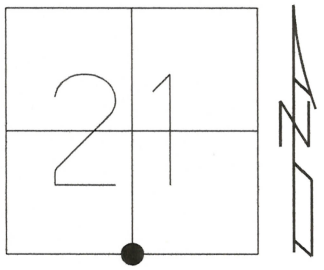

HORZ.DATUM: NAD83 2011 GEOID: 18
GRID: NORTHING: 592723.355 EASTING: 1538149.973
LDP: NORTHING: 449219.4 EASTING: 173404.9

RECORD:
STA 443+87.93
FD SM.R.R.SPIKE
8/18/98, MB
SET P.K./WASHER
9/28/98, MB
FD P.K.NAIL
REF18
9/4/18, JFO
7/25/19, JMR
FD SM RSPK 2" DOWN
REF18
7/22/24, TDN
FD SM RSPK 2" DOWN
11/26/24, TDN

FD SM RR SPIKE
REF18
4-30-26, TDN

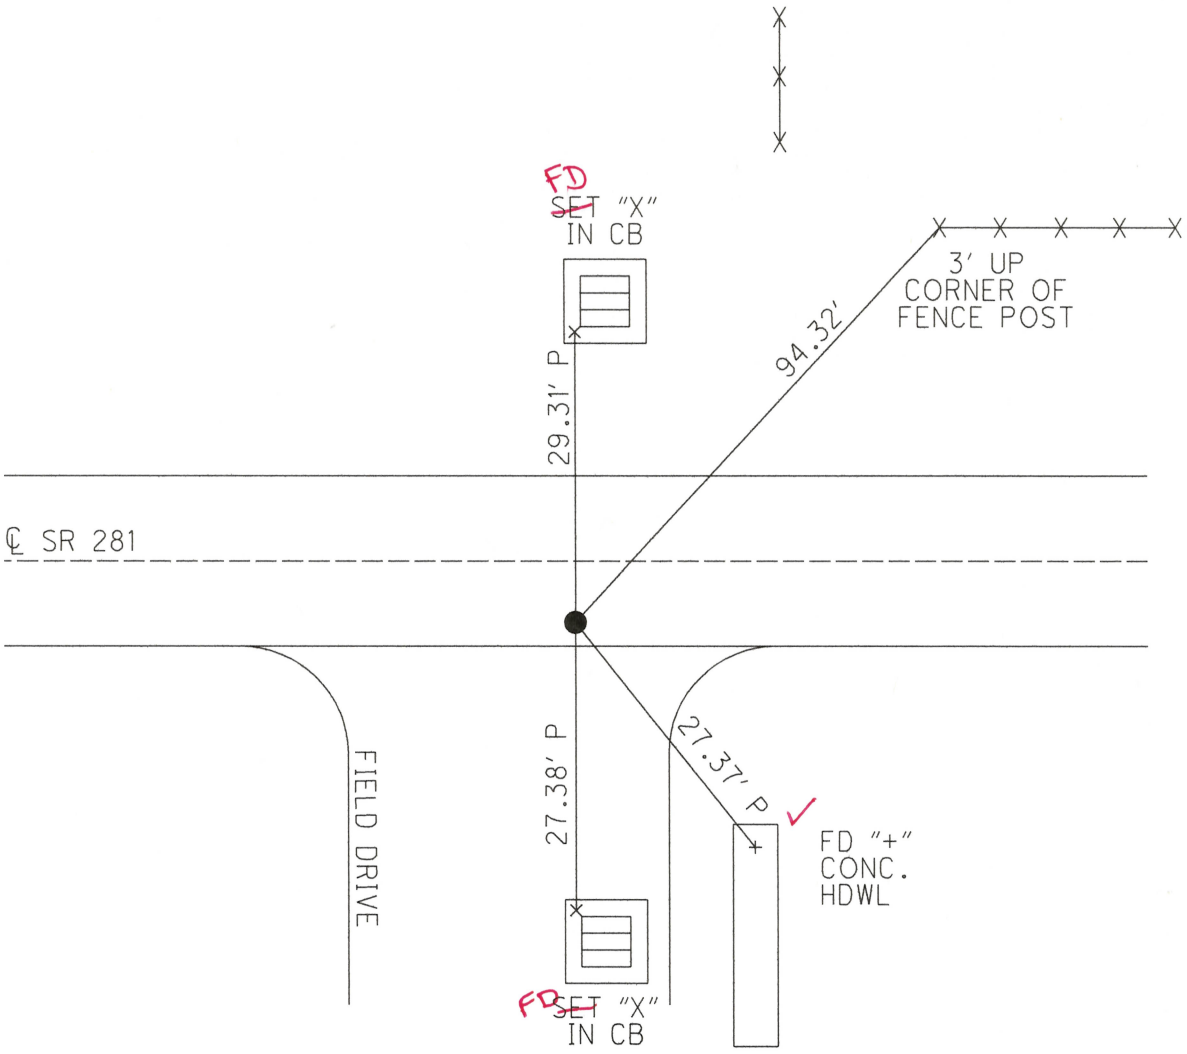

O.D.O.T. DISTRICT 2 SURVEY OFFICE (USE ONLY)

PERSONNEL

REFERENCE NO. 18 A

SHEET 10 OF 34


NOTES PRESTON-COLVIN
H.C. NEISE
R.C. PRESTON-COLVIN

DATE 11/26/24
WEATHER WINDY
TEMP. 40°

ROUTE SR 281
COUNTY HENRY
TOWNSHIP MONROE
SECTION 21
T 4 N R 7 E

DWG BY PRESTON-COLVIN PID PAVING TRAIN

TYPE MONUMENT PK/WASHER
ON SURFACE - ~~BELOW~~ ON
OFFSET ℄ PAVEMENT 5.0' ~~LT~~ : RT
5.4' TO RT EDGE PAVEMENT
STATION: 456+88

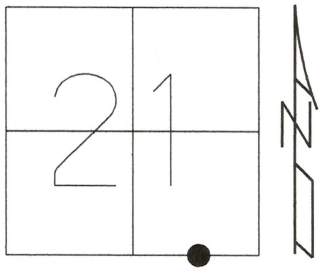

HORZ.DATUM: NAD83 2011 GEOID: 18
GRID: NORTHING: 592702.295 EASTING: 1539478.421
LDP: NORTHING: 449222.7 EASTING: 174733.6

RECORD:
STA 457+16.4
1/4-1/4 POINT SEC 21
FD SM.R.R.SPIKE
8/18/98, MB
SET P.K./WASHER
9/28/98, MB
FD P.K./WASHER
REFA18
9/4/18, JFO
7/25/19, JMR
FD PK/WASHER
REF 18A
7/22/24, TDN
FD PK/WASHER
11/26/24, TDN
FD PK WASHER
REF 18A
4-30-26, TDN

℄ SR 281

FD
~~SET~~
SHI

70.74'

O.D.O.T. DISTRICT 2 SURVEY OFFICE (USE ONLY)

PERSONNEL

REFERENCE NO. 19

SHEET 11 OF 34


NOTES PRESTON-COLVIN
H.C. NEISE
R.C. PRESTON-COLVIN

DATE 11/26/24
WEATHER WINDY
TEMP. 40°

ROUTE SR 281
COUNTY HENRY
TOWNSHIP MONROE
SECTION 22
T 4 N R 7 E

DWG BY PRESTON-COLVIN PID PAVING TRAIN


TYPE MONUMENT SM RR SPIKE
ON SURFACE - ~~BELOW~~ 1.5"
OFFSET ℄ PAVEMENT 5.25' ~~LT~~ : RT
- TO - EDGE PAVEMENT
STATION: 470+16

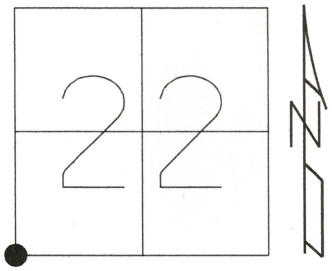

HORZ.DATUM: NAD83 2011 GEOID: 18
GRID: NORTHING: 592681.183 EASTING: 1540806.673
LDP: NORTHING: 449226 EASTING: 176062.2

RECORD:
STA 470+44.45
FD SM.R.R.SPIKE
8/18/98, MB
SET P.K./WASHER
9/28/98, CL
FD RR SPIKE
1½" DOWN
REF19
9/6/18, JFO
7/25/19, JMR
FD RRSPK
1 1/2" DOWN
REF19
7/22/24, TDN
FD RRPSK
11/26/24, TDN

FD SM RR SPIKE
REF19
4-30-26, TDN

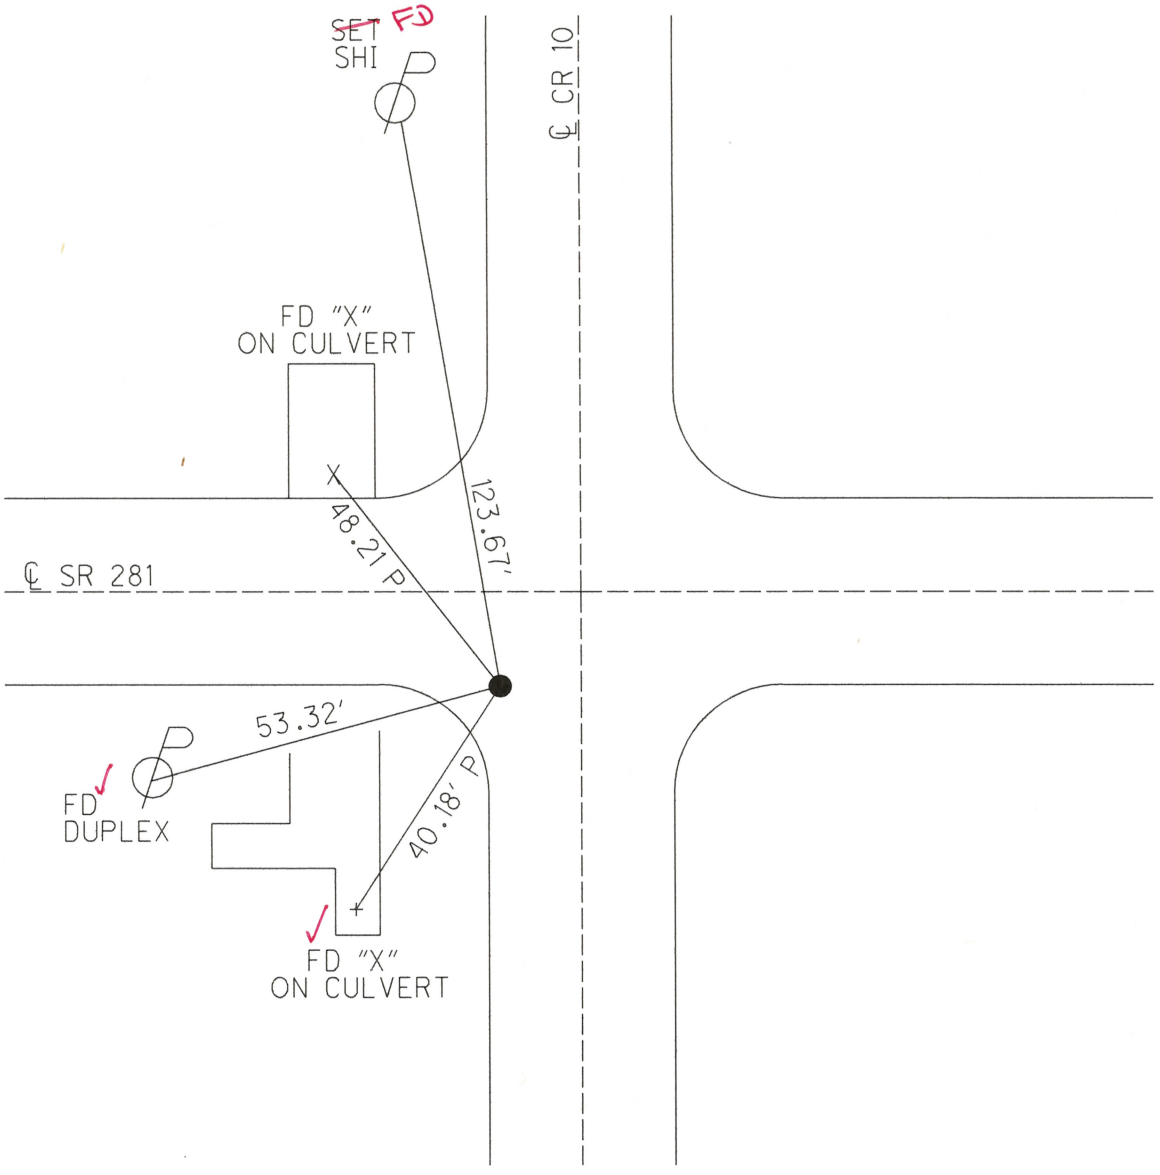

O.D.O.T. DISTRICT 2 SURVEY OFFICE (USE ONLY)

PERSONNEL

REFERENCE NO. 19 A

SHEET 11 OF 34

NOTES PRESTON-COLVIN HAJ

DATE 11/26/24 4-28-26

ROUTE SR 281

H.C. TDN NEISE

WEATHER (WINDY) Cloudy

COUNTY HENRY

R.C. JAB PRESTON-COLVIN

TEMP. 40° 66°

TOWNSHIP MONROE

SECTION 22

DWG BY PRESTON-COLVIN PID PAVING TRAIN

T 4 N R 7 E


TYPE MONUMENT PK NAIL ✓

ON SURFACE - ~~BELOW~~ ON ✓

OFFSET ℄ PAVEMENT 4.3' ~~LT~~ : RT

6.4' TO RT EDGE PAVEMENT

STATION: 470+16

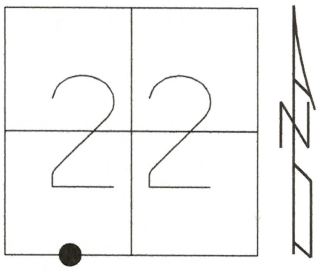


HORZ.DATUM: NAD83 2011 GEOID: 18

GRID: NORTHING: 592670.827 EASTING: 1542131.201

LDP: NORTHING: 449239.9 EASTING: 177386.8

RECORD:
STA 483+68.7
1/4-1/4 SEC 22
FD SM.R.R.SPIKE
8/18/98, MB
SET P.K./WASHER
9/28/98, MRC
FD P.K.NAIL
REFA19
9/6/18, JFO
7/25/19, JMR
FD PK NAIL
REF19A
7/22/24, TDN
FD PK NAIL
11/26/24, TDN

FD PK NAIL
REF 19A
4-28-26, TDN

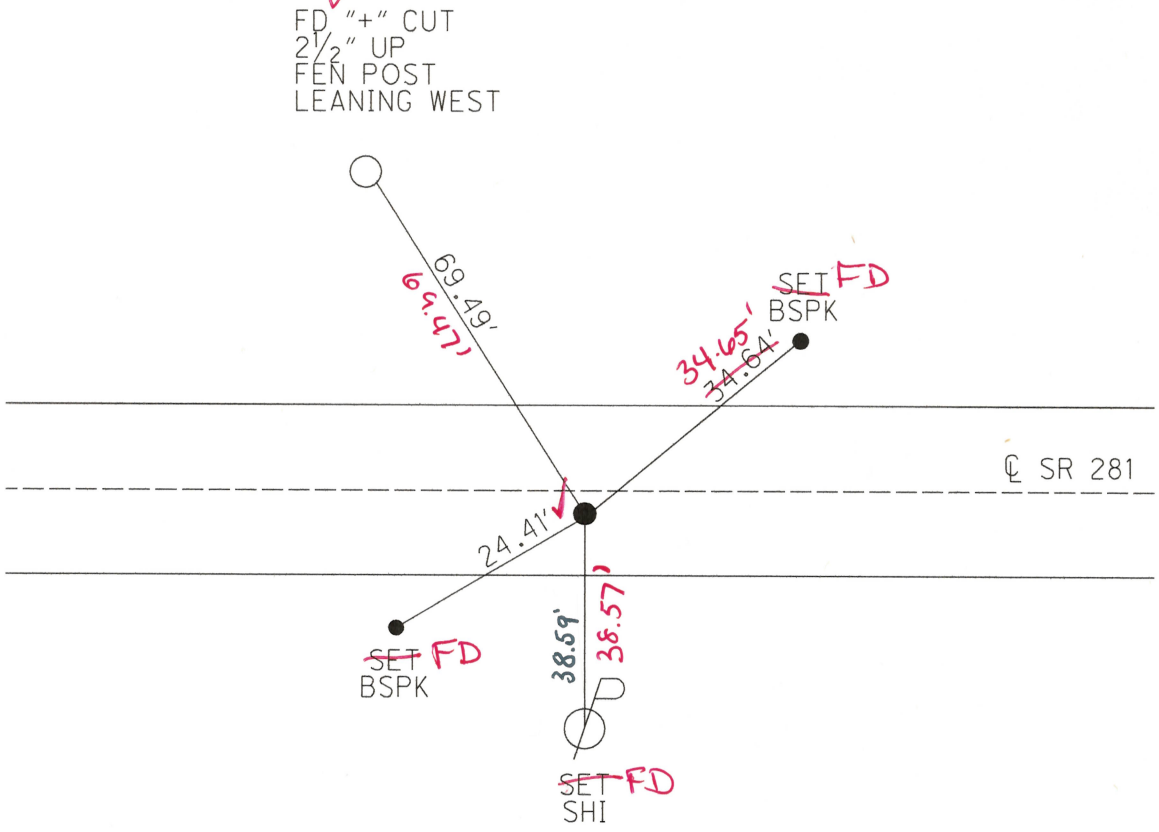

O.D.O.T. DISTRICT 2 SURVEY OFFICE (USE ONLY)

PERSONNEL

REFERENCE NO. 20

SHEET 11 OF 34


NOTES PRESTON-COLVIN
H.C. NEISE
R.C. PRESTON-COLVIN

DATE 11/26/24
WEATHER WINDY
TEMP. 40°

ROUTE SR 281
COUNTY HENRY
TOWNSHIP MONROE
SECTION 22
T 4 N R 7 E

DWG BY PRESTON-COLVIN PID PAVING TRAIN


TYPE MONUMENT Sm RSPK
~~ON SURFACE~~ - BELOW 1 1/2" ✓
OFFSET ℄ PAVEMENT 4.0' ~~LT~~ : RT
6.7' TO RT EDGE PAVEMENT
STATION: 496+88.49

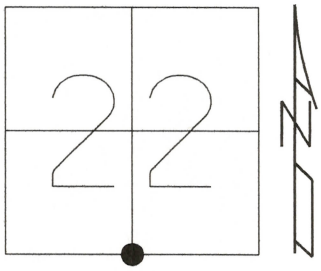

HORZ.DATUM: NAD83 2011 GEOID: 18
GRID: NORTHING: 592670.827 EASTING: 1542131.201
LDP: NORTHING: 449239.9 EASTING: 177386.8

RECORD:
STA 496+93.3
FD SM.R.R.SPIKE
8/18/98, MB
SET P.K./WASHER
9/29/98, MC
FD P.K./WASHER
REF20
9/6/18, JFO
7/25/19, JMR
FD RSPK 1 1/2" DOWN
REF20
7/22/24, TDN
FD RSPK 1 1/2" DOWN
11/26/24, TDN

FD Sm RR SPIKE
1½" Down
4-28-26, TDN

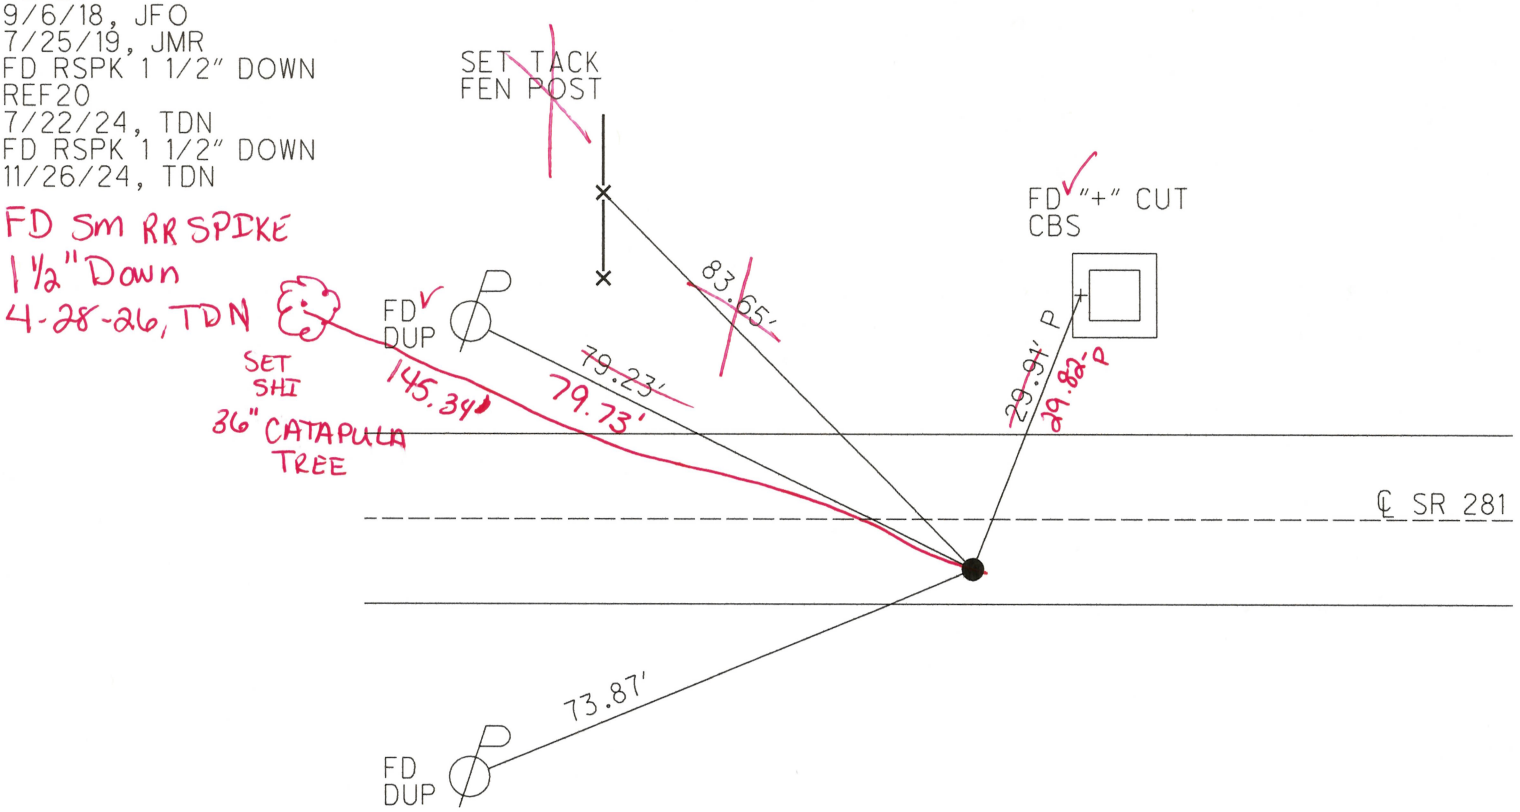

O.D.O.T. DISTRICT 2 SURVEY OFFICE (USE ONLY)

PERSONNEL

NOTES HUSS
H.C. BARNHISEL
R.C. ROUSOS

DWG BY NIESE

REFERENCE NO. 20 A


DATE 8/18/98
WEATHER FAIR
TEMP. 84°

PID CHIP_2

SHEET 14 OF 34


ROUTE SR 281
COUNTY HENRY
TOWNSHIP MONROE
SECTION 22
T 4 N R 7 E

TYPE MONUMENT SM.R.R.SPIKE
ON SURFACE - ~~BELOW~~ ON
OFFSET ℄ PAVEMENT 0.6' ~~LT~~ : RT
9.9' TO RT EDGE PAVEMENT
STATION: 509+89

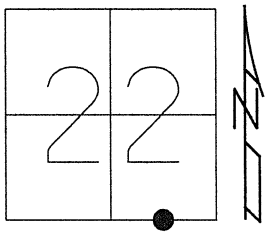

HORZ.DATUM: -
GEOID: -
GRID: NORTHING: -
EASTING: -

RECORD:
STA 510+16.87
1/4-1/4 SEC 22
FD SM.R.R.SPIKE
8/18/98, MB
SET P.K./WASHER
9/29/98, MRC
DNF
9/6/18, JFO

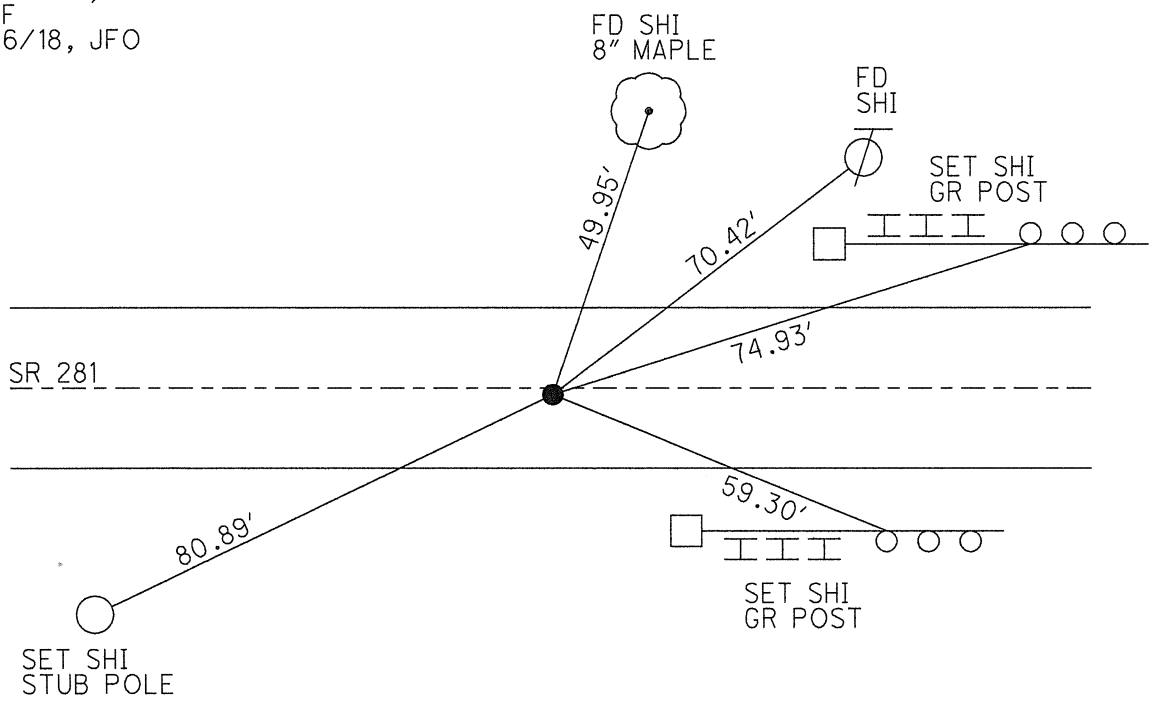

O.D.O.T. DISTRICT 2 SURVEY OFFICE (USE ONLY)

PERSONNEL

NOTES RHOADES ~~AHS~~
H.C. O'DONNELL ~~TDN~~
R.C. RHOADES ~~JAB~~

DWG BY NIESE


REFERENCE NO. 22

DATE ~~9/6/18~~ 4-25-26
WEATHER ~~FAIR~~ Windy Cloudy
TEMP. 70° 64°

PID PAVETRAIN


SHEET 15 OF 34
ROUTE SR 281
COUNTY HENRY
TOWNSHIP MONROE
SECTION 23
T 4 N R 7 E

TYPE MONUMENT R.R. SPIKE
~~ON SURFACE~~ - BELOW 1 1/2"
OFFSET ℄ PAVEMENT ON LT : RT
- TO - EDGE PAVEMENT 8.0' LT OF ℄ SR 109
STATION: 523+38

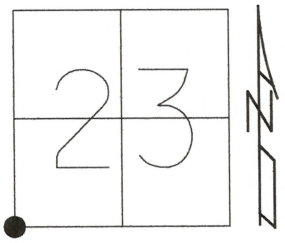

HORZ.DATUM: NAD83(2011) GEOID: 2012A
GRID: NORTHING: 592634.363 EASTING: 1546102.887

RECORD:
STA 523+41.55
FD P.K./WASHER
8/18/98, MB
SET P.K./WASHER
9/28/98, MB
FD R.R.SPIKE
REF22
9/6/18, JFO
7/25/19,
1/11/23, JMR
FD MONBOX
1" IPIN
REF22
4-28-26, TDN

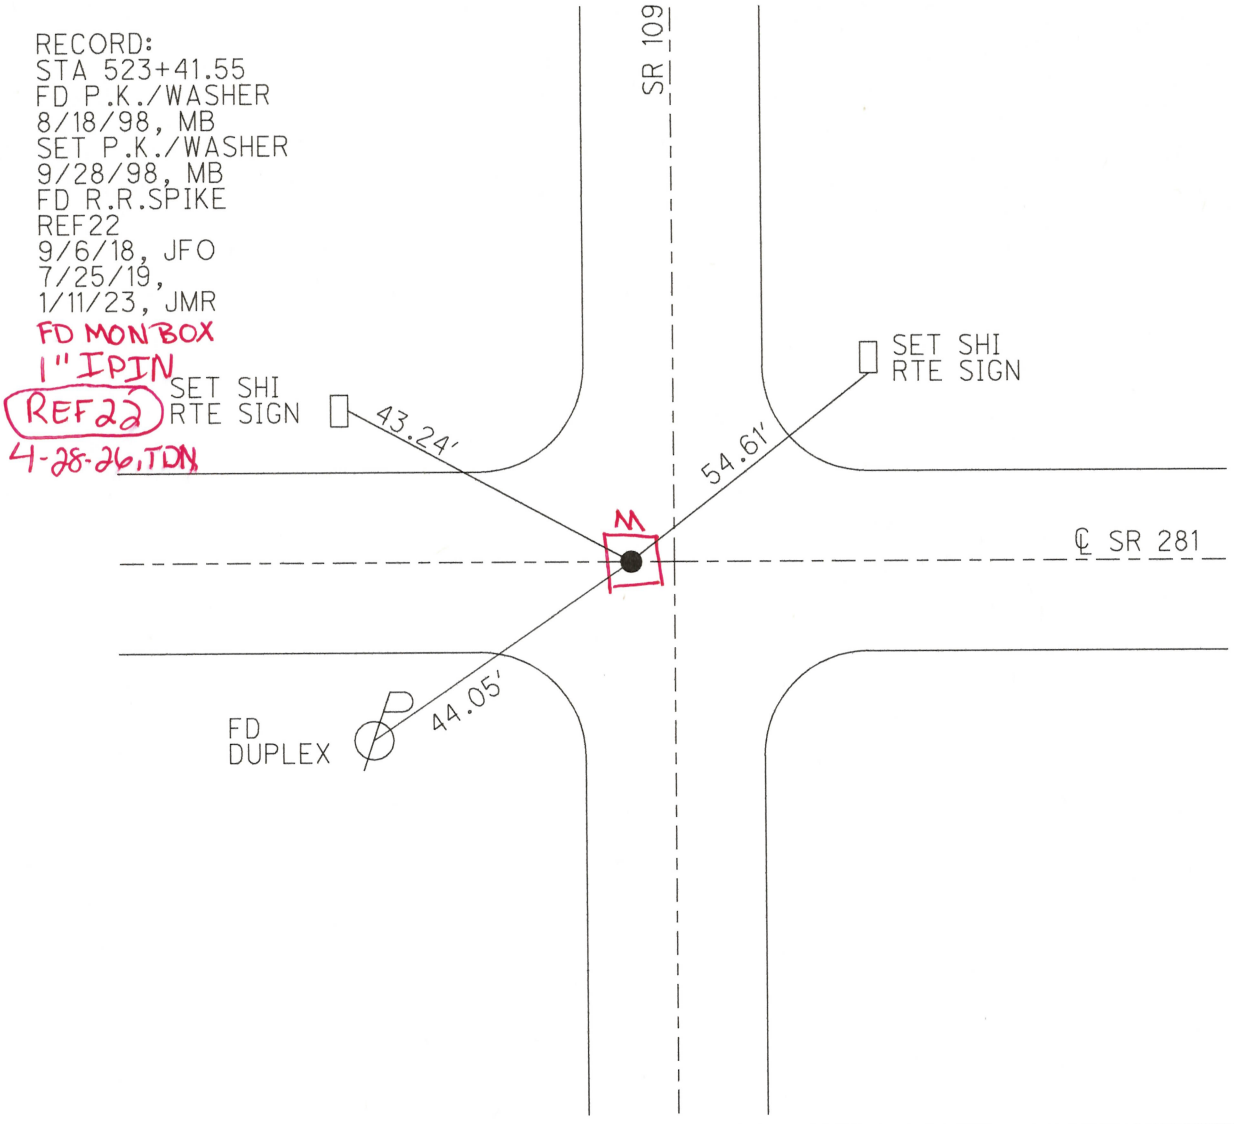

O.D.O.T. DISTRICT 2 SURVEY OFFICE (USE ONLY)

PERSONNEL

NOTES ~~PRESTON-COLVIN~~ HAT

H.C. TDN NEISE

R.C. JAB PRESTON-COLVIN

DWG BY PRESTON-COLVIN

REFERENCE NO. 22 A

DATE 11/26/24 4-28-26

WEATHER ~~WINDY~~ Cloudy

TEMP. 40° 64°

PID PAVING TRAIN

SHEET 16 OF 34

ROUTE SR 281

COUNTY HENRY

TOWNSHIP MONROE

SECTION 23

T 4 N R 7 E


TYPE MONUMENT PK NAIL ✓

~~ON SURFACE~~ - BELOW ON ✓

OFFSET ℄ PAVEMENT ON LT : RT

10.6' TO RT EDGE PAVEMENT

STATION: 549+61

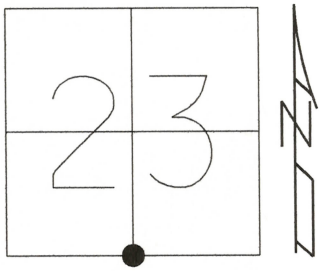

HORZ.DATUM: NAD83 2011

GEOID: 18


GRID: NORTHING: 592631.828

EASTING: 1548748.942

LDP: NORTHING: 449322.3

EASTING: 184004.7

RECORD:
FD SM.R.R.SPIKE
5/28/98, MC
SET P.K./WASHER
10/1/98, MRC
FD P.K.NAIL
REFA22
9/6/18, JFO
7/25/19,
1/11/23, JMR
FD PK NAIL
REF22A
7/22/24, TDN
FD PK NAIL
11/26/24, TDN
FD PK NAIL
REF22A
4-28-26, TDN

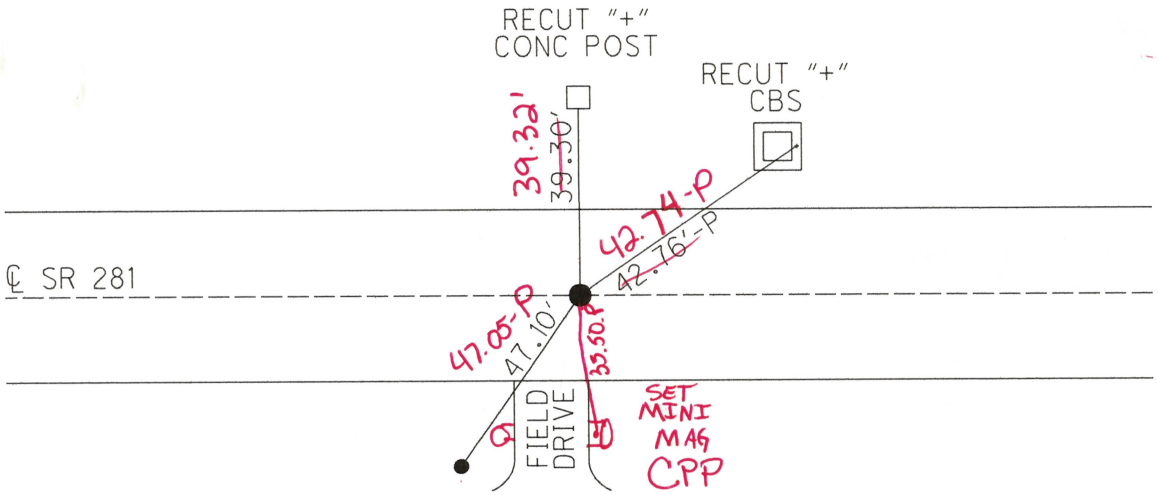

FD CMON
BENT NORTH
USED TIP
OF PIN

O.D.O.T. DISTRICT 2 SURVEY OFFICE (USE ONLY)

PERSONNEL

REFERENCE NO. 22 AB

SHEET 17 OF 34

NOTES HAJ PRESTON-COLVIN

DATE 11/26/24 4-28-26

ROUTE SR 281

H.C. TDN NEISE

WEATHER (WINDY) Cloudy

COUNTY HENRY

R.C. JAB PRESTON-COLVIN

TEMP. 40° 65°

TOWNSHIP MONROE

SECTION 24

DWG BY PRESTON-COLVIN PID PAVING TRAIN

T 4 N R 7 E


TYPE MONUMENT PK NAIL ✓

ON SURFACE - ~~BELOW~~ ON ✓

OFFSET ℄ PAVEMENT 2.8' ~~LT~~ : RT

- TO - EDGE PAVEMENT

STATION: 576+06

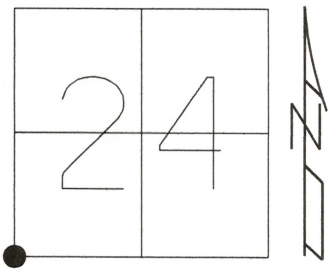


HORZ.DATUM: NAD83 2011 GEOID: 18

GRID: NORTHING: - EASTING: -

LDP: NORTHING: 449350.8 EASTING: 186649.6

RECORD:
FD R.R.SPIKE,
SET BY COUNTY
OVER STONE
6/5/79
FD SM.R.R.SPIKE
5/28/98, MC
SET P.K./WASHER
10/1/98, MRC
FD P.K.NAIL
REF22AB
9/6/18, JFO
7/25/19,
1/11/23, JMR
FD PK NAIL
REF22AB
7/22/24, TDN
FD PK NAIL
11/26/24, TDN

FD PK NAIL
REF22AB
4-28-26, TDN

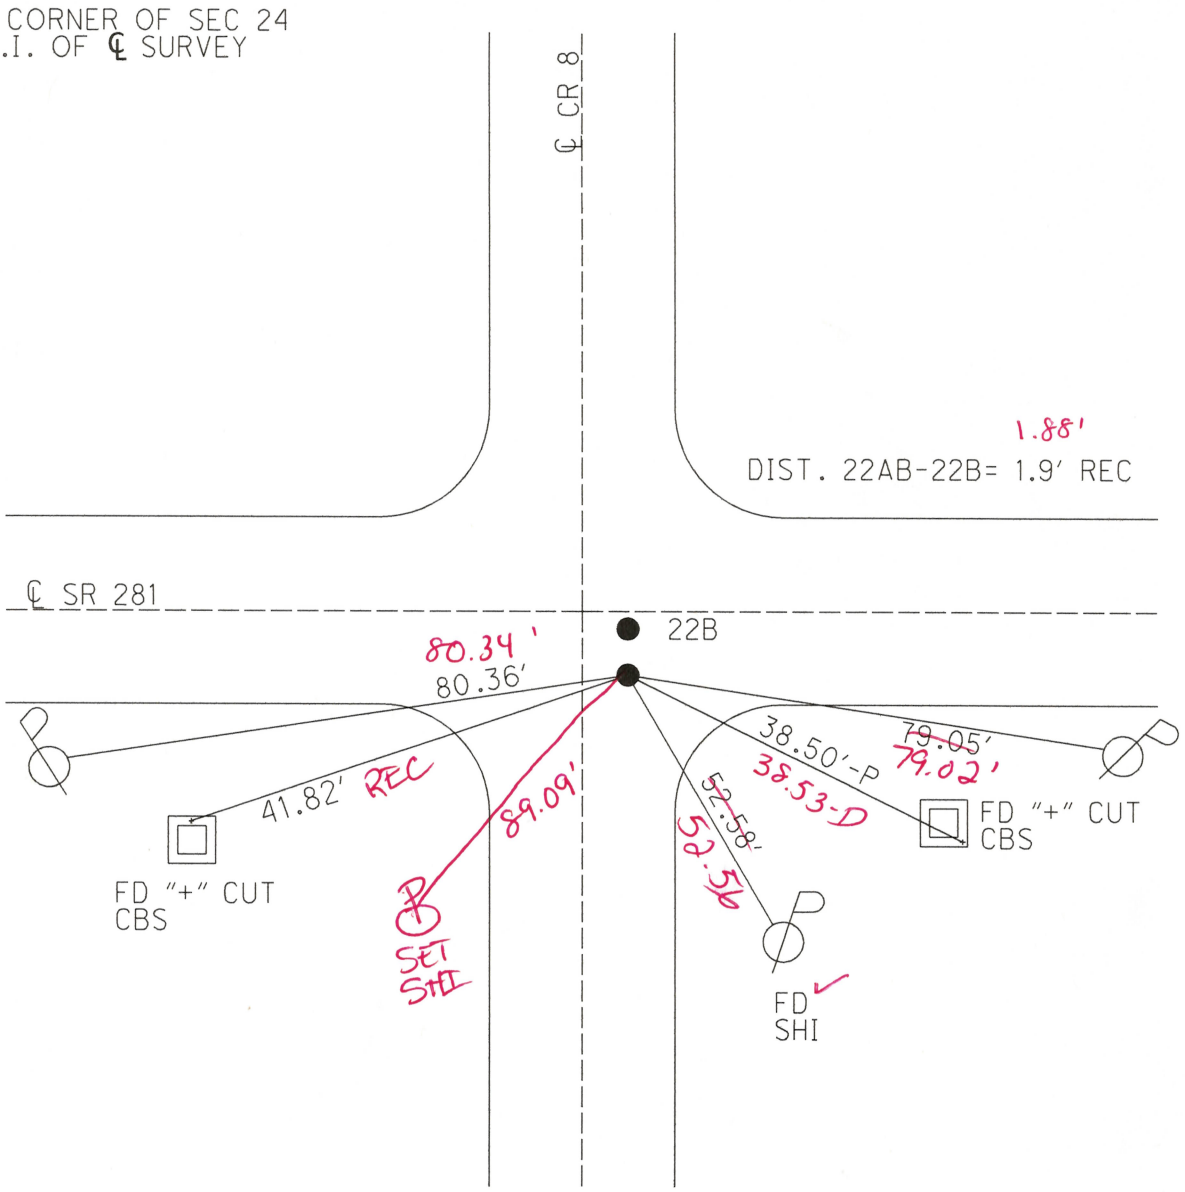

O.D.O.T. DISTRICT 2 SURVEY OFFICE (USE ONLY)

PERSONNEL

REFERENCE NO. 22 B

SHEET 18 OF 34

NOTES HAJ PRESTON-COLVIN

DATE 11/26/24 4-28-26

ROUTE SR 281

H.C. TDN NEISE

WEATHER WINDY Cloudy

COUNTY HENRY

R.C. JAB PRESTON-COLVIN

TEMP. 40° 65°

TOWNSHIP MONROE

SECTION 24

DWG BY PRESTON-COLVIN PID PAVING TRAIN

T 4 N R 7 E


TYPE MONUMENT PK NAIL HARROW TOOTH

~~ON SURFACE~~ - ~~BELOW~~ ~~ON~~ 5"

OFFSET ℄ PAVEMENT 1.0' ~~LT~~ : RT

- TO - EDGE PAVEMENT

STATION: 576+06

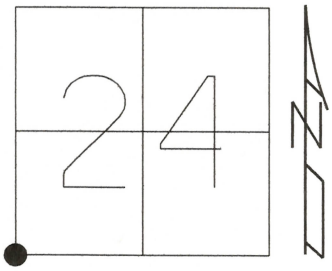


HORZ.DATUM: NAD83 2011 GEOID: 18

GRID: NORTHING: 592611.755 EASTING: 1551393.702

LDP: NORTHING: 449352.7 EASTING: 186649.9

RECORD:
FD HARROW TOOTH
SQUARE SPIKE
BY COUNTY
6/5/79
FD SM.R.R. SPIKE
5/28/98, MC
SET P.K./WASHER
10/1/98, MRC
FD HARROW TOOTH
5" DOWN
REF22B
7/22/24, TDN
FD HARROW TOOTH
5" DOWN
REF 22 B
4-28-26, TDN

BELIEVED TO BE
ON ℄ CONSTRUCTION

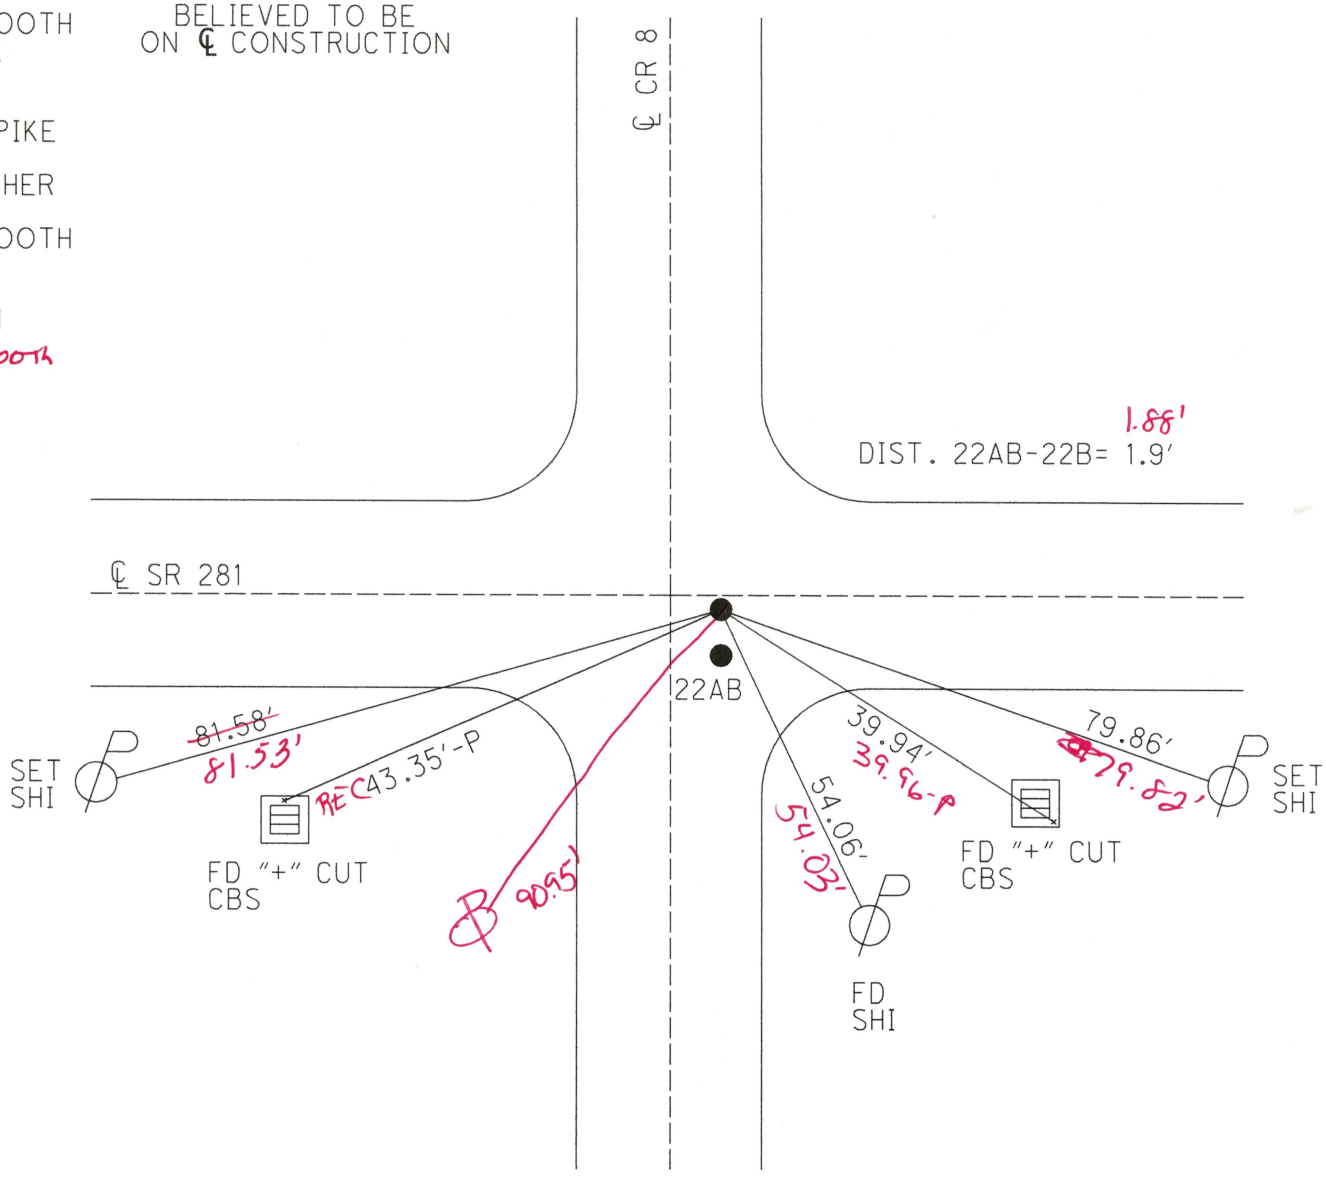

O.D.O.T. DISTRICT 2 SURVEY OFFICE (USE ONLY)

PERSONNEL

REFERENCE NO. 23

SHEET 19 OF 34

NOTES HAT PRESTON-COLVIN

DATE 11/26/24 4-28-26

ROUTE SR 281

H.C. TDN NEISE

WEATHER WINDY Cloudy

COUNTY HENRY

R.C. JAB PRESTON-COLVIN

TEMP. 40° 65°

TOWNSHIP MONROE

SECTION 24

T 4 N R 7 E

DWG BY PRESTON-COLVIN PID PAVING TRAIN


TYPE MONUMENT SM RR SPIKE ✓

ON SURFACE - ~~BELOW~~ 5.5" DOWN 5 ½" Down

OFFSET ℄ PAVEMENT ON ~~LT~~ : RT

10.4' TO RT EDGE PAVEMENT

STATION: 589+31

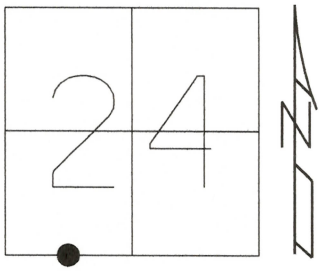


HORZ.DATUM: NAD83 2011 GEOID: 18

GRID: NORTHING: 592604.447 EASTING: 1552718.822

LDP: NORTHING: 449367.7 EASTING: 187974.8

RECORD:
1/4-1/4 COR SEC 24
FD SM.R.R.SPIKE
8/18/98, MC
SET SM.R.R.SPIKE
9/2/87, CL
FD SM.R.R.SPIKE
8/18/98, MC
SET P.K./WASHER
10/1/98, MRC
FD P.K.SHANK
REF23
9/6/18, JFO
7/25/19,
1/11/23, JMR
FD PK SHANK
REF23
7/23/24, TDN
FD SM RRSPK
NEW REF23
5.5" DOWN
11/26/24, TDN
FD SM RR SPIKE
5 ½" Down
REF23
4-28-26, TDN

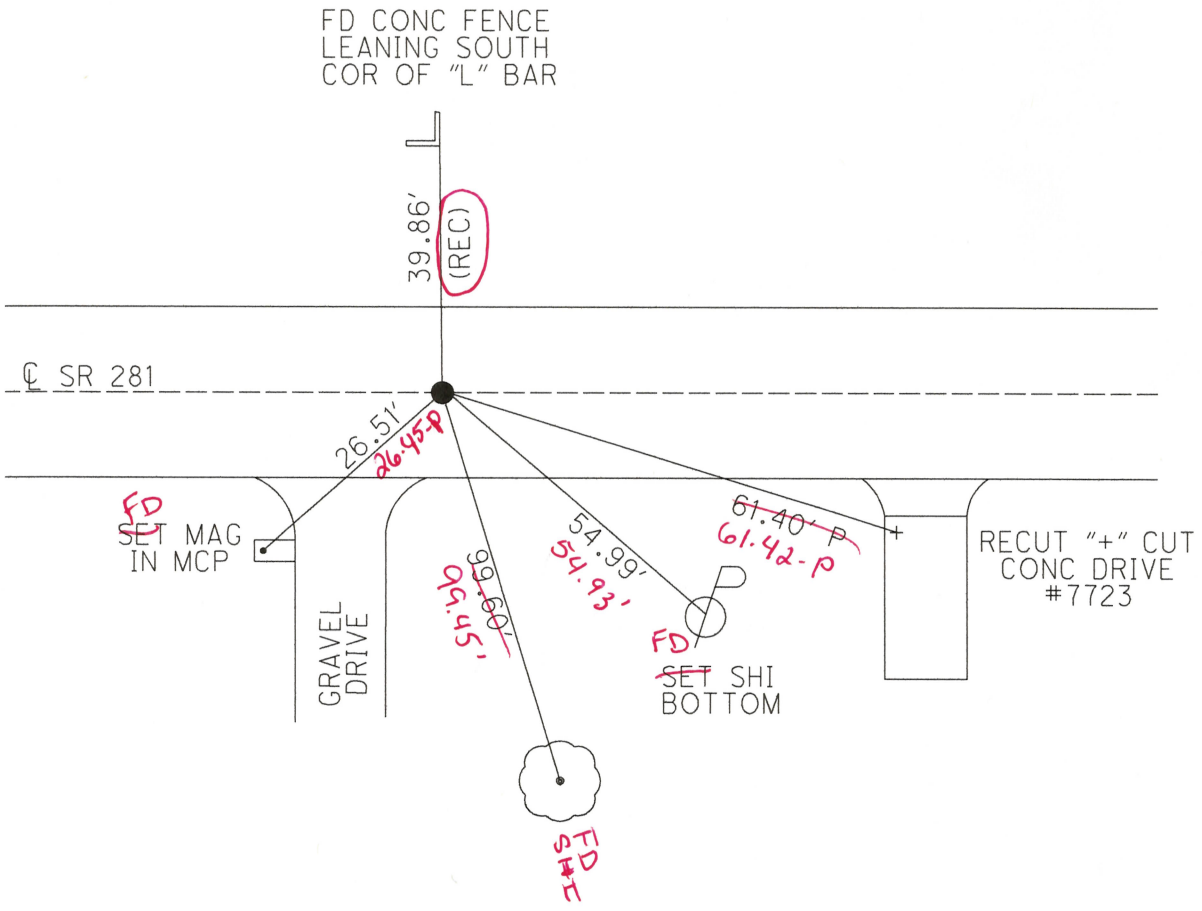

O.D.O.T. DISTRICT 2 SURVEY OFFICE (USE ONLY)

PERSONNEL

REFERENCE NO. 25

SHEET 20 OF 34

NOTES HAS PRESTON-COLVIN

DATE 11/26/24 4-28-26

ROUTE SR 281

H.C. TDN NEISE

WEATHER (WINDY) Cloudy

COUNTY HENRY

R.C. JAB PRESTON-COLVIN

TEMP. ~~40°~~ 65°

TOWNSHIP RICHFIELD

SECTION 19

DWG BY PRESTON-COLVIN

PID PAVING TRAIN

T 4 N R 8 E


TYPE MONUMENT SM RR SPIKE ✓

ON SURFACE - ~~BELOW~~ 3" ✓

OFFSET ℄ PAVEMENT 3.9' ~~LT~~ : RT

- TO - EDGE PAVEMENT 11.7' W ℄ CR 7 S

STATION: 628+82

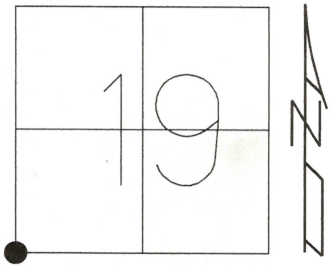

HORZ.DATUM: NAD83 2011

GEOID: 18


GRID: NORTHING: 592526.089

EASTING: 1556668.797

LDP: NORTHING: 449361.9

EASTING: 191925.8

RECORD:
FD SM.R.R.SPIKE
8/18/98, MC
SET P.K./WASHER
10/1/98, MRC
FD SM.R.R.SPIKE
3" DOWN
REF25
9/6/18, JFO
7/25/19,
1/11/23, JMR
FD SM RRS
3" DOWN DAMAGED
7/24/24, TDN
FD SM RRS
3" DOWN
11/26/24, TDN
FD Sm RR SPIKE
3" DOWN
REF25
4-28-26, TDN

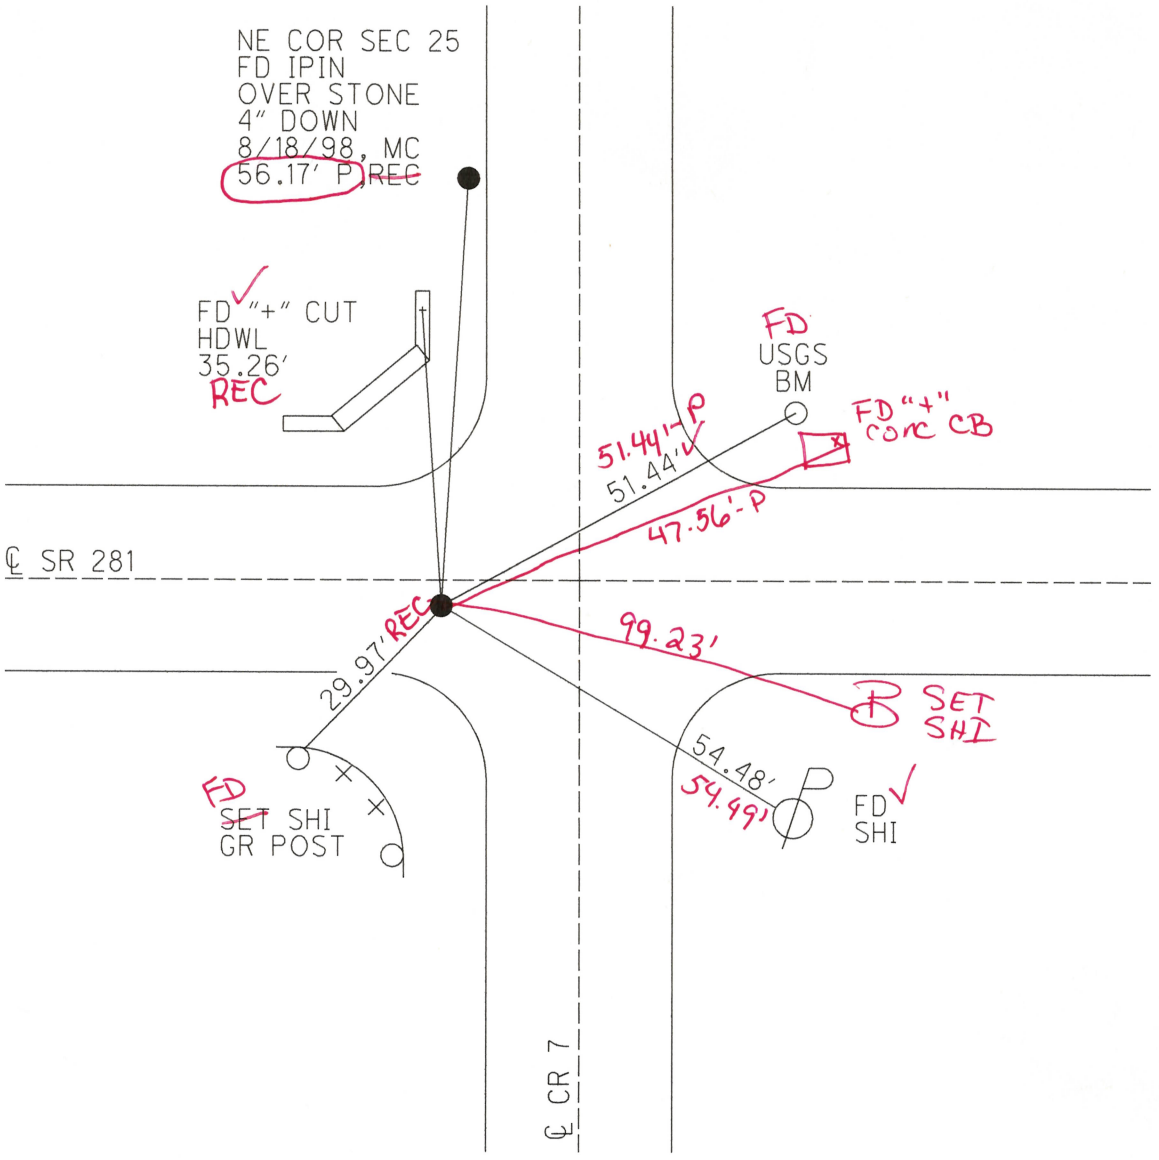

O.D.O.T. DISTRICT 2 SURVEY OFFICE (USE ONLY)

PERSONNEL

REFERENCE NO. 26

SHEET 21 OF 34

NOTES HAJ PRESTON-COLVIN

DATE 11/26/24 4-28-26

ROUTE SR 281

H.C. TDN NEISE

WEATHER (WINDY) Cloudy

COUNTY HENRY

R.C. JAB PRESTON-COLVIN

TEMP. ~~40°~~ 64°

TOWNSHIP RICHFIELD

SECTION 19

T 4 N R 8 E

DWG BY PRESTON-COLVIN

PID PAVING TRAIN


TYPE MONUMENT PK NAIL ✓

ON SURFACE - ~~BELOW~~ ON ✓

OFFSET ℄ PAVEMENT 1.8' ~~LT~~ : RT

8.2' TO RT EDGE PAVEMENT 11.7' W ℄ CR 7 S

STATION: 628+82

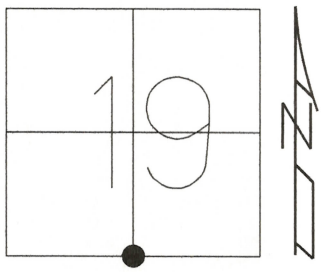

HORZ.DATUM: NAD83 2011

GEOID: 18


GRID: NORTHING: 592526.089

EASTING: 1556668.797

LDP: NORTHING: 449383.8

EASTING: 194509.4

RECORD:
SET SM.R.R.SPIKE
9/2/87, CL
FD SM.R.R.SPIKE
ATOP R.R.SPIKE
8/18/98, MC
SET P.K./WASHER
10/1/98, MRC
FD P.K.NAIL
REF26
9/6/18, JFO
7/25/19,
1/11/23, JMR
FD PK NAIL
7/24/24, TDN
PK PK WASHER
11/26/24, TDN
FD PK Nail
REF 26
4-28-26, TDN

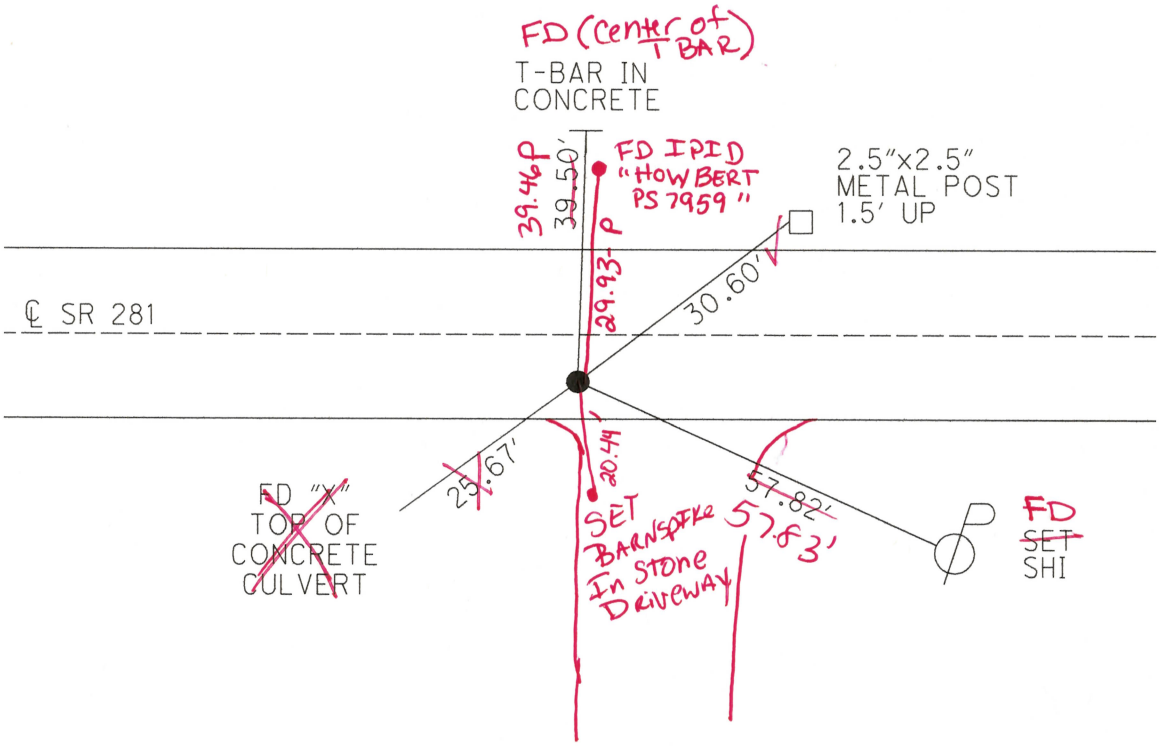

O.D.O.T. DISTRICT 2 SURVEY OFFICE (USE ONLY)

PERSONNEL

REFERENCE NO. 27

SHEET 22 OF 34

NOTES PRESTON-COLVIN HAJ

H.C. TDN NEISE

R.C. JAB PRESTON-COLVIN

DWG BY PRESTON-COLVIN

DATE 11/26/24 4-28-26

WEATHER WINDY ~~Rainy~~ cloudy

TEMP. ~~40°~~ 62°

ROUTE SR 281

COUNTY HENRY

TOWNSHIP RICHFIELD

SECTION 19

T 4 N R 8 E

PID PAVING TRAIN


TYPE MONUMENT SM RR SPIKE ✓

ON SURFACE - ~~BELOW~~ 3" ✓

OFFSET ℄ PAVEMENT 4.8' ~~LT~~ : RT

- TO - EDGE PAVEMENT

STATION: 681+06

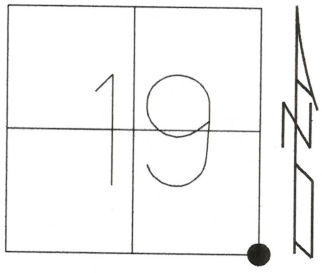

HORZ.DATUM: NAD83 2011

GEOID: 18

GRID: NORTHING: 592470.611


EASTING: 1561893.334

LDP: NORTHING: 449402.4

EASTING: 194509.4

RECORD:
FD SM.R.R.SPIKE
ATOP SM.R.R.SPIKE
8/18/98, MC
SET P.K./WASHER
10/1/98, MRC
FD SM.R.R.SPIKE
3" DOWN
REF27
9/6/18, JFO
7/25/19,
1/11/23, JMR
FD SM RRS
REF27
3" DOWN
FD SM RRS
REF27
11/26/24, TDN

FD SM RR SPIKE
3" DOWN
4-28-26, TDN
REF27

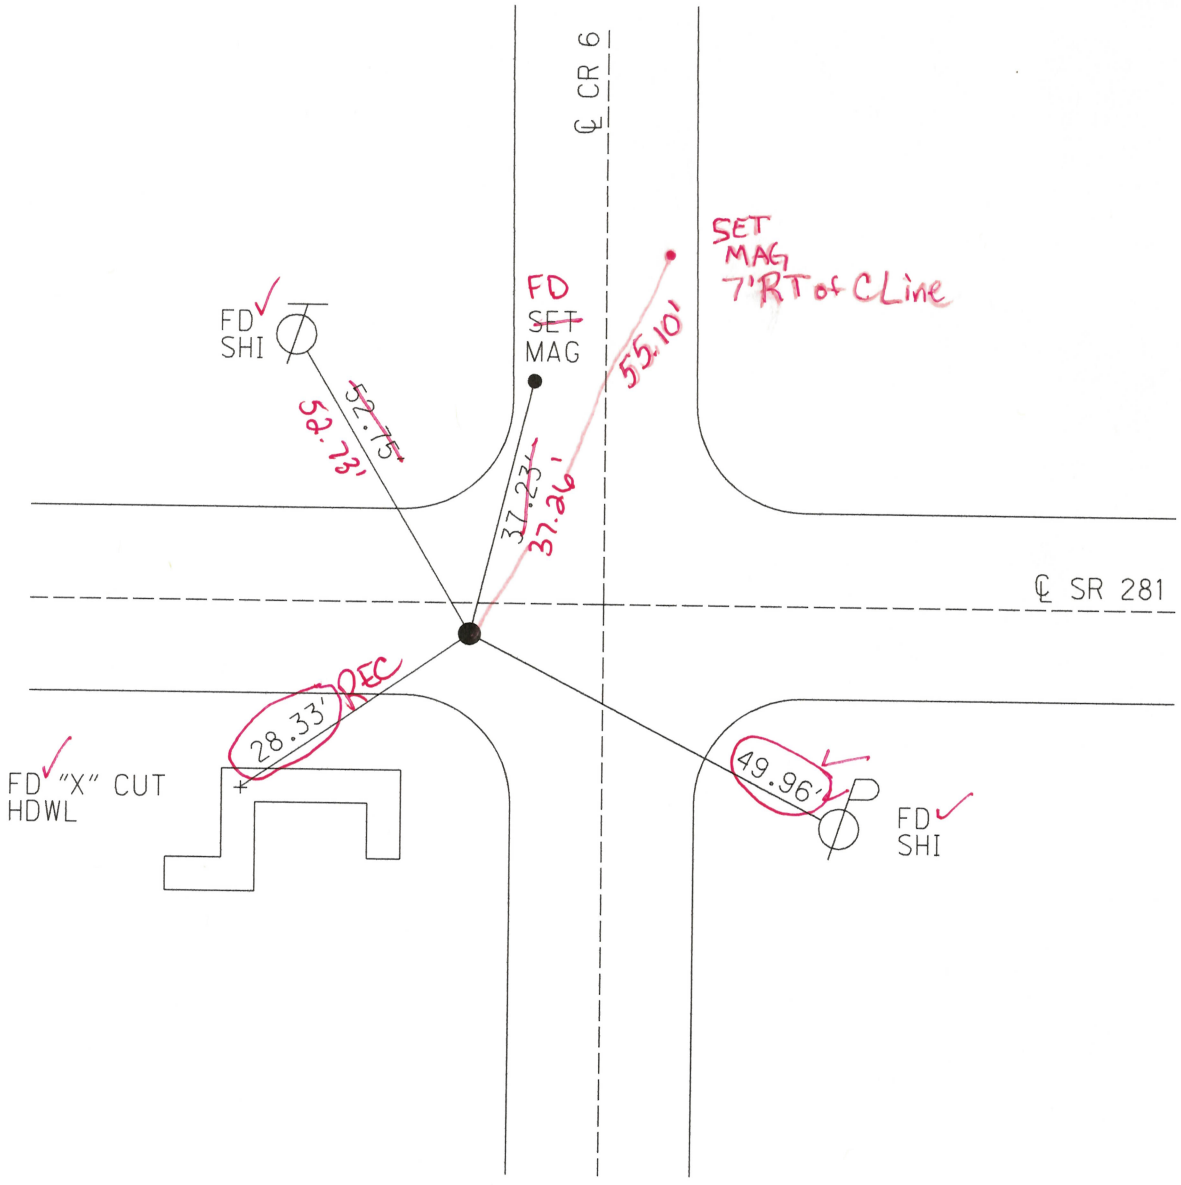

O.D.O.T. DISTRICT 2 SURVEY OFFICE (USE ONLY)

PERSONNEL

REFERENCE NO. 28

SHEET 23 OF 34

NOTES HAJ PRESTON-COLVIN

DATE 11/26/24 4-28-26

ROUTE SR 281

H.C. TDN NEISE

WEATHER WINDY ✓ cloudy

COUNTY HENRY

R.C. JAB PRESTON-COLVIN

TEMP. ~~40°~~ 62°

TOWNSHIP RICHFIELD

SECTION 20

DWG BY PRESTON-COLVIN

PID PAVING TRAIN

T 4 N R 8 E


TYPE MONUMENT SHANK/WASHER ✓

ON SURFACE - ~~BELOW~~ ON ✓

OFFSET ℄ PAVEMENT 1.7' ~~LT~~ : RT

- TO - EDGE PAVEMENT

STATION: 681+06

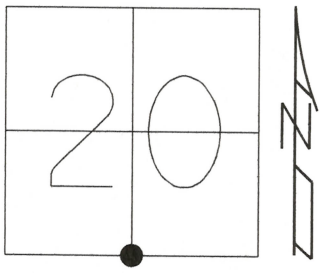

HORZ.DATUM: NAD83 2011

GEOID: 18


GRID: NORTHING: 592460.657

EASTING: 1564562.113

LDP: NORTHING: 449402.4

EASTING: 197150.9

RECORD:
FD SM.R.R.SPIKE
ATOP P.K.NAIL
6/2/98, MC
SET P.K./WASHER
10/5/98, MRC
FD P.K./WASHER
REF20
9/6/18, JFO
7/25/19,
1/11/23, JMR
FD PK
REF28
7/24/24, TDN
FD SHANK/WASHER
11/26/24, TDN
FD SHANK / WASHER
4-28-26, TDN
REF28

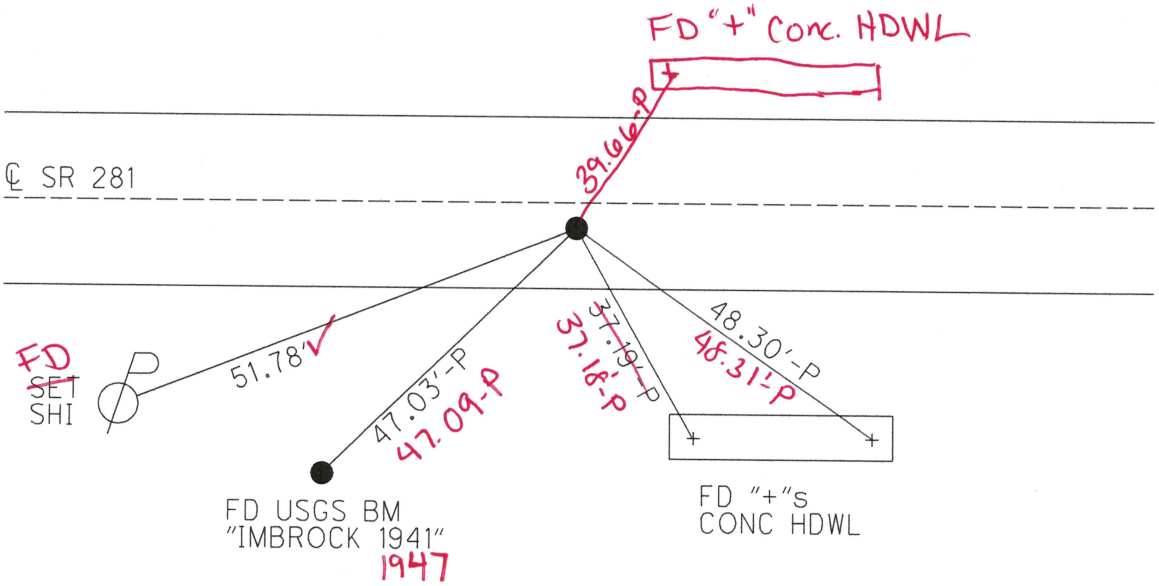

O.D.O.T. DISTRICT 2 SURVEY OFFICE (USE ONLY)

PERSONNEL

NOTES HAJ PRESTON-COLVIN
H.C. TDN NEISE
R.C. JAB PRESTON-COLVIN

DWG BY PRESTON-COLVIN


REFERENCE NO. 29

DATE 11/26/24 4-28-26
WEATHER WINDY ✓ Cloudy
TEMP. 40° 62°

PID PAVING TRAIN


SHEET 24 OF 34
ROUTE SR 281
COUNTY HENRY
TOWNSHIP RICHFIELD
SECTION 20
T 4 N R 8 E

TYPE MONUMENT SM RR SPIKE ✓
~~ON SURFACE~~ - BELOW 3" ~~@~~ 3.5"
OFFSET ℄ PAVEMENT 2.0' ~~LT~~ : RT
- TO - EDGE PAVEMENT 5.2' W OF ℄ CR 5 N
STATION: 734+43

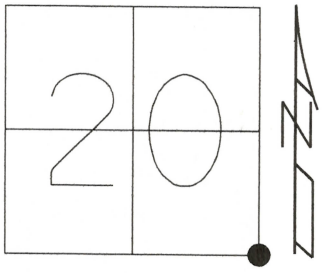

HORZ.DATUM: NAD83 2011
GEOID: 18
GRID: NORTHING: 592440.193
EASTING: 1567230.169
LDP: NORTHING: 449469.9
EASTING: 202487.9

RECORD:
SET SM.R.R.SPIKE
9/2/87, CL
FD SM.R.R.SPIKE
6/2/98, MC
SET P.K./WASHER
10/5/98, MRC
FD SM.R.R.SPIKE
3" DOWN
REF29
9/6/18, JFO
7/25/19,
1/11/23, JMR
FD SM RRSK
REF29
7/24/24, TDN
FD SM RRSK
11/26/24, TDN
FD SM RR SPIKE
@ # 3.5" DOWN
4-28-26, TDN
REF29

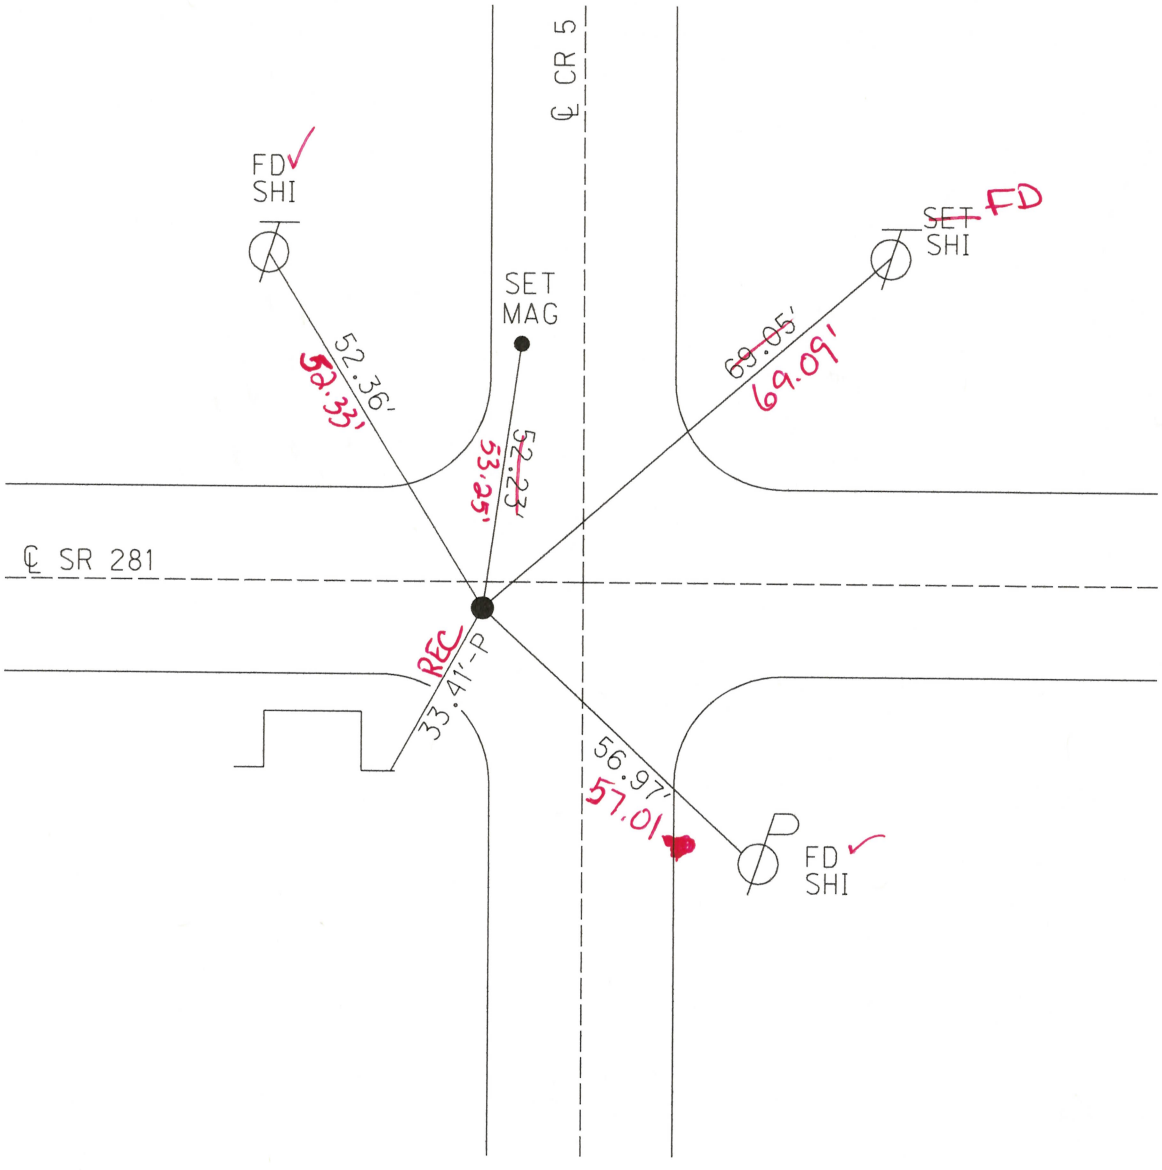

O.D.O.T. DISTRICT 2 SURVEY OFFICE (USE ONLY)

PERSONNEL

REFERENCE NO. 30

SHEET 25 OF 34


NOTES ~~HAT~~ PRESTON-COLVIN
H.C. TDN NEISE
R.C. ~~JAB~~ PRESTON-COLVIN

DATE 11/26/24 4-28-26
WEATHER WINDY ✓ Cloudy
TEMP. 40° 62°

ROUTE SR 281
COUNTY HENRY
TOWNSHIP RICHFIELD
SECTION 21
T 4 N R 8 E

DWG BY PRESTON-COLVIN PID PAVING TRAIN


TYPE MONUMENT SM RR SPIKE ✓
~~ON SURFACE~~ - BELOW ~~ON~~ .5"
OFFSET ℄ PAVEMENT 4.0' ~~LT~~ : RT
6.1' TO RT EDGE PAVEMENT
STATION: 761+02

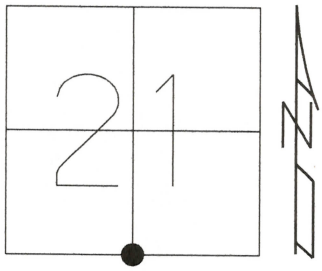

HORZ.DATUM: NAD83 2011 GEOID: 18
GRID: NORTHING: 592440.193 EASTING: 1567230.169
LDP: NORTHING: 449469.9 EASTING: 202487.9

RECORD:
SET SM.R.R.SPIKE
9/2/87, CL
FD SM.R.R.SPIKE
6/2/98, MC
SET P.K./WASHER
10/5/98, MRC
FD SM.R.R.SPIKE
REF30
9/7/18, JFO
7/25/19,
1/11/23, JMR
FD SM RRS
REF30
7/24/24, JAM
FD SM RRS
11/26/24, TDN

FD SM RR SPIKE
4-28-26, TDN
REF30

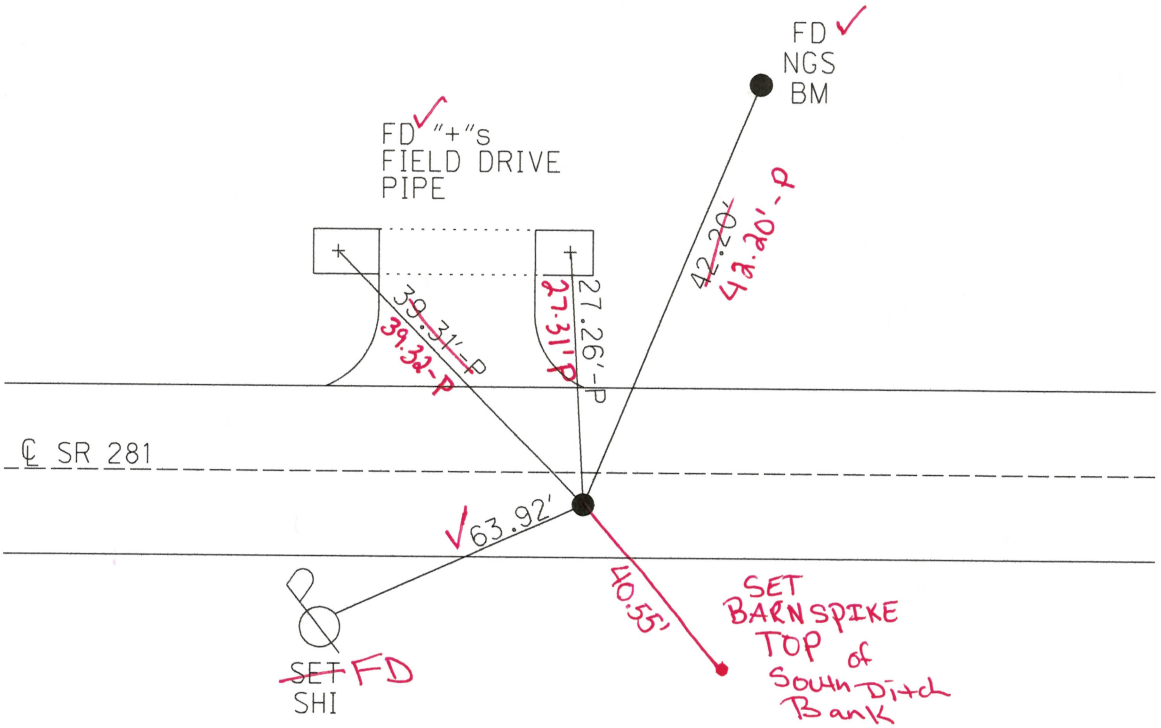

O.D.O.T. DISTRICT 2 SURVEY OFFICE (USE ONLY)

PERSONNEL

REFERENCE NO. 31

SHEET 26 OF 34

NOTES PRESTON-COLVIN HAS

DATE 11/26/24 4-28-24

ROUTE SR 281

H.C. TDN NEISE

WEATHER WINDY ✓ Cloudy

COUNTY HENRY

R.C. JAB PRESTON-COLVIN

TEMP. ~~40°~~ 61°

TOWNSHIP RICHFIELD

SECTION 28

DWG BY PRESTON-COLVIN PID PAVING TRAIN

T 4 N R 8 E


TYPE MONUMENT MAG/WASHER ✓

~~ON SURFACE~~ - BELOW ON

OFFSET ℄ PAVEMENT 1.7' ~~LT~~ : RT

- TO - EDGE PAVEMENT

STATION: 787+93

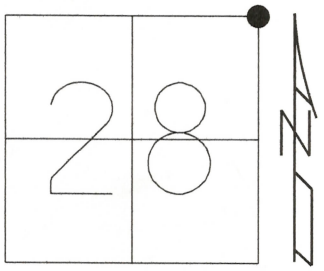

HORZ.DATUM: NAD83 2011 GEOID: 18


GRID: NORTHING: 592437.952 EASTING: 1572551.483

LDP: NORTHING: 449565.4 EASTING: 207808.7

RECORD:
R.R.SPIKE SET
BY COUNTY ENG
FD MAG/WASHER
9/16/02, DCH
SET MAG/WASHER
11/21/02, MB
FD MAG/WASHER
7/11/12, MC
FD MAG/WASHER
REF17
5/10/17, JFO
SET MAG/WASHER
9/22/17, JFO
FD MAG/WASHER
1/11/23, JMR
FD MAG/WASHER
REF31
7/24/24, JAM
FD MAG/WASHER
11/26/24, TDN

FD MAG/WASHER
4-28-24, TDN
REF 31

NOT: REF 17 SR 65

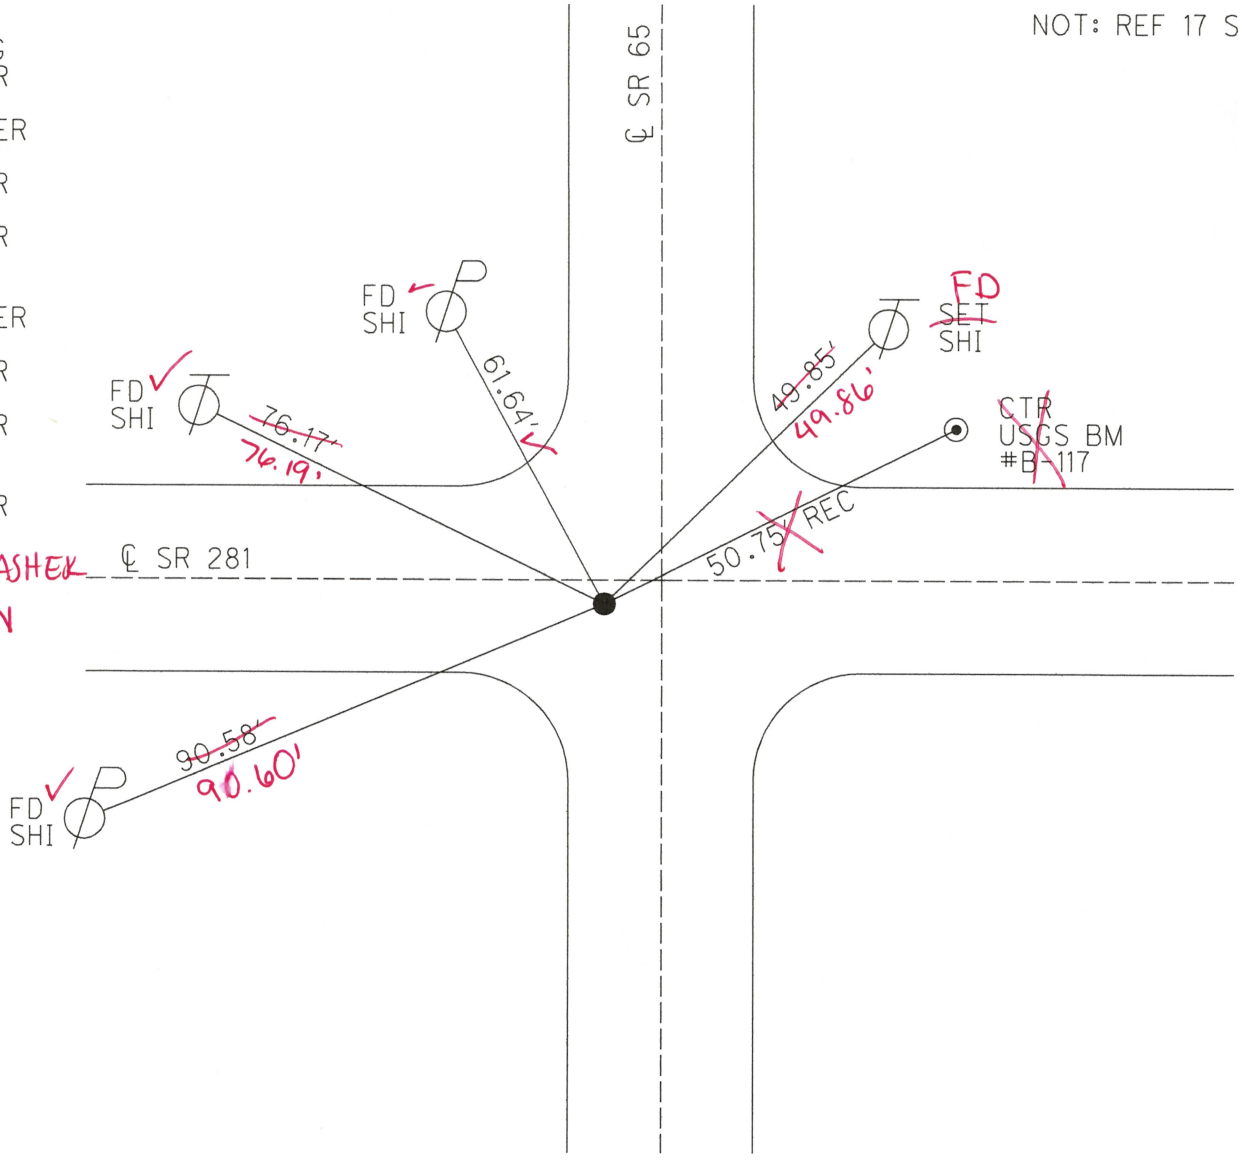

O.D.O.T. DISTRICT 2 SURVEY OFFICE (USE ONLY)

PERSONNEL HAJ

REFERENCE NO. 32 SHEET 27 OF 34

NOTES PRESTON-COLVIN DATE 11/26/24 4-24-26 ROUTE SR 281

H.C. TDN NEISE WEATHER WINDY Cloudy Windy COUNTY HENRY

R.C. HAJ PRESTON-COLVIN TEMP. 40° 77° TOWNSHIP RICHFIELD

SECTION 27

DWG BY PRESTON-COLVIN PID PAVING TRAIN

T 4 N R 8 E


TYPE MONUMENT 5/8" IPIN ✓

~~ON SURFACE~~ - (BELOW) ~~3"~~ 4"

OFFSET ℄ PAVEMENT 17.9' ~~LT~~ : RT

7.7' TO RT EDGE PAVEMENT

STATION: 814+32

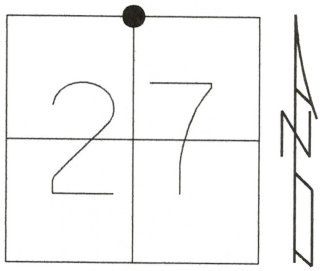

HORZ.DATUM: NAD83 2011 GEOID: 18


GRID: NORTHING: 592410.579 EASTING: 1575206.585

LDP: NORTHING: 449586.6 EASTING: 210464.2

RECORD:
N1/4 COR SEC 27
CORNER LOST, RE-ESTABLISHED MIDWAY
BETWEEN NE&NW COR OF SEC 27
PLACED 5/8"x18" IPIN
P.K.'S 15' NE&NW
HENRY COUNTY, 1979

RECORD:
FD 5/8" IPIN
6" DOWN
LEANING SOUTH
6/2/98, MC
FD 5/8" IPIN
3" DOWN
9/7/18, JFO
7/25/19, JMR
FD 5/8" IPIN
3" DOWN
7/25/24, JAM
FD 5/8" IPIN
4" DOWN
REF 32
4-24-26, TDN

℄ SR 281

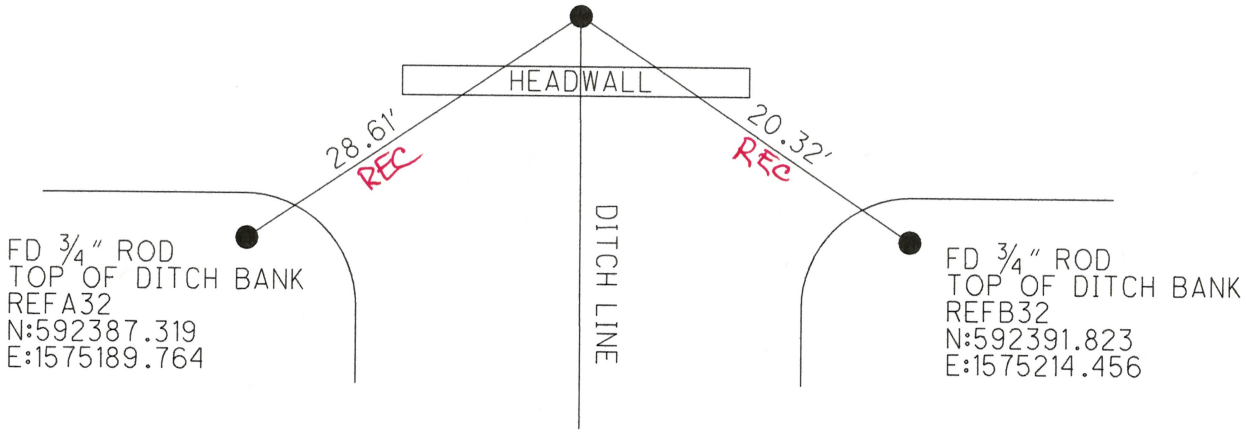

FD 3/4" ROD
TOP OF DITCH BANK
REFA32
N:592387.319
E:1575189.764

FD 3/4" ROD
TOP OF DITCH BANK
REFB32
N:592391.823
E:1575214.456

O.D.O.T. DISTRICT 2 SURVEY OFFICE (USE ONLY)

PERSONNEL ~~HAJ~~ TDN

REFERENCE NO. 32

SHEET 27 OF 34

NOTES PRESTON-COLVIN

H.C. TDN NEISE

R.C. HAJ PRESTON-COLVIN

DWG BY PRESTON-COLVIN

DATE 8/11/26 11/26/24 4-24-26

WEATHER Rainy WINDY Cloudy Windy

TEMP. 75° 40° 77°

PID 101233 ~~PAVING TRAIN~~


ROUTE SR 281

COUNTY HENRY

TOWNSHIP RICHFIELD

SECTION 27

T 4 N R 8 E

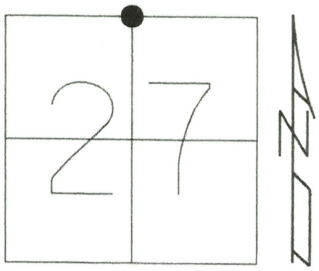

TYPE MONUMENT 5/8" IPIN ✓J

~~ON SURFACE~~ - BELOW ~~3"~~ 4" J

OFFSET ℄ PAVEMENT 17.9' ~~LT~~ : RT

7.7' TO RT EDGE PAVEMENT

STATION: 814+32

HORZ.DATUM: NAD83 2011 GEOID: 18

GRID: NORTHING: 592410.579 EASTING: 1575206.585

LDP: NORTHING: 449586.6 EASTING: 210464.2


RECORD:
N1/4 COR SEC 27
CORNER LOST, RE-ESTABLISHED MIDWAY
BETWEEN NE&NW COR OF SEC 27
PLACED 5/8"x18" IPIN
P.K.'S 15' NE&NW
HENRY COUNTY, 1979

REF32TS
N: 592410.307
E: 1575206.646

RECORD:
FD 5/8" IPIN
6" DOWN
LEANING SOUTH
6/2/98, MC
FD 5/8" IPIN
3" DOWN
9/7/18, JFO
7/25/19, JMR
FD 5/8" IPIN
3" DOWN
7/25/24, JAM
FD 5/8" IPIN
4" DOWN
REF32
4-24-26, TDN
FD 5/8" IPIN
4" DOWN
SET UP ON MON32A, BACKSIGHT
MON32C with total station
REF32TS
8/11/26, TDN

℄ SR 281

SET MAG NAIL
MON32C
N: 592418.207
E: 1574994.243

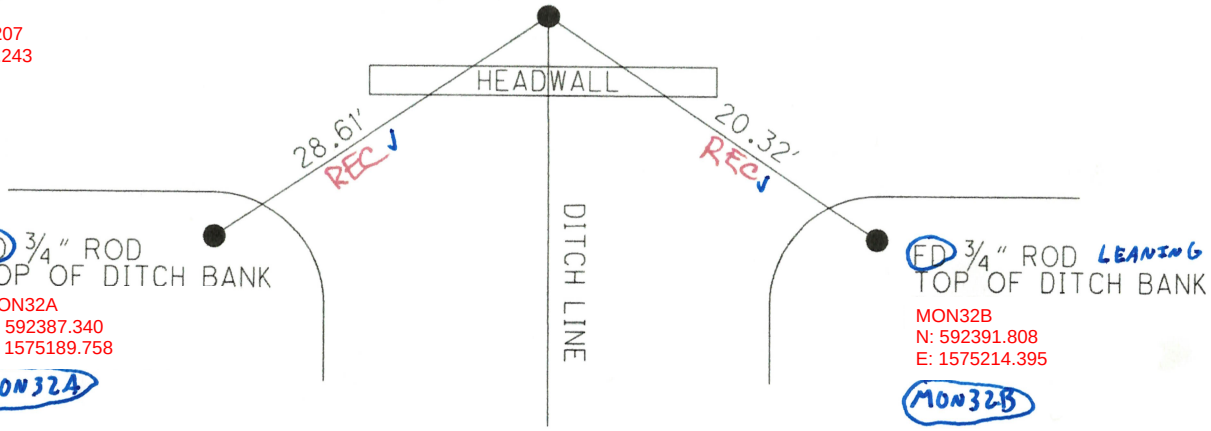

FD 3/4" ROD
TOP OF DITCH BANK
MON32A
N: 592387.340
E: 1575189.758
MON32A

FD 3/4" ROD LEANING
TOP OF DITCH BANK
MON32B
N: 592391.808
E: 1575214.395
MON32B

O.D.O.T. DISTRICT 2 SURVEY OFFICE (USE ONLY)

PERSONNEL ~~HAJ~~ TDN ✓

NOTES PRESTON-COLVIN
H.C. TDN NEISE ✓
R.C. ✓ HAJ PRESTON-COLVIN

DWG BY PRESTON-COLVIN

REFERENCE NO. 32

DATE ~~9/3/26~~ ~~8/11/26~~ 11/26/24 4-24-26


WEATHER ~~RAINY~~ ~~WINDY~~ ~~CLOUDY WINDY~~ SUNNY/CLEAR

TEMP. 75° 40° ~~77°~~ 92°

PID ~~PAVING TRAIN~~ 101233 ✓

SHEET 27 OF 34

ROUTE SR 281
COUNTY HENRY
TOWNSHIP RICHFIELD
SECTION 27
T 4 N R 8 E

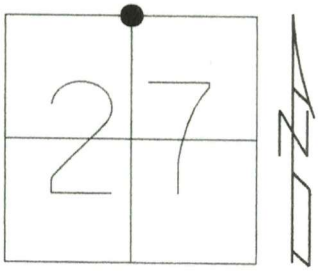

TYPE MONUMENT ~~5/8" IPIN~~ ✓ ~~3/4"x15" IPIN~~

~~ON SURFACE~~ - BELOW ~~3" ✓~~ 1"

OFFSET ℄ PAVEMENT 17.9' ~~LT~~ : RT

7.7' TO RT EDGE PAVEMENT

STATION: 814+32


HORZ.DATUM: NAD83 2011 GEOID: 18

GRID: NORTHING: 592410.579 EASTING: 1575206.585

LDP: NORTHING: 449586.6 EASTING: 210464.2

RECORD:
N1/4 COR SEC 27
CORNER LOST, RE-ESTABLISHED MIDWAY
BETWEEN NE&NW COR OF SEC 27
PLACED 5/8"x18" IPIN
P.K.'S 15' NE&NW
HENRY COUNTY, 1979

RECORD:
FD 5/8" IPIN
6" DOWN
LEANING SOUTH
6/2/98, MC
FD 5/8" IPIN
3" DOWN
9/7/18, JFO
7/25/19, JMR
FD 5/8" IPIN
3" DOWN
7/25/24, JAM
FD 5/8" IPIN
4" DOWN
REF 32
4-24-26, TDN
FD 5/8" IPIN
4" DOWN
SET UP ON MON32A, BACKSIGHT MON32C with Total station
REF32TS
8/11/26, TDN
SET 3/4" x 15" IPIN
1" DOWN
~~SET~~ w/ Total Station
SET REF32TS
9/3/26, TDN

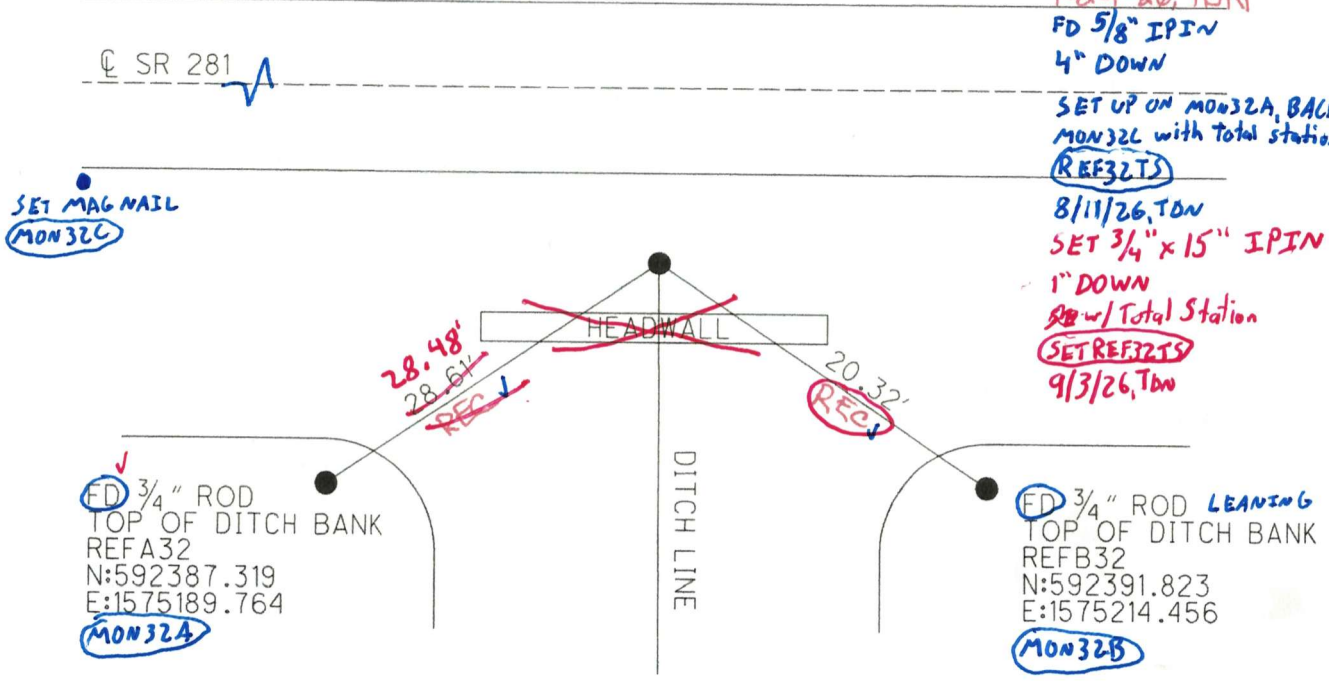

Shoot w/GPS during Precon

O.D.O.T. DISTRICT 2 SURVEY OFFICE (USE ONLY)

PERSONNEL

REFERENCE NO. 33

SHEET 28 OF 34

NOTES PRESTON-COLVIN
H.C. NEISE
R.C. PRESTON-COLVIN

DATE 11/26/24
WEATHER WINDY
TEMP. 40°

ROUTE SR 281
COUNTY HENRY
TOWNSHIP RICHFIELD
SECTION 26
T 4 N R 8 E

DWG BY PRESTON-COLVIN PID PAVING TRAIN


TYPE MONUMENT PK/WASHER ✓

~~ON SURFACE~~ - ~~BELOW~~ (ON)

OFFSET ℄ PAVEMENT 5.2' ~~LT~~ : RT

4.5' TO RT EDGE PAVEMENT

STATION: 840+91

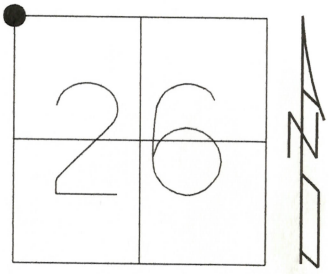


HORZ.DATUM: NAD83 2011 GEOID: 18

GRID: NORTHING: 592383.286 EASTING: 1577861.760

LDP: NORTHING: 449608.2 EASTING: 213119.6

RECORD:
FD IPIN OVER STONE
REMOVED PIN & PLACED
RR SPK ON SURFACE
NW COR SEC 26
HENRY COUNTY, 1979
SET SM.R.R.SPIKE
10/28/89
FD SM.R.R.SPIKE
ATOP R.R.SPIKE
6/2/98, MC
SET P.K./WASHER
9/29/98, MRC
FD P.K./WASHER
REF33
9/7/18, JFO
7/25/19,
1/11/23, JMR
FD PK/WASHER
7/25/24, TDN
FD PK/WASHER
11/26/24, TDN

FD PK/WASHER
REF 33
4-24-26, TDN

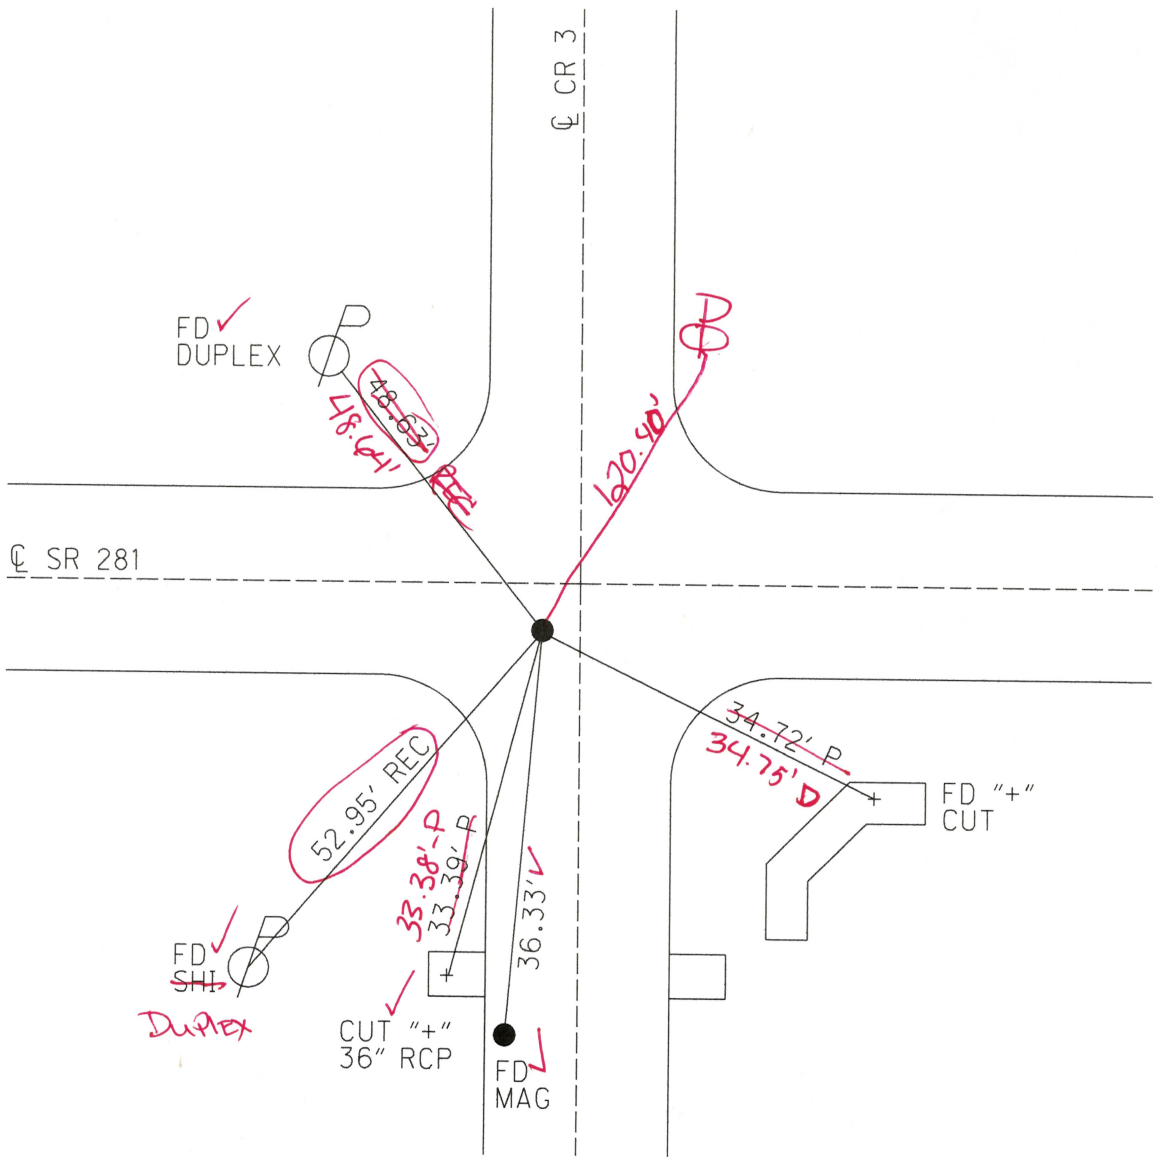

O.D.O.T. DISTRICT 2 SURVEY OFFICE (USE ONLY)

PERSONNEL HAJ

REFERENCE NO. 34

SHEET 29 OF 34

NOTES PRESTON-COLVIN

DATE 11/26/24 4-24-26

ROUTE SR 281

H.C. TDN NEISE

WEATHER WINDY P. Sunny/~~Rain~~ Windy

COUNTY HENRY

R.C. HAJ PRESTON-COLVIN

TEMP. 40° 77°

TOWNSHIP RICHFIELD

SECTION 26

T 4 N R 8 E

DWG BY PRESTON-COLVIN

PID PAVING TRAIN

TYPE MONUMENT MAG/WASHER ✓

~~ON SURFACE~~ - ~~BELOW~~ ON ✓

OFFSET ℄ PAVEMENT ~~7.9'~~ 8.1' ~~LT~~ : RT

2.8 ~~2.9'~~ TO RT EDGE PAVEMENT

STATION: 867+60

HORZ.DATUM: NAD83 2011


GEOID: 18

GRID: NORTHING: 592370.588

EASTING: 1580527.030


LDP: NORTHING: -

EASTING: -

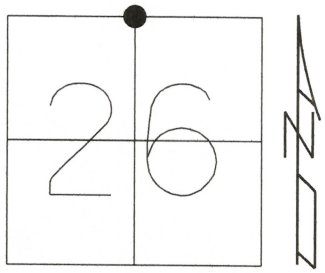

RECORD:
N 1/4 CORNER SEC 26
FD IPIPE OVER STONE
REMOVED PIPE AND PLACED
RR SPIKE OVER STONE
HENRY CO., 1979
SET SM.R.R.SPIKE
10/28/86
FD SM.R.R.SPIKE
ATOP R.R.SPIKE
6/2/98, MC
SET P.K./WASHER
9/29/98, MRC
FD SM.R.R.SPIKE
REF34
9/7/18, JFO
7/25/19,
1/11/23, JMR
SET MAG/WASHER
NEWREF34
11/26/24, TDN
SET BY GPS

FD MAG/WASHER
on Surface
4-24-26, TDN
REF 34

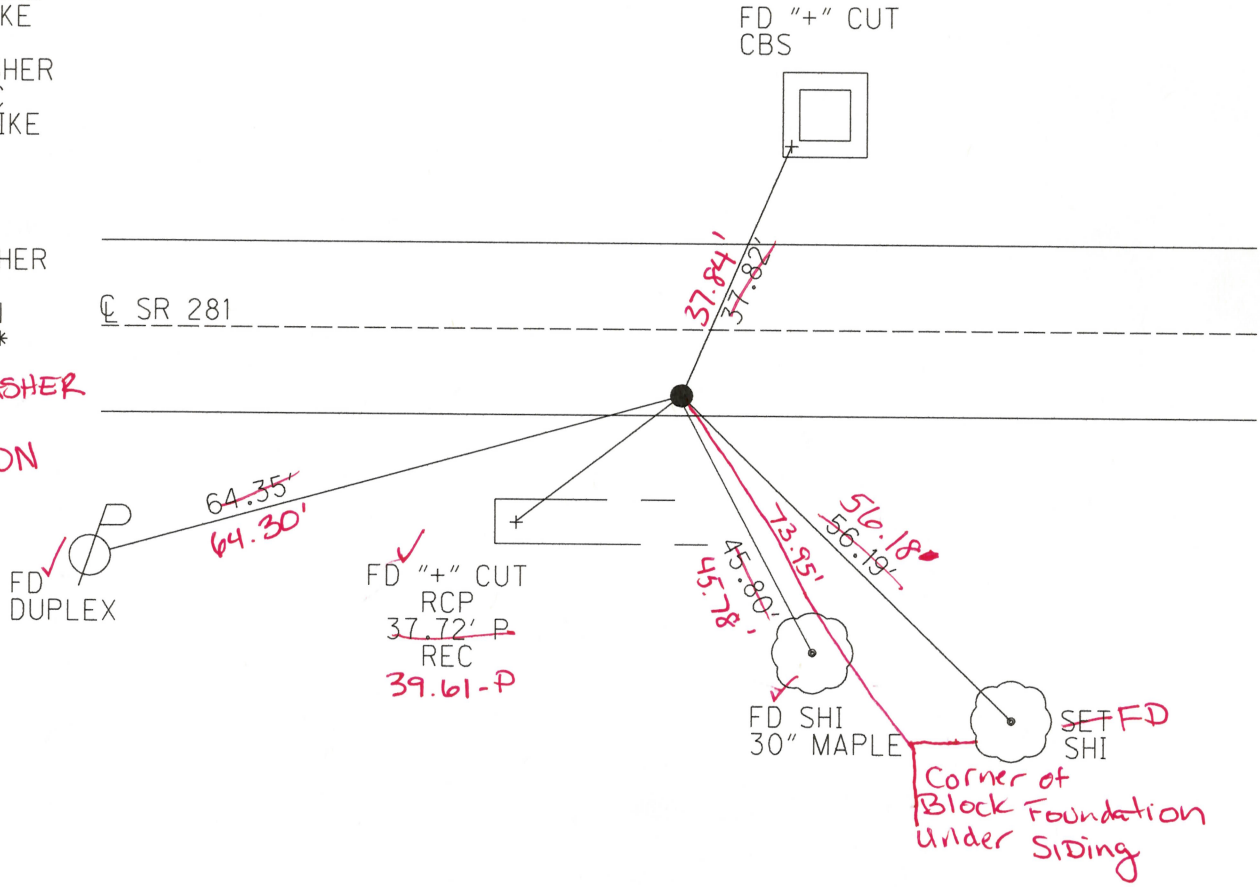

O.D.O.T. DISTRICT 2 SURVEY OFFICE (USE ONLY)

PERSONNEL

REFERENCE NO. 35

SHEET 30 OF 34

NOTES HAJ ~~HAJ~~ PRESTON-COLVIN

H.C. TDN NEISE

R.C. HAJ PRESTON-COLVIN

DATE 11/26/24 4-24-25

WEATHER WINDY ~~Sunny~~ Cloudy CALM

TEMP. 40° 69°

ROUTE SR 281

COUNTY HENRY

TOWNSHIP RICHFIELD

SECTION 25

T 4 N R 8 E

DWG BY PRESTON-COLVIN PID PAVING TRAIN

TYPE MONUMENT small RR SPIKE

~~ON SURFACE~~ - BELOW 1" 2"

OFFSET ℄ PAVEMENT 10.0' ~~LT~~ : RT


ON TO RT EDGE PAVEMENT

STATION: 899+27

HORZ.DATUM: NAD83 2011 GEOID: 18


GRID: NORTHING: 592359.117 EASTING: 1583189.767

LDP: NORTHING: 449681.8 EASTING: 218447.6

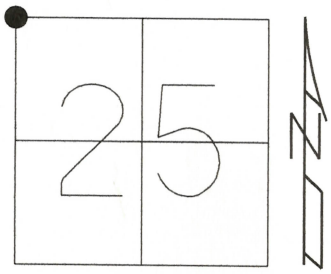

RECORD:
SET SM.R.R.SPIKE
10/28/86
FD SM.R.R.SPIKE
ATOP R.R.SPIKE
6/2/98, MC
SET P.K./WASHER
9/29/98, MRC
FD R.R.SPIKE
1" DOWN
REF35
9/7/18, JFO
7/25/19,
1/11/23, JMR
FD RRS 1" DOWN
REF35
7/25/24, TDN
FD RRS 1" DOWN
11/26/24, TDN

FD SM RR SPIKE
2" DOWN
4-24-26 TDN
REF 35

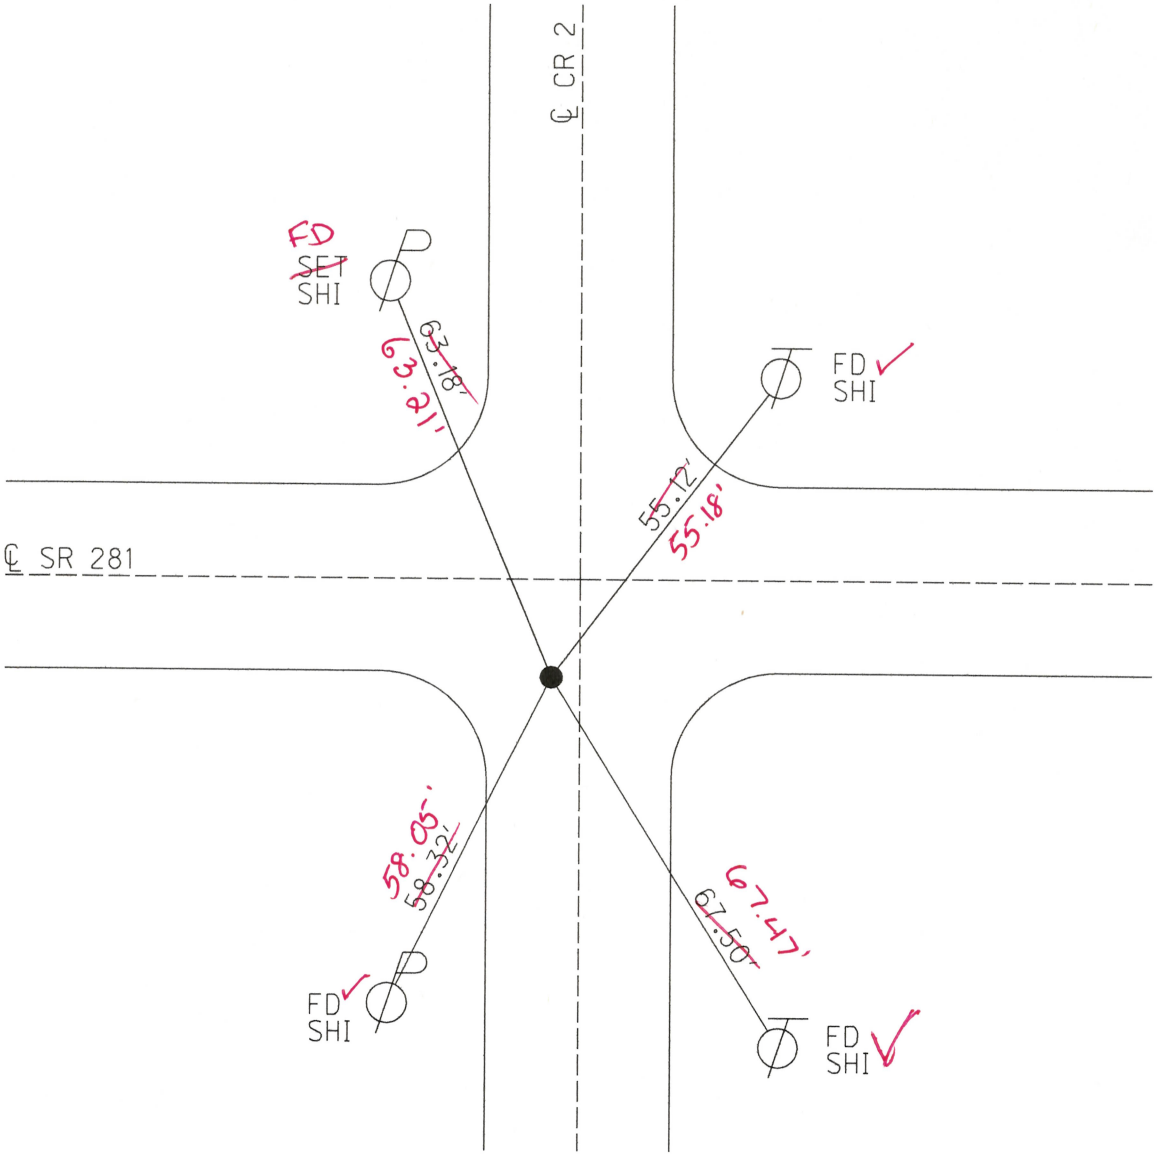

O.D.O.T. DISTRICT 2 SURVEY OFFICE (USE ONLY)

PERSONNEL

REFERENCE NO. 36

SHEET 31 OF 34

NOTES HAJ PRESTON-COLVIN

DATE 11/26/24 4-24-26

ROUTE SR 281

H.C. TDN NEISE

WEATHER WINDY Sunny Calm

COUNTY HENRY

R.C. HAJ PRESTON-COLVIN

TEMP. 40° 63°

TOWNSHIP RICHFIELD

SECTION 25

DWG BY PRESTON-COLVIN

PID PAVING TRAIN

T 4 N R 8 E


TYPE MONUMENT SM RR SPIKE ✓

~~ON SURFACE~~ - BELOW 2" 3"

OFFSET ℄ PAVEMENT ~~10.6'~~ 10.1' ~~LT~~ : RT ✓

0.6' ✓ TO RT EDGE PAVEMENT

STATION: 920+83

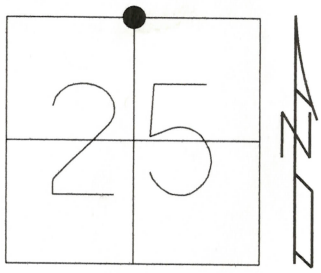

HORZ.DATUM: NAD83 2011

GEOID: 18

GRID: NORTHING: 592359.117


EASTING: 1583189.767

LDP: NORTHING: 449681.8

EASTING: 218447.6

RECORD:
FD SM.R.R.SPIKE
ATOP R.R.SPIKE
6/2/98, MC
FD SM.R.R.SPIKE
2" DOWN
REF36
9/7/18, JFO
7/25/19,
1/11/23, JMR
FD SM RRS
REF36
7/25/24, JAM
FD SM RRS
11/26/24, TDN

FD Sm RR spike
Bent EAST
Top 3" Down
Measured to BASE
4" Down
REF 36
4-24-26, TDN

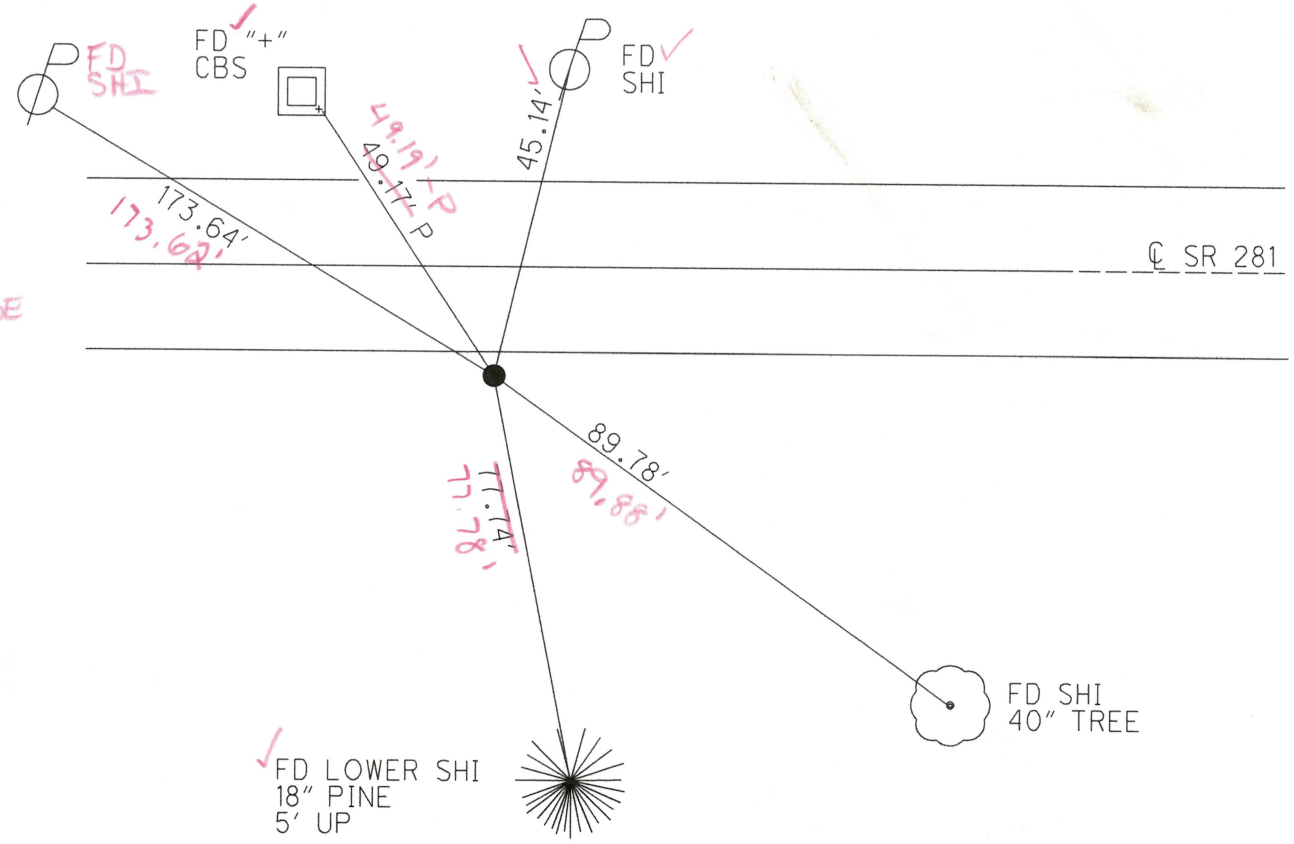

O.D.O.T. DISTRICT 2 SURVEY OFFICE (USE ONLY)

PERSONNEL

NOTES HAJ
H.C. TDN
R.C. LSPC

DWG BY

REFERENCE NO. 36AA


DATE 5-6-26
WEATHER Sunny CALM
TEMP. 51°

PID

SHEET ___ OF ___

ROUTE SR-281
COUNTY HENRY
TOWNSHIP RICHFIELD
SECTION 25
T 4 N R 8 E


TYPE MONUMENT PK NAIL
ON SURFACE - (BELOW) ~~ON~~ 2"
OFFSET ℄ PAVEMENT ___ LT : (RT)
___ TO ___ EDGE PAVEMENT
STATION:

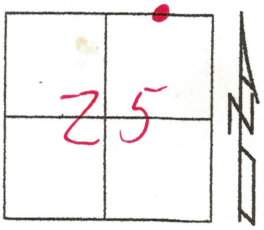

HORZ.DATUM: NAD83(2011)
GEOID: 18
GRID: NORTHING: 592323.526
EASTING: 1587177.770

RECORD:
PT FND USING TIES ON
"HEN-281-17.74-1989" Plans,
STA 934+25.65 ℄ Survey
- Point falls on line between
Sec. 25 N¼ Cor. and NE Cor
FND P.K. Nail
2" DOWN
REF36AA
5/6/26 TDN

36AA to PL5=3.01'

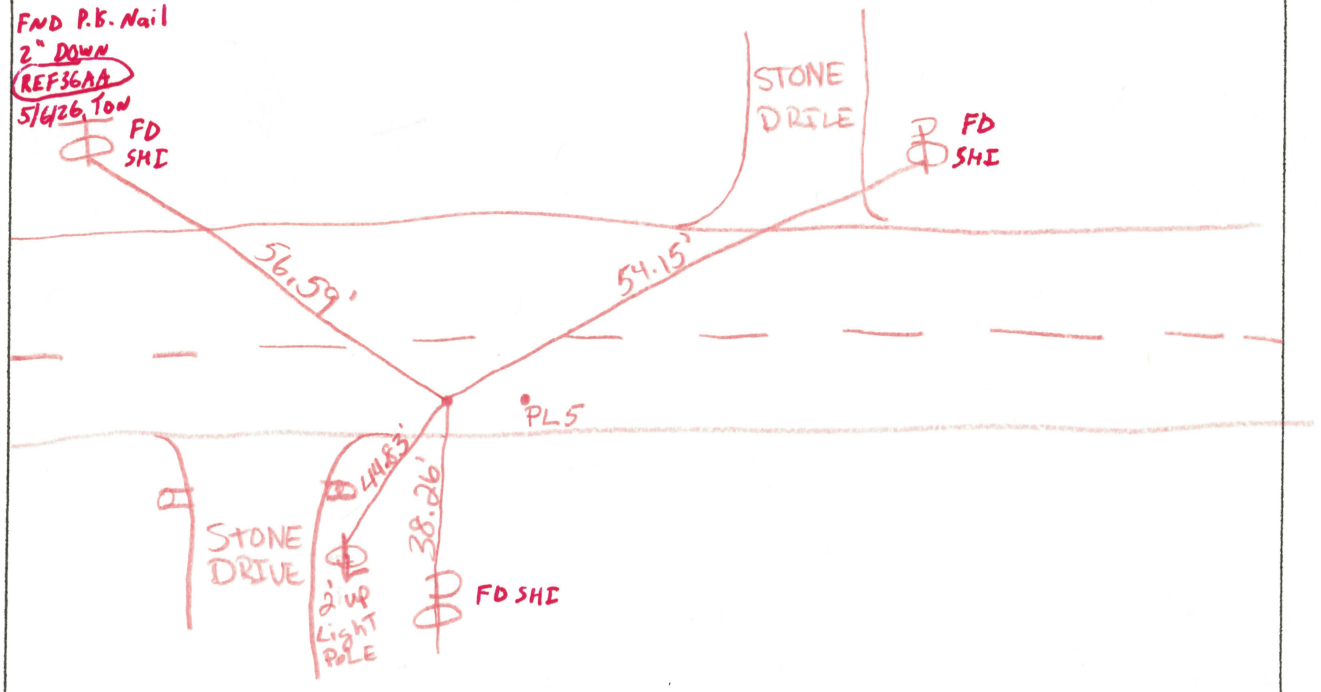

O.D.O.T. DISTRICT 2 SURVEY OFFICE (USE ONLY)

PERSONNEL

REFERENCE NO. 36A

SHEET 32 OF 34

NOTES HAJ PRESTON-COLVIN

DATE 11/26/24 4-24-26

ROUTE SR 281

H.C. TDN NEISE

WEATHER WINDY P Cloudy

COUNTY HENRY

R.C. HAJ PRESTON-COLVIN

TEMP. 40° 61° CALM

TOWNSHIP RICHFIELD

SECTION 25

T 4 N R 8 E

DWG BY PRESTON-COLVIN PID PAVING TRAIN


TYPE MONUMENT MONBOX ✓

~~ON SURFACE~~ - ~~BELOW~~ ~~2"~~ ON

OFFSET ℄ PAVEMENT ~~11'~~ 10.6' ~~LT~~ : RT

~~0.3'~~ 0.0' TO RT EDGE PAVEMENT

STATION: 936+03.62

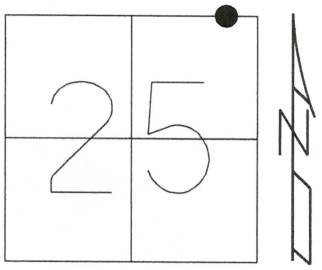


HORZ.DATUM: NAD83 2011 GEOID: 18

GRID: NORTHING: 592318.170 EASTING: 1587371.210

LDP: NORTHING: 449717.7 EASTING: 222629.4

RECORD:
FD MONBOX
W/BOLT
SHOT TOP CTR LID
REFA36
9/7/18, JFO
7/25/19, JMR
FD MON BOX
REF36A
7/25/24, JAM
FD MON BOX
4-24-26, TDN

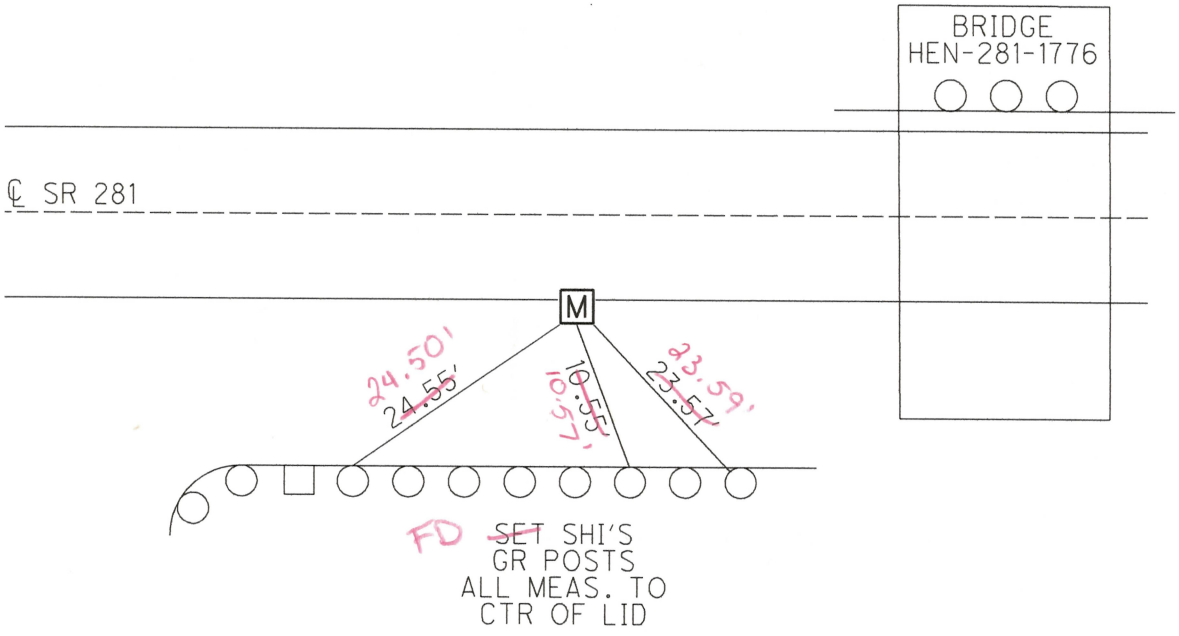

O.D.O.T. DISTRICT 2 SURVEY OFFICE (USE ONLY)

PERSONNEL

REFERENCE NO. 36B

SHEET 33 OF 34

NOTES PRESTON-COLVIN HAJ

DATE 11/26/24 4-24-26

ROUTE SR 281

H.C. TDN NEISE

WEATHER WINDY P.Cloudy calm

COUNTY HENRY

R.C. HAJ PRESTON-COLVIN

TEMP. 40° 61°


TOWNSHIP RICHFIELD

SECTION 25

T 4 N R 8 E

DWG BY PRESTON-COLVIN

PID PAVING TRAIN

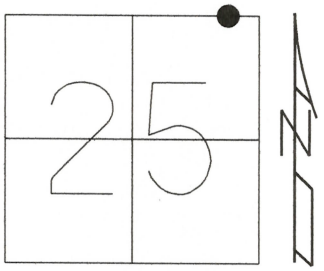

TYPE MONUMENT MONBOX ✓ 1" IPIN

~~ON SURFACE~~ - BELOW ON ✓

OFFSET ℄ PAVEMENT 9.5' ~~LT~~ : RT

0.9' TO RT EDGE PAVEMENT

STATION: 938+83.72

HORZ.DATUM: NAD83 2011

GEOID: 18

GRID: NORTHING: 592316.625


EASTING: 1587651.079

LDP: NORTHING: 449717.7

EASTING: 222629.4

RECORD:
FD MONBOX
COVERED W/ASPHALT
SHOT CTR LID
REFB36
9/7/18, JFO
7/25/19, JMR
FD MON BOX
REF36B
7/25/24, JAM

FD MON BOX
With 1" IPIN
4-24-26, TDN

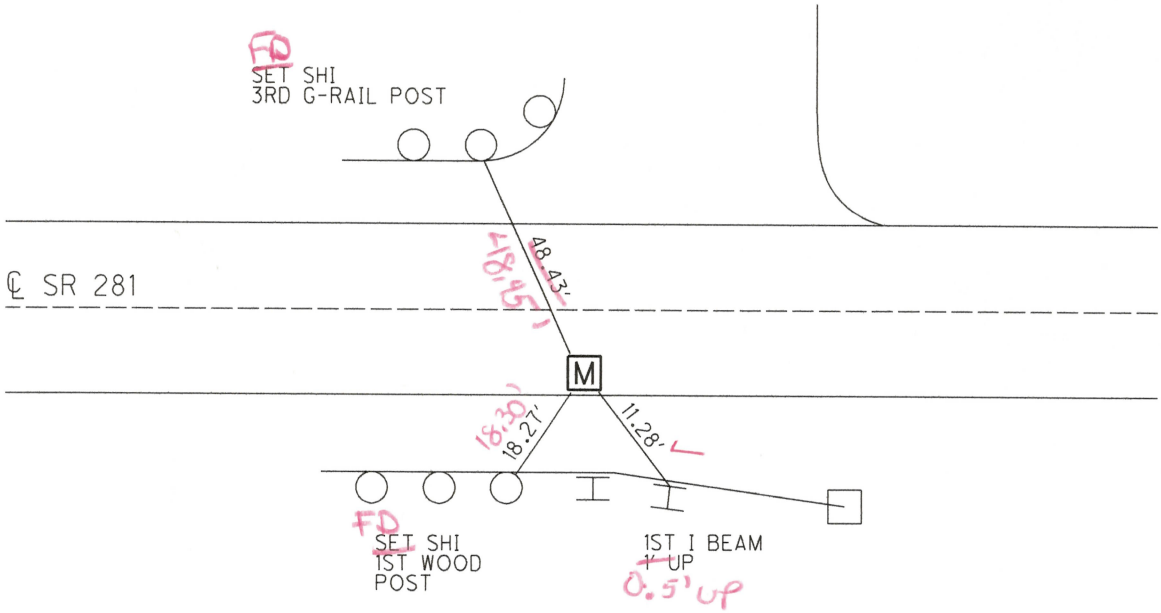

O.D.O.T. DISTRICT 2 SURVEY OFFICE (USE ONLY)

PERSONNEL

REFERENCE NO. 37

SHEET 34 OF 34

NOTES PRESTON-COLVIN HAS

H.C. TDN NEISE

R.C. HAS PRESTON-COLVIN

DATE 11/26/24 4-24-26

WEATHER WINDY P.Cloudy/Calm

TEMP. 40° 61°

ROUTE SR 281

COUNTY HENRY

TOWNSHIP RICHFIELD

SECTION 25

T 4 N R 8 E

DWG BY PRESTON-COLVIN PID PAVING TRAIN


TYPE MONUMENT ~~MAG/WASHER~~ MAG/SHANK

~~ON SURFACE~~ - BELOW ON ✓

OFFSET ℄ PAVEMENT - 10.9' ~~LT~~ : RT

- TO - EDGE PAVEMENT

STATION: 947+59

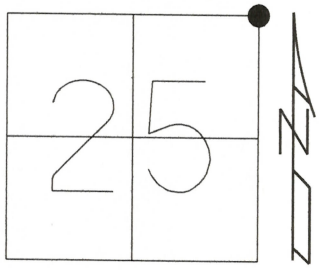

HORZ.DATUM: NAD83 2011

GEOID: 18

GRID: NORTHING: ~~592316.625~~


EASTING: ~~1587651.079~~

LDP: NORTHING: 449717.7

EASTING: 222629.4

RECORD:
FD R.R.SPIKE
1/8/75, TOMSIC
FD SM.R.R.SPIKE
5/22/90, CL
7/2/12, DCH
SET MAG/WASHER
NEWREF1
9/24/12, DCH
FD MAG/WASHER
REF37
9/7/18, JFO
FD MAG/WASHER
REF37
7/25/24, JAM
FD MAG/WASHER
11/26/24, TDN
FD MAG SHANK
4-24-26, TDN

37 to Wood ~~REF1~~ REF2: 52.87'

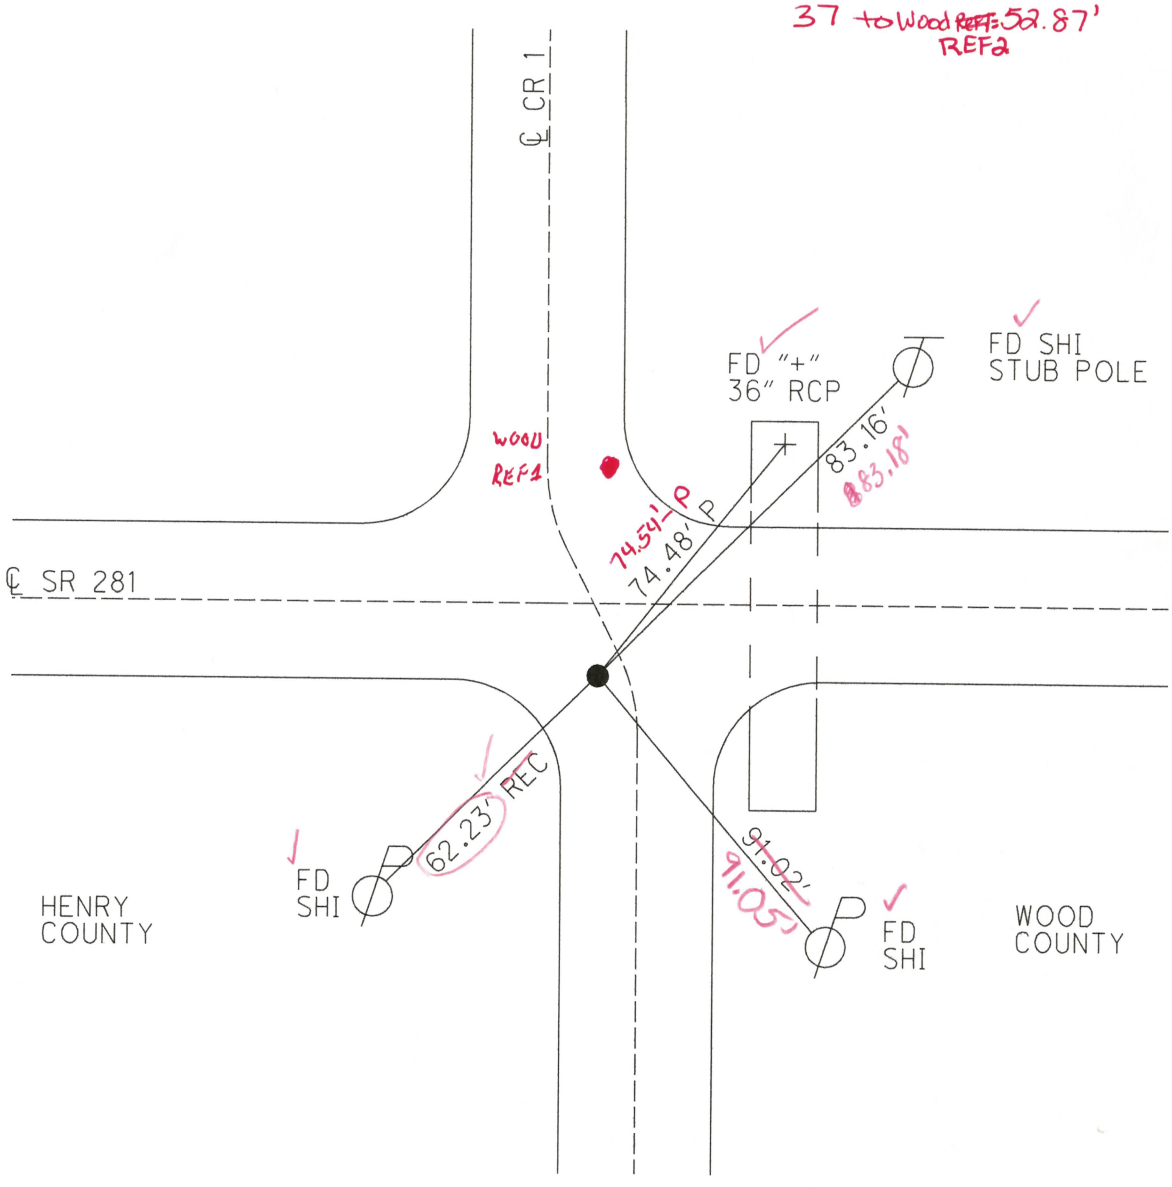

O.D.O.T. DISTRICT 2 SURVEY OFFICE (USE ONLY)

PERSONNEL

NOTES RHOADES
H.C. O'DONNELL
R.C. RHOADES

DWG BY NIESE


REFERENCE NO. 1

DATE 9/7/18
WEATHER CLOUDY
TEMP. 69°

PID CHIP_2

SHEET 1 OF 15

ROUTE SR 281
COUNTY WOO
TOWNSHIP MILTON
SECTION 19
T 4 N R 9 E

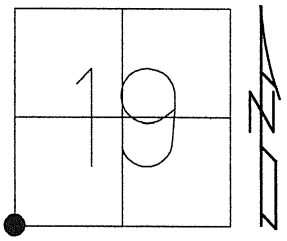


TYPE MONUMENT MAG/WASHER
ON SURFACE - BELOW ON
OFFSET ℄ PAVEMENT - LT : RT
- TO - EDGE PAVEMENT
STATION: 0+00

HORZ.DATUM: NAD83(2011)
GEOID: 2012A
GRID: NORTHING: 592312.219
EASTING: 1588509.764

RECORD:
FD R.R.SPIKE
1/8/75, TOMSIC
FD SM.R.R.SPIKE
5/22/90, CL
7/2/12, DCH
SET MAG/WASHER
NEWREF1
9/24/12, DCH
FD MAG/WASHER
REF37
9/7/18, JFO

NOTE:
REF 37 HEN SR 281

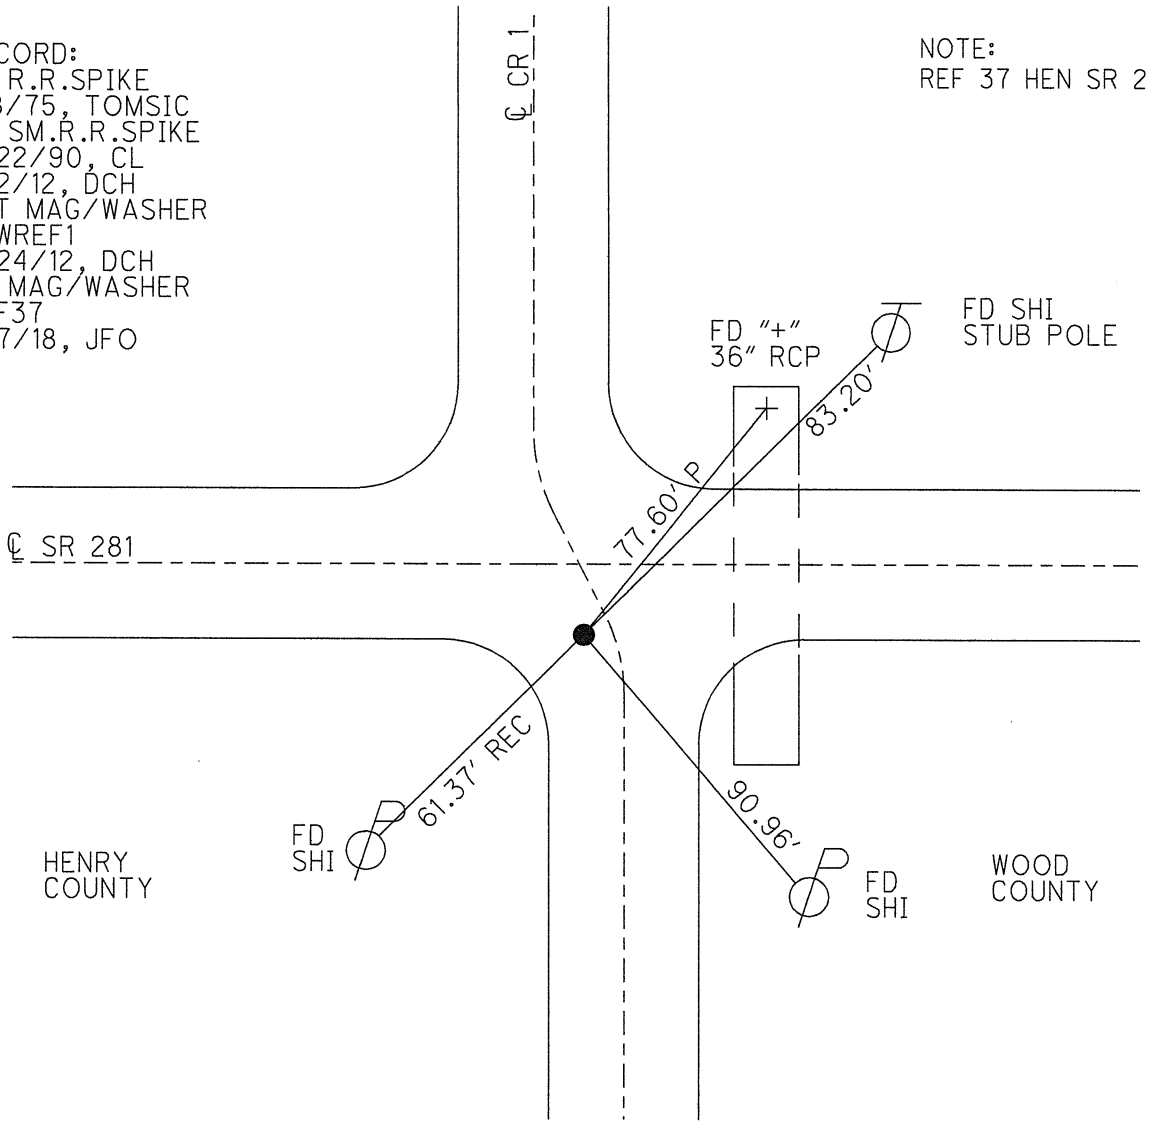

O.D.O.T. DISTRICT 2 SURVEY OFFICE (USE ONLY)

PERSONNEL

NOTES HOMAN ~~HAJ~~
H.C. ROUSOS ~~TDN~~
R.C. HOMAN ~~HAJ~~


REFERENCE NO. 2 SHEET 2 OF 15

DATE ~~7/2/12~~ 4/24/26
WEATHER ~~SUNNY~~ Pt. Cloudy
TEMP. ~~75°~~ 61°

ROUTE SR 281
COUNTY WOOD
TOWNSHIP MILTON
SECTION 19
T 4 N R 9 E

TYPE MONUMENT ~~LG.R.R.SPIKE~~ Mag Spike
ON SURFACE - ~~BELOW~~ ON ✓
LEFT - ℄ PAV'T - ~~RIGHT~~ ~~42.6~~ 41.8'
- TO - EDGE PAVEMENT (ON E/EP NORTH)
S.L.M. 0+00


GRID: NORTHING: 592365.~~027~~ .140 EASTING: ~~1588509.995~~ 1588510.102
WOOD OCCS 413365.374 100084.331

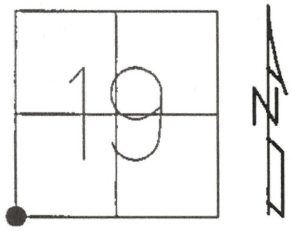

RECORD:
FD LG.R.R.SPIKE
5/22/90, CL

FD LG.R.R.SPIKE
7/2/12, DCH

SET MAG/WASHER
GPS, NEWREF2
9/24/12, DCH
FND MAG SPIKE
REF2
4/24/26, TDN

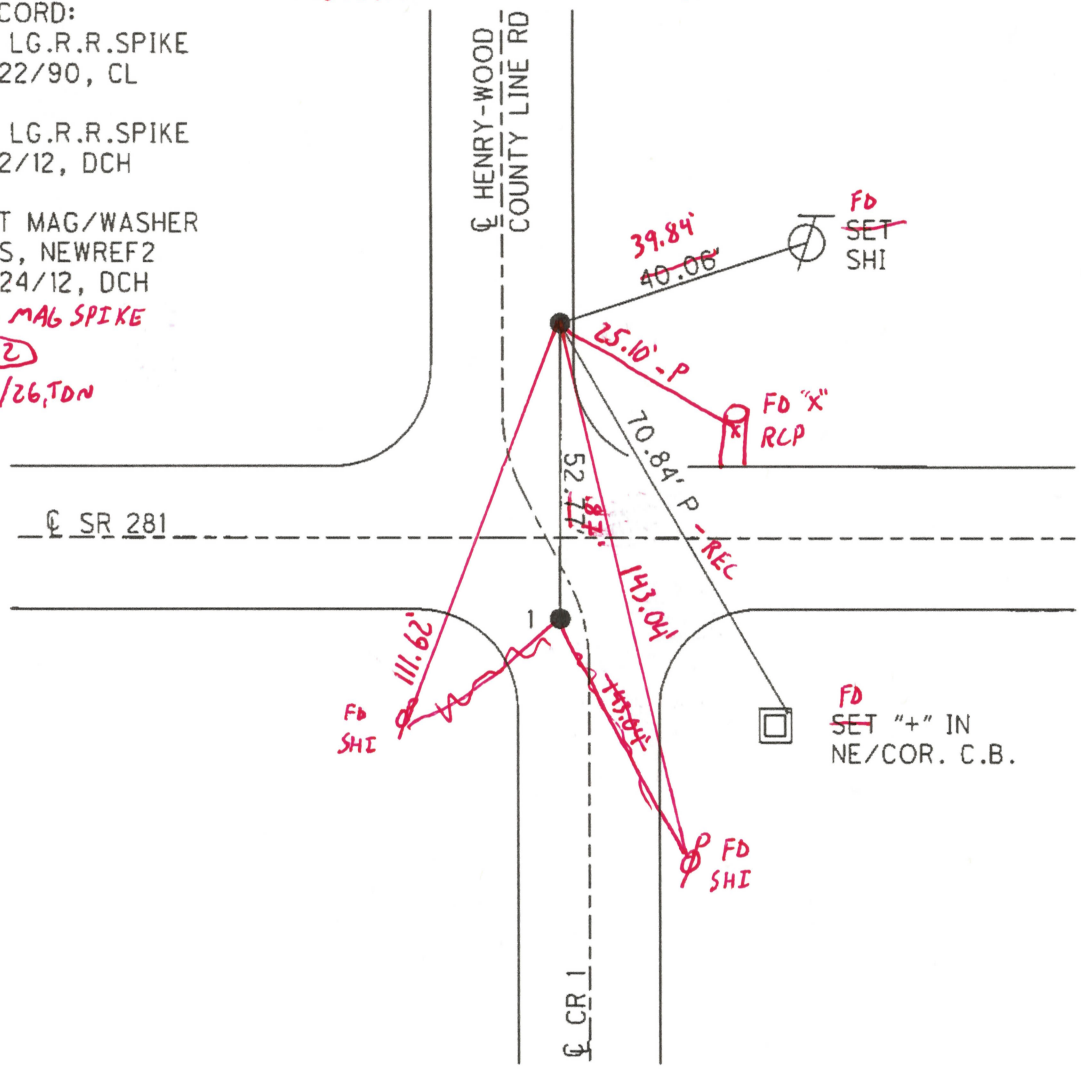

O.D.O.T. DISTRICT 2 SURVEY OFFICE (USE ONLY)

PERSONNEL

NOTES PRESTON-COLVIN HAS

H.C. TDN PRESTON-COLVIN

R.C. HAS FRUCHEY

DWG BY FRUCHEY

REFERENCE NO. 3

DATE 6/12/25 4-24-26

WEATHER CLOUDY P.CLOUDY CALM

TEMP. 71° 61°

PID PAVING TRAIN

SHEET 3 OF 15

ROUTE SR 281

COUNTY WOOD

TOWNSHIP MILTON

SECTION 19

T 4 N R 9 E


TYPE MONUMENT MAG SHANK ✓

ON SURFACE - BELOW ON

OFFSET ℄ PAVEMENT 4.5' LT : ~~RT~~

5.2' TO LT EDGE PAVEMENT

STATION: 26+03

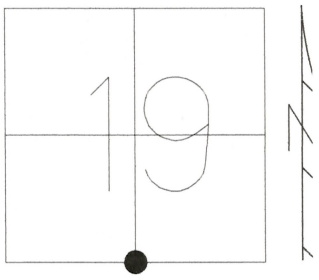

HORZ.DATUM: NAD83 2011 ✓

GEOID: NAVD88 2018 ✓

GRID: NORTHING: 592419.~~531~~ .559

EASTING: 1591108.~~961~~ .997

LDP: NORTHING: 413454.~~035~~ .033

EASTING: 102682.~~378~~ .500

RECORD:
FD SM.R.R.SPIKE
5/22/90, CL
SET SM.R.R.SPIKE
7/2/90, MB
FD SM.R.R.SPIKE
7/2/12, DCH
SET MAG/WASHER
NEWREF3
9/25/12, DCH
FD MAG SHANK
REF3
7/15/22, DSA
2/10/23, TDN
FD MAG SHANK
REF 3
6/12/25, LSPC

FD MAG SHANK
~~DS~~ 0.5" DOWN
4-24-26, TDN

