


# STATE OF OHIO DEPARTMENT OF TRANSPORTATION

## HUR-13-0.00

FITCHVILLE TOWNSHIP  
GREENWICH TOWNSHIP

HURON COUNTY

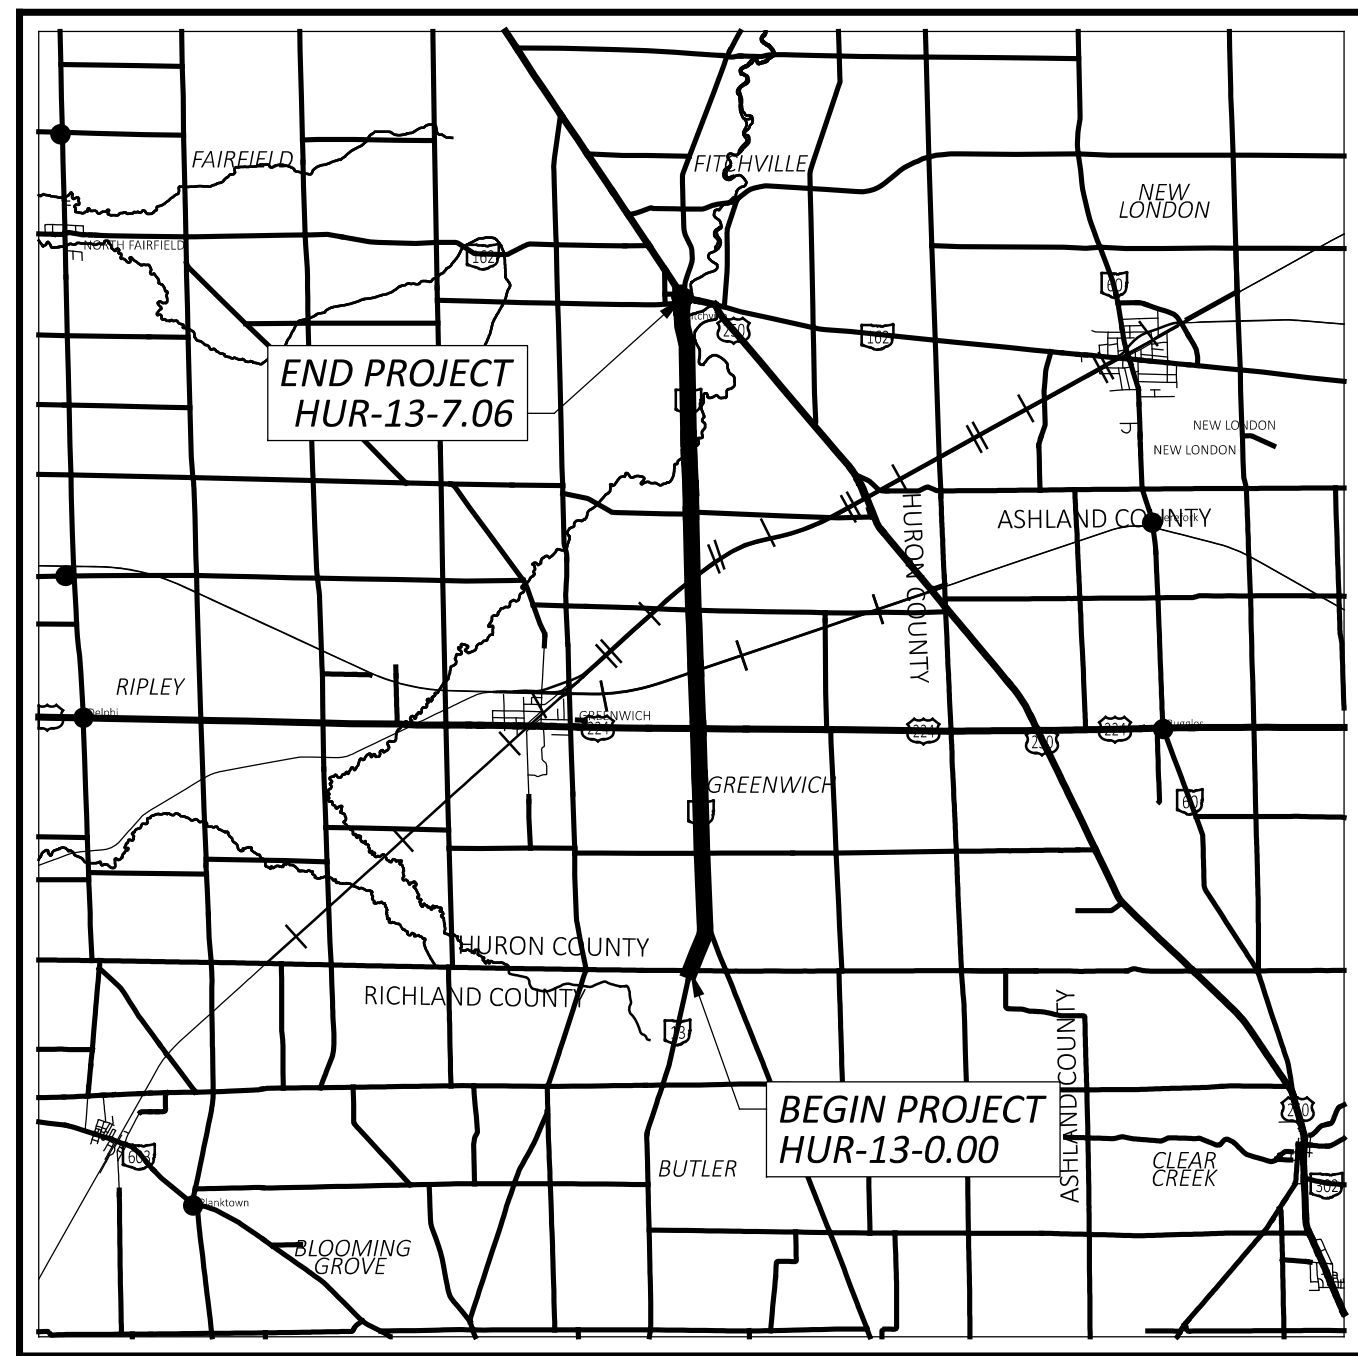

**LOCATION MAP**

LATITUDE: 41°02'42" N LONGITUDE: 82°29'12" W



PORTION TO BE IMPROVED	
INTERSTATE HIGHWAY	
FEDERAL ROUTES	
STATE ROUTES	
COUNTY & TOWNSHIP ROADS	
OTHER ROADS	

**DESIGN DESIGNATION**

	HUR-13-0.00-2.55	HUR-13-2.55-3.17	HUR-13-3.17-7.06
CURRENT ADT (2024)	3,300	2,500	2,500
DESIGN YEAR ADT (2044)	3,400	2,600	2,500
DESIGN HOURLY VOLUME (2044)	300	250	250
DIRECTIONAL DISTRIBUTION	50.8%	55.7%	53.2%
TRUCKS (24 HOUR B&C)	20%	13%	14%
DESIGN SPEED	55 MPH	55 MPH	55 MPH
LEGAL SPEED	55 MPH	55 MPH	55 MPH
DESIGN FUNCTIONAL CLASSIFICATION:	MINOR ARTERIAL	MINOR ARTERIAL	MINOR ARTERIAL
NHS PROJECT	NO	NO	NO

**DESIGN EXCEPTIONS**

SHOULDER WIDTH (APPROVAL DATE 11/20/23)  
SUPERELEVATION RATE (APPROVAL DATE 11/20/23)

**ADA DESIGN WAIVERS**

NONE

**UNDERGROUND UTILITIES**  
Contact Two Working Days  
Before You Dig

**OHIO811.org**  
Before You Dig

OHIO811, 8-1-1, or 1-800-362-2764  
(Non members must be called directly)

**ENGINEER'S SEAL**

**INDEX OF SHEETS:**

TITLE SHEET	1
SCHEMATIC PLAN	2 - 9
TYPICAL SECTIONS	10 - 11
GENERAL NOTES	12 - 15
GUARDRAIL NOTES	16
MAINTENANCE OF TRAFFIC NOTES	17 - 18
DETOUR PLAN	19 - 21
GENERAL SUMMARY	22 - 24
PAVEMENT & SHOULDER DATA	25
ROADWAY SUB-SUMMARY	26
GUARDRAIL DETAILS	27 - 31
DRAINAGE SUB-SUMMARY	32
CULVERT DETAILS	
HUR-13-0.98	33
HUR-13-1.68	34
HUR-13-4.38	35
HUR-13-5.21	36 - 37
HUR-13-5.52	38
PAVEMENT MARKING/RPM SUB-SUMMARY	39
STRUCTURE NOTES	40
STRUCTURE DETAILS	
HUR-13-3.05	41
HUR-13-5.45	42
PROFILE ELEVATION TABLES	43 - 57
PIS: GR-1.1	58 - 60
PIS: GR-2.1	61 - 62
PIS: GR-3.4	63
GEOTECHNICAL PROFILE - ROADWAY CENTERLINE PLAT	

STANDARD CONSTRUCTION DRAWINGS								SUPPLEMENTAL SPECIFICATIONS		SPECIAL PROVISIONS
BP-3.1	1/21/22	MGS-1.1	7/16/21	MT-97.10	4/19/19	TC-41.20	10/18/13	800-2023	10/20/23	WATERWAY PERMIT
BP-3.2	1/18/19	MGS-2.1	1/19/18	MT-97.12	1/20/17	TC-42.20	10/18/13	830	7/19/19	CONDITIONS
BP-4.1	7/19/13	MGS-2.3	1/20/23	MT-99.20	4/19/19	TC-52.10	10/18/13	832	7/21/23	DATED 12/21/23
BP-5.1	7/15/22	MGS-4.2	7/19/13	MT-101.90	7/17/20	TC-52.20	1/15/21	833	7/21/23	
		MGS-4.3	1/18/13	MT-105.10	1/17/20	TC-61.30	7/19/19	872	1/21/22	
CB-3A	7/16/21					TC-64.10	7/21/23	874	4/17/20	
DM-1.1	7/17/20	RM-1.1	1/20/23			TC-65.10	1/17/14	875	1/18/19	
DM-1.2	7/16/21					TC-65.11	7/15/22	899	1/20/23	
DM-4.3	1/15/16					TC-71.10	4/21/23			
DM-4.4	1/15/16									
HW-2.1	7/15/22									

**FEDERAL PROJECT NUMBER**

E161192

**RAILROAD INVOLVEMENT**

CSX TRANSPORTATION, INC.

**PROJECT DESCRIPTION**

THIS PROJECT SHALL CONSIST OF THE FULL DEPTH PAVEMENT REPLACEMENT OF SR 13 FROM THE RICHLAND COUNTY LINE (SLM 0.00) TO US 250 (SLM 7.06). THIS PROJECT WILL ALSO INCLUDE GUARDRAIL REPAIR, MINOR CULVERT REPAIR, STRUCTURE MAINTENANCE AND PAVEMENT MARKINGS.

**EARTH DISTURBED AREAS**

PROJECT EARTH DISTURBED AREA:	50.1 ACRES
ESTIMATED CONTRACTOR EARTH DISTURBED AREA:	1.0 ACRES
NOTICE OF INTENT EARTH DISTURBED AREA:	51.1 ACRES

**2023 SPECIFICATIONS**

THE STANDARD SPECIFICATIONS OF THE STATE OF OHIO, DEPARTMENT OF TRANSPORTATION, INCLUDING SUPPLEMENTAL SPECIFICATIONS LISTED IN THE PLANS, CHANGES LISTED IN THE PROPOSAL, AND THE SUPPLEMENTAL SPECIFICATION 800 VERSION INDICATED ON THE PROPOSAL SHALL GOVERN THIS IMPROVEMENT.

I HEREBY APPROVE THESE PLANS AND DECLARE THAT THE MAKING OF THIS IMPROVEMENT WILL REQUIRE THE CLOSING TO TRAFFIC OF THE HIGHWAY AND THAT DETOURS WILL BE PROVIDED AS INDICATED ON SHEETS 19-21.

Robert Weaver  
District 03 Deputy Director

Jack Marchbanks, PhD  
Director, Department of Transportation

PLANS PREPARED BY:

OHIO DEPARTMENT OF  
TRANSPORTATION  
DISTRICT THREE ENGINEERING

TITLE SHEET

DESIGN AGENCY  
DISTRICT 3



ENGINEERING  
TEAM ONE

DESIGNER  
JLL

REVIEWER  
KRB 11/13/23


PROJECT ID  
101386

SHEET TOTAL  
P.1 | 63

HUR-13-0.00

MODEL: Sheet PAPER: 34x22 (in.) DATE: 1/10/2024 TIME: 4:32:13 PM USER: ksalay pvc:\ohiodot-pw-bentley.com\ohiodot-pw-02\Documents\01 Active Projects\District 03\Huron\101386\40b-Engineering\Roadway\Sheets\101386\_GTO01.dgn



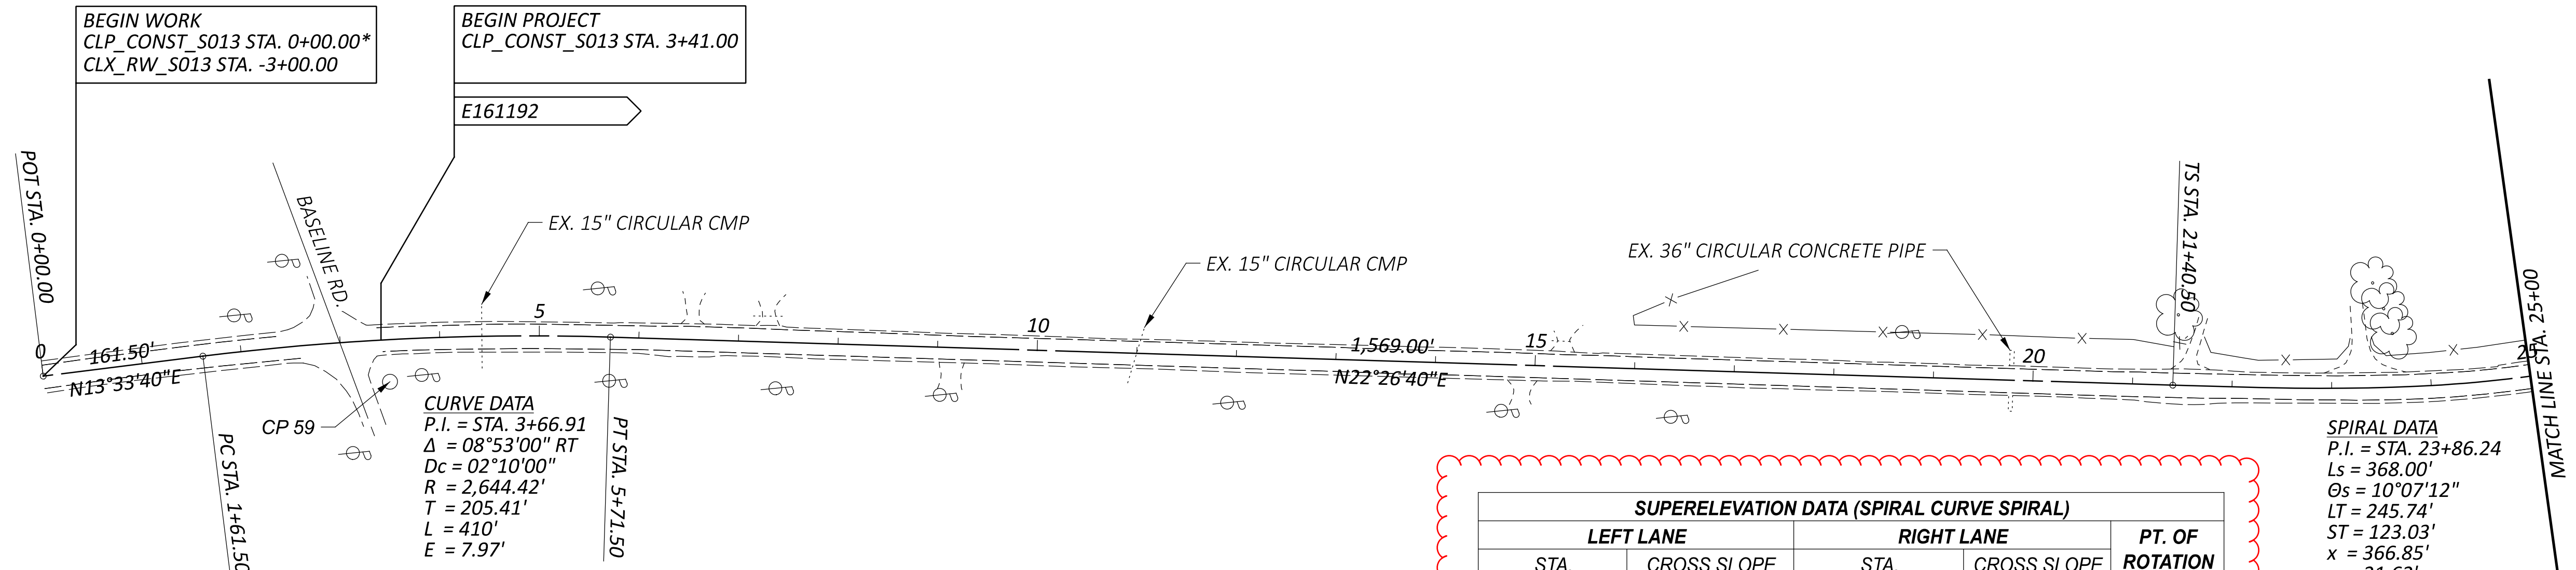

BEGIN WORK  
 CLP\_CONST\_S013 STA. 0+00.00\*  
 CLX\_RW\_S013 STA. -3+00.00

BEGIN PROJECT  
 CLP\_CONST\_S013 STA. 3+41.00

**CURVE DATA**  
 P.I. = STA. 3+66.91  
 $\Delta = 08^{\circ}53'00''$  RT  
 $D_c = 02^{\circ}10'00''$   
 $R = 2,644.42'$   
 $T = 205.41'$   
 $L = 410'$   
 $E = 7.97'$


**SPIRAL DATA**  
 P.I. = STA. 23+86.24  
 $L_s = 368.00'$   
 $\theta_s = 10^{\circ}07'12''$   
 $LT = 245.74'$   
 $ST = 123.03'$   
 $x = 366.85'$   
 $y = 21.62'$   
 $k = 183.81'$   
 $p = 5.41'$   
 $C = 367.49'$   
 Start = Sta. 21+40.50  
 End = Sta. 25+08.50  
 C.B. =  $N19^{\circ}04'19''E$

**NOTES**

\* 0.00' OFFSET FROM CLX RW S013


SUPERELEVATION DATA (SIMPLE CURVE)				
LEFT LANE		RIGHT LANE		PT. OF ROTATION
STA.	CROSS SLOPE	STA.	CROSS SLOPE	
0+00.00	0	0+00.00	-0.016	CROWN
0+41.00	-0.016	0+41.00	-0.016	RT. EP
2+10.00	-0.049	2+10.00	-0.049	RT. EP
4+35.00	-0.049	4+35.00	-0.049	RT. EP
6+04.00	-0.016	6+04.00	-0.016	RT. EP
6+45.00	0	6+45.00	-0.016	CROWN
6+86.00	0.016	6+86.00	-0.016	CROWN

SUPERELEVATION DATA (SPIRAL CURVE SPIRAL)				
LEFT LANE		RIGHT LANE		PT. OF ROTATION
STA.	CROSS SLOPE	STA.	CROSS SLOPE	
21+00.00	0.016	21+00.00	-0.016	CROWN
21+40.50	0.016	21+40.50	0	CROWN
21+81.50	0.016	21+81.50	0.016	LT. EP
25+08.50	0.08	25+08.50	0.08	LT. EP
25+87.00	0.08	25+87.00	0.08	LT. EP
29+13.50	0.016	29+13.50	0.016	LT. EP
29+55.00	0.016	29+55.00	0	CROWN
29+95.50	0.016	29+95.50	-0.016	CROWN

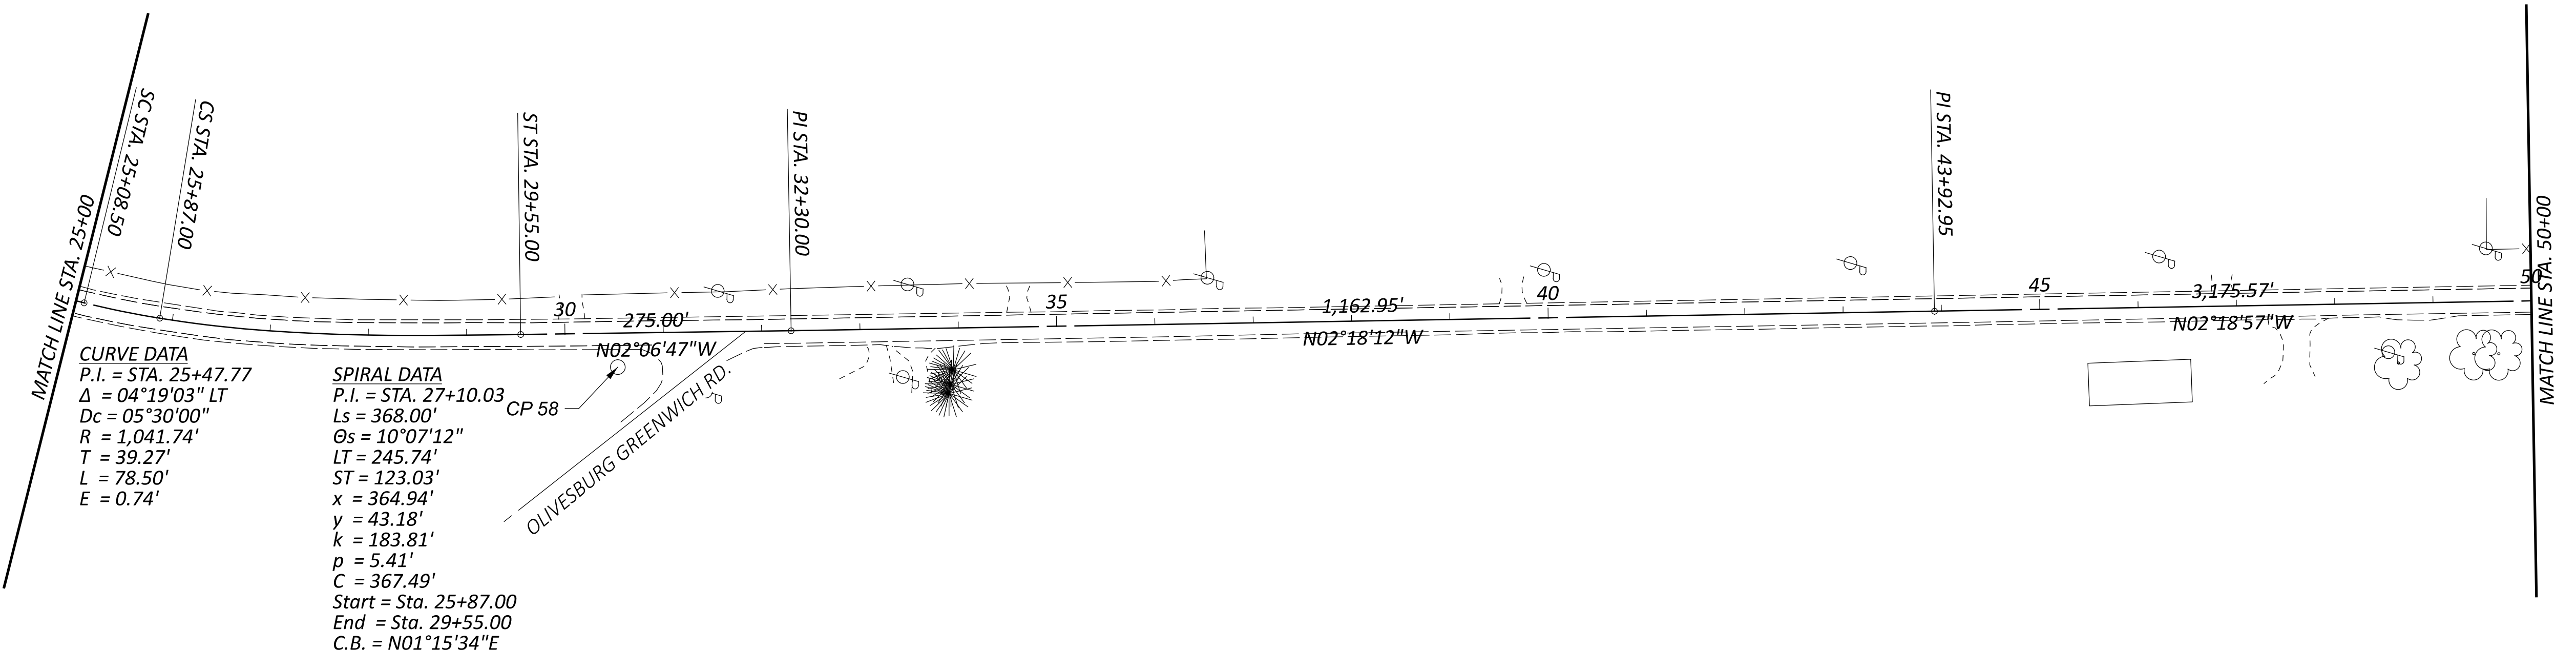

**CURVE DATA**  
 P.I. = STA. 25+47.77  
 $\Delta = 04^{\circ}19'03''$  LT  
 $D_c = 05^{\circ}30'00''$   
 $R = 1,041.74'$   
 $T = 39.27'$   
 $L = 78.50'$   
 $E = 0.74'$

**SPIRAL DATA**  
 P.I. = STA. 27+10.03  
 $L_s = 368.00'$   
 $\theta_s = 10^{\circ}07'12''$   
 $LT = 245.74'$   
 $ST = 123.03'$   
 $x = 364.94'$   
 $y = 43.18'$   
 $k = 183.81'$   
 $p = 5.41'$   
 $C = 367.49'$   
 Start = Sta. 25+87.00  
 End = Sta. 29+55.00  
 C.B. =  $N01^{\circ}15'34''E$

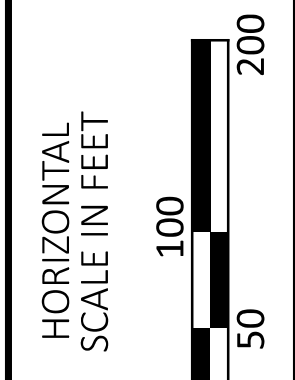

**SCHEMATIC PLAN  
 HUR-13**

DESIGN AGENCY  
**DISTRICT 3**


ENGINEERING  
 TEAM ONE

DESIGNER  
 JSR


REVIEWER  
 KRB 11-13-23

PROJECT ID  
 101386

SHEET TOTAL  
 P.2 43

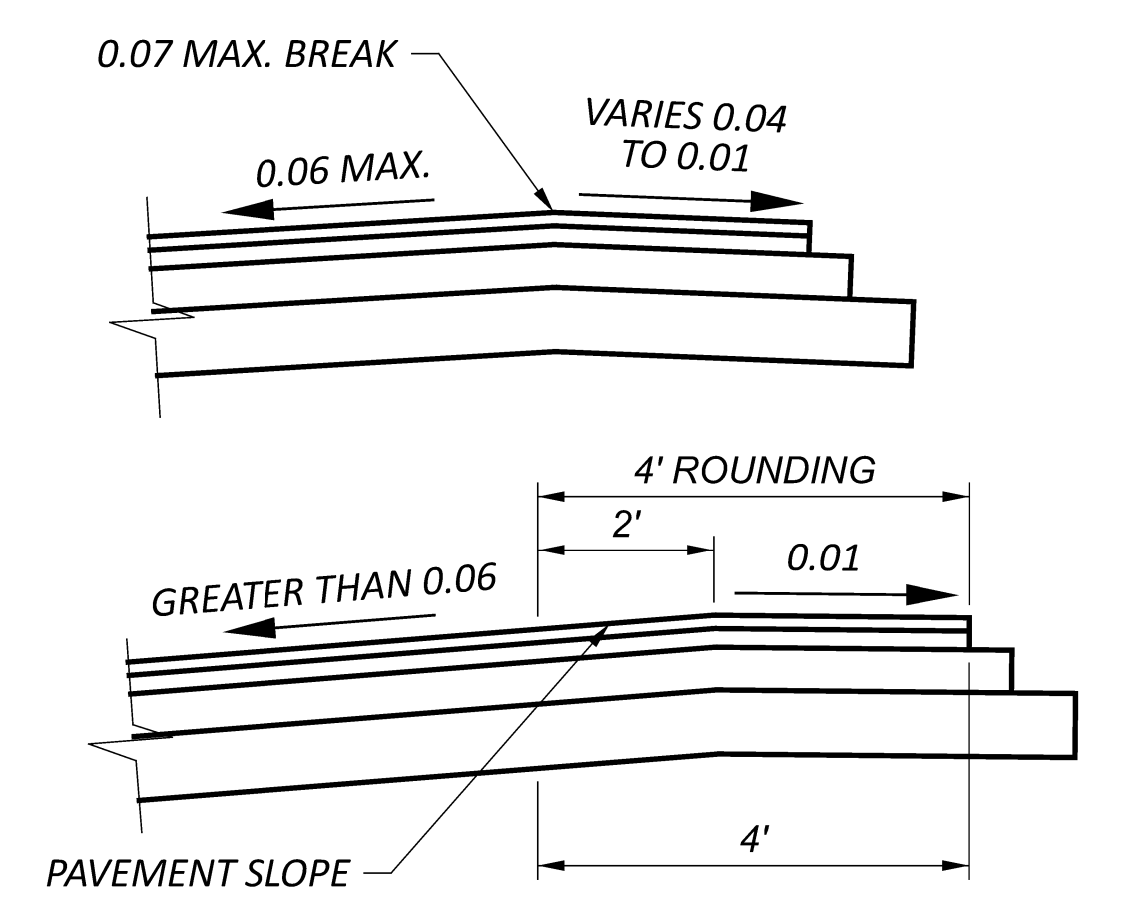


UNCURBED-HIGH SIDE OF SUPERELEVATED SECTIONS

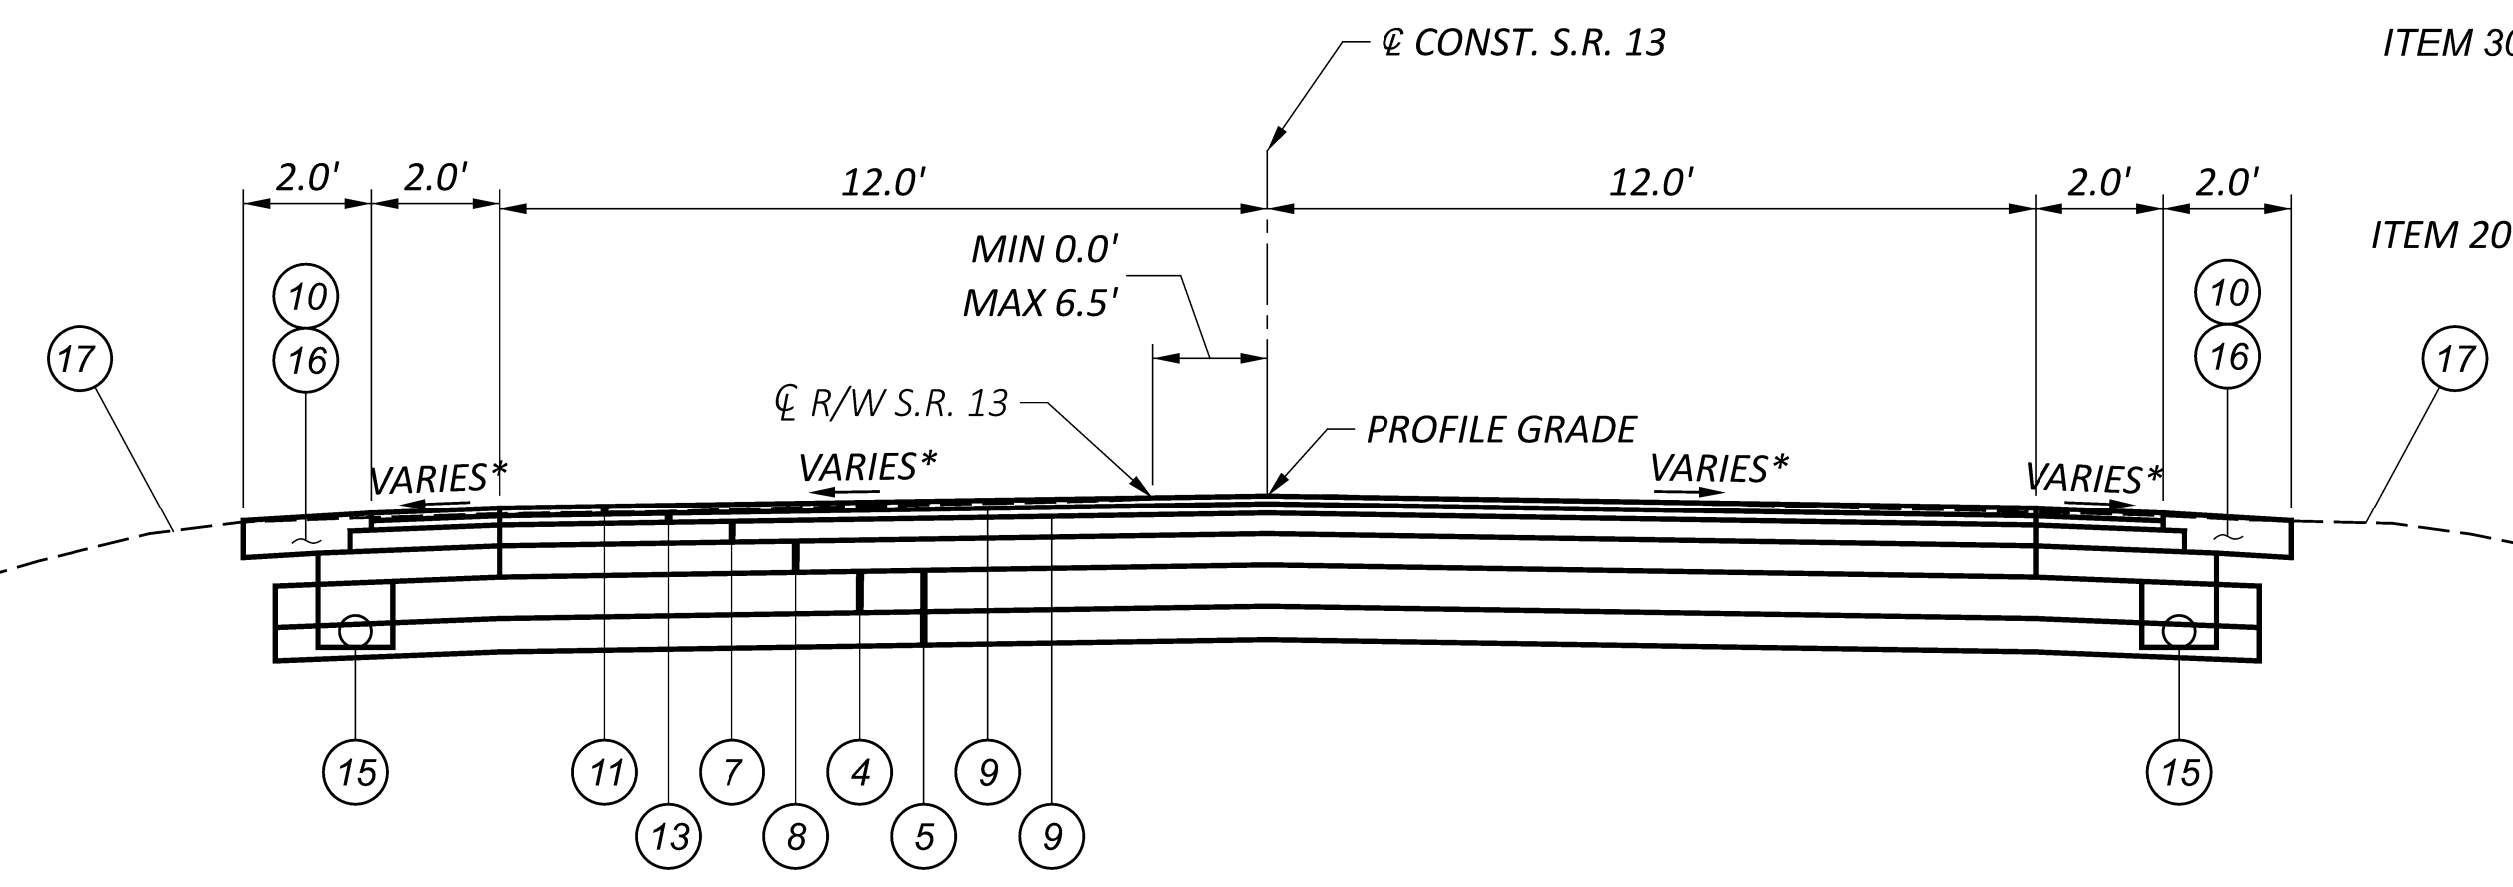

TYPICAL 1 (FULL DEPTH)

STA. 3+41.00 TO STA. 163+97.00 = 16,056.00 L.F.  
 STA. 164+97.00 TO STA. 169+27.00 = 430.00 L.F.  
 STA. 169+82.00 TO STA. 219+36.00 = 4,954.00 L.F.  
 STA. 220+03.00 TO STA. 290+75.00 = 7,072.00 L.F.  
 STA. 292+48.00 TO STA. 374+62.00 = 8,214.00 L.F.

TOTAL = 36,726.00 L.F. = 6.96 MILES

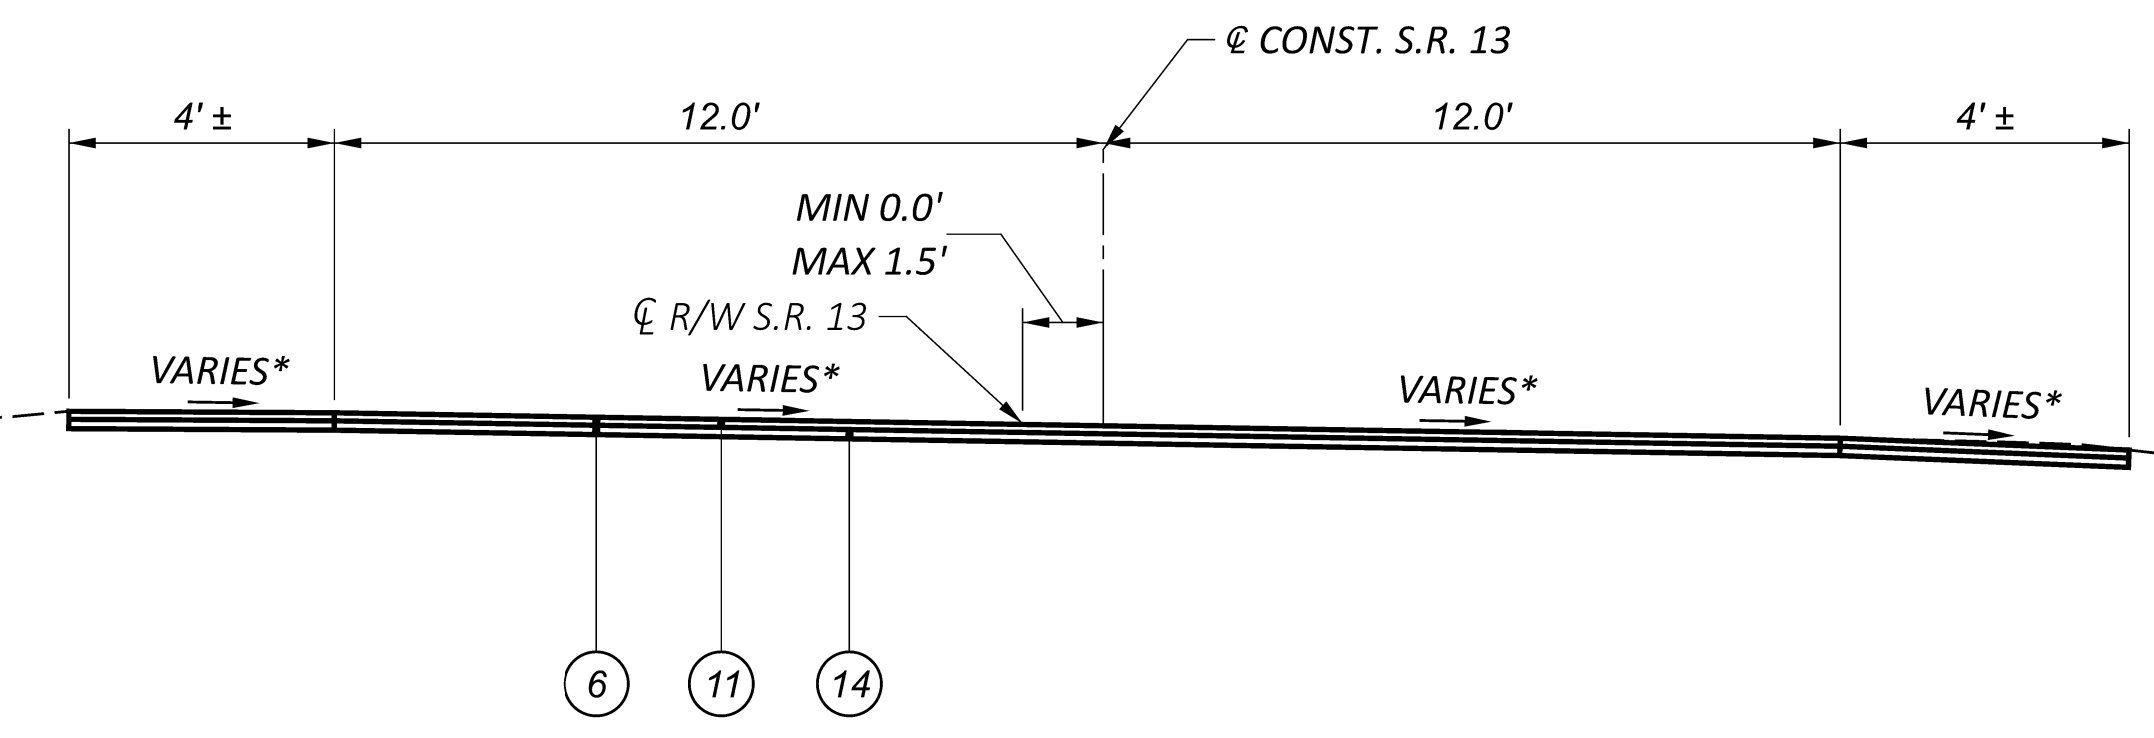


TYPICAL 2 (RESURFACING)

STA. 0+00.00 TO STA. 3+41.00 = 341.00 L.F.  
 STA. 374+62.00 TO STA. 375+52.68 = 91.00 L.F.

TOTAL = 432.00'

- ITEM 407 TACK COAT (0.05 GAL/SY)
- ITEM 442 - 1.75" ASPHALT CONCRETE INTERMEDIATE COURSE 12.5MM TYPE A (446)
- ITEM 442 - 1.50" ASPHALT CONCRETE SURFACE COURSE 12.5MM TYPE A (446)(PG70-22)
- ITEM 407 TACK COAT (0.05 GAL/SY)

- ITEM 301 - 4" ASPHALT CONCRETE BASE(449)(PG64-22)
- ITEM 304 - AGGREGATE BASE (6.0")
- ITEM 204 - EMBANKMENT (7.75")
- ITEM 206 - CEMENT STABILIZED SUBGRADE, 14 INCHES DEEP

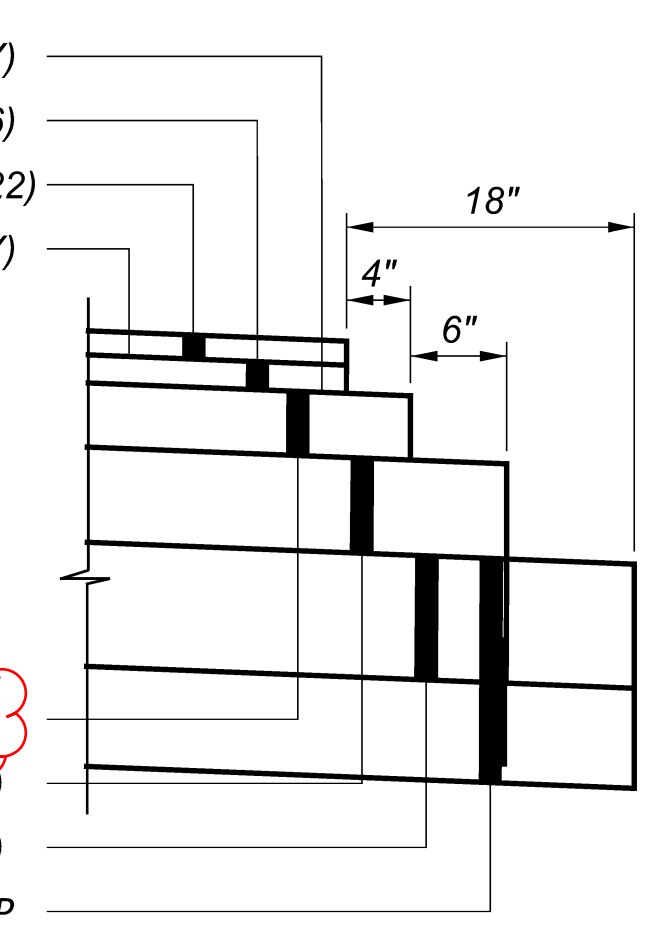


SHOULDER STEP DETAIL  
UNDERDRAIN NOT SHOWN

NOTES:

\* REFER TO ELEVATION TABLES FOR CROSS SLOPE RATE(S).


PROPOSED LEGEND

- |   |   |
|---|---|
| ① ITEM 202 - PAVEMENT REMOVED   | ⑩ ITEM 408 - PRIME COAT, AS PER PLAN (0.4 GAL/SY)                                 |
| ② ITEM 203 - EXCAVATION (VARIES 4.5" - 21")   | ⑪ ITEM 442 - 1.50" ASPHALT CONCRETE SURFACE COURSE 12.5MM TYPE A (446)(PG70-22)   |
| ③ ITEM 203 - EMBANKMENT (6.00")   | ⑫ ITEM 442 - ASPHALT CONCRETE SURFACE COURSE 12.5MM TYPE A (SAFETY EDGE)(PG70-22) |
| ④ ITEM 204 - EMBANKMENT (7.75") TO BE INCORPORATED INTO ITEM 206 - CEMENT STABILIZED SUBGRADE, 14 INCHES DEEP | ⑬ ITEM 442 - 1.75" ASPHALT CONCRETE INTERMEDIATE COURSE 12.5MM TYPE A (446)       |
| ⑤ ITEM 206 - CEMENT STABILIZED SUBGRADE, 14 INCHES DEEP   | ⑭ ITEM 442 - ASPHALT CONCRETE INTERMEDIATE COURSE 12.5MM TYPE A (449)(VARIABLE)   |
| ⑥ ITEM 254 - PAVEMENT PLANING, ASPHALT CONCRETE (3.25")   | ⑮ ITEM 605 - 6" BASE PIPE UNDERDRAINS, AS PER PLAN                                |
| ⑦ ITEM 301 - 4" ASPHALT CONCRETE BASE (449)(PG64-22)  | ⑯ ITEM 617 - COMPACTED AGGREGATE (7.25")  |
| ⑧ ITEM 304 - AGGREGATE BASE (6.0")  | ⑰ ITEM 659 - SEEDING AND MULCHING   |
| ⑨ ITEM 407 - TACK COAT (0.05 GAL/SY BETWEEN PROPOSED LIFTS, 0.08 GAL/SY ON MILLED SURFACE)                    |   |

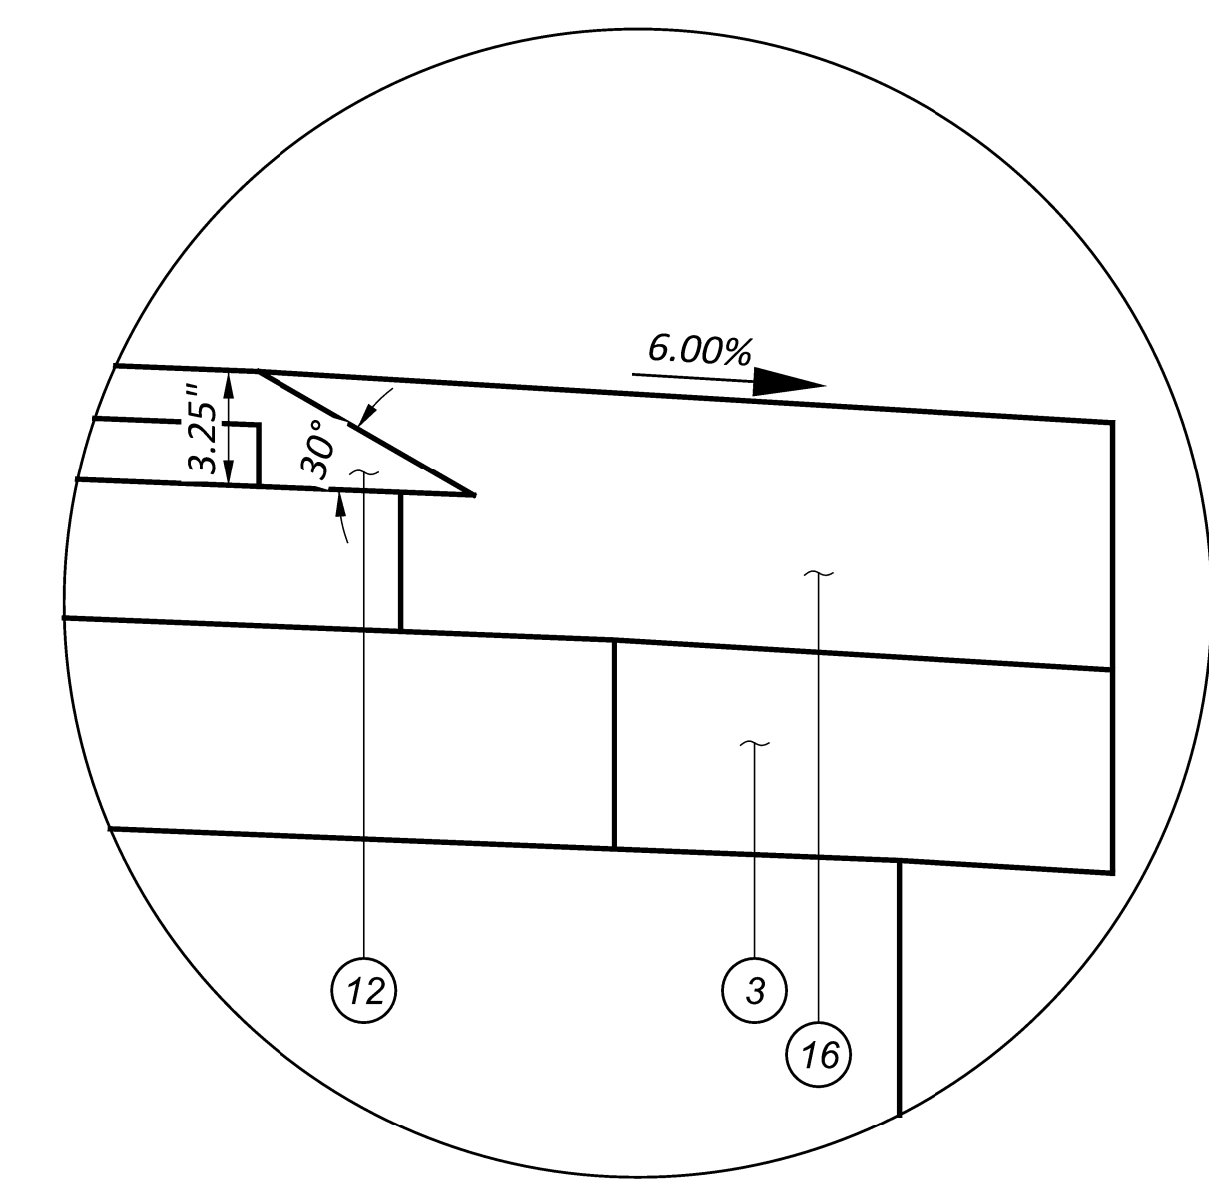

SAFETY EDGE DETAIL



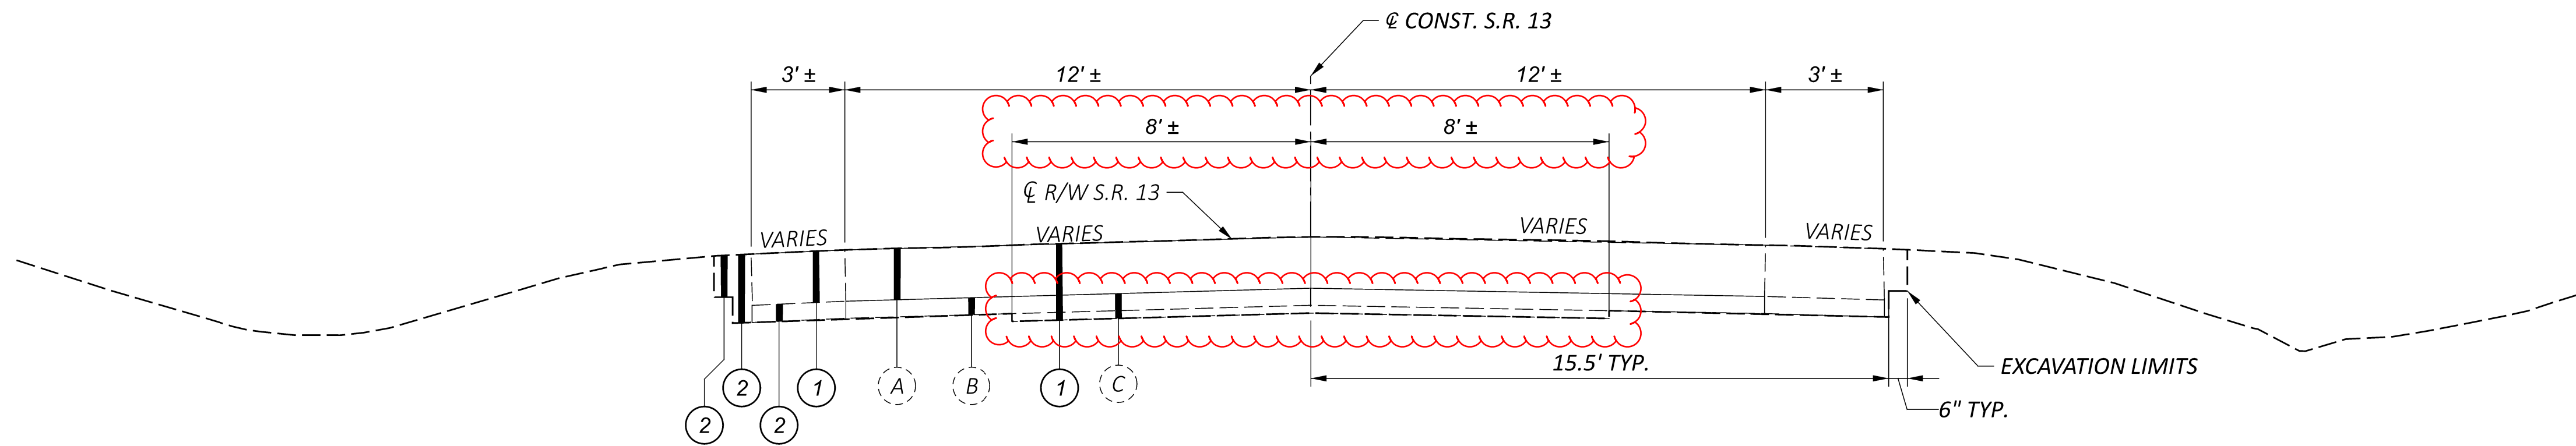

**TYPICAL 3 (EXISTING)**

STA. 3+41.00 TO STA. 163+97.00 = 16,056.00 L.F.  
 STA. 164+97.00 TO STA. 169+27.00 = 430.00 L.F.  
 STA. 169+82.00 TO STA. 219+36.00 = 4,954.00 L.F.  
 STA. 220+03.00 TO STA. 290+75.00 = 7,072.00 L.F.  
 STA. 292+48.00 TO STA. 374+62.00 = 8,214.00 L.F.

TOTAL = 36,726.00 L.F. = 6.96 MILES

**EXISTING LEGEND**

- (A) EXISTING ASPHALT (16.5" ±)
- (B) EXISTING AGG. BASE (4.5" ±)
- (C) EXISTING CONCRETE BASE (8.0" ±)

**PROPOSED LEGEND**

- (1) ITEM 202 - PAVEMENT REMOVED
- (2) ITEM 203 - EXCAVATION (VARIES 4.5" - 21")
- (3) ITEM 203 - EMBANKMENT (6.00")
- (4) ITEM 204 - EMBANKMENT (7.75") TO BE INCORPORATED INTO ITEM 206 - CEMENT STABILIZED SUBGRADE, 14 INCHES DEEP
- (5) ITEM 206 - CEMENT STABILIZED SUBGRADE, 14 INCHES DEEP
- (6) ITEM 254 - PAVEMENT PLANING, ASPHALT CONCRETE (3.25")
- (7) ITEM 301 - 4" ASPHALT CONCRETE BASE (449)(PG64-22)
- (8) ITEM 304 - AGGREGATE BASE (6.0")
- (9) ITEM 407 - TACK COAT (0.05 GAL/SY BETWEEN PROPOSED LIFTS, 0.08 GAL/SY ON MILLED SURFACE)
- (10) ITEM 408 - PRIME COAT, AS PER PLAN (0.4 GAL/SY)
- (11) ITEM 442 - 1.50" ASPHALT CONCRETE SURFACE COURSE 12.5MM TYPE A (446)(PG70-22)
- (12) ITEM 442 - ASPHALT CONCRETE SURFACE COURSE 12.5MM TYPE A (SAFETY EDGE)(PG70-22)
- (13) ITEM 442 - 1.75" ASPHALT CONCRETE INTERMEDIATE COURSE 12.5MM TYPE A (446)
- (14) ITEM 442 - ASPHALT CONCRETE INTERMEDIATE COURSE 12.5MM TYPE A (449)(VARIABLE)
- (15) ITEM 605 - 6" BASE PIPE UNDERDRAINS, AS PER PLAN
- (16) ITEM 617 - COMPACTED AGGREGATE (7.25")
- (17) ITEM 659 - SEEDING AND MULCHING





**ITEM 605 – 6" BASE PIPE UNDERDRAINS, AS PER PLAN**

UNDERDRAINS SHALL BE INSTALLED AT THE DEPTHS SHOWN ON THE DRAINAGE SUB-SUMMARY PLAN SHEET.

PAYMENT FOR ALL OF THE ABOVE SHALL BE AT THE UNIT PRICE BID PER FOOT FOR THE ABOVE ITEM, WHICH WILL INCLUDE ALL LABOR, EQUIPMENT, MATERIALS AND INCIDENTALS NECESSARY TO COMPLETE THE ABOVE WORK.

**POST CONSTRUCTION STORM WATER TREATMENT (W100)**

THIS PLAN UTILIZES STRUCTURAL BEST MANAGEMENT PRACTICES (BMPs) FOR POST CONSTRUCTION STORM WATER TREATMENT.

**VEGETATED FILTER STRIP (W104)**

THIS PLAN UTILIZES VEGETATED FILTER STRIPS FOR POST CONSTRUCTION STORM WATER TREATMENT. PLACE EITHER ITEM 660 SODDING OR ITEM 659 SEEDING AND MULCHING WITH A 4-INCH LIFT OF TOPSOIL AND ITEM 670, SLOPE EROSION PROTECTION TO ALL DISTURBED AREAS DESIGNATED AS VEGETATED FILTER STRIPS, THE EDGE OF SHOULDER, AND THE FORESLOPE AS SPECIFIED IN THE PLANS.

**MAILBOX APPROACHES**

THE MAILBOX APPROACHES SHALL BE PAVED WITH [RESURFACING TREATMENT]. THEY SHALL CONFORM AS MUCH AS PRACTICAL TO STANDARD DRAWING BP-4.1 OR AS DIRECTED BY THE ENGINEER.

GRADING SHALL BE PERFORMED IN THESE AREAS TO OBTAIN A BASE WHICH WILL ALLOW THE FINISHED GRADE TO BE FLUSH WITH THE ADJACENT PAVEMENT. A QUANTITY OF ITEM 617 COMPACTED AGGREGATE HAS BEEN PROVIDED FOR AREAS WHERE THE SHOULDER IS LOW PRIOR TO GRADING AND/OR LOW AREAS CAUSED BY THE REMOVAL OF UNSUITABLE MATERIAL. QUANTITIES TO PERFORM THIS WORK HAVE BEEN INCLUDED IN THE GENERAL SUMMARY AND ARE ESTIMATED AS FOLLOWS:

- ITEM 209 – GRADING MAILBOX APPROACHES 15 EACH (01/STR/04)
- ITEM 617 – COMPACTED AGGREGATE 15 CU YD (01/STR/04)

**ITEM SPECIAL – MAILBOX SUPPORT (R118)**

THIS WORK SHALL CONSIST OF FURNISHING AND ERECTING MAILBOX SUPPORTS AND ANY ASSOCIATED MOUNTING HARDWARE IN ACCORDANCE WITH PLAN DETAILS AND ATTACHING AN OWNER-SUPPLIED MAILBOX AT LOCATIONS SPECIFIED IN THE PLAN, OR OTHERWISE ESTABLISHED BY THE ENGINEER.

WOOD POSTS SHALL BE NOMINAL 4 INCHES BY 4 INCHES SQUARE OR 4.5 INCHES DIAMETER ROUND AND CONFORM TO 710.14.

STEEL POSTS SHALL BE NOMINAL PIPE SIZE 2 INCHES I.D. AND CONFORM TO AASHTO M 181.

ALL HARDWARE INCLUDING BUT NOT LIMITED TO PLATES, SCREWS, BOLTS, AND ETC. SHALL BE COMMERCIAL-GRADE GALVANIZED STEEL.

POSTS SHALL BE SET PER THE FIRST PARAGRAPH OF 606.03 AND SHALL IN NO INSTANCE BE ENCASED IN CONCRETE.

SUPPORT HARDWARE SHALL ACCOMMODATE EITHER A SINGLE OR A DOUBLE MAILBOX INSTALLATION, AND NO MORE THAN TWO BOXES MAY BE MOUNTED ON A SINGLE POST.

THE MAILBOX SHALL BE SECURELY AND NEATLY ATTACHED BY THE CONTRACTOR TO THE NEW SUPPORT. THE CONTRACTOR SHALL FURNISH ALL NECESSARY ATTACHMENT HARDWARE (NUTS, BOLTS, PLATES, SPACERS, AND WASHERS) AS NECESSARY TO ACCOMMODATE THE COMPLETE INSTALLATION.

IN THE ABSENCE OF A NEW BOX SUPPLIED BY THE OWNER, THE CONTRACTOR SHALL SALVAGE THE EXISTING BOX AND PLACE IT ON THE NEW SUPPORT. DUE CARE SHALL BE EXERCISED IN SUCH AN OPERATION, AND THE CONTRACTOR SHALL BE RESPONSIBLE FOR REPAIRING OR REPLACING ANY BOX DAMAGED BY IMPROPER HANDLING ON HIS PART, AS JUDGED AND DIRECTED BY THE ENGINEER.

THE CONTRACTOR SHALL BE RESPONSIBLE FOR COORDINATING WITH THE LOCAL POST MASTER REGARDING THE TIMING OF THE MOVEMENT OF ANY MAILBOX TO A NEW LOCATION.

PAYMENT UNDER THIS ITEM SHALL BE LIMITED TO FINAL PERMANENT INSTALLATIONS, TEMPORARY INSTALLATIONS SHALL BE IN ACCORDANCE WITH 107.10. HOWEVER, THE SAME MATERIAL AND SIZE LIMITATIONS AS FOR PERMANENT INSTALLATIONS SHALL APPLY.

MAILBOX SUPPORTS, COMPLETE IN PLACE, WILL BE PAID FOR AT THE CONTRACT UNIT PRICE PER EACH, FOR ITEM SPECIAL MAILBOX SUPPORT SYSTEM, (SINGLE) (DOUBLE).

THE FOLLOWING ESTIMATED QUANTITIES HAVE BEEN CARRIED TO THE GENERAL SUMMARY TO BE USED AS DESCRIBED ABOVE:

- ITEM SPECIAL – MAILBOX SUPPORT SYSTEM, SINGLE 1 EACH (01/STR/04)

**LOCATIONS OF MAILBOX SUPPORT SYSTEM TO BE REPLACED**

ADDRESSES AND/OR LOCATIONS OF MAILBOX SUPPORT SYSTEM TO BE REPLACED:

2472 S.R. 13, SLM 5.41

**STOP BAR PLACEMENT**

IN ORDER TO COMPLY WITH THE REQUIREMENTS OF THE TRAFFIC ENGINEERING MANUAL AND THE OMTCD, AT NORMAL STOP CONTROLLED INTERSECTIONS WITHOUT CROSSWALK, PLACE THE LEADING EDGE OF THE STOP BAR (CLOSEST TO THE CENTER OF THE INTERSECTION) IN ACCORDANCE WITH THE BELOW TABLE UNLESS SPECIFIED OTHERWISE IN THESE PLANS:

SHOULDER WIDTH OF INTERSECTED ROADWAY	PLACE THE LEADING EDGE OF STOP BAR ON INTERSECTING/APPROACH ROADWAY
0 FEET < SHOULDER WIDTH ≤ 2 FEET	4 FEET BACK FROM EDGE OF PAVED SHOULDER OF INTERSECTED ROADWAY
2 FEET < SHOULDER WIDTH ≤ 4 FEET	2 FEET BACK FROM EDGE OF PAVED SHOULDER OF INTERSECTED ROADWAY
SHOULDER WIDTH > 4 FEET	IN LINE WITH EDGE OF PAVED SHOULDER OF INTERSECTED ROADWAY


**PAVEMENT MARKING LOG**

PRIOR TO REMOVING, GRINDING, OR OTHERWISE DESTROYING ANY EXISTING PAVEMENT MARKINGS, IT IS THE RESPONSIBILITY OF THE CONTRACTOR TO CREATE AN EXISTING PAVEMENT MARKING LOG IN ORDER TO PLACE THE PROPOSED PAVEMENT MARKINGS IN THE SAME LOCATION AS THEIR EXISTING CONFIGURATION. SUBMIT THE EXISTING PAVEMENT MARKING LOG TO THE ENGINEER AND OBTAIN HIS OR HER APPROVAL PRIOR TO REMOVING, GRINDING, OR OTHERWISE DESTROYING THE EXISTING PAVEMENT MARKINGS.

ALL LABOR, MATERIAL, EQUIPMENT, AND INCIDENTALS NEEDED TO COMPLETE THIS WORK SHOULD BE INCLUDED IN THE CONTRACT LUMP SUM BID PRICE FOR ITEM 614 – MAINTAINING TRAFFIC.

**RPMs FOR FIRE HYDRANTS (TWO- AND FOUR-LANE UNDIVIDED)**

INSTALL ONE BLUE/BLUE RAISED PAVEMENT MARKER ALONG THE CENTERLINE OF THE ROADWAY IN FRONT OF ALL FIRE HYDRANTS WITHIN THE PROJECT LIMITS AS LISTED ON THE RPM SUBSUMMARY. OFFSET THESE RPMs A DISTANCE OF 12 INCHES, MEASURED FROM THE CENTER OF THE CENTERLINE TO THE CENTER OF THE RPM, LATERALLY FROM THE CENTERLINE OF THE ROADWAY, TOWARD THE MARKED FIRE HYDRANT. SEE THE DETAIL BELOW AS INFORMATION. THESE RPMs SHOULD BE ADDED IN ADDITION TO THE STANDARD LONG LINE MARKING PLAN; THEY SHOULD NOT REPLACE ANY YELLOW, RED, OR WHITE MARKINGS.

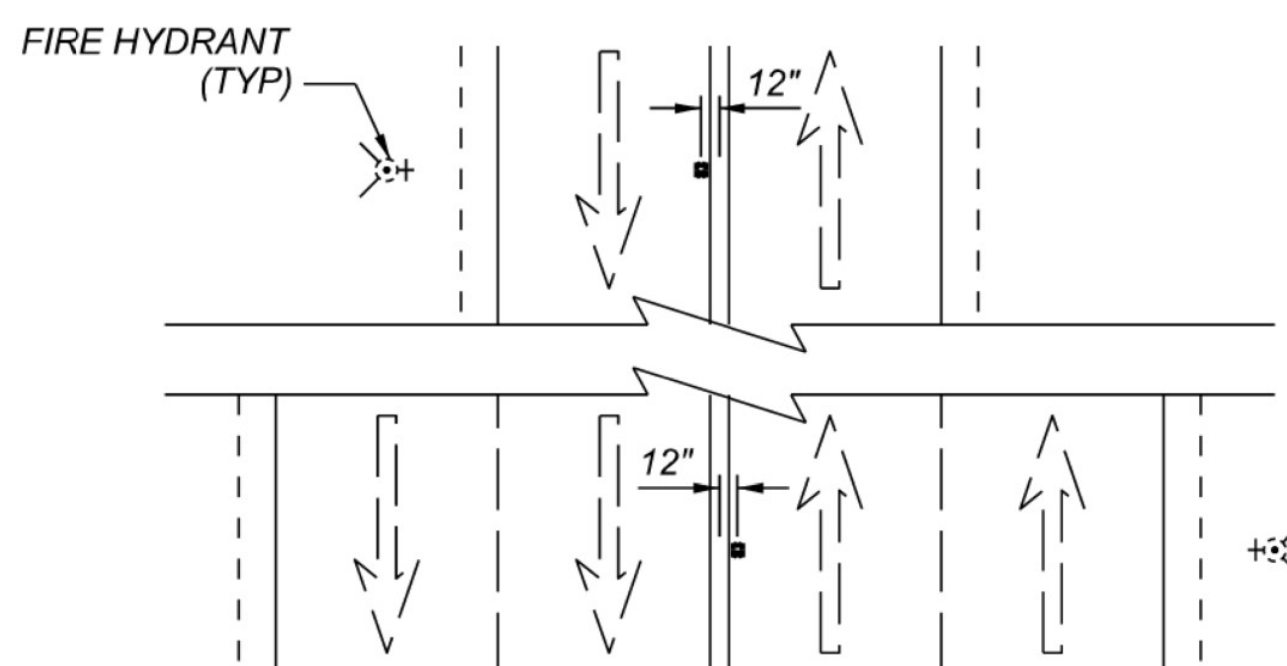

**PAVEMENT CORING INFORMATION**

COUNTY	ROUTE	SLM	ASPHALT (IN)	CONCRETE (IN)	BRICK (IN)	LOCATION	DIRECTION	YEAR CORED
HUR	13	0.06	17.0	8.5	0.0	LT. WHEEL PATH	NB	2020
HUR	13	0.06	13.0	0.0	0.0	RT. WHEEL PATH	NB	2020
HUR	13	0.06	7.0	0.0	0.0	SHOULDER	NB	2020
HUR	13	0.60	6.0	0.0	0.0	CENTER	NB	2020
HUR	13	0.60	9.0	0.0	0.0	RT. WHEEL PATH	NB	2020
HUR	13	0.60	7.0	0.0	0.0	SHOULDER	NB	2020
HUR	13	1.00	14.5	7.0	0.0	LT. WHEEL PATH	NB	2020
HUR	13	1.00	14.0	0.0	0.0	RT. WHEEL PATH	NB	2020
HUR	13	1.00	7.5	0.0	0.0	SHOULDER	NB	2020
HUR	13	2.00	12.0	8.0	0.0	LT. WHEEL PATH	NB	2020
HUR	13	2.00	13.0	0.0	0.0	RT. WHEEL PATH	NB	2020
HUR	13	2.00	6.5	0.0	0.0	SHOULDER	NB	2020
HUR	13	2.75	9.5	7.5	0.0	CENTER	NB	2020
HUR	13	2.75	14.0	0.0	0.0	RT. WHEEL PATH	NB	2020
HUR	13	2.75	7.5	0.0	0.0	SHOULDER	NB	2020
HUR	13	3.30	12.0	7.5	0.0	CENTER	NB	2020
HUR	13	3.30	13.5	0.0	0.0	RT. WHEEL PATH	NB	2020
HUR	13	3.30	10.0	0.0	0.0	SHOULDER	NB	2020
HUR	13	3.95	12.0	8.0	0.0	CENTER	NB	2020
HUR	13	3.95	10.0	0.0	0.0	RT. WHEEL PATH	NB	2020
HUR	13	3.95	7.5	0.0	0.0	SHOULDER	NB	2020
HUR	13	4.50	14.0	8.0	0.0	CENTER	NB	2020
HUR	13	4.50	15.0	0.0	0.0	RT. WHEEL PATH	NB	2020
HUR	13	4.50	10.0	0.0	0.0	SHOULDER	NB	2020
HUR	13	5.00	12.5	7.5	0.0	CENTER	NB	2020
HUR	13	5.00	15.0	0.0	0.0	RT. WHEEL PATH	NB	2020
HUR	13	5.00	6.5	0.0	0.0	SHOULDER	NB	2020
HUR	13	5.51	15.0	0.0	0.0	CENTER	NB	2020
HUR	13	5.51	15.0	0.0	0.0	RT. WHEEL PATH	NB	2020
HUR	13	5.51	9.0	0.0	0.0	SHOULDER	NB	2020
HUR	13	6.00	14.0	8.0	0.0	CENTER	NB	2020
HUR	13	6.00	15.0	0.0	0.0	RT. WHEEL PATH	NB	2020
HUR	13	6.00	9.0	0.0	0.0	SHOULDER	NB	2020
HUR	13	6.85	15.0	8.0	0.0	CENTER	NB	2020
HUR	13	6.85	12.0	0.0	0.0	RT. WHEEL PATH	NB	2020
HUR	13	6.85	9.0	0.0	0.0	SHOULDER	NB	2020

GENERAL NOTES

DESIGN AGENCY  
 DISTRICT 3

ENGINEERING TEAM ONE

DESIGNER  
 KRB

REVIEWER  
 XXX 11/13/23

PROJECT ID  
 101386

SHEET TOTAL  
 P.15 | 63



**ITEM 614 – MAINTAINING TRAFFIC (GENERAL)**

MAINTAIN ONE 10' LANE OF TRAFFIC AT ALL TIMES, UNLESS OTHERWISE SPECIFIED.

ROAD CLOSURE PERIODS AND ASSOCIATED DETOURS ARE PROVIDED IN THE PLANS. THE CONTRACTOR IS REQUIRED TO MAINTAIN ONE 10' MINIMUM LANE FOR LOCAL ACCESS DURING ALL CLOSURE PERIODS. THE CONTRACTOR SHALL PROVIDE FOR POSITIVE CONTROL AND DECONFLICTION OF LOCAL TRAFFIC USING FLAGGERS, SIGNALS, OR OTHER MEANS APPROVED BY THE ENGINEER. TRAFFIC SHALL BE DETOURED UNTIL INTERMEDIATE COURSE FOR A GIVEN SECTION HAS BEEN PLACED AND IS ABLE TO BEAR TRAFFIC.

SUBMIT, IN WRITING, A SCHEDULE OF OPERATIONS TO THE ENGINEER AND RECEIVE APPROVAL BEFORE WORK IS STARTED ON THE PROJECT. PRIOR TO BEGINNING WORK, COORDINATE THE MAINTENANCE OF TRAFFIC OPERATIONS WITH THE LOCAL STATE HIGHWAY PATROL.

ALL WORK AND TRAFFIC CONTROL DEVICES SHALL BE IN ACCORDANCE WITH C&MS 614 AND OTHER APPLICABLE PORTIONS OF THE SPECIFICATIONS, AS WELL AS THE OHIO MANUAL OF UNIFORM TRAFFIC CONTROL DEVICES, 2012, WITH THE LATEST REVISIONS. PAYMENT FOR ALL LABOR, EQUIPMENT AND MATERIALS SHALL BE INCLUDED IN THE LUMP SUM CONTRACT PRICE FOR ITEM 614, MAINTAINING TRAFFIC, UNLESS SEPARATELY ITEMIZED IN THE PLAN.

**ITEM 614 – MAINTAINING TRAFFIC (TIME LIMITATION ON A DETOUR)**

A MINIMUM OF ONE LANE OF TRAFFIC IN EACH DIRECTION SHALL BE MAINTAINED AT ALL TIMES, EXCEPT FOR A PERIOD NOT TO EXCEED THE CONSECUTIVE CALENDAR DAYS SHOWN ON THE TABLE BELOW. WHEN THROUGH TRAFFIC MAY BE DETOURED AS SHOWN ON SHEETS 19-21, AND LOCAL TRAFFIC MAINTAINED IN AT LEAST ONE DIRECTION. A DISINCENTIVE SHALL BE ASSESSED FOR EACH CALENDAR DAY THE ROADWAY REMAINS CLOSED TO TRAFFIC BEYOND THE SPECIFIED LIMIT, ACCORDING TO THE TABLE BELOW. THE CLOSURES FOR HUR-13-0.00 TO 2.55 AND HUR-13-2.55 TO 7.06 ARE PERMITTED TO OCCUR SIMULTANEOUSLY.

SEGMENT	MAXIMUM DURATION OF CLOSURE	DISINCENTIVE AMOUNT
HUR-13-0.00 TO 2.55	120 DAYS	\$10,000 / DAY
HUR-13-2.55 TO 7.06	120 DAYS	\$10,000 / DAY

**ITEM 614 – MAINTAINING TRAFFIC RESIDENTIAL AND AGRICULTURAL DRIVES**

ACCESS TO ALL RESIDENTIAL AND AGRICULTURAL DRIVES SHALL BE MAINTAINED AT ALL TIMES WITH EITHER EXISTING / NEW PAVEMENT OR ITEM 410 – TRAFFIC COMPACTED SURFACE, TYPE A OR B EXCEPT FOR A MINIMAL PERIOD APPROVED BY THE ENGINEER FOR THE PLACEMENT OF ASPHALT CONCRETE PAVEMENT IN FRONT OF AND/OR ADJACENT TO THE DRIVE APRON. THE CONTRACTOR IS TO PROVIDE 7 CALENDAR DAY NOTICE TO THE AFFECTED PERSON(S) SO THEY CAN MAKE ALTERNATIVE PARKING ARRANGEMENTS. ASPHALT GRINDINGS THAT MEET THE REQUIREMENTS OF C&MS 703.18 MAY BE USED.

**ITEM 614 – MAINTAINING TRAFFIC SIDE / CROSS ROADS**

ACCESS TO ALL SIDE AND / OR INTERSECTING ROADS, INCLUDING ACCESS ACROSS S.R. 13, SHALL BE MAINTAINED AT ALL TIMES WITH EITHER EXISTING / NEW PAVEMENT OR ITEM 410 – TRAFFIC COMPACTED SURFACE, TYPE A OR B, EXCEPT FOR MINIMUM PERIODS AS APPROVED BY THE ENGINEER TO ALLOW CONSTRUCTION ACTIVITIES WITHIN THE INTERSECTION.

**MAINTAINING TRAFFIC PHASES**

DURING EACH PHASE, LOCAL TRAFFIC SHALL BE MAINTAINED IN AT LEAST ONE DIRECTION.

- PH 1A: ROAD CLOSURE BETWEEN HUR-13-0.00 AND 2.55. MAINTAIN ONE 10' LANE FOR LOCAL TRAFFIC USING EXISTING WEST SIDE PAVEMENT. CONSTRUCT THE EAST SIDE.
- PH 1B: ROAD CLOSURE BETWEEN HUR-13-0.00 AND 2.55. MAINTAIN ONE 10' LANE FOR LOCAL TRAFFIC USING NEW / EXISTING EAST SIDE PAVEMENT. CONSTRUCT THE WEST SIDE.
- PH 2A: ROAD CLOSURE BETWEEN HUR-13-2.55 AND 7.06. MAINTAIN ONE 10' LANE FOR LOCAL TRAFFIC USING EXISTING WEST SIDE PAVEMENT. CONSTRUCT THE EAST SIDE.
- PH 2B: ROAD CLOSURE BETWEEN HUR-13-2.55 AND 7.06. MAINTAIN ONE 10' LANE FOR LOCAL TRAFFIC USING NEW / EXISTING EAST SIDE PAVEMENT. CONSTRUCT THE WEST SIDE.

**DETOUR SIGNING**

THE FOLLOWING QUANTITY IS INCLUDED FOR THE CONTRACTOR TO PROVIDE THE DETOUR SIGNING AS SHOWN IN THESE PLANS AND AS PER C&MS 614.06:

ITEM 614 – DETOUR SIGNING 01/STR/04 - LUMP

**ITEM 614 – MAINTAINING TRAFFIC (LANE CLOSURE/REDUCTION REQUIRED)**

LENGTH AND DURATION OF LANE CLOSURES AND RESTRICTIONS SHALL BE AT THE APPROVAL OF THE ENGINEER. IT IS THE INTENT TO MINIMIZE THE IMPACT TO THE TRAVELING PUBLIC. LANE CLOSURES OR RESTRICTIONS OVER SEGMENTS OF THE PROJECT IN WHICH NO WORK IS ANTICIPATED WITHIN A REASONABLE TIME FRAME, AS DETERMINED BY THE ENGINEER, SHALL NOT BE PERMITTED. THE LEVEL OF UTILIZATION OF MAINTENANCE OF TRAFFIC DEVICES SHALL BE COMMENSURATE WITH THE WORK IN PROGRESS.

**ITEM 614 – MAINTAINING TRAFFIC (NOTICE OF CLOSURE SIGN)**

NOTICE OF CLOSURE SIGNS (W20-H14) SHALL BE ERECTED BY THE CONTRACTOR PRIOR TO THE SCHEDULED ROAD OR RAMP CLOSURE IN ACCORDANCE WITH THE NOTICE OF CLOSURE TIME TABLE BELOW. [AT THE APPROVAL OF THE ENGINEER, PORTABLE CHANGEABLE MESSAGE SIGNS MAY BE USED IN LIEU OF THE STANDARD FLAT SHEET SIGN FOR CLOSURE DURATIONS OF LESS THAN 1 WEEK.] THE SIGNS SHALL BE ERECTED ON THE RIGHT-HAND SIDE OF THE ROAD/RAMP FACING TRAFFIC. THEY SHALL BE PLACED SO AS NOT TO INTERFERE WITH THE VISIBILITY OF ANY OTHER TRAFFIC CONTROL SIGNS. ON ROADWAYS, THEY SHOULD BE ERECTED AT OR NEAR THE POINT OF CLOSURE. THE SIGNS MAY BE ERECTED ANYWHERE ON RAMPS AS LONG AS THEY ARE VISIBLE TO THE MOTORISTS USING THE RAMP. ON ENTRANCE RAMPS, THE SIGN SHALL BE ERECTED WELL IN ADVANCE OF THE MERGE AREA TO AVOID DISTRACTING MOTORISTS.

NOTICE OF CLOSURE SIGN TIME TABLE		
ITEM	DURATION OF CLOSURE	SIGN DISPLAYED TO PUBLIC
RAMP AND ROAD CLOSURES	≥ 2 WEEKS	14 CALENDAR DAYS*
	> 12 HOURS & < 2 WEEKS	7 CALENDAR DAYS*
	< 12 HOURS	2 BUSINESS DAYS*

\* DAYS PRIOR TO CLOSURE

THE SIGN SHALL DISPLAY THE DATE OF THE CLOSURE IN MMM-DD FORMAT AND THE NUMBER OF DAYS OF THE CLOSURE. THE LAST LINE OF THE W20-H14 SIGN LISTS THE NAME OF THE DEPARTMENT, i.e. "THE OHIO DEPT. OF TRANS."

**ITEM 614 – MAINTAINING TRAFFIC (ESTIMATED QUANTITIES)**

THE FOLLOWING ESTIMATED QUANTITIES HAVE BEEN INCLUDED IN THE GENERAL SUMMARY FOR USE AS DETERMINED BY THE ENGINEER FOR MAINTENANCE OF TRAFFIC. INCLUDE THE COST FOR THE REMOVAL OF ALL MAINTENANCE OF TRAFFIC MATERIALS IN THE CONTRACT BID PRICE FOR EACH ITEM BELOW. REMOVE THE MATERIALS AT THE DIRECTION OF THE ENGINEER WHEN NO LONGER OPERATIONALLY NEEDED.

01/STR/04:  
ITEM 410 – TRAFFIC COMPACTED SURFACE, TYPE A OR B

1,400 CU YD  
208 CU YD

ITEM 410 – TRAFFIC COMPACTED SURFACE, TYPE C

ITEM 614 – ASPHALT CONCRETE FOR MAINTAINING TRAFFIC 100 CU YD

**TEMPORARY PAVEMENT WEDGES**

PROVIDE TEMPORARY PAVEMENT WEDGES AT ALL TIMES WHERE TRAFFIC IS REQUIRED TO TRAVEL FROM OR ONTO A SURFACE OF A DIFFERENT ELEVATION IN THE DIRECTION OF TRAVEL (JOINTS, MANHOLES, CATCH BASINS, VALVE BOXES, MONUMENT BOXES, ETC.). THE TAPER RATE OF THE TEMPORARY PAVEMENT WEDGES SHALL BE AS PER THE REQUIREMENTS IN THE CHART BELOW. REMOVE THE TEMPORARY PAVEMENT WEDGES PRIOR TO PLACING EACH PROPOSED PAVEMENT COURSE. CONSIDER PAYMENT FOR THIS WORK, INCLUDING ALL MATERIAL, LABOR, EQUIPMENT, AND INCIDENTALS NEEDED TO COMPLETE THIS WORK, AS INCIDENTAL TO ITEM 614 – ASPHALT CONCRETE FOR MAINTAINING TRAFFIC.

SPEED	LESS THAN 45 MPH 45 MPH OR GREATER	DURATION	
		7 DAYS OR LESS	MORE THAN 7 DAYS
		36H:1V	60H:1V
		60H:1V	120H:1V

**DUST CONTROL**

THE CONTRACTOR SHALL FURNISH AND APPLY WATER FOR DUST CONTROL AS DIRECTED BY THE ENGINEER. THE FOLLOWING ESTIMATED QUANTITIES HAVE BEEN INCLUDED FOR DUST CONTROL PURPOSES:

ITEM 616, WATER 01/STR/04 - 100 M. GAL.

**ITEM 614 – PORTABLE CHANGEABLE MESSAGE SIGNS, AS PER PLAN**

THE CONTRACTOR SHALL FURNISH, INSTALL, MAINTAIN AND REMOVE, WHEN NO LONGER NEEDED, A CHANGEABLE MESSAGE SIGN. THE SIGN SHALL BE OF A TYPE SHOWN ON A LIST OF APPROVED PCMS UNITS AVAILABLE ON THE OFFICE OF MATERIALS MANAGEMENT WEB PAGE. THE LIST CONTAINS CLASS A AND B UNITS WITH MINIMUM LEGIBILITY DISTANCES OF 800 FEET AND 650 FEET, RESPECTIVELY.

EACH SIGN SHALL BE TRAILER-MOUNTED AND EQUIPPED WITH A FUNCTIONAL DIMMING MECHANISM, TO DIM THE SIGN DURING DARKNESS, AND A TAMPER AND VANDAL PROOF ENCLOSURE. EACH SIGN SHALL BE PROVIDED WITH APPROPRIATE TRAINING AND OPERATION INSTRUCTIONS TO ENABLE ON-SITE PERSONNEL TO OPERATE AND TROUBLESHOOT THE UNIT. THE SIGN SHALL ALSO BE CAPABLE OF BEING POWERED BY AN ELECTRICAL SERVICE DROP FROM A LOCAL UTILITY COMPANY. THE PCMS SHALL BE DELINEATED IN ACCORDANCE WITH C&MS 614.03.

THE PROBABLE PCMS LOCATIONS AND WORK LIMITS FOR THOSE LOCATIONS ARE SHOWN ON SHEET(S) OF THE PLAN. PLACEMENT, OPERATION, MAINTENANCE AND ALL ACTIVATION OF THE SIGNS BY THE CONTRACTOR SHALL BE AS DIRECTED BY THE ENGINEER. THE PCMS SHALL BE LOCATED IN A HIGHLY VISIBLE POSITION YET PROTECTED FROM TRAFFIC. THE CONTRACTOR SHALL, AT THE DIRECTION OF THE ENGINEER, RELOCATE THE PCMS TO IMPROVE VISIBILITY OR

ACCOMMODATE CHANGED CONDITIONS. WHEN NOT IN USE, THE PCMS SHALL BE TURNED OFF. ADDITIONALLY, WHEN NOT IN USE FOR EXTENDED PERIODS OF TIME, THE PCMS SHALL BE TURNED AWAY FROM ALL TRAFFIC.

THE ENGINEER SHALL BE PROVIDED ACCESS TO EACH SIGN UNIT AND SHALL BE PROVIDED WITH APPROPRIATE TRAINING AND OPERATION INSTRUCTIONS TO ENABLE ODOT PERSONNEL TO OPERATE AND TROUBLESHOOT THE UNIT, AND TO REVISE SIGN MESSAGES, IF NECESSARY.

ALL MESSAGES TO BE DISPLAYED ON THE SIGN WILL BE PROVIDED BY THE ENGINEER. A LIST OF ALL REQUIRED PRE-PROGRAMMED MESSAGES WILL BE GIVEN TO THE CONTRACTOR AT THE PROJECT PRECONSTRUCTION CONFERENCE. THE SIGN SHALL HAVE THE CAPABILITY TO STORE UP TO 99 MESSAGES. MESSAGE MEMORY OR PRE-PROGRAMMED DISPLAYS SHALL NOT BE LOST AS A RESULT OF POWER FAILURES TO THE ON-BOARD COMPUTER. THE SIGN LEGEND SHALL BE CAPABLE OF BEING CHANGED IN THE FIELD. THREE-LINE PRESENTATION FORMATS WITH UP TO SIX MESSAGE PHASES SHALL BE SUPPORTED. PCMS FORMAT SHALL PERMIT THE COMPLETE MESSAGE FOR EACH PHASE TO BE READ AT LEAST TWICE.

THE PCMS SHALL CONTAIN AN ACCURATE CLOCK AND PROGRAMMING LOGIC WHICH WILL ALLOW THE SIGN TO BE ACTIVATED, DEACTIVATED OR MESSAGES CHANGED AUTOMATICALLY AT DIFFERENT TIMES OF THE DAY FOR DIFFERENT DAYS OF THE WEEK.

THE PCMS UNIT SHALL BE MAINTAINED IN GOOD WORKING ORDER BY THE CONTRACTOR IN ACCORDANCE WITH THE PROVISIONS OF C&MS 614.07. THE CONTRACTOR SHALL, PRIOR TO ACTIVATING THE UNIT, MAKE ARRANGEMENTS, WITH AN AUTHORIZED SERVICE AGENT FOR THE PCMS, TO ASSURE PROMPT SERVICE IN THE EVENT OF FAILURE. ANY FAILURE SHALL NOT RESULT IN THE SIGN BEING OUT OF SERVICE FOR MORE THAN 12 HOURS, INCLUDING WEEKENDS. FAILURE TO COMPLY MAY RESULT IN AN ORDER TO STOP WORK AND OPEN ALL TRAFFIC LANES AND/OR IN THE DEPARTMENT TAKING APPROPRIATE ACTION TO SAFELY CONTROL TRAFFIC. THE ENTIRE COST TO CONTROL TRAFFIC, ACCRUED BY THE DEPARTMENT DUE TO THE CONTRACTOR'S NONCOMPLIANCE, WILL BE DEDUCTED FROM MONEYS DUE, OR TO BECOME DUE THE CONTRACTOR ON HIS CONTRACT.

THE CONTRACTOR SHALL BE RESPONSIBLE FOR 24-HOUR-PER-DAY OPERATION AND MAINTENANCE OF THESE SIGNS ON THE PROJECT FOR THE DURATION OF THE PHASES WHEN THE PLAN REQUIRES THEIR USE.

PAYMENT FOR THE ABOVE DESCRIBED ITEM SHALL BE AT THE CONTRACT UNIT PRICE. PAYMENT SHALL INCLUDE ALL LABOR, MATERIALS, EQUIPMENT, FUELS, LUBRICATING OILS, SOFTWARE, HARDWARE AND INCIDENTALS TO PERFORM THE ABOVE DESCRIBED WORK.

ITEM 614 – PORTABLE CHANGEABLE MESSAGE SIGN, AS PER PLAN  
01/STR/04 – 16 SIGN MONTH  
ASSUMING 2 PCMS SIGN(S) FOR 8 MONTH(S)

**ITEM 614 – BUSINESS ENTRANCE (M4-H15) SIGN, AS PER PLAN**

THE BUSINESS ENTRANCE (M4-H15) SIGN SHOULD BE PROVIDED AT EACH TEMPORARILY RELOCATED COMMERCIAL DRIVEWAY FOR WHICH THE RELOCATION IS NOT OBVIOUS TO THE MOTORIST. THE PROJECT ENGINEER SHALL DETERMINE WHETHER OR NOT THE DRIVEWAY RELOCATION IS, OR IS NOT, OBVIOUS AND WHETHER OR NOT A SIGN SHOULD BE PROVIDED. ONLY ONE SIGN PER BUSINESS SHALL BE PERMITTED. THE SIGN SHALL BE 36 INCH X 48 INCH IN SIZE WITH TYPE G OR TYPE H ORANGE RETROREFLECTIVE SHEETING. THE SIGN LEGEND SHALL BE PLACED ON BOTH SIDES OF THE SIGN (BACK TO BACK). THE SIGN SHALL HAVE THE STANDARD M4-H15 LEGEND WITH THE WORD "BUSINESS" ON THE TOP LINE, EXCEPT UNDER UNUSUAL CIRCUMSTANCES WHERE IT MAY NOT BE INTUITIVE THAT A DRIVEWAY SERVES A SPECIFIC BUSINESS. IN SUCH UNUSUAL CASES, THE ACTUAL BUSINESS NAME MAY BE SUBSTITUTED FOR THE WORD "BUSINESS".

THE SIGN SHALL BE MOUNTED ON TWO #3 POSTS OR ON TEMPORARY POSTS IN ACCORDANCE WITH SCD MT105.10 AND IN ACCORDANCE WITH THE OHIO MANUAL OF UNIFORM TRAFFIC CONTROL DEVICES, LATEST EDITION. THE SIGN SHALL BE CLEARLY VISIBLE AND SHALL CLEARLY IDENTIFY THE LOCATION OF THE DRIVEWAY. THE SIGN SHOULD BE POSITIONED AT 900 TO THE DIRECTION(S) OF TRAFFIC. THE SIGN MAY NEED TO BE MOVED FOR EACH PHASE OF THE MAINTENANCE OF TRAFFIC OPERATIONS.

PAYMENT FOR ALL COSTS ASSOCIATED WITH MANUFACTURING, MOUNTING, RELOCATING, AND REMOVING THE SIGN, INCLUDING ALL LABOR, MATERIALS AND EQUIPMENT SHALL BE INCLUDED IN THE CONTRACT PRICE PER EACH FOR ITEM 614-BUSINESS ENTRANCE SIGN.

THE FOLLOWING ESTIMATED QUANTITY HAS BEEN CARRIED TO THE GENERAL SUMMARY FOR THIS ITEM:

ITEM 614, BUSINESS ENTRANCE SIGN 01/STR/04 – 3 EACH

**ONE WAY SIGNING**

PROVIDE TEMPORARY ONE-WAY SIGNING IN FRONT OF EACH DRIVEWAY WITHIN ANY SEGMENT UNDER ONE-WAY LOCAL TRAFFIC. BELOW IS AN ESTIMATE OF REQUIRED SIGN INSTALLATIONS TO ACCOMPLISH THIS WORK. ALL LABOR, MATERIALS, AND EQUIPMENT REQUIRED TO ACCOMPLISH THE ABOVE SHALL BE INCLUDED IN THE CONTRACT PRICE PER EACH FOR ITEM 614 – WORK ZONE MARKING SIGN.


WORK ZONE MARKING SIGN: (R6-1L-36) ONE WAY 01/STR/04 – 72 EACH  
WORK ZONE MARKING SIGN: (R6-1R-36) ONE WAY 01/STR/04 – 72 EACH  
TOTAL = 01/STR/04 – 144 EACH



SHEET NUM.												PART.	ITEM	ITEM	GRAND	UNIT	DESCRIPTION	SEE SHEET NO.	
12	13	14	15	17	18	25	26	32	39	40	RW.5	01/STR/04	EXT	TOTAL					
								LS				LS	201	11000	LS			<b>ROADWAY</b>	
								2				2	202	20010	2	EACH		CLEARING AND GRUBBING	
						123,953						123,953	202	23000	123,953	SY		HEADWALL REMOVED	
								43				43	202	32000	43	FT		PAVEMENT REMOVED	
								39				39	202	35100	39	FT		CURB REMOVED	
																		PIPE REMOVED, 24" AND UNDER	
							3,281.25					3,281.25	202	38000	3,281.25	FT		GUARDRAIL REMOVED	
							300					300	202	38201	300	FT		GUARDRAIL REMOVED FOR REUSE, AS PER PLAN	16
							23					23	202	42010	23	EACH		ANCHOR ASSEMBLY REMOVED, TYPE E	
							8					8	202	42040	8	EACH		ANCHOR ASSEMBLY REMOVED, TYPE T	
							16					16	202	47000	16	EACH		BRIDGE TERMINAL ASSEMBLY REMOVED	
								2				2	202	58100	2	EACH		CATCH BASIN REMOVED	
		51										51	SPECIAL	20270120	51	FT		PIPE CLEANOUT, 27" TO 48"	14
		248										248	SPECIAL	20270130	248	FT		PIPE CLEANOUT OVER 48"	14
						14,461						14,461	203	10000	14,461	CY		EXCAVATION	
						1,377						1,377	203	20000	1,377	CY		EMBANKMENT	
							95					95	203	20001	95	CY		EMBANKMENT, AS PER PLAN	16
3,400												3,400	204	10000	3,400	SY		SUBGRADE COMPACTION	
1,200						34,001						35,201	204	20000	35,201	CY		EMBANKMENT	
1,200												1,200	204	13000	1,200	CY		EXCAVATION OF SUBGRADE	
2						64						66	204	45000	66	HOUR		PROOF ROLLING	
						3,353						3,353	206	10500	3,353	TON		CEMENT	
						128,085						128,085	206	11000	128,085	SY		CURING COAT	
						128,085						128,085	206	15020	128,085	SY		CEMENT STABILIZED SUBGRADE, 14 INCHES DEEP	
							48.31					48.31	209	15000	48.31	STA		RESHAPING UNDER GUARDRAIL	
						14.25						14.25	209	72051	14.25	MILE		PREPARING SUBGRADE FOR SHOULDER PAVING, AS PER PLAN	13
			15									15	209	80000	15	EACH		GRADING MAILBOX APPROACHES	
							300					300	606	13000	300	FT		GUARDRAIL, TYPE 5	
							2,631.25					2,631.25	606	15050	2,631.25	FT		GUARDRAIL, TYPE MGS	
							200					200	606	15100	200	FT		GUARDRAIL, TYPE MGS WITH LONG POSTS	
							275					275	606	15200	275	FT		GUARDRAIL, TYPE MGS HALF POST SPACING WITH LONG POSTS	
							50					50	606	17001	50	FT		RAISING TYPE 5 GUARDRAIL, AS PER PLAN	16
							50					50	606	17350	50	FT		GUARDRAIL, TYPE MGS, 25' LONG-SPAN	
							125					125	606	17360	125	FT		GUARDRAIL, TYPE MGS, LONG-SPAN	
							23					23	606	26150	23	EACH		ANCHOR ASSEMBLY, MGS TYPE E, MASH 2016	
							8					8	606	26550	8	EACH		ANCHOR ASSEMBLY, MGS TYPE T	
							12					12	606	35140	12	EACH		BRIDGE TERMINAL ASSEMBLY, TYPE 4	
											23	23	623	38500	23	EACH		MONUMENT ASSEMBLY, TYPE C	
											4	4	623	40500	4	EACH		REFERENCE MONUMENT, TYPE A	
3												3	623	39501	3	EACH		MONUMENT ASSEMBLY ADJUSTED TO GRADE, AS PER PLAN	12
2												2	623	39601	2	EACH		MONUMENT ASSEMBLY RECONSTRUCTED TO GRADE, AS PER PLAN	12
LS												LS	623	50000	LS			PRECONSTRUCTION SURVEY MONUMENT VERIFICATION AND REPORT	
LS												LS	623	51000	LS			POST CONSTRUCTION SURVEY MONUMENT VERIFICATION AND REPORT	
			1									1	SPECIAL	69050100	1	EACH		MAILBOX SUPPORT SYSTEM, SINGLE	15
																		<b>EROSION CONTROL</b>	
								68				68	601	32100	68	CY		ROCK CHANNEL PROTECTION, TYPE B WITH FILTER	
		2										2	659	00100	2	EACH		SOIL ANALYSIS TEST	
		9,195										9,195	659	00300	9,195	CY		TOPSOIL	
							1,542					1,542	659	00300	1,542	CY		TOPSOIL (4" THICK)	
		82,837										82,837	659	10000	82,837	SY		SEEDING AND MULCHING	
		4,142										4,142	659	14000	4,142	SY		REPAIR SEEDING AND MULCHING	
		4,142										4,142	659	15000	4,142	SY		INTER-SEEDING	
		11.55										11.55	659	20000	11.55	TON		COMMERCIAL FERTILIZER	
		17.12										17.12	659	31000	17.12	ACRE		LIME	
		459										459	659	35000	459	MGAL		WATER	
							13,875					13,875	670	00500	13,875	SY		SLOPE EROSION PROTECTION	
							LS					LS	832	15000	LS			STORM WATER POLLUTION PREVENTION PLAN	
							LS					LS	832	15002	LS			STORM WATER POLLUTION PREVENTION INSPECTIONS	
							LS					LS	832	15010	LS			STORM WATER POLLUTION PREVENTION INSPECTION SOFTWARE	
							100,000					100,000	832	30000	100,000	EACH		EROSION CONTROL	

GENERAL SUMMARY

DESIGN AGENCY  
DISTRICT 3



ENGINEERING TEAM ONE

DESIGNER  
KRB

REVIEWER  
JLL 11/13/23

PROJECT ID  
101386

SHEET TOTAL  
P.22 63






SHEET NUM.												PART.	ITEM	ITEM	GRAND	UNIT	DESCRIPTION	SEE SHEET NO.
12	13	14	15	17	18	25	26	32	39	40	RW.5	01/STR/04	EXT	TOTAL				
				1,400 208								1,400 208	410 410	12000 13000	1,400 208	CY CY	MAINTENANCE OF TRAFFIC TRAFFIC COMPACTED SURFACE, TYPE A OR B TRAFFIC COMPACTED SURFACE, TYPE C	
					80								80	614 11110	80	HOUR	LAW ENFORCEMENT OFFICER WITH PATROL CAR FOR ASSISTANCE	
				LS 144									LS 144	614 12420 614 12460	LS 144		DETOUR SIGNING WORK ZONE MARKING SIGN	
				100 16									100 16	614 614	100 16	CY SNMT	ASPHALT CONCRETE FOR MAINTAINING TRAFFIC PORTABLE CHANGEABLE MESSAGE SIGN, AS PER PLAN	17
									7.06				7.06	614	7.06	MILE	WORK ZONE CENTER LINE, CLASS III, 642 PAINT	
									14.12				14.12	614	14.12	MILE	WORK ZONE EDGE LINE, CLASS III, 6" 642 PAINT	
									134				134	614	134	FT	WORK ZONE STOP LINE, CLASS III, 642 PAINT	
				3 100									3 100	614 616	3 100	EACH MGAL	BUSINESS ENTRANCE SIGN, AS PER PLAN WATER	17
													LS 15 LS LS	614 619 623 624	LS 15 LS LS		INCIDENTALS MAINTAINING TRAFFIC FIELD OFFICE, TYPE C CONSTRUCTION LAYOUT STAKES AND SURVEYING MOBILIZATION	

GENERAL SUMMARY

DESIGN AGENCY  
**DISTRICT 3**



ENGINEERING  
 TEAM ONE

DESIGNER  
**KRB**

REVIEWER  
**JLL 11/13/23**

PROJECT ID  
**101386**

SHEET TOTAL  
 P.24 | 63





**UNDERDRAIN QUANTITIES**

OUTLET STA.	OFFSET [FT]		CONDUIT, TYPE F FOR UNDERDRAIN OUTLETS [FT]	PRECAST REINFORCED CONCRETE OUTLET	6" BASE PIPE UNDERDRAINS, AS PER PLAN [FT]		UNDERDRAIN DEPTH [IN]	
	LT	RT			LT	RT	LT	RT
	10+33.00	27			27	26	2	692
20+48.00	27	28	27	2	1015	1015*	12"	12"
30+48.00	26	26	24	2	1000	1000*	12"	12"
40+48.00	26	25	23	2	1000	1000	12"	12"
50+48.00	26	24	22	2	1000	1000	12"	12"
55+67.00	27	27	26	2	519	519	12"	12"
65+67.00	25	25	22	2	1000	1000	12"	12"
75+67.00	24	27	23	2	1000	1000	12"	12"
83+25.00	25	28	25	2	758	758	12"	12"
92+40.00	27	29	28	2	915	915	12"	12"
102+40.00	24	26	22	2	1000	1000	12"	12"
108+75.00	24		10	1	635		12"	12"
112+40.00		26	12	1		1000	12"	12"
118+75.00	26		12	1	1000		12"	12"
122+40.00		25	11	1		1000	12"	12"
128+75.00	25		11	1	1000		12"	12"
131+75.00		26	12	1		935	12"	12"
133+75.00	27		13	1	500		12"	12"
141+62.00	27	26	25	2	787	987	12"	12"
151+62.00	27	27	26	2	1000	1000	12"	12"
156+62.00	24	26	22	2	500	500	12"	12"
163+75.00	26	28	26	2	713	713	12"	12"
165+25.00	27	27	26	2	150	150	12"	12"
176+13.00	25	28	25	2	1088	1088	12"	12"
186+13.00	25	26	23	2	1000	1000	12"	12"
195+20.00	27	27	26	2	907	907	12"	12"
205+20.00	25	26	23	2	1000	1000	12"	12"
214+75.00	28	25	25	2	955	955	12"	12"
225+75.00	27	27	26	2	1100	1100	12"	12"
235+25.00	25	27	24	2	950	950	12"	12"
245+25.00	25	26	23	2	1000	1000	12"	12"
253+00.00	25		11	1	775		12"	12"
254+00.00		25	11	1		875	12"	12"
263+00.00	25		11	1	1000		12"	12"
264+00.00		24	10	1		1000	12"	12"
268+75.00	26		12	1	575		12"	12"
269+50.00		24	10	1		550	12"	12"
278+75.00	19	25	16	2	1000	925	12"	12"
292+50.00	28	30	30	2	1375	1375	12"	12"
302+00.00	20	19	11	2	950	950	12"	12"
312+00.00	LATERAL	24	45	1	1000	1000	12"	10"
321+50.00	LATERAL	27	48	1	950	950	12"	10"
331+50.00	20	21	13	2	1000	1000	12"	12"
340+00.00	21	20	13	2	850	850	12"	12"
347+75.00	LATERAL	24	45	1	775	775	12"	10"
352+75.00	LATERAL	22	43	1	500	500	12"	10"
359+26.00	31	27	30	2	651	651	12"	12"
368+40.00	23	24	19	2	914	914	12"	12"
TOTAL			1047	79	72998			

ALL QUANTITIES CARRIED TO THE DRAINAGE SUB-SUMMARY


**DRAINAGE SUB-SUMMARY**

PLAN SPLIT	ITEM	EXTENSION	DESCRIPTION	UNIT	HUR-13-0-98 (01/STR/04)	HUR-13-1-68 (01/STR/04)	HUR-13-4-38 (01/STR/04)	HUR-13-5-21 OPTION A & B (01/STR/04)	HUR-13-5-52 (01/STR/04)	UNDERDRAINS	TOTALS
					SHEET 33	SHEET 34	SHEET 35	SHEETS 36 - 37	SHEET 38		
01/STR/04	201	11000	CLEARING AND GRUBBING	LS	LS	LS	LS	LS			LS
01/STR/04	202	20010	HEADWALL REMOVED	EACH			2				2
01/STR/04	202	32000	CURB REMOVED	FT					43		43
01/STR/04	202	35100	PIPE REMOVED, 24" AND UNDER	FT					39		39
01/STR/04	202	58100	CATCH BASIN REMOVED	EACH					2		2
01/STR/04	503	11100	COFFERDAMS AND EXCAVATION BRACING	LS	LS	LS	LS	LS	LS		LS
01/STR/04	601	32100	ROCK CHANNEL PROTECTION, TYPE B W/ FILTER	CY	31	20	17				68
01/STR/04	602	20000	CONCRETE MASONRY	CY			5				5
01/STR/04	605	05100	4" SHALLOW PIPE UNDERDRAINS	FT					10		10
01/STR/04	605	14001	6" BASE PIPE UNDERDRAINS, AS PER PLAN	FT						72998	72998
01/STR/04	609	24510	CURB, TYPE 4-C	FT					43		43
01/STR/04	611	00510	6" CONDUIT, TYPE F FOR UNDERDRAIN OUTLETS	FT						1047	1047
01/STR/04	611	04600	12" CONDUIT, TYPE C	FT					29		29
01/STR/04	611	96551	FIELD PAVING OF EXISTING PIPE, AS PER PLAN (103" SPAN X 71" RISE CMP ARCH)	FT	92						92
01/STR/04	611	96551	FIELD PAVING OF EXISTING PIPE, AS PER PLAN (87" SPAN X 63" RISE CMP ARCH)	FT		82					82
01/STR/04	611	98180	CATCH BASIN, NO. 3A	EACH					2		2
01/STR/04	611	99710	PRECAST REINFORCED CONCRETE OUTLET	EACH						79	79
01/STR/04	833	10000	CONDUIT RENEWAL USING SPRAY APPLIED STRUCTURAL LINER, ROUND CONDUIT (42" DIAMETER)	FT				51			51
01/STR/04	833	12000	CONDUIT RENEWAL USING SPRAY APPLIED STRUCTURAL LINER, ARCH (87" SPAN X 63" RISE)	FT			74				74
01/STR/04	899	10000	CURED-IN-PLACE PIPE LINER (42" DIAMETER)	FT				51			51

ALL QUANTITIES CARRIED TO GENERAL SUMMARY

**NOTES:**  
 - 6" UNDERDRAINS SHALL BE CENTERED 14'-3" FROM THE @ CONST. UNLESS SPECIFIED ELSEWHERE.  
 - \* UNDERDRAIN CENTERED 16'-3" FROM @ CONST..  
 - OFFSETS MARKED "LATERAL" WILL REQUIRE LATERAL DRAINAGE AS PER DM-1.2.  
 - UNDERDRAIN DEPTH MEASURED FROM THE TOP OF PROPOSED SUBGRADE.



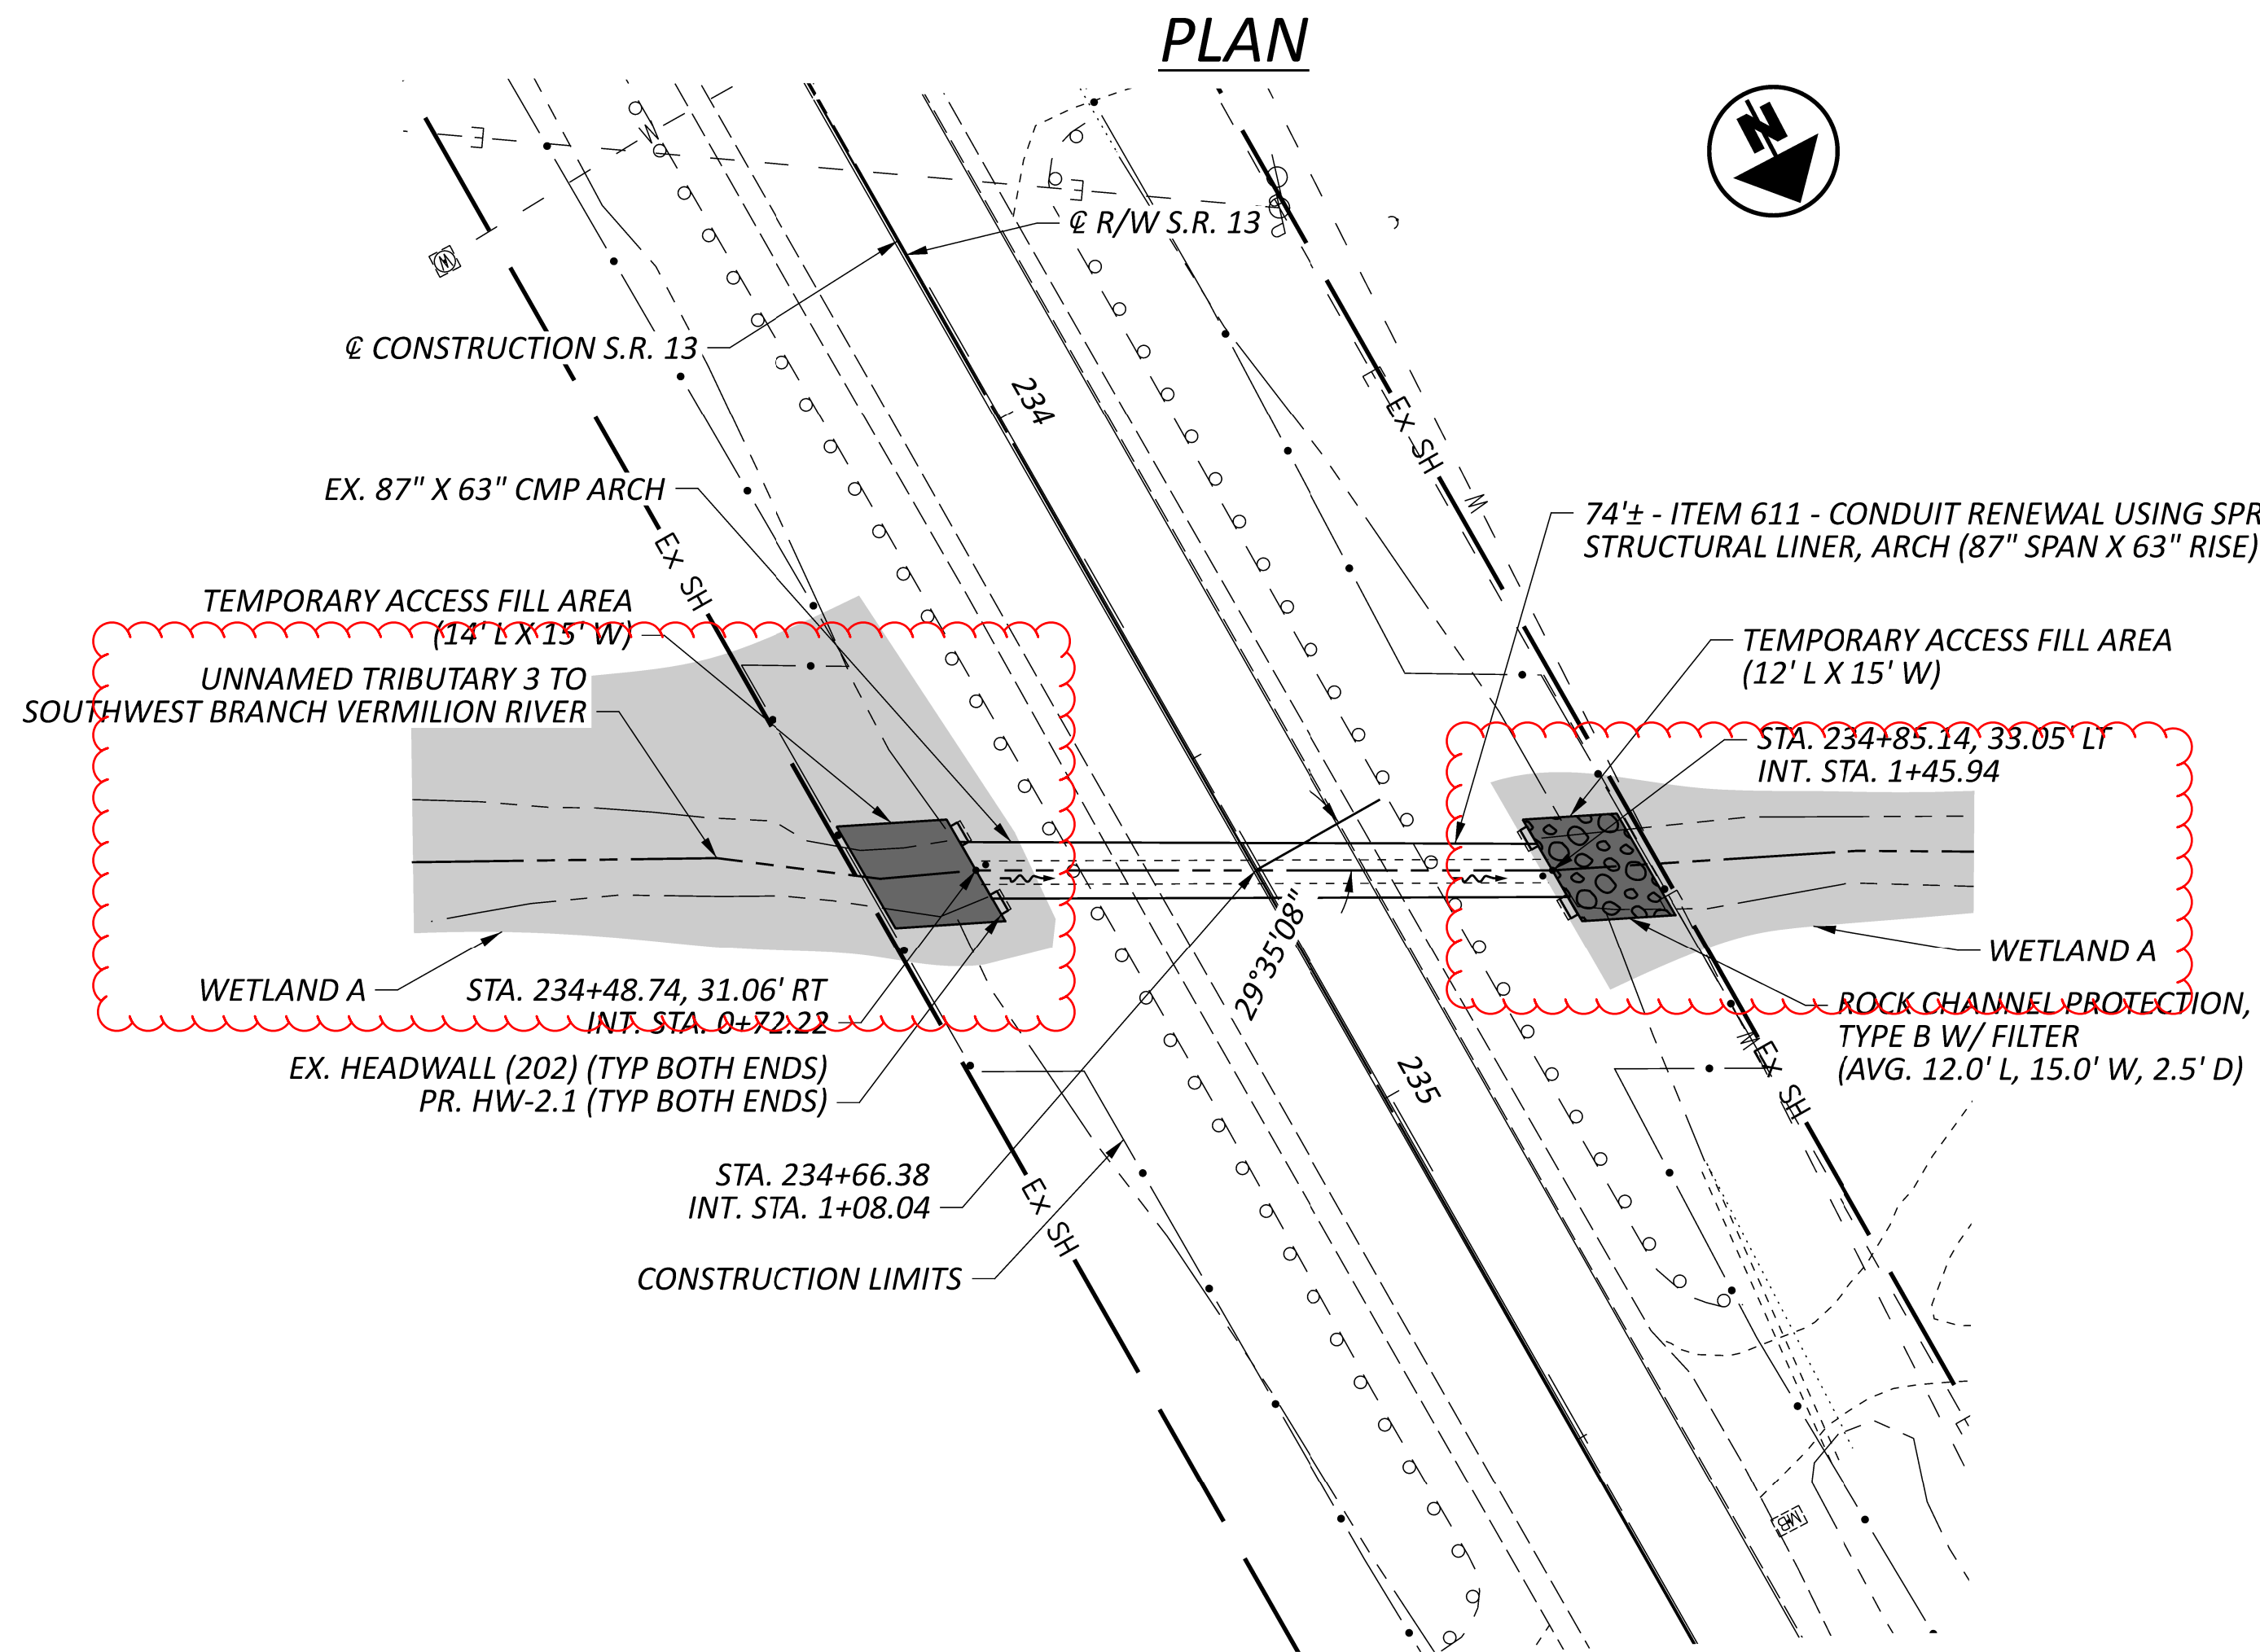

**LEGEND**

- 202 - TO BE REMOVED, DND - DO NOT DISTURB
- ROCK CHANNEL PROTECTION, TYPE B W/ FILTER
- TEMPORARY ACCESS FILL AREA
- WETLAND

**NOTES**

- 1.) EARTHWORK LIMITS SHOWN ARE APPROXIMATE. ACTUAL SLOPES SHALL CONFORM TO EARTHWORK DATA TABLES.
- 2.) PROPOSED PAVEMENT WORK NOT SHOWN ON PLAN VIEW FOR CLARITY. GUARDRAIL WORK NOT SHOWN ON PLAN AND PROFILE VIEW FOR CLARITY.

**HYDRAULIC DATA**

DRAINAGE AREA = 0.41 SQ. MILES  
 Q (25) = 186 CFS      V (25) = 11.00 FT/S  
 Q (100) = 280 CFS      V (100) = 12.27 FT/S




**EXISTING STRUCTURE**

TYPE: CORRUGATED METAL PIPE ARCH  
 CULVERT FILE NUMBER: 1835334  
 DIMENSIONS: 87" SPAN X 63" RISE  
 LENGTH: 73'-9"±  
 SKEW: 29° 35' 08" L.F.  
 ALIGNMENT: TANGENT  
 STREAM: ABRASION LEVEL = 2, pH = 8.5  
 DATE BUILT: 1958  
 COORDINATES: 41°03'22" N 82°29'11" W  
 DISPOSITION: POOR (TO BE REHABILITATED)

**HUR-13-4.38 ESTIMATED QUANTITIES (01/STR/01)**

ITEM	QUANTITY	UNIT	DESCRIPTION
201	LS		CLEARING AND GRUBBING
202	2	EACH	HEADWALL REMOVED
503	LS		COFFERDAMS AND EXCAVATION BRACING
601	17	CY	ROCK CHANNEL PROTECTION, TYPE B WITH FILTER
602	5	CY	CONCRETE MASONRY
833	74	FT	CONDUIT RENEWAL USING SPRAY APPLIED STRUCTURAL LINER, ARCH (87" SPAN X 63" RISE)

ALL QUANTITIES CARRIED TO DRAINAGE SUB-SUMMARY

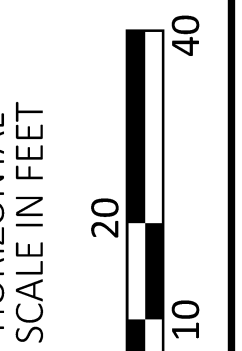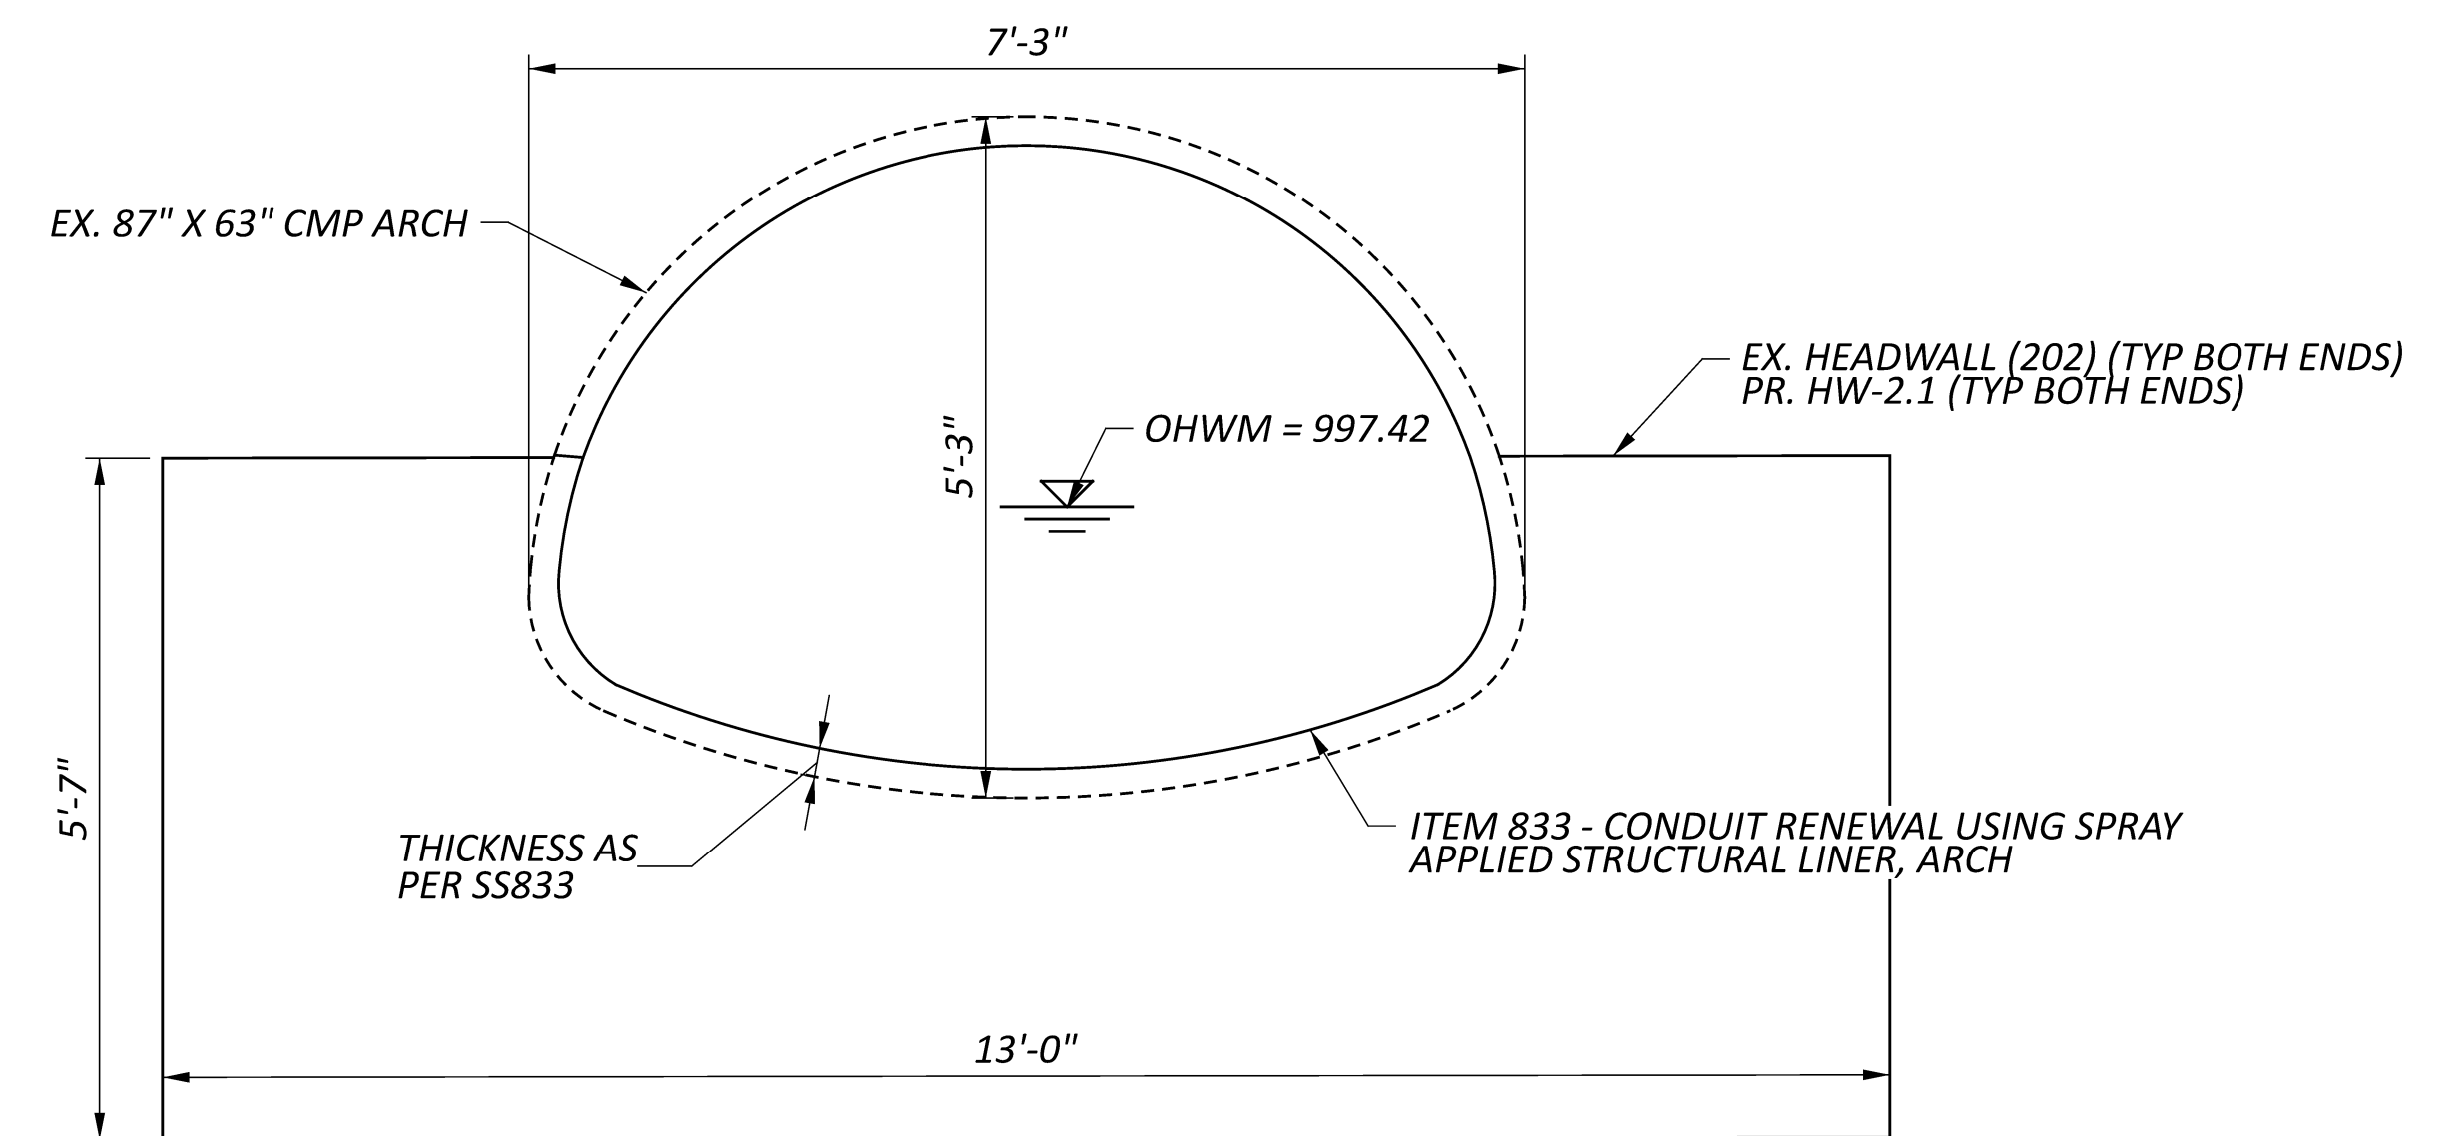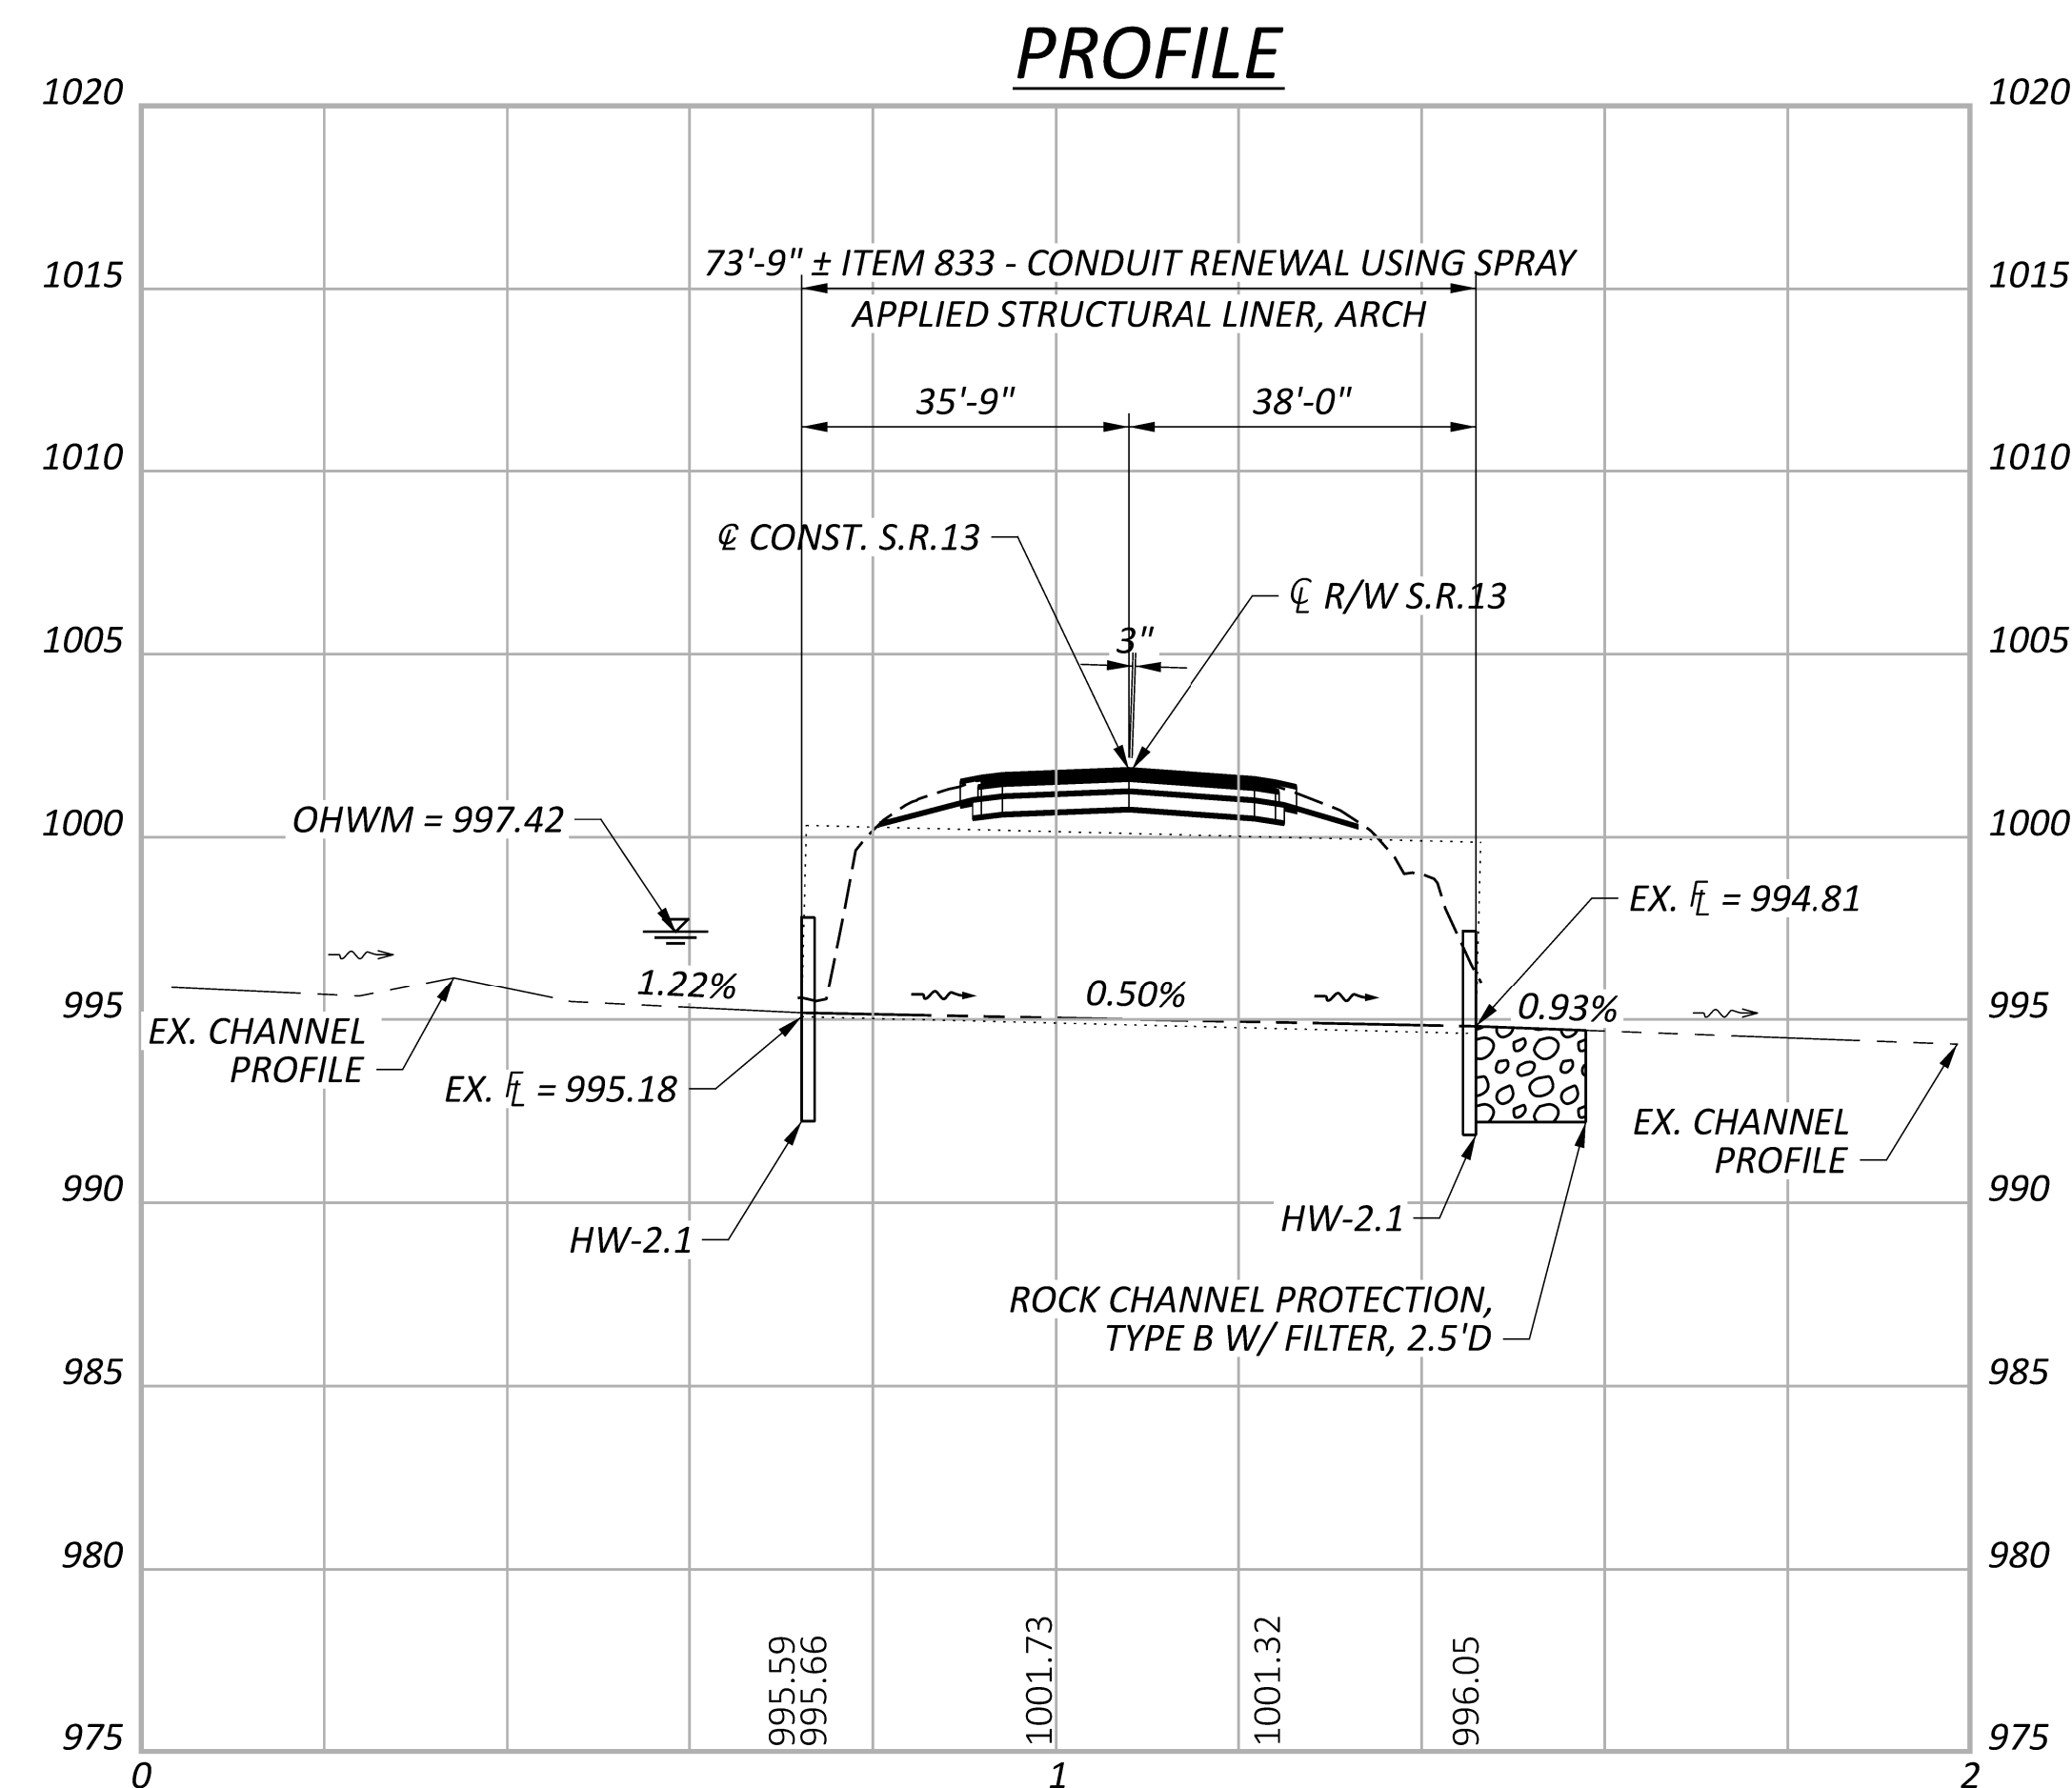

**CULVERT DETAILS**  
 HUR-13-4.38

DESIGN AGENCY

DISTRICT 3



ENGINEERING TEAM ONE

DESIGNER

ACM

REVIEWER

KRB 11/13/23

PROJECT ID

101386

SHEET TOTAL

P.35 63







HUR-13-0.00

MODEL: PGLSHEET 2 PAPER SIZE: 34x22 (in.) DATE: 1/10/2024 TIME: 5:53:55 PM USER: ksabay  
pw:\01hodot-pw.bentley.com\ohodot-pw-02\Documents\01.Active Projects\District 03\Huron\101386\400-Engineering\Roadway\Sheets\101386\_GF001.dgn




**HUR-13-0.00**

MODEL: PGLSHEET 3 PAPER SIZE: 34x22 (in.) DATE: 1/10/2024 TIME: 5:54:26 PM USER: ksabay  
 pw:\01hohdot-pw.bentley.com\ohohdot-pw-02\Documents\01.Active Projects\District 03\Huron\101386\400-Engineering\Roadway\Sheets\101386\_GF001.dgn

ELEVATION				WIDTH (FT)				CENTERLINE				ELEVATION				RIGHT SIDE			
ELEVATION		CROSS SLOPE		WIDTH (FT)		STATION		PROFILE GRADE		ELEVATION		CROSS SLOPE		WIDTH (FT)					
EP.	EPS.	LANE	SH.	ROTATION	LANE	SH.	STATION	PROFILE GRADE	EP.	EPS.	LANE	SH.	ROTATION	LANE	SH.				
1130.834	1130.754	1.60%	4.00%	CROWN	12	2	50+25.00	1131.026	1130.834	1130.754	-1.60%	4.00%	CROWN	12	2				
1129.819	1129.739	1.60%	4.00%	CROWN	12	2	50+50.00	1130.011	1129.819	1129.739	-1.60%	4.00%	CROWN	12	2				
1128.859	1128.779	1.60%	4.00%	CROWN	12	2	50+75.00	1129.051	1128.859	1128.779	-1.60%	4.00%	CROWN	12	2				
1128.000	1127.920	1.60%	4.00%	CROWN	12	2	51+00.00	1128.192	1128.000	1127.920	-1.60%	4.00%	CROWN	12	2				
1127.165	1127.085	1.60%	4.00%	CROWN	12	2	51+25.00	1127.357	1127.165	1127.085	-1.60%	4.00%	CROWN	12	2				
1126.431	1126.351	1.60%	4.00%	CROWN	12	2	51+50.00	1126.623	1126.431	1126.351	-1.60%	4.00%	CROWN	12	2				
1125.725	1125.645	1.60%	4.00%	CROWN	12	2	51+75.00	1125.917	1125.725	1125.645	-1.60%	4.00%	CROWN	12	2				
1125.148	1125.068	1.60%	4.00%	CROWN	12	2	52+00.00	1125.340	1125.148	1125.068	-1.60%	4.00%	CROWN	12	2				
1124.659	1124.579	1.60%	4.00%	CROWN	12	2	52+25.00	1124.851	1124.659	1124.579	-1.60%	4.00%	CROWN	12	2				
1124.065	1123.985	1.60%	4.00%	CROWN	12	2	52+50.00	1124.257	1124.065	1123.985	-1.60%	4.00%	CROWN	12	2				
1123.546	1123.466	1.60%	4.00%	CROWN	12	2	52+75.00	1123.738	1123.546	1123.466	-1.60%	4.00%	CROWN	12	2				
1123.039	1122.959	1.60%	4.00%	CROWN	12	2	53+00.00	1123.231	1123.039	1122.959	-1.60%	4.00%	CROWN	12	2				
1122.556	1122.476	1.60%	4.00%	CROWN	12	2	53+25.00	1122.748	1122.556	1122.476	-1.60%	4.00%	CROWN	12	2				
1122.052	1121.972	1.60%	4.00%	CROWN	12	2	53+50.00	1122.244	1122.052	1121.972	-1.60%	4.00%	CROWN	12	2				
1121.668	1121.588	1.60%	4.00%	CROWN	12	2	53+75.00	1121.860	1121.668	1121.588	-1.60%	4.00%	CROWN	12	2				
1121.400	1121.320	1.60%	4.00%	CROWN	12	2	54+00.00	1121.592	1121.400	1121.320	-1.60%	4.00%	CROWN	12	2				
1121.227	1121.147	1.60%	4.00%	CROWN	12	2	54+25.00	1121.419	1121.227	1121.147	-1.60%	4.00%	CROWN	12	2				
1121.198	1121.118	1.60%	4.00%	CROWN	12	2	54+50.00	1121.390	1121.198	1121.118	-1.60%	4.00%	CROWN	12	2				
1121.138	1121.058	1.60%	4.00%	CROWN	12	2	54+75.00	1121.330	1121.138	1121.058	-1.60%	4.00%	CROWN	12	2				
1121.068	1120.988	1.60%	4.00%	CROWN	12	2	55+00.00	1121.260	1121.068	1120.988	-1.60%	4.00%	CROWN	12	2				
1121.028	1120.948	1.60%	4.00%	CROWN	12	2	55+25.00	1121.220	1121.028	1120.948	-1.60%	4.00%	CROWN	12	2				
1121.038	1120.958	1.60%	4.00%	CROWN	12	2	55+50.00	1121.230	1121.038	1120.958	-1.60%	4.00%	CROWN	12	2				
1121.026	1120.946	1.60%	4.00%	CROWN	12	2	55+75.00	1121.218	1121.026	1120.946	-1.60%	4.00%	CROWN	12	2				
1121.057	1120.977	1.60%	4.00%	CROWN	12	2	56+00.00	1121.249	1121.057	1120.977	-1.60%	4.00%	CROWN	12	2				
1121.136	1121.056	1.60%	4.00%	CROWN	12	2	56+25.00	1121.328	1121.136	1121.056	-1.60%	4.00%	CROWN	12	2				
1121.251	1121.171	1.60%	4.00%	CROWN	12	2	56+50.00	1121.443	1121.251	1121.171	-1.60%	4.00%	CROWN	12	2				
1121.433	1121.353	1.60%	4.00%	CROWN	12	2	56+75.00	1121.625	1121.433	1121.353	-1.60%	4.00%	CROWN	12	2				
1121.586	1121.506	1.60%	4.00%	CROWN	12	2	57+00.00	1121.778	1121.586	1121.506	-1.60%	4.00%	CROWN	12	2				
1121.783	1121.703	1.60%	4.00%	CROWN	12	2	57+25.00	1121.975	1121.783	1121.703	-1.60%	4.00%	CROWN	12	2				
1121.967	1121.887	1.60%	4.00%	CROWN	12	2	57+50.00	1122.159	1121.967	1121.887	-1.60%	4.00%	CROWN	12	2				
1122.286	1122.206	1.60%	4.00%	CROWN	12	2	57+75.00	1122.478	1122.286	1122.206	-1.60%	4.00%	CROWN	12	2				
1122.692	1122.612	1.60%	4.00%	CROWN	12	2	58+00.00	1122.884	1122.692	1122.612	-1.60%	4.00%	CROWN	12	2				
1123.172	1123.092	1.60%	4.00%	CROWN	12	2	58+25.00	1123.364	1123.172	1123.092	-1.60%	4.00%	CROWN	12	2				
1123.766	1123.686	1.60%	4.00%	CROWN	12	2	58+50.00	1123.958	1123.766	1123.686	-1.60%	4.00%	CROWN	12	2				
1124.343	1124.263	1.60%	4.00%	CROWN	12	2	58+75.00	1124.535	1124.343	1124.263	-1.60%	4.00%	CROWN	12	2				
1124.917	1124.837	1.60%	4.00%	CROWN	12	2	59+00.00	1125.109	1124.917	1124.837	-1.60%	4.00%	CROWN	12	2				
1125.490	1125.410	1.60%	4.00%	CROWN	12	2	59+25.00	1125.682	1125.490	1125.410	-1.60%	4.00%	CROWN	12	2				
1126.100	1126.020	1.60%	4.00%	CROWN	12	2	59+50.00	1126.292	1126.100	1126.020	-1.60%	4.00%	CROWN	12	2				
1126.740	1126.660	1.60%	4.00%	CROWN	12	2	59+75.00	1126.932	1126.740	1126.660	-1.60%	4.00%	CROWN	12	2				
1127.417	1127.337	1.60%	4.00%	CROWN	12	2	60+00.00	1127.609	1127.417	1127.337	-1.60%	4.00%	CROWN	12	2				
1128.057	1127.977	1.60%	4.00%	CROWN	12	2	60+25.00	1128.249	1128.057	1127.977	-1.60%	4.00%	CROWN	12	2				
1128.672	1128.592	1.60%	4.00%	CROWN	12	2	60+50.00	1128.864	1128.672	1128.592	-1.60%	4.00%	CROWN	12	2				
1129.158	1129.078	1.60%	4.00%	CROWN	12	2	60+75.00	1129.350	1129.158	1129.078	-1.60%	4.00%	CROWN	12	2				
1129.654	1129.574	1.60%	4.00%	CROWN	12	2	61+00.00	1129.846	1129.654	1129.574	-1.60%	4.00%	CROWN	12	2				
1130.160	1130.080	1.60%	4.00%	CROWN	12	2	61+25.00	1130.352	1130.160	1130.080	-1.60%	4.00%	CROWN	12	2				
1130.667	1130.587	1.60%	4.00%	CROWN	12	2	61+50.00	1130.859	1130.667	1130.587	-1.60%	4.00%	CROWN	12	2				
1131.153	1131.073	1.60%	4.00%	CROWN	12	2	61+75.00	1131.345	1131.153	1131.073	-1.60%	4.00%	CROWN	12	2				
1131.739	1131.659	1.60%	4.00%	CROWN	12	2	62+00.00	1131.931	1131.739	1131.659	-1.60%	4.00%	CROWN	12	2				
1132.251	1132.171	1.60%	4.00%	CROWN	12	2	62+25.00	1132.443	1132.251	1132.171	-1.60%	4.00%	CROWN	12	2				
1132.791	1132.711	1.60%	4.00%	CROWN	12	2	62+50.00	1132.983	1132.791	1132.711	-1.60%	4.00%	CROWN	12	2				
1133.326	1133.246	1.60%	4.00%	CROWN	12	2	62+75.00	1133.518	1133.326	1133.246	-1.60%	4.00%	CROWN	12	2				
1133.874	1133.794	1.60%	4.00%	CROWN	12	2	63+00.00	1134.066	1133.874	1133.794	-1.60%	4.00%	CROWN	12	2				
1134.329	1134.249	1.60%	4.00%	CROWN	12	2	63+25.00	1134.521	1134.329	1134.249	-1.60%	4.00%	CROWN	12	2				
1134.641	1134.561	1.60%	4.00%	CROWN	12	2	63+50.00	1134.833	1134.641	1134.561	-1.60%	4.00%	CROWN	12	2				
1134.875	1134.795	1.60%	4.00%	CROWN	12	2	63+75.00	1135.067	1134.875	1134.795	-1.60%	4.00%	CROWN	12	2				
1134.991	1134.911	1.60%	4.00%	CROWN	12	2	64+00.00	1135.183	1134.991	1134.911	-1.60%	4.00%	CROWN	12	2				
1135.064	1134.984	1.60%	4.00%	CROWN	12	2	64+25.00	1135.256	1135.064	1134.984	-1.60%	4.00%	CROWN	12	2				
1135.123	1135.043	1.60%	4.00%	CROWN	12	2	64+50.00	1135.315	1135.123	1135.043	-1.60%	4.00%	CROWN	12	2				
1135.210	1135.130	1.60%	4.00%	CROWN	12	2	64+75.00	1135.402	1135.210	1135.130	-1.60%	4.00%	CROWN	12	2				
1135.207	1135.127	1.60%	4.00%	CROWN	12	2	65+00.00	1135.399	1135.207	1135.127	-1.60%	4.00%	CROWN	12	2				
1135.224	1135.144	1.60%	4.00%	CROWN	12	2	65+25.00	1135.416	1135.224	1135.144	-1.60%	4.00%	CROWN	12	2				
1135.173	1135.093	1.60%	4.00%	CROWN	12	2	65+50.00	1135.365	1135.173	1135.093	-1.60%	4.00%	CROWN	12	2				
1135.192	1135.112	1.60%	4.00%	CROWN	12	2	65+75.00	1135.384	1135.192	1135.112	-1.60%	4.00%	CROWN	12	2				
1135.050	1134.970	1.60%	4.00%	CROWN	12	2	66+00.00	1135.242	1135.050	1134.970	-1.60%	4.00%	CROWN	12	2				
1134.854	1134.774	1.60%	4.00%	CROWN	12	2	66+25.00	1135.046	1134.854	1134.774	-1.60%	4.00%	CROWN	12	2				
1134.575	1134.495	1.60%	4.00%	CROWN	12	2	66+50.00	1134.767	1134.575	1134.495	-1.60%	4.00%	CROWN	12	2				
1134.227	1134.147	1.60%	4.00%	CROWN	12	2	66+75.00	1134.419	1134.227	1134.147	-1.60%	4.00%	CROWN	12	2				
1133.859	1133.779	1.60%	4.00%	CROWN	12	2	67+00.00	1134.051	1133.859	1133.779	-1.60%	4.00%	CROWN	12	2				
1133.456	1133.376	1.60%	4.00%	CROWN	12	2	67+25.00	1133.648	1133.456	1133.376	-1.60%	4.00%	CROWN	12	2				
1133.161	1133.081	1.60%	4.00%	CROWN	12	2	67+50.00	1133.353	1133.161	1133.081	-1.60%	4.00%	CROWN	12	2				
1132.820	1132.740	1.60%	4.00%	CROWN	12	2	67+75.00	1133.012	1132.820	1132.740	-1.60%	4.00%	CROWN	12	2				
1132.505	1132.425	1.60%	4.00%	CROWN	12	2	68+00.00	1132.697	1132.505	1132.425	-1.60%	4.00%	CROWN	12	2				
1132.164	1132.084	1.60%	4.00%	CROWN	12	2	68+25.00	1132.356	1132.164	1132.084	-1.60%	4.00%	CROWN	12	2				
1131.865	1131.785	1.60%	4.00%	CROWN	12	2	68+50.00	1132.057	1131.865	1131.785	-1.60%	4.00%	CROWN	12	2				
1131.524	1131.444	1.60%	4.00%	CROWN	12	2	68+75.00	1131.716	1131.524	1131.444	-1.60%	4.00%	CROWN	12	2				
1131.219	1131.139	1.60%	4.00%	CROWN	12														



HUR-13-0.00

MODEL: PGL SHEET 4 PAPER SIZE: 34x22 (in.) DATE: 1/10/2024 TIME: 5:54:53 PM USER: ksabay  
pw:\01h0dot-pw.bentley.com\ohdot-pw-02\Documents\01.Active Projects\District 03\Huron\101386\400-Engineering\Roadway\Sheets\101386\_GF001.dgn

ELEVATION				CENTERLINE				RIGHT SIDE						
LEFT SIDE		RIGHT SIDE		CENTERLINE		RIGHT SIDE		ELEVATION		CROSS SLOPE		WIDTH (FT)		
EP.	EPS.	LANE	SH.	ROTATION	LANE	SH.	ROTATION	EP.	EPS.	LANE	SH.	ROTATION	LANE	SH.
1122.661	1122.581	1.60%	4.00%	CROWN	12	2	CROWN	1122.661	1122.581	-1.60%	-4.00%	CROWN	12	2
1122.505	1122.425	1.60%	4.00%	CROWN	12	2	CROWN	1122.505	1122.425	-1.60%	-4.00%	CROWN	12	2
1122.463	1122.383	1.60%	4.00%	CROWN	12	2	CROWN	1122.463	1122.383	-1.60%	-4.00%	CROWN	12	2
1122.488	1122.408	1.60%	4.00%	CROWN	12	2	CROWN	1122.488	1122.408	-1.60%	-4.00%	CROWN	12	2
1122.421	1122.341	1.60%	4.00%	CROWN	12	2	CROWN	1122.421	1122.341	-1.60%	-4.00%	CROWN	12	2
1122.419	1122.339	1.60%	4.00%	CROWN	12	2	CROWN	1122.419	1122.339	-1.60%	-4.00%	CROWN	12	2
1122.470	1122.390	1.60%	4.00%	CROWN	12	2	CROWN	1122.470	1122.390	-1.60%	-4.00%	CROWN	12	2
1122.530	1122.450	1.60%	4.00%	CROWN	12	2	CROWN	1122.530	1122.450	-1.60%	-4.00%	CROWN	12	2
1122.644	1122.564	1.60%	4.00%	CROWN	12	2	CROWN	1122.644	1122.564	-1.60%	-4.00%	CROWN	12	2
1122.683	1122.603	1.60%	4.00%	CROWN	12	2	CROWN	1122.683	1122.603	-1.60%	-4.00%	CROWN	12	2
1122.692	1122.612	1.60%	4.00%	CROWN	12	2	CROWN	1122.692	1122.612	-1.60%	-4.00%	CROWN	12	2
1122.757	1122.677	1.60%	4.00%	CROWN	12	2	CROWN	1122.757	1122.677	-1.60%	-4.00%	CROWN	12	2
1122.826	1122.746	1.60%	4.00%	CROWN	12	2	CROWN	1122.826	1122.746	-1.60%	-4.00%	CROWN	12	2
1122.887	1122.807	1.60%	4.00%	CROWN	12	2	CROWN	1122.887	1122.807	-1.60%	-4.00%	CROWN	12	2
1122.904	1122.824	1.60%	4.00%	CROWN	12	2	CROWN	1122.904	1122.824	-1.60%	-4.00%	CROWN	12	2
1122.842	1122.762	1.60%	4.00%	CROWN	12	2	CROWN	1122.842	1122.762	-1.60%	-4.00%	CROWN	12	2
1122.784	1122.704	1.60%	4.00%	CROWN	12	2	CROWN	1122.784	1122.704	-1.60%	-4.00%	CROWN	12	2
1122.645	1122.565	1.60%	4.00%	CROWN	12	2	CROWN	1122.645	1122.565	-1.60%	-4.00%	CROWN	12	2
1122.497	1122.417	1.60%	4.00%	CROWN	12	2	CROWN	1122.497	1122.417	-1.60%	-4.00%	CROWN	12	2
1122.352	1122.272	1.60%	4.00%	CROWN	12	2	CROWN	1122.352	1122.272	-1.60%	-4.00%	CROWN	12	2
1122.128	1122.048	1.60%	4.00%	CROWN	12	2	CROWN	1122.128	1122.048	-1.60%	-4.00%	CROWN	12	2
1121.885	1121.805	1.60%	4.00%	CROWN	12	2	CROWN	1121.885	1121.805	-1.60%	-4.00%	CROWN	12	2
1121.640	1121.560	1.60%	4.00%	CROWN	12	2	CROWN	1121.640	1121.560	-1.60%	-4.00%	CROWN	12	2
1121.318	1121.238	1.60%	4.00%	CROWN	12	2	CROWN	1121.318	1121.238	-1.60%	-4.00%	CROWN	12	2
1120.952	1120.872	1.60%	4.00%	CROWN	12	2	CROWN	1120.952	1120.872	-1.60%	-4.00%	CROWN	12	2
1120.532	1120.452	1.60%	4.00%	CROWN	12	2	CROWN	1120.532	1120.452	-1.60%	-4.00%	CROWN	12	2
1120.053	1119.973	1.60%	4.00%	CROWN	12	2	CROWN	1120.053	1119.973	-1.60%	-4.00%	CROWN	12	2
1119.426	1119.346	1.60%	4.00%	CROWN	12	2	CROWN	1119.426	1119.346	-1.60%	-4.00%	CROWN	12	2
1118.756	1118.676	1.60%	4.00%	CROWN	12	2	CROWN	1118.756	1118.676	-1.60%	-4.00%	CROWN	12	2
1118.126	1118.046	1.60%	4.00%	CROWN	12	2	CROWN	1118.126	1118.046	-1.60%	-4.00%	CROWN	12	2
1117.574	1117.494	1.60%	4.00%	CROWN	12	2	CROWN	1117.574	1117.494	-1.60%	-4.00%	CROWN	12	2
1116.969	1116.889	1.60%	4.00%	CROWN	12	2	CROWN	1116.969	1116.889	-1.60%	-4.00%	CROWN	12	2
1116.300	1116.220	1.60%	4.00%	CROWN	12	2	CROWN	1116.300	1116.220	-1.60%	-4.00%	CROWN	12	2
1115.671	1115.591	1.60%	4.00%	CROWN	12	2	CROWN	1115.671	1115.591	-1.60%	-4.00%	CROWN	12	2
1115.116	1115.036	1.60%	4.00%	CROWN	12	2	CROWN	1115.116	1115.036	-1.60%	-4.00%	CROWN	12	2
1114.605	1114.525	1.60%	4.00%	CROWN	12	2	CROWN	1114.605	1114.525	-1.60%	-4.00%	CROWN	12	2
1114.058	1113.978	1.60%	4.00%	CROWN	12	2	CROWN	1114.058	1113.978	-1.60%	-4.00%	CROWN	12	2
1113.513	1113.433	1.60%	4.00%	CROWN	12	2	CROWN	1113.513	1113.433	-1.60%	-4.00%	CROWN	12	2
1112.971	1112.891	1.60%	4.00%	CROWN	12	2	CROWN	1112.971	1112.891	-1.60%	-4.00%	CROWN	12	2
1112.465	1112.385	1.60%	4.00%	CROWN	12	2	CROWN	1112.465	1112.385	-1.60%	-4.00%	CROWN	12	2
1111.921	1111.841	1.60%	4.00%	CROWN	12	2	CROWN	1111.921	1111.841	-1.60%	-4.00%	CROWN	12	2
1111.377	1111.297	1.60%	4.00%	CROWN	12	2	CROWN	1111.377	1111.297	-1.60%	-4.00%	CROWN	12	2
1110.900	1110.820	1.60%	4.00%	CROWN	12	2	CROWN	1110.900	1110.820	-1.60%	-4.00%	CROWN	12	2
1110.432	1110.352	1.60%	4.00%	CROWN	12	2	CROWN	1110.432	1110.352	-1.60%	-4.00%	CROWN	12	2
1109.905	1109.825	1.60%	4.00%	CROWN	12	2	CROWN	1109.905	1109.825	-1.60%	-4.00%	CROWN	12	2
1109.342	1109.262	1.60%	4.00%	CROWN	12	2	CROWN	1109.342	1109.262	-1.60%	-4.00%	CROWN	12	2
1108.781	1108.701	1.60%	4.00%	CROWN	12	2	CROWN	1108.781	1108.701	-1.60%	-4.00%	CROWN	12	2
1108.187	1108.107	1.60%	4.00%	CROWN	12	2	CROWN	1108.187	1108.107	-1.60%	-4.00%	CROWN	12	2
1107.633	1107.553	1.60%	4.00%	CROWN	12	2	CROWN	1107.633	1107.553	-1.60%	-4.00%	CROWN	12	2
1107.024	1106.944	1.60%	4.00%	CROWN	12	2	CROWN	1107.024	1106.944	-1.60%	-4.00%	CROWN	12	2
1106.312	1106.232	1.60%	4.00%	CROWN	12	2	CROWN	1106.312	1106.232	-1.60%	-4.00%	CROWN	12	2
1105.573	1105.493	1.60%	4.00%	CROWN	12	2	CROWN	1105.573	1105.493	-1.60%	-4.00%	CROWN	12	2
1104.856	1104.776	1.60%	4.00%	CROWN	12	2	CROWN	1104.856	1104.776	-1.60%	-4.00%	CROWN	12	2
1104.258	1104.178	1.60%	4.00%	CROWN	12	2	CROWN	1104.258	1104.178	-1.60%	-4.00%	CROWN	12	2
1103.659	1103.579	1.60%	4.00%	CROWN	12	2	CROWN	1103.659	1103.579	-1.60%	-4.00%	CROWN	12	2
1103.023	1102.943	1.60%	4.00%	CROWN	12	2	CROWN	1103.023	1102.943	-1.60%	-4.00%	CROWN	12	2
1102.452	1102.372	1.60%	4.00%	CROWN	12	2	CROWN	1102.452	1102.372	-1.60%	-4.00%	CROWN	12	2
1101.942	1101.862	1.60%	4.00%	CROWN	12	2	CROWN	1101.942	1101.862	-1.60%	-4.00%	CROWN	12	2
1101.404	1101.324	1.60%	4.00%	CROWN	12	2	CROWN	1101.404	1101.324	-1.60%	-4.00%	CROWN	12	2
1100.888	1100.808	1.60%	4.00%	CROWN	12	2	CROWN	1100.888	1100.808	-1.60%	-4.00%	CROWN	12	2
1100.370	1100.290	1.60%	4.00%	CROWN	12	2	CROWN	1100.370	1100.290	-1.60%	-4.00%	CROWN	12	2
1099.867	1099.787	1.60%	4.00%	CROWN	12	2	CROWN	1099.867	1099.787	-1.60%	-4.00%	CROWN	12	2
1099.387	1099.307	1.60%	4.00%	CROWN	12	2	CROWN	1099.387	1099.307	-1.60%	-4.00%	CROWN	12	2
1098.922	1098.842	1.60%	4.00%	CROWN	12	2	CROWN	1098.922	1098.842	-1.60%	-4.00%	CROWN	12	2
1098.482	1098.402	1.60%	4.00%	CROWN	12	2	CROWN	1098.482	1098.402	-1.60%	-4.00%	CROWN	12	2
1098.082	1098.002	1.60%	4.00%	CROWN	12	2	CROWN	1098.082	1098.002	-1.60%	-4.00%	CROWN	12	2
1097.857	1097.777	1.60%	4.00%	CROWN	12	2	CROWN	1097.857	1097.777	-1.60%	-4.00%	CROWN	12	2
1097.729	1097.649	1.60%	4.00%	CROWN	12	2	CROWN	1097.729	1097.649	-1.60%	-4.00%	CROWN	12	2
1097.689	1097.619	1.60%	4.00%	CROWN	12	2	CROWN	1097.689	1097.619	-1.60%	-4.00%	CROWN	12	2
1097.667	1097.587	1.60%	4.00%	CROWN	12	2	CROWN	1097.667	1097.587	-1.60%	-4.00%	CROWN	12	2
1097.706	1097.626	1.60%	4.00%	CROWN	12	2	CROWN	1097.706	1097.626	-1.60%	-4.00%	CROWN	12	2
1097.811	1097.731	1.60%	4.00%	CROWN	12	2	CROWN	1097.811	1097.731	-1.60%	-4.00%	CROWN	12	2
1097.970	1097.890	1.60%	4.00%	CROWN	12	2	CROWN	1097.970	1097.890	-1.60%	-4.00%	CROWN	12	2
1098.188	1098.108	1.60%	4.00%	CROWN	12	2	CROWN	1098.188	1098.108	-1.60%	-4.00%	CROWN	12	2
1098.423	1098.343	1.60%	4.00%	CROWN	12	2	CROWN	1098.423	1098.343	-1.60%	-4.00%	CROWN	12	2
1098.664	1098.584	1.60%	4.00%	CROWN	12	2	CROWN	1098.664	1098.584	-1.60%	-4.00%	CROWN	12	2
1099.003	1098.923	1.60%	4.00%	CROWN	12	2	CROWN	1099.003	1098.923	-1.60%	-4.00%	CROWN	12	2
1099.349	1099.269	1.60%	4.00%	CROWN	12	2	CROWN	1099.349	1099.269	-1.60%	-4.00%	CROWN	12	2
1099.747	1099.667	1.60%	4.00%	CROWN	12	2	CROWN	1099.747	1099.667	-1.60%	-4.00%	CROWN	12	2
1100.135	1100.055	1.60%	4.00%	CROWN	12	2	CROWN	1100.135	1100.055	-1.60%	-4.00%	CROWN	12	2
1100.409	1100.329	1.60%	4.00%	CROWN	12	2	CROWN	1100.409	1100.329	-1.60%	-4.00%	CROWN	12	2
1100.560	1100.480	1.60%	4.00%	CROWN	12	2	CROWN	1100.560	1100.480	-1.60%	-4.00%	CROWN	12	2
1100.530	1100.450	1.60%	4.00%	CROWN	12	2	CROWN	1100.530	1100.450	-1.60%	-4.00%	CROWN	12	2
1100.395	1100.315	1.60%	4.00%	CROWN	12	2	CROWN	1100.395	1100.315	-1.60%	-4.00%	CROWN	12	2
1100.213	1100.133	1.60%	4.00%	CROWN	12	2	CROWN	1100.213	1100.133	-1.60%	-4.00%	CROWN	12	2
1100.006	1099.926	1.60%	4.00%	CROWN	12	2	CROWN	1100.006	1099.926	-1.60%	-4.00%	CROWN	12	2
1099.726	1099.646	1.60%	4.00%	CROWN	12	2	CROWN	1099.726	1099.646	-1.60%	-4.00%			



HUR-13-0-00

MODEL: PGL SHEET 5 PAPER SIZE: 34x22 (in.) DATE: 1/10/2024 TIME: 5:55:52 PM USER: ksabay  
pw:\01chodot-pw.bentley.com\ohodot-pw-02\Documents\01 Active Projects\District 03\Huron\101386\400-Engineering\Roadway\Sheets\101386\_GF001.dgn

LEFT SIDE										CENTERLINE										RIGHT SIDE														
ELEVATION					WIDTH (FT)					STATION					PROFILE GRADE					ELEVATION					CROSS SLOPE					WIDTH (FT)				
EP.	EPS.	LANE	SH.	ROTATION	LANE	SH.	LANE	SH.	ROTATION	STATION	PROFILE GRADE	EP.	EPS.	LANE	SH.	ROTATION	LANE	SH.	ROTATION	STATION	PROFILE GRADE	EP.	EPS.	LANE	SH.	ROTATION	LANE	SH.						
1093.739	1093.659	1.60%	4.00%	CROWN	12	2	100+25.00	1093.931	1093.739	1093.659	1093.931	1093.739	1093.659	-1.60%	-4.00%	CROWN	12	2	CROWN	100+25.00	1093.931	1093.739	1093.659	-1.60%	-4.00%	CROWN	12	2						
1093.317	1093.237	1.60%	4.00%	CROWN	12	2	100+50.00	1093.509	1093.317	1093.237	1093.509	1093.317	1093.237	-1.60%	-4.00%	CROWN	12	2	CROWN	100+50.00	1093.509	1093.317	1093.237	-1.60%	-4.00%	CROWN	12	2						
1092.918	1092.838	1.60%	4.00%	CROWN	12	2	100+75.00	1093.110	1092.918	1092.838	1093.110	1092.918	1092.838	-1.60%	-4.00%	CROWN	12	2	CROWN	100+75.00	1093.110	1092.918	1092.838	-1.60%	-4.00%	CROWN	12	2						
1092.493	1092.413	1.60%	4.00%	CROWN	12	2	101+00.00	1092.685	1092.493	1092.413	1092.685	1092.493	1092.413	-1.60%	-4.00%	CROWN	12	2	CROWN	101+00.00	1092.685	1092.493	1092.413	-1.60%	-4.00%	CROWN	12	2						
1092.126	1092.046	1.60%	4.00%	CROWN	12	2	101+25.00	1092.318	1092.126	1092.046	1092.318	1092.126	1092.046	-1.60%	-4.00%	CROWN	12	2	CROWN	101+25.00	1092.318	1092.126	1092.046	-1.60%	-4.00%	CROWN	12	2						
1091.756	1091.676	1.60%	4.00%	CROWN	12	2	101+50.00	1091.948	1091.756	1091.676	1091.948	1091.756	1091.676	-1.60%	-4.00%	CROWN	12	2	CROWN	101+50.00	1091.948	1091.756	1091.676	-1.60%	-4.00%	CROWN	12	2						
1091.360	1091.280	1.60%	4.00%	CROWN	12	2	101+75.00	1091.552	1091.360	1091.280	1091.552	1091.360	1091.280	-1.60%	-4.00%	CROWN	12	2	CROWN	101+75.00	1091.552	1091.360	1091.280	-1.60%	-4.00%	CROWN	12	2						
1091.065	1090.985	1.60%	4.00%	CROWN	12	2	102+00.00	1091.257	1091.065	1090.985	1091.257	1091.065	1090.985	-1.60%	-4.00%	CROWN	12	2	CROWN	102+00.00	1091.257	1091.065	1090.985	-1.60%	-4.00%	CROWN	12	2						
1090.770	1090.690	1.60%	4.00%	CROWN	12	2	102+25.00	1090.962	1090.770	1090.690	1090.962	1090.770	1090.690	-1.60%	-4.00%	CROWN	12	2	CROWN	102+25.00	1090.962	1090.770	1090.690	-1.60%	-4.00%	CROWN	12	2						
1090.408	1090.328	1.60%	4.00%	CROWN	12	2	102+50.00	1090.267	1090.408	1090.328	1090.267	1090.408	1090.328	-1.60%	-4.00%	CROWN	12	2	CROWN	102+50.00	1090.267	1090.408	1090.328	-1.60%	-4.00%	CROWN	12	2						
1090.075	1089.995	1.60%	4.00%	CROWN	12	2	102+75.00	1089.845	1089.075	1089.995	1089.845	1089.075	1089.995	-1.60%	-4.00%	CROWN	12	2	CROWN	102+75.00	1089.845	1089.075	1089.995	-1.60%	-4.00%	CROWN	12	2						
1089.845	1089.765	1.60%	4.00%	CROWN	12	2	103+00.00	1089.037	1089.845	1089.765	1089.037	1089.845	1089.765	-1.60%	-4.00%	CROWN	12	2	CROWN	103+00.00	1089.037	1089.845	1089.765	-1.60%	-4.00%	CROWN	12	2						
1089.628	1089.548	1.60%	4.00%	CROWN	12	2	103+25.00	1088.820	1089.628	1089.548	1088.820	1089.628	1089.548	-1.60%	-4.00%	CROWN	12	2	CROWN	103+25.00	1088.820	1089.628	1089.548	-1.60%	-4.00%	CROWN	12	2						
1089.378	1089.298	1.60%	4.00%	CROWN	12	2	103+50.00	1088.570	1089.378	1089.298	1088.570	1089.378	1089.298	-1.60%	-4.00%	CROWN	12	2	CROWN	103+50.00	1088.570	1089.378	1089.298	-1.60%	-4.00%	CROWN	12	2						
1089.170	1089.090	1.60%	4.00%	CROWN	12	2	103+75.00	1088.362	1089.170	1089.090	1088.362	1089.170	1089.090	-1.60%	-4.00%	CROWN	12	2	CROWN	103+75.00	1088.362	1089.170	1089.090	-1.60%	-4.00%	CROWN	12	2						
1089.025	1088.945	1.60%	4.00%	CROWN	12	2	104+00.00	1088.217	1089.025	1088.945	1088.217	1089.025	1088.945	-1.60%	-4.00%	CROWN	12	2	CROWN	104+00.00	1088.217	1089.025	1088.945	-1.60%	-4.00%	CROWN	12	2						
1088.891	1088.811	1.60%	4.00%	CROWN	12	2	104+25.00	1088.063	1088.891	1088.811	1088.063	1088.891	1088.811	-1.60%	-4.00%	CROWN	12	2	CROWN	104+25.00	1088.063	1088.891	1088.811	-1.60%	-4.00%	CROWN	12	2						
1088.732	1088.652	1.60%	4.00%	CROWN	12	2	104+50.00	1088.924	1088.732	1088.652	1088.924	1088.732	1088.652	-1.60%	-4.00%	CROWN	12	2	CROWN	104+50.00	1088.924	1088.732	1088.652	-1.60%	-4.00%	CROWN	12	2						
1088.568	1088.488	1.60%	4.00%	CROWN	12	2	104+75.00	1088.760	1088.568	1088.488	1088.760	1088.568	1088.488	-1.60%	-4.00%	CROWN	12	2	CROWN	104+75.00	1088.760	1088.568	1088.488	-1.60%	-4.00%	CROWN	12	2						
1088.400	1088.320	1.60%	4.00%	CROWN	12	2	105+00.00	1088.592	1088.400	1088.320	1088.592	1088.400	1088.320	-1.60%	-4.00%	CROWN	12	2	CROWN	105+00.00	1088.592	1088.400	1088.320	-1.60%	-4.00%	CROWN	12	2						
1088.157	1088.077	1.60%	4.00%	CROWN	12	2	105+25.00	1088.349	1088.157	1088.077	1088.349	1088.157	1088.077	-1.60%	-4.00%	CROWN	12	2	CROWN	105+25.00	1088.349	1088.157	1088.077	-1.60%	-4.00%	CROWN	12	2						
1087.905	1087.825	1.60%	4.00%	CROWN	12	2	105+50.00	1088.097	1087.905	1087.825	1088.097	1087.905	1087.825	-1.60%	-4.00%	CROWN	12	2	CROWN	105+50.00	1088.097	1087.905	1087.825	-1.60%	-4.00%	CROWN	12	2						
1087.691	1087.611	1.60%	4.00%	CROWN	12	2	105+75.00	1087.883	1087.691	1087.611	1087.883	1087.691	1087.611	-1.60%	-4.00%	CROWN	12	2	CROWN	105+75.00	1087.883	1087.691	1087.611	-1.60%	-4.00%	CROWN	12	2						
1087.471	1087.391	1.60%	4.00%	CROWN	12	2	106+00.00	1087.663	1087.471	1087.391	1087.663	1087.471	1087.391	-1.60%	-4.00%	CROWN	12	2	CROWN	106+00.00	1087.663	1087.471	1087.391	-1.60%	-4.00%	CROWN	12	2						
1087.304	1087.224	1.60%	4.00%	CROWN	12	2	106+25.00	1087.496	1087.304	1087.224	1087.496	1087.304	1087.224	-1.60%	-4.00%	CROWN	12	2	CROWN	106+25.00	1087.496	1087.304	1087.224	-1.60%	-4.00%	CROWN	12	2						
1087.174	1087.094	1.60%	4.00%	CROWN	12	2	106+50.00	1087.366	1087.174	1087.094	1087.366	1087.174	1087.094	-1.60%	-4.00%	CROWN	12	2	CROWN	106+50.00	1087.366	1087.174	1087.094	-1.60%	-4.00%	CROWN	12	2						
1087.053	1086.973	1.60%	4.00%	CROWN	12	2	106+75.00	1087.245	1087.053	1086.973	1087.245	1087.053	1086.973	-1.60%	-4.00%	CROWN	12	2	CROWN	106+75.00	1087.245	1087.053	1086.973	-1.60%	-4.00%	CROWN	12	2						
1086.938	1086.858	1.60%	4.00%	CROWN	12	2	107+00.00	1087.130	1086.938	1086.858	1087.130	1086.938	1086.858	-1.60%	-4.00%	CROWN	12	2	CROWN	107+00.00	1087.130	1086.938	1086.858	-1.60%	-4.00%	CROWN	12	2						
1086.823	1086.743	1.60%	4.00%	CROWN	12	2	107+25.00	1087.015	1086.823	1086.743	1087.015	1086.823	1086.743	-1.60%	-4.00%	CROWN	12	2	CROWN	107+25.00	1087.015	1086.823	1086.743	-1.60%	-4.00%	CROWN	12	2						
1086.759	1086.679	1.60%	4.00%	CROWN	12	2	107+50.00	1086.951	1086.759	1086.679	1086.951	1086.759	1086.679	-1.60%	-4.00%	CROWN	12	2	CROWN	107+50.00	1086.951	1086.759	1086.679	-1.60%	-4.00%	CROWN	12	2						
1086.731	1086.651	1.60%	4.00%	CROWN	12	2	107+75.00	1086.923	1086.731	1086.651	1086.923	1086.731	1086.651	-1.60%	-4.00%	CROWN	12	2	CROWN	107+75.00	1086.923	1086.731	1086.651	-1.60%	-4.00%	CROWN	12	2						
1086.663	1086.583	1.60%	4.00%	CROWN	12	2	108+00.00	1086.855	1086.663	1086.583	1086.855	1086.663	1086.583	-1.60%	-4.00%	CROWN	12	2	CROWN	108+00.00	1086.855	1086.663	1086.583	-1.60%	-4.00%	CROWN	12	2						
1086.630	1086.550	1.60%	4.00%	CROWN	12	2	108+25.00	1086.822	1086.630	1086.550	1086.822	1086.630	1086.550	-1.60%	-4.00%	CROWN	12	2	CROWN	108+25.00	1086.822	1086.630	1086.550	-1.60%	-4.00%	CROWN	12	2						
1086.567	1086.487	1.60%	4.00%	CROWN	12	2	108+50.00	1086.759	1086.567	1086.487	1086.759	1086.567	1086.487	-1.60%	-4.00%	CROWN	12	2	CROWN	108+50.00	1086.759	1086.567	1086.487	-1.60%	-4.00%	CROWN	12	2						
1086.476	1086.396	1.60%	4.00%	CROWN	12	2	108+75.00	1086.688	1086.476	1086.396	1086.688	1086.476	1086.396	-1.60%	-4.00%	CROWN	12	2	CROWN	108+75.00	1086.688	1086.476	1086.396	-1.60%	-4.00%	CROWN	12	2						
1086.364	1086.284	1.60%	4.00%	CROWN	12	2	109+00.00	1086.556	1086.364	1086.284	1086.556	1086.364	1086.284	-1.60%	-4.00%	CROWN	12	2	CROWN	109+00.00	1086.556	1086.364	1086.284	-1.60%	-4.00%	CROWN	12	2						
1086.211	1086.131	1.60%	4.00%	CROWN	12	2	109+25.00	1086.403	1086.211	1086.131	1086.403	1086.211	1086.131	-1.60%	-4.00%	CROWN	12	2	CROWN	109+25.00	1086.403	1086.211	1086.131	-1.60%	-4.00%	CROWN	12	2						
1086.050	1085.970	1.60%	4.00%	CROWN	12	2	109+50.00	1086.242	1086.050	1085.970	1086.242	1086.050	1085.970	-1.60%	-4.00%	CROWN	12	2	CROWN	109+50.00	1086.242	1086.050	1085.970	-1.60%	-4.00%	CROWN	12	2						
1085.865	1085.785	1.60%	4.00%	CROWN	12	2	109+75.00	1086.057	1085.865	1085.785	1086.057	1085.865	1085.785	-1.60%	-4.00%	CROWN	12	2	CROWN	109+75.00	1086.057	1085.865	1085.785	-1.60%	-4.00%	CROWN	12	2						
1085.736	1085.656	1.60%	4.00%	CROWN	12	2	110+00.00	1085.928	1085.736	1085.656	1085.928	1085.736	1085.656	-1.60%	-4.00%	CROWN	12	2	CROWN	110+00.00	1085.928	1085.736	1085.656	-1.60%	-4.00%	CROWN	12	2						
1085.581	1085.501	1.60%	4.00%	CROWN	12	2																												



HUR-13-0.00

MODEL: PGL SHEET 6 PAPER SIZE: 34x22 (in.) DATE: 1/10/2024 TIME: 5:56:30 PM USER: ksalay  
pw:\01h0dot-pw\_bentley.com\ohdot-pw-02\Documents\01\_Active Projects\District 03\Huron\101386\400-Engineering\Roadway\Sheets\101386\_GF001.dgn

ELEVATION				LEFT SIDE				CENTERLINE				RIGHT SIDE					
EP.	EPS.	LANE	SH.	LANE	SH.	STATION	PROF. GRADE	EP.	EPS.	LANE	SH.	LANE	SH.	ROTATION	LANE	SH.	WIDTH (FT)
1074.906	1074.826	1.60%	4.00%	1.60%	2	125+25.00	1075.098	1074.906	1074.826	-1.60%	2	-1.60%	2	CROWN	12	2	2
1074.428	1074.348	1.60%	4.00%	1.60%	2	125+50.00	1074.620	1074.428	1074.348	-1.60%	2	-1.60%	2	CROWN	12	2	2
1073.925	1073.845	1.60%	4.00%	1.60%	2	125+75.00	1074.117	1073.925	1073.845	-1.60%	2	-1.60%	2	CROWN	12	2	2
1073.490	1073.410	1.60%	4.00%	1.60%	2	126+00.00	1073.682	1073.490	1073.410	-1.60%	2	-1.60%	2	CROWN	12	2	2
1073.053	1072.973	1.60%	4.00%	1.60%	2	126+25.00	1073.245	1073.053	1072.973	-1.60%	2	-1.60%	2	CROWN	12	2	2
1072.617	1072.537	1.60%	4.00%	1.60%	2	126+50.00	1072.809	1072.617	1072.537	-1.60%	2	-1.60%	2	CROWN	12	2	2
1072.176	1072.096	1.60%	4.00%	1.60%	2	126+75.00	1072.368	1072.176	1072.096	-1.60%	2	-1.60%	2	CROWN	12	2	2
1071.740	1071.688	1.60%	4.00%	1.60%	2	127+00.00	1071.960	1071.740	1071.688	-1.60%	2	-1.60%	2	CROWN	12	2	2
1063.800	1064.021	1.60%	4.00%	1.60%	2	131+75.00	1064.293	1064.101	1064.021	-1.60%	2	-1.60%	2	CROWN	12	2	2
1063.360	1063.741	1.60%	4.00%	1.60%	2	132+00.00	1064.013	1063.821	1063.741	-1.60%	2	-1.60%	2	CROWN	12	2	2
1062.920	1063.432	1.60%	4.00%	1.60%	2	132+25.00	1063.704	1063.512	1063.432	-1.60%	2	-1.60%	2	CROWN	12	2	2
1062.480	1063.159	1.60%	4.00%	1.60%	2	132+50.00	1063.431	1063.239	1063.159	-1.60%	2	-1.60%	2	CROWN	12	2	2
1062.040	1062.928	1.60%	4.00%	1.60%	2	132+75.00	1063.200	1063.008	1062.928	-1.60%	2	-1.60%	2	CROWN	12	2	2
1061.600	1062.665	1.60%	4.00%	1.60%	2	133+00.00	1062.937	1062.745	1062.665	-1.60%	2	-1.60%	2	CROWN	12	2	2
1061.160	1062.337	1.60%	4.00%	1.60%	2	133+25.00	1062.609	1062.417	1062.337	-1.60%	2	-1.60%	2	CROWN	12	2	2
1060.720	1062.028	1.60%	4.00%	1.60%	2	133+50.00	1062.300	1062.108	1062.028	-1.60%	2	-1.60%	2	CROWN	12	2	2
1060.280	1061.724	1.60%	4.00%	1.60%	2	133+75.00	1061.996	1061.804	1061.724	-1.60%	2	-1.60%	2	CROWN	12	2	2
1059.840	1061.460	1.60%	4.00%	1.60%	2	134+00.00	1061.732	1061.540	1061.460	-1.60%	2	-1.60%	2	CROWN	12	2	2
1059.400	1061.234	1.60%	4.00%	1.60%	2	134+25.00	1061.506	1061.314	1061.234	-1.60%	2	-1.60%	2	CROWN	12	2	2
1058.960	1061.068	1.60%	4.00%	1.60%	2	134+50.00	1061.340	1061.148	1061.068	-1.60%	2	-1.60%	2	CROWN	12	2	2
1058.520	1060.932	1.60%	4.00%	1.60%	2	134+75.00	1061.204	1061.012	1060.932	-1.60%	2	-1.60%	2	CROWN	12	2	2
1058.080	1060.777	1.60%	4.00%	1.60%	2	135+00.00	1061.049	1060.857	1060.777	-1.60%	2	-1.60%	2	CROWN	12	2	2
1057.640	1060.540	1.60%	4.00%	1.60%	2	135+25.00	1060.812	1060.620	1060.540	-1.60%	2	-1.60%	2	CROWN	12	2	2
1057.200	1060.336	1.60%	4.00%	1.60%	2	135+50.00	1060.608	1060.416	1060.336	-1.60%	2	-1.60%	2	CROWN	12	2	2
1056.760	1060.108	1.60%	4.00%	1.60%	2	135+75.00	1060.380	1060.188	1060.108	-1.60%	2	-1.60%	2	CROWN	12	2	2
1056.320	1059.879	1.60%	4.00%	1.60%	2	136+00.00	1060.151	1059.959	1059.879	-1.60%	2	-1.60%	2	CROWN	12	2	2
1055.880	1059.688	1.60%	4.00%	1.60%	2	136+25.00	1059.960	1059.768	1059.688	-1.60%	2	-1.60%	2	CROWN	12	2	2
1055.440	1059.490	1.60%	4.00%	1.60%	2	136+50.00	1059.762	1059.570	1059.490	-1.60%	2	-1.60%	2	CROWN	12	2	2
1055.000	1059.478	1.60%	4.00%	1.60%	2	136+75.00	1059.750	1059.558	1059.478	-1.60%	2	-1.60%	2	CROWN	12	2	2
1054.560	1059.458	1.60%	4.00%	1.60%	2	137+00.00	1059.730	1059.538	1059.458	-1.60%	2	-1.60%	2	CROWN	12	2	2
1054.120	1059.488	1.60%	4.00%	1.60%	2	137+25.00	1059.760	1059.568	1059.488	-1.60%	2	-1.60%	2	CROWN	12	2	2
1053.680	1059.530	1.60%	4.00%	1.60%	2	137+50.00	1059.802	1059.610	1059.530	-1.60%	2	-1.60%	2	CROWN	12	2	2
1053.240	1059.788	1.60%	4.00%	1.60%	2	137+75.00	1060.060	1059.868	1059.788	-1.60%	2	-1.60%	2	CROWN	12	2	2
1052.800	1059.416	1.60%	4.00%	1.60%	2	138+00.00	1059.688	1059.496	1059.416	-1.60%	2	-1.60%	2	CROWN	12	2	2
1052.360	1058.765	1.60%	4.00%	1.60%	2	138+25.00	1059.037	1058.845	1058.765	-1.60%	2	-1.60%	2	CROWN	12	2	2
1051.920	1058.184	1.60%	4.00%	1.60%	2	138+50.00	1058.456	1058.264	1058.184	-1.60%	2	-1.60%	2	CROWN	12	2	2
1051.480	1057.671	1.60%	4.00%	1.60%	2	138+75.00	1057.943	1057.751	1057.671	-1.60%	2	-1.60%	2	CROWN	12	2	2
1051.040	1057.303	1.60%	4.00%	1.60%	2	139+00.00	1057.575	1057.383	1057.303	-1.60%	2	-1.60%	2	CROWN	12	2	2
1050.600	1056.976	1.60%	4.00%	1.60%	2	139+25.00	1057.248	1057.056	1056.976	-1.60%	2	-1.60%	2	CROWN	12	2	2
1050.160	1056.770	1.60%	4.00%	1.60%	2	139+50.00	1057.042	1056.850	1056.770	-1.60%	2	-1.60%	2	CROWN	12	2	2
1049.720	1056.686	1.60%	4.00%	1.60%	2	139+75.00	1056.958	1056.766	1056.686	-1.60%	2	-1.60%	2	CROWN	12	2	2
1049.280	1056.585	1.60%	4.00%	1.60%	2	140+00.00	1056.857	1056.665	1056.585	-1.60%	2	-1.60%	2	CROWN	12	2	2
1048.840	1056.514	1.60%	4.00%	1.60%	2	140+25.00	1056.786	1056.594	1056.514	-1.60%	2	-1.60%	2	CROWN	12	2	2
1048.400	1056.490	1.60%	4.00%	1.60%	2	140+50.00	1056.762	1056.570	1056.490	-1.60%	2	-1.60%	2	CROWN	12	2	2
1047.960	1056.473	1.60%	4.00%	1.60%	2	140+75.00	1056.745	1056.553	1056.473	-1.60%	2	-1.60%	2	CROWN	12	2	2
1047.520	1056.440	1.60%	4.00%	1.60%	2	141+00.00	1056.712	1056.520	1056.440	-1.60%	2	-1.60%	2	CROWN	12	2	2
1047.080	1056.373	1.60%	4.00%	1.60%	2	141+25.00	1056.645	1056.453	1056.373	-1.60%	2	-1.60%	2	CROWN	12	2	2
1046.640	1056.307	1.60%	4.00%	1.60%	2	141+50.00	1056.579	1056.387	1056.307	-1.60%	2	-1.60%	2	CROWN	12	2	2
1046.200	1056.306	1.60%	4.00%	1.60%	2	141+75.00	1056.578	1056.386	1056.306	-1.60%	2	-1.60%	2	CROWN	12	2	2
1045.760	1056.256	1.60%	4.00%	1.60%	2	142+00.00	1056.528	1056.336	1056.256	-1.60%	2	-1.60%	2	CROWN	12	2	2
1045.320	1056.282	1.60%	4.00%	1.60%	2	142+25.00	1056.554	1056.362	1056.282	-1.60%	2	-1.60%	2	CROWN	12	2	2
1044.880	1056.310	1.60%	4.00%	1.60%	2	142+50.00	1056.582	1056.390	1056.310	-1.60%	2	-1.60%	2	CROWN	12	2	2
1044.440	1056.297	1.60%	4.00%	1.60%	2	142+75.00	10										



**HUR-13-0.00**

MODEL: PGL SHEET 7 PAPER SIZE: 34x22 (in.) DATE: 1/10/2024 TIME: 5:57:00 PM USER: ksabay  
 pw:\01h0dot-pw\_bentley.com\ohdotot-pw-02\Documents\01\_Active Projects\District 03\Huron\101386\400-Engineering\Roadway\Sheets\101386\_GF001.dgn

ELEVATION				WIDTH (FT)				CENTERLINE				ELEVATION				RIGHT SIDE								
LEFT SIDE		RIGHT SIDE		LEFT SIDE		RIGHT SIDE		LEFT SIDE		RIGHT SIDE		LEFT SIDE		RIGHT SIDE		LEFT SIDE		RIGHT SIDE						
EP.	EPS.	LANE	SH.	ROTATION	LANE	SH.	STATION	PROG. ELEV.	EP.	EPS.	LANE	SH.	ROTATION	LANE	SH.	STATION	PROG. ELEV.	EP.	EPS.	LANE	SH.	ROTATION	LANE	SH.



HUR-13-0-00

MODEL: PGL SHEET 8 PAPER SIZE: 34x22 (in.) DATE: 1/10/2024 TIME: 5:57:39 PM USER: ksalay  
pw:\ohiodot-pw\_bentley.com\ohiodot-pw-02\Documents\01\_Active Projects\District 03\Huron\101386\400-Engineering\Roadway\Sheets\101386\_GF001.dgn

LEFT SIDE										CENTERLINE										RIGHT SIDE										
ELEVATION					WIDTH (FT)					STATION					PROFILE GRADE					ELEVATION					CROSS SLOPE					
EP.	EPS.	LANE	SH.	ROTATION	LANE	SH.	LANE	SH.	ROTATION	LANE	SH.	EP.	EPS.	LANE	SH.	ROTATION	LANE	SH.	ROTATION	LANE	SH.	EP.	EPS.	LANE	SH.	ROTATION	LANE	SH.		
1035.912	10																													



**HUR-13-0.00**

MODEL: PGL SHEET 9 PAPER SIZE: 34x22 (in.) DATE: 1/10/2024 TIME: 5:58:08 PM USER: ksalay  
 pw:\01chodot-pw.bentley.com\ohodot-pw-02\Documents\01 Active Projects\District 03\Huron\101386\400-Engineering\Roadway\Sheets\101386\_GF001.dgn

LEFT SIDE										CENTERLINE										RIGHT SIDE														
ELEVATION					WIDTH (FT)					STATION					PROFILE GRADE					ELEVATION					CROSS SLOPE					WIDTH (FT)				
EP.	EPS.	LANE	SH.	ROTATION	LANE	SH.	LANE	SH.	ROTATION	STATION	PROFILE GRADE	EP.	EPS.	LANE	SH.	ROTATION	LANE	SH.	ROTATION	STATION	PROFILE GRADE	EP.	EPS.	LANE	SH.	ROTATION	LANE	SH.						
1026.141	1026.061	1.60%	4.00%	CROWN	12	2	200+25.00	1026.333	1026.061	200+25.00	1026.333	1026.141	1026.061	-1.60%	-4.00%	CROWN	12	2	CROWN	12	2	1026.141	1026.061	-1.60%	-4.00%	CROWN	12	2						
1026.027	1026.947	1.60%	4.00%	CROWN	12	2	200+50.00	1026.219	1026.947	200+50.00	1026.219	1026.027	1026.947	-1.60%	-4.00%	CROWN	12	2	CROWN	12	2	1026.027	1026.947	-1.60%	-4.00%	CROWN	12	2						
1025.918	1025.838	1.60%	4.00%	CROWN	12	2	200+75.00	1026.110	1025.838	200+75.00	1026.110	1025.918	1025.838	-1.60%	-4.00%	CROWN	12	2	CROWN	12	2	1025.918	1025.838	-1.60%	-4.00%	CROWN	12	2						
1025.745	1025.665	1.60%	4.00%	CROWN	12	2	201+00.00	1025.937	1025.665	201+00.00	1025.937	1025.745	1025.665	-1.60%	-4.00%	CROWN	12	2	CROWN	12	2	1025.745	1025.665	-1.60%	-4.00%	CROWN	12	2						
1025.509	1025.429	1.60%	4.00%	CROWN	12	2	201+25.00	1025.701	1025.429	201+25.00	1025.701	1025.509	1025.429	-1.60%	-4.00%	CROWN	12	2	CROWN	12	2	1025.509	1025.429	-1.60%	-4.00%	CROWN	12	2						
1025.318	1025.238	1.60%	4.00%	CROWN	12	2	201+50.00	1025.510	1025.238	201+50.00	1025.510	1025.318	1025.238	-1.60%	-4.00%	CROWN	12	2	CROWN	12	2	1025.318	1025.238	-1.60%	-4.00%	CROWN	12	2						
1025.105	1025.025	1.60%	4.00%	CROWN	12	2	201+75.00	1025.297	1025.025	201+75.00	1025.297	1025.105	1025.025	-1.60%	-4.00%	CROWN	12	2	CROWN	12	2	1025.105	1025.025	-1.60%	-4.00%	CROWN	12	2						
1024.891	1024.811	1.60%	4.00%	CROWN	12	2	202+00.00	1025.083	1024.811	202+00.00	1025.083	1024.891	1024.811	-1.60%	-4.00%	CROWN	12	2	CROWN	12	2	1024.891	1024.811	-1.60%	-4.00%	CROWN	12	2						
1024.742	1024.662	1.60%	4.00%	CROWN	12	2	202+25.00	1024.934	1024.662	202+25.00	1024.934	1024.742	1024.662	-1.60%	-4.00%	CROWN	12	2	CROWN	12	2	1024.742	1024.662	-1.60%	-4.00%	CROWN	12	2						
1024.581	1024.501	1.60%	4.00%	CROWN	12	2	202+50.00	1024.773	1024.501	202+50.00	1024.773	1024.581	1024.501	-1.60%	-4.00%	CROWN	12	2	CROWN	12	2	1024.581	1024.501	-1.60%	-4.00%	CROWN	12	2						
1024.391	1024.311	1.60%	4.00%	CROWN	12	2	202+75.00	1024.583	1024.311	202+75.00	1024.583	1024.391	1024.311	-1.60%	-4.00%	CROWN	12	2	CROWN	12	2	1024.391	1024.311	-1.60%	-4.00%	CROWN	12	2						
1024.138	1024.058	1.60%	4.00%	CROWN	12	2	203+00.00	1024.330	1024.058	203+00.00	1024.330	1024.138	1024.058	-1.60%	-4.00%	CROWN	12	2	CROWN	12	2	1024.138	1024.058	-1.60%	-4.00%	CROWN	12	2						
1023.948	1023.868	1.60%	4.00%	CROWN	12	2	203+25.00	1024.140	1023.868	203+25.00	1024.140	1023.948	1023.868	-1.60%	-4.00%	CROWN	12	2	CROWN	12	2	1023.948	1023.868	-1.60%	-4.00%	CROWN	12	2						
1023.767	1023.687	1.60%	4.00%	CROWN	12	2	203+50.00	1024.059	1023.687	203+50.00	1024.059	1023.767	1023.687	-1.60%	-4.00%	CROWN	12	2	CROWN	12	2	1023.767	1023.687	-1.60%	-4.00%	CROWN	12	2						
1023.578	1023.498	1.60%	4.00%	CROWN	12	2	203+75.00	1023.907	1023.498	203+75.00	1023.907	1023.578	1023.498	-1.60%	-4.00%	CROWN	12	2	CROWN	12	2	1023.578	1023.498	-1.60%	-4.00%	CROWN	12	2						
1023.461	1023.381	1.60%	4.00%	CROWN	12	2	204+00.00	1023.770	1023.381	204+00.00	1023.770	1023.461	1023.381	-1.60%	-4.00%	CROWN	12	2	CROWN	12	2	1023.461	1023.381	-1.60%	-4.00%	CROWN	12	2						
1023.337	1023.257	1.60%	4.00%	CROWN	12	2	204+25.00	1023.653	1023.257	204+25.00	1023.653	1023.337	1023.257	-1.60%	-4.00%	CROWN	12	2	CROWN	12	2	1023.337	1023.257	-1.60%	-4.00%	CROWN	12	2						
1023.228	1023.148	1.60%	4.00%	CROWN	12	2	204+50.00	1023.529	1023.148	204+50.00	1023.529	1023.228	1023.148	-1.60%	-4.00%	CROWN	12	2	CROWN	12	2	1023.228	1023.148	-1.60%	-4.00%	CROWN	12	2						
1023.106	1023.026	1.60%	4.00%	CROWN	12	2	204+75.00	1023.420	1023.026	204+75.00	1023.420	1023.106	1023.026	-1.60%	-4.00%	CROWN	12	2	CROWN	12	2	1023.106	1023.026	-1.60%	-4.00%	CROWN	12	2						
1022.980	1022.900	1.60%	4.00%	CROWN	12	2	205+00.00	1023.298	1022.900	205+00.00	1023.298	1022.980	1022.900	-1.60%	-4.00%	CROWN	12	2	CROWN	12	2	1022.980	1022.900	-1.60%	-4.00%	CROWN	12	2						
1022.774	1022.694	1.60%	4.00%	CROWN	12	2	205+25.00	1023.172	1022.694	205+25.00	1023.172	1022.774	1022.694	-1.60%	-4.00%	CROWN	12	2	CROWN	12	2	1022.774	1022.694	-1.60%	-4.00%	CROWN	12	2						
1022.568	1022.488	1.60%	4.00%	CROWN	12	2	205+50.00	1022.966	1022.488	205+50.00	1022.966	1022.568	1022.488	-1.60%	-4.00%	CROWN	12	2	CROWN	12	2	1022.568	1022.488	-1.60%	-4.00%	CROWN	12	2						
1022.350	1022.270	1.60%	4.00%	CROWN	12	2	206+00.00	1022.842	1022.270	206+00.00	1022.842	1022.350	1022.270	-1.60%	-4.00%	CROWN	12	2	CROWN	12	2	1022.350	1022.270	-1.60%	-4.00%	CROWN	12	2						
1022.162	1022.082	1.60%	4.00%	CROWN	12	2	206+25.00	1022.716	1022.082	206+25.00	1022.716	1022.162	1022.082	-1.60%	-4.00%	CROWN	12	2	CROWN	12	2	1022.162	1022.082	-1.60%	-4.00%	CROWN	12	2						
1022.043	1021.963	1.60%	4.00%	CROWN	12	2	206+50.00	1022.595	1021.963	206+50.00	1022.595	1022.043	1021.963	-1.60%	-4.00%	CROWN	12	2	CROWN	12	2	1022.043	1021.963	-1.60%	-4.00%	CROWN	12	2						
1021.915	1021.835	1.60%	4.00%	CROWN	12	2	206+75.00	1022.470	1021.835	206+75.00	1022.470	1021.915	1021.835	-1.60%	-4.00%	CROWN	12	2	CROWN	12	2	1021.915	1021.835	-1.60%	-4.00%	CROWN	12	2						
1021.788	1021.708	1.60%	4.00%	CROWN	12	2	207+00.00	1022.344	1021.708	207+00.00	1022.344	1021.788	1021.708	-1.60%	-4.00%	CROWN	12	2	CROWN	12	2	1021.788	1021.708	-1.60%	-4.00%	CROWN	12	2						
1021.667	1021.587	1.60%	4.00%	CROWN	12	2	207+25.00	1022.218	1021.587	207+25.00	1022.218	1021.667	1021.587	-1.60%	-4.00%	CROWN	12	2	CROWN	12	2	1021.667	1021.587	-1.60%	-4.00%	CROWN	12	2						
1021.551	1021.471	1.60%	4.00%	CROWN	12	2	207+50.00	1022.092	1021.471	207+50.00	1022.092	1021.551	1021.471	-1.60%	-4.00%	CROWN	12	2	CROWN	12	2	1021.551	1021.471	-1.60%	-4.00%	CROWN	12	2						
1021.404	1021.324	1.60%	4.00%	CROWN	12	2	207+75.00	1021.966	1021.324	207+75.00	1021.966	1021.404	1021.324	-1.60%	-4.00%	CROWN	12	2	CROWN	12	2	1021.404	1021.324	-1.60%	-4.00%	CROWN	12	2						
1021.232	1021.152	1.60%	4.00%	CROWN	12	2	208+00.00	1021.840	1021.152	208+00.00	1021.840	1021.232	1021.152	-1.60%	-4.00%	CROWN	12	2	CROWN	12	2	1021.232	1021.152	-1.60%	-4.00%	CROWN	12	2						
1021.048	1020.968	1.60%	4.00%	CROWN	12	2	208+25.00	1021.714	1020.968	208+25.00	1021.714	1021.048	1020.968	-1.60%	-4.00%	CROWN	12	2	CROWN	12	2	1021.048	1020.968	-1.60%	-4.00%	CROWN	12	2						
1020.914	1020.834	1.60%	4.00%	CROWN	12	2	208+50.00	1021.588	1020.834	208+50.00	1021.588	1020.914	1020.834	-1.60%	-4.00%	CROWN	12	2	CROWN	12	2	1020.914	1020.834	-1.60%	-4.00%	CROWN	12	2						
1020.820	1020.740	1.60%	4.00%	CROWN	12	2	208+75.00	1021.462	1020.740	208+75.00	1021.462	1020.820	1020.740	-1.60%	-4.00%	CROWN	12	2	CROWN	12	2	1020.820	1020.740	-1.60%	-4.00%	CROWN	12	2						
1020.772	1020.692	1.60%	4.00%	CROWN	12	2	209+00.00	1021.336	1020.692	209+00.00	1021.336	1020.772	1020.692	-1.60%	-4.00%	CROWN	12	2	CROWN	12	2	1020.772	1020.692	-1.60%	-4.00%	CROWN	12	2						
1020.710	1020.630	1.60%	4.00%	CROWN	12	2	209+25.00	1021.210	1020.630	209+25.00	1021.210	1020.710	1020.630	-1.60%	-4.00%	CROWN	12	2	CROWN	12	2	1020.710	1020.630	-1.60%	-4.00%	CROWN	12	2						
1020.595	1020.515	1.60%	4.00%	CROWN	12	2	209+50.00	1021.084	1020.515	209+50.00	1021.084	1020.595	1020.515	-1.60%	-4.00%	CROWN	12	2	CROWN	12	2	1020.595	1020.515	-1.60%	-4.00%	CROWN	12	2						
1020.484	1020.404	1.60%	4.00%	CROWN	12	2	209+75.00	1020.958	1020.404	209+75.00	1020.958	1020.484	1020.404	-1.60%	-4.00%	CROWN	12	2	CROWN	12	2	1020.484	1020.404	-1.60%	-4.00%	CROWN	12	2						
1020.418	1020.338	1.60%	4.00%	CROWN	12	2	210+00.00	1020.832	1020.338	210+00.00	1020.832	1020.418	1020.338	-1.60%	-4.00%	CROWN	12	2	CROWN	12	2	1020.418	1020.338	-1.60%	-4.00%	CROWN	12	2						
1020.328	1020.248	1.60%	4.00%	CROWN	12	2	210+25.00	1020.706	1020.248	210+25.00	1020.706	1020.328	1020.248	-1.60%	-4.00%	CROWN	12	2	CROWN	12	2	1020.328	1020.248	-1.60%	-4.00%	CROWN	12	2						
1020.235	1020.155	1.60%	4.00%	CROWN	12	2	210+50.00	1020.580	1020.155	210+50.00	1020.580	1020.235	1020.155	-1.60%	-4.00%	CROWN	12	2	CROWN	12	2	1020.235	1020.155	-1.60%	-4.00%	CROWN	12	2						
1020.143	1020.063	1.60%	4.00%	CROWN	12	2	210+75.00	1020.454	1020.063	210+75.00	1020.454	1020.143	1020.063	-1.60%	-4.00%	CROWN	12	2	CROWN	12	2	1020.143	1020.063	-1.60%	-4.00%	CROWN	12	2						
1020.0																																		



HUR-13-0.00

MODEL: PGL SHEET 10 PAPER SIZE: 34x22 (in.) DATE: 1/10/2024 TIME: 5:38:43 PM USER: ksalay  
pw:\ahodot-pw.bentley.com\ohodot-pw-02\Documents\01 Active Projects\District 03\Huron\101386\400-Engineering\Roadway\Sheets\101386\_GF001.dgn

LEFT SIDE										CENTERLINE										RIGHT SIDE									
ELEVATION					WIDTH (FT)					STATION					PROFILE GRADE					ELEVATION					CROSS SLOPE				
EP.	EPS.	LANE	SH.	ROTATION	LANE	SH.	LANE	SH.	ROTATION	STATION	PROFILE GRADE	EP.	EPS.	LANE	SH.	ROTATION	LANE	SH.	ROTATION	STATION	PROFILE GRADE	EP.	EPS.	LANE	SH.	ROTATION	LANE	SH.	
1016.044	1015.964	1.60%	4.00%	CROWN	12	2	225+25.00	1016.236	1015.964	1015.964	1016.236	1016.044	1015.964	-1.60%	-4.00%	CROWN	12	2	225+25.00	1016.236	1015.964	1015.964	1016.044	1015.964	-1.60%	-4.00%	CROWN	12	2
1015.737	1015.657	1.60%	4.00%	CROWN	12	2	225+50.00	1015.929	1015.657	1015.657	1015.929	1015.737	1015.657	-1.60%	-4.00%	CROWN	12	2	225+50.00	1015.929	1015.657	1015.657	1015.737	1015.657	-1.60%	-4.00%	CROWN	12	2
1015.465	1015.385	1.60%	4.00%	CROWN	12	2	225+75.00	1015.657	1015.385	1015.385	1015.657	1015.465	1015.385	-1.60%	-4.00%	CROWN	12	2	225+75.00	1015.657	1015.385	1015.385	1015.465	1015.385	-1.60%	-4.00%	CROWN	12	2
1015.221	1015.141	1.60%	4.00%	CROWN	12	2	226+00.00	1015.413	1015.141	1015.141	1015.413	1015.221	1015.141	-1.60%	-4.00%	CROWN	12	2	226+00.00	1015.413	1015.141	1015.141	1015.221	1015.141	-1.60%	-4.00%	CROWN	12	2
1014.957	1014.877	1.60%	4.00%	CROWN	12	2	226+25.00	1015.149	1014.877	1014.877	1015.149	1014.957	1014.877	-1.60%	-4.00%	CROWN	12	2	226+25.00	1015.149	1014.877	1014.877	1014.957	1014.877	-1.60%	-4.00%	CROWN	12	2
1014.705	1014.625	1.60%	4.00%	CROWN	12	2	226+50.00	1014.897	1014.625	1014.625	1014.897	1014.705	1014.625	-1.60%	-4.00%	CROWN	12	2	226+50.00	1014.897	1014.625	1014.625	1014.705	1014.625	-1.60%	-4.00%	CROWN	12	2
1014.474	1014.394	1.60%	4.00%	CROWN	12	2	226+75.00	1014.666	1014.474	1014.474	1014.666	1014.474	1014.394	-1.60%	-4.00%	CROWN	12	2	226+75.00	1014.666	1014.474	1014.474	1014.394	1014.394	-1.60%	-4.00%	CROWN	12	2
1014.221	1014.141	1.60%	4.00%	CROWN	12	2	227+00.00	1014.413	1014.141	1014.141	1014.413	1014.221	1014.141	-1.60%	-4.00%	CROWN	12	2	227+00.00	1014.413	1014.141	1014.141	1014.221	1014.141	-1.60%	-4.00%	CROWN	12	2
1013.910	1013.830	1.60%	4.00%	CROWN	12	2	227+25.00	1014.102	1013.830	1013.830	1014.102	1013.910	1013.830	-1.60%	-4.00%	CROWN	12	2	227+25.00	1014.102	1013.830	1013.830	1013.910	1013.830	-1.60%	-4.00%	CROWN	12	2
1013.614	1013.534	1.60%	4.00%	CROWN	12	2	227+50.00	1013.806	1013.534	1013.534	1013.806	1013.614	1013.534	-1.60%	-4.00%	CROWN	12	2	227+50.00	1013.806	1013.534	1013.534	1013.614	1013.534	-1.60%	-4.00%	CROWN	12	2
1013.351	1013.271	1.60%	4.00%	CROWN	12	2	227+75.00	1013.543	1013.271	1013.271	1013.543	1013.351	1013.271	-1.60%	-4.00%	CROWN	12	2	227+75.00	1013.543	1013.271	1013.271	1013.351	1013.271	-1.60%	-4.00%	CROWN	12	2
1013.077	1012.997	1.60%	4.00%	CROWN	12	2	228+00.00	1013.269	1012.997	1012.997	1013.269	1013.077	1012.997	-1.60%	-4.00%	CROWN	12	2	228+00.00	1013.269	1012.997	1012.997	1013.077	1012.997	-1.60%	-4.00%	CROWN	12	2
1012.788	1012.708	1.60%	4.00%	CROWN	12	2	228+25.00	1012.980	1012.708	1012.708	1012.980	1012.788	1012.708	-1.60%	-4.00%	CROWN	12	2	228+25.00	1012.980	1012.708	1012.708	1012.788	1012.708	-1.60%	-4.00%	CROWN	12	2
1012.503	1012.423	1.60%	4.00%	CROWN	12	2	228+50.00	1012.695	1012.423	1012.423	1012.695	1012.503	1012.423	-1.60%	-4.00%	CROWN	12	2	228+50.00	1012.695	1012.423	1012.423	1012.503	1012.423	-1.60%	-4.00%	CROWN	12	2
1012.257	1012.177	1.60%	4.00%	CROWN	12	2	228+75.00	1012.449	1012.177	1012.177	1012.449	1012.257	1012.177	-1.60%	-4.00%	CROWN	12	2	228+75.00	1012.449	1012.177	1012.177	1012.257	1012.177	-1.60%	-4.00%	CROWN	12	2
1012.060	1011.980	1.60%	4.00%	CROWN	12	2	229+00.00	1012.252	1011.980	1011.980	1012.252	1012.060	1011.980	-1.60%	-4.00%	CROWN	12	2	229+00.00	1012.252	1011.980	1011.980	1012.060	1011.980	-1.60%	-4.00%	CROWN	12	2
1011.789	1011.709	1.60%	4.00%	CROWN	12	2	229+25.00	1011.981	1011.709	1011.709	1011.981	1011.789	1011.709	-1.60%	-4.00%	CROWN	12	2	229+25.00	1011.981	1011.709	1011.709	1011.789	1011.709	-1.60%	-4.00%	CROWN	12	2
1011.523	1011.443	1.60%	4.00%	CROWN	12	2	229+50.00	1011.715	1011.443	1011.443	1011.715	1011.523	1011.443	-1.60%	-4.00%	CROWN	12	2	229+50.00	1011.715	1011.443	1011.443	1011.523	1011.443	-1.60%	-4.00%	CROWN	12	2
1011.240	1011.160	1.60%	4.00%	CROWN	12	2	229+75.00	1011.432	1011.160	1011.160	1011.432	1011.240	1011.160	-1.60%	-4.00%	CROWN	12	2	229+75.00	1011.432	1011.160	1011.160	1011.240	1011.160	-1.60%	-4.00%	CROWN	12	2
1010.963	1010.883	1.60%	4.00%	CROWN	12	2	230+00.00	1011.155	1010.883	1010.883	1011.155	1010.963	1010.883	-1.60%	-4.00%	CROWN	12	2	230+00.00	1011.155	1010.883	1010.883	1010.963	1010.883	-1.60%	-4.00%	CROWN	12	2
1010.732	1010.652	1.60%	4.00%	CROWN	12	2	230+25.00	1010.924	1010.652	1010.652	1010.924	1010.732	1010.652	-1.60%	-4.00%	CROWN	12	2	230+25.00	1010.924	1010.652	1010.652	1010.732	1010.652	-1.60%	-4.00%	CROWN	12	2
1010.501	1010.421	1.60%	4.00%	CROWN	12	2	230+50.00	1010.693	1010.421	1010.421	1010.693	1010.501	1010.421	-1.60%	-4.00%	CROWN	12	2	230+50.00	1010.693	1010.421	1010.421	1010.501	1010.421	-1.60%	-4.00%	CROWN	12	2
1010.156	1010.076	1.60%	4.00%	CROWN	12	2	230+75.00	1010.348	1010.076	1010.076	1010.348	1010.156	1010.076	-1.60%	-4.00%	CROWN	12	2	230+75.00	1010.348	1010.076	1010.076	1010.156	1010.076	-1.60%	-4.00%	CROWN	12	2
1009.647	1009.567	1.60%	4.00%	CROWN	12	2	231+00.00	1009.839	1009.567	1009.567	1009.839	1009.647	1009.567	-1.60%	-4.00%	CROWN	12	2	231+00.00	1009.839	1009.567	1009.567	1009.647	1009.567	-1.60%	-4.00%	CROWN	12	2
1009.076	1008.996	1.60%	4.00%	CROWN	12	2	231+25.00	1009.268	1008.996	1008.996	1009.268	1009.076	1008.996	-1.60%	-4.00%	CROWN	12	2	231+25.00	1009.268	1008.996	1008.996	1009.076	1008.996	-1.60%	-4.00%	CROWN	12	2
1008.437	1008.357	1.60%	4.00%	CROWN	12	2	231+50.00	1008.629	1008.357	1008.357	1008.629	1008.437	1008.357	-1.60%	-4.00%	CROWN	12	2	231+50.00	1008.629	1008.357	1008.357	1008.437	1008.357	-1.60%	-4.00%	CROWN	12	2
1007.773	1007.693	1.60%	4.00%	CROWN	12	2	231+75.00	1007.965	1007.693	1007.693	1007.965	1007.773	1007.693	-1.60%	-4.00%	CROWN	12	2	231+75.00	1007.965	1007.693	1007.693	1007.773	1007.693	-1.60%	-4.00%	CROWN	12	2
1007.068	1006.988	1.60%	4.00%	CROWN	12	2	232+00.00	1007.260	1006.988	1006.988	1007.260	1007.068	1006.988	-1.60%	-4.00%	CROWN	12	2	232+00.00	1007.260	1006.988	1006.988	1007.068	1006.988	-1.60%	-4.00%	CROWN	12	2
1006.353	1006.273	1.60%	4.00%	CROWN	12	2	232+25.00	1006.545	1006.273	1006.273	1006.545	1006.353	1006.273	-1.60%	-4.00%	CROWN	12	2	232+25.00	1006.545	1006.273	1006.273	1006.353	1006.273	-1.60%	-4.00%	CROWN	12	2
1005.633	1005.553	1.60%	4.00%	CROWN	12	2	232+50.00	1005.825	1005.553	1005.553	1005.825	1005.633	1005.553	-1.60%	-4.00%	CROWN	12	2	232+50.00	1005.825	1005.553	1005.553	1005.633	1005.553	-1.60%	-4.00%	CROWN	12	2
1004.944	1004.864	1.60%	4.00%	CROWN	12	2	232+75.00	1005.136	1004.864	1004.864	1005.136	1004.944	1004.864	-1.60%	-4.00%	CROWN	12	2	232+75.00	1005.136	1004.864	1004.864	1004.944	1004.864	-1.60%	-4.00%	CROWN	12	2
1004.243	1004.163	1.60%	4.00%	CROWN	12	2	233+00.00	1004.435	1004.163	1004.163	1004.435	1004.243	1004.163	-1.60%	-4.00%	CROWN	12	2	233+00.00	1004.435	1004.163	1004.163	1004.243	1004.163	-1.60%	-4.00%	CROWN	12	2
1003.605	1003.525	1.60%	4.00%	CROWN	12	2	233+25.00	1003.797	1003.525	1003.525	1003.797	1003.605	1003.525	-1.60%	-4.00%	CROWN	12	2	233+25.00	1003.797	1003.525	1003.525	1003.605	1003.525	-1.60%	-4.00%	CROWN	12	2
1003.106	1003.026	1.60%	4.00%	CROWN	12	2	233+50.00	1003.298	1003.026	1003.026	1003.298	1003.106	1003.026	-1.60%	-4.00%	CROWN	12	2	233+50.00	1003.298	1003.026	1003.026	1003.106	1003.026	-1.60%	-4.00%	CROWN	12	2
1002.702	1002.622	1.60%	4.00%	CROWN	12	2	233+75.00	1002.894	1002.622	1002.622	1002.894	1002.702	1002.622	-1.60%	-4.00%	CROWN	12	2	233+75.00	1002.894	1002.622	1002.622	1002.702	1002.622	-1.60%	-4.00%	CROWN	12	2
1002.396	1002.316	1.60%	4.00%	CROWN	12	2	234+00.00	1002.588	1002.316	1002.316	1002.588	1002.396	1002.316	-1.60%	-4.00%	CROWN	12	2	234+00.00	1002.588	1002.316	1002.316	1002.396	1002.316	-1.60%	-4.00%	CROWN	12	2
1002.106	1002.026	1.60%	4.00%	CROWN	12	2	234+25.00	1002.298	1002.026	1002.026	1002.298	1002.106	1002.026	-1.60%	-4.00%	CROWN	12	2	234+25.00	1002.298	1002.026	1002.026	1002.106	1002.026	-1.60%	-4.00%	CROWN	12	2
1001.778	1001.698	1.60%	4.00%	CROWN	12	2	234+50.00	1001.970	1001.698	1001.698	1001.970	1001.778	1001.698	-1.60%	-4.00%	CROWN	12	2	234+50.00	100									



HUR-13-0.00

MODEL: PGL SHEET 11 PAPER SIZE: 34x22 (in.) DATE: 1/10/2024 TIME: 5:59:18 PM USER: ksalay  
pw:\ahidiot-pw.bentley.com\ohidiot-pw-02\Documents\01 Active Projects\District 03\Huron\101386\400-Engineering\Roadway\Sheets\101386\_GF001.dgn

ELEVATION				CENTERLINE				RIGHT SIDE								
ELEVATION		STATION		PROFILE GRADE		ELEVATION		CROSS SLOPE		ROTATION		LANE		WIDTH (FT)		
EP.	EPS.	LANE	SH.	ROTATION	LANE	SH.	EP.	EPS.	LANE	SH.	ROTATION	LANE	SH.	ROTATION	LANE	SH.
998.762	998.682	1.60%	2	CROWN	12	2	998.762	998.682	-1.60%	4.00%	CROWN	12	2	CROWN	12	2
998.618	998.538	1.60%	2	CROWN	12	2	998.618	998.538	-1.60%	4.00%	CROWN	12	2	CROWN	12	2
998.477	998.397	1.60%	2	CROWN	12	2	998.477	998.397	-1.60%	4.00%	CROWN	12	2	CROWN	12	2
998.312	998.232	1.60%	2	CROWN	12	2	998.312	998.232	-1.60%	4.00%	CROWN	12	2	CROWN	12	2
998.145	998.065	1.60%	2	CROWN	12	2	998.145	998.065	-1.60%	4.00%	CROWN	12	2	CROWN	12	2
998.030	997.950	1.60%	2	CROWN	12	2	998.030	997.950	-1.60%	4.00%	CROWN	12	2	CROWN	12	2
997.920	997.840	1.60%	2	CROWN	12	2	997.920	997.840	-1.60%	4.00%	CROWN	12	2	CROWN	12	2
997.808	997.728	1.60%	2	CROWN	12	2	997.808	997.728	-1.60%	4.00%	CROWN	12	2	CROWN	12	2
997.651	997.571	1.60%	2	CROWN	12	2	997.651	997.571	-1.60%	4.00%	CROWN	12	2	CROWN	12	2
997.506	997.426	1.60%	2	CROWN	12	2	997.506	997.426	-1.60%	4.00%	CROWN	12	2	CROWN	12	2
997.322	997.242	1.60%	2	CROWN	12	2	997.322	997.242	-1.60%	4.00%	CROWN	12	2	CROWN	12	2
997.169	997.089	1.60%	2	CROWN	12	2	997.169	997.089	-1.60%	4.00%	CROWN	12	2	CROWN	12	2
996.946	996.866	1.60%	2	CROWN	12	2	996.946	996.866	-1.60%	4.00%	CROWN	12	2	CROWN	12	2
996.751	996.671	1.60%	2	CROWN	12	2	996.751	996.671	-1.60%	4.00%	CROWN	12	2	CROWN	12	2
996.552	996.472	1.60%	2	CROWN	12	2	996.552	996.472	-1.60%	4.00%	CROWN	12	2	CROWN	12	2
996.384	996.304	1.60%	2	CROWN	12	2	996.384	996.304	-1.60%	4.00%	CROWN	12	2	CROWN	12	2
996.158	996.078	1.60%	2	CROWN	12	2	996.158	996.078	-1.60%	4.00%	CROWN	12	2	CROWN	12	2
995.942	995.862	1.60%	2	CROWN	12	2	995.942	995.862	-1.60%	4.00%	CROWN	12	2	CROWN	12	2
995.733	995.653	1.60%	2	CROWN	12	2	995.733	995.653	-1.60%	4.00%	CROWN	12	2	CROWN	12	2
995.498	995.418	1.60%	2	CROWN	12	2	995.498	995.418	-1.60%	4.00%	CROWN	12	2	CROWN	12	2
995.276	995.196	1.60%	2	CROWN	12	2	995.276	995.196	-1.60%	4.00%	CROWN	12	2	CROWN	12	2
995.057	994.977	1.60%	2	CROWN	12	2	995.057	994.977	-1.60%	4.00%	CROWN	12	2	CROWN	12	2
994.859	994.779	1.60%	2	CROWN	12	2	994.859	994.779	-1.60%	4.00%	CROWN	12	2	CROWN	12	2
994.661	994.581	1.60%	2	CROWN	12	2	994.661	994.581	-1.60%	4.00%	CROWN	12	2	CROWN	12	2
994.431	994.351	1.60%	2	CROWN	12	2	994.431	994.351	-1.60%	4.00%	CROWN	12	2	CROWN	12	2
994.190	994.110	1.60%	2	CROWN	12	2	994.190	994.110	-1.60%	4.00%	CROWN	12	2	CROWN	12	2
993.938	993.858	1.60%	2	CROWN	12	2	993.938	993.858	-1.60%	4.00%	CROWN	12	2	CROWN	12	2
993.712	993.632	1.60%	2	CROWN	12	2	993.712	993.632	-1.60%	4.00%	CROWN	12	2	CROWN	12	2
993.508	993.428	1.60%	2	CROWN	12	2	993.508	993.428	-1.60%	4.00%	CROWN	12	2	CROWN	12	2
993.279	993.199	1.60%	2	CROWN	12	2	993.279	993.199	-1.60%	4.00%	CROWN	12	2	CROWN	12	2
993.097	993.017	1.60%	2	CROWN	12	2	993.097	993.017	-1.60%	4.00%	CROWN	12	2	CROWN	12	2
992.873	992.793	1.60%	2	CROWN	12	2	992.873	992.793	-1.60%	4.00%	CROWN	12	2	CROWN	12	2
992.675	992.595	1.60%	2	CROWN	12	2	992.675	992.595	-1.60%	4.00%	CROWN	12	2	CROWN	12	2
992.455	992.375	1.60%	2	CROWN	12	2	992.455	992.375	-1.60%	4.00%	CROWN	12	2	CROWN	12	2
992.250	992.170	1.60%	2	CROWN	12	2	992.250	992.170	-1.60%	4.00%	CROWN	12	2	CROWN	12	2
992.028	991.948	1.60%	2	CROWN	12	2	992.028	991.948	-1.60%	4.00%	CROWN	12	2	CROWN	12	2
991.800	991.720	1.60%	2	CROWN	12	2	991.800	991.720	-1.60%	4.00%	CROWN	12	2	CROWN	12	2
991.577	991.497	1.60%	2	CROWN	12	2	991.577	991.497	-1.60%	4.00%	CROWN	12	2	CROWN	12	2
991.339	991.259	1.60%	2	CROWN	12	2	991.339	991.259	-1.60%	4.00%	CROWN	12	2	CROWN	12	2
991.129	991.049	1.60%	2	CROWN	12	2	991.129	991.049	-1.60%	4.00%	CROWN	12	2	CROWN	12	2
990.948	990.868	1.60%	2	CROWN	12	2	990.948	990.868	-1.60%	4.00%	CROWN	12	2	CROWN	12	2
990.741	990.661	1.60%	2	CROWN	12	2	990.741	990.661	-1.60%	4.00%	CROWN	12	2	CROWN	12	2
990.540	990.460	1.60%	2	CROWN	12	2	990.540	990.460	-1.60%	4.00%	CROWN	12	2	CROWN	12	2
990.346	990.266	1.60%	2	CROWN	12	2	990.346	990.266	-1.60%	4.00%	CROWN	12	2	CROWN	12	2
990.185	990.105	1.60%	2	CROWN	12	2	990.185	990.105	-1.60%	4.00%	CROWN	12	2	CROWN	12	2
990.008	989.928	1.60%	2	CROWN	12	2	990.008	989.928	-1.60%	4.00%	CROWN	12	2	CROWN	12	2
989.852	989.772	1.60%	2	CROWN	12	2	989.852	989.772	-1.60%	4.00%	CROWN	12	2	CROWN	12	2
989.662	989.582	1.60%	2	CROWN	12	2	989.662	989.582	-1.60%	4.00%	CROWN	12	2	CROWN	12	2
989.498	989.418	1.60%	2	CROWN	12	2	989.498	989.418	-1.60%	4.00%	CROWN	12	2	CROWN	12	2
989.317	989.237	1.60%	2	CROWN	12	2	989.317	989.237	-1.60%	4.00%	CROWN	12	2	CROWN	12	2
989.098	989.018	1.60%	2	CROWN	12	2	989.098	989.018	-1.60%	4.00%	CROWN	12	2	CROWN	12	2
988.926	988.846	1.60%	2	CROWN	12	2	988.926	988.846	-1.60%	4.00%	CROWN	12	2	CROWN	12	2
988.765	988.685	1.60%	2	CROWN	12	2	988.765	988.685	-1.60%	4.00%	CROWN	12	2	CROWN	12	2
988.551	988.471	1.60%	2	CROWN	12	2	988.551	988.471	-1.60%	4.00%	CROWN	12	2	CROWN	12	2
988.333	988.253	1.60%	2	CROWN	12	2	988.333	988.253	-1.60%	4.00%	CROWN	12	2	CROWN	12	2
988.177	988.097	1.60%	2	CROWN	12	2	988.177	988.097	-1.60%	4.00%	CROWN	12	2	CROWN	12	2
987.997	987.917	1.60%	2	CROWN	12	2	987.997	987.917	-1.60%	4.00%	CROWN	12	2	CROWN	12	2
987.897	987.817	1.60%	2	CROWN	12	2	987.897	987.817	-1.60%	4.00%	CROWN	12	2	CROWN	12	2
987.599	987.519	1.60%	2	CROWN	12	2	987.599	987.519	-1.60%	4.00%	CROWN	12	2	CROWN	12	2
987.317	987.237	1.60%	2	CROWN	12	2	987.317	987.237	-1.60%	4.00%	CROWN	12	2	CROWN	12	2
987.002	986.922	1.60%	2	CROWN	12	2	987.002	986.922	-1.60%	4.00%	CROWN	12	2	CROWN	12	2
986.668	986.588	1.60%	2	CROWN	12	2	986.668	986.588	-1.60%	4.00%	CROWN	12	2	CROWN	12	2
986.274	986.194	1.60%	2	CROWN	12	2	986.274	986.194	-1.60%	4.00%	CROWN	12	2	CROWN	12	2
985.814	985.734	1.60%	2	CROWN	12	2	985.814	985.734	-1.60%	4.00%	CROWN	12	2	CROWN	12	2
985.327	985.247	1.60%	2	CROWN	12	2	985.327	985.247	-1.60%	4.00%	CROWN	12	2	CROWN	12	2
984.827	984.747	1.60%	2	CROWN	12	2	984.827	984.747	-1.60%	4.00%	CROWN	12	2	CROWN	12	2
984.307	984.227	1.60%	2	CROWN	12	2	984.307	984.227	-1.60%	4.00%	CROWN	12	2	CROWN	12	2
983.814	983.734	1.60%	2	CROWN	12	2	983.814	983.734	-1.60%	4.00%	CROWN	12	2	CROWN	12	2
983.320	983.240	1.60%	2	CROWN	12	2	983.320	983.240	-1.60%	4.00%	CROWN	12	2	CROWN	12	2
982.888	982.808	1.60%	2	CROWN	12	2	982.888	982.808	-1.60%	4.00%	CROWN	12	2	CROWN	12	2
982.474	982.394	1.60%	2	CROWN	12	2	982.474	982.394	-1.60%	4.00%	CROWN	12	2	CROWN	12	2
982.158	982.078	1.60%	2	CROWN	12	2	982.158	982.078	-1.60%	4.00%	CROWN	12	2	CROWN	12	2
981.918	981.838	1.60%	2	CROWN	12	2	981.918	981.838	-1.60%	4.00%	CROWN	12	2	CROWN	12	2
981.668	981.588	1.60%	2	CROWN	12	2	981.668	981.588	-1.60%	4.00%	CROWN	12	2	CROWN	12	2
981.489	981.409	1.60%	2	CROWN	12	2	981.489	981.409	-1.60%	4.00%	CROWN	12	2	CROWN	12	2
981.319	981.239	1.60%	2	CROWN	12	2	981.319	981.239	-1.60%	4.00%	CROWN	12	2	CROWN	12	2
981.149	981.069	1.60%	2	CROWN	12	2	981.149	981.069	-1.60%	4.00%	CROWN	12	2	CROWN	12	2
981.045	980.965	1.60%	2	CROWN	12	2	981.045	980.965	-1.60%	4.00%	CROWN	12	2	CROWN	12	2
981.005	980.925	1.60%	2	CROWN	12	2	981.005	980.925	-1.60%	4.00%	CROWN	12	2	CROWN	12	2
980.990	980.910	1.60%	2	CROWN	12	2	980.990	980.910	-1.60%	4.00%	CROWN	12	2	CROWN	12	2
981.047	980.967	1.60%	2	CROWN	12	2	981.047	980.967	-1.60%	4.00%	CROWN	12	2	CROWN	12	2
981.038	980.958	1.60%	2	CROWN	12	2	981.038	980.958	-1.60%	4.00%	CROWN	12	2	CROWN	12	2
980.978	980.898	1.60%	2	CROWN	12	2	980.978	980.898	-1.60%	4.00%	CROWN	12	2	CROWN	12	2



# HUR-13-0.00

MODEL: PGL SHEET 12 PAPER SIZE: 34x22 (in.) DATE: 1/10/2024 TIME: 5:59:55 PM USER: ksalay  
pw:\ohiodot-pw.bentley.com\ohiodot-pw-02\Documents\01\_Active Projects\District 03\Huron\101386\400-Engineering\Roadway\Sheets\101386\_GF001.dgn

LEFT SIDE										CENTERLINE										RIGHT SIDE														
ELEVATION					WIDTH (FT)					STATION					PROFILE					ELEVATION					CROSS SLOPE					WIDTH (FT)				
EP.	EPS.	LANE	SH.	ROTATION	LANE	SH.	ROTATION	LANE	SH.	EP.	EPS.	LANE	SH.	ROTATION	EP.	EPS.	LANE	SH.	ROTATION	LANE	SH.	ROTATION	LANE	SH.										
969.188	969.108	1.60%	4.00%	CROWN	12	2	275+25.00	969.380	969.108	969.188	969.108	-1.60%	-4.00%	CROWN	969.188	969.108	-1.60%	-4.00%	CROWN	12	2	275+25.00	969.380	969.108										
968.285	968.205	1.60%	4.00%	CROWN	12	2	275+50.00	968.477	968.205	968.285	968.205	-1.60%	-4.00%	CROWN	968.477	968.205	-1.60%	-4.00%	CROWN	12	2	275+50.00	968.477	968.205										
967.427	967.347	1.60%	4.00%	CROWN	12	2	275+75.00	967.619	967.347	967.427	967.347	-1.60%	-4.00%	CROWN	967.619	967.347	-1.60%	-4.00%	CROWN	12	2	275+75.00	967.619	967.347										
966.618	966.538	1.60%	4.00%	CROWN	12	2	276+00.00	966.810	966.538	966.618	966.538	-1.60%	-4.00%	CROWN	966.810	966.538	-1.60%	-4.00%	CROWN	12	2	276+00.00	966.810	966.538										
965.773	965.693	1.60%	4.00%	CROWN	12	2	276+25.00	965.985	965.693	965.773	965.693	-1.60%	-4.00%	CROWN	965.985	965.693	-1.60%	-4.00%	CROWN	12	2	276+25.00	965.985	965.693										
965.042	964.962	1.60%	4.00%	CROWN	12	2	276+50.00	965.234	964.962	965.042	964.962	-1.60%	-4.00%	CROWN	965.234	964.962	-1.60%	-4.00%	CROWN	12	2	276+50.00	965.234	964.962										
964.365	964.285	1.60%	4.00%	CROWN	12	2	277+00.00	964.557	964.285	964.365	964.285	-1.60%	-4.00%	CROWN	964.557	964.285	-1.60%	-4.00%	CROWN	12	2	277+00.00	964.557	964.285										
963.818	963.738	1.60%	4.00%	CROWN	12	2	277+25.00	963.534	963.342	963.818	963.342	-1.60%	-4.00%	CROWN	963.534	963.342	-1.60%	-4.00%	CROWN	12	2	277+25.00	963.534	963.342										
963.342	963.262	1.60%	4.00%	CROWN	12	2	277+50.00	963.150	962.958	963.342	962.958	-1.60%	-4.00%	CROWN	963.150	962.958	-1.60%	-4.00%	CROWN	12	2	277+50.00	963.150	962.958										
962.631	962.551	1.60%	4.00%	CROWN	12	2	277+75.00	962.823	962.631	962.631	962.551	-1.60%	-4.00%	CROWN	962.823	962.551	-1.60%	-4.00%	CROWN	12	2	277+75.00	962.823	962.551										
962.313	962.233	1.60%	4.00%	CROWN	12	2	278+00.00	962.505	962.313	962.313	962.233	-1.60%	-4.00%	CROWN	962.505	962.313	-1.60%	-4.00%	CROWN	12	2	278+00.00	962.505	962.313										
962.131	962.051	1.60%	4.00%	CROWN	12	2	278+25.00	962.323	962.131	962.131	962.051	-1.60%	-4.00%	CROWN	962.323	962.051	-1.60%	-4.00%	CROWN	12	2	278+25.00	962.323	962.051										
962.058	961.978	1.60%	4.00%	CROWN	12	2	278+50.00	962.250	962.058	962.058	961.978	-1.60%	-4.00%	CROWN	962.250	962.058	-1.60%	-4.00%	CROWN	12	2	278+50.00	962.250	962.058										
962.128	962.048	1.60%	4.00%	CROWN	12	2	278+75.00	962.320	962.128	962.128	962.048	-1.60%	-4.00%	CROWN	962.320	962.048	-1.60%	-4.00%	CROWN	12	2	278+75.00	962.320	962.048										
962.281	962.201	1.60%	4.00%	CROWN	12	2	279+00.00	962.473	962.281	962.281	962.201	-1.60%	-4.00%	CROWN	962.473	962.201	-1.60%	-4.00%	CROWN	12	2	279+00.00	962.473	962.201										
962.434	962.354	1.60%	4.00%	CROWN	12	2	279+25.00	962.626	962.434	962.434	962.354	-1.60%	-4.00%	CROWN	962.626	962.354	-1.60%	-4.00%	CROWN	12	2	279+25.00	962.626	962.354										
962.621	962.541	1.60%	4.00%	CROWN	12	2	279+50.00	962.813	962.621	962.621	962.541	-1.60%	-4.00%	CROWN	962.813	962.541	-1.60%	-4.00%	CROWN	12	2	279+50.00	962.813	962.541										
962.865	962.785	1.60%	4.00%	CROWN	12	2	279+75.00	963.057	962.865	962.865	962.785	-1.60%	-4.00%	CROWN	963.057	962.785	-1.60%	-4.00%	CROWN	12	2	279+75.00	963.057	962.785										
963.183	963.103	1.60%	4.00%	CROWN	12	2	280+00.00	963.375	963.183	963.183	963.103	-1.60%	-4.00%	CROWN	963.375	963.103	-1.60%	-4.00%	CROWN	12	2	280+00.00	963.375	963.103										
963.511	963.431	1.60%	4.00%	CROWN	12	2	280+25.00	963.703	963.511	963.511	963.431	-1.60%	-4.00%	CROWN	963.703	963.431	-1.60%	-4.00%	CROWN	12	2	280+25.00	963.703	963.431										
963.849	963.769	1.60%	4.00%	CROWN	12	2	280+50.00	964.041	963.849	963.849	963.769	-1.60%	-4.00%	CROWN	964.041	963.769	-1.60%	-4.00%	CROWN	12	2	280+50.00	964.041	963.769										
964.185	964.105	1.60%	4.00%	CROWN	12	2	280+75.00	964.377	964.185	964.185	964.105	-1.60%	-4.00%	CROWN	964.377	964.105	-1.60%	-4.00%	CROWN	12	2	280+75.00	964.377	964.105										
964.524	964.444	1.60%	4.00%	CROWN	12	2	281+00.00	964.716	964.524	964.524	964.444	-1.60%	-4.00%	CROWN	964.716	964.444	-1.60%	-4.00%	CROWN	12	2	281+00.00	964.716	964.444										
964.801	964.721	1.60%	4.00%	CROWN	12	2	281+25.00	964.993	964.801	964.801	964.721	-1.60%	-4.00%	CROWN	964.993	964.721	-1.60%	-4.00%	CROWN	12	2	281+25.00	964.993	964.721										
965.028	964.948	1.60%	4.00%	CROWN	12	2	281+50.00	965.220	965.028	965.028	964.948	-1.60%	-4.00%	CROWN	965.220	964.948	-1.60%	-4.00%	CROWN	12	2	281+50.00	965.220	964.948										
965.181	965.101	1.60%	4.00%	CROWN	12	2	281+75.00	965.373	965.181	965.181	965.101	-1.60%	-4.00%	CROWN	965.373	965.101	-1.60%	-4.00%	CROWN	12	2	281+75.00	965.373	965.101										
965.250	965.170	1.60%	4.00%	CROWN	12	2	282+00.00	965.442	965.250	965.250	965.170	-1.60%	-4.00%	CROWN	965.442	965.170	-1.60%	-4.00%	CROWN	12	2	282+00.00	965.442	965.170										
965.298	965.218	1.60%	4.00%	CROWN	12	2	282+25.00	965.490	965.298	965.298	965.218	-1.60%	-4.00%	CROWN	965.490	965.218	-1.60%	-4.00%	CROWN	12	2	282+25.00	965.490	965.218										
965.235	965.155	1.60%	4.00%	CROWN	12	2	282+50.00	965.427	965.235	965.235	965.155	-1.60%	-4.00%	CROWN	965.427	965.155	-1.60%	-4.00%	CROWN	12	2	282+50.00	965.427	965.155										
965.118	965.038	1.60%	4.00%	CROWN	12	2	282+75.00	965.310	965.118	965.118	965.038	-1.60%	-4.00%	CROWN	965.310	965.038	-1.60%	-4.00%	CROWN	12	2	282+75.00	965.310	965.038										
964.977	964.897	1.60%	4.00%	CROWN	12	2	283+00.00	965.169	964.977	964.977	964.897	-1.60%	-4.00%	CROWN	965.169	964.897	-1.60%	-4.00%	CROWN	12	2	283+00.00	965.169	964.897										
964.788	964.708	1.60%	4.00%	CROWN	12	2	283+25.00	964.980	964.788	964.788	964.708	-1.60%	-4.00%	CROWN	964.980	964.708	-1.60%	-4.00%	CROWN	12	2	283+25.00	964.980	964.708										
964.562	964.482	1.60%	4.00%	CROWN	12	2	283+50.00	964.754	964.562	964.562	964.482	-1.60%	-4.00%	CROWN	964.754	964.482	-1.60%	-4.00%	CROWN	12	2	283+50.00	964.754	964.482										
964.349	964.269	1.60%	4.00%	CROWN	12	2	283+75.00	964.541	964.349	964.349	964.269	-1.60%	-4.00%	CROWN	964.541	964.269	-1.60%	-4.00%	CROWN	12	2	283+75.00	964.541	964.269										
964.142	964.062	1.60%	4.00%	CROWN	12	2	284+00.00	964.334	964.142	964.142	964.062	-1.60%	-4.00%	CROWN	964.334	964.062	-1.60%	-4.00%	CROWN	12	2	284+00.00	964.334	964.062										
963.930	963.850	1.60%	4.00%	CROWN	12	2	284+25.00	964.122	963.930	963.930	963.850	-1.60%	-4.00%	CROWN	964.122	963.850	-1.60%	-4.00%	CROWN	12	2	284+25.00	964.122	963.850										
963.703	963.623	1.60%	4.00%	CROWN	12	2	284+50.00	963.895	963.703	963.703	963.623	-1.60%	-4.00%	CROWN	963.895	963.623	-1.60%	-4.00%	CROWN	12	2	284+50.00	963.895	963.623										
963.425	963.345	1.60%	4.00%	CROWN	12	2	284+75.00	963.617	963.425	963.425	963.345	-1.60%	-4.00%	CROWN	963.617	963.345	-1.60%	-4.00%	CROWN	12	2	284+75.00	963.617	963.345										
963.168	963.088	1.60%	4.00%	CROWN	12	2	285+00.00	963.360	963.168	963.168	963.088	-1.60%	-4.00%	CROWN	963.360	963.088	-1.60%	-4.00%	CROWN	12	2	285+00.00	963.360	963.088										
962.867	962.787	1.60%	4.00%	CROWN	12	2	285+25.00	963.059	962.867	962.867	962.787	-1.60%	-4.00%	CROWN	963.059	962.787	-1.60%	-4.00%	CROWN	12	2	285+25.00	963.059	962.787										
962.600	962.520	1.60%	4.00%	CROWN	12	2	285+50.00	962.792	962.600	962.600	962.520	-1.60%	-4.00%	CROWN	962.792	962.520	-1.60%	-4.00%	CROWN	12	2	285+50.00	962.792	962.520										
962.390	962.310	1.60%	4.00%	CROWN	12	2	285+75.00	962.582	962.390	962.390	962.310	-1.60%	-4.00%	CROWN	962.582	962.310	-1.60%	-4.00%	CROWN	12	2	285+75.00	962.582	962.310										
962.188	962.108	1.60%	4.00%	CROWN	12	2	286+00.00	962.380	962.188	962.188	962.108	-1.60%	-4.00%	CROWN	962.380	962.108	-1.60%	-4.00%	CROWN	12	2	286+00.00	962.380	962.108										
961.994	961.914	1.60%	4.00%	CROWN	12	2	286+25.00	962.186	961.994	961.994	961.914	-1.60%	-4.00%	CROWN	962.186	961.914	-1.60%	-4.00%	CROWN	12	2	286+25.00	962.186	961.914										
961.805	961.725	1.60%	4.00%	CROWN	12	2	286+50.00	961.997	961.805	961.805	961.725	-1.60%	-4.00%	CROWN	961.997	961.725	-1.60%	-4.00%	CROWN	12	2	286+50.00	961.997	961.725										
961.605	961.525	1.60%	4.00%	CROWN	12	2	286+75.00	961.797	961.605	961.605	961.525	-1.60%	-4.00%	CROWN	961.797	961.525	-1.60%	-4.00%	CROWN	12	2	286+75.00	961.797	961.525										
961.416	961.336	1.60%	4.00%	CROWN	12	2	287+00.00	961.608	961.416	961.416	961.336	-1.60%	-4.00%	CROWN	961.608	961.336	-1.60%	-4.00%	CROWN	12	2	287+00.00	961.608	961.336										
961.178	961.098	1.60%	4.00%	CROWN	12	2	287+25.00	961.370	961.178	961.178	96																							



**HUR-13-0.00**

MODEL: PGL SHEET 13 PAPER SIZE: 34x22 (in.) DATE: 1/10/2024 TIME: 6:00:26 PM USER: ksalay  
 pw:\ahodot-pw.bentley.com\ohodot-pw-02\Documents\01 Active Projects\District 03\Huron\101386\400-Engineering\Roadway\Sheets\101386\_GF001.dgn

ELEVATION				CROSS SLOPE				WIDTH (FT)				STATION				PROFILE GRADE				ELEVATION				CROSS SLOPE				WIDTH (FT)							
LEFT SIDE				CENTERLINE				RIGHT SIDE				LEFT SIDE				CENTERLINE				RIGHT SIDE				LEFT SIDE				CENTERLINE				RIGHT SIDE			
EP.	EPS.	LANE	SH.	ROTATION	LANE	SH.	STATION	PROFILE GRADE	EP.	EPS.	LANE	SH.	ROTATION	LANE	SH.	STATION	PROFILE GRADE	EP.	EPS.	LANE	SH.	ROTATION	LANE	SH.	STATION	PROFILE GRADE	EP.	EPS.	LANE	SH.	ROTATION	LANE	SH.		







HUR-13-0-00

MODEL: PGL SHEET 15 PAPER SIZE: 34x22 (in.) DATE: 1/10/2024 TIME: 6:01:48 PM USER: ksalay  
pw:\ohiodot-pw.bentley.com\ohiodot-pw-02\Documents\01 Active Projects\District 03\Huron\101386\400-Engineering\Roadway\Sheets\101386\_GF001.dgn

ELEVATION				WIDTH (FT)				STATION				PROFILE GRADE				ELEVATION				RIGHT SIDE				
LEFT SIDE		CENTERLINE		RIGHT SIDE		LEFT SIDE		CENTERLINE		RIGHT SIDE		LEFT SIDE		CENTERLINE		RIGHT SIDE		LEFT SIDE		CENTERLINE		RIGHT SIDE		
EP.	EPS.	LANE	SH.	ROTATION	LANE	SH.	STATION	PROFILE GRADE	ELEVATION	EPS.	ROTATION	LANE	SH.	ROTATION	LANE	SH.	CROSS SLOPE	EP.	EPS.	LANE	SH.	ROTATION	LANE	SH.
982.063	981.983	1.60%	4.00%	CROWN	12	2	350+25.00	982.255	982.063	981.983	CROWN	12	-4.00%	CROWN	12	-4.00%	-4.00%	982.063	981.983	-1.60%	-4.00%	CROWN	12	-4.00%
982.124	982.044	1.60%	4.00%	CROWN	12	2	350+50.00	982.316	982.124	982.044	CROWN	12	-4.00%	CROWN	12	-4.00%	-4.00%	982.124	982.044	-1.60%	-4.00%	CROWN	12	-4.00%
982.167	982.087	1.60%	4.00%	CROWN	12	2	350+75.00	982.359	982.167	982.087	CROWN	12	-4.00%	CROWN	12	-4.00%	-4.00%	982.167	982.087	-1.60%	-4.00%	CROWN	12	-4.00%
982.128	982.048	1.60%	4.00%	CROWN	12	2	351+00.00	982.320	982.128	982.048	CROWN	12	-4.00%	CROWN	12	-4.00%	-4.00%	982.128	982.048	-1.60%	-4.00%	CROWN	12	-4.00%
982.108	982.028	1.60%	4.00%	CROWN	12	2	351+25.00	982.300	982.108	982.028	CROWN	12	-4.00%	CROWN	12	-4.00%	-4.00%	982.108	982.028	-1.60%	-4.00%	CROWN	12	-4.00%
982.108	982.028	1.60%	4.00%	CROWN	12	2	351+50.00	982.300	982.108	982.028	CROWN	12	-4.00%	CROWN	12	-4.00%	-4.00%	982.108	982.028	-1.60%	-4.00%	CROWN	12	-4.00%
982.070	981.990	1.60%	4.00%	CROWN	12	2	351+75.00	982.262	982.070	981.990	CROWN	12	-4.00%	CROWN	12	-4.00%	-4.00%	982.070	981.990	-1.60%	-4.00%	CROWN	12	-4.00%
982.089	982.009	1.60%	4.00%	CROWN	12	2	352+00.00	982.281	982.089	982.009	CROWN	12	-4.00%	CROWN	12	-4.00%	-4.00%	982.089	982.009	-1.60%	-4.00%	CROWN	12	-4.00%
982.082	982.002	1.60%	4.00%	CROWN	12	2	352+25.00	982.274	982.082	982.002	CROWN	12	-4.00%	CROWN	12	-4.00%	-4.00%	982.082	982.002	-1.60%	-4.00%	CROWN	12	-4.00%
982.098	982.018	1.60%	4.00%	CROWN	12	2	352+50.00	982.290	982.098	982.018	CROWN	12	-4.00%	CROWN	12	-4.00%	-4.00%	982.098	982.018	-1.60%	-4.00%	CROWN	12	-4.00%
982.079	981.999	1.60%	4.00%	CROWN	12	2	352+75.00	982.271	982.079	981.999	CROWN	12	-4.00%	CROWN	12	-4.00%	-4.00%	982.079	981.999	-1.60%	-4.00%	CROWN	12	-4.00%
982.088	982.008	1.60%	4.00%	CROWN	12	2	353+00.00	982.280	982.088	982.008	CROWN	12	-4.00%	CROWN	12	-4.00%	-4.00%	982.088	982.008	-1.60%	-4.00%	CROWN	12	-4.00%
982.091	982.011	1.60%	4.00%	CROWN	12	2	353+25.00	982.283	982.091	982.011	CROWN	12	-4.00%	CROWN	12	-4.00%	-4.00%	982.091	982.011	-1.60%	-4.00%	CROWN	12	-4.00%
982.047	981.967	1.60%	4.00%	CROWN	12	2	353+50.00	982.239	982.047	981.967	CROWN	12	-4.00%	CROWN	12	-4.00%	-4.00%	982.047	981.967	-1.60%	-4.00%	CROWN	12	-4.00%
981.978	981.898	1.60%	4.00%	CROWN	12	2	353+75.00	982.170	981.978	981.898	CROWN	12	-4.00%	CROWN	12	-4.00%	-4.00%	981.978	981.898	-1.60%	-4.00%	CROWN	12	-4.00%
981.832	981.752	1.60%	4.00%	CROWN	12	2	354+00.00	982.024	981.832	981.752	CROWN	12	-4.00%	CROWN	12	-4.00%	-4.00%	981.832	981.752	-1.60%	-4.00%	CROWN	12	-4.00%
981.632	981.552	1.60%	4.00%	CROWN	12	2	354+25.00	981.824	981.632	981.552	CROWN	12	-4.00%	CROWN	12	-4.00%	-4.00%	981.632	981.552	-1.60%	-4.00%	CROWN	12	-4.00%
981.366	981.286	1.60%	4.00%	CROWN	12	2	354+50.00	981.558	981.366	981.286	CROWN	12	-4.00%	CROWN	12	-4.00%	-4.00%	981.366	981.286	-1.60%	-4.00%	CROWN	12	-4.00%
981.058	980.978	1.60%	4.00%	CROWN	12	2	354+75.00	981.250	981.058	980.978	CROWN	12	-4.00%	CROWN	12	-4.00%	-4.00%	981.058	980.978	-1.60%	-4.00%	CROWN	12	-4.00%
980.709	980.629	1.60%	4.00%	CROWN	12	2	355+00.00	980.901	980.709	980.629	CROWN	12	-4.00%	CROWN	12	-4.00%	-4.00%	980.709	980.629	-1.60%	-4.00%	CROWN	12	-4.00%
980.310	980.230	1.60%	4.00%	CROWN	12	2	355+25.00	980.502	980.310	980.230	CROWN	12	-4.00%	CROWN	12	-4.00%	-4.00%	980.310	980.230	-1.60%	-4.00%	CROWN	12	-4.00%
979.888	979.808	1.60%	4.00%	CROWN	12	2	355+50.00	980.080	980.080	979.888	CROWN	12	-4.00%	CROWN	12	-4.00%	-4.00%	979.888	979.808	-1.60%	-4.00%	CROWN	12	-4.00%
979.395	979.315	1.60%	4.00%	CROWN	12	2	355+75.00	979.587	979.395	979.315	CROWN	12	-4.00%	CROWN	12	-4.00%	-4.00%	979.395	979.315	-1.60%	-4.00%	CROWN	12	-4.00%
978.897	978.817	1.60%	4.00%	CROWN	12	2	356+00.00	979.089	978.897	978.817	CROWN	12	-4.00%	CROWN	12	-4.00%	-4.00%	978.897	978.817	-1.60%	-4.00%	CROWN	12	-4.00%
978.374	978.294	1.60%	4.00%	CROWN	12	2	356+25.00	978.566	978.374	978.294	CROWN	12	-4.00%	CROWN	12	-4.00%	-4.00%	978.374	978.294	-1.60%	-4.00%	CROWN	12	-4.00%
977.841	977.761	1.60%	4.00%	CROWN	12	2	356+50.00	978.033	977.841	977.761	CROWN	12	-4.00%	CROWN	12	-4.00%	-4.00%	977.841	977.761	-1.60%	-4.00%	CROWN	12	-4.00%
977.310	977.230	1.60%	4.00%	CROWN	12	2	356+75.00	977.502	977.310	977.230	CROWN	12	-4.00%	CROWN	12	-4.00%	-4.00%	977.310	977.230	-1.60%	-4.00%	CROWN	12	-4.00%
976.770	976.690	1.60%	4.00%	CROWN	12	2	357+00.00	976.962	976.770	976.690	CROWN	12	-4.00%	CROWN	12	-4.00%	-4.00%	976.770	976.690	-1.60%	-4.00%	CROWN	12	-4.00%
976.171	976.091	1.60%	4.00%	CROWN	12	2	357+25.00	976.363	976.171	976.091	CROWN	12	-4.00%	CROWN	12	-4.00%	-4.00%	976.171	976.091	-1.60%	-4.00%	CROWN	12	-4.00%
975.598	975.518	1.60%	4.00%	CROWN	12	2	357+50.00	975.790	975.598	975.518	CROWN	12	-4.00%	CROWN	12	-4.00%	-4.00%	975.598	975.518	-1.60%	-4.00%	CROWN	12	-4.00%
975.010	974.930	1.60%	4.00%	CROWN	12	2	357+75.00	975.202	975.010	974.930	CROWN	12	-4.00%	CROWN	12	-4.00%	-4.00%	975.010	974.930	-1.60%	-4.00%	CROWN	12	-4.00%
974.453	974.373	1.60%	4.00%	CROWN	12	2	358+00.00	974.645	974.453	974.373	CROWN	12	-4.00%	CROWN	12	-4.00%	-4.00%	974.453	974.373	-1.60%	-4.00%	CROWN	12	-4.00%
973.985	973.905	1.60%	4.00%	CROWN	12	2	358+25.00	974.177	973.985	973.905	CROWN	12	-4.00%	CROWN	12	-4.00%	-4.00%	973.985	973.905	-1.60%	-4.00%	CROWN	12	-4.00%
973.575	973.495	1.60%	4.00%	CROWN	12	2	358+50.00	973.767	973.575	973.495	CROWN	12	-4.00%	CROWN	12	-4.00%	-4.00%	973.575	973.495	-1.60%	-4.00%	CROWN	12	-4.00%
973.233	973.153	1.60%	4.00%	CROWN	12	2	358+75.00	973.425	973.233	973.153	CROWN	12	-4.00%	CROWN	12	-4.00%	-4.00%	973.233	973.153	-1.60%	-4.00%	CROWN	12	-4.00%
972.975	972.895	1.60%	4.00%	CROWN	12	2	359+00.00	973.167	972.975	972.895	CROWN	12	-4.00%	CROWN	12	-4.00%	-4.00%	972.975	972.895	-1.60%	-4.00%	CROWN	12	-4.00%
972.858	972.778	1.60%	4.00%	CROWN	12	2	359+25.00	973.050	972.858	972.778	CROWN	12	-4.00%	CROWN	12	-4.00%	-4.00%	972.858	972.778	-1.60%	-4.00%	CROWN	12	-4.00%
972.901	972.821	1.60%	4.00%	CROWN	12	2	359+50.00	973.093	972.901	972.821	CROWN	12	-4.00%	CROWN	12	-4.00%	-4.00%	972.901	972.821	-1.60%	-4.00%	CROWN	12	-4.00%
972.963	972.883	1.60%	4.00%	CROWN	12	2	359+75.00	973.155	972.963	972.883	CROWN	12	-4.00%	CROWN	12	-4.00%	-4.00%	972.963	972.883	-1.60%	-4.00%	CROWN	12	-4.00%
973.074	972.994	1.60%	4.00%	CROWN	12	2	360+00.00	973.266	973.074	972.994	CROWN	12	-4.00%	CROWN	12	-4.00%	-4.00%	973.074	972.994	-1.60%	-4.00%	CROWN	12	-4.00%
973.173	973.093	1.60%	4.00%	CROWN	12	2	360+25.00	973.365	973.173	973.093	CROWN	12	-4.00%	CROWN	12	-4.00%	-4.00%	973.173	973.093	-1.60%	-4.00%	CROWN	12	-4.00%
973.279	973.199	1.60%	4.00%	CROWN	12	2	360+50.00	973.471	973.279	973.199	CROWN	12	-4.00%	CROWN	12	-4.00%	-4.00%	973.279	973.199	-1.60%	-4.00%	CROWN	12	-4.00%
973.387	973.307	1.60%	4.00%	CROWN	12	2	360+75.00	973.579	973.387	973.307	CROWN	12	-4.00%	CROWN	12	-4.00%	-4.00%	973.387	973.307	-1.60%	-4.00%	CROWN	12	-4.00%
973.558	973.478	1.60%	4.00%	CROWN	12	2	361+00.00	973.750	973.558	973.478	CROWN	12	-4.00%	CROWN	12	-4.00%	-4.00%	973.558	973.478	-1.60%	-4.00%	CROWN	12	-4.00%
973.799	973.719	1.60%	4.00%	CROWN	12	2	361+25.00	973.991	973.799	973.719	CROWN	12	-4.00%	CROWN	12	-4.00%	-4.00%	973.799	973.719	-1.60%	-4.00%	CROWN	12	-4.00%
974.138	974.058	1.60%	4.00%	CROWN	12	2	361+50.00	974.330	974.138	974.058	CROWN	12	-4.00%	CROWN	12	-4.00%	-4.00%	974.138	974.058	-1.60%	-4.00%	CROWN	12	-4.00%
974.585	974.505	1.60%	4.00%	CROWN	12	2	361+75.00	974.777	974.585	974.505	CROWN	12	-4.00%	CROWN	12	-4.00%	-4.00%	974.585	974.505	-1.60%	-4.00%	CROWN	12	-4.00%
974.980	974.900	1.60%	4.00%	CROWN	12	2	362+00.00	975.172	974.980	974.900	CROWN	12	-4.00%	CROWN	12	-4.00%	-4.00%	974.980	974.900	-1.60%	-4.00%	CROWN	12	-4.00%
975.418	975.338	1.60%	4.00%	CROWN	12	2	362+25.00	975.610	975.418	975.338	CROWN	12	-4.00%	CROWN	12	-4.00%	-4.00%	975.418	975.338	-1.60%	-4.00%	CROWN	12	-4.00%
975.861	975.781	1.60%	4.00%	CROWN	12	2	362+50.00	976.053	975.861	975.781	CROWN	12	-4.00%	CROWN	12	-4.00%	-4.00%	975.861	975.781	-1.60%	-4.00%	CROWN	12	-4.00%
976.324	976.244	1.60%	4.00%	CROWN	12	2	362+75.00	9																