

US-35 E STANDPIPE ROAD,

JACKSON OHIO, FRANKLIN TOWNSHIP,
45640
TURN LANE LENGTHENING


"JAL-35-18.16 - 01"

VRS
↑

BASE @ ODOT CORS STA.
"PRS 51741367733"

1 CNPT, REBAR w/ "BG ENG
CONTROL" CAP SET
- 100' N E STANDPIPE RD
- 65' W E US35 / CTR MEDIAN

2 CNPT, REBAR w/ "BG ENG
CONTROL" CAP SET
- 600' N E STANDPIPE RD
- 60' W E US35 / CTR MEDIAN

500 BM1, BENCH TIE SET IN S/E SIDE
OF  NO #
- 122' W WESTERLY EP US35
- 14 S/E CORNER OF STORAGE BLDG
@ 1981 STANDPIPE RD
(SOUTH/EASTERLY MOST BUILDING)
* FROM S/E CORNER *

(Kw)
FE 10-6-2025

53/8


NOTE: USED + HELP OHIO COUNTY
COORDINATE SYSTEM,
ODOT LDP, JACKSON COUNTY,
NAD83(2011), NAD88, w/ GEOID 18.

501 BM2, BENCH TIE 12" π UP ON
 SIDE OF π "BREC 080041"
 - 81' S π STANDPIPE RD
 - 24' W π CLARY RD

BENCH RUN			
1			781.789'
	4.845'	786.634	
501 (BM2)		5.79	780.844'
	5.58'	786.424'	
TP		4.63	781.794'
	11.22	793.014'	
500 (BM1)		1.67'	791.344'
	1.83	793.174'	
TP		11.415'	781.759'
	4.145	785.904'	
2		6.16'	779.744'
	5.945	785.689	
TP		3.93	781.759'
	5.95'	787.709	
1		5.91	781.799' ✓

CONTROL SKETCH * NOT TO SCALE

54/8

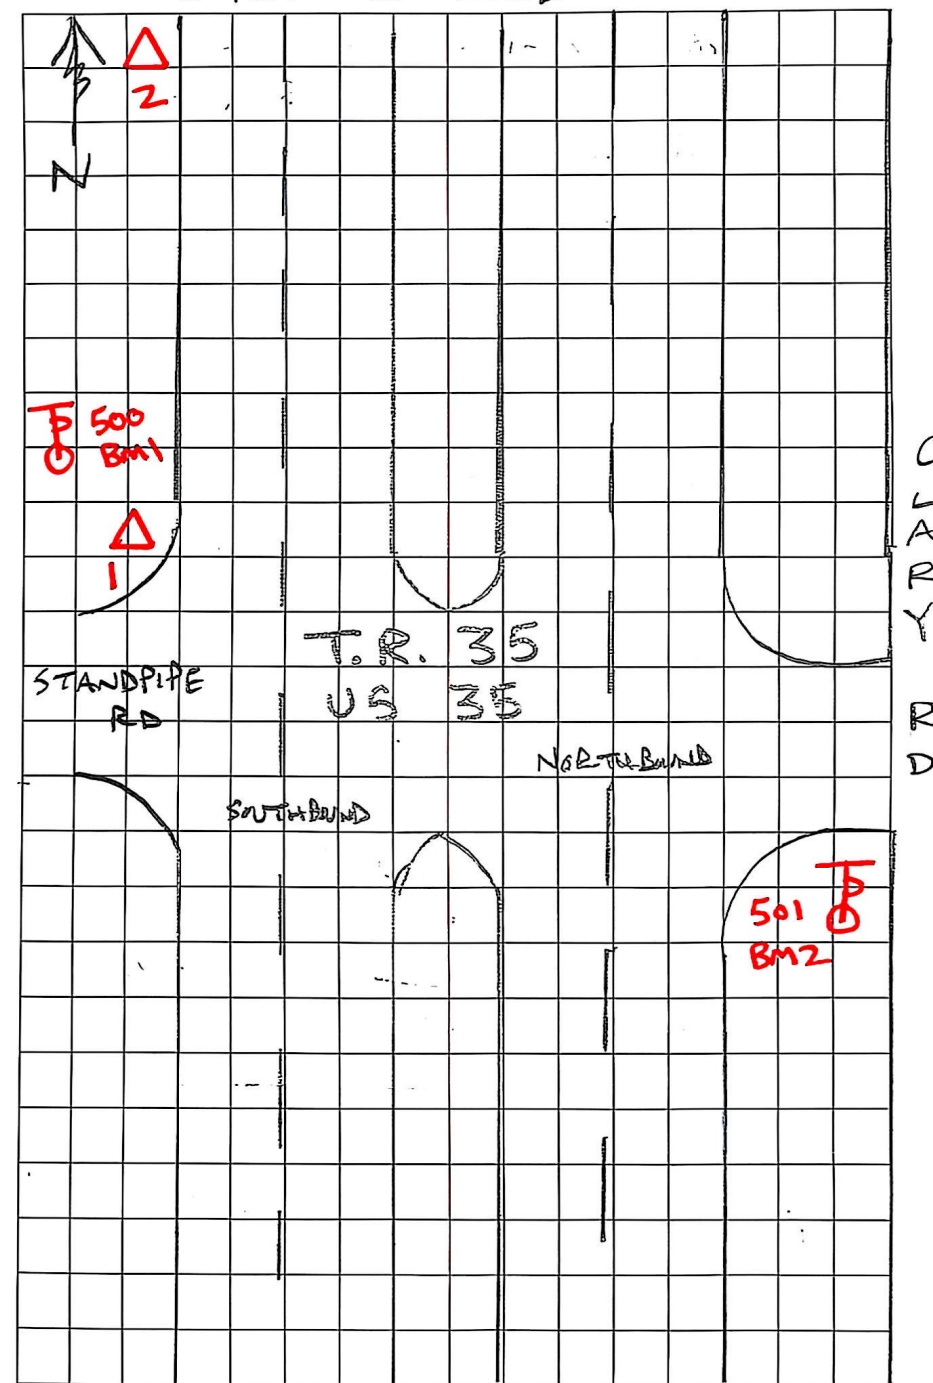

1235	"DO NOT ENTER"
------	----------------

DR	14	10-8-2025	
650		11	11

[illegible]

27" ϕ Elliptical RCP
(From CBS)

"STOP" \in

CBS * (outflow @ 1321)

11

JACKSON COUNTRY CR 55

STANDPIPE RD

"EAST 35"

"OHIO BYWAY"

"WELSH BYWAY"

"DO NOT ENTER"

'SAME AS #1236'		
-----------------	--	--

CBS	*
-----	---

⌒ @ 2 BS | 00000 HI: 5.40'
(1451-1493)

1491 "STANDPIPE RD"

