

CENTERLINE PLAT

OHIO DEPARTMENT OF HIGHWAYS

JEF-7-13.53

JEFFERSON COUNTY

287
307

R/W
1 OF 21

255699

TRANSFER NOT NECESSARY
STEPHEN J. HAMROCK
COUNTY AUDITOR

PRESENTED BY RECORD
AT 2:30
RECORDED
FILE NO.
INDEXED
BOOK OF 485.00

CURVE DATA
P.I. Sta. 683+02.61
 $\Delta = 6^{\circ}00'00''$ Lt.
 $D = 2^{\circ}59'59''$
 $R = 1910.02'$
 $T = 100.10'$
 $L = 200.02'$
P.I. Sta. 686+06.22
 $\Delta = 16^{\circ}11'21''$ Lt.
 $D = 4^{\circ}00'00''$
 $R = 1432.39'$
 $T = 203.72'$
 $L = 404.73'$
P.I. Sta. 689+07.33
 $\Delta = 6^{\circ}00'00''$ Lt.
 $D = 2^{\circ}59'59''$
 $R = 1910.02'$
 $T = 100.10'$
 $L = 200.02'$

CURVE DATA

P.I. Sta. 695+17.75
 $\Delta = 1^{\circ}30'00''$ Rt.
 $D = 1^{\circ}30'00''$
 $R = 3819.51'$
 $T = 50'$
 $L = 100.00'$
P.I. Sta. 698+94.15
 $\Delta = 13^{\circ}00'00''$ Rt.
 $D = 2^{\circ}00'00''$
 $R = 2864.79'$
 $T = 326.40'$
 $L = 650.00'$
P.I. Sta. 702+67.75
 $\Delta = 1^{\circ}30'00''$ Rt.
 $D = 1^{\circ}30'00''$
 $R = 3819.51'$
 $T = 50'$
 $L = 100.00'$

CURVE DATA

P.I. Sta. 706+48.26
 $\Delta = 4^{\circ}22'30''$ Lt.
 $D = 2^{\circ}37'29''$
 $R = 2182.86'$
 $T = 83.38'$
 $L = 166.68'$
P.I. Sta. 707+69.86
 $\Delta = 2^{\circ}40'54''$ Lt.
 $D = 3^{\circ}30'00''$
 $R = 1637.02'$
 $T = 38.32'$
 $L = 76.62'$
P.I. Sta. 708+91.54
 $\Delta = 4^{\circ}22'30''$ Lt.
 $D = 2^{\circ}37'29''$
 $R = 2182.86'$
 $T = 83.38'$
 $L = 166.68'$

CURVE DATA

P.I. Sta. 716+28.13
 $\Delta = 6^{\circ}00'00''$ Lt.
 $D = 2^{\circ}59'59''$
 $R = 1910.02'$
 $T = 100.10'$
 $L = 200.02'$
P.I. Sta. 721+25.26
 $\Delta = 31^{\circ}00'00''$ Lt.
 $D = 4^{\circ}00'00''$
 $R = 1432.39'$
 $T = 397.24'$
 $L = 775.00'$
P.I. Sta. 726+03.12
 $\Delta = 6^{\circ}00'00''$ Lt.
 $D = 2^{\circ}59'59''$
 $R = 1910.02'$
 $T = 100.10'$
 $L = 200.02'$


BEGIN PROJECT
LIMITED ACCESS
Sta. 681+95.00

CURVE DATA
P.I. Sta. 672+80.41
 $\Delta = 24^{\circ}49'55''$ Rt.
 $D = 4^{\circ}00'00''$
 $R = 1432.39'$
 $T = 315.35'$
 $L = 620.80'$
P.I. Sta. 676+85.96
 $\Delta = 6^{\circ}00'00''$ Rt.
 $D = 2^{\circ}59'59''$
 $R = 1910.02'$
 $T = 100.10'$
 $L = 200.02'$

S.R. 7 CENTERLINE MONUMENTS

- PC STA. 682+02.51
- P.C.C. " 684+02.53 Bk=684+02.50 Ahd.
- P.C.C. " 688+07.23
- P.T. " 690+07.25 Bk=690+07.88 Ahd.
- *P.C. " 694+67.75
- *P.C.C. " 695+67.75
- P.C.C. " 702+17.75
- P.T. " 703+17.75 Bk=703+19.83 Ahd.
- P.C. " 705+64.88
- P.C.C. " 707+31.56 Bk=707+31.54 Ahd.
- P.C.C. " 708+08.16
- P.T. " 709+74.84 Bk=709+74.82 Ahd.
- P.C. " 715+28.03
- P.C.C. " 717+28.05 Bk=717+28.02 Ahd.
- P.C.C. " 725+03.02
- *P.T. " 727+03.04 Bk=727+03.01 Ahd.
- P.C. " 731+52.66
- P.O.C. " 739+00
- P.T. " 746+52.66
- P.C. " 749+06.63
- P.C.C. " 750+39.96
- P.C.C. " 755+80.07
- P.T. " 757+13.40
- P.C. " 758+91.32
- P.C.C. " 760+91.34 Bk=760+91.31 Ahd.
- P.C.C. " 761+16.31
- P.T. " 763+16.33 Bk=763+16.30 Ahd.
- P.C. " 765+50.05
- P.C.C. " 767+50.07 Bk=767+50.05 Ahd.
- P.C.C. " 767+80.24
- P.T. " 769+80.26 Bk=769+80.24 Ahd.
- P.O.T. " 770+80.24 Bk=770+80.96 Ahd.

*MONUMENTS OFFSET 36.5' EACH SIDE OF CENTERLINE

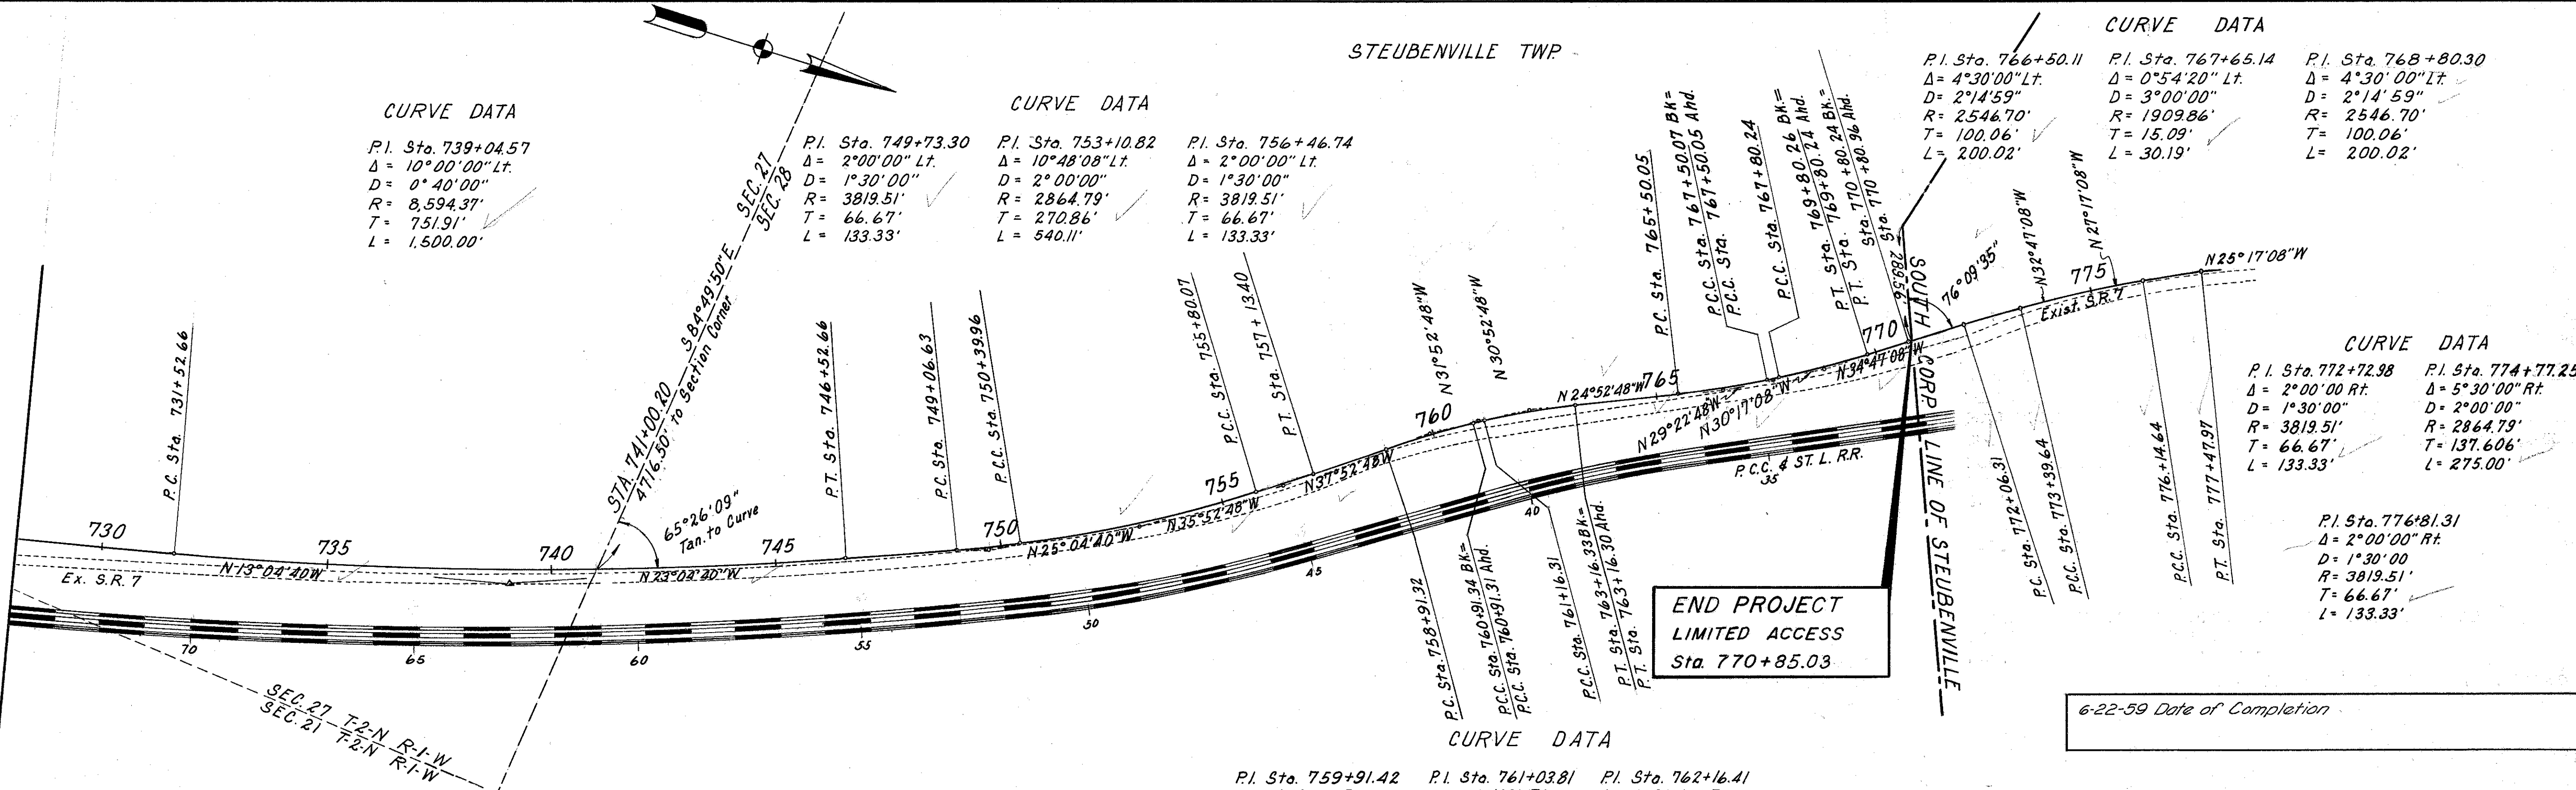


END PROJECT
LIMITED ACCESS
Sta. 770+85.03

6-22-59 Date of Completion

I hereby certify that this plat is correct to the best of my knowledge and belief.
William P. McKenna
DIVISION ENGINEER
Aug. 14, 1959
DATE

RIGHT OF WAY CENTERLINE PLAT

LOCATION PLAN JEF-7-13.53 1966 SCALE: 1" = 50'

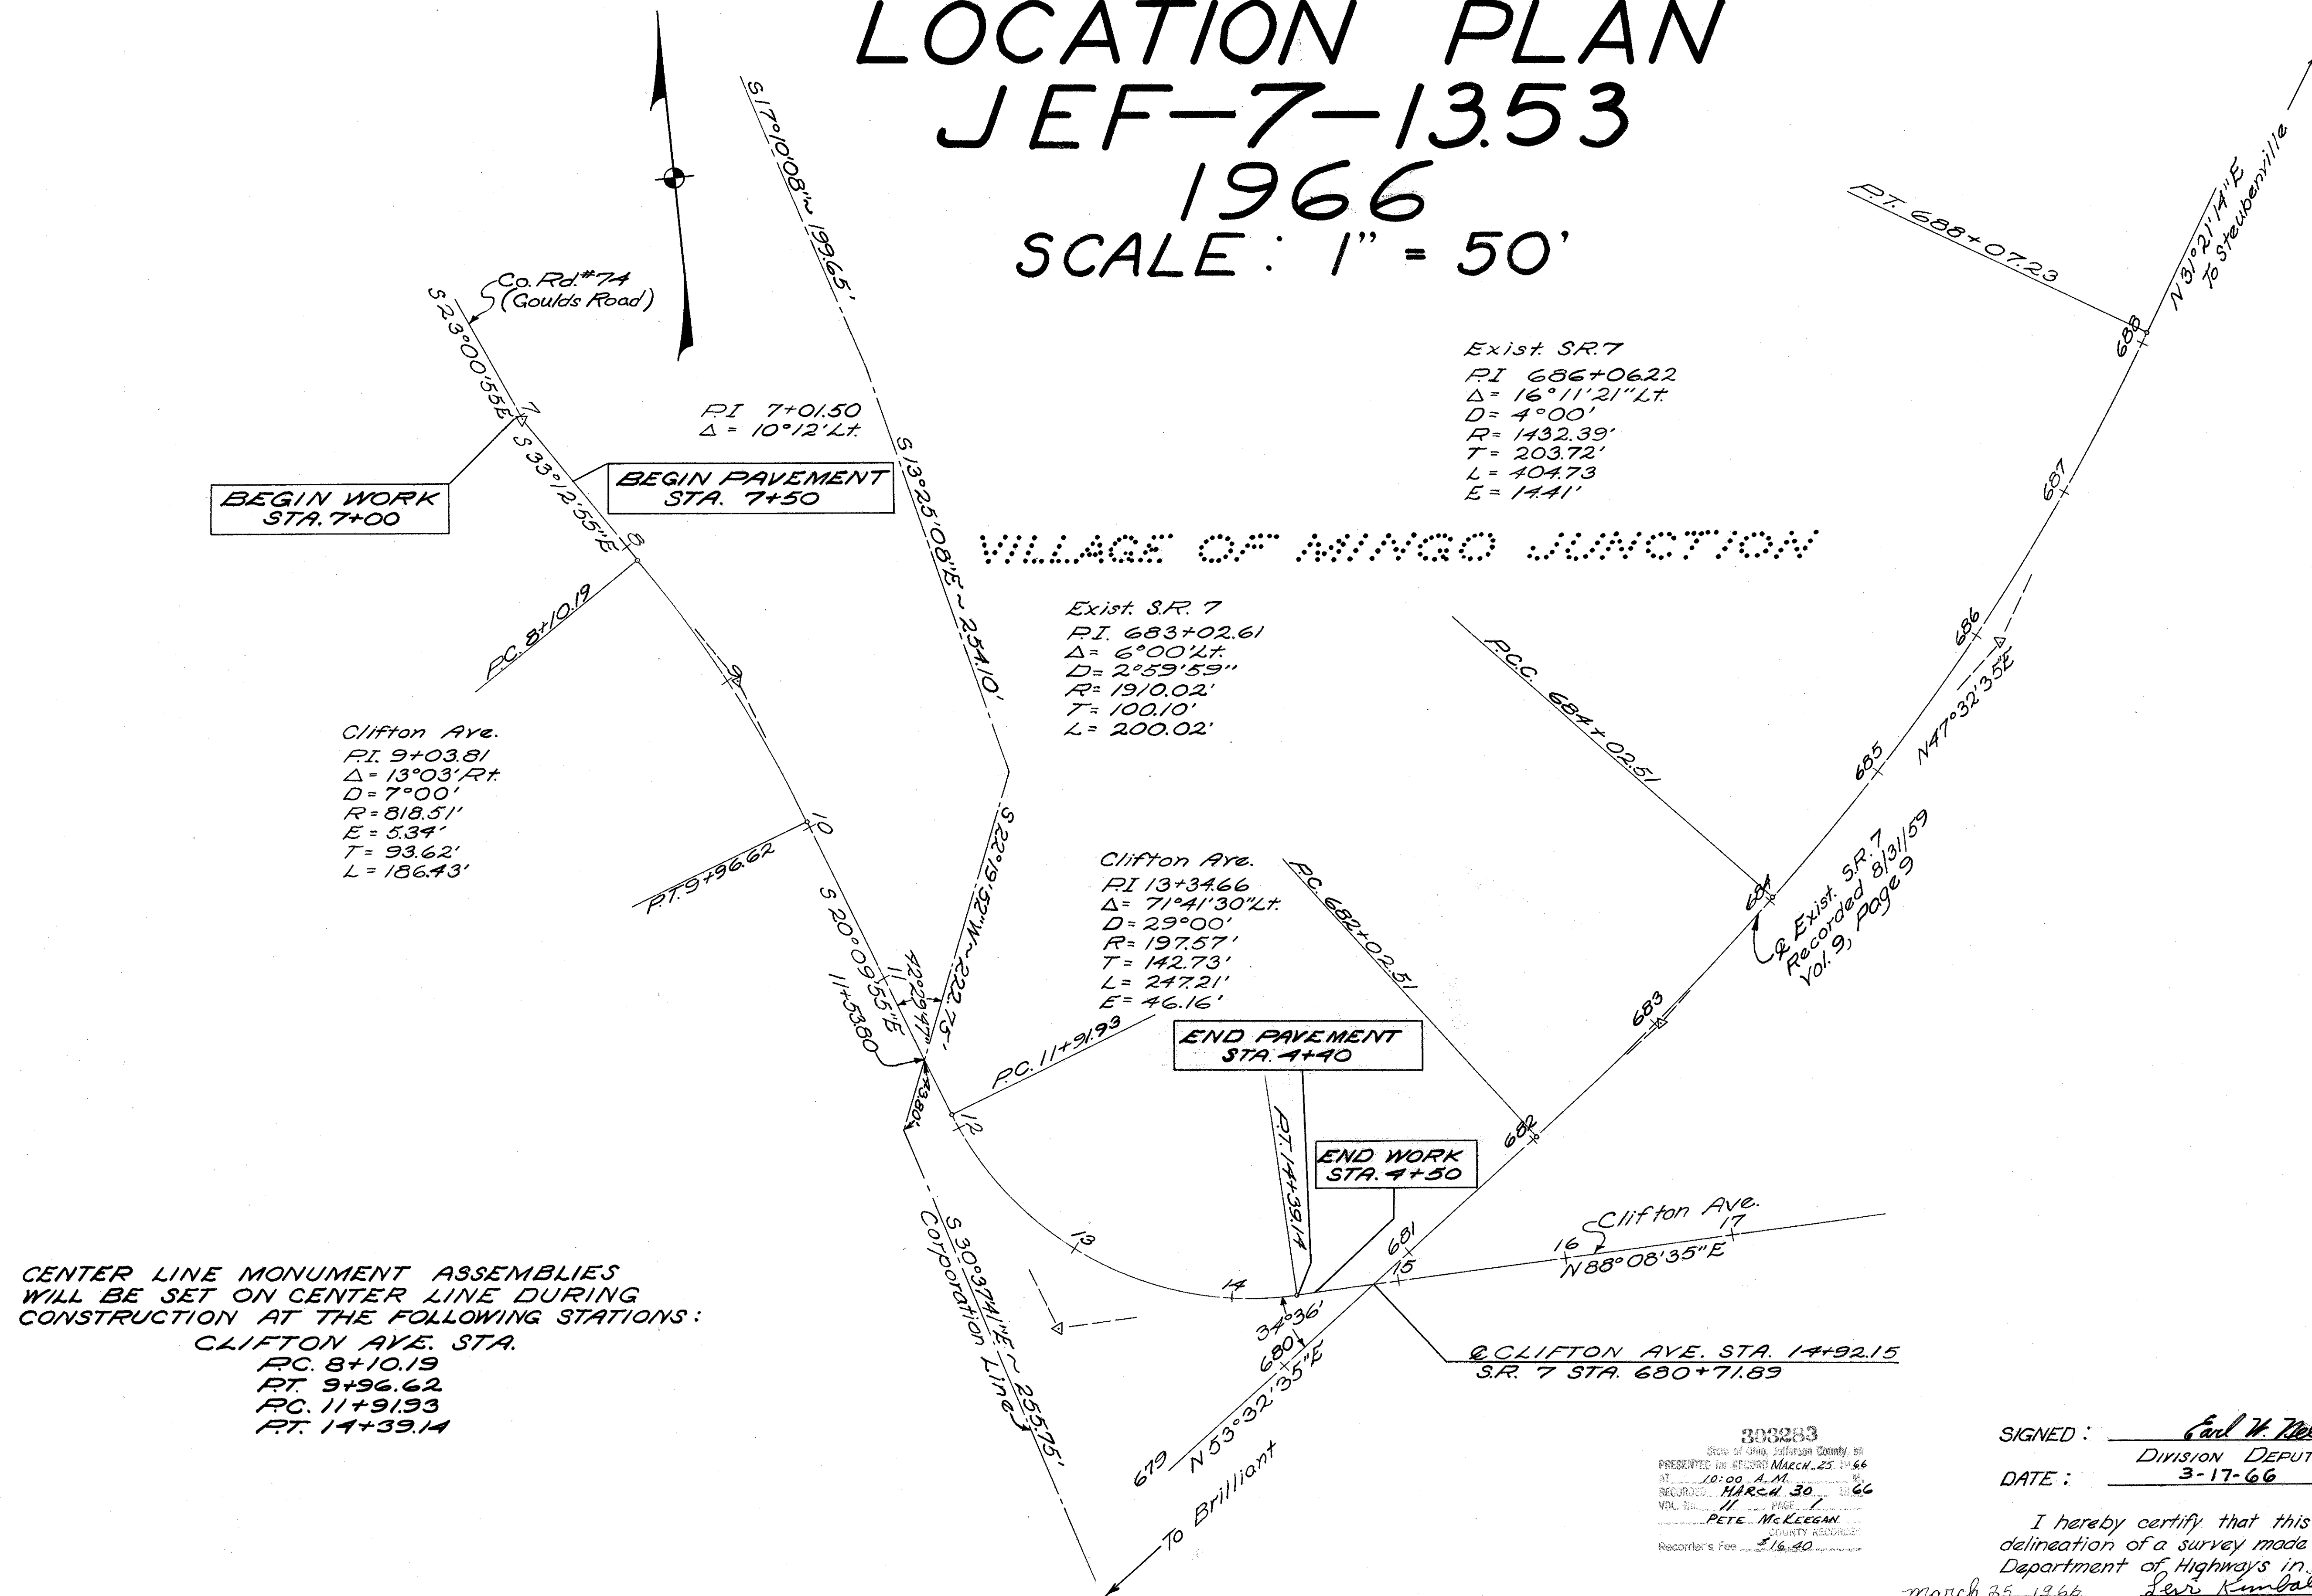

CENTER LINE MONUMENT ASSEMBLIES
WILL BE SET ON CENTER LINE DURING
CONSTRUCTION AT THE FOLLOWING STATIONS:


CLIFTON AVE. STA.
PC. 8+10.19
PT. 9+96.62
PC. 11+91.93
PT. 14+39.14

300283
State of Ohio, Jefferson County, ss
PRESENTED TO RECORD MARCH 25, 1966
AT 10:00 A.M.
RECORDED MARCH 30, 1966
VOL. 11, PAGE 1
PETE McKEEGAN
COUNTY RECORDER
Recorder's Fee \$16.40

SIGNED: Carl W. Nelson
DIVISION DEPUTY DIRECTOR
DATE: 3-17-66

I hereby certify that this plot is a true
delineation of a survey made for The Ohio
Department of Highways in 1966
Leslie Kimball
REGISTERED SURVEYOR
DATE: 3-21-66

TRANSFER NOT NECESSARY
Stephen R. Hamrock
COUNTY AUDITOR

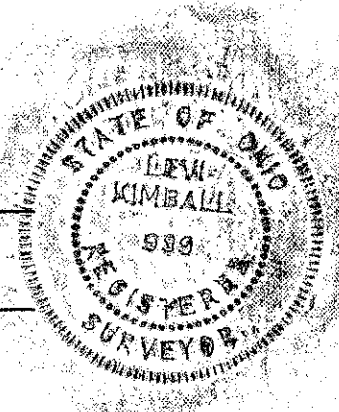

SUMMARY OF ADDITIONAL R/W REQUIRED

JEFFERSON COUNTY LIMITED ACCESS
JEF - 7-13.53 R/W
2 OF 21


Parcel No.	Owner	Area Acres	Exist. Bldgs.	Sheet No's	Remarks
98-S	P.C.C. & ST. L. RY.	—	No	3	
98-SL	P.C.C. & ST. L. RY.	0.01	No	3	
99-S	GAETANO & MARIA DEL GALLO	0.004	No	3	
100	JOHN & SUSAN ZABEN	0.06	No	3	
101	ANGELINA GARANDA	0.06	Yes	3	
102-LA	LORETO PETROZZI ETAL.	—	—	3	
103-LA	LUIGI CIOFARDONE ETAL.	—	—	3	
104-LA	MARION FABIAN ETAL.	—	—	3	
104A-LA	M. D. HALL ETAL.	0.008	Yes	3	
105-LA	ZOLA A. THOMPSON	—	—	3	
105A-LA	DOLORES Mc DONALD	0.02	No	3	
106-LA	E.C. MURRAY	—	—	3	
107-LA	WILLA L. SMITH	—	—	3	
108-LA	CATHERINE WELSH	—	—	3 & 4	
109-LA	CESARE & RESTITUTA FERRONI	—	—	4	
110-LA	JOSH WILLIAMS	—	—	4	
111-LA	FANNIE SABATINO	—	—	4	
112-LA	LEE E. & IDA M. WELLS	—	—	3 & 4	
113-LA	HUGH T. RUSSELL ETAL.	—	—	4	
114-LA	ELIZA SHELINE	—	—	4	
115-LA	MILDRED J. COX PHOENIX	—	—	4	
115-A	VILLAGE OF MINGO JUNCTION	0.11	No	4	
116-LA	MEDICO P. & RUTH MERZI	—	—	4	
116-A	RAY & HILDA MENENDES	0.05	No	4	
117-LA	EDMOND S. & EUELLA A. JOHNSON	—	—	4	
117A	VICTOR MAGARY ETAL.	0.05	Yes	4	
118-LA	G. & J.H. Mc CLAVE	0.15	Yes	4	
119-LA	P. & L. RAUCH	0.12	Yes	4	
119A-LA	RUSSELL C. HYDE & LORELLA MUTH	0.16	Yes	4	
119B-LA	BASILIO PRESTIPINO	0.03	Yes	4	
119C-LA	HELEN ZIZA ETAL.	0.002	Yes	4	
120-LA	EDWARD J. & SARA M. PFISTER	—	—	4	
121-LA	FRED & LENA R. FOX	—	—	4	
122-LA	BERTHA SELICK	—	—	4	
123-LA	JOHN VALUSKA ETAL.	—	—	4	
124-LA	MAMIE A. BUSH ETAL.	—	—	4	
125-LA	HARRY W. SMITH ETAL.	0.09	Yes	4	
125A-LA	HOFF FUNERAL HOME	0.07	Yes	4	
126	JOHN DAVANZO	0.07	Yes	4	
127	WM. J. MINCH ETAL.	—	Yes	4	
127-LA	WM. J. MINCH ETAL.	—	Yes	4	
128-LA	GEORGE E. SMITH ET AL.	—	—	4	
128A	MAGDALIN CHAPMAN	0.09	Yes	4 & 5	
128B	RUTH AVEY	0.18	Yes	4 & 5	
129-LA	RUTH L. ALBAUGH	—	—	4 & 5	
129A	BILLIE BRIGHT & EVELYN R. CHAPMAN	—	—	5	
130-LA	POTTER MEM. PRESBY. CHURCH	—	—	5	
131-LA	MILDRED MUNIS ET AL.	—	—	5	
132-LA	DANIEL G. DIORIO ETAL.	—	—	5	
133-LA	ELLEN H. ROOD	—	—	5	
134-LA	LUJUAN KOSTUR	—	—	5	
134A	EUGENE O. MAUL ETAL.	0.20	Yes	5	
135-LA	EARL D. & HETTIE BRITT	—	—	5	
136-LA	BERTHA WEISBERGER ETAL.	—	—	5	
136A	JOHN BUCKMELTER ETAL.	0.07	Yes	5	
136B	T. KANE	0.07	Yes	5	
137-LA	ANTHONY F. SHARPE ETAL.	0.16	Yes	5	
137A	N. MOLINARO ETAL.	0.08	Yes	5	
138-LA	JOHN H. BUCHAN	0.12	Yes	5	
138A	STELLA SCHAEFER	0.19	Yes	5	
139-LA	MICHAELINA CAVA	—	—	5 & 6	
140-LA	MARY E. GREEN BARTLETT	—	—	5 & 6	
140A	F.F. PFISTER	0.08	Yes	5 & 6	
141-LA	ANDREW & MARY MARCINKO	—	—	6	
141A-LA	CALVIN & ANN WHITNEY	0.10	Yes	6	
142-LA	JOHN J. BRINSKEY	0.11	Yes	6	
143-LA	JOHN H. BUCHAN	0.16	Yes	6	
144-LA	DOROTHY M. ARTHURS	—	—	6	
144A-LA	ERNESTO & MARIE BERARDUCCI	0.04	Yes	6	
144B-LA	JOS. SLATNISKE	0.01	No	6	
145-LA	JOSEPH & SUSIE KOVACS	—	—	6	
145A-LA	LAURA PIZZO FERRATO	0.08	Yes	6	
146-LA	WILLIAM & BLANCHE DEVORE	—	—	6	
146A-LA	ANDREW JOHN MATY ETAL.	0.06	Yes	6	
116-S	RAY & HILDA MENENDES	0.005	—	4	
117-S	VICTOR MAGARY	0.014	—	4	
118-S	G & J.H. Mc CLAVE	0.009	—	4	Not Acquired
126-S	JOHN DAVAZO	0.008	—	4	Not Acquired

Parcel No.	Owner	Area Acres	Exist. Bldgs.	Sheet No's	Remarks
147-LA	TOM NICOSIA ETAL.	—	—	6	
147A-LA	MARY STEPHEN KOZUP	0.05	Yes	6	
148-LA	JOSEPH SLATNISKE	—	—	6	
148A-LA	E.E. CALHOUN ETAL.	0.03	No	6	
149-LA	JOSEPH MELKO ETAL.	—	—	6	
150-LA	STEPHANIE & STEPHEN MELKO	—	—	6 & 7	
151-LA	MIKE DODASOVICH	—	—	7	
151A-LA	VILLAGE OF MINGO JUNCTION	0.03	Yes	7	
152-LA	JOHN & ANNA ANDRECHAK	—	—	7	
152A-LA	WILLARD & HELEN JUSTICE	0.03	Yes	7	
153-LA	MIKE EVANY ETAL.	—	—	7	
154-LA	SLAVISH PRESBY. CHURCH	0.19	Yes	7	
154-SL	SLAVISH PRESBY. CHURCH	0.004	No	7	
155-LA	JOSEPH I. BUCHMELTER ETAL.	—	Yes	7	
155A-LA	GEORGE & ANNA S. DZVONARIK	—	—	7	
155B-LA	PETER SLATNISKE	0.06	No	7	
156-LA	MARY GRECUA ETAL.	—	—	7	
157-LA	MARY PITOSH	—	—	7	
157A-LA	ANDREW MARCIN ETAL.	0.06	Yes	7 & 8	
158-LA	CLARENCE THOMPSON	0.13	Yes	7 & 8	
158A-LA	MARY SLATNISKE	0.13	Yes	7 & 8	
158B-LA	ANNA MATTEY	0.006	Yes	7 & 8	
159-LA	FRED & MARY DI COLA	—	—	8	
160-LA	ANDY GRANITIR	0.08	Yes	8	
161-LA	FRANK & CHIARINA BONAFEDE	—	—	8	
161A-LA	JOSEPH A. CASCIOLI	—	Yes	8	
161B-LA	MICHAEL ROBERTS	0.05	Yes	8	
162-LA	PHILLIP A. & ANGELINE BASSO	—	—	8	
163-LA	MIKE DIORIO ETAL.	0.14	Yes	8	
164-LA	MATTEO & MARIA CRUGNALE	—	—	8	
165-LA	LOUIS BRANDI	0.14	Yes	8	
166-LA	GEORGE & MARGARET TIMCHO	0.14	Yes	8 & 9	
167-LA	MIKE LESNANSKY ETAL.	—	—	8	
167A-LA	GIUSEPPE & CARMELA CASCIOLA	—	Yes	8	
168-LA	GIOVANNI D'AUVERA ETAL.	0.16	Yes	8	
169-LA	LOUIS CORTESE	0.15	Yes	8 & 9	
170-LA	MARY A. FRANKHAUSER	0.33	Yes	8 & 9	
171-LA	JOHN DI PILLO	0.14	Yes	9	
172-LA	ETHEL LOUISE ORBAN ETAL.	0.16	Yes	9	
173-LA	PASQUALE CAPOBIANCO	—	—	9	
173A-LA	ANTHONY PARISSI ETAL.	0.13	Yes	9	
173B-LA	JOHN SLIVKA ETAL.	0.14	Yes	9	
173C-LA	F. MANNARINO	0.14	Yes	9 & 10	
173D-LA	MATTHEW ZITO ETAL.	0.05	Yes	9 & 10	
173E-LA	GIUSEPPI CASCALI ETAL.	0.11	Yes	9	
173F-LA	FREELAND BURKE	0.07	Yes	9	
173G-LA	DOMENICK ORSINI & LUIGIA ORSINI	0.14	No	9 & 10	
173H-LA	MARGARET TIMCHO ETAL.	0.14	No	9, 10, 12	
174-LA	VIRGINIA DILORETO	—	Yes	9	
175-LA	VINCENZO COLETTI ETAL.	—	—	9	
176-LA	VINCENZO ORSINI	—	—	9	
177-LA	SUNDA ROSSI	—	—	9	
178-LA	MARY DIORIO ETAL.	—	—	9	
179-LA	JOE ESPOSITO	0.02	Yes	9	
179A-LA	ILONA MERJAVI	0.04	Yes	9	
179A	ILONA MERJAVI	0.008	No	11	
179B-LA	G. HOMOL JR. ETAL.	0.05	Yes	9	
179B	G. HOMOL JR. ETAL.	0.07	Yes	9 & 11	
179C-LA	R. FRATTICCI & R. GIANNAMORE	0.07	Yes	9	
179C	R. FRATTICCI & R. GIANNAMORE	0.09	Yes	9 & 11	
179D-LA	MICHAEL KUCER ETAL.	0.09	Yes	9 & 12	
179D	MICHAEL KUCER ETAL.	0.06	No	9, 11, 12, 14	
179E-LA	SANTI LEONARDO ETAL.	0.11	Yes	12	
179E	SANTI LEONARDO ETAL.	0.005	No	12 & 14	
179F-LA	ELIZABETH EVAN	0.12	Yes	12	
179G	JOSEPH P. CONLEY	0.08	Yes	11	
179H	THOMAS & ROSE SPROCHI	0.16	Yes	11	
179K	G.S. CARDUCCI ETAL.	0.07	Yes	11	
179L	JOHN GOLEC	0.005	No	11 & 14	
180-LA	ADOLFO DIORIO	—	—	9	
180A-S	P.C.C. & ST. L. RY.	—	No	19	
181-LA	MARGARET ROSS ETAL.	—	—	9	
182-LA	DOMINIC SAURO	—	—	9	
183-LA	FAUSTO ZITO ETAL.	—	—	9	
141A-S	M. J. Daplar	0.022	—	6	
144B-S	C. W. STEVENS	0.018	—	6	
145A-S	Laura Pizzoferrato	0.012	—	6	
146A-S	Andrew John Maty	0.008	—	6	

Parcel No.	Owner	Area Acres	Exist. Bldgs.	Sheet No's	Remarks
184-LA	JOHN & ANNA DICENZO	—	—	9 & 12	
185-LA	PATRICK J. REIDY	—	—	12	
185A-LA	HERBERT HUGGINS ETAL.	0.14	Yes	12 & 13	
185B-LA	GERTRUDE JOHNSON	0.22	No	12 & 13	
185B	GERTRUDE JOHNSON	0.05	No	13	
185C	THOMAS A. WATSON	0.13	Yes	13	
186-LA	ALFRED A. ADYNIEC	0.07	No	12	
187-LA	CARMELA SANFILIPPO	0.36	Yes	12	
188-LA	ELIZABETH EVAN	0.22	Yes	12	
189-LA	VILLAGE OF MINGO JUNCTION	0.10	No	12	
190-LA	VILLAGE OF MINGO JUNCTION	0.25	No	12 & 13	
190A	E.A. BOARD ETAL.			13	NEED WA FOR RET WALL & STEPS
190B	M. CONNOR ETAL.			13	NEED WA FOR RET WALL & STEPS
190C	E.P. CONNOR	0.003	Yes	13	NEED WA FOR RET WALL & STEPS
190D	ALFRED ROTELLA	0.06	Yes	13	
191-LA	ANNA TOTH GRANAT	0.12	Yes	12	
191A-LA	FRANK FORTUNATO ETAL.	0.001	No	14	
191B-LA	LUIGI PETRELLA ETAL.	0.014	Yes	14	
191C-LA	JOHN H. BUCHAN ETAL.	0.03	Yes	14	
191D-LA	THOS. C. MITCHELL ETAL.	0.04	Yes	14	
191E-LA	R. STINARD ETAL.	0.04	Yes	14	
191F-LA	J. PETROSKEY ETAL.	0.06	Yes	14	
191G-LA	SADIE L. GLENN	0.07	Yes	14	
191H-LA	NORFOLK OLDHAM ETAL.	0.05	Yes	14	
191J-LA	NICK RUSEN	0.05	Yes	14	
192-LA	ANNA BALAK	0.39	Yes	12	
193-LA	CHARLES B. LANMAN ETAL.	3.86	No	12 & 15	
194-LA	STEPHEN & ANNA HAMROCK	0.07	No	12	
195-LA	ROBERTA SIGESMUND BROWN	0.07	Yes	12	
199-LA	VIRGIL L.M. FLIPPEN	0.28	Yes	12 & 15	
200-LA	FRANK PERGI, SR. & S.J. HAMROCK	0.15	No	15	
202-LA	FRANK BRUNNER	0.07	No	15	
203-LA	JOHN W. PORTER ETAL.	0.003	No	15	
204-LA	RUSSELL JACKSON ETAL.	0.04	Yes	15	
205-LA	OSCAR A. GASSER	0.05	Yes	15	
206-LA	ROCCO CRUGNALE	0.05	No	15	
207-LA	MICHAEL BELARDINE ETAL.	0.06	Yes	15	
208-LA	JOSEPH CONNORS	0.07	Yes	15	
209-LA	ANTHONY SHARPE ETAL.	0.08	No	15	
210-LA	EMILY A. SHARPE	0.09	Yes	15	
211-LA	JOSEPH J. JACOBS ETAL.	0.19	Yes	15	
212-LA	EMMET C. SANDERS ETAL.	0.21	Yes	15	
213-LA	J. & F. MILES	0.13	Yes	15	
214-LA	ADOLF BEREN ETAL.	7.46	Yes	15 & 16	
214S	ADOLF BEREN ETAL.	0.009	No	15	
214A-S	P.C.C. & ST. L. RY.	—	No	19	
215-LA	BRETTELL COAL CO.	10.61	No	16 & 17	
217-LA	WILLIAM A. HAESE	1.78	No	17	
218-LA	MYRON J. WYANT	2.40	No	17	
219-LA	Wheeling Steel Co.	1.23	No	17	
167B-LA	DOM. ROBERTO & DELINA ROBERTS	0.07	Yes	8	
179J	ROMEO J. DI LEONARDO	0.16	Yes	11	
216-LA	MARIE HAGERTY	0.37	No	17	
173DA-LA	JOSEPH & ROSE EMANUEL	0.17	Yes	9 & 10	
119D-LA	WILLIAM C. OTTE	0.02	No	4 & 4A	
171A-LA	ALFRED DIORIO	0.08	Yes	9	
185D	VILLAGE OF MINGO JUNCTION	0.10	No	13	
159A-LA	ANDY GRANITIR	0.09	Yes	8	
216A-LA	LOUIS BERKMAN	0.07	No	17	
147A-S	Mary Stephen Kozup	0.016	—	6	
148A-S	E.E. Calhoun ETAL.	0.001	—	6	
203-S	John W. Porter ETAL.	0.009	—	15	Not Acq
204-S	Russell Jackson ETAL.	0.01	—	15	Not Acq
205-S	Oscar Gasser	0.006	—	15	Not Acq
211A-S	Alfonzo Tarrieri	0.013	—	15	Not Acq
212-S	Emmet C. Sanders ETAL.	0.004	—	15	Not Acq
141AB-S	C.W. Stevens ETAL.	0.014	—	6	
191-DI-LA	Thos. C. Mitchell et al.	0.055	—	14	
191-EI-LA	R. Stinard et al.	0.045	—	14	
191-FI-LA	J. Petroskey et al.	0.035	—	14	
191-GI-LA	Sadie L. Glenn	0.025	—	14	
191-HI-LA	Norfolk Oldham et al.	0.010	—	14	
191-JI-LA	Nick Rusen	0.008	—	14	
148-B-LA	Geo. B. Stephenson	—	—	6	LA Only
152-B	Willard & Helen Justice	0.020	No	7	
220	George & Anna Gerouch	0.006	Yes	7	

6-22-59	Date of Completion
7-3-59	Revised Parcels 185-C & 185-D
12-22-59	Revised Parcels 185-C & 185-D
2-19-60	Revised Sewer Easement Parcels
5-17-60	Revised - Added Parcel No. 219-LA
4-12-61	Added Parcel Nos. 191-DI-LA, 191-EI-LA, 191-FI-LA, 191-GI-LA, 191-HI-LA & 191-JI-LA.

FED. RD. DIVISION	STATE	PROJECT	
2	OHIO	U-430(14)	

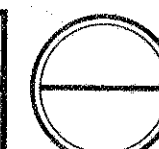[illegible]

SUMMARY OF ADDITIONAL RIW REQUIRED

Begin Const
Sta. 2+25

22

FED. RD. DIVISION	STATE	PROJECT	TYPE FUNDS
2	OHIO	U-430(14)	

JEFFERSON COUNTY
JEF -7-13.53
LIMITED ACCESS
R/W
3 OF 21


STUEBENVILLE TWP
SEC. 27 T2 R1

CURVE DATA
P.I. Sta. 683+02.61
 $\Delta = 6^{\circ}00'17''$
 $D = 2^{\circ}58'59''$
 $R = 1910.02'$
 $T = 100.10'$
 $L = 200.02'$

CLIFTON ST. - CURVE DATA

P.I. Sta. 3+48.73
 $\Delta = 62^{\circ}26'00''$ Lt.
 $D = 32^{\circ}30'$
 $R = 176.30'$
 $T = 106.84'$
 $L = 192.10'$

P.I. Sta. 6+99.98
 $\Delta = 3^{\circ}12'00''$ Lt.
 $D = 3^{\circ}00'$
 $R = 1909.86'$
 $T = 53.35'$
 $L = 106.67'$

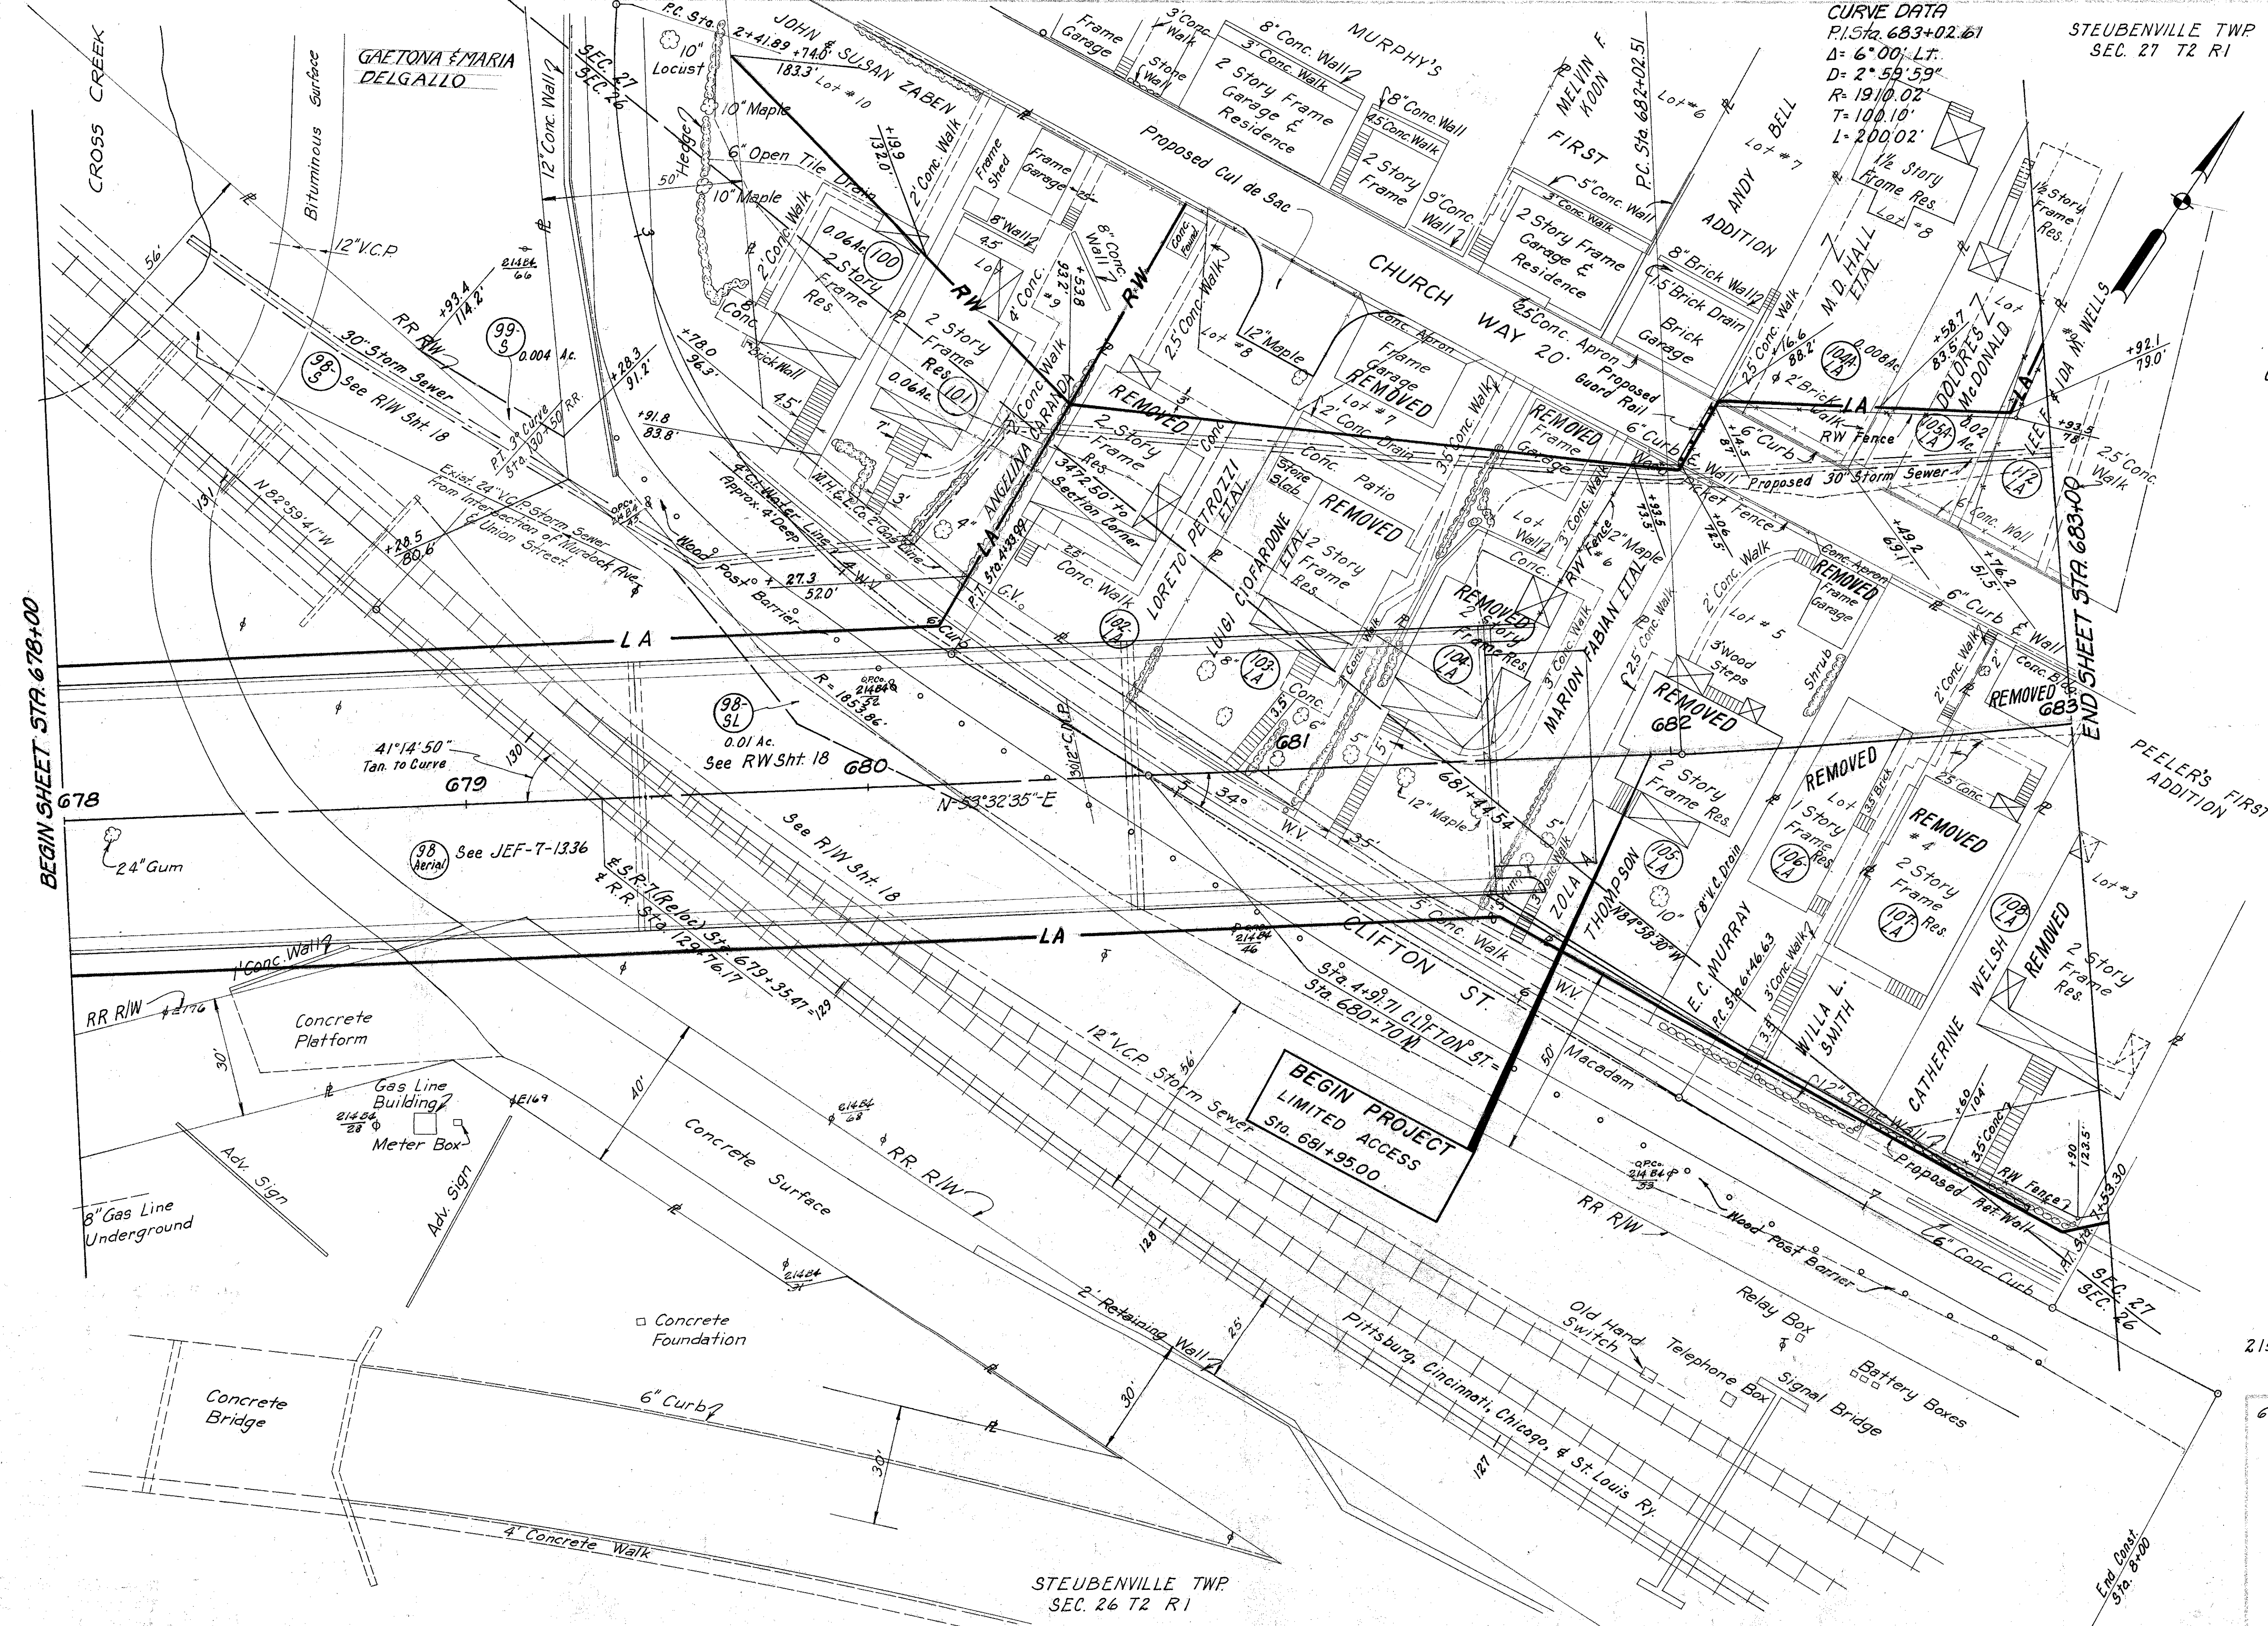


215 L.F. Type "C" Fence

Scale 1"=20'
6-22-59 Date of Completion

STUEBENVILLE TWP
SEC. 26 T2 R1

RIGHT OF WAY STA. 678 +00 TO STA. 683 +00

JEFFERSON COUNTY
JEF-7-13.53
LIMITED ACCESS
R/W
4 OF 21

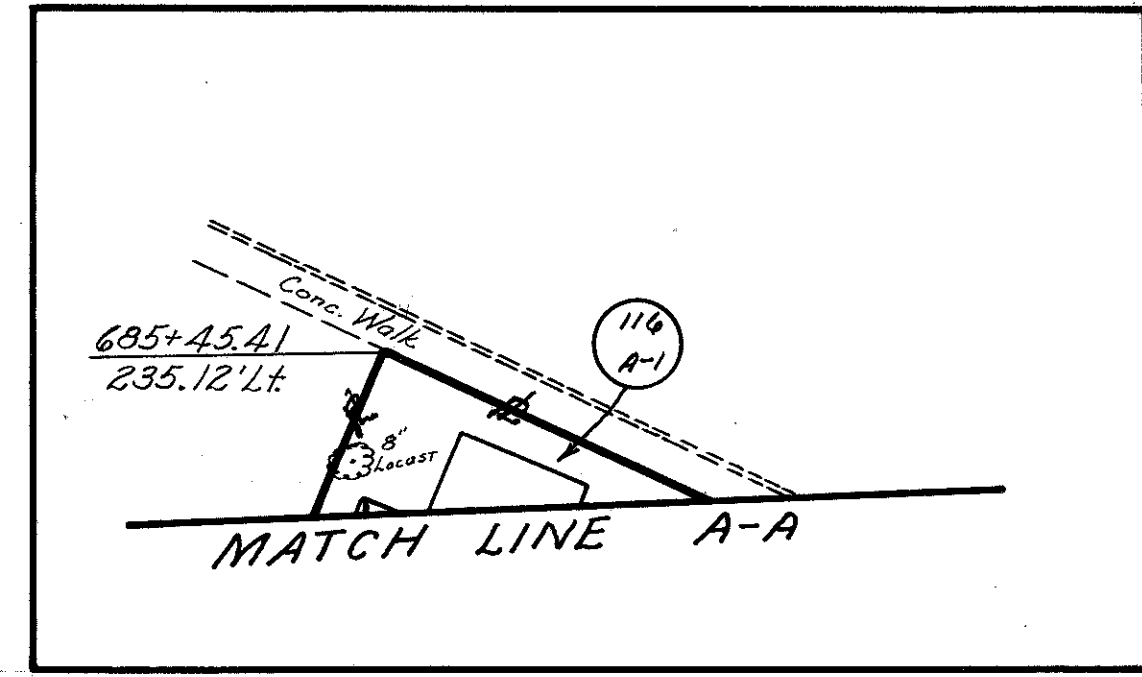


Parcel	Remarks
118-5	Not Acquired
126-5	Not Acquired

1070 L.F. Type "C" Fence

Scale 1" = 20'
6-22-59 Date of Completion

CURVE DATA
P.I. Sta. 683+02.61
Δ = 6°00'00" LT.
D = 2°59'33"
R = 1910.02'
T = 100.10'
L = 200.02'

CURVE DATA
P.I. Sta. 686+06.22
Δ = 14°11'21" LT.
D = 4°00'00"
R = 432.40'
T = 203.77'
L = 404.73'

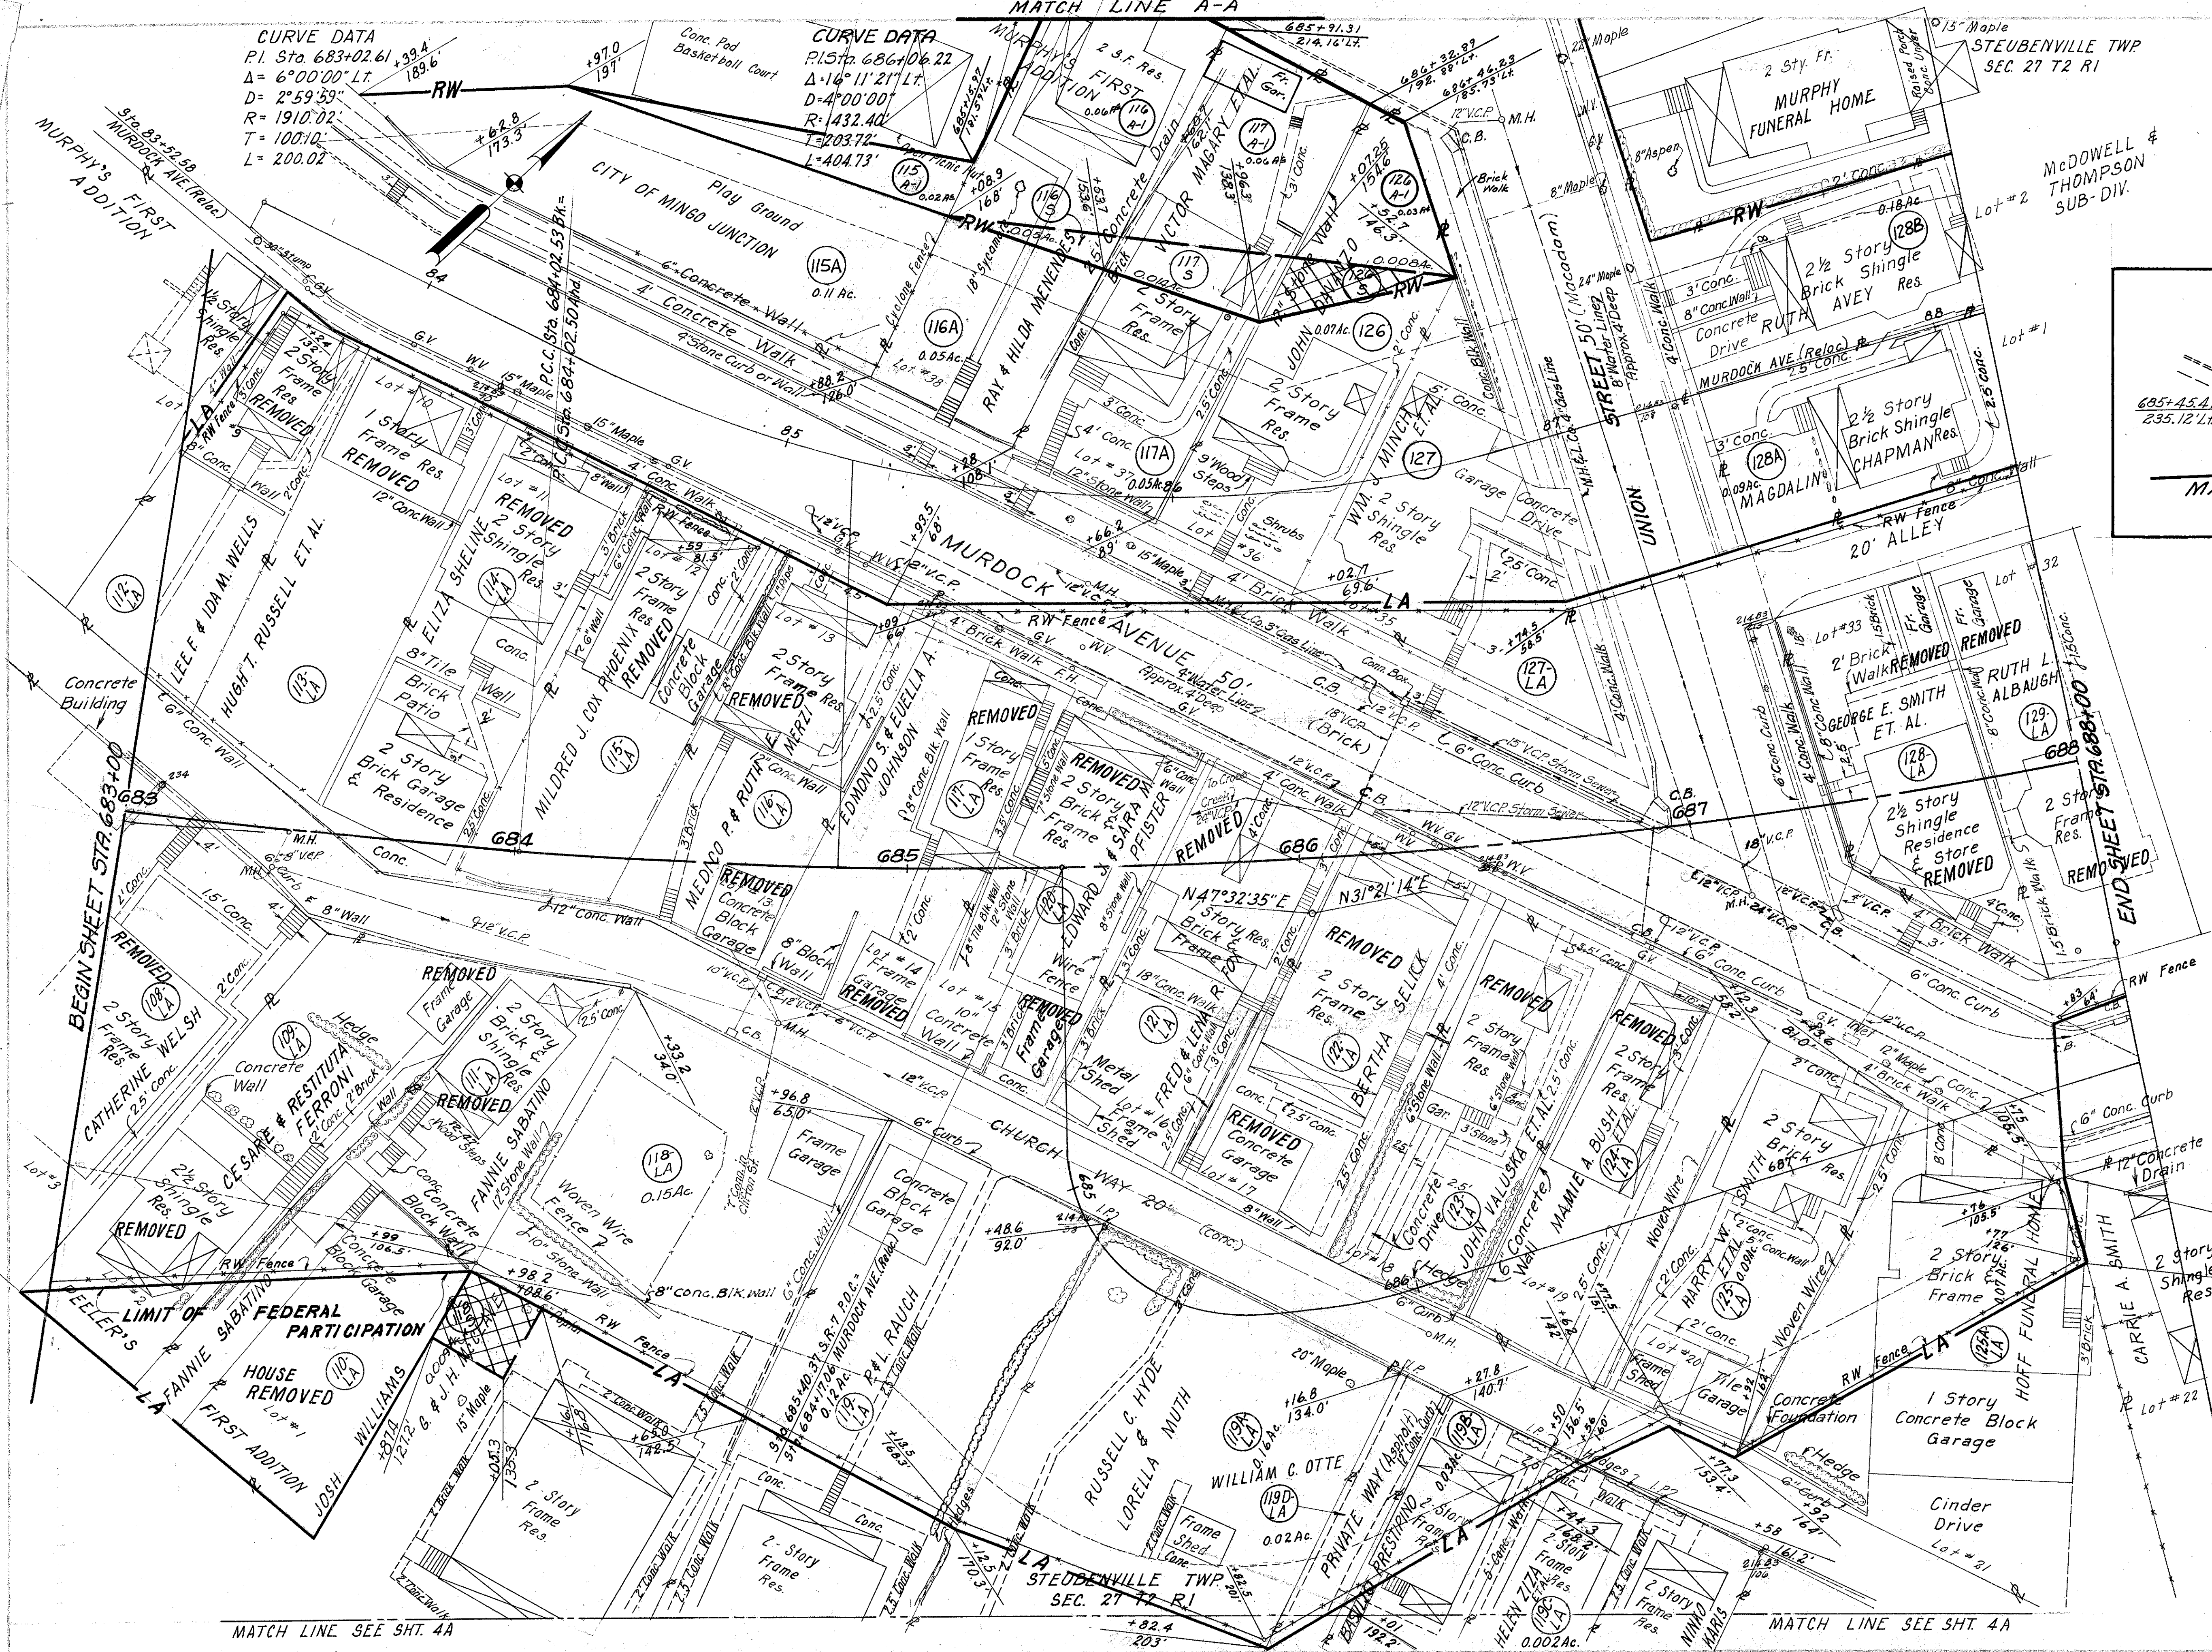


MATCH LINE SEE SHT. 4A

MATCH LINE SEE SHT. 4A

RIGHT OF WAY STA. 683+00 TO STA. 688+00

JEFFERSON COUNTY
JEF -7-13.53
LIMITED ACCESS
R/W
4A OF 21

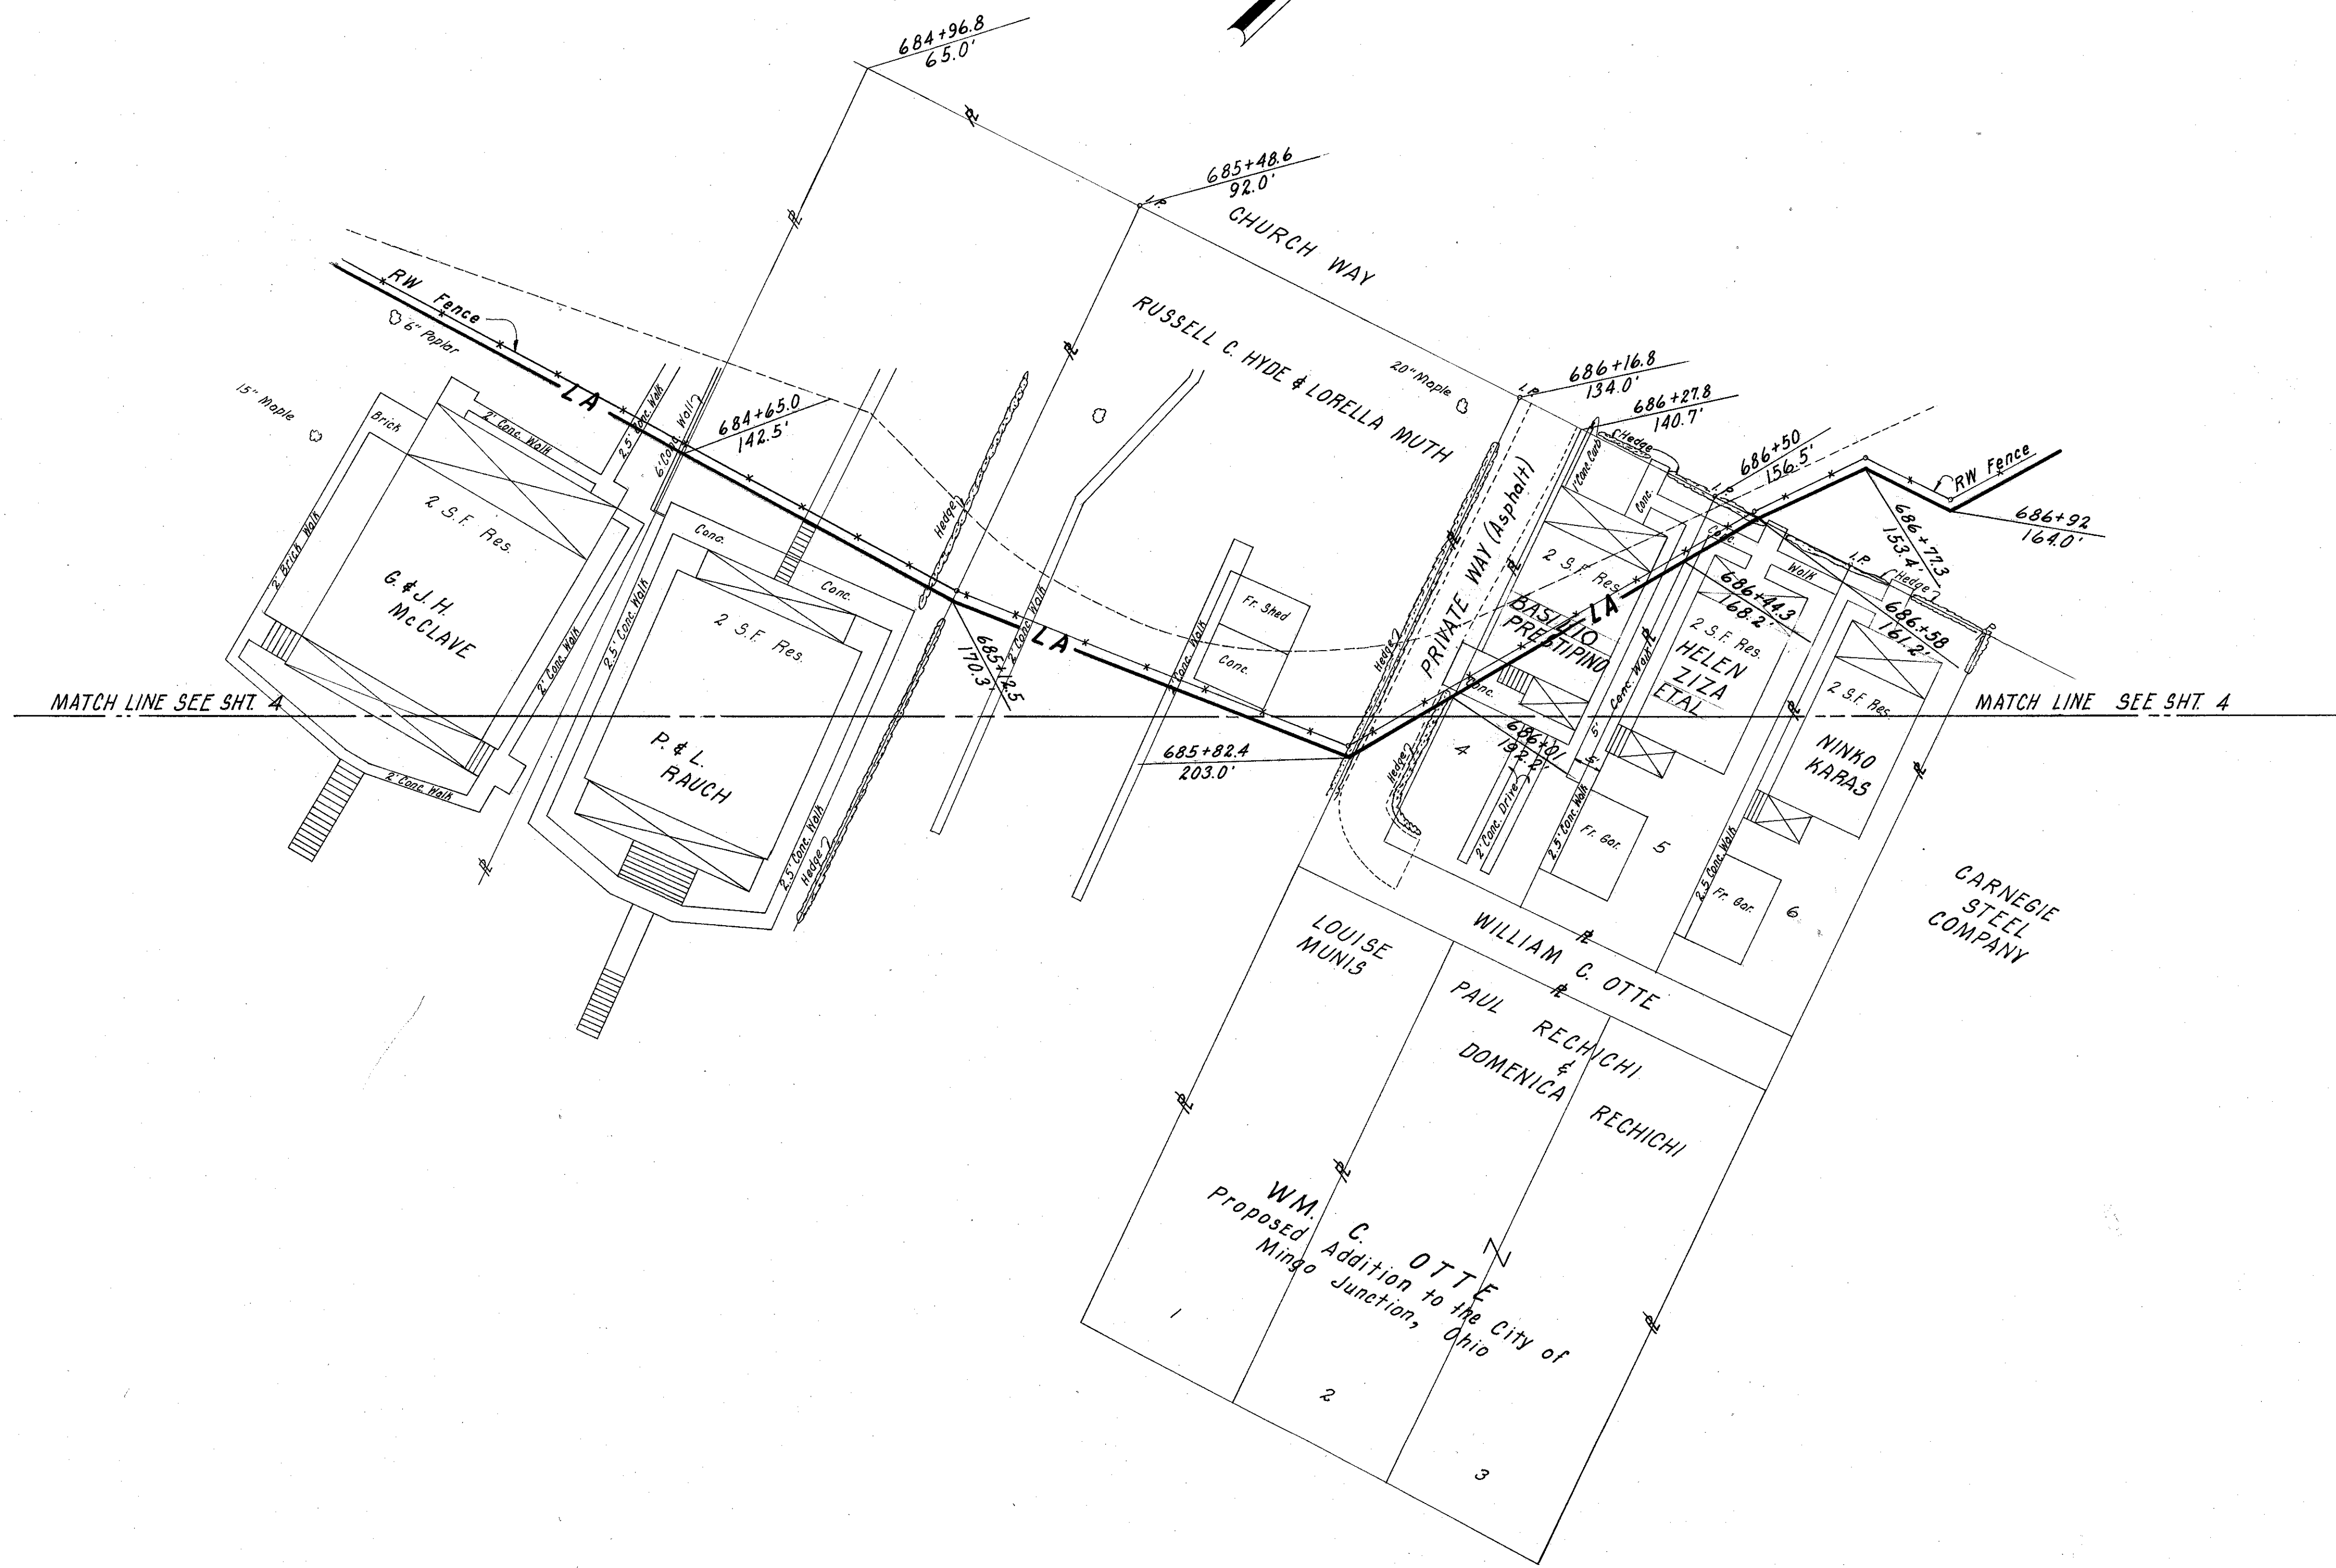

Scale 1"=20'

6-22-59 Date of Completion

CURVE DATA
P.I. Sta. 686+06.22
Δ = 16°11'21" L.T.
D = 4°00'00"
R = 1432.40'
T = 203.72'
L = 404.73'

Mc DOWELL & THOMPSON
SUB-DIV.

CURVE DATA
P.I. Sta. 689+07.33
Δ = 6°00'00" L.T.
D = 2°59'59"
R = 1910.02'
T = 100.10'
L = 200.02'


STEBENVILLE TWP.
SEC. 27 T2N R1-W

SPRING AVE. 30'
DEMPSEY'S PROP. ADDITION

FED. RD. DIVISION	STATE	PROJECT	TYPE FUNDS
2	OHIO	U-430(14)	

292
307

JEFFERSON COUNTY
JEF-7-13.53
LIMITED ACCESS
R/W
5 OF 21

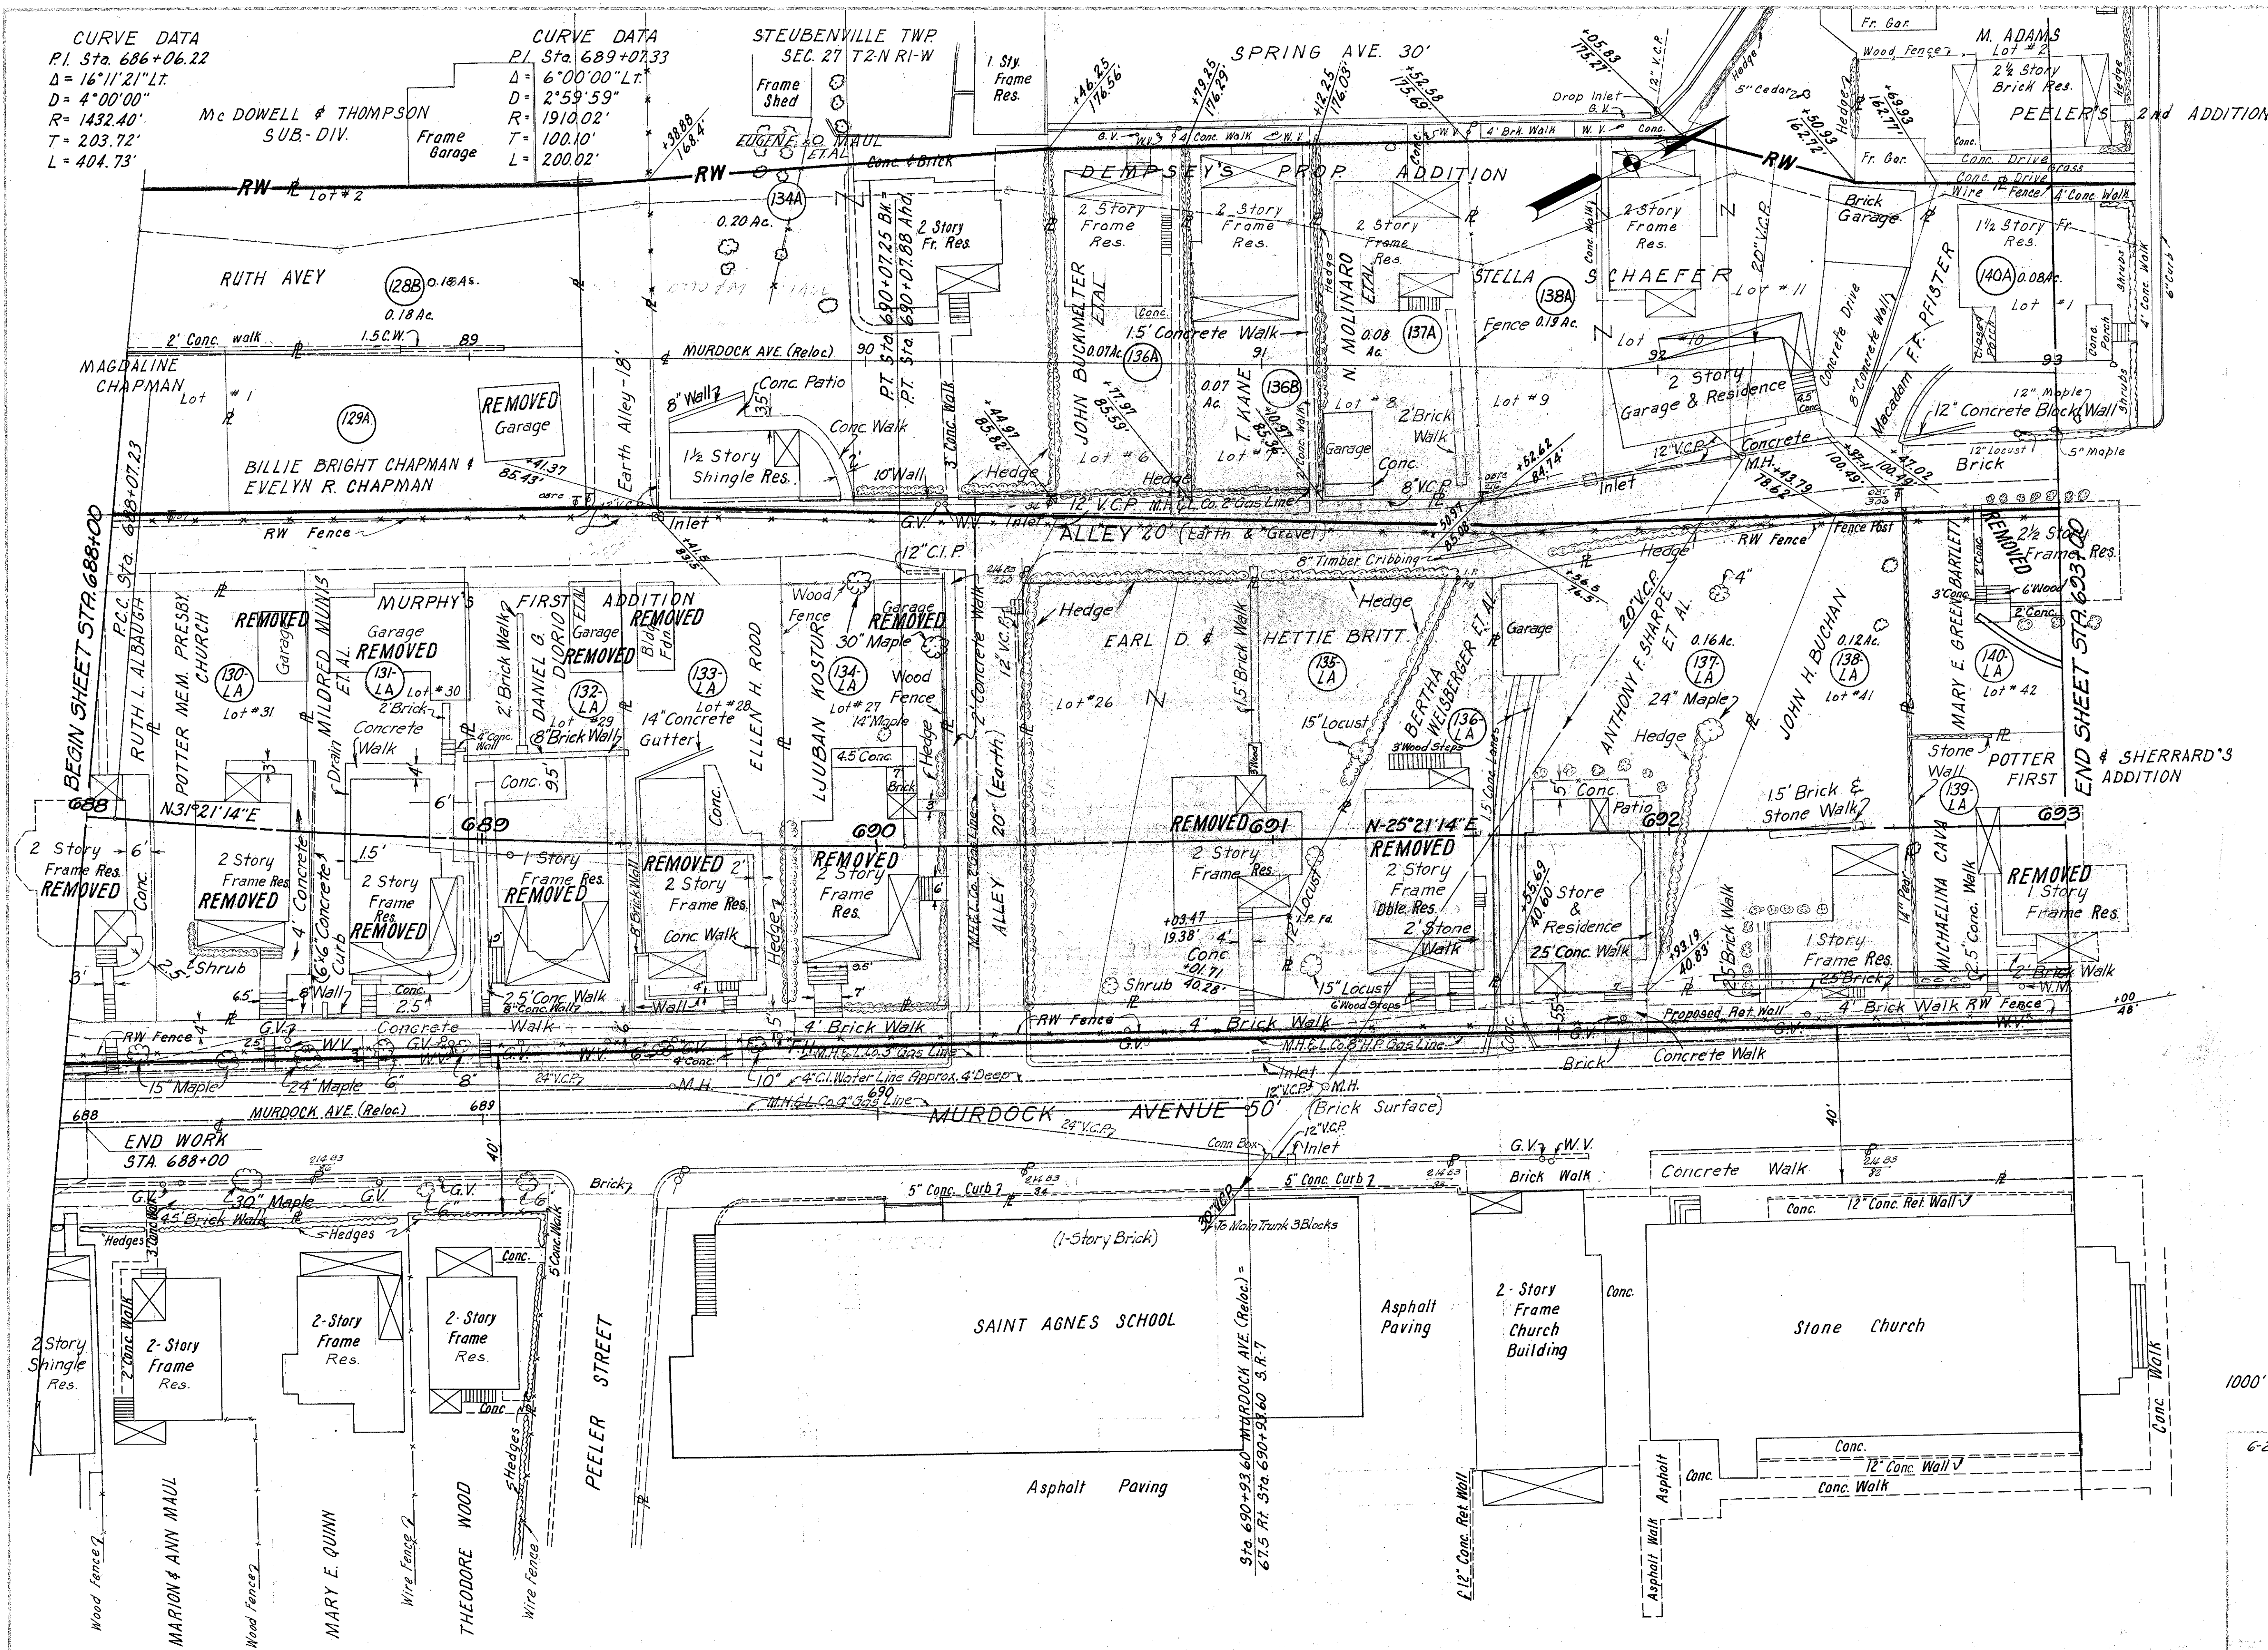

1000' L.F. Type "C" Fence

Scale 1"=20'
6-22-59 Date of Completion

CURVE DATA
PI Sta. 695+17.75
 $\Delta = 1^{\circ}30'00''$ RH
 $D = 1^{\circ}30'00''$
 $R = 3819.51'$
 $T = 50.00'$
 $L = 99.99'$

STEBENVILLE TWP.
SEC. 27 T2-N R1-W


CURVE DATA
PI Sta. 698+94.15
 $\Delta = 13^{\circ}00'00''$ RH
 $D = 2^{\circ}00'00''$
 $R = 2864.79'$
 $T = 326.40'$
 $L = 650.00'$

FED. RD. DIVISION	STATE	PROJECT	
2	OHIO	U-430 (14)	

293
307

JEFFERSON COUNTY
JEF-7-13.53
LIMITED ACCESS
R/W
6 OF 21


SPRING STREET (Macadam)

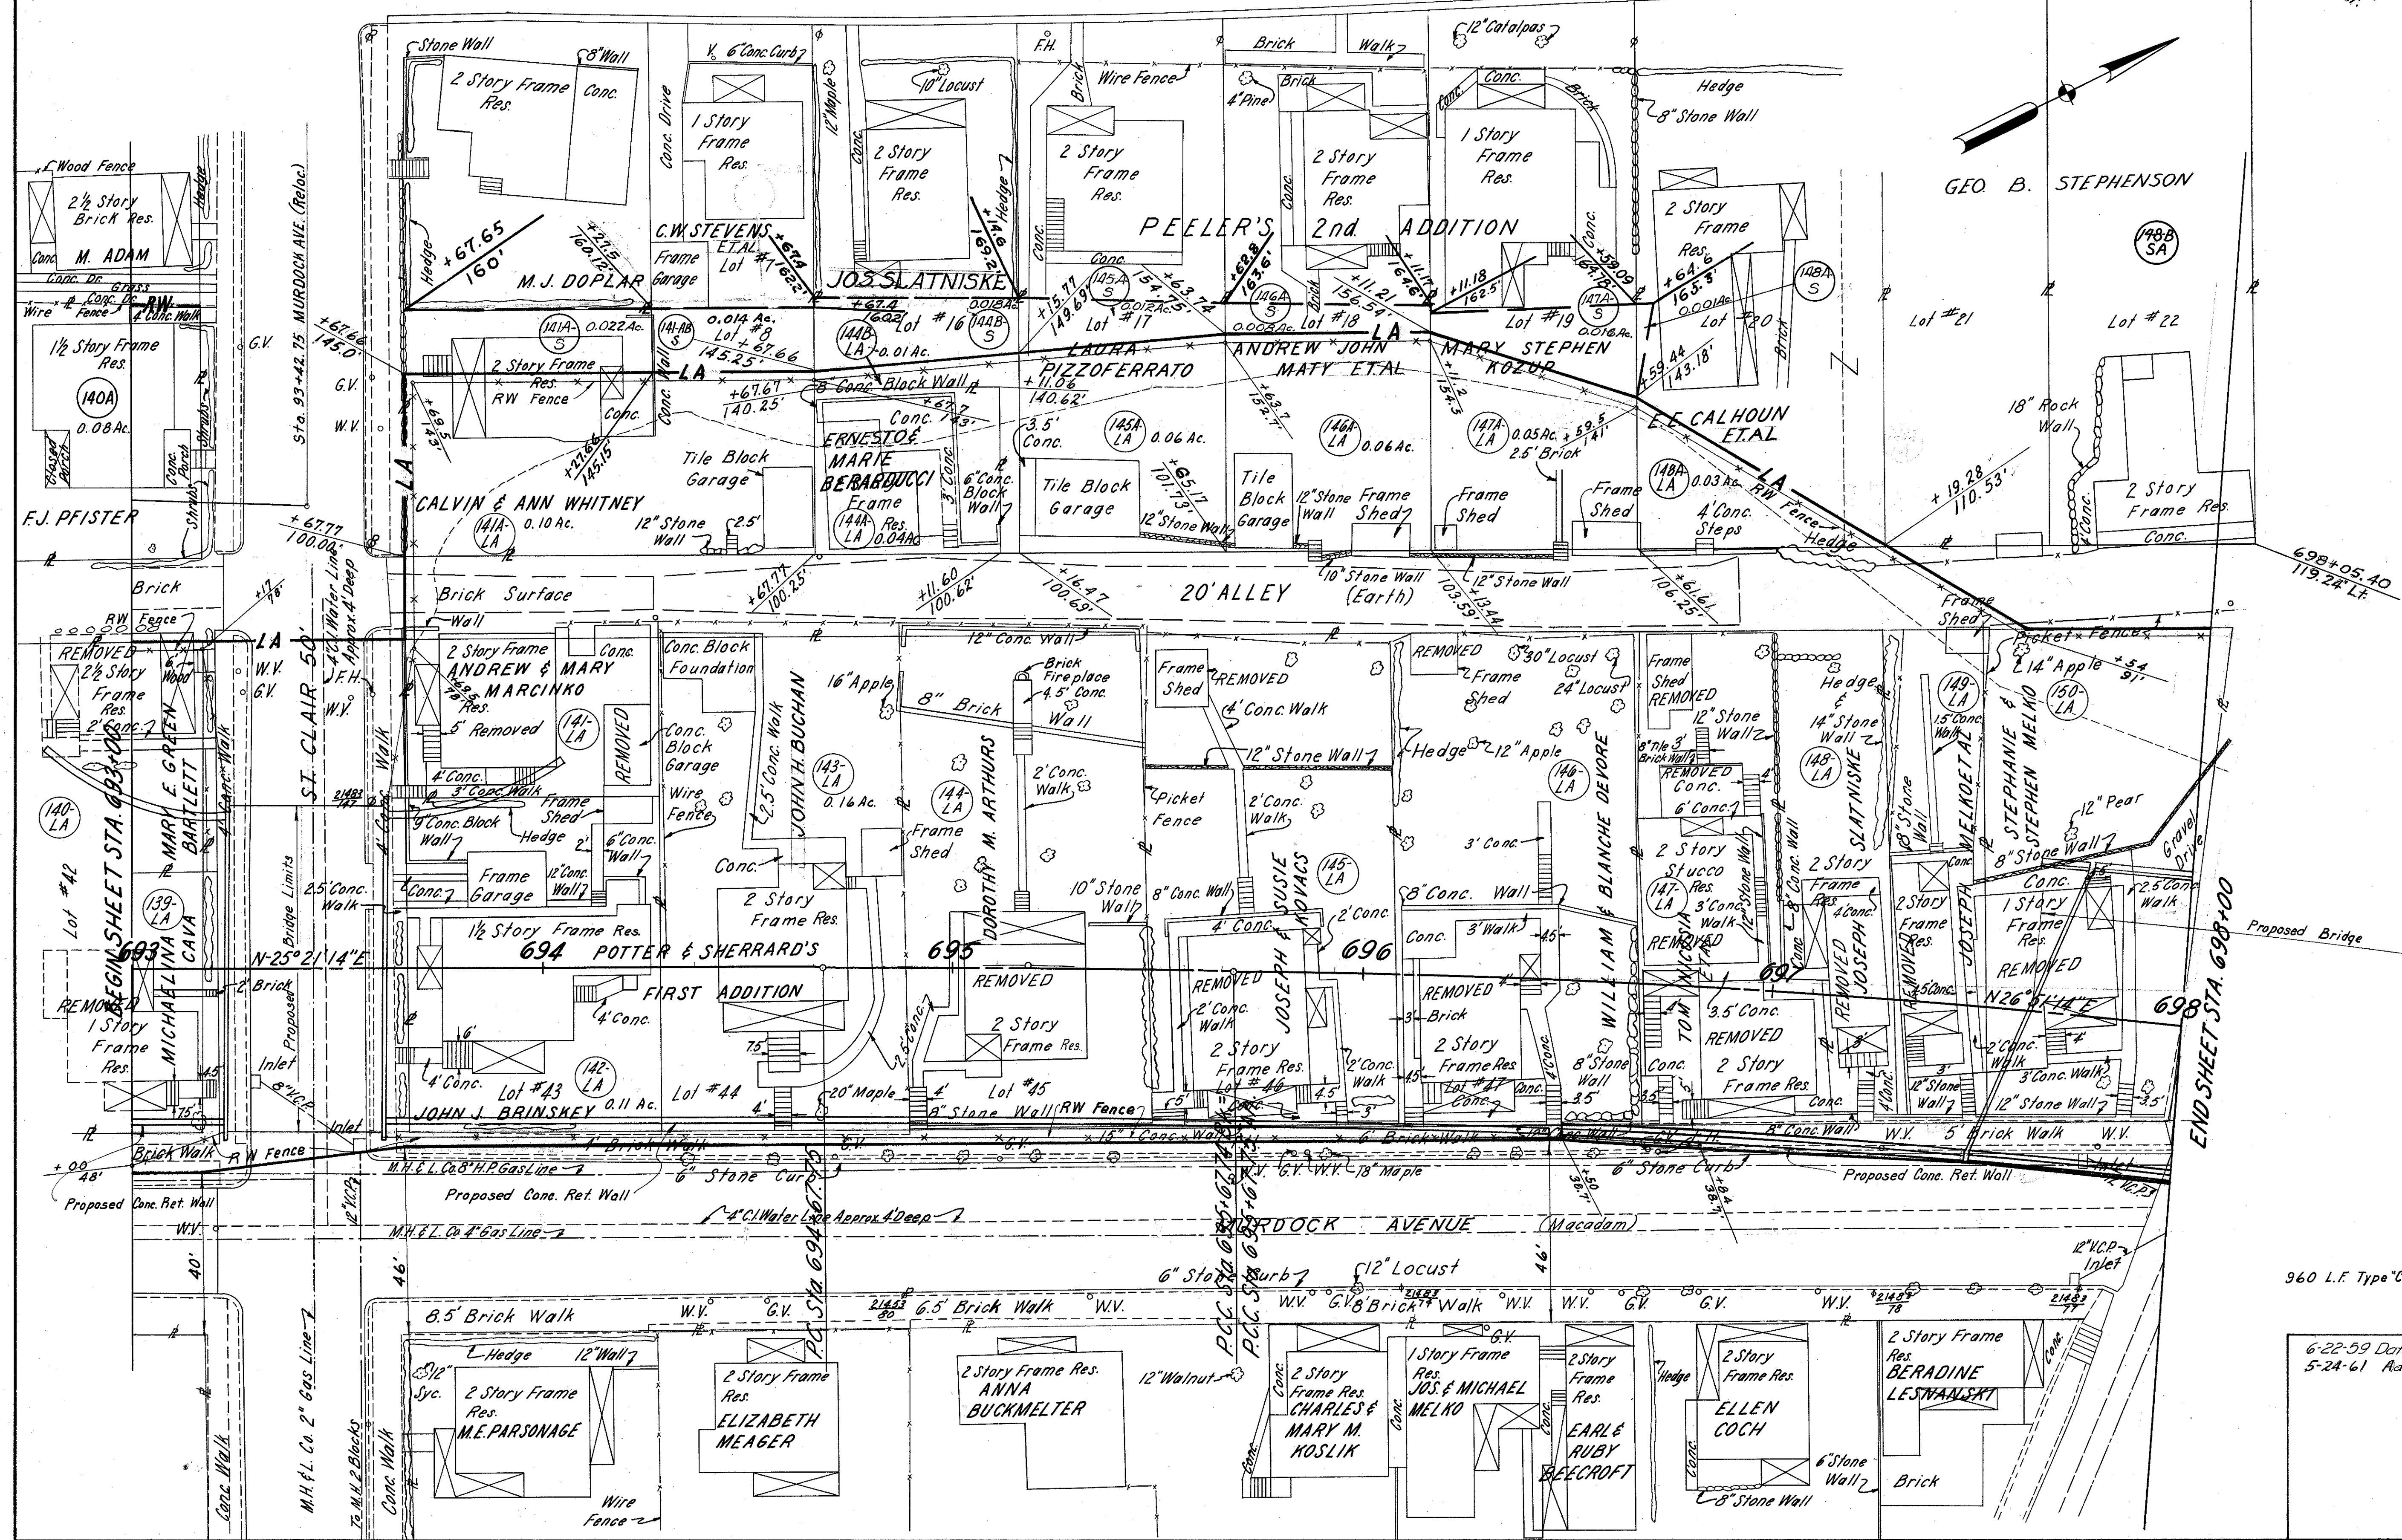

960 L.F. Type "C" Fence

Scale 1"=20'
6-22-59 Date of Completion
5-24-61 Added plusses on parcel No. 148-B-LA

JEFFERSON COUNTY
JEF-7-13.53
LIMITED ACCESS
R/W
7 OF 21

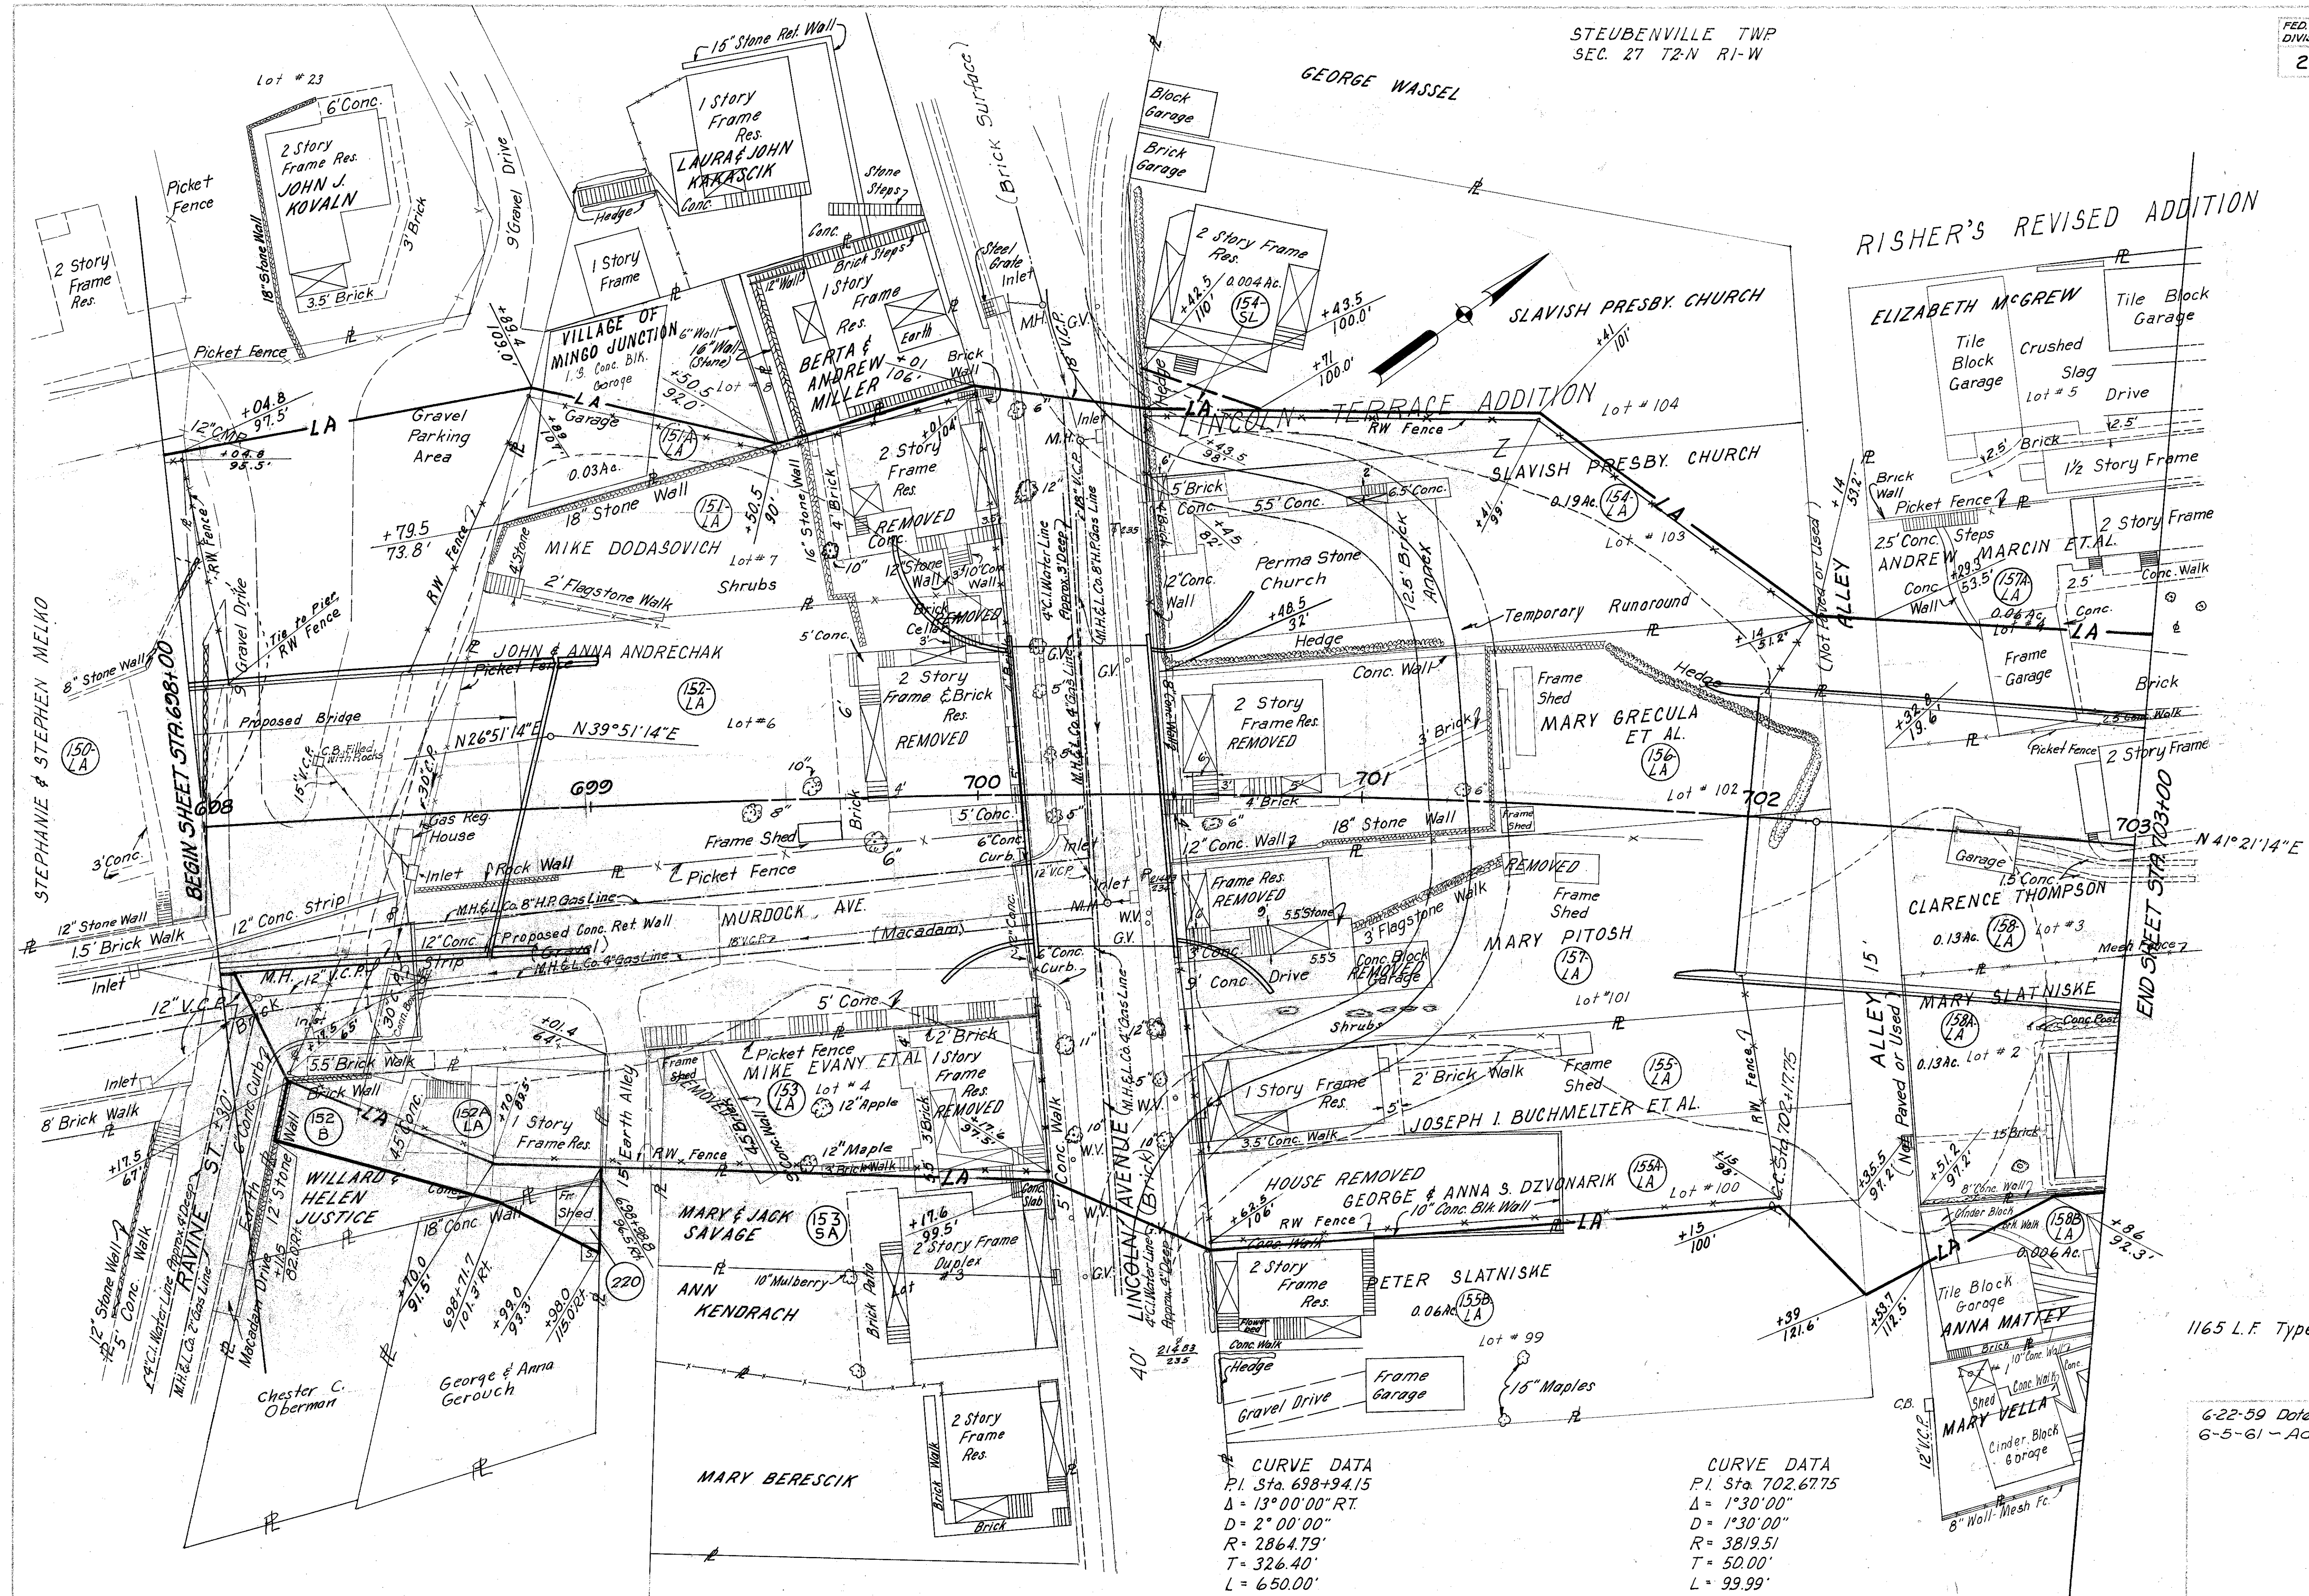

CURVE DATA
P.I. Sta. 698+94.15
Δ = 13° 00' 00" RT.
D = 2° 00' 00"
R = 2864.79'
T = 326.40'
L = 650.00'

CURVE DATA
P.I. Sta. 702.6775
Δ = 1° 30' 00"
D = 1° 30' 00"
R = 3819.51'
T = 50.00'
L = 99.99'


1165 L.F. Type "C" Fence
Scale 1" = 20'
6-22-59 Date of Completion
6-5-61 - Added Parcel 152-B & 202

JEFFERSON COUNTY
JEF-7-13.53
LIMITED ACCESS
R/W
8 OF 21

CURVE DATA
P.I. Sta. 702+67.75
Δ = 1°30'00" Rt.
D = 1°30'00"
R = 3819.51'
T = 50.00'
L = 99.99'

CURVE DATA
P.I. Sta. 706+48.26
Δ = 4°22'30" Lt.
D = 2°37'29"
R = 2182.86'
T = 83.38'
L = 166.68

CURVE DATA
P.I. Sta. 707+69.86
Δ = 2°40'54" Lt.
D = 3°30'00"
R = 1637.02'
T = 38.32'
L = 76.62'

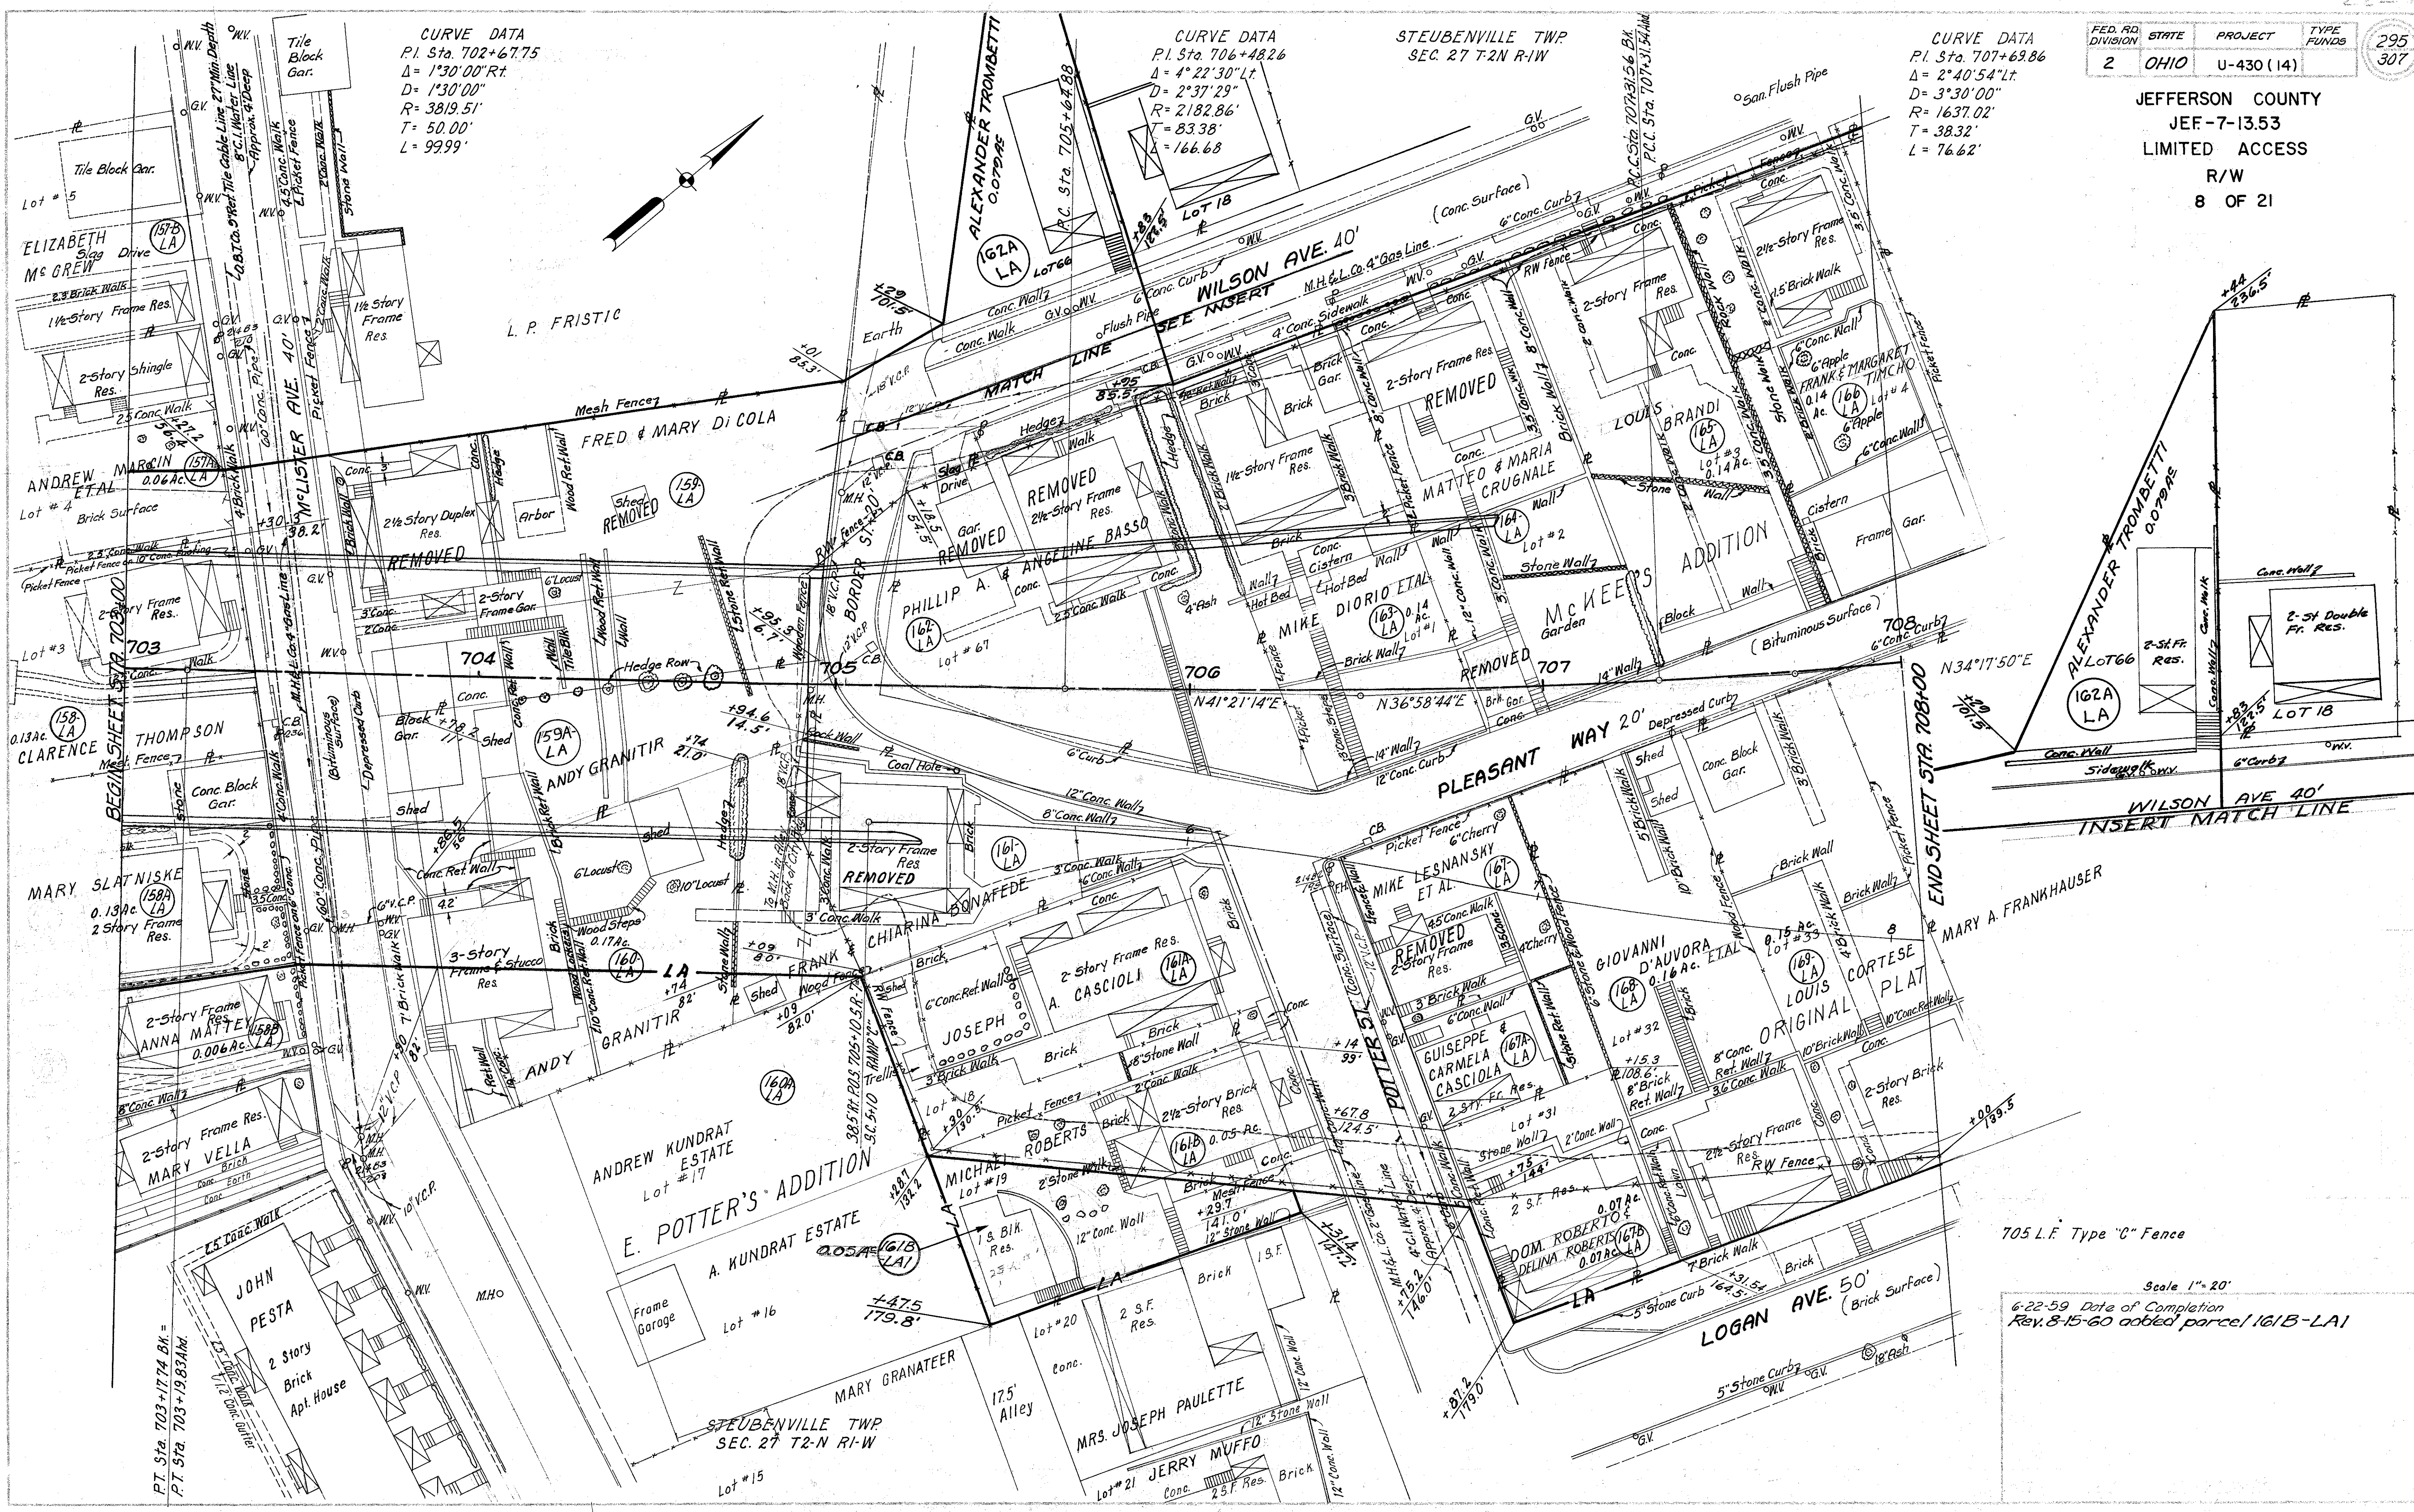


FED. RD. DIVISION	STATE	PROJECT	
2	OHIO	U-430 (14)	

296
307


JEFFERSON COUNTY
JEF-7-13.53
LIMITED ACCESS
R/W
8A OF 21

STEUBENVILLE TWP
SEC. 27 T2 R-1

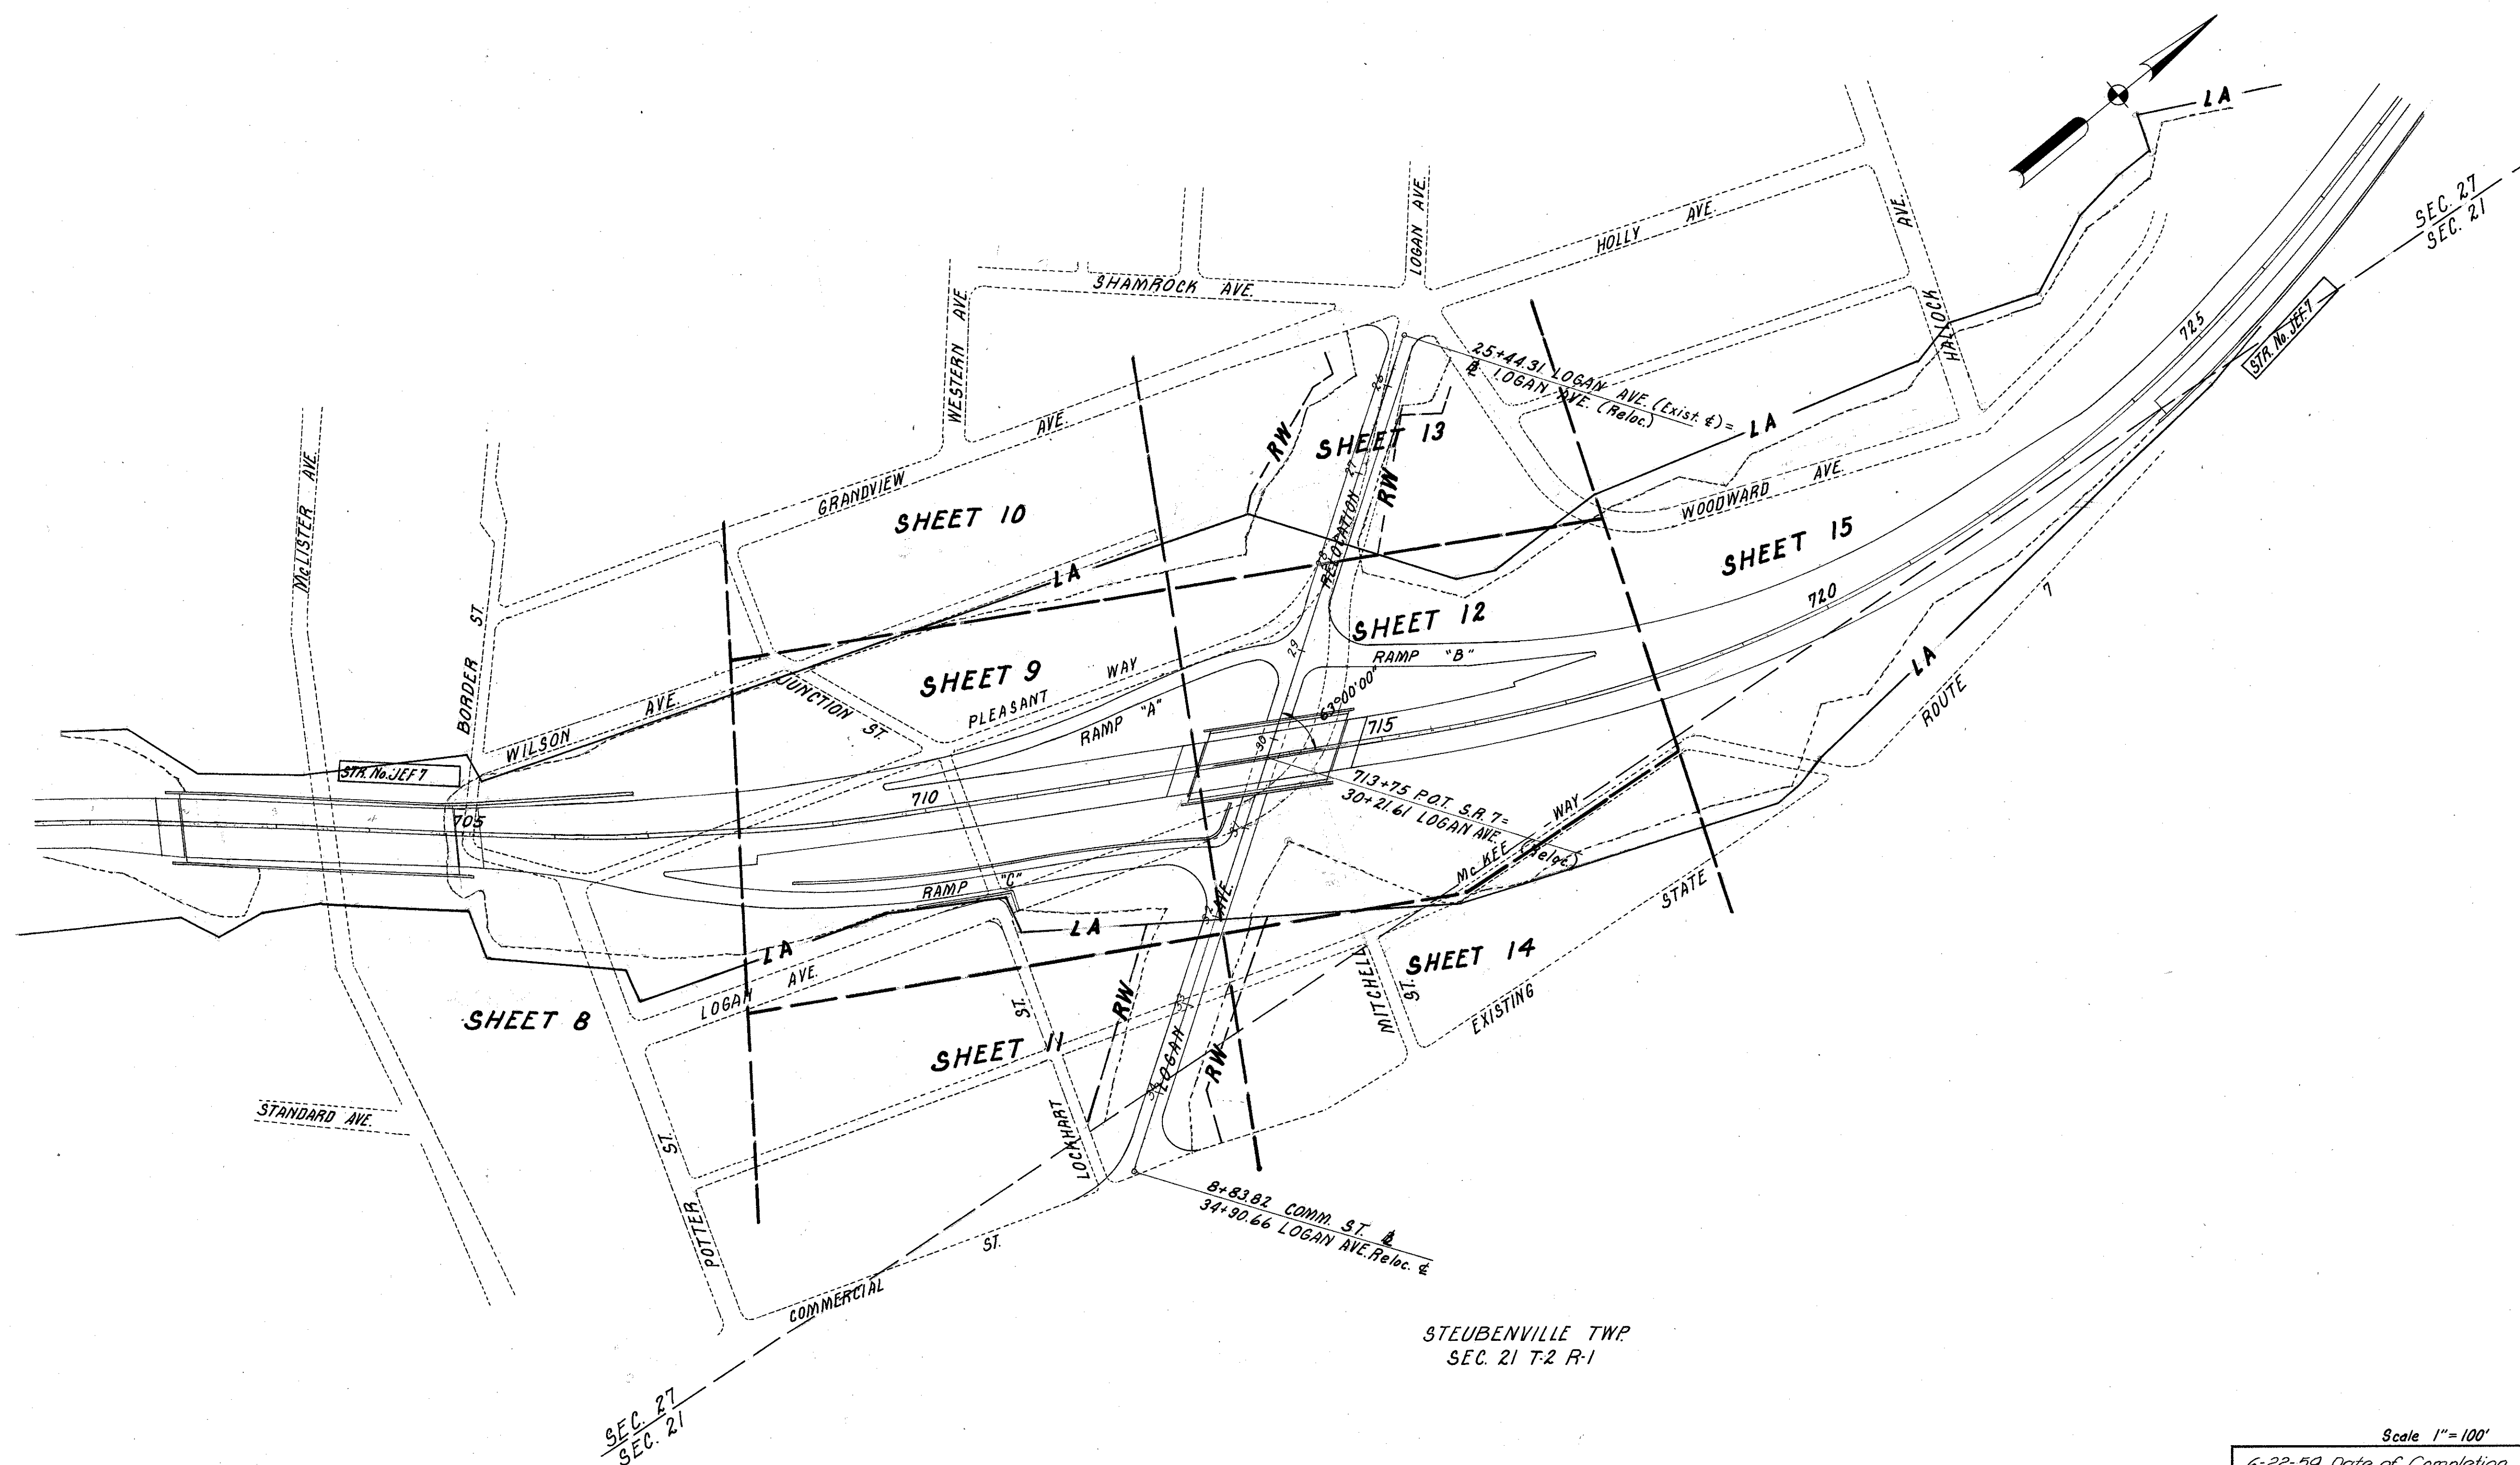

Scale 1"=100'

6-22-59 Date of Completion

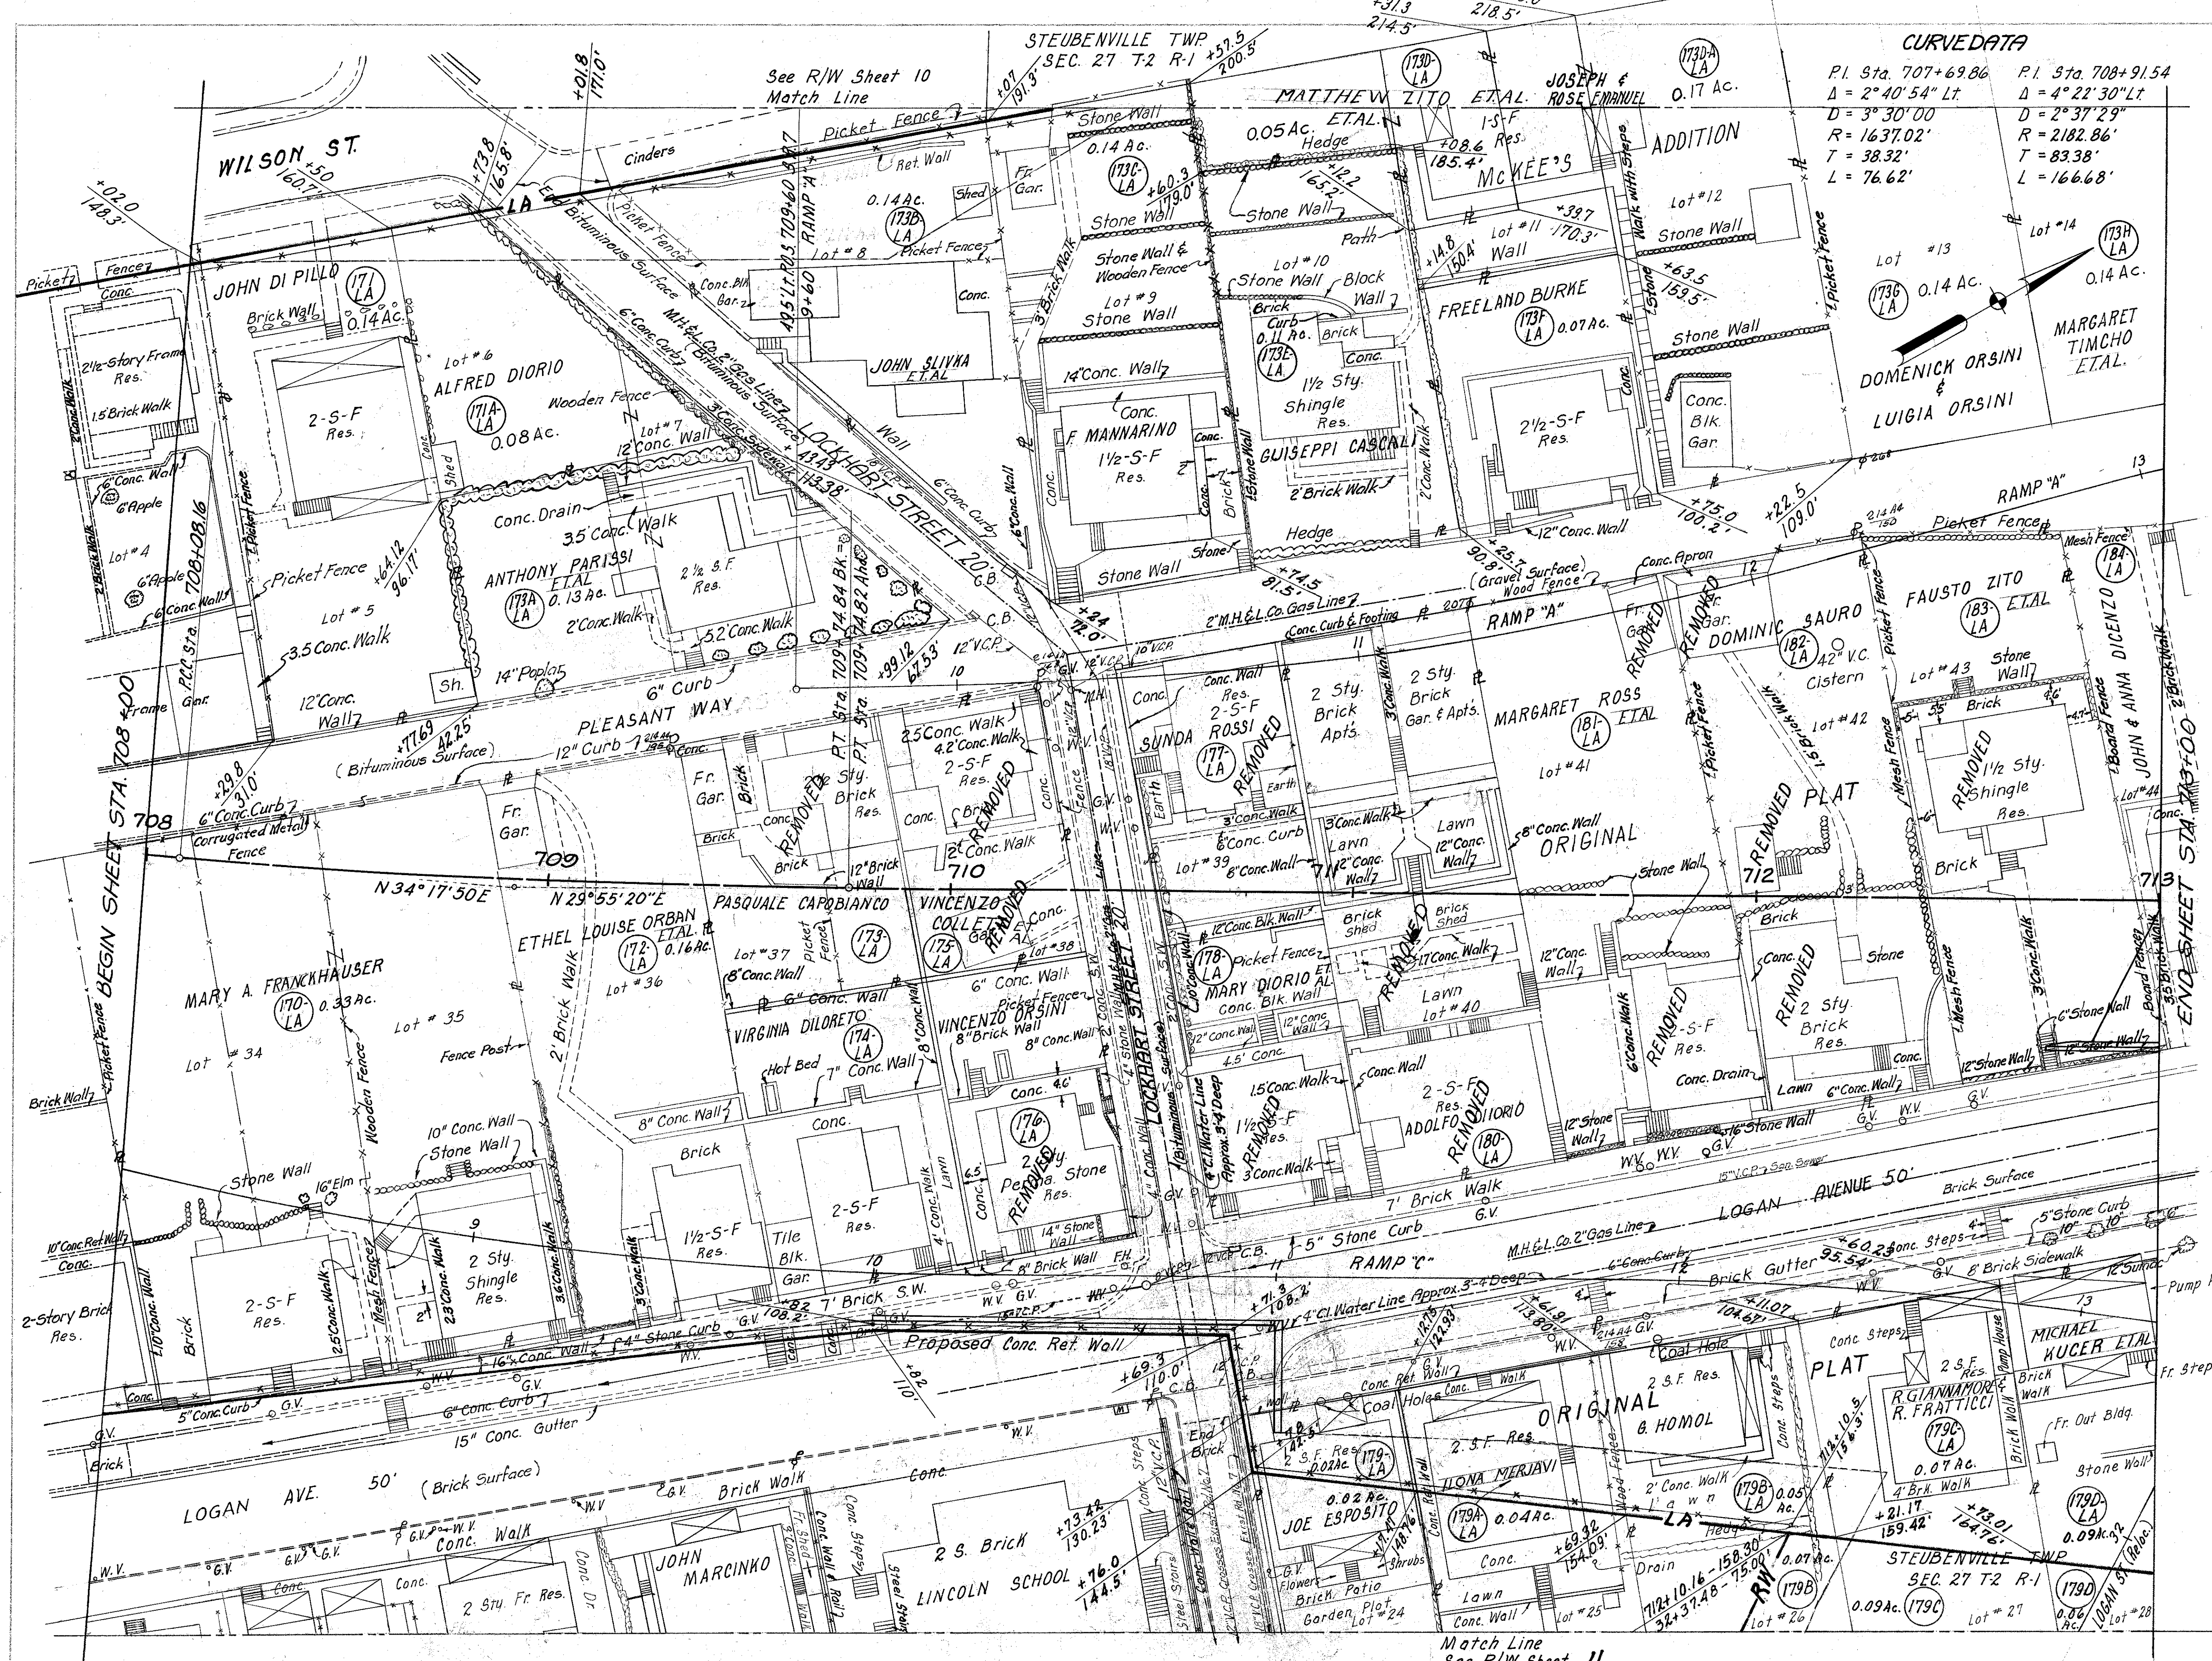

FED. RD. DIVISION	STATE	PROJECT	TYPE FUNDS
2	OHIO	U-430 (14)	297 307

JEFFERSON COUNTY
JEF-7-13.53
LIMITED ACCESS
R/W
9 OF 21

CURVED DATA	
P.I. Sta. 707+69.86 $\Delta = 2^\circ 40' 54''$ Lt. $D = 3^\circ 30' 00''$ $R = 1637.02'$ $T = 38.32'$ $L = 76.62'$	P.I. Sta. 708+91.54 $\Delta = 4^\circ 22' 30''$ Lt. $D = 2^\circ 37' 29''$ $R = 2182.86'$ $T = 83.38'$ $L = 166.68'$

685 L.F. Type "C" Fence
Scale 1"=20'
6-22-59 Date of Completion


RIGHT OF WAY STA. 708+00 TO STA. 713+00

STEUBENVILLE TWP.
SEC. 27 T2 R1

FED. RD. DIVISION	STATE	PROJECT	
2	OHIO	U-430(14)	

298
307

JEFFERSON COUNTY
JEF-7-13.53
LIMITED ACCESS
R/W
10 OF 21

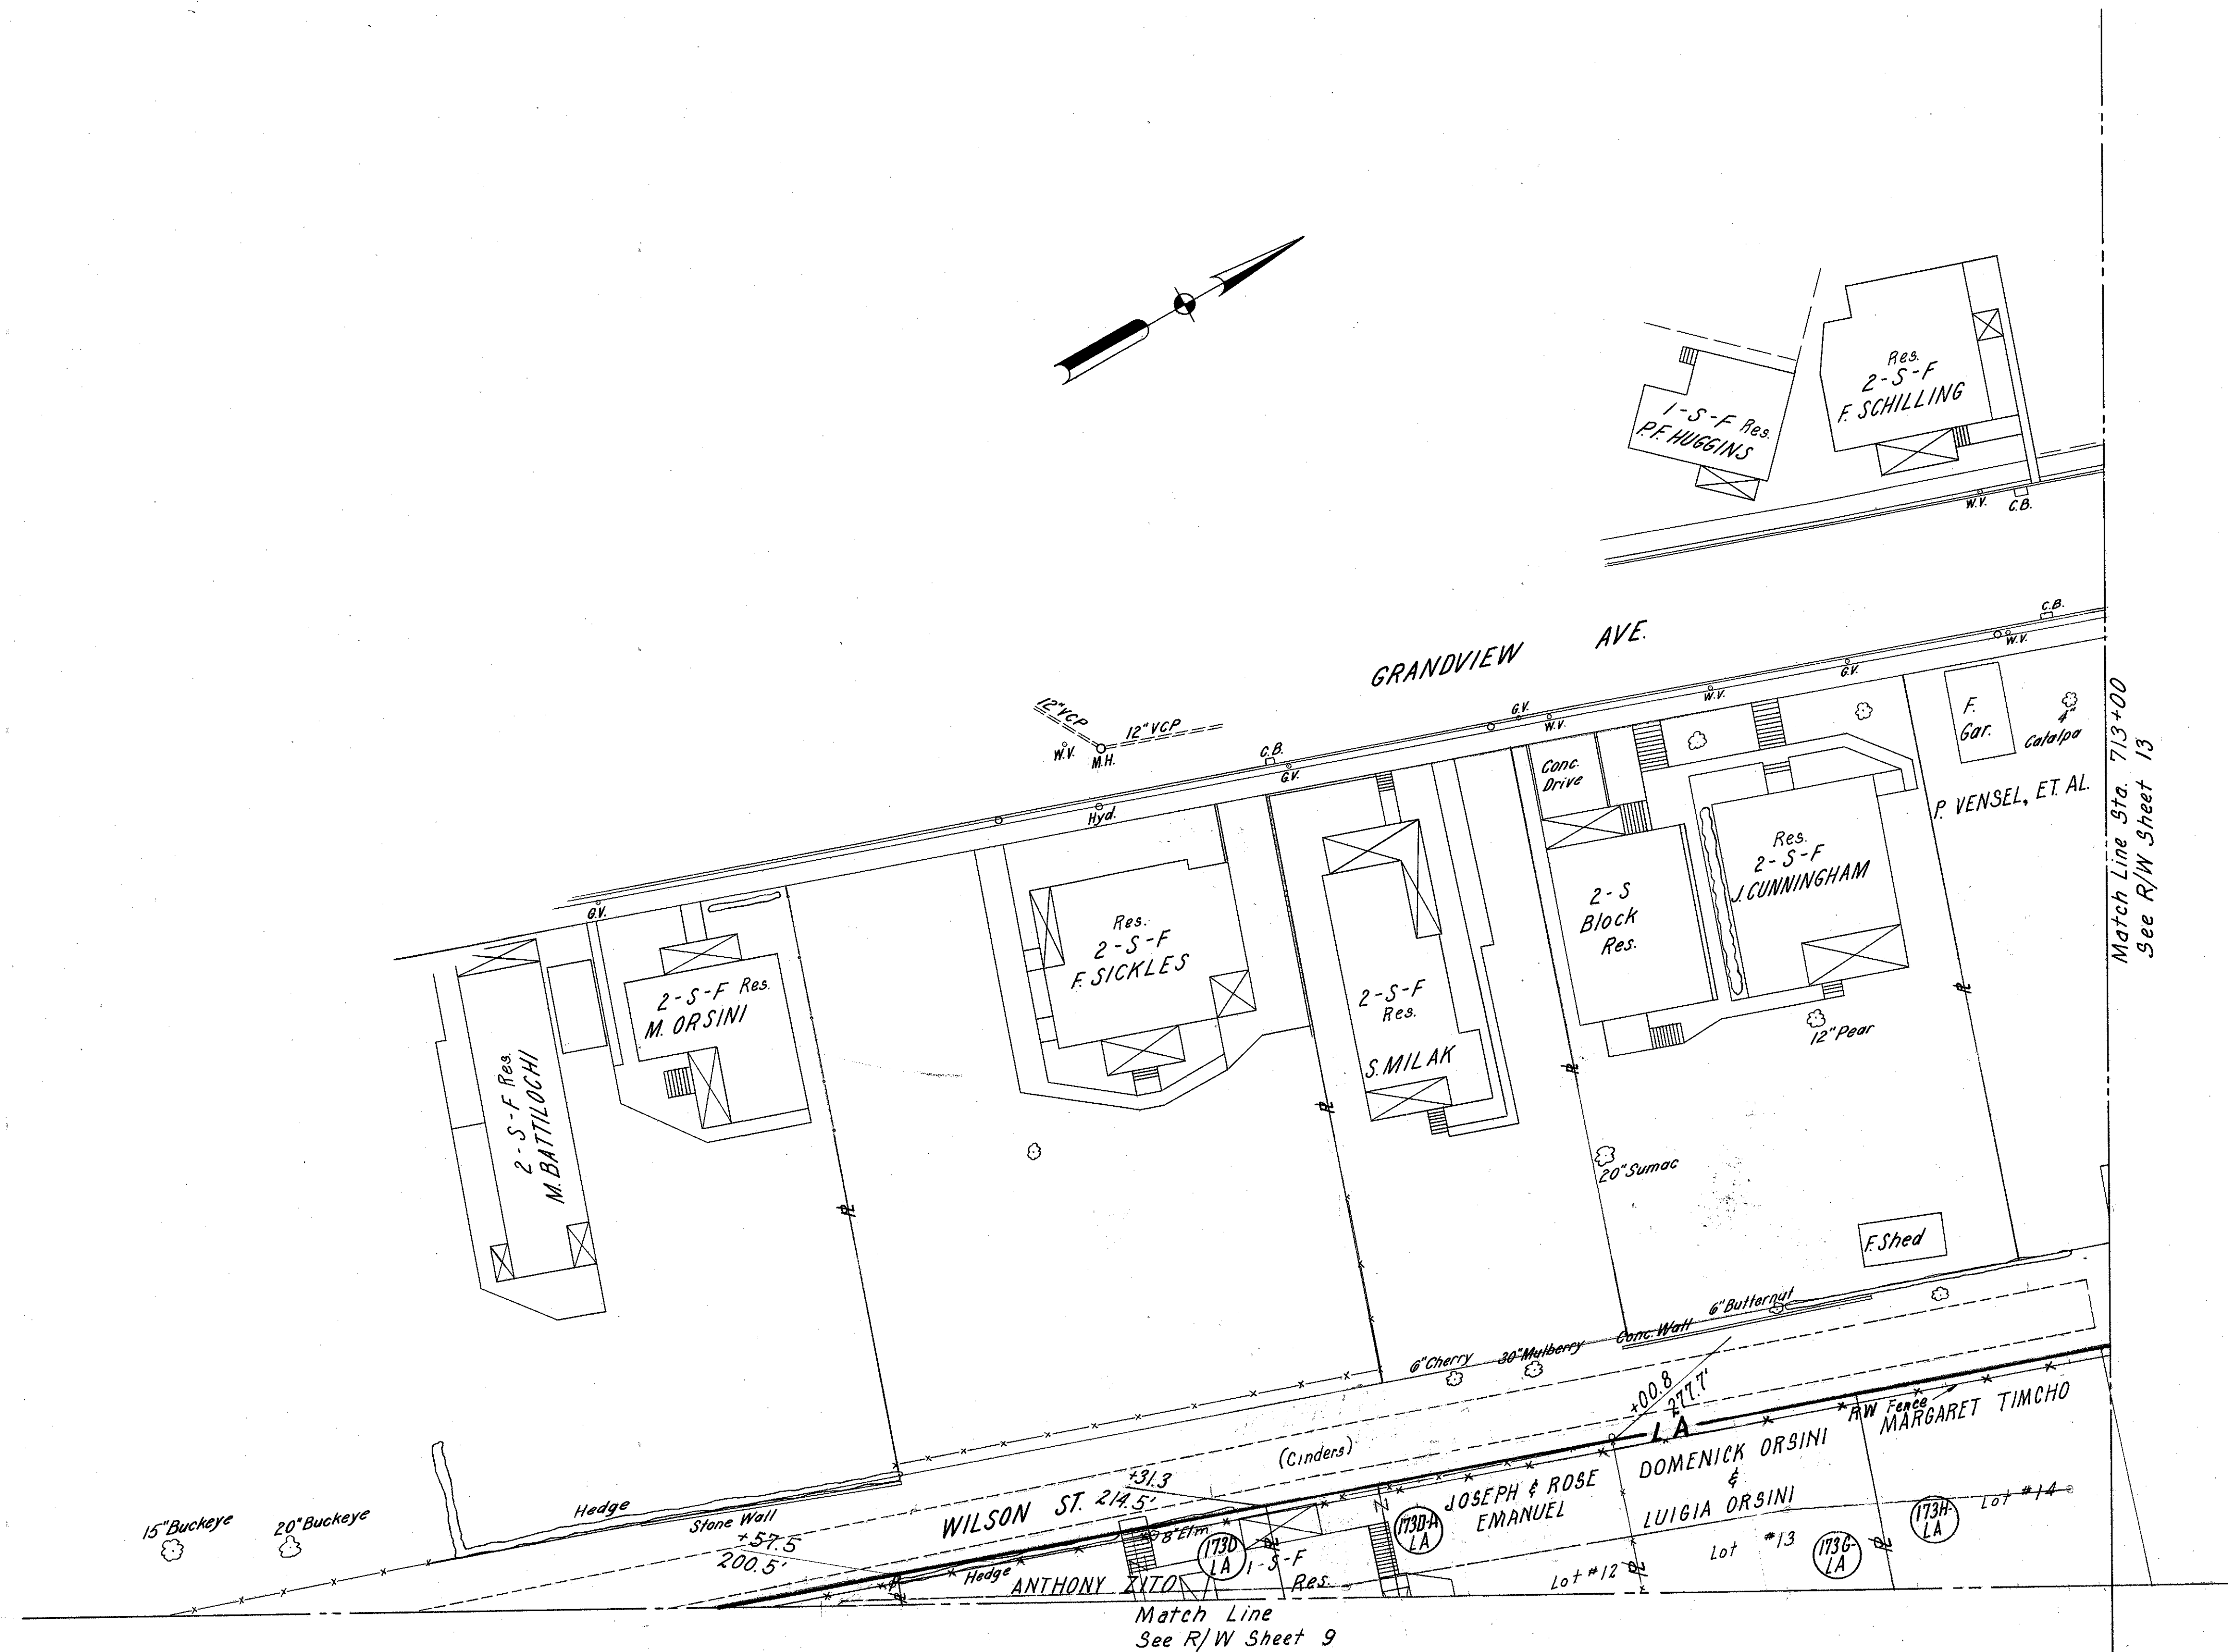


275 L.F. Type 'C' Fence

Scale 1"=20'


6-22-59 Date of Completion

JEFFERSON COUNTY
JEF-7-13.53
LIMITED ACCESS
R/W
11 OF 21

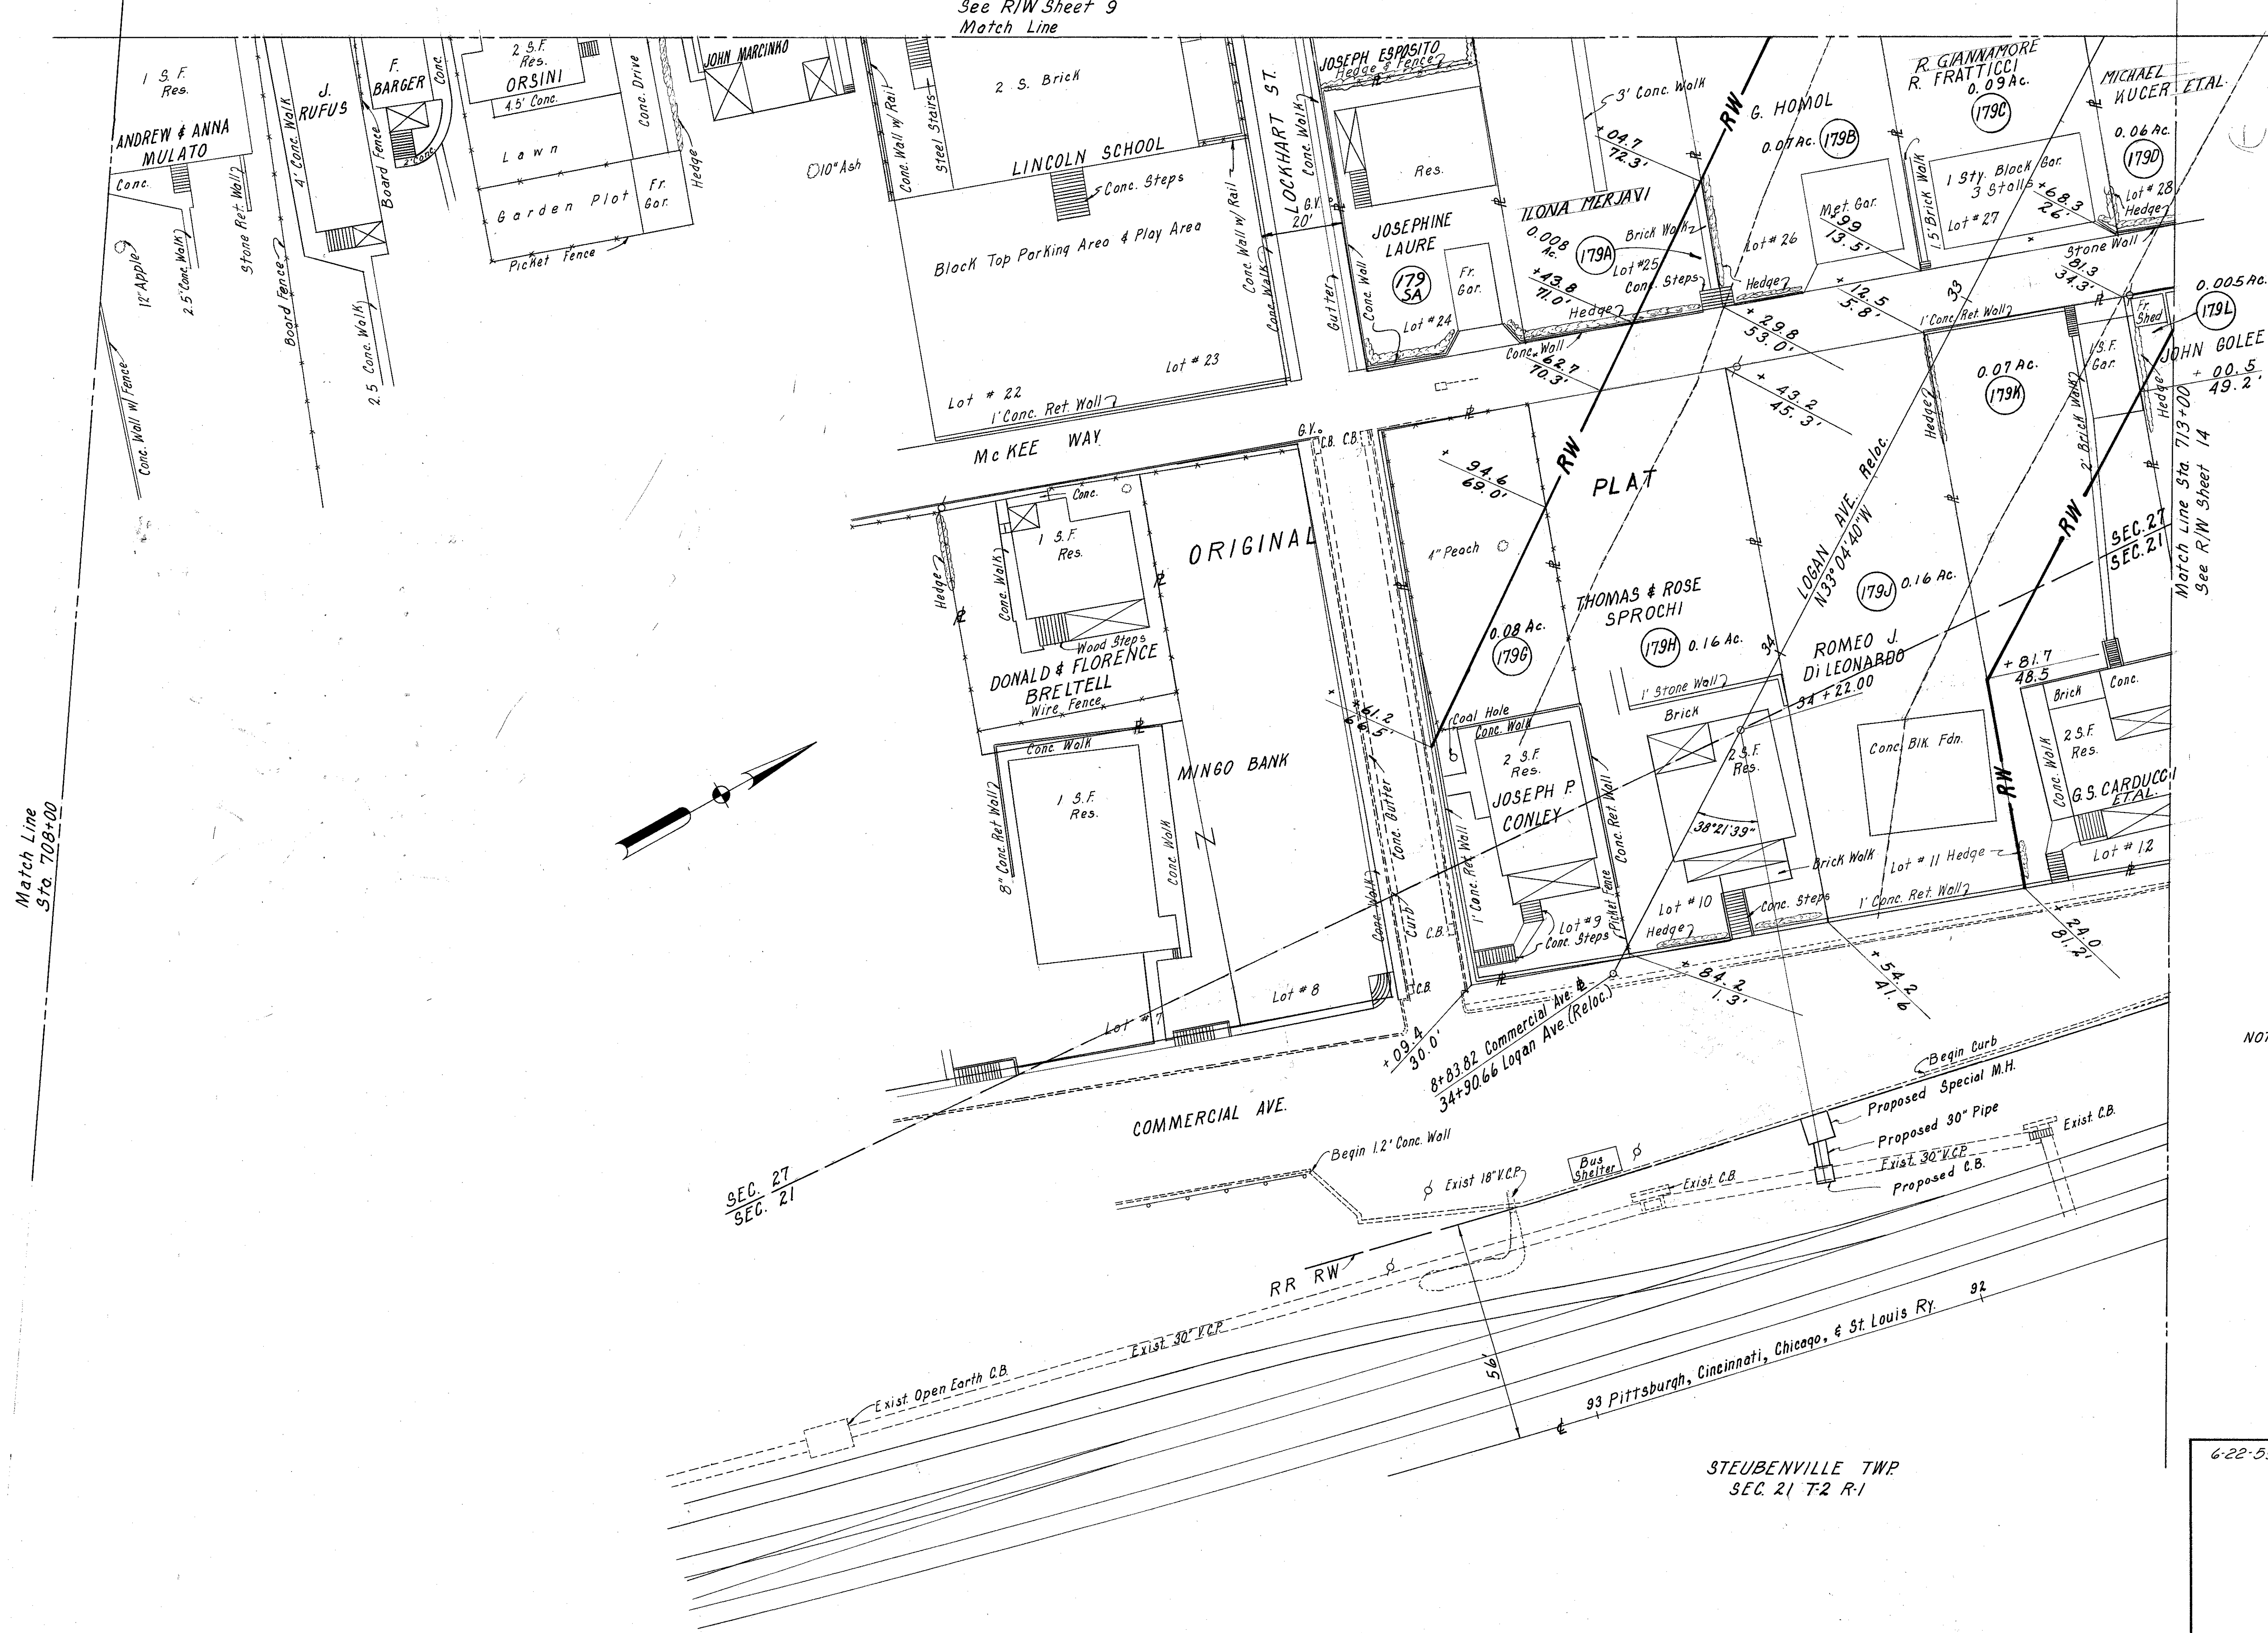

NOTE: All ties this sheet are to Logan Ave. Relocation.
P.C.C. & St. L. RR - R/W - See sheet 19.

JEFFERSON COUNTY
JEF-7-13.53
LIMITED ACCESS
R/W
12 OF 21

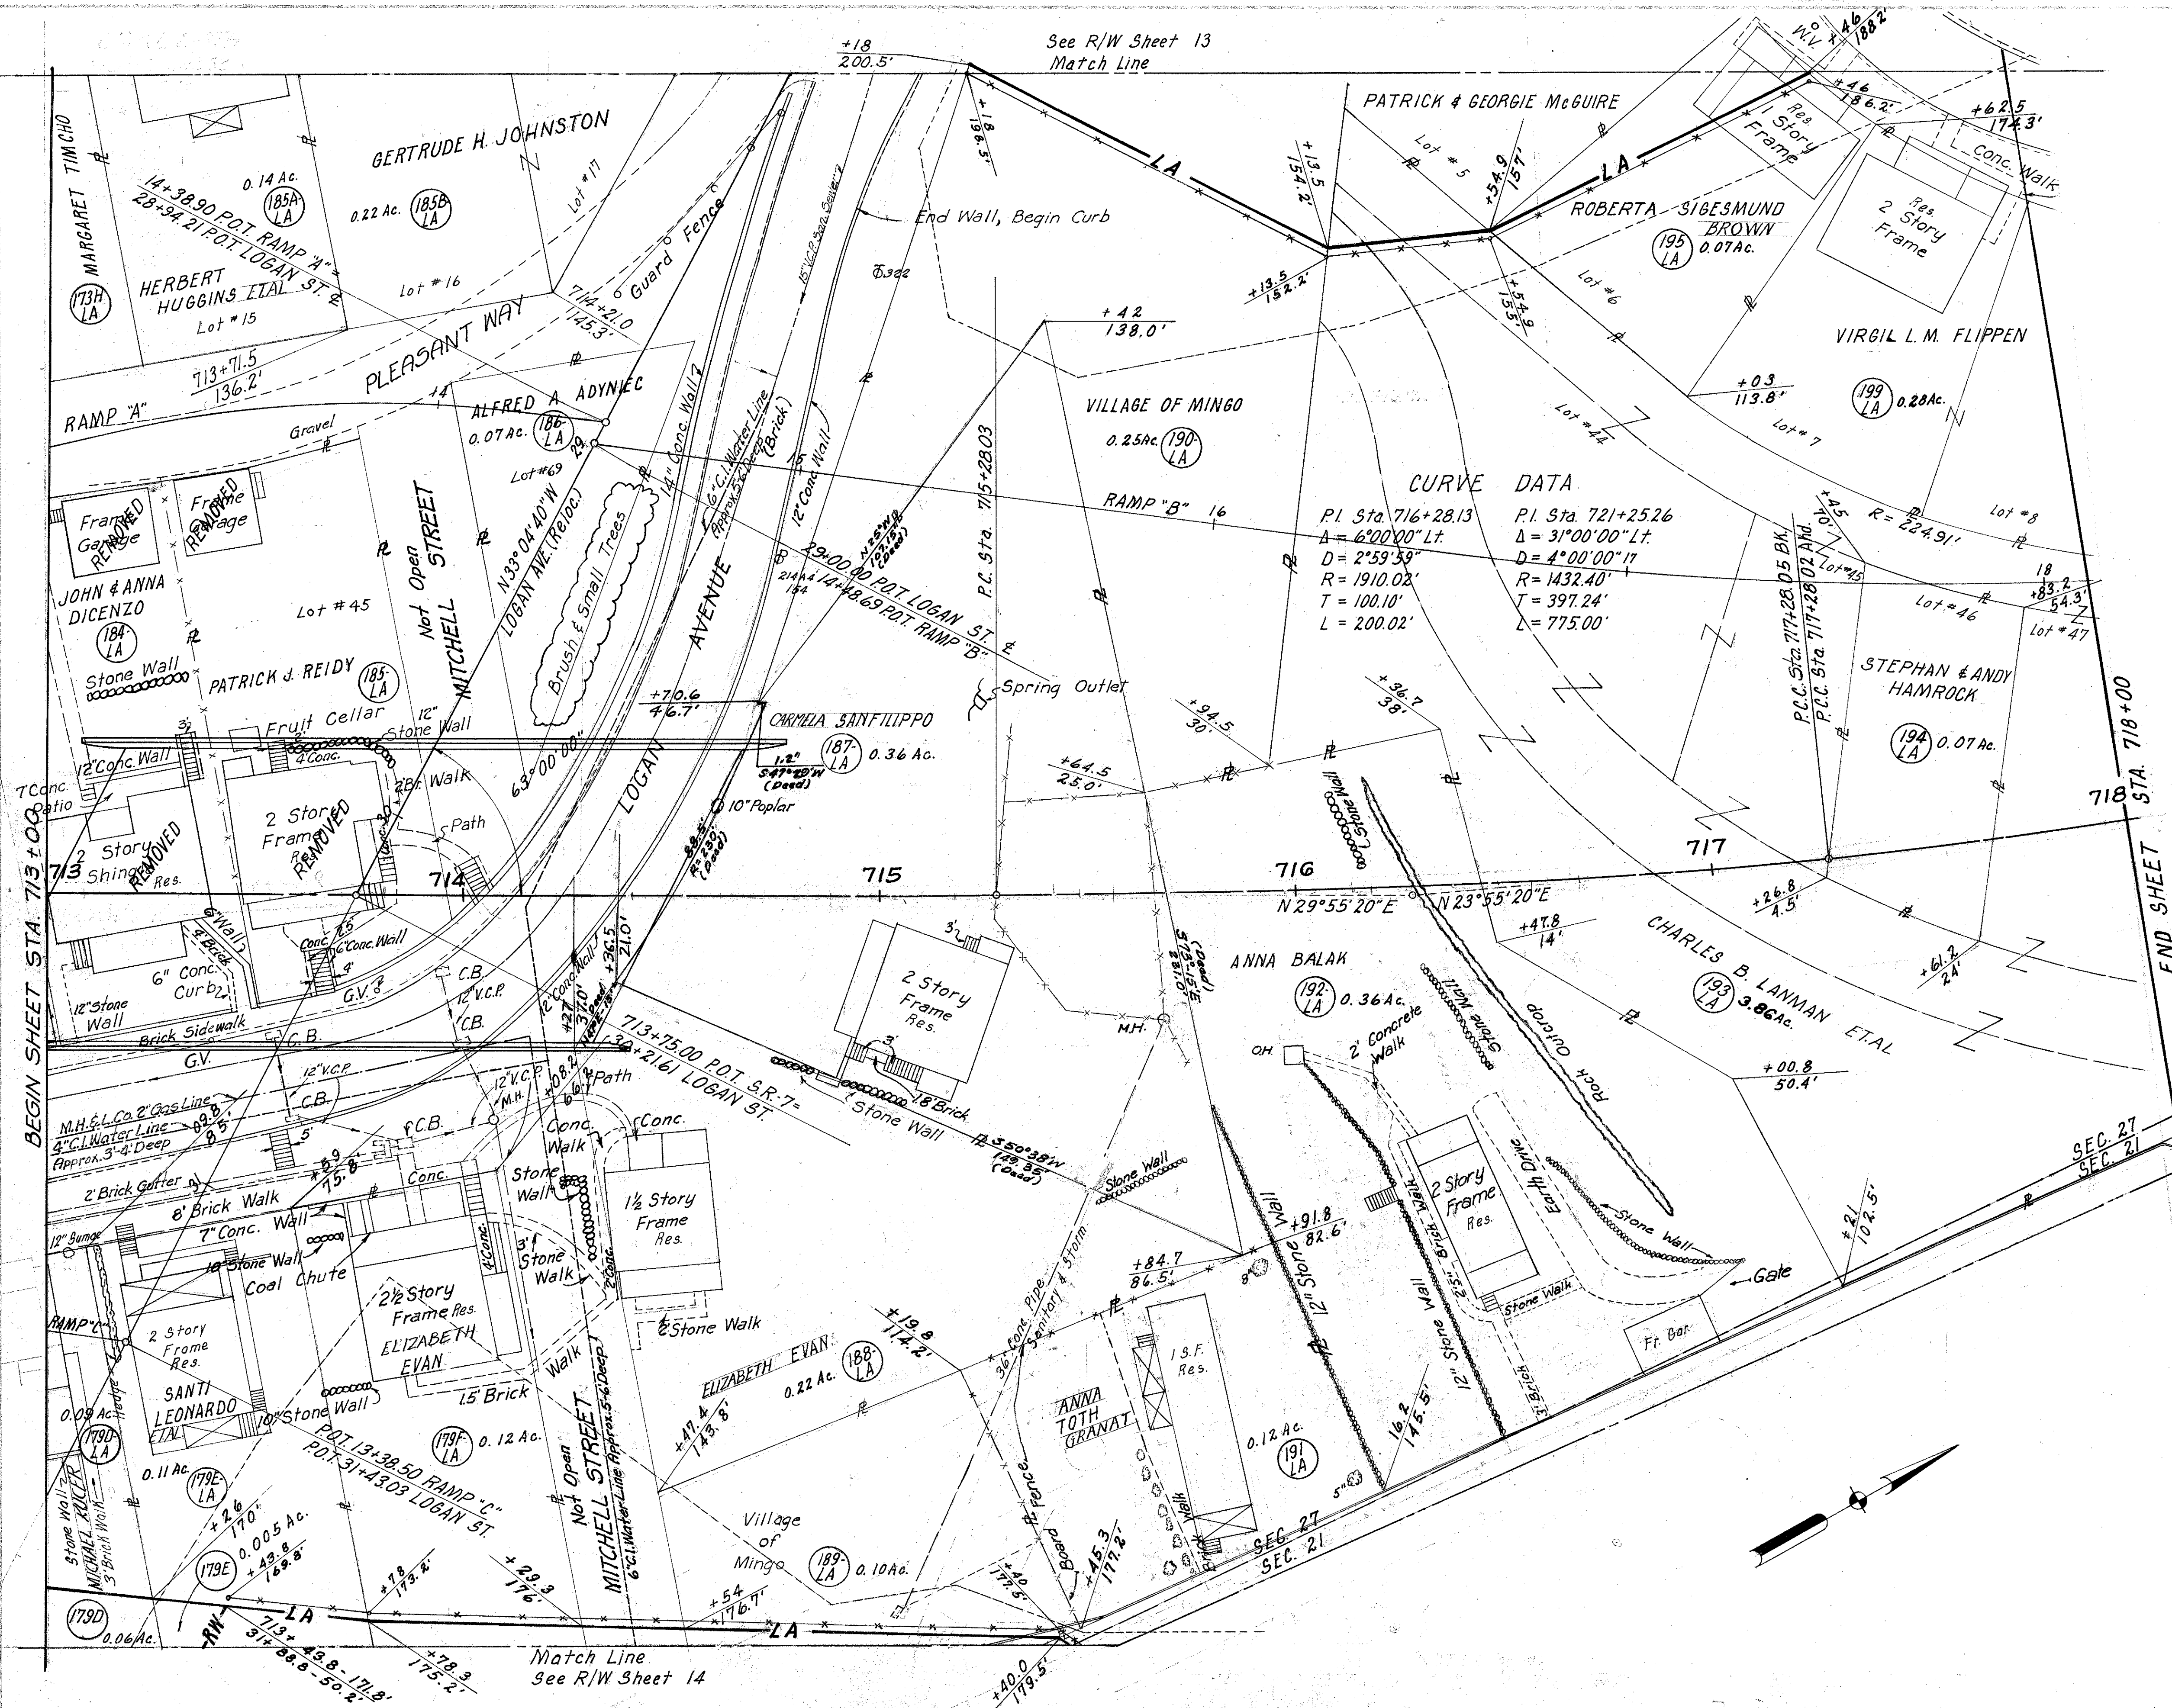


430 L.F. Type "C" Fence

Scale 1"=20'
6-22-59 Date of Completion

FED. RD. DIVISION	STATE	PROJECT	
2	OHIO	U-430(14)	

301
307

JEFFERSON COUNTY
JEF-7-13.53
LIMITED ACCESS
R/W
13 OF 21

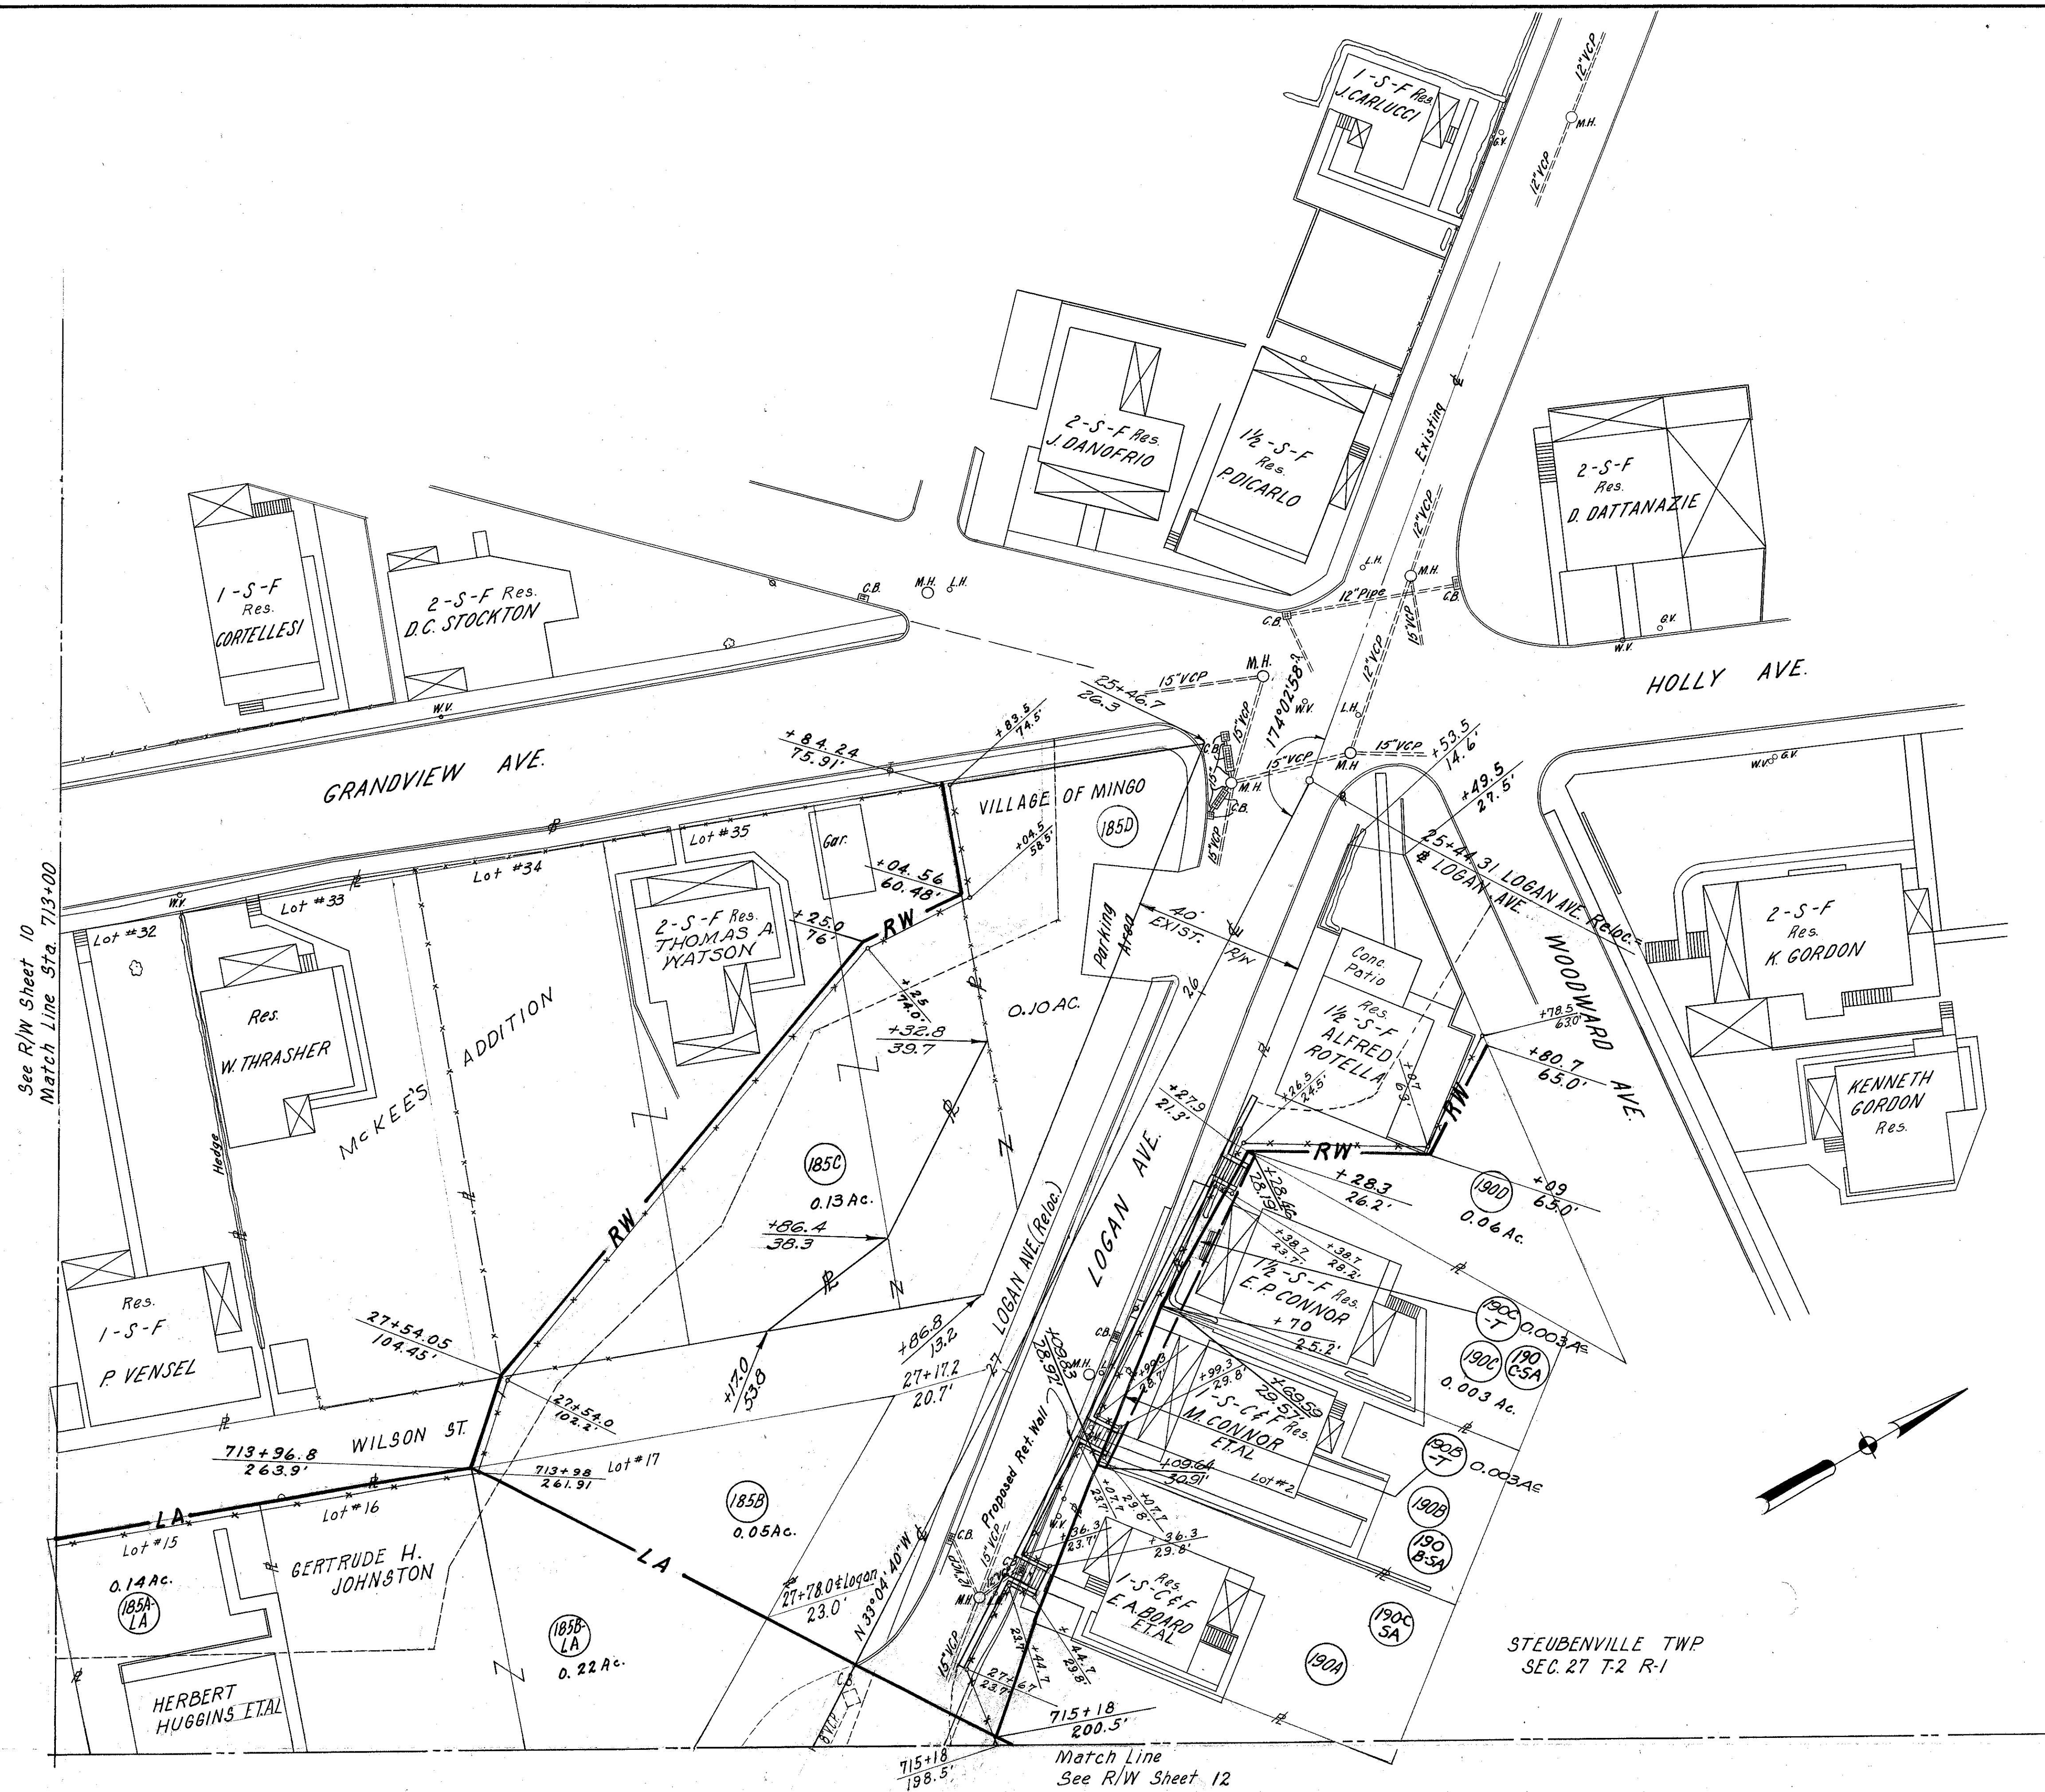


550 L.F. Type "C" Fence

Scale 1"=20'

6-22-59 Date of Completion
7-3-59 Revised - Parcels 185-C & 185-D
10-18-60 Revised - Added parcels 190B-T and 190C-T

JEFFERSON COUNTY
JEF - 7-1353
LIMITED ACCESS
R/W
14 OF 21

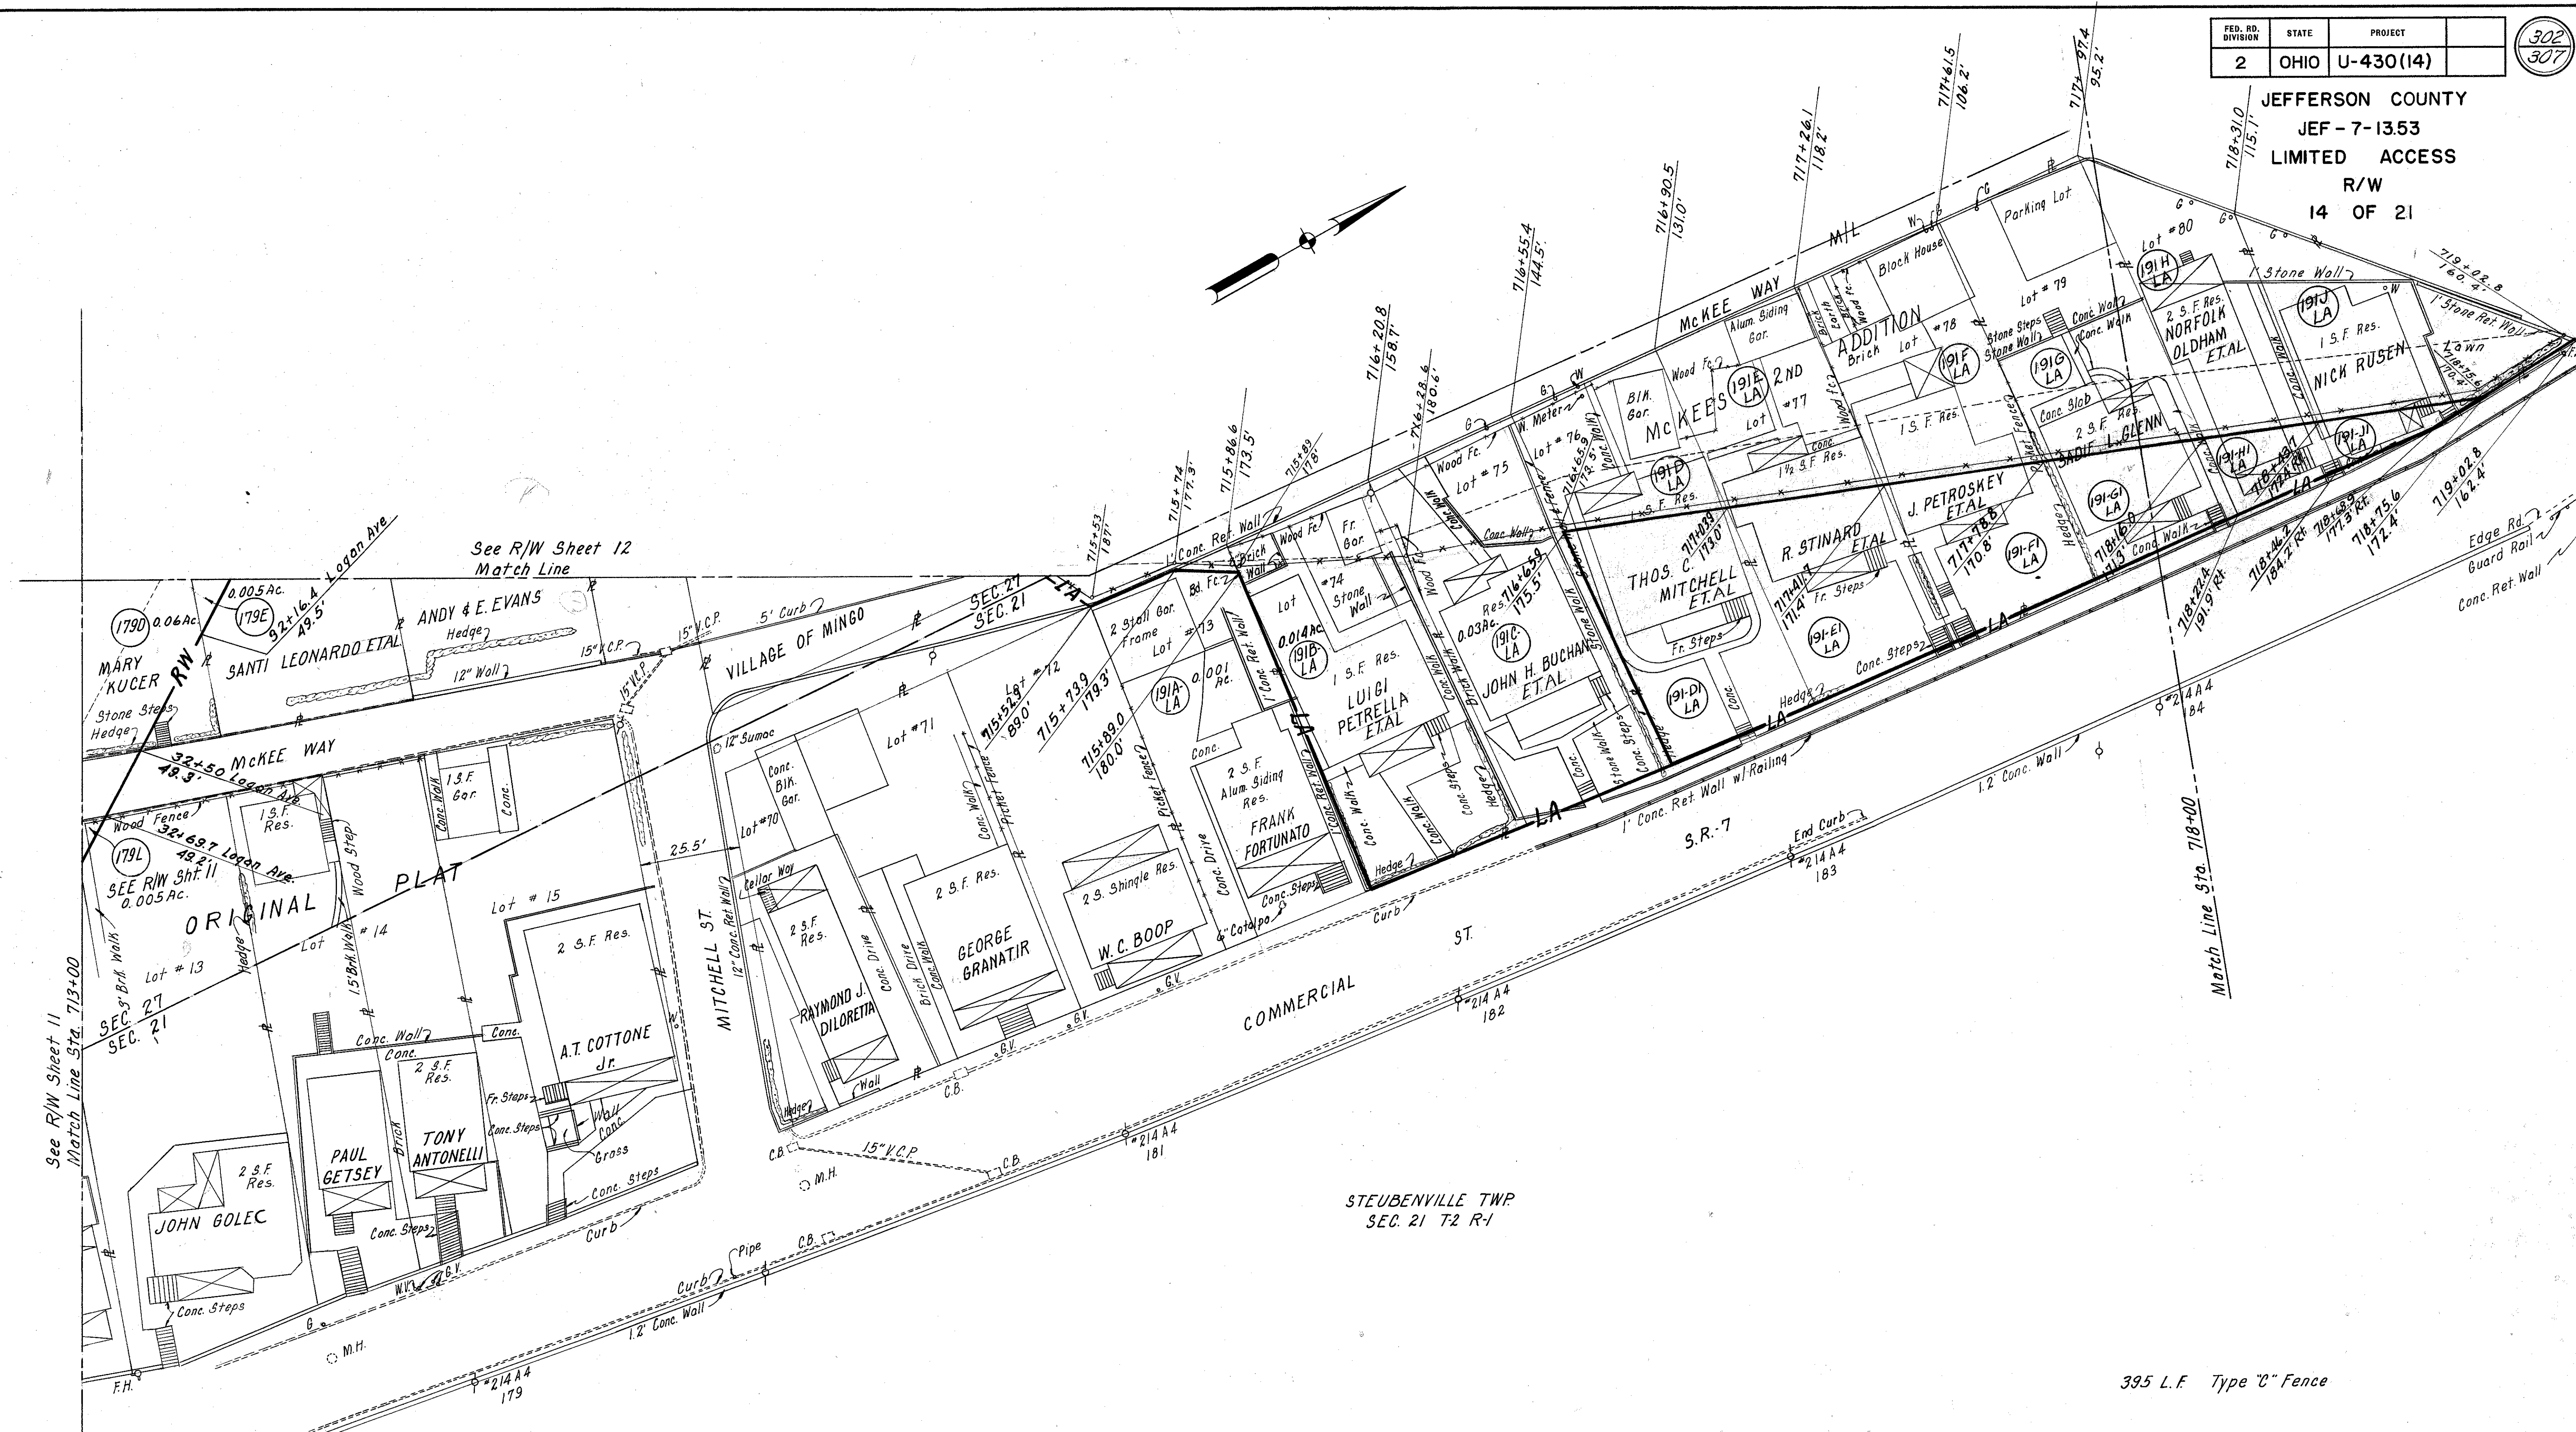

395 L.F. Type "C" Fence

Scale 1"=20'


6-22-59 Date of Completion
4-12-61 Added Parcel Nos. 191-DI-LA, 191-EI-LA, 191-FI-LA, 191-GI-LA, 191-HI-LA & 191-JI-LA

JEFFERSON COUNTY
JEF - 7 - 13.53
LIMITED ACCESS
R/W

CURVE DATA

P.I. Sta. 721+25.26	P.I. Sta. 726+03.12
Δ = 31°00'00" Lt	Δ = 6°00'00" Lt
D = 4°00'00"	D = 2°59'59"
R = 1432.40'	R = 1910.02'
T = 397.24'	T = 100.10'
L = 775.00'	L = 200.02'

STUEBENVILLE TWP
SEC. 27 T-2 R-1

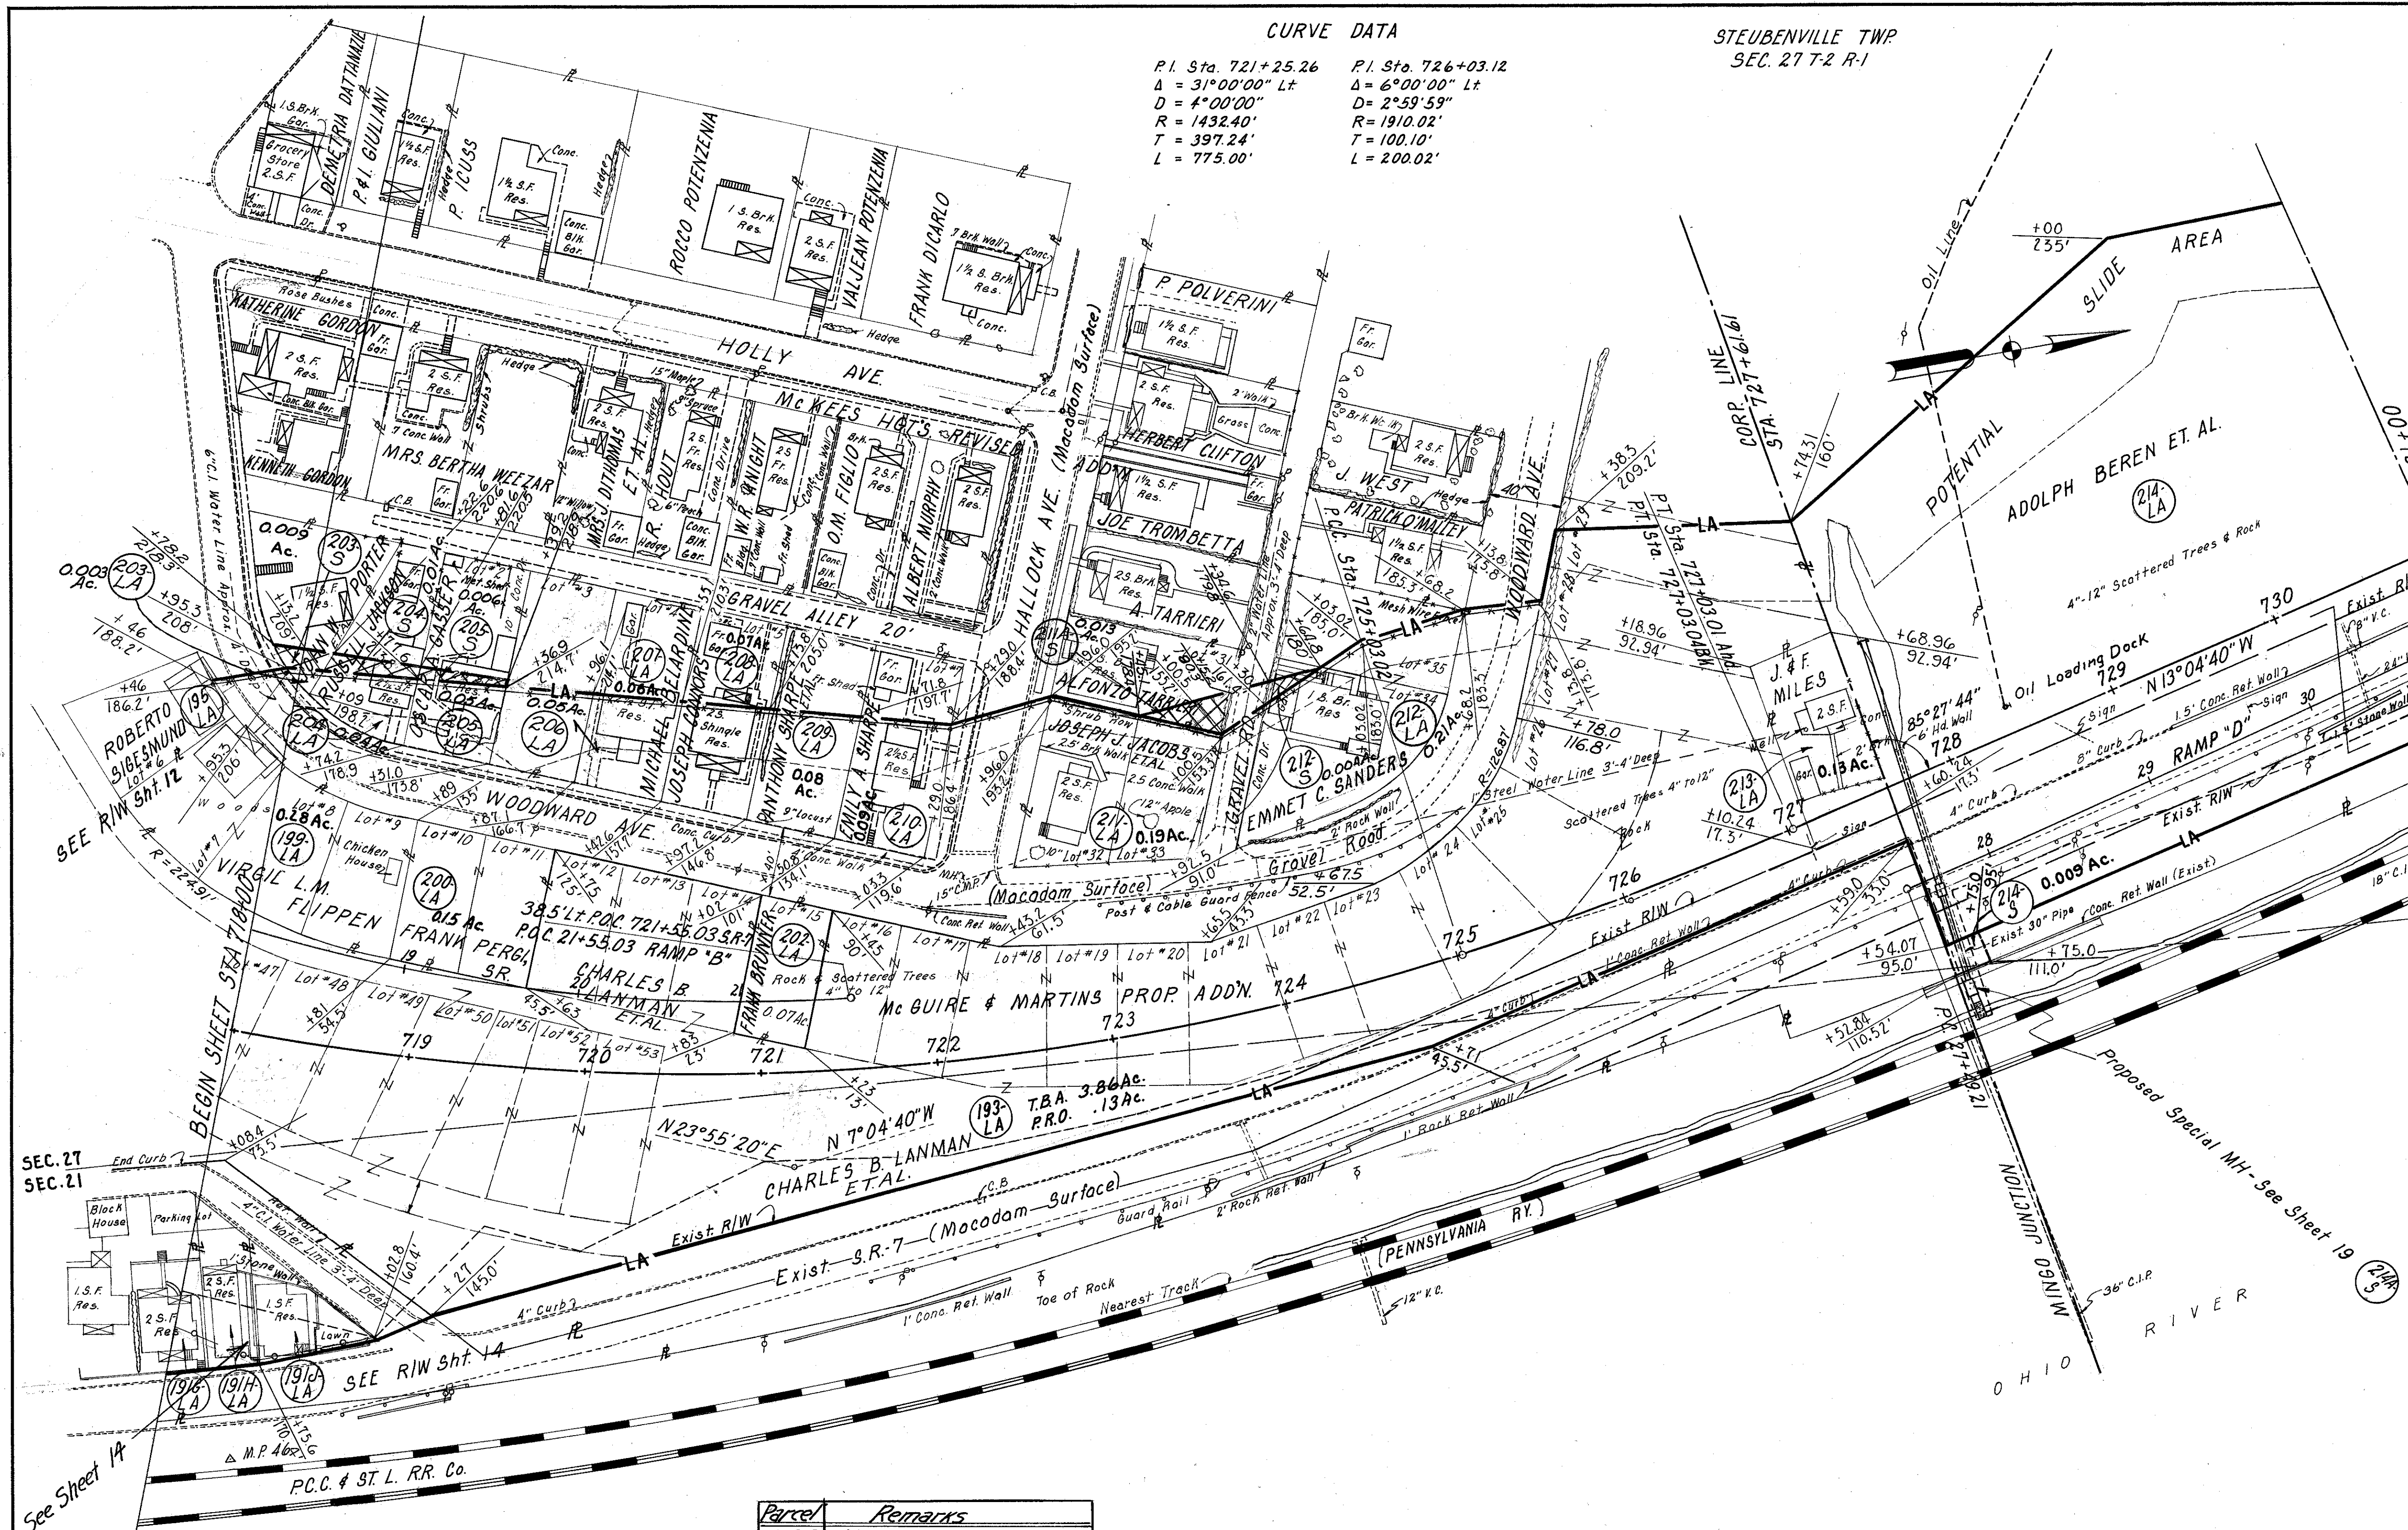

Item I-8 - Centerline Reference Monuments
Total to General Summary - 35 Each
(See RW Sheet 1 for Locations)

SHEET NO.	STATION TO STATION	ITEM SS-18 FENCE TYPE "C" LIN. FT.
3	678+00 to 683+00	215 L.F.
4	683+00 to 688+00	1070 L.F.
5	688+00 to 693+00	1000 L.F.
6	693+00 to 698+00	960 L.F.
7	698+00 to 703+00	1165 L.F.
8	703+00 to 708+00	705 L.F.
9	708+00 to 713+00	685 L.F.
10	708+00 to 713+00	275 L.F.
12	713+00 to 718+00	430 L.F.
13	713+00 to 718+00	550 L.F.
14	713+00 to 718+00	395 L.F.
15	718+00 to 731+00	780 L.F.
TOTAL TO GENERAL SUMMARY		8230 L.F.

Parcel	Remarks
203-S	Not Acquired
204-S	Not Acquired
205-S	Not Acquired
211-AS	Not Acquired
212-S	Not Acquired

780 L.F. Type "C" Fence



Scale 1"=50'

6-22-59 Date of Completion

STUEBENVILLE TWP
SEC. 21 T-2 R-1

RIGHT OF WAY STA. 718+00 TO STA. 731+00

JEFFERSON COUNTY
JEF-7-1353
LIMITED ACCESS
R/W
17 OF 21

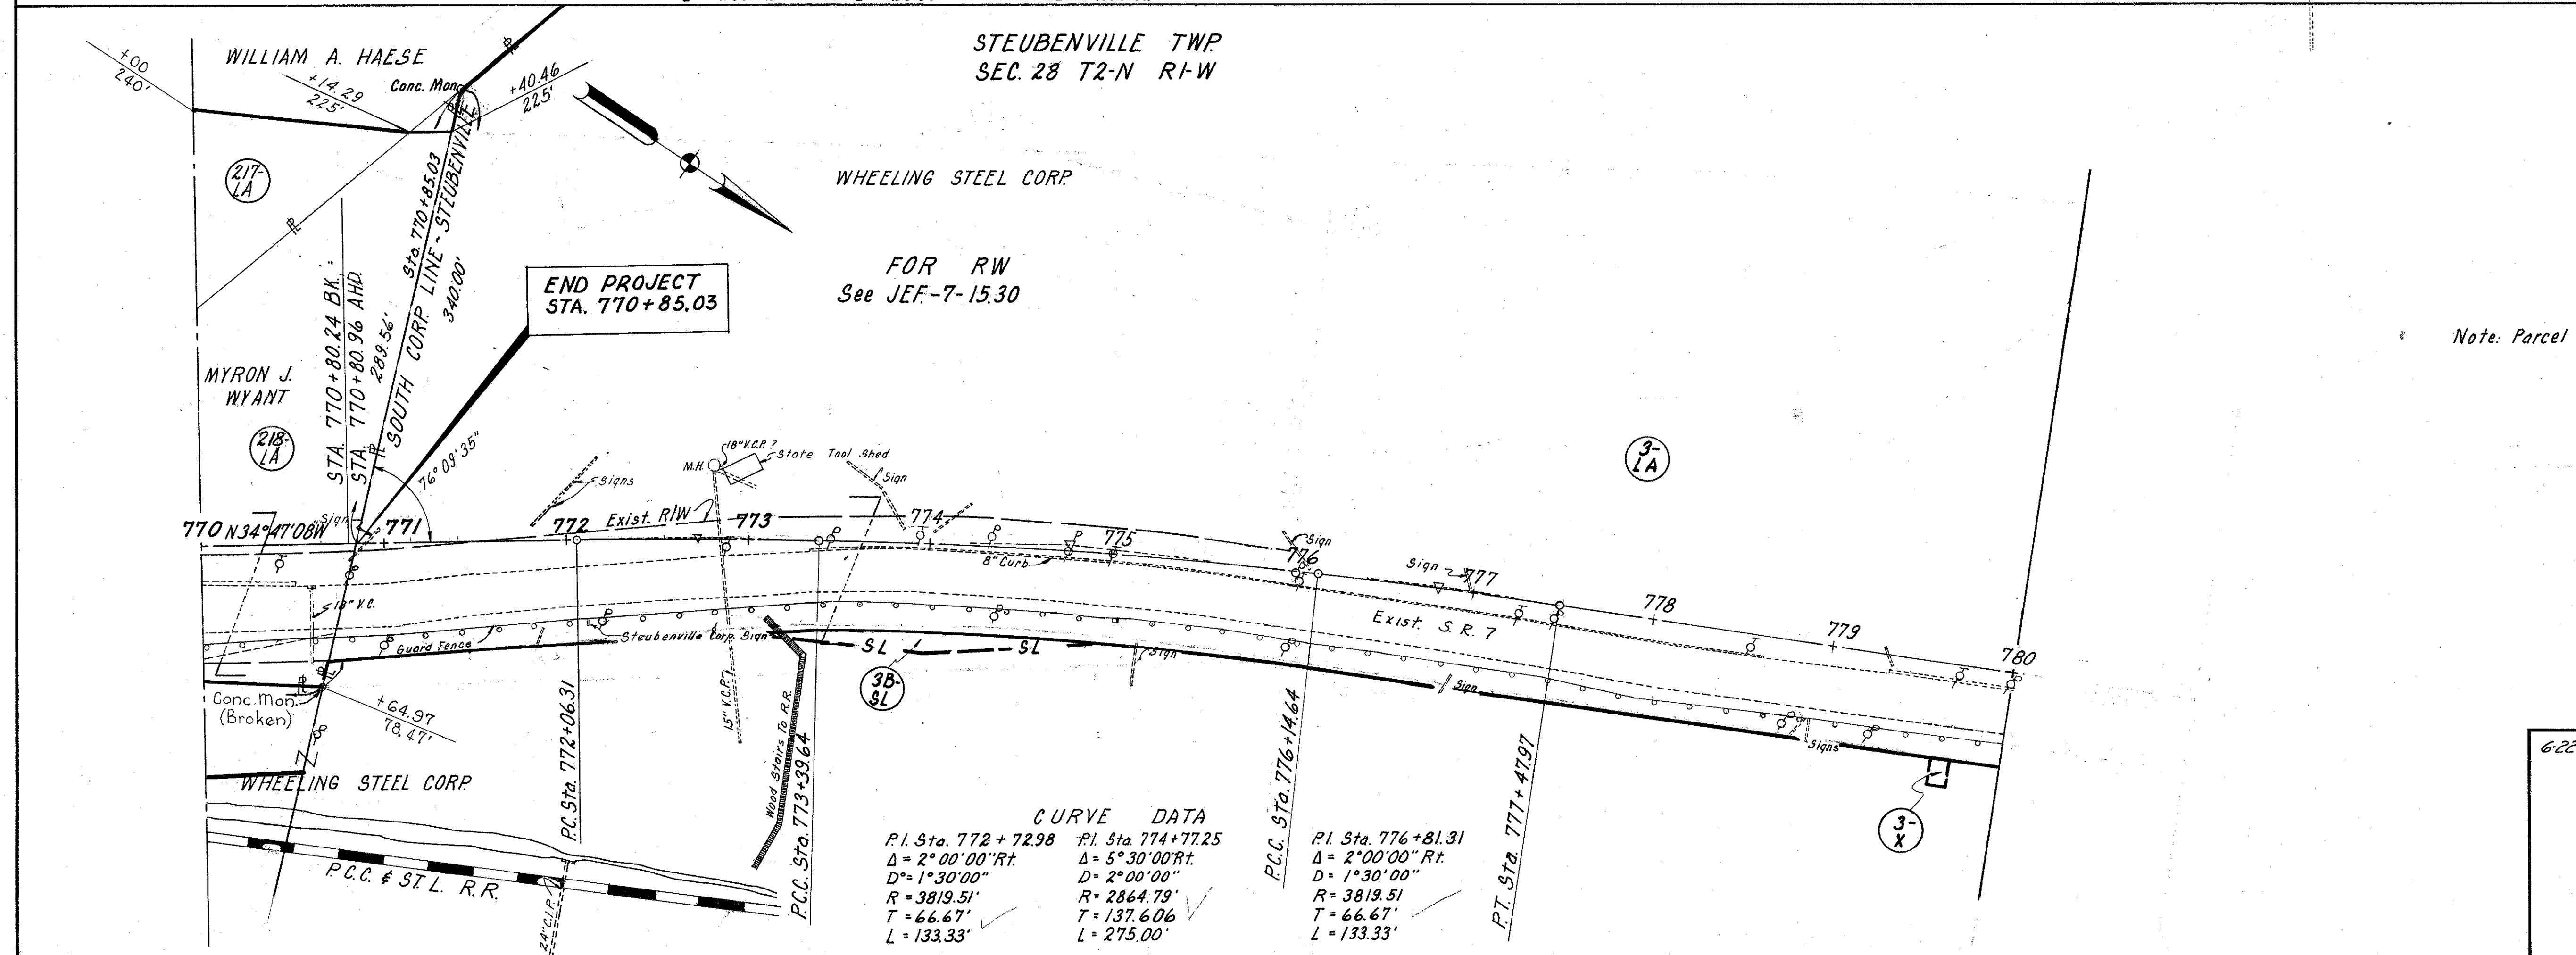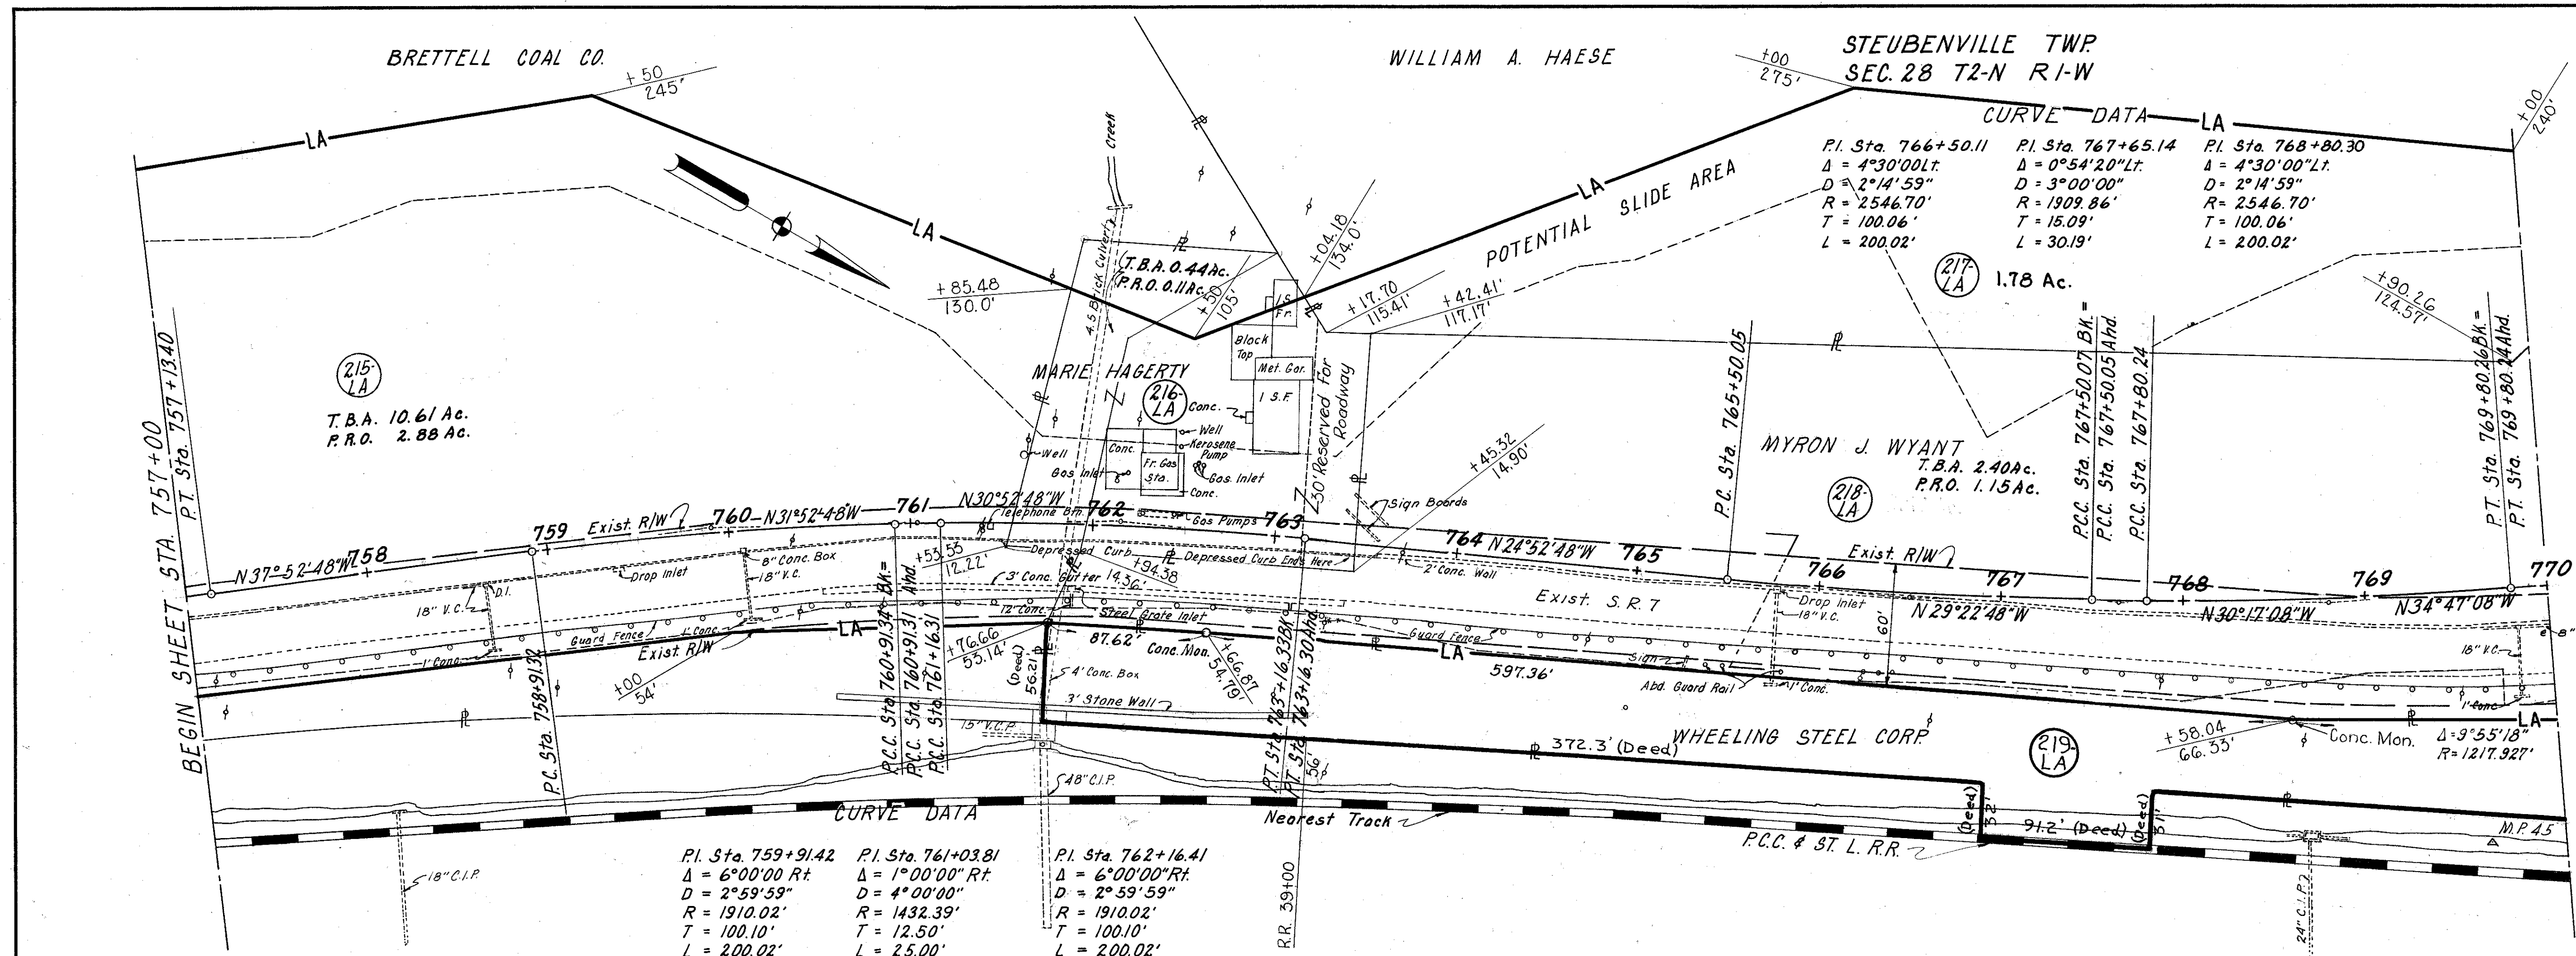

Note: Parcel No. 31A, 3B-5L, & 3X Purchased in JEF-7-1530


Scale 1"=50'
6-22-59 Date of Completion

FED. RD. DIVISION	STATE	PROJECT	TYPE FUNDS
2	OHIO	U-430 (14)	

306
307

JEFFERSON COUNTY
JEF-7-13.53
LIMITED ACCESS
R/W
18 OF 21

CLIFTON ST. ~ CURVE DATA
P.I. Sta. 3+48.73
Δ = 62° 26' 00" Lt.
D = 32° 30'
R = 176.30'
T = 106.84'
L = 192.10'

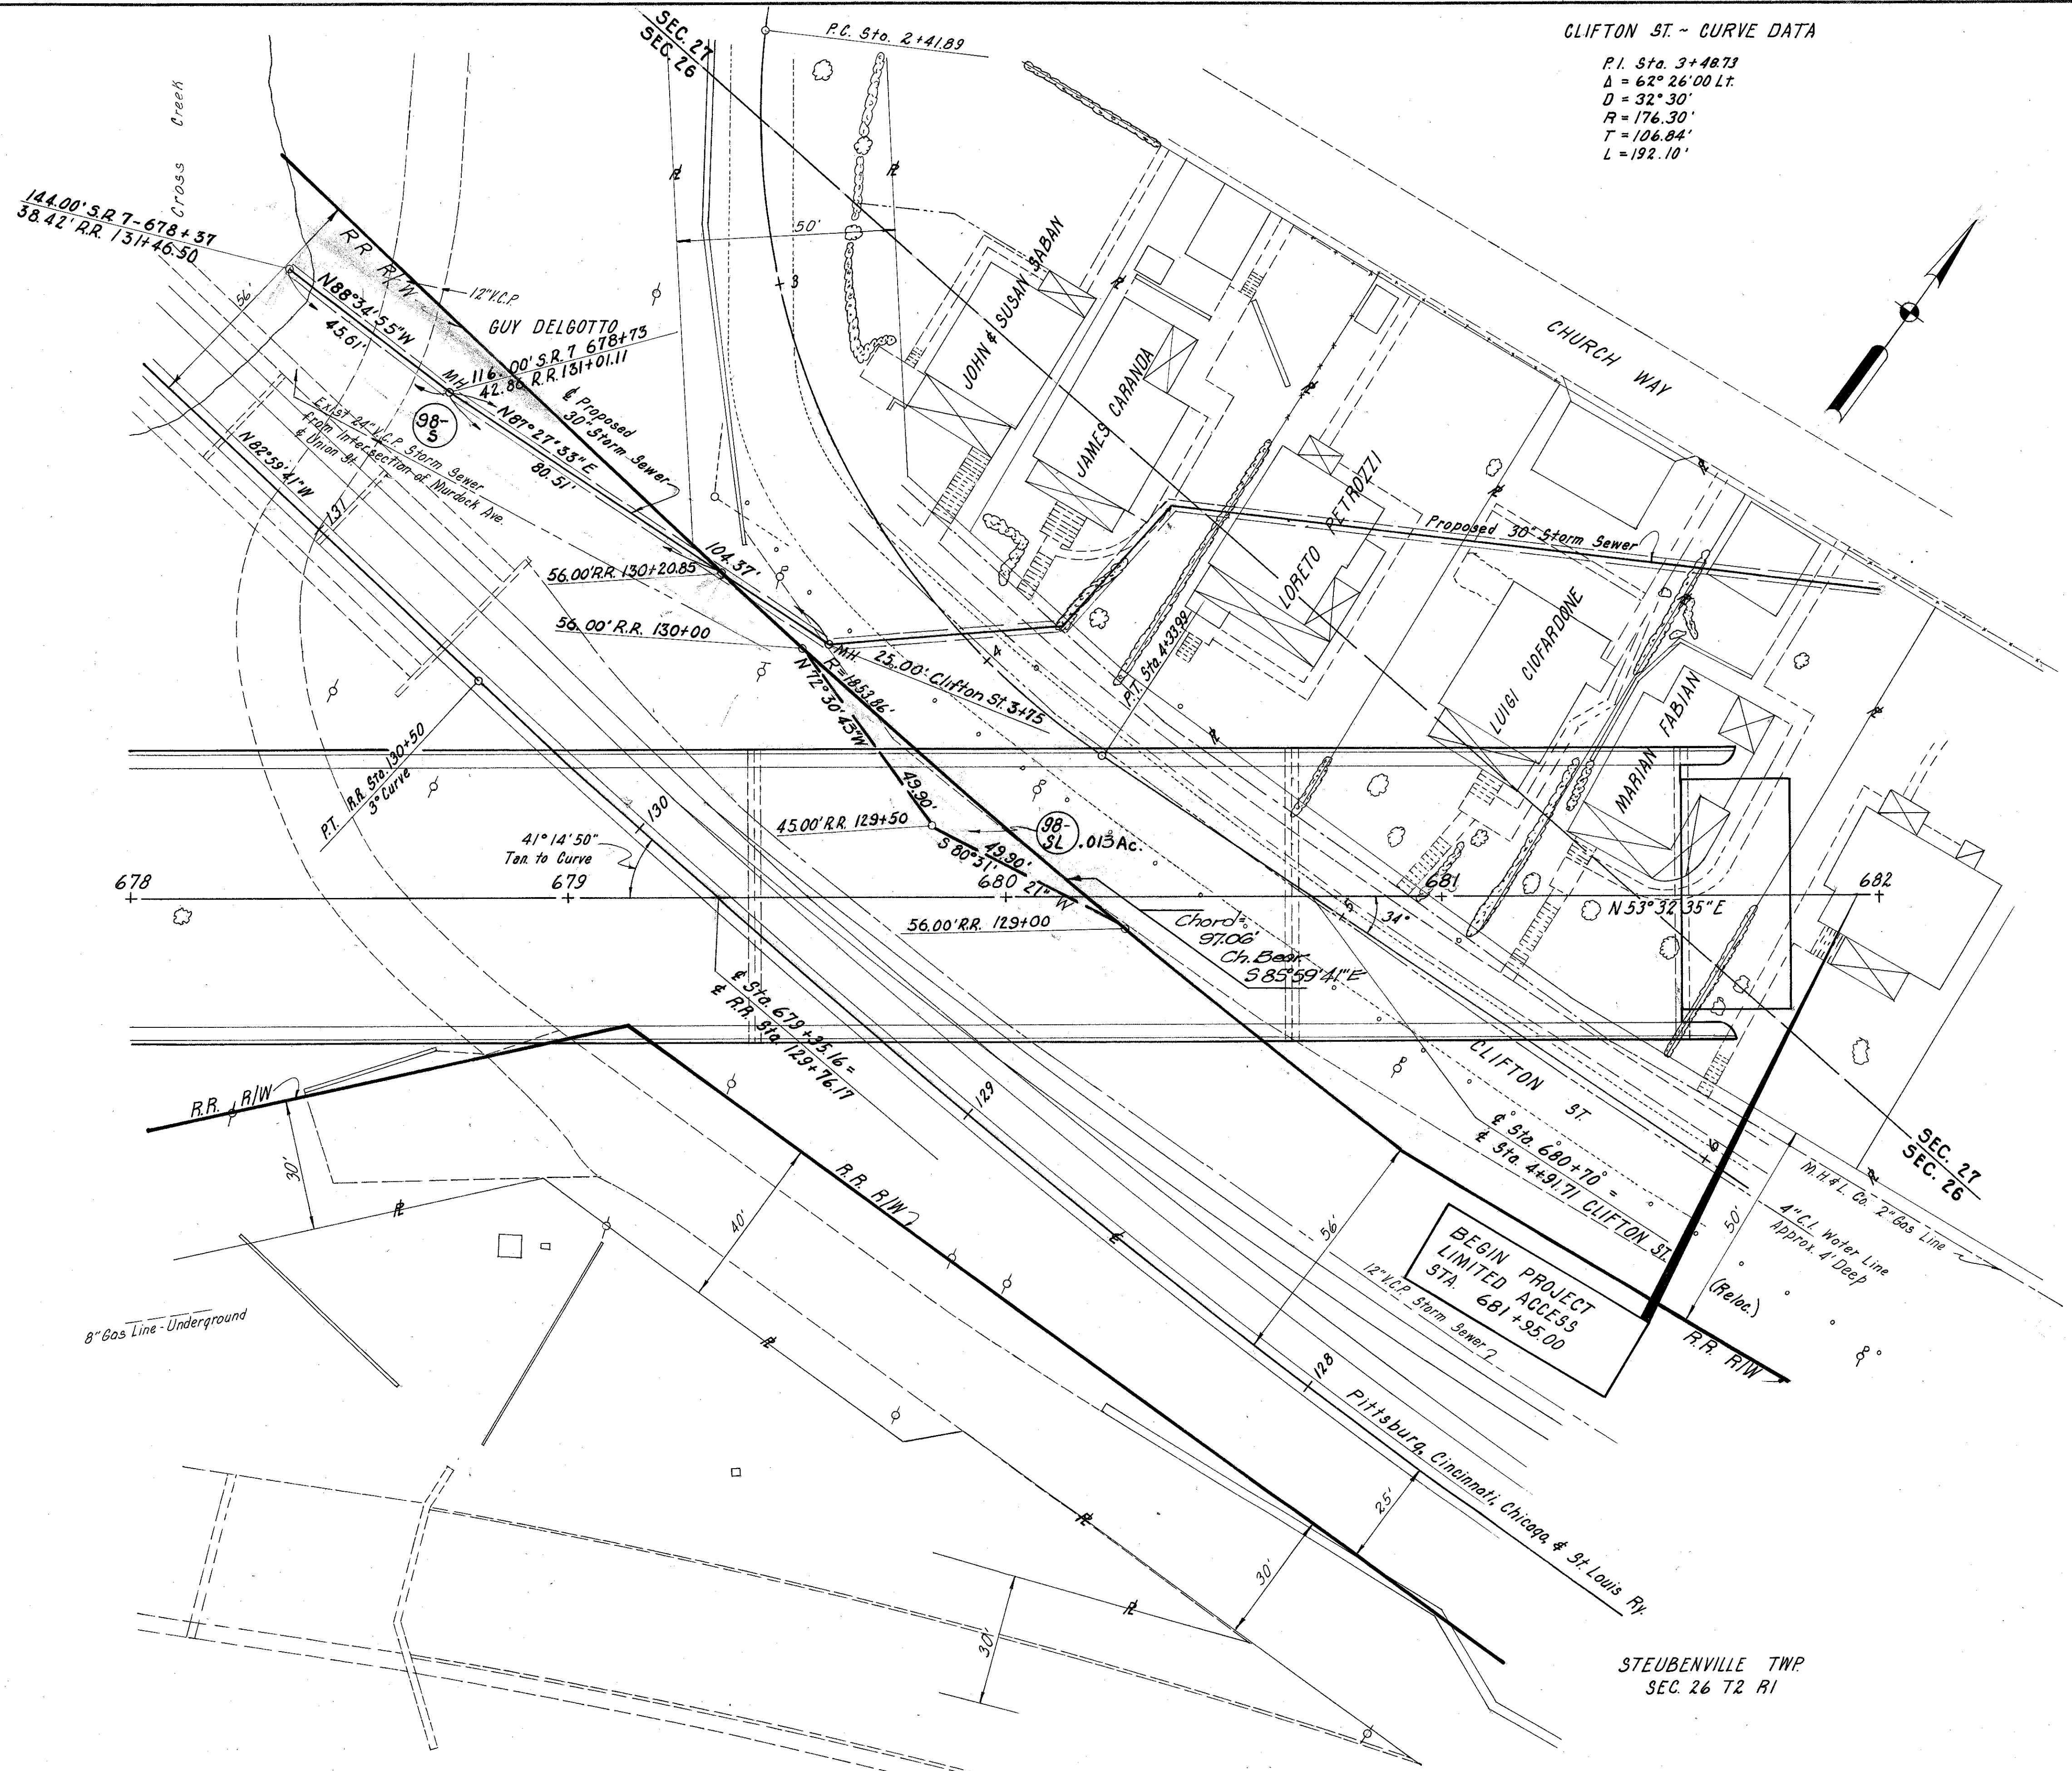

Note: Railroad Stations Are Referred To Those Shown On Railroad Company R/W Tract Map V-1, Ohio, Sheet 5, Sta. 98+00 to Sta. 150+80.

Scale 1" = 20'
6-22-59 Date of Completion


STEBENVILLE TWP
SEC. 26 T2 R1

STEUBENVILLE TWP
SEC. 27 T-2 R-1

FED. RD. DIVISION	STATE	PROJECT	TYPE FUNDS
2	OHIO	U-430 (14)	


307
307

JEFFERSON COUNTY
JEF-7-13.53
LIMITED ACCESS
R/W
19 OF 21

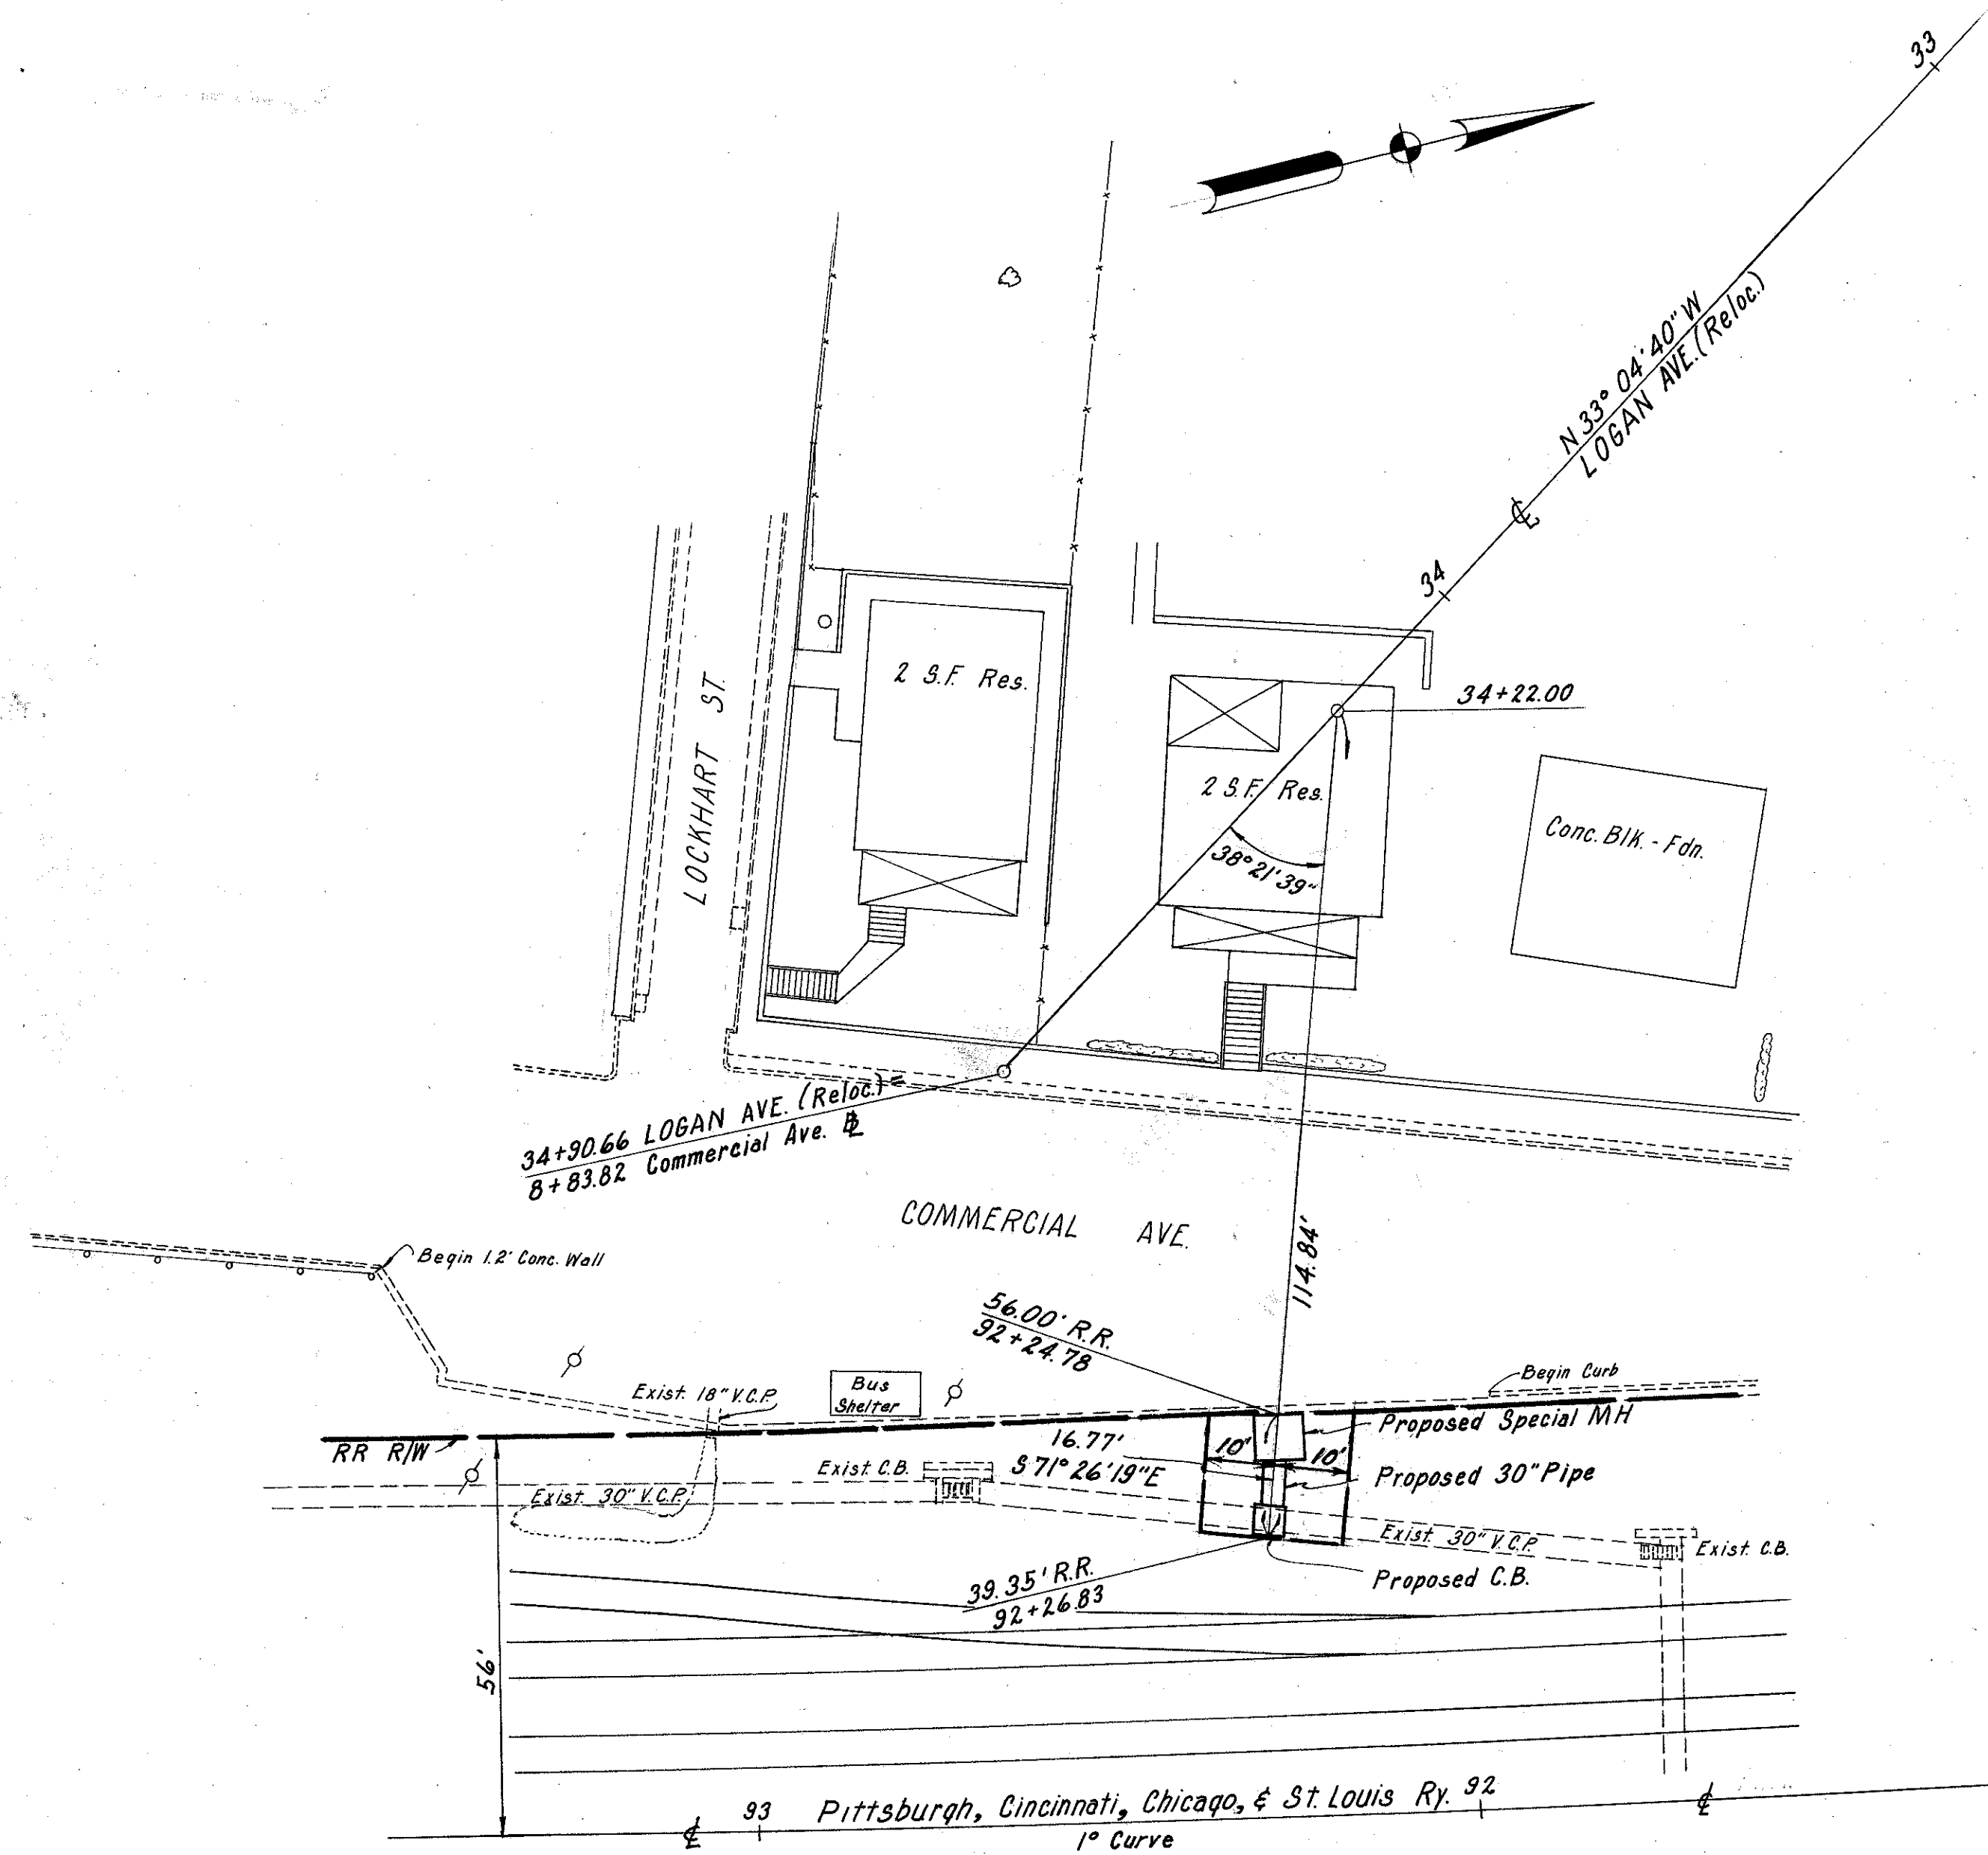

180A-S

NOTE: For Logan Ave. RW See Sheet 11

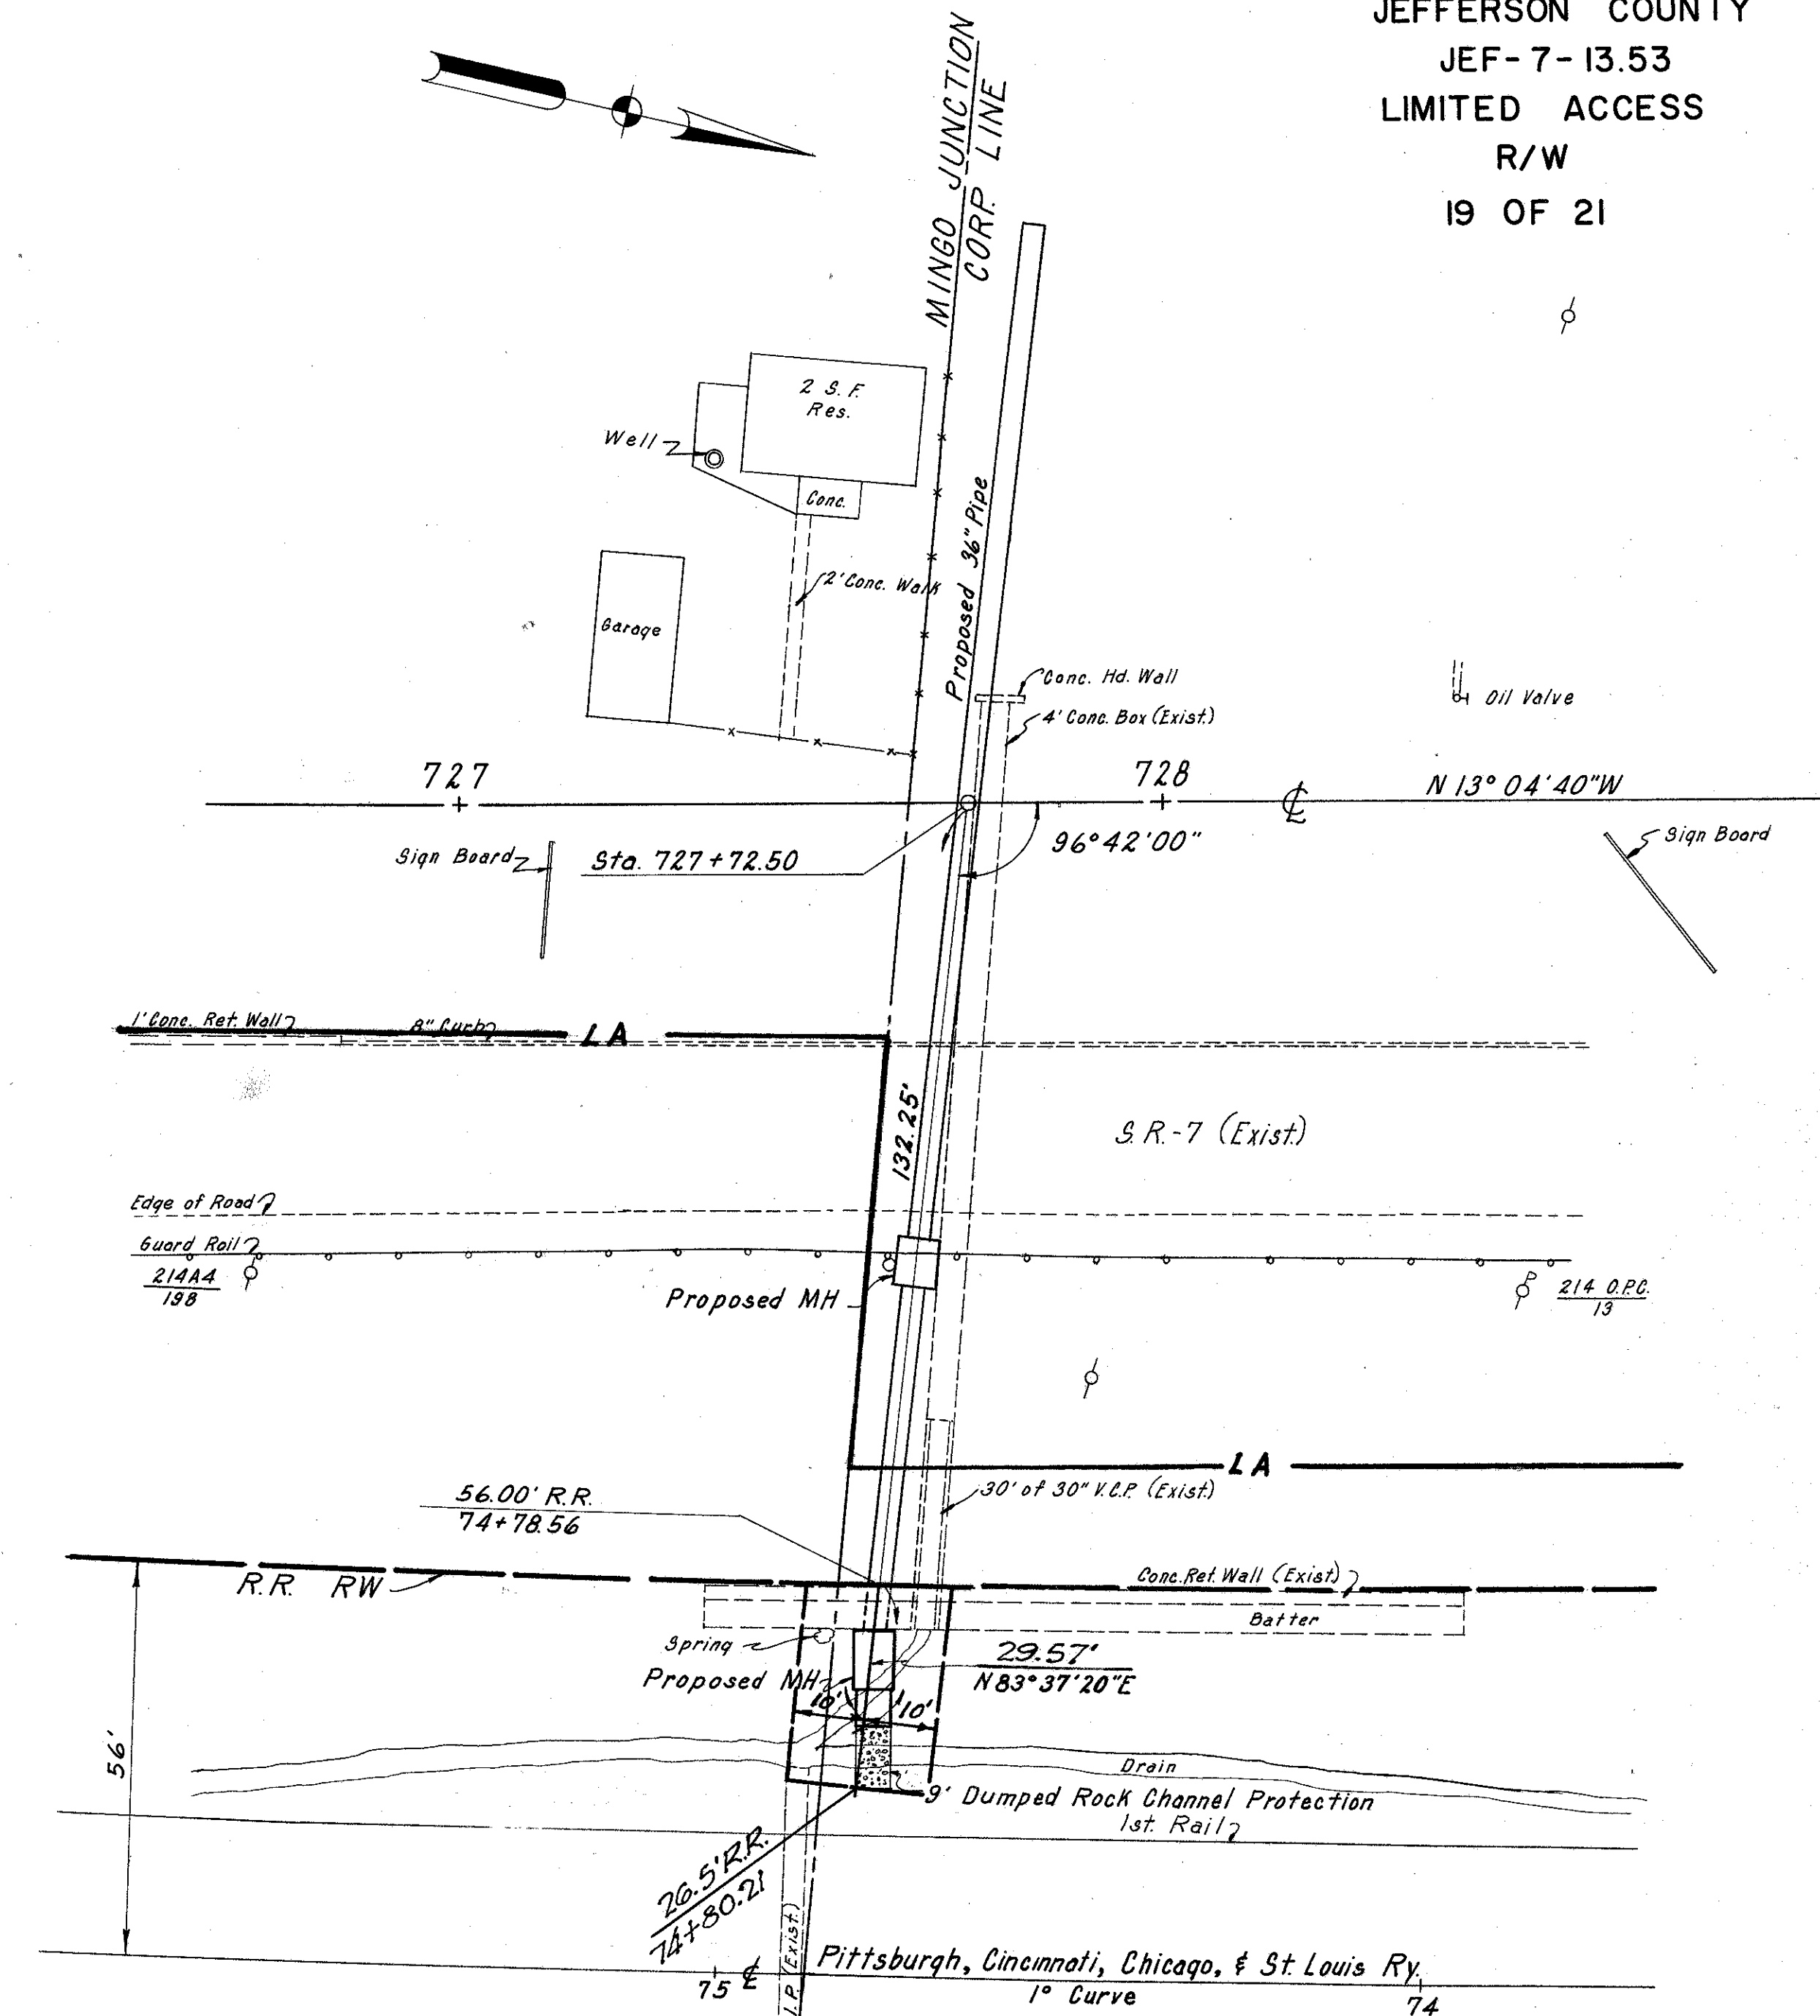

214A-S

NOTE: For Mainline RW See Sheet 15

Scale: 1" = 20'

6-22-59 Date of Completion