


Approved 9-22-17
w/ comments
N. J.

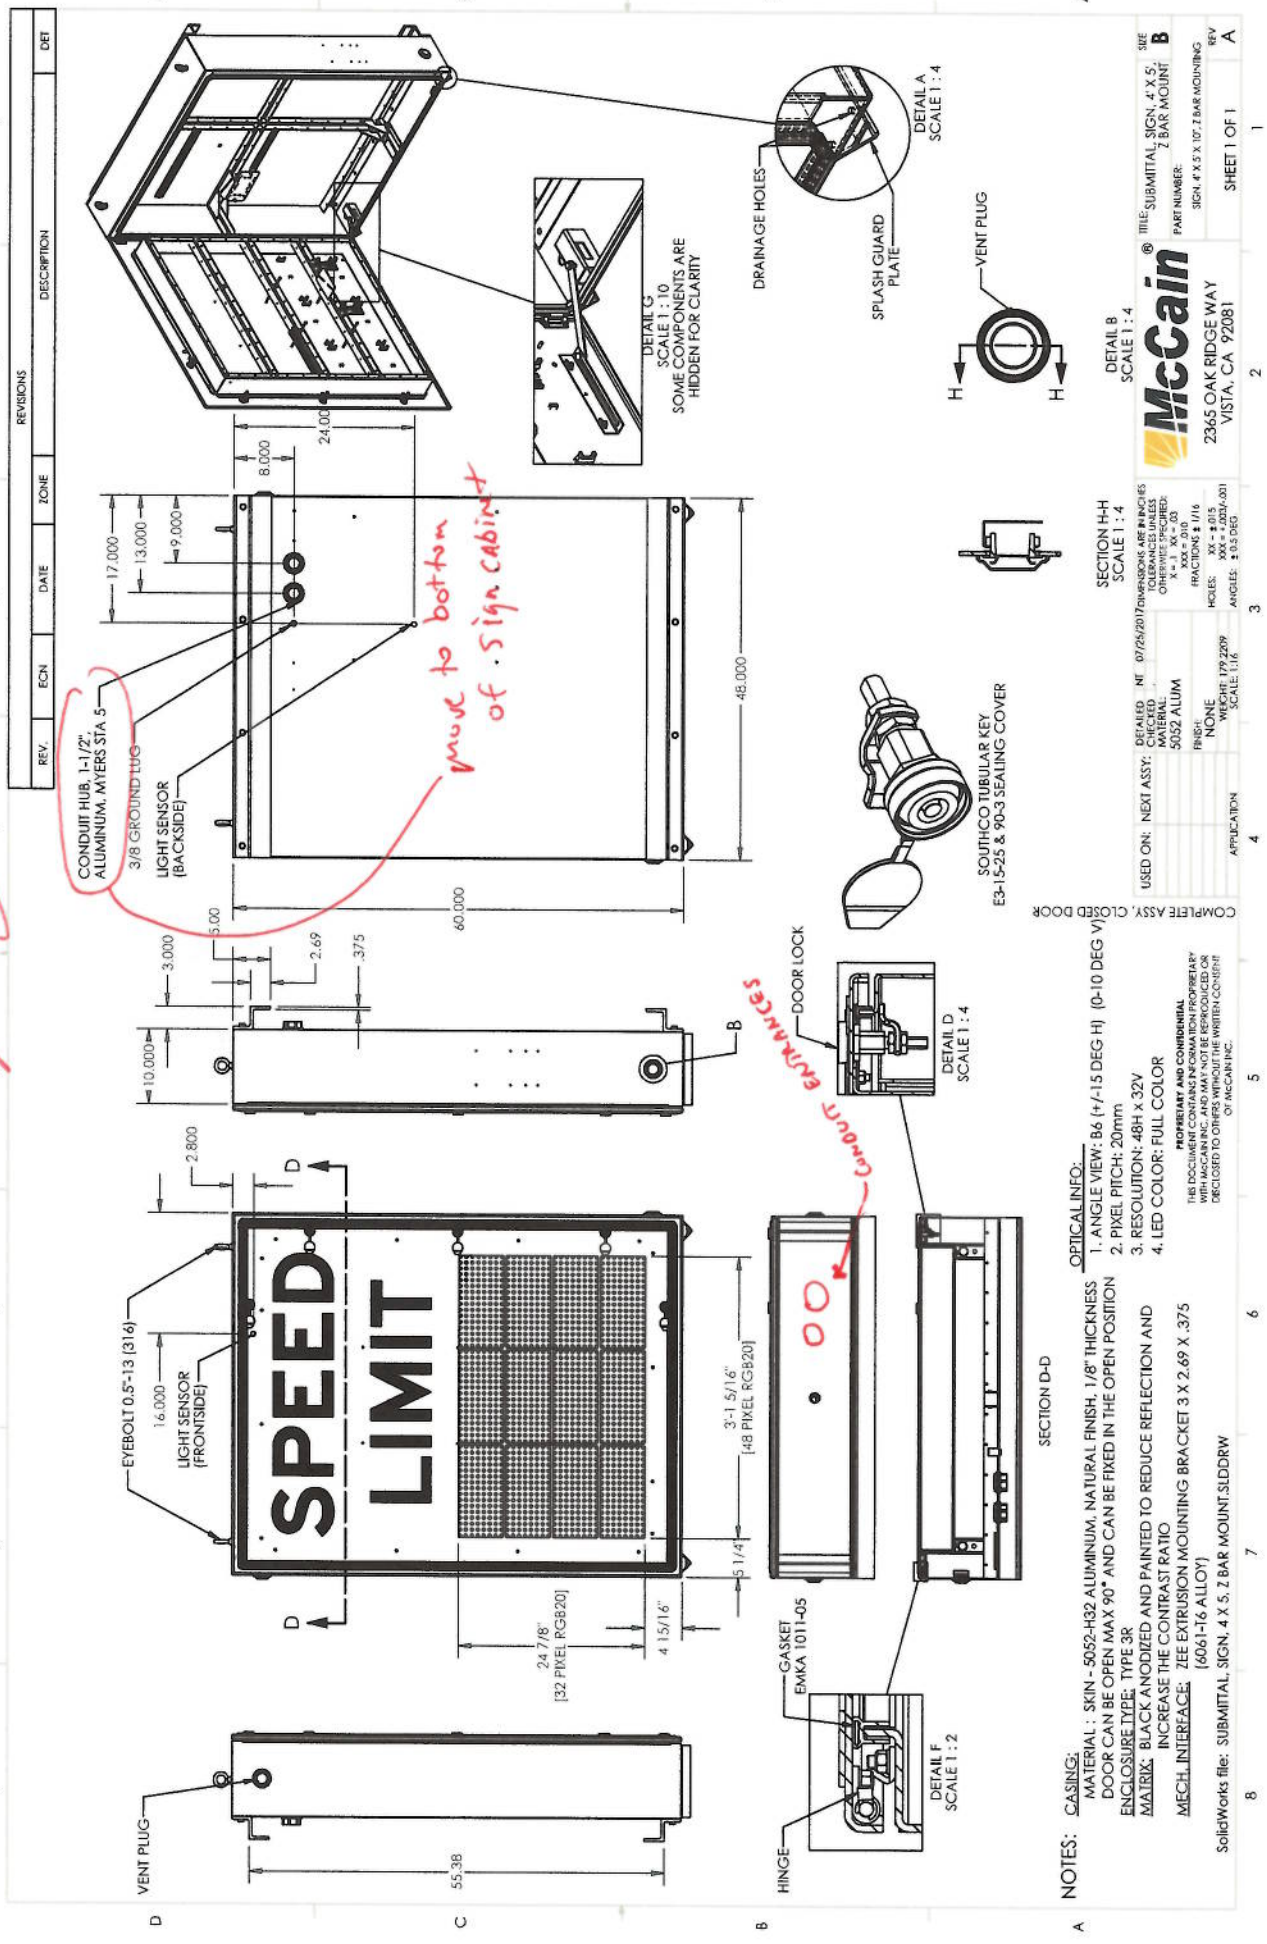

NOTES: CASING: MATERIAL: SKIN - 5052-H32 ALUMINUM, NATURAL FINISH, 1/8" THICKNESS DOOR CAN BE OPEN MAX 90° AND CAN BE FIXED IN THE OPEN POSITION ENCLOSURE TYPE: TYPE 3R MATRIX: BLACK ANODIZED AND PAINTED TO REDUCE REFLECTION AND INCREASE THE CONTRAST RATIO MECH. INTERFACE: ZEE EXTRUSION MOUNTING BRACKET 3 X 2.69 X .375 (6061-T6 ALLOY) Solidworks file: SUBMITTAL_SIGN_4 X 5.7_BAR_MOUNT.SLDRW		OPTICAL INFO: 1. ANGLE VIEW: B6 (+/-15 DEG H) (0-10 DEG V) 2. PIXEL PITCH: 20mm 3. RESOLUTION: 48H x 32V 4. LED COLOR: FULL COLOR	
DETAIL F SCALE 1:2		DETAIL G SCALE 1:10 SOME COMPONENTS ARE HIDDEN FOR CLARITY	
DETAIL A SCALE 1:4		DETAIL B SCALE 1:4	

McCain
 2365 OAK RIDGE WAY
 VISTA, CA 92081

NEXT ASSY:	5052 ALUM				
MATERIAL:	5052 ALUM				
FINISH:	NONE				
WEIGHT:	179.2209				
SCALE:	1:1.6				
ANGLE:	5.9.5 DEG				

REVISIONS	DESCRIPTION	DATE	ZONE	REV	DEF
