

Transportation Dr

SR-254 (Detroit Rd)

$\phi 4$

$\phi 4$

$\phi 4$

$\phi 5$   
 $\phi 2$

$\phi 4$


$\phi 8$



Image Landsat / Copernicus

Google Earth



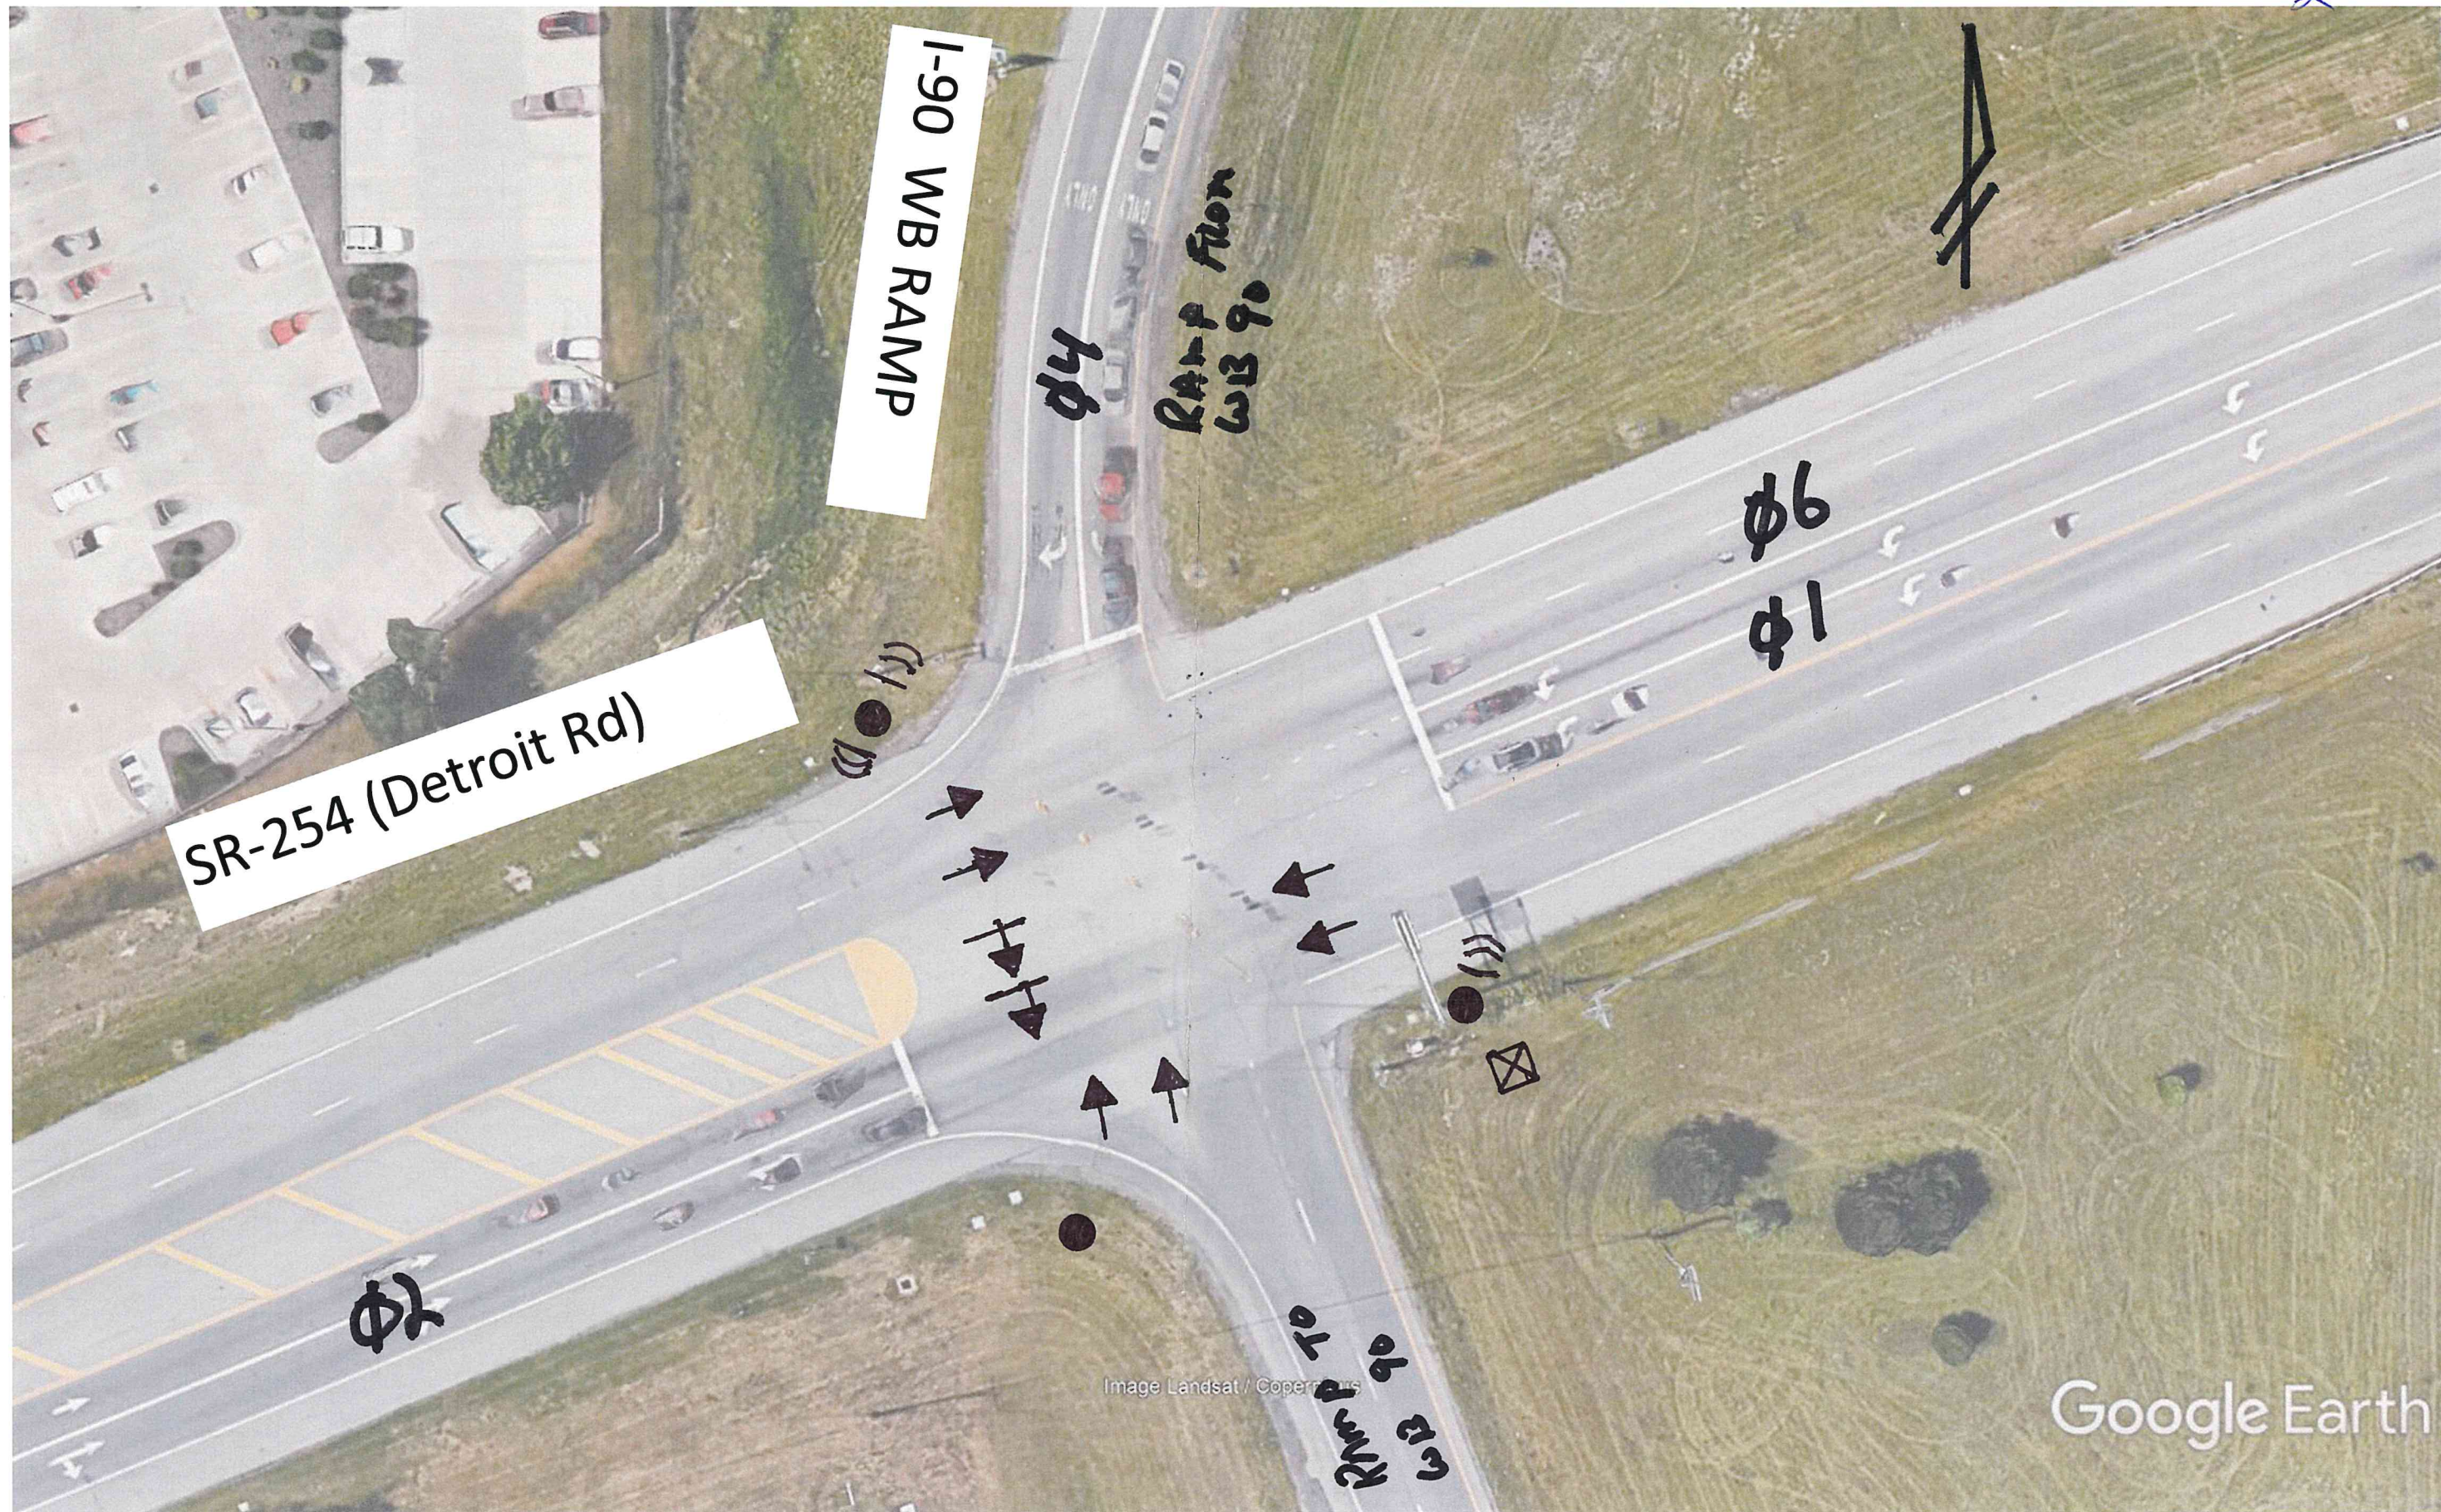

SR-254 (Detroit Rd)

I-90 WB RAMP

RAMP from WB 90

φ4

φ6  
φ1


φ2

RAMP TO WB 90

Image Landsat / Copernicus

Google Earth



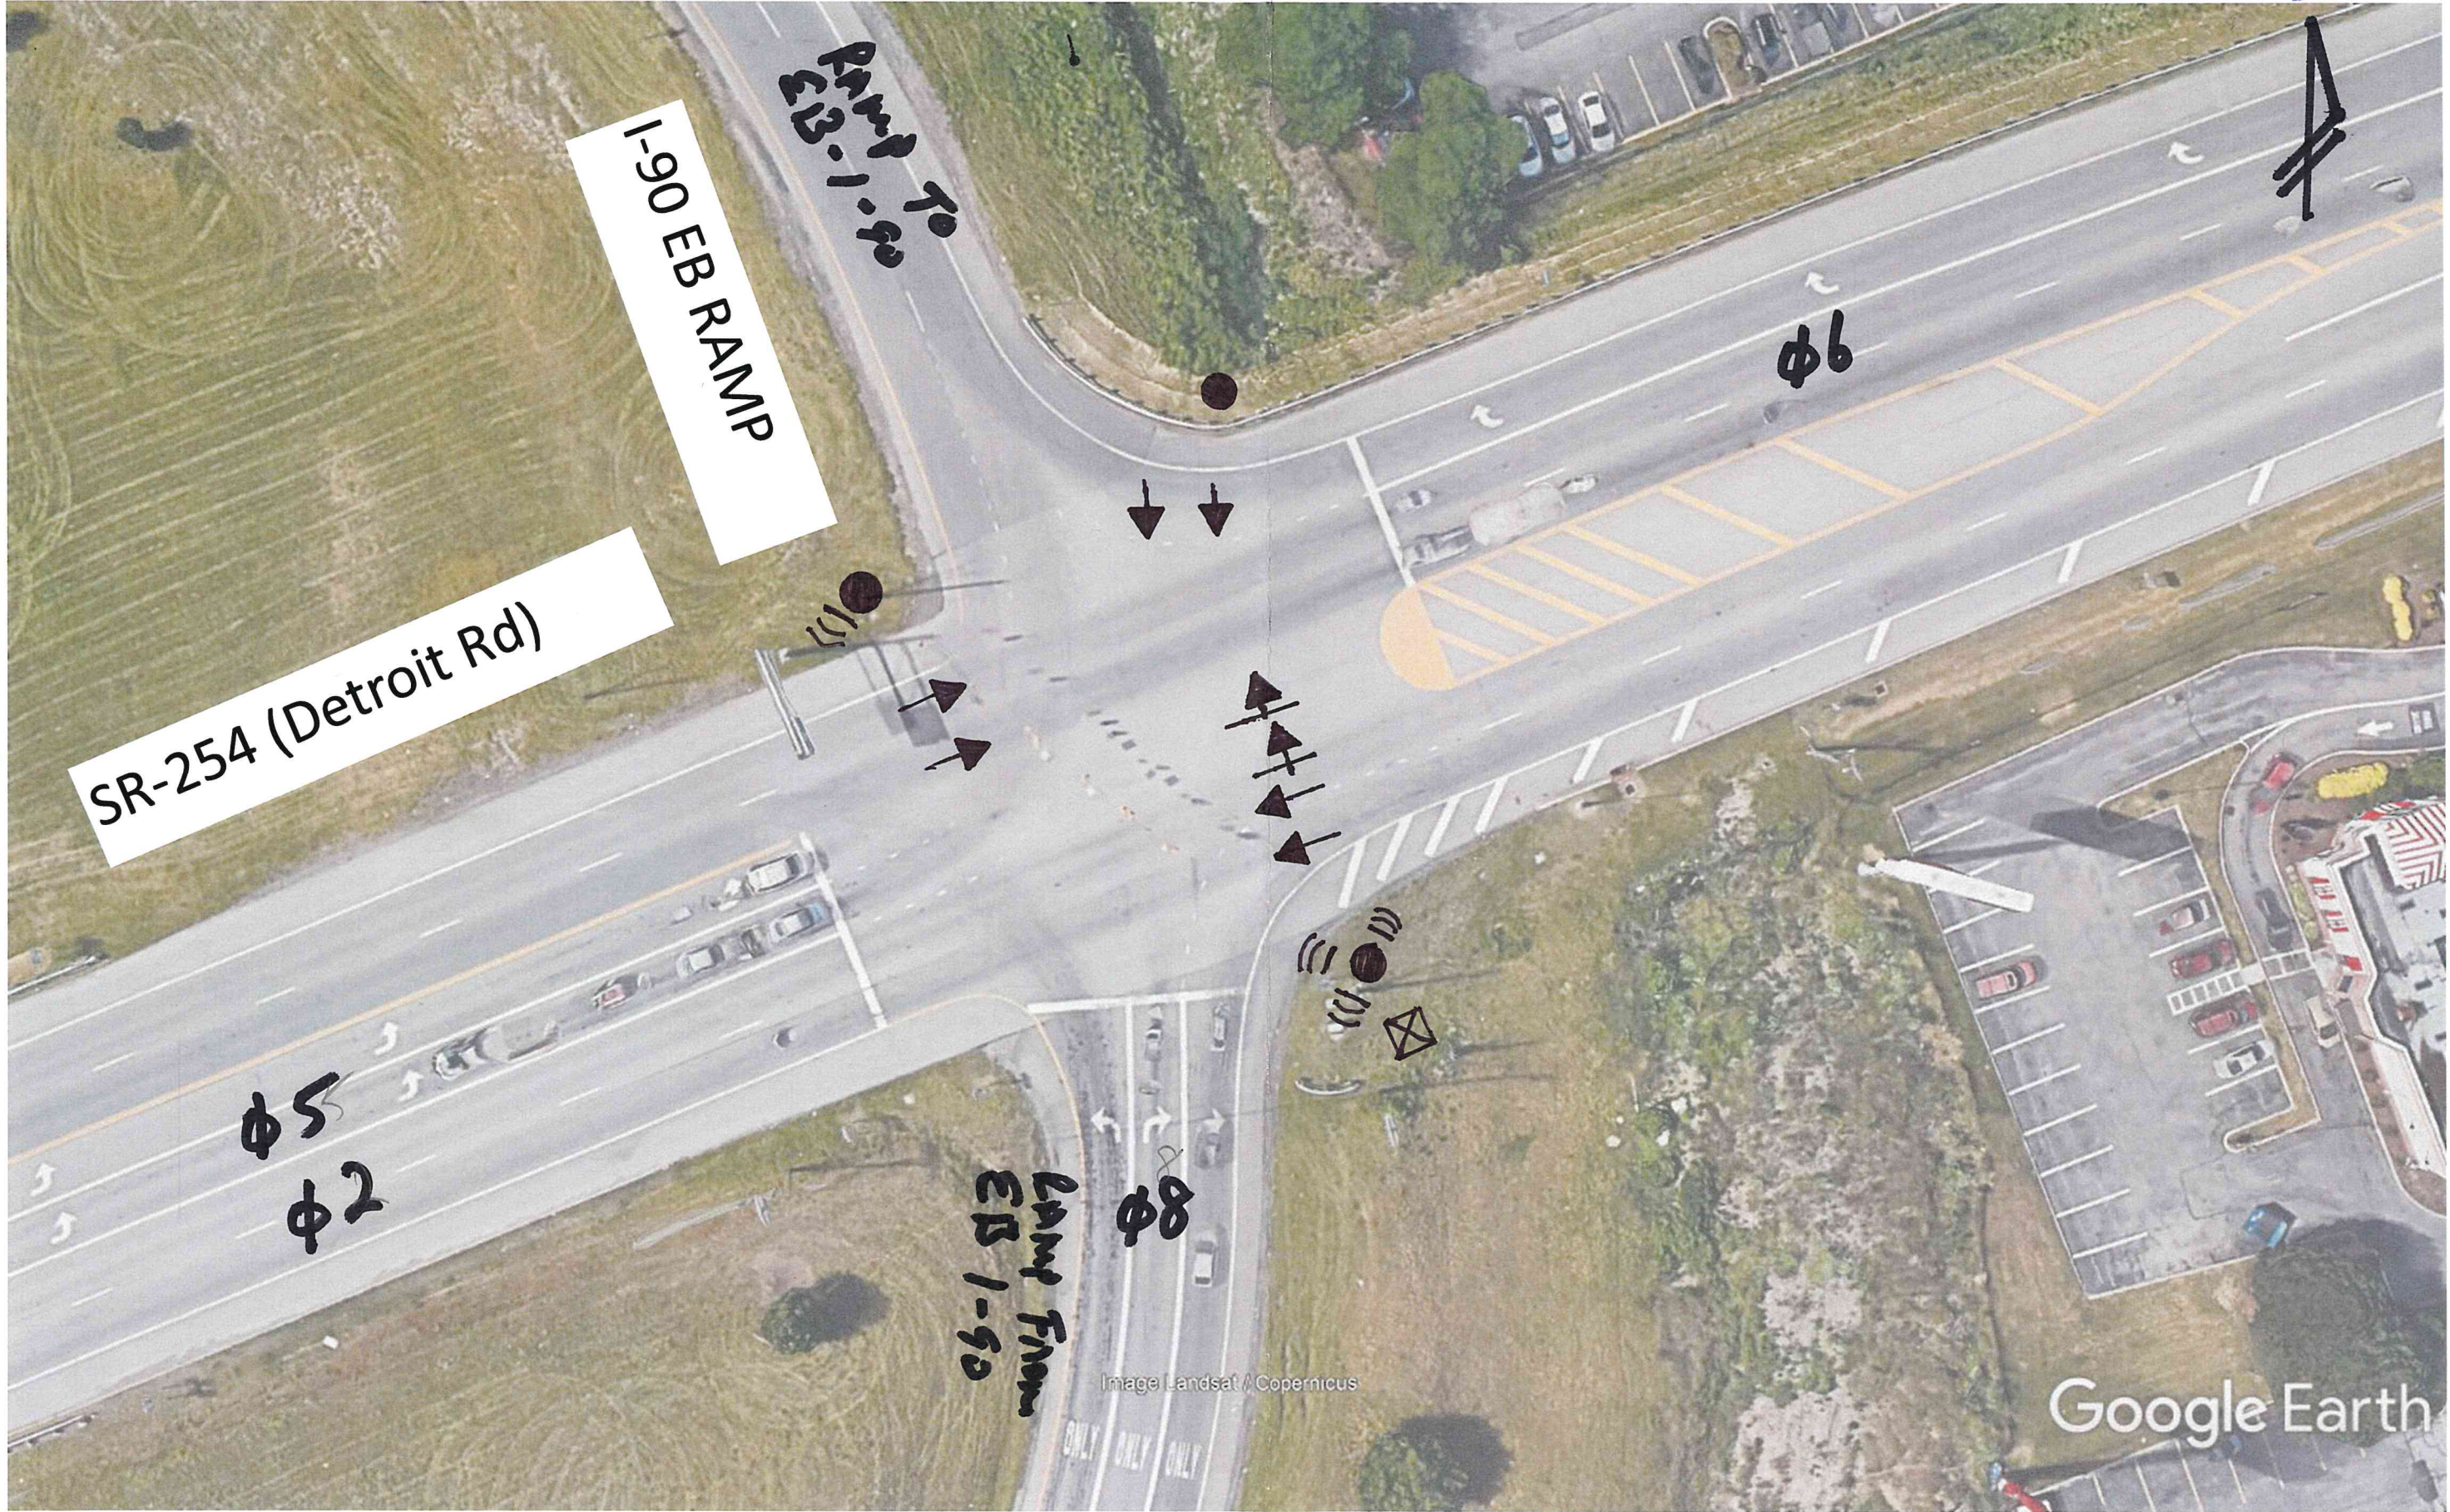

SR-254 (Detroit Rd)

I-90 EB RAMP

Ramp Flow  
EB I-90

φ5  
φ2

Ramp Flow  
EB I-90

φ8

φ6

Google Earth

3

Image Landsat / Copernicus



Sheffield Crossing

SR-254 (Detroit Rd)




Φ5  
Φ2


Φ4

Φ6  
Φ1

Φ8

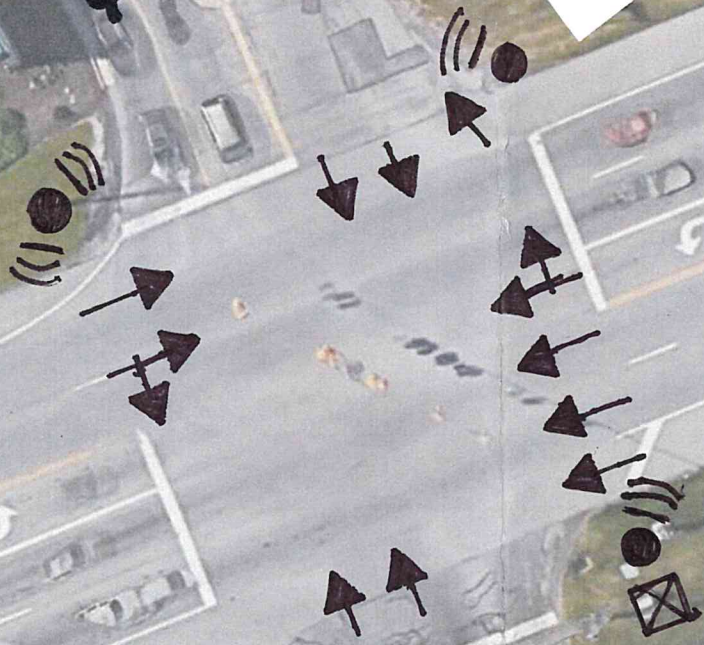



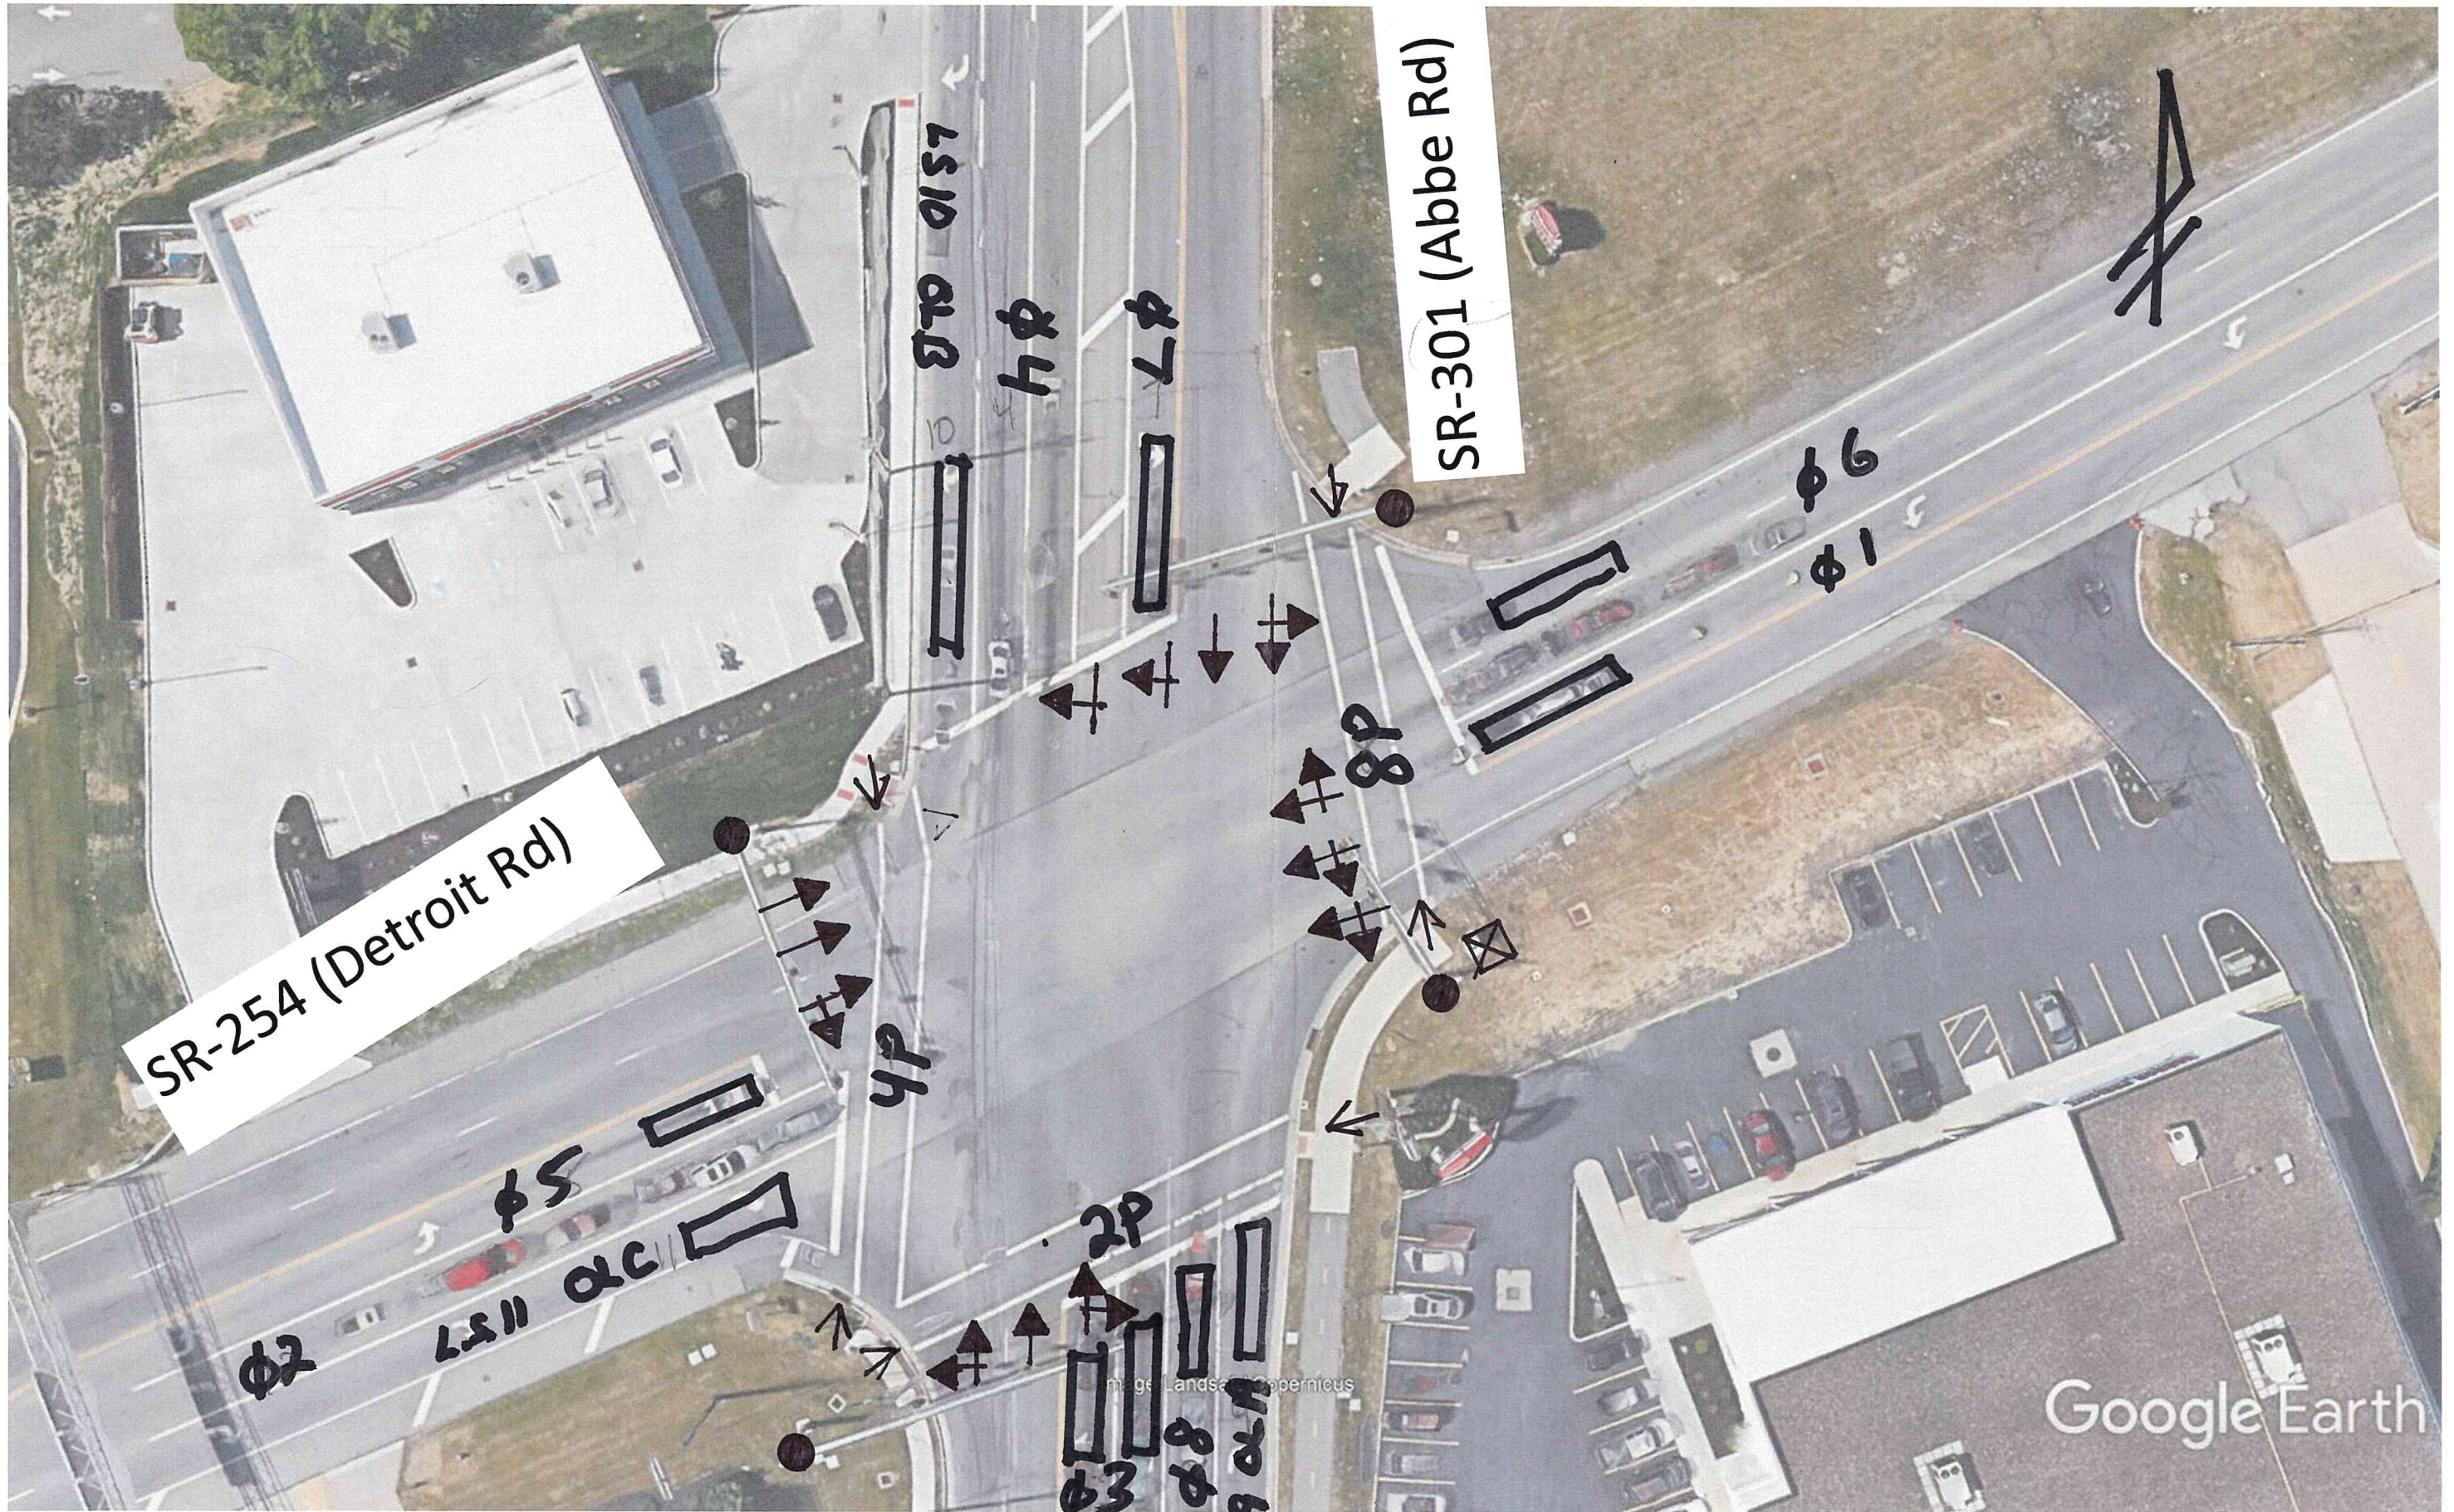

SR-254 (Detroit Rd)

SR-301 (Abbe Rd)

SR-301 (Abbe Rd)

Φ2

Φ5

L311 αC

4P

2P

Φ8

L319 αA

L317

hφ

L7

8P

Φ6


Φ1

Google Earth

5

5



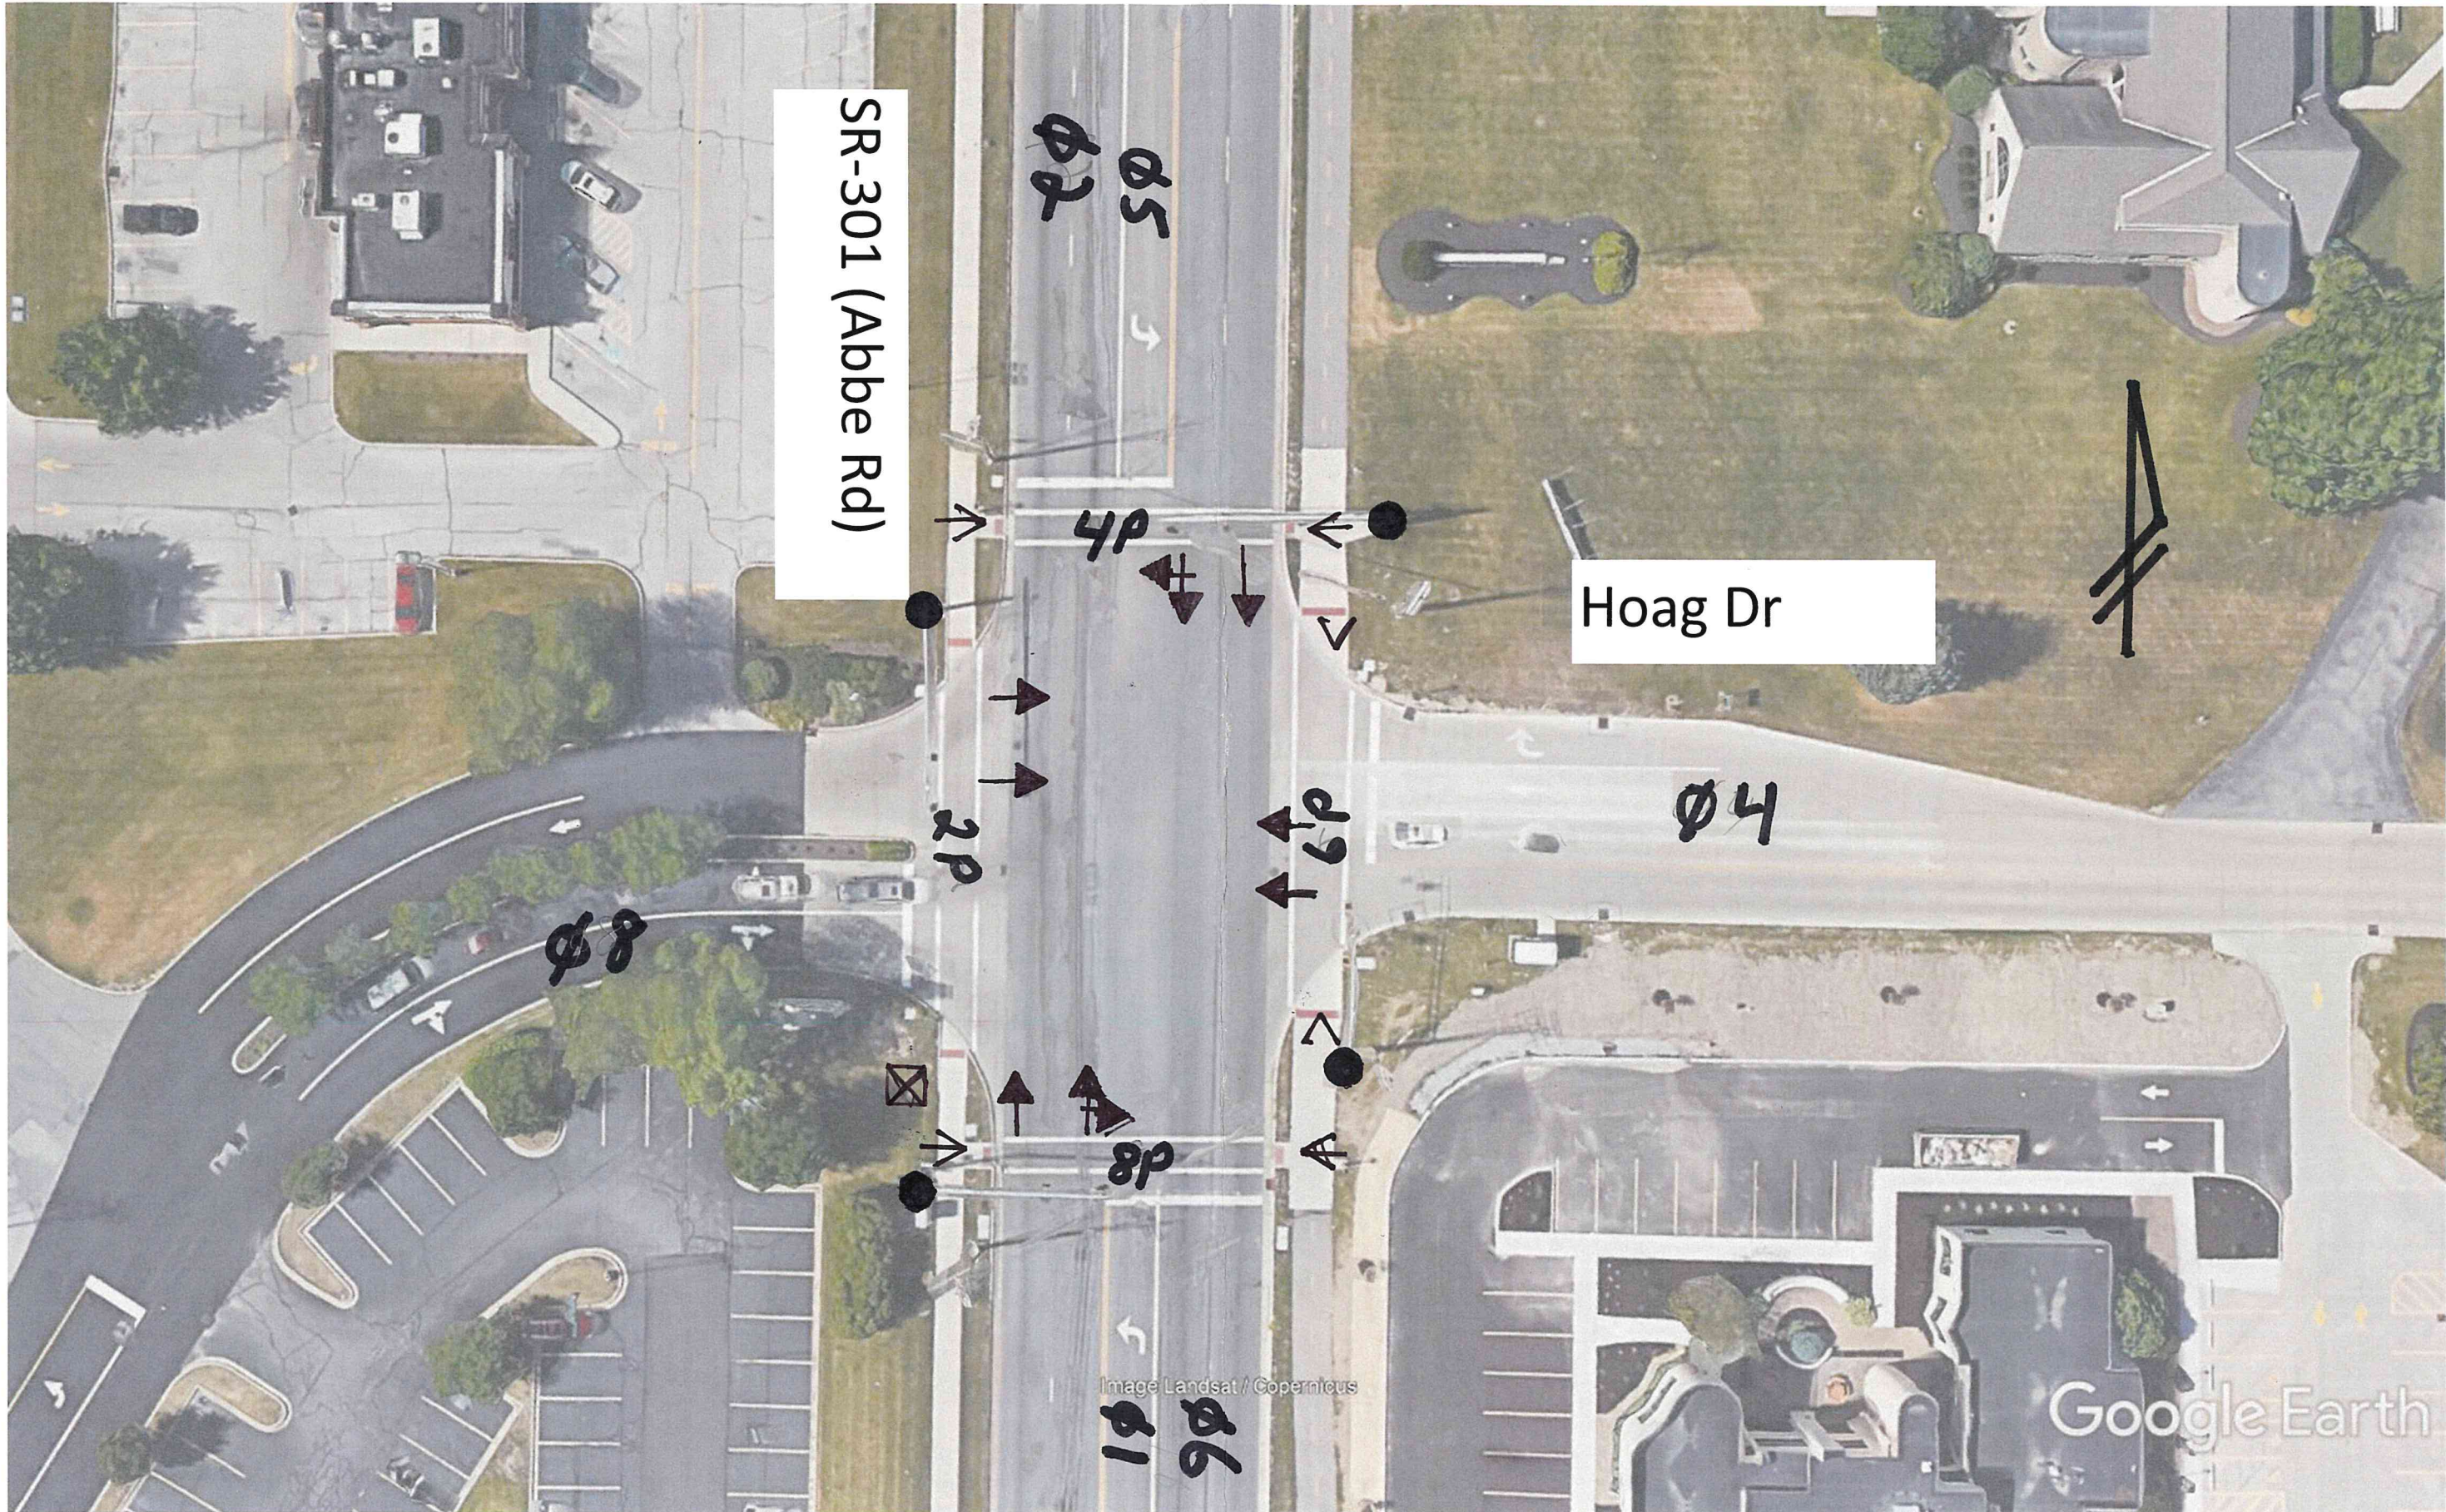

SR-301 (Abbe Rd)

Hoag Dr

Ø5  
Ø2

Ø4

Ø8

Ø1  
Ø6

Ø8

Ø9

Ø2




Image Landsat / Copernicus

Google Earth



LO 254

20033-002

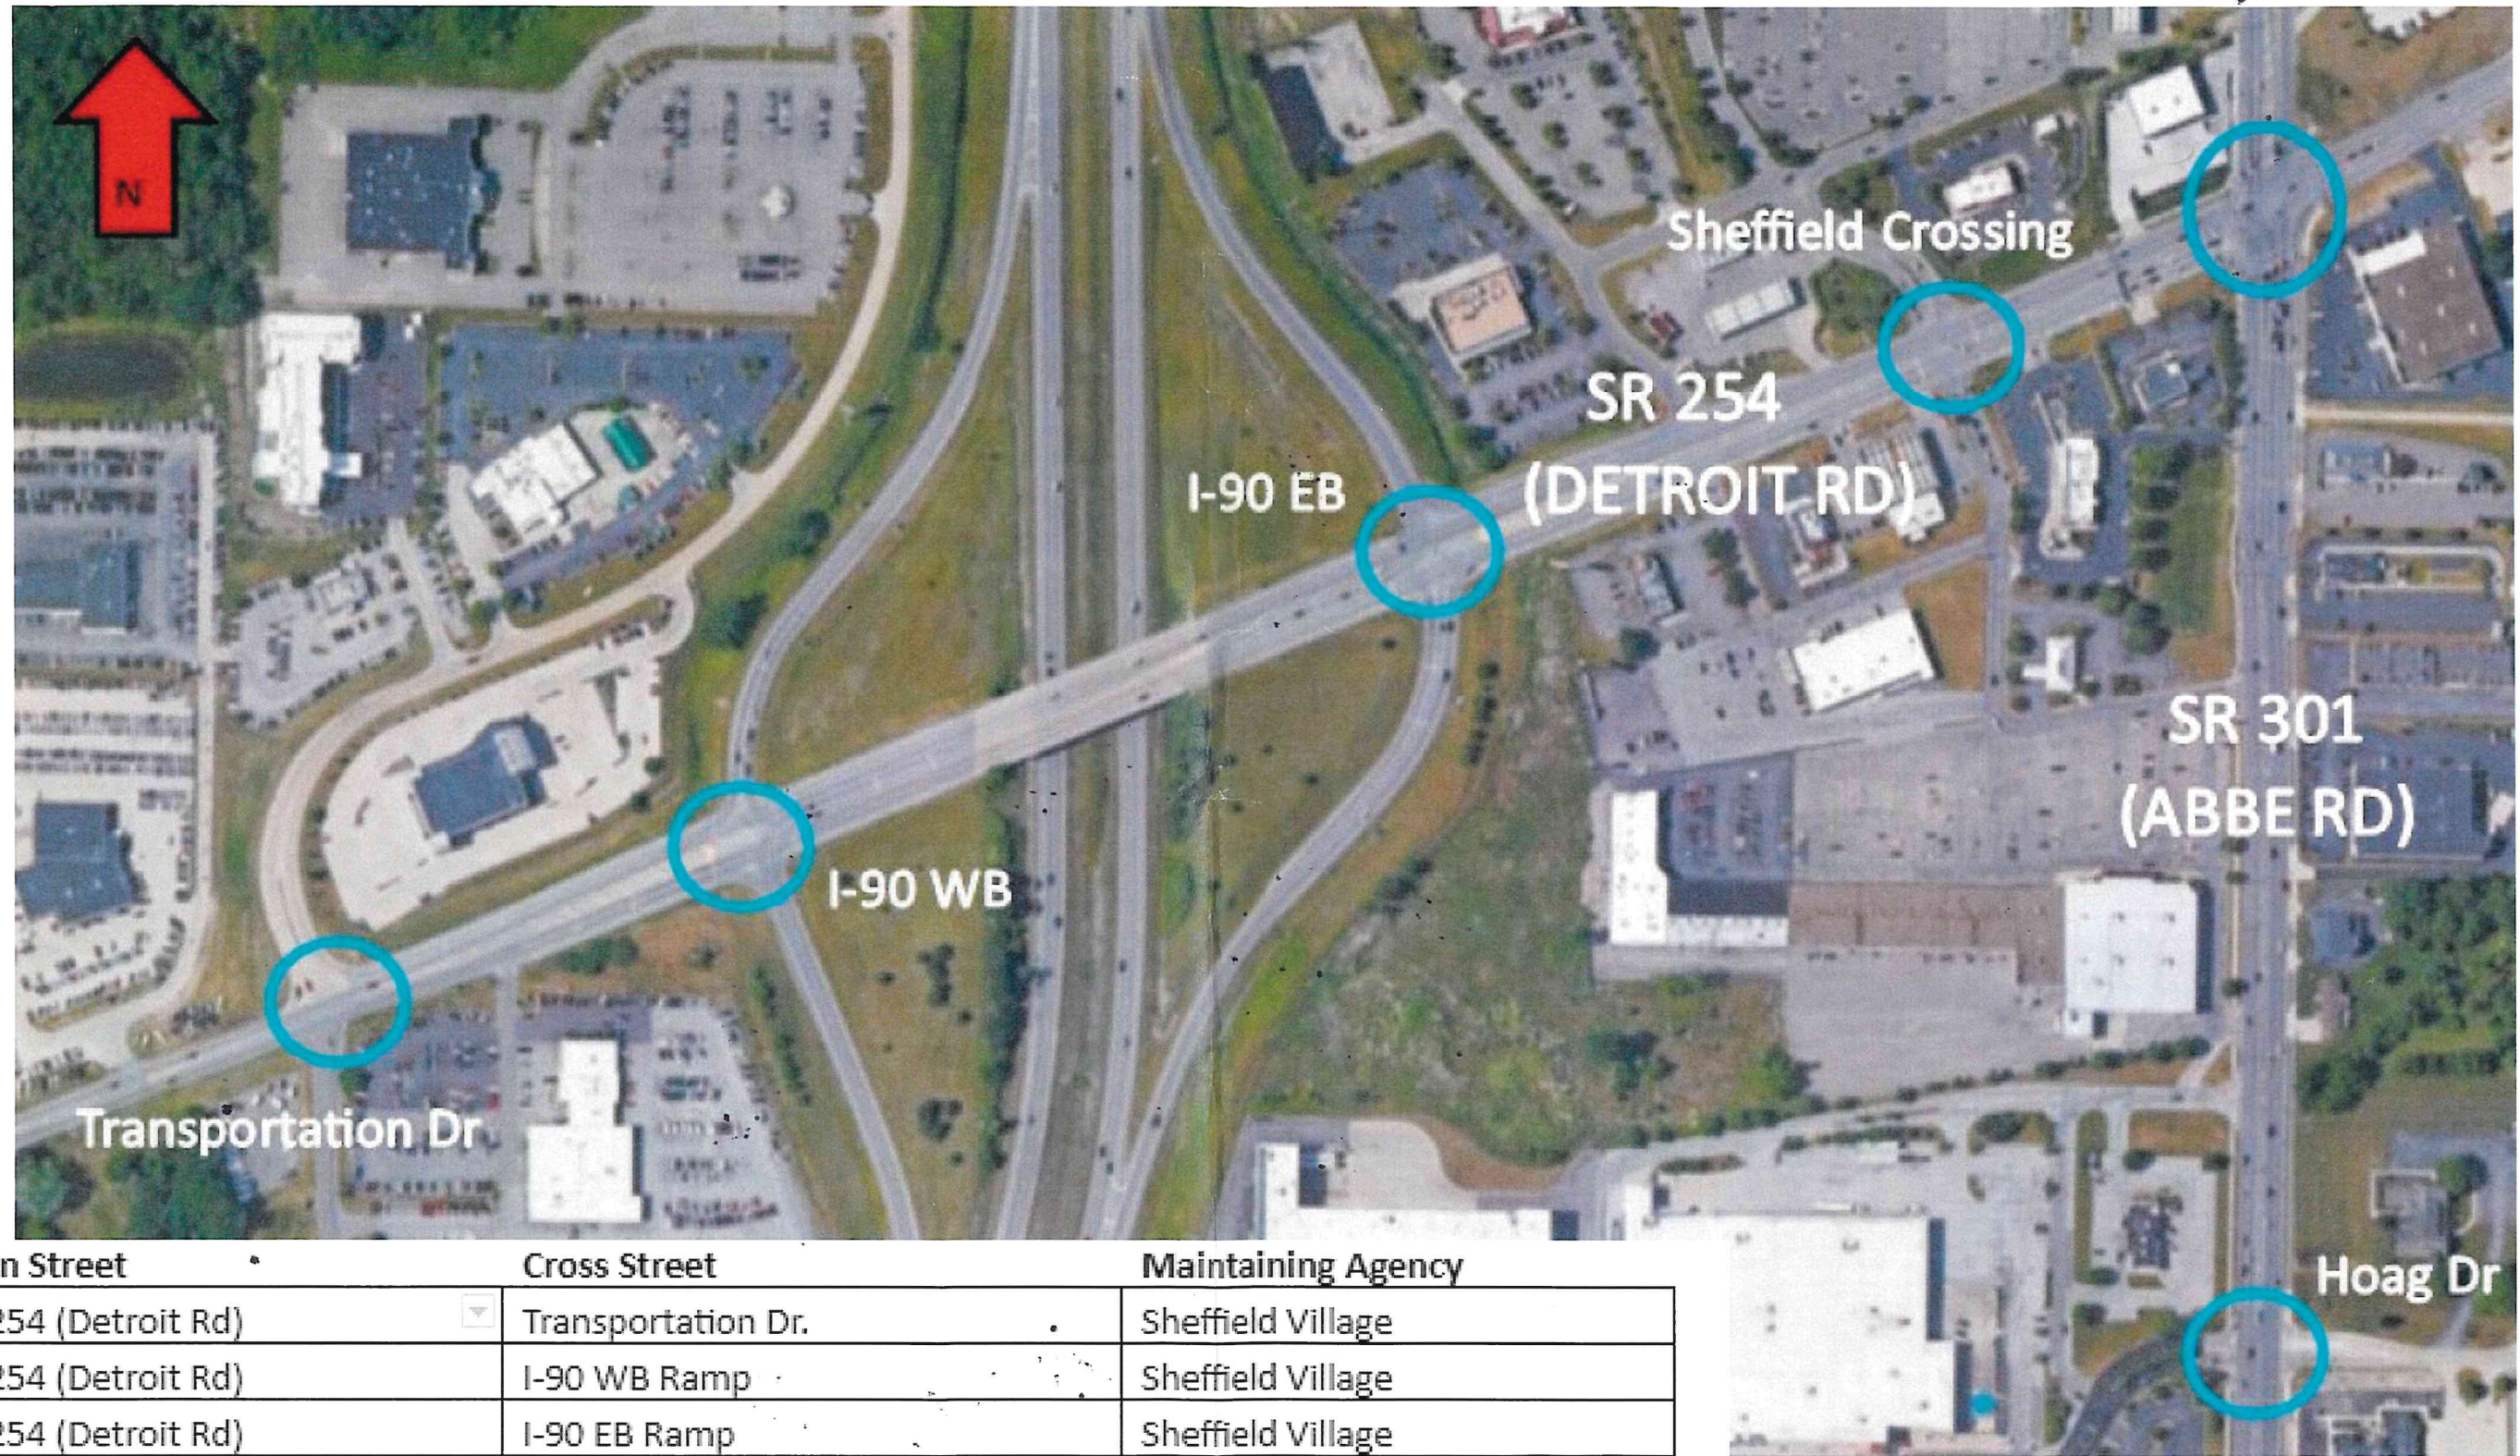

Main Street	Cross Street	Maintaining Agency
SR-254 (Detroit Rd)	Transportation Dr.	Sheffield Village
SR-254 (Detroit Rd)	I-90 WB Ramp	Sheffield Village
SR-254 (Detroit Rd)	I-90 EB Ramp	Sheffield Village
SR-254 (Detroit Rd)	Sheffield Crossing	Sheffield Village
SR-254 (Detroit Rd)	SR 301 (Abbe Rd)	Sheffield Village
SR-301 (Abbe Rd)	Hoag Dr.	Sheffield Village