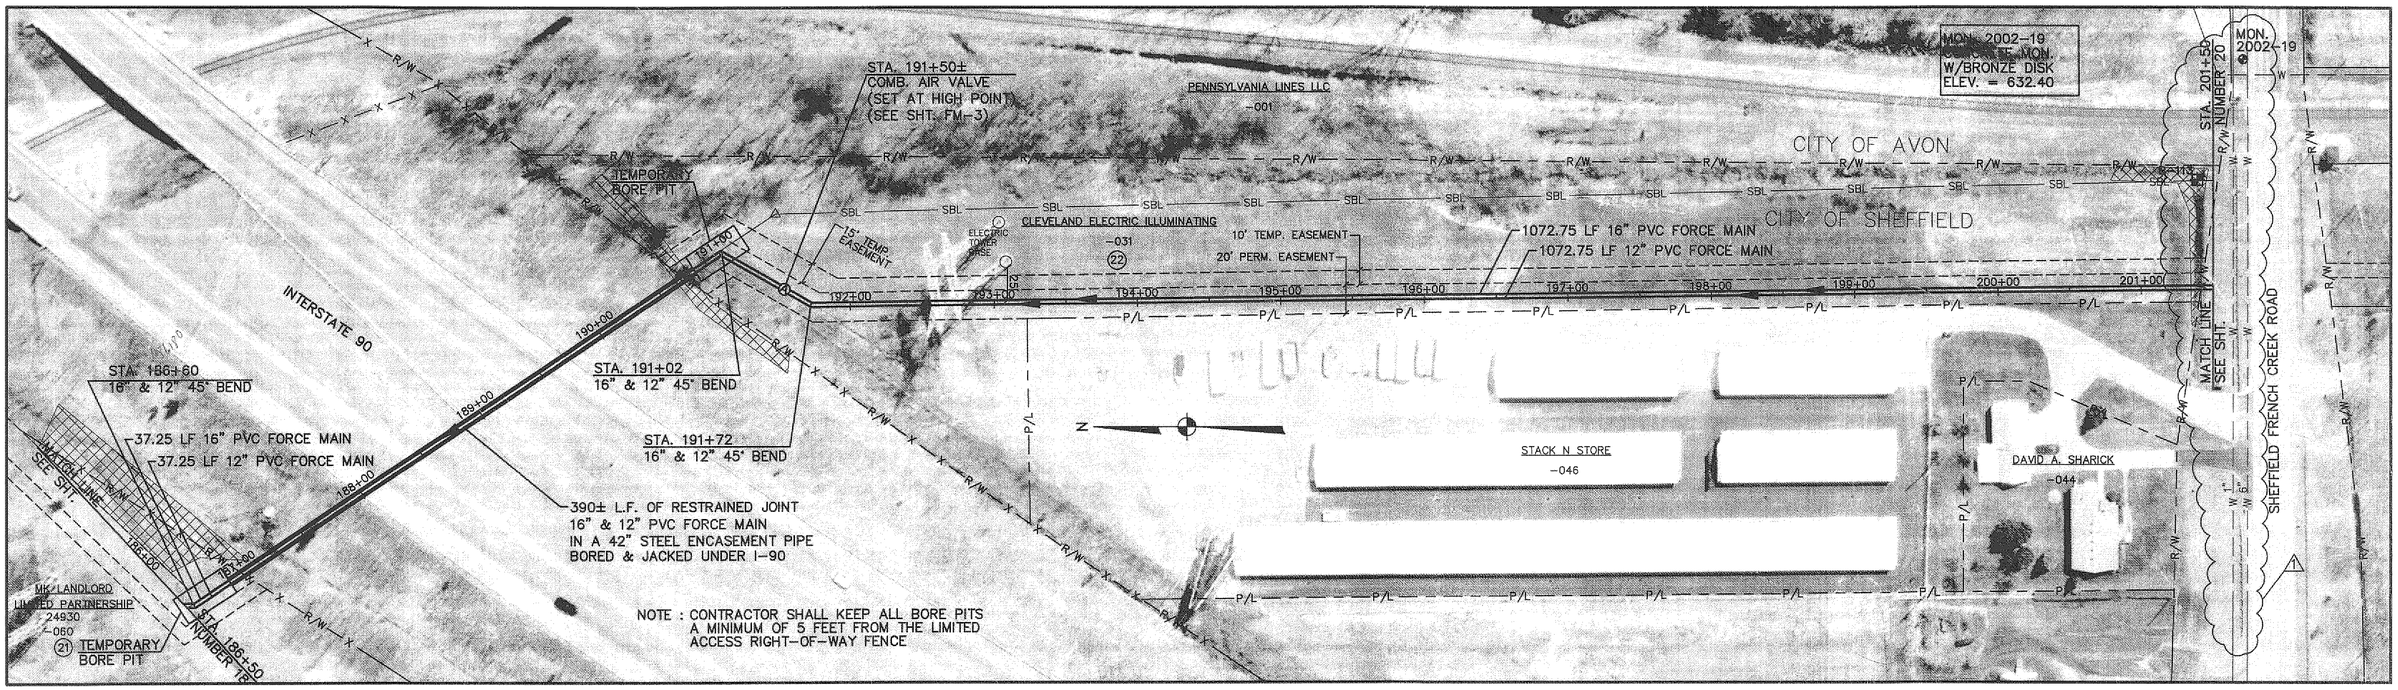

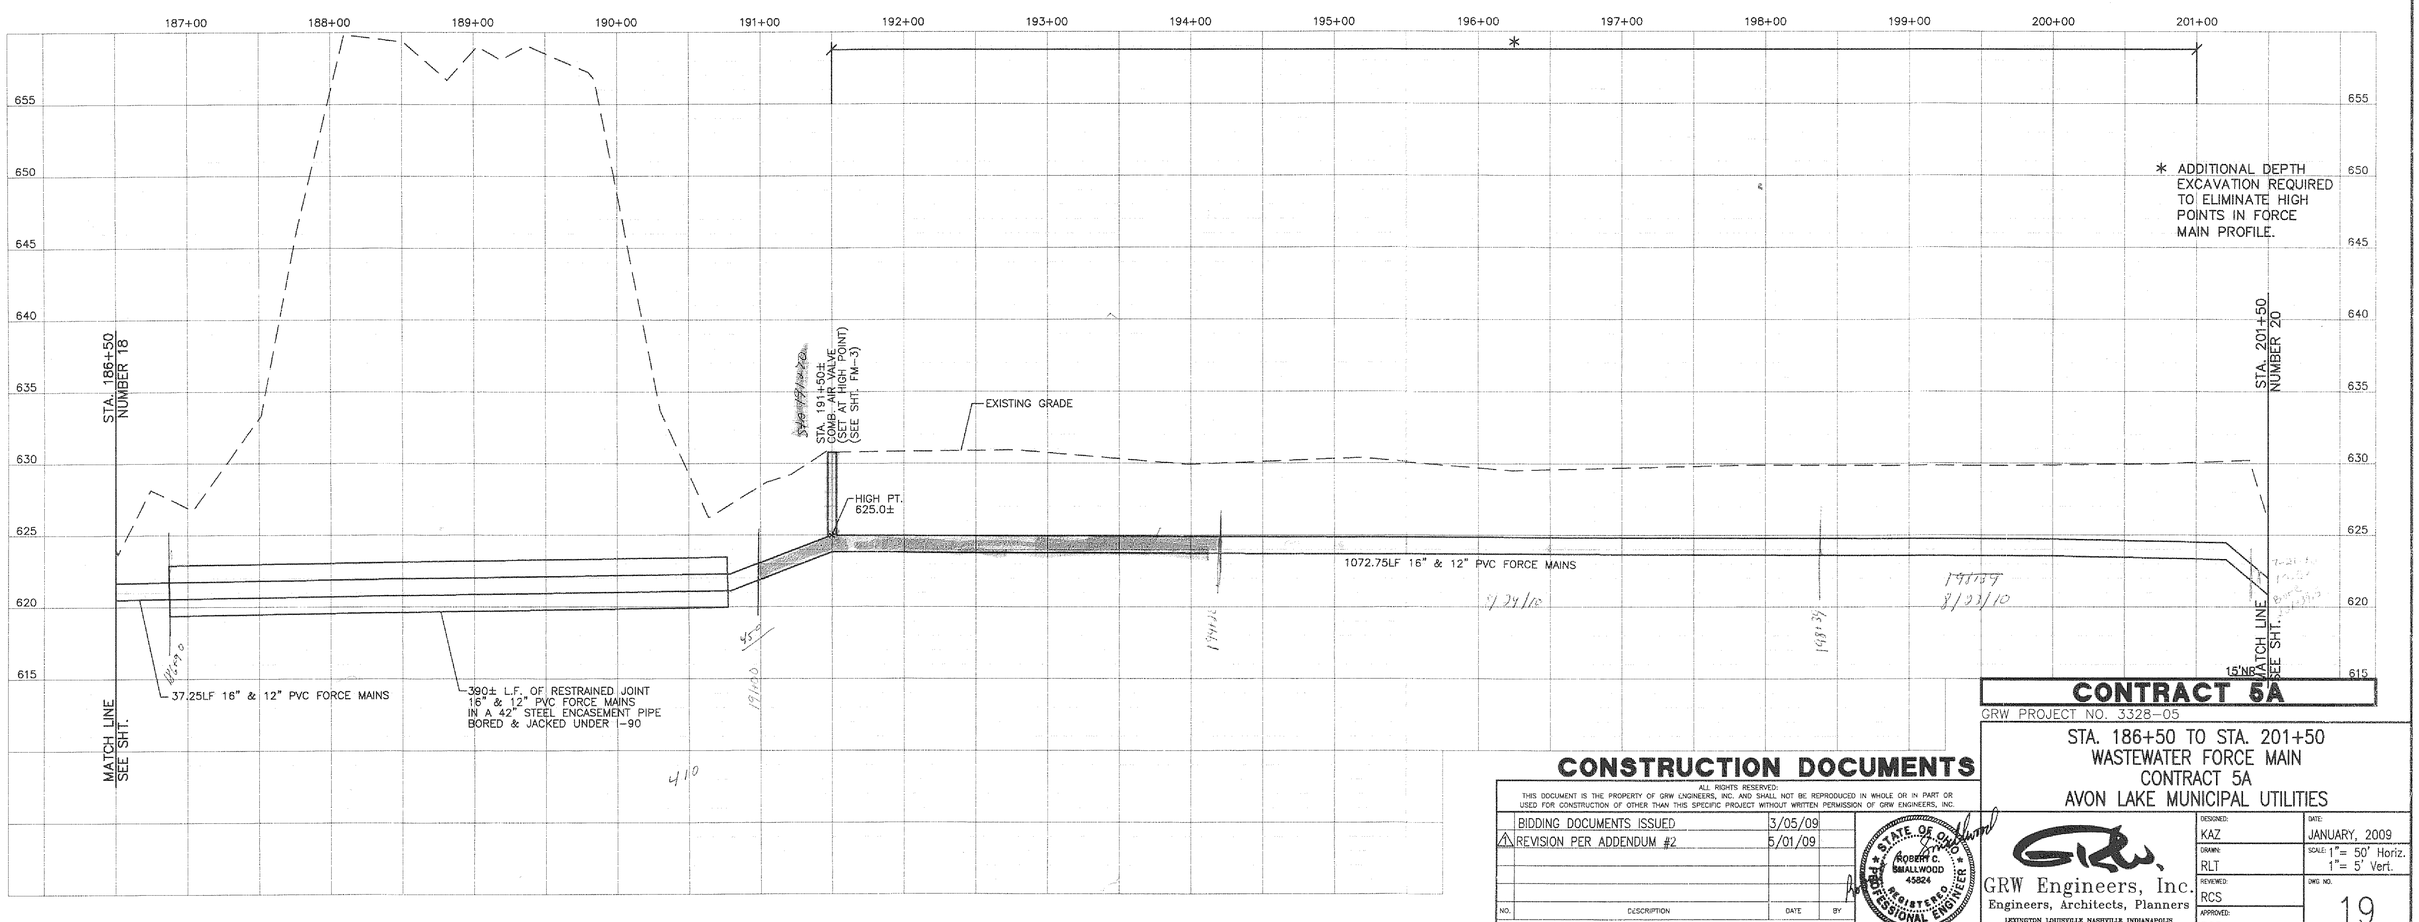

CONTRACT 5A

GRW PROJECT NO. 3328-05

STA. 186+50 TO STA. 201+50
WASTEWATER FORCE MAIN
CONTRACT 5A
AVON LAKE MUNICIPAL UTILITIES

CONSTRUCTION DOCUMENTS

ALL RIGHTS RESERVED:
THIS DOCUMENT IS THE PROPERTY OF GRW ENGINEERS, INC. AND SHALL NOT BE REPRODUCED IN WHOLE OR IN PART OR USED FOR CONSTRUCTION OF OTHER THAN THIS SPECIFIC PROJECT WITHOUT WRITTEN PERMISSION OF GRW ENGINEERS, INC.

NO.	DESCRIPTION	DATE	BY
	BIDDING DOCUMENTS ISSUED	3/05/09	
1	REVISION PER ADDENDUM #2	5/01/09	

REVISIONS

STATE OF OHIO
ROBERT C. SMALLWOOD
45824
REGISTERED PROFESSIONAL ENGINEER

2/26/09

GRW Engineers, Inc.
Engineers, Architects, Planners
LEXINGTON LOUISVILLE NASHVILLE INDIANAPOLIS
FORT MITCHELL KNOXVILLE ARLINGTON

DESIGNED: KAZ	DATE: JANUARY, 2009
DRAWN: RLT	SCALE: 1"= 50' Horiz. 1"= 5' Vert.
REVIEWED: RCS	DWG NO. 19
APPROVED: RCS	

PRINTED: 10/15/2009 @ 4:22PM

FILE NAME: U:\3328\-05\Cadd\3328-05-19.dwg