



CALCULATED
CHECKED

PLAN AND PROFILE
STA. 10+00 TO STA. 14+00



MAH-170-5.08

7
36

LEGEND

- PROPOSED LIGHT POLE ☼
- PROPOSED JUNCTION BOX ■
- PROPOSED CONDUIT —



CROSS REFERENCES	
SHEET NO.	DESCRIPTION
6	SUB-SUMMARY
15A	DRIVEWAY SUB-SUMMARY
18	LIGHTING DETAILS

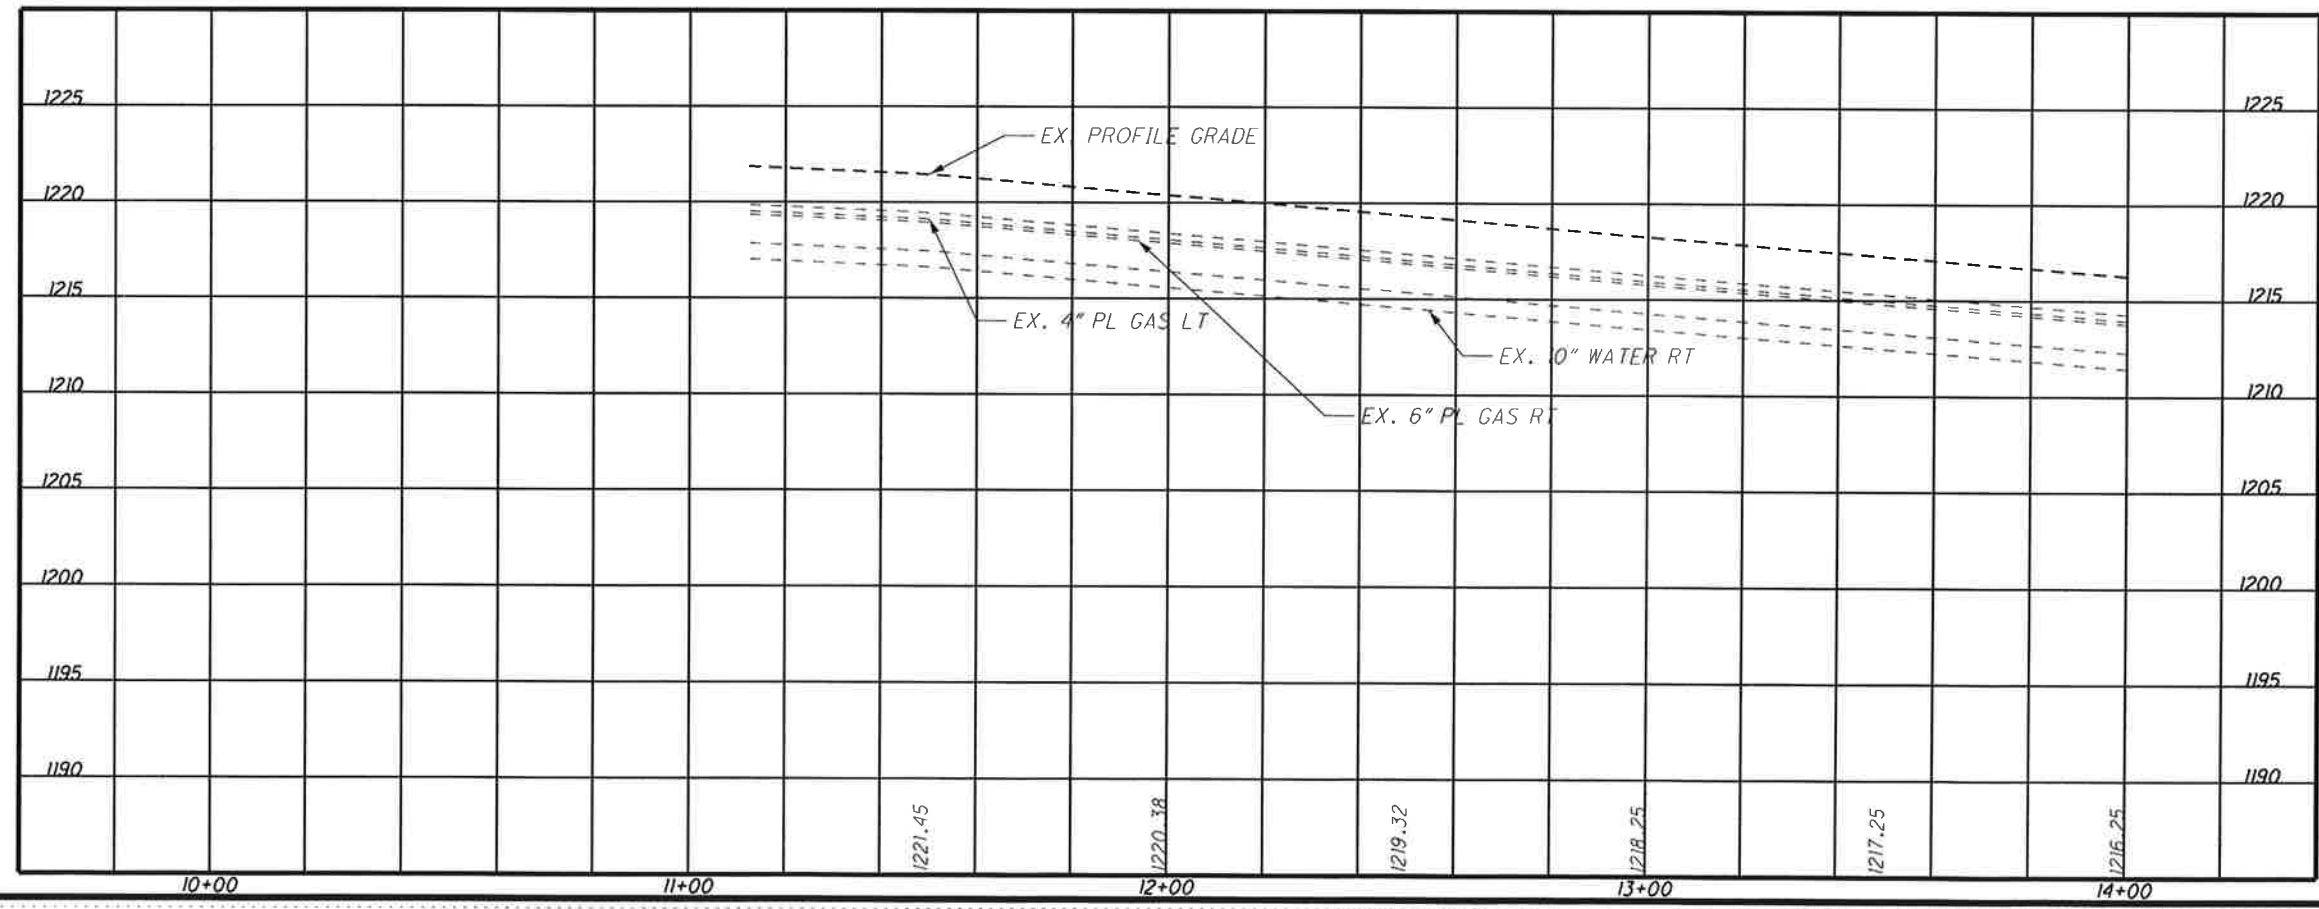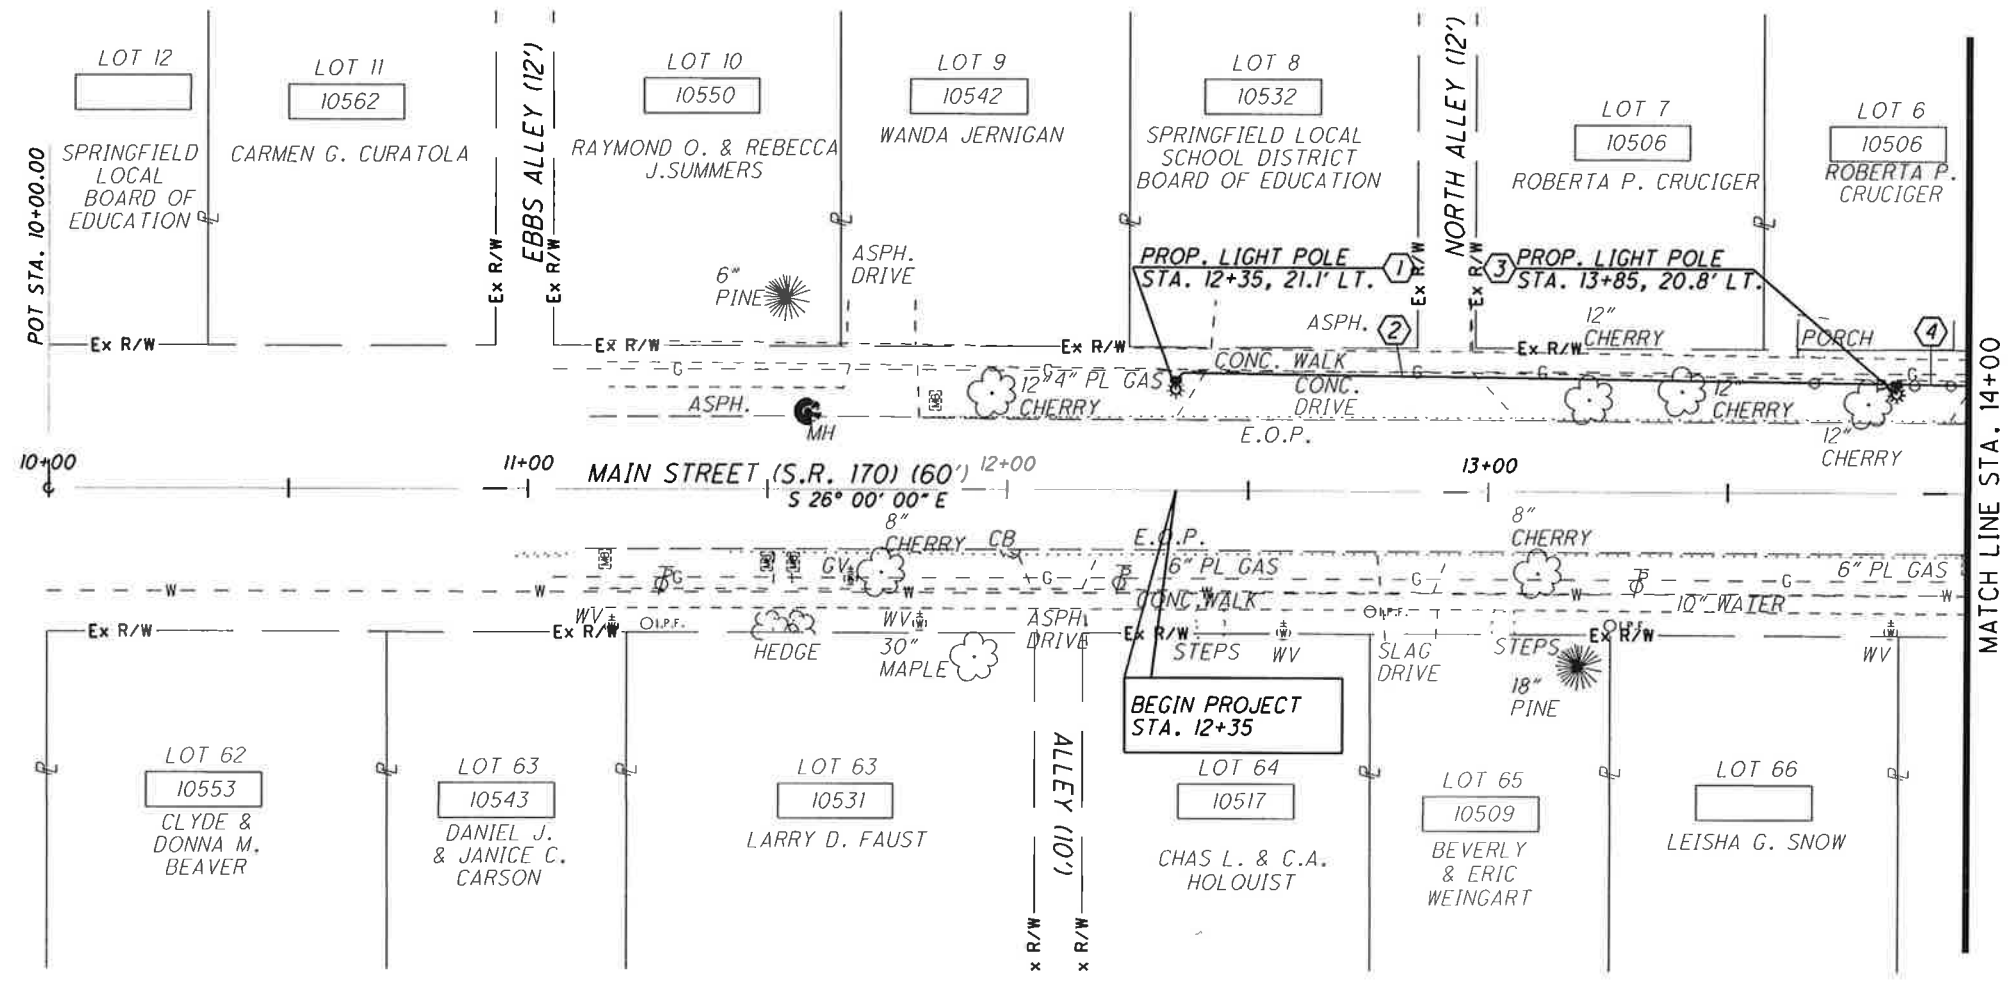

DATE: 15-May-08 10:13
FILE: J:\Job\6072 MAH-170-5.08\Plan_Sheets\10_Plan&Profile\6072_GPA.dgn
SCALE: 1" = 20'

DATE: 17-Jun-08 11:34
 FILE: J:\JOB\6072 MAH-170-5.08\Plan_Sheets\10_Plan_Profile\6072_CPB.dgn
 SCALE: 1" = 20'

PULLBOX AND APPARENT POWER SOURCE

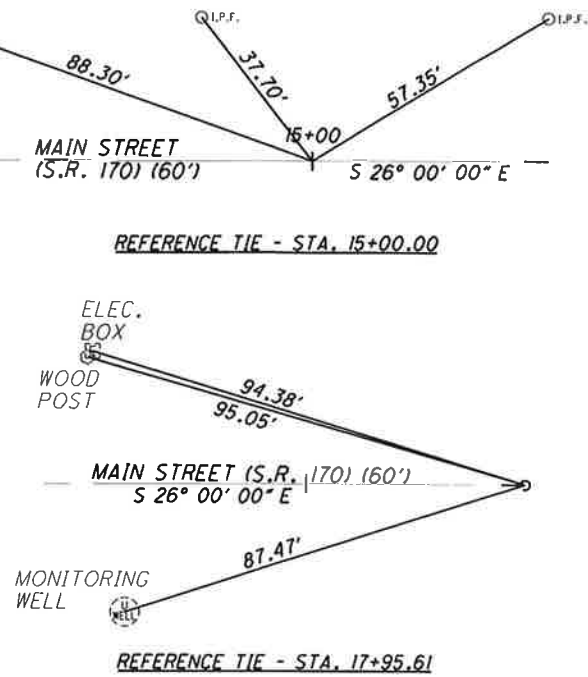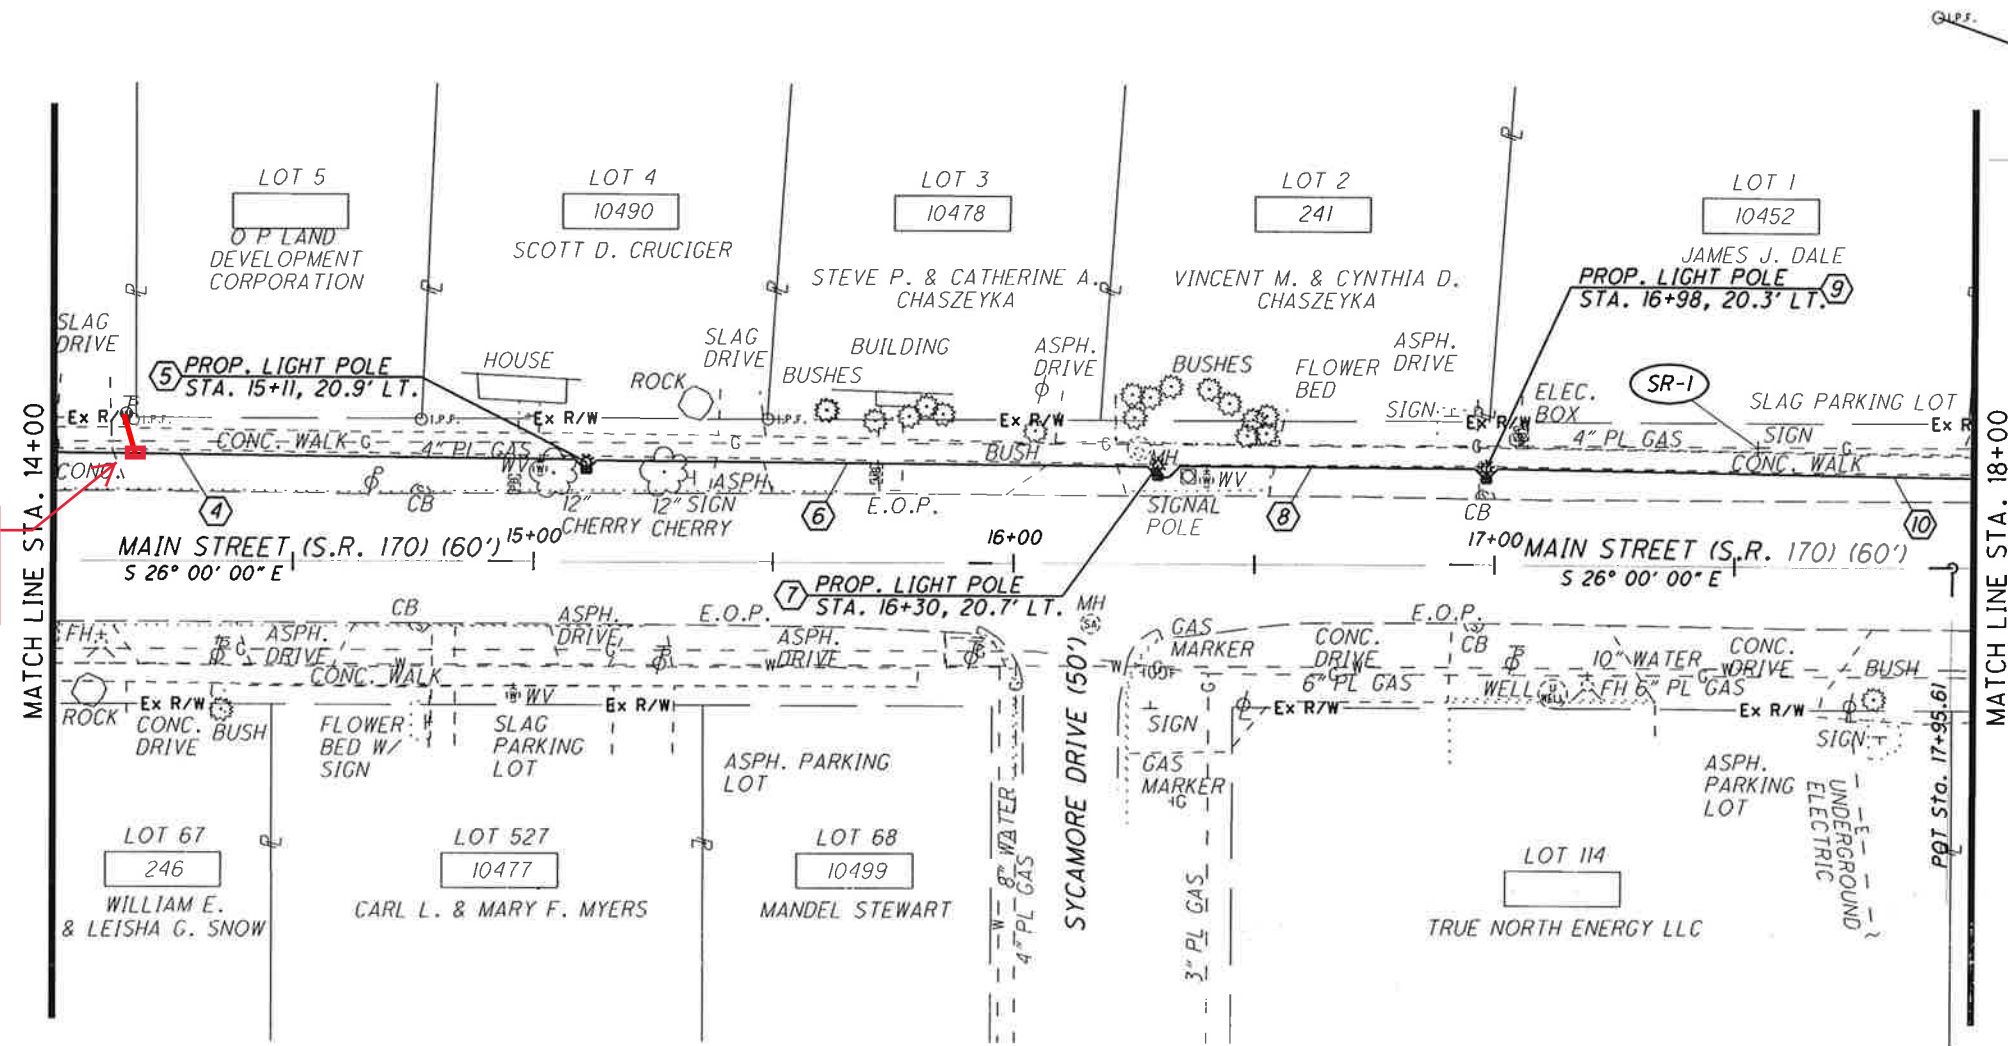


CROSS REFERENCES	
SHEET NO.	DESCRIPTION
6	SUB-SUMMARY
15A	DRIVEWAY SUB-SUMMARY
18	LIGHTING DETAILS

LEGEND

PROPOSED LIGHT POLE *



PROPOSED JUNCTION BOX ■

PROPOSED CONDUIT —

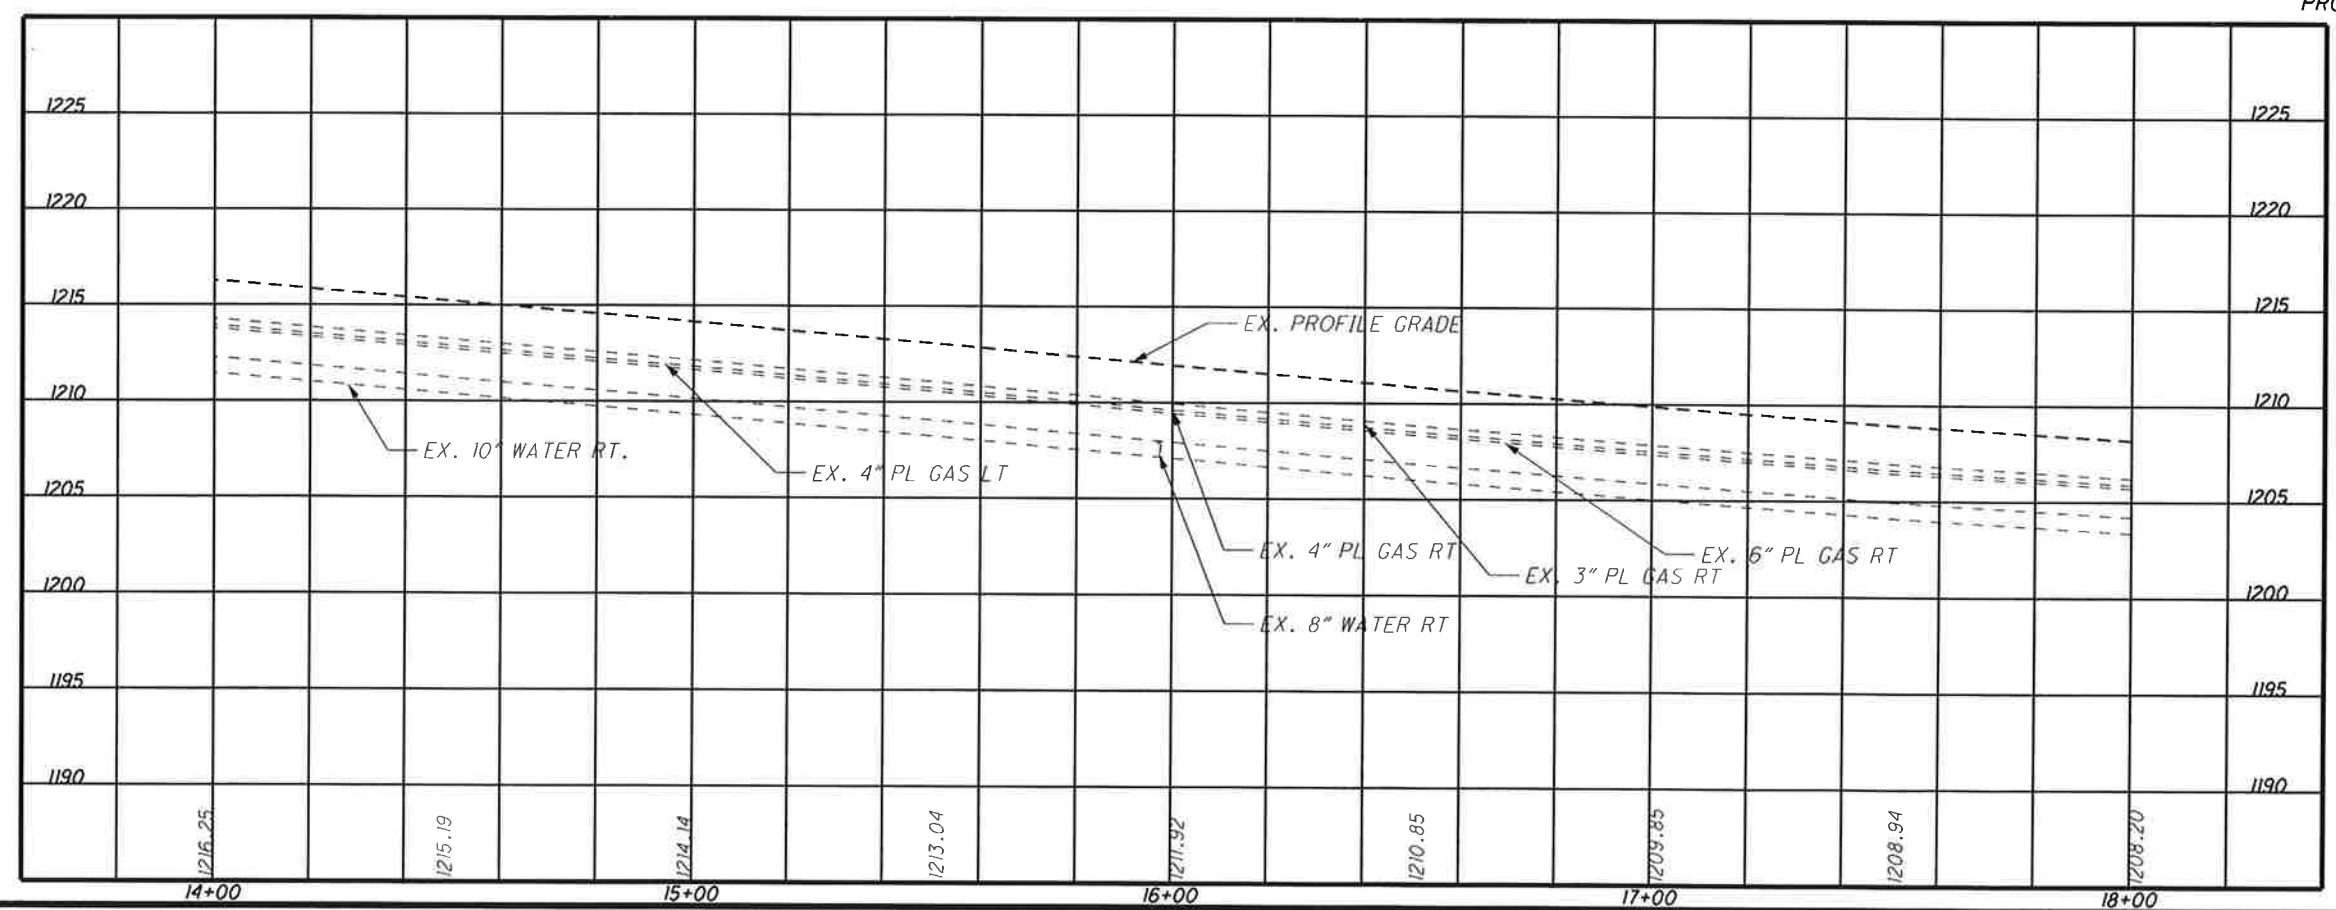


PLAN AND PROFILE
 STA. 14+00 TO STA. 18+00
 MAH-170-5.08
 8
 36

DATE: 17-Jun-08 13:26
 FILE: J:\JOB\6072 MAH-170-5.08\Plan_Sheets\10_Plan_Sheets\10_Plan&Profile\6072_CPC.dgn
 SCALE: 1" = 20'

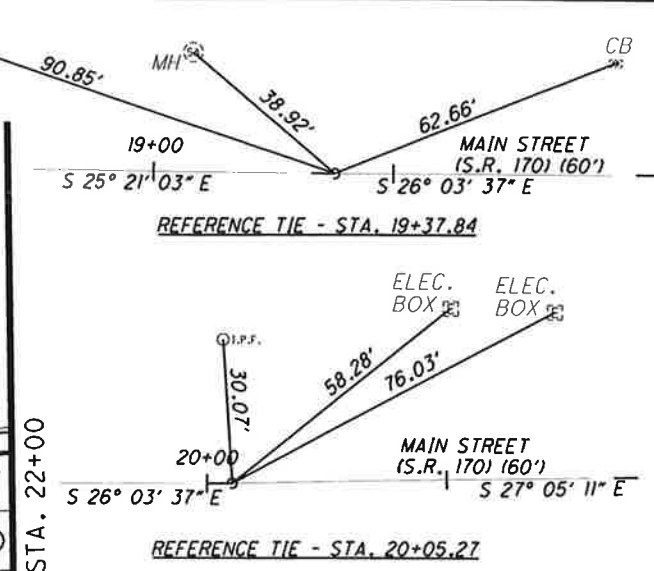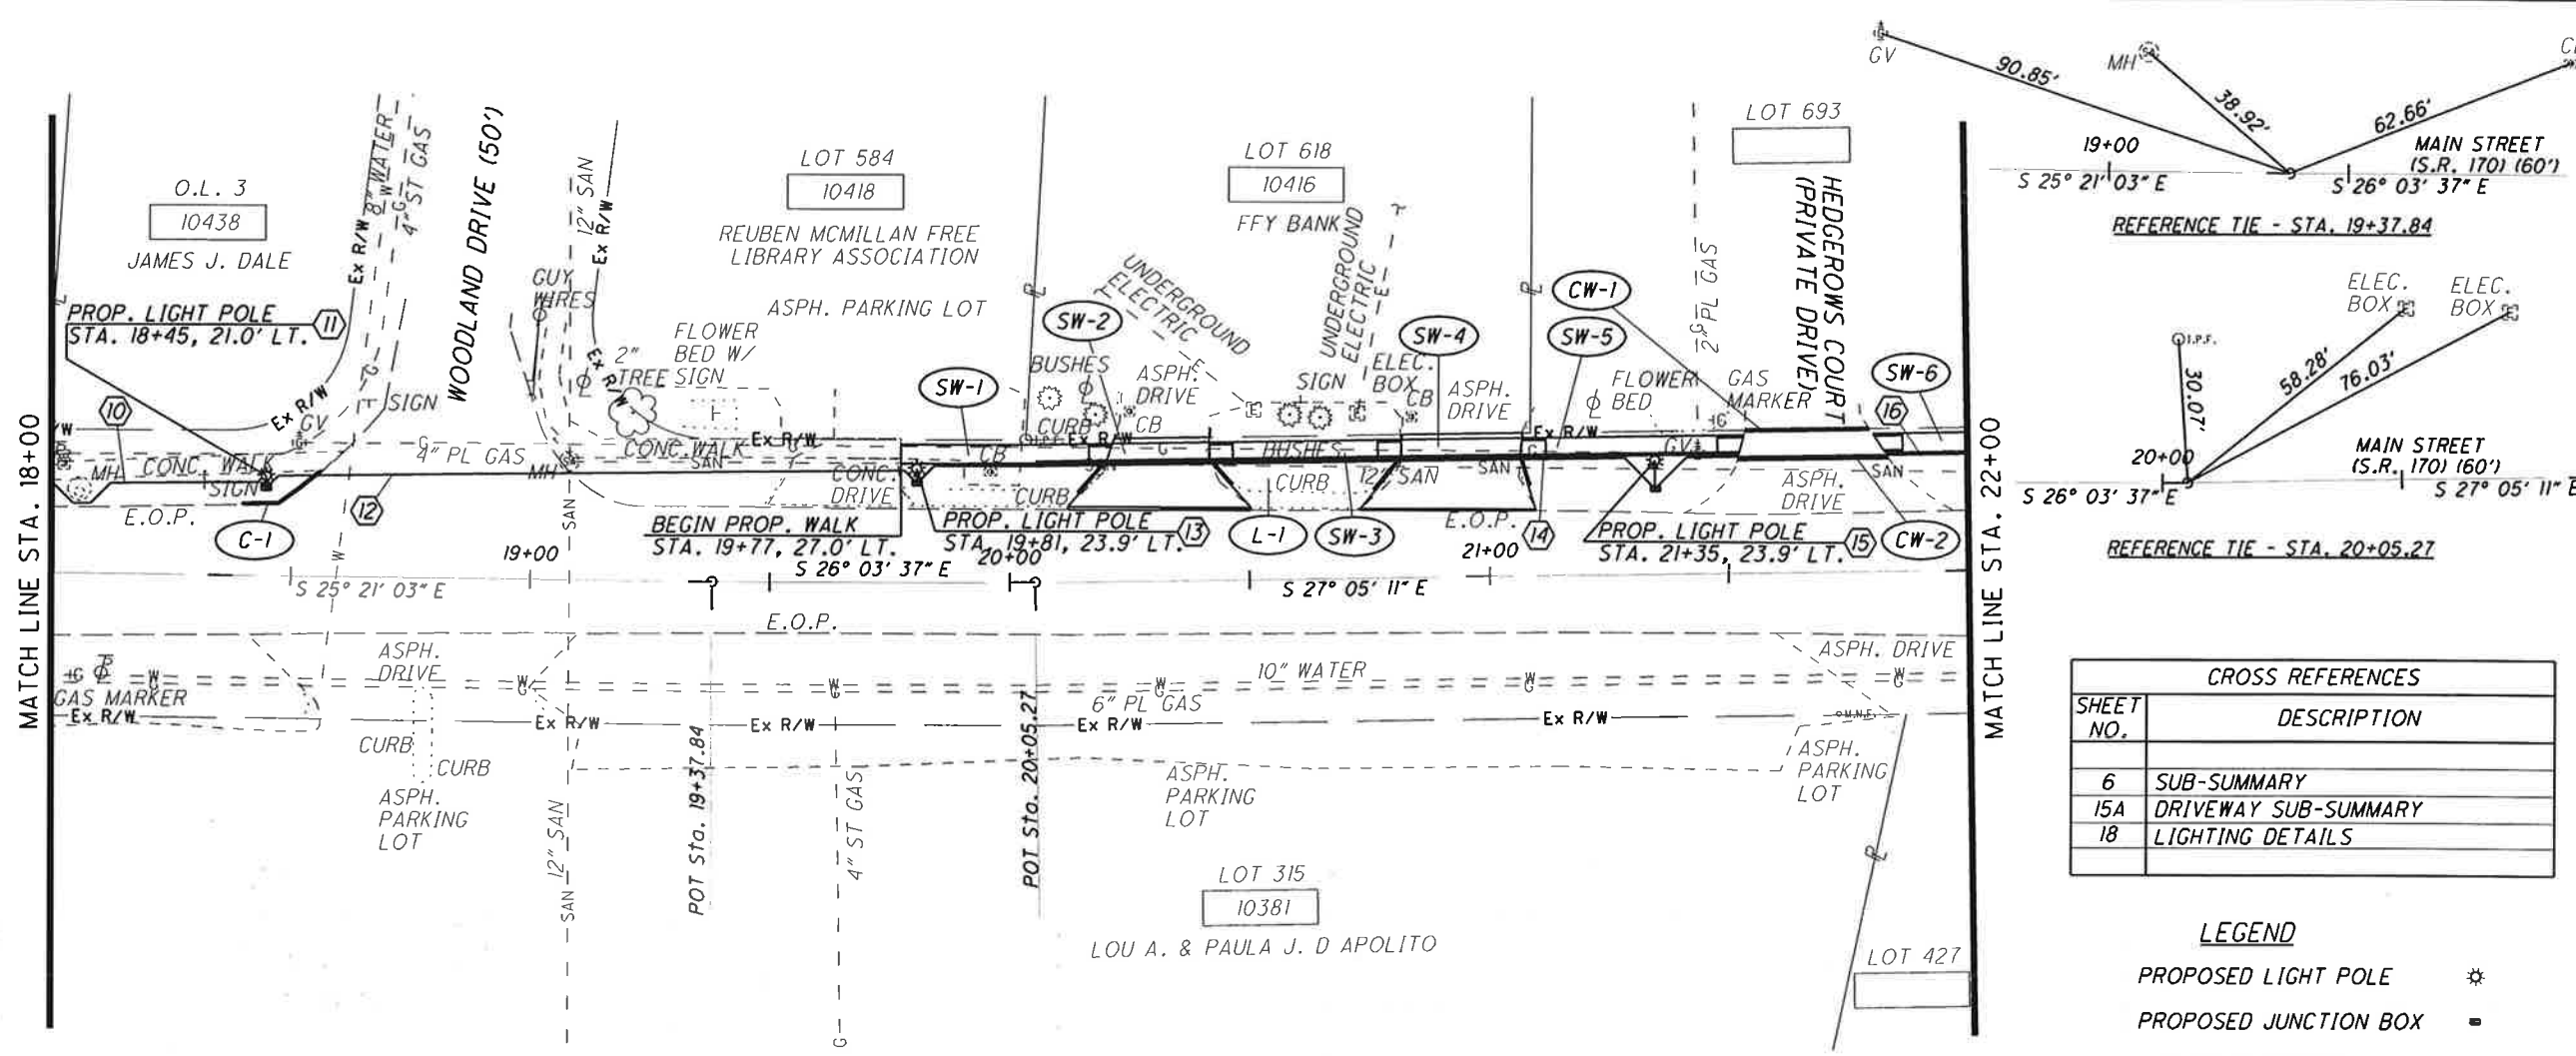


CROSS REFERENCES	
SHEET NO.	DESCRIPTION
6	SUB-SUMMARY
15A	DRIVEWAY SUB-SUMMARY
18	LIGHTING DETAILS

- LEGEND**
- PROPOSED LIGHT POLE *
 - PROPOSED JUNCTION BOX ■
 - PROPOSED CONDUIT —


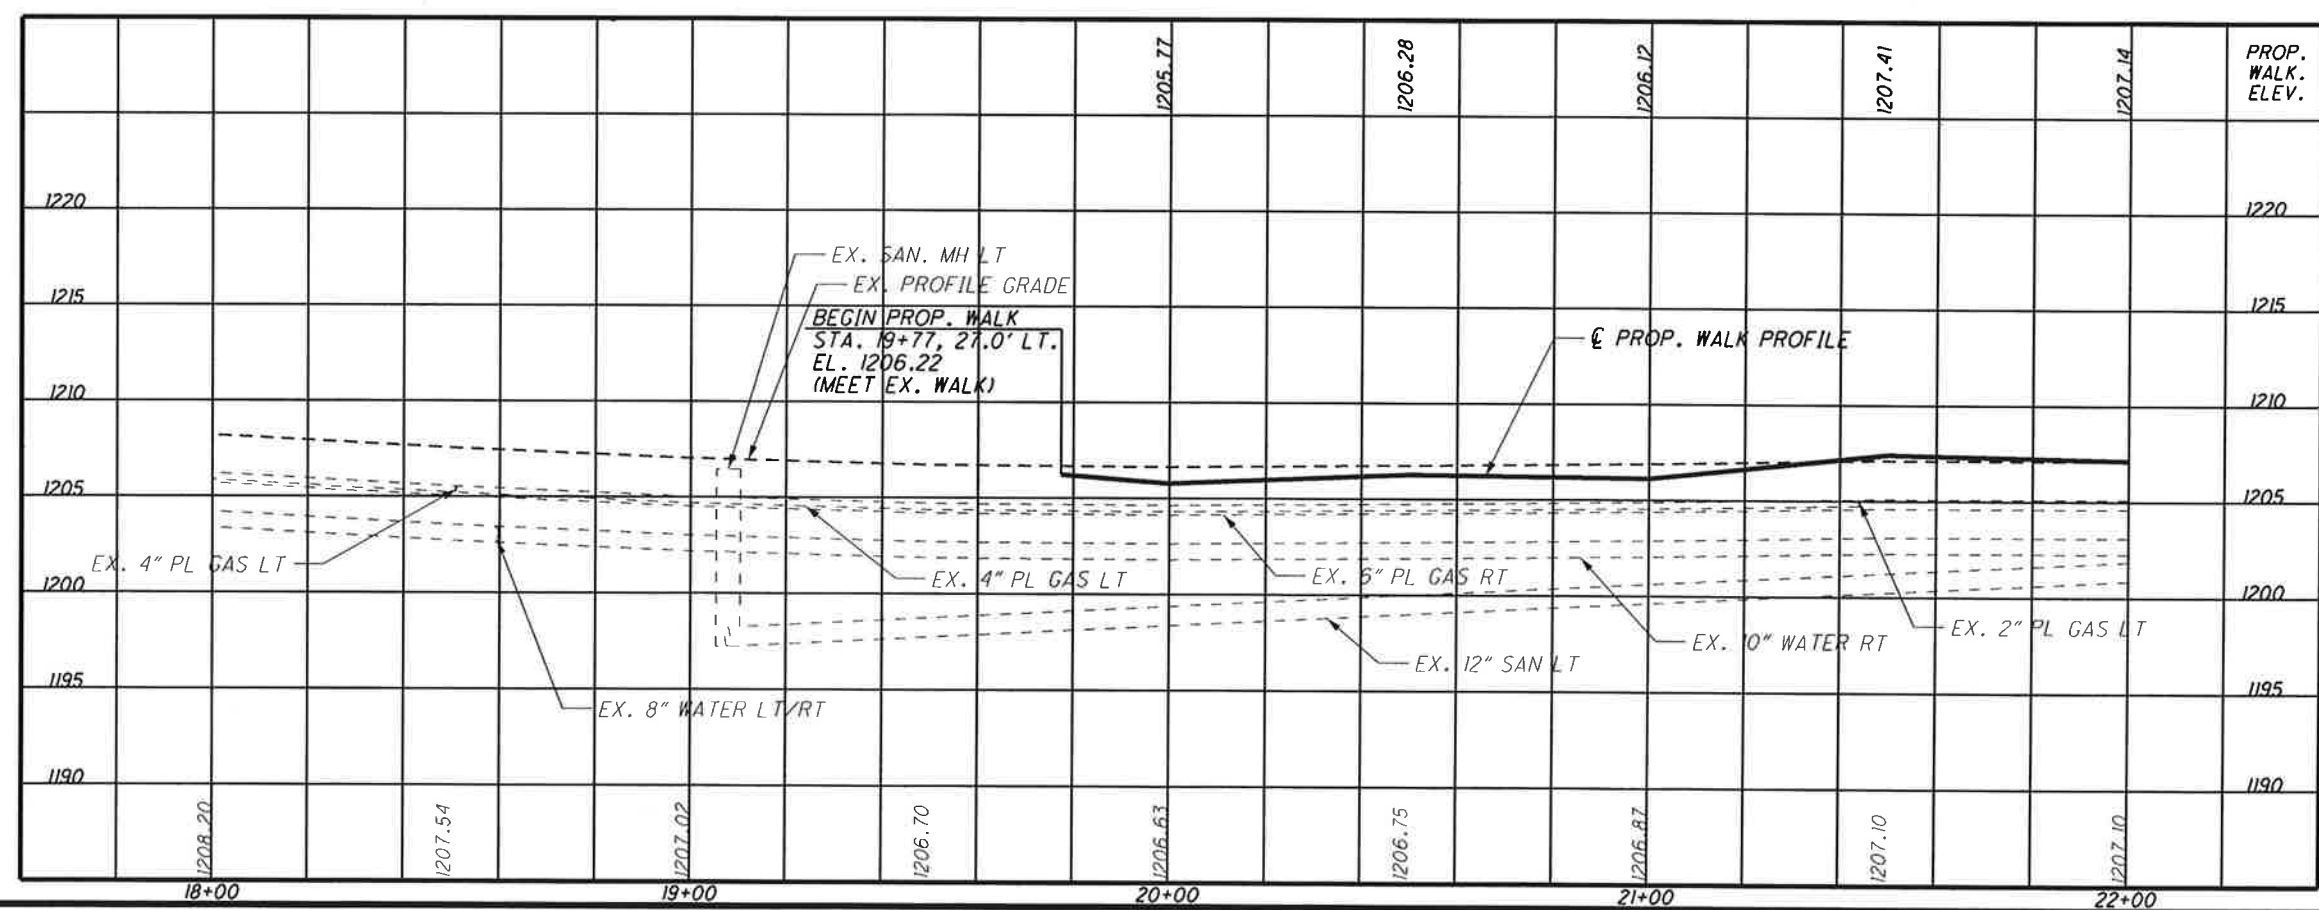


PLAN AND PROFILE
 STA. 18+00 TO STA. 22+00
 MAH-170-5.08
 9
 36

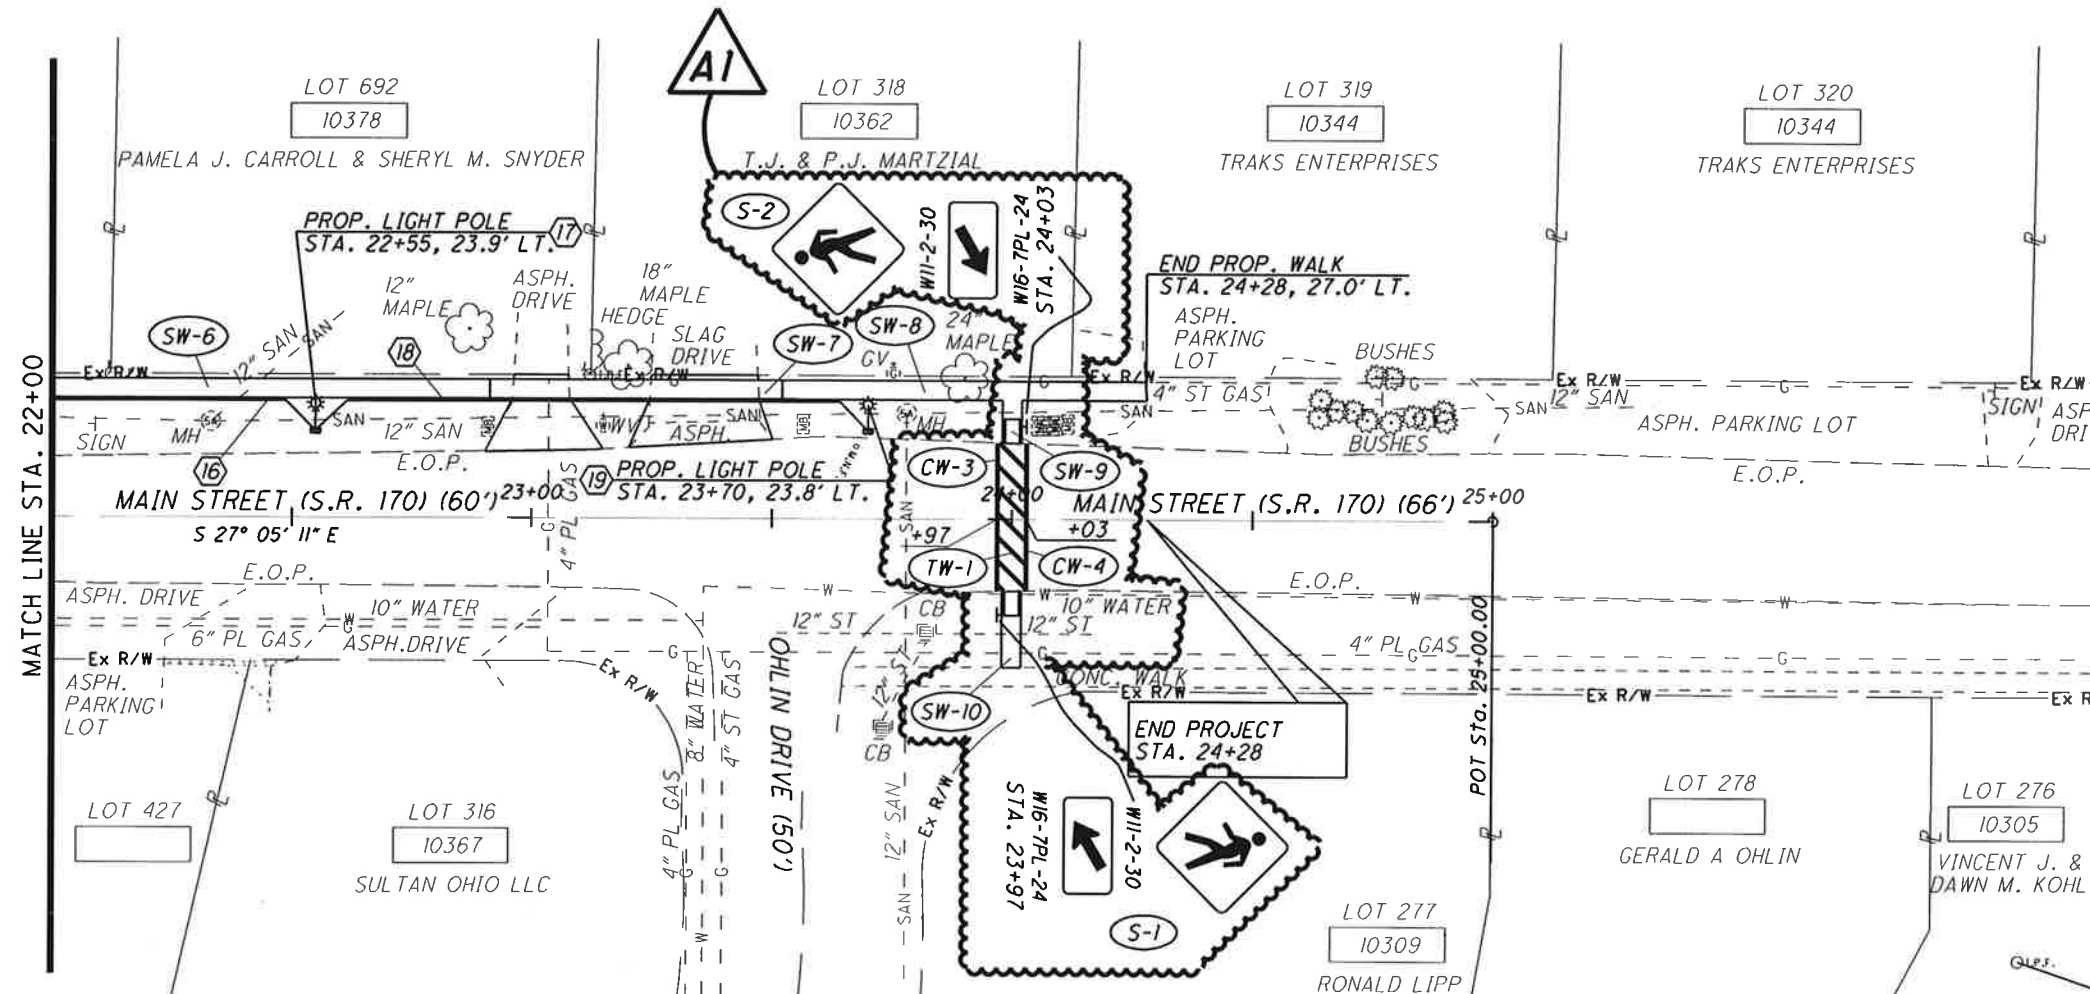

- LEGEND**
- PROPOSED LIGHT POLE
 - PROPOSED JUNCTION BOX
 - PROPOSED CONDUIT

CROSS REFERENCES	
SHEET NO.	DESCRIPTION
6	SUB-SUMMARY
15A	DRIVEWAY SUB-SUMMARY
18	LIGHTING DETAILS

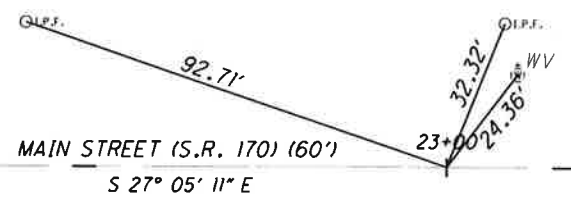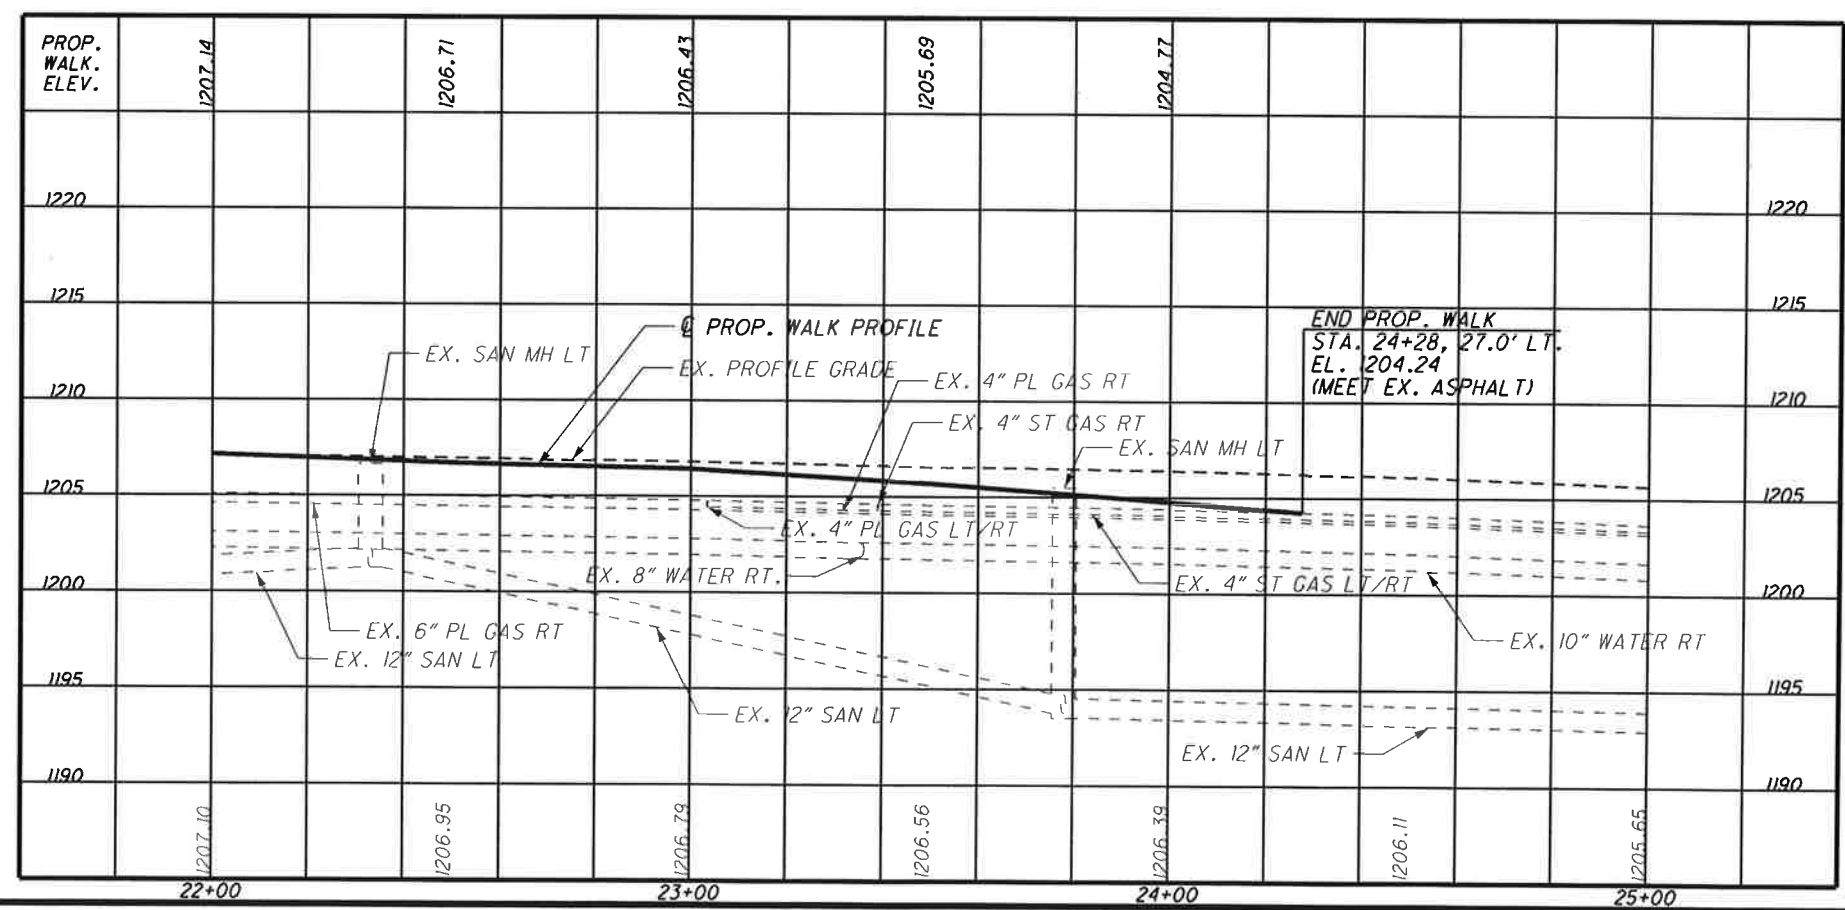

LINE SPECIFICATIONS

	ITEM 642 - TRAFFIC PAINT
	TRANSVERSE/DIAGONAL LINE, TYPE I, WHITE (45° ANGLE, SPACED AT 5')
TW	24"
CW	12"

DATE: 27-Feb-09 15:57
FILE: J:\Job\6072 MAH-170-5.08\Plan_Sheets\10_Plan&Profile\6072_GPD.dgn
SCALE: 1" = 20'

PLAN AND PROFILE
STA. 22+00 TO STA. 25+00
MAH-170-5.08
10
36