

STRUCTURE

PROJ. NO: 095059 DATE: 10/13/25 SURVEYED BY: N. Brown

STRUCTURE TYPE:

SAN = SANITARY

STM = STORM

CB = CATCH BASIN

CI = CURB INLET

CC = CB & CI

WV = WATER VALVE

LID INFO: MH, 2X2 GRATE, ETC.


CONDITION:

N = NEW

G = GOOD

P = POOR


X = CAN'T OPEN

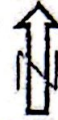

SH: _____

OF: _____

NORTH

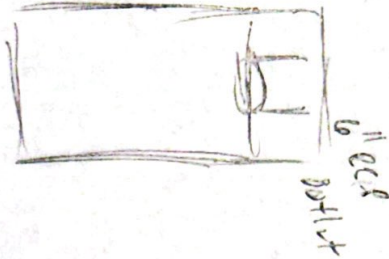


SAN STM CB CI CC WV

ID NO. 14001

RIM ELEV. 1159.061

STR DEPTH _____

CONDITION: N G P X

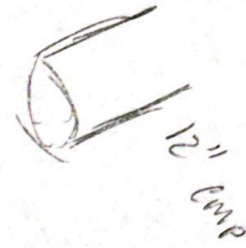



SAN STM CB CI CC WV

ID NO. 14004

RIM ELEV. _____

STR DEPTH _____

CONDITION: N G P X

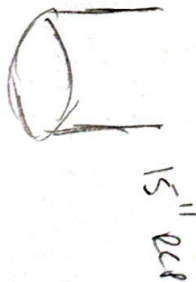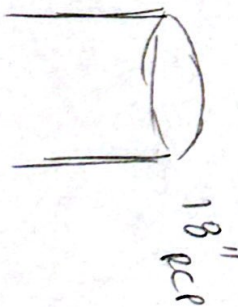


SAN STM CB CI CC WV

ID NO. 14002, 14003

RIM ELEV. _____

STR DEPTH _____

CONDITION: N G P X

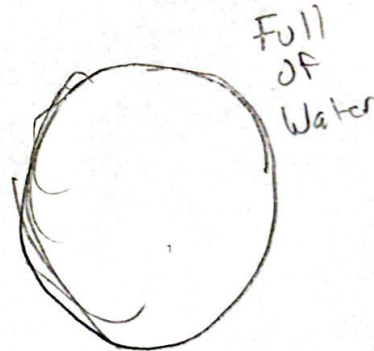

SAN STM CB CI CC WV

ID NO. 14005



RIM ELEV. 1158.504

STR DEPTH 7.10

CONDITION: N G P X

STRUCTURE

PROJ. NO: <u>095059</u>		DATE: <u>10/13/25</u>		SURVEYED BY: <u>N. P. D. W.</u>			
STRUCTURE TYPE:		LID INFO: MH, 2X2 GRATE, ETC.		 SH: _____ OF: _____ NORTH			
SAN = SANITARY		CI = CURB INLET				CONDITION:	
STM = STORM		CC = CB & CI				N = NEW	
CB = CATCH BASIN		WV = WATER VALVE				P = POOR	
				X = CAN'T OPEN			

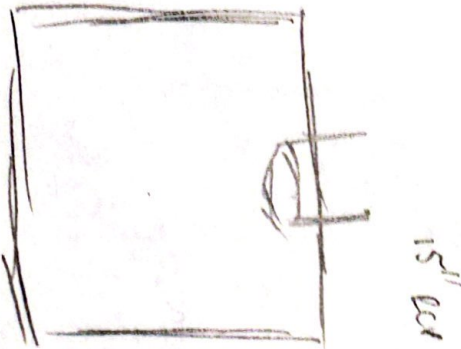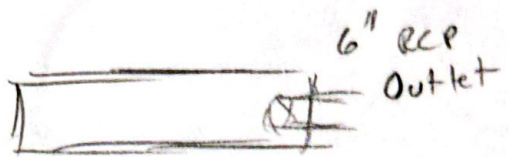 15" CI SAN STM <u>CB</u> CI CC WV ID NO. <u>14006</u> RIM ELEV. <u>1163.309</u> STR DEPTH <u>5.20</u> CONDITION: N <u>G</u> P X	 12" RCP SAN STM <u>CB</u> CI CC WV ID NO. <u>14015</u> RIM ELEV. _____ STR DEPTH _____ CONDITION: N G <u>P</u> X
Unknown Full of Water  SAN <u>STM</u> CB CI CC WV ID NO. <u>14014</u> RIM ELEV. _____ STR DEPTH <u>6.00</u> CONDITION: N <u>G</u> P X	 6" RCP Outlet SAN STM CB CI CC WV ID NO. <u>14016</u> RIM ELEV. _____ STR DEPTH <u>1154.107</u> CONDITION: N <u>G</u> P X

STRUCTURE

PROJ. NO: 095259

DATE: 10/12/25

SURVEYED BY: A. Brown

STRUCTURE TYPE:

SAN = SANITARY

CI = CURB INLET

STM = STORM

CC = CB & CI

CB = CATCH BASIN

WV = WATER VALVE

LID INFO: MH, 2X2 GRATE, ETC.

CONDITION:

N = NEW

P = POOR

G = GOOD

X = CAN'T OPEN



SH: _____

OF: _____

9" CAP



SAN STM CB CI CC WV

ID NO. 14017

RIM ELEV. _____

STR DEPTH _____

CONDITION: N G P X

SAN STM CB CI CC WV

ID NO. _____

RIM ELEV. _____

STR DEPTH _____

CONDITION: N G P X

6" D.C.F



SAN STM CB CI CC WV

ID NO. 14018

RIM ELEV. 1157.225

STR DEPTH _____

CONDITION: N G P X

SAN STM CB CI CC WV

ID NO. _____

RIM ELEV. _____

STR DEPTH _____

CONDITION: N G P X

10/13/25

095059

NICK/THOMAS

MD

VD

BASE 104

ZM

CHIL 105

ZM

.007

.015

Weather 44° - 70° Sunny

POINTS 14000 - 14019

TRUCK 446 440

48834

48858

48876