

STRUCTURE

PROJ NO: 09059

DATE: 10/14/25

SURVEYED BY: N. Brown

STRUCTURE TYPE:

SAN = SANITARY

CI = CURB INLET

STM = STORM

CC = CB & CI

CB = CATCH BASIN

WV = WATER VALVE

LID INFO: MH, 2X2 GRATE, ETC.

CONDITION:

N = NEW

P = POOR


G = GOOD

X = CAN'T OPEN



SH: _____

OF: _____

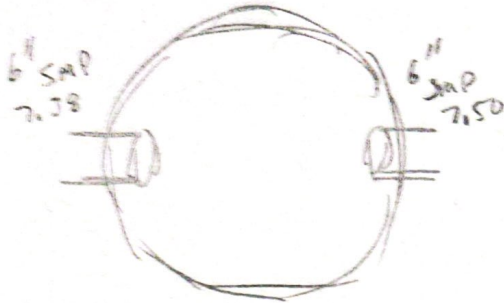


SAN STM CB CI CC WV

ID NO. 14165

RIM ELEV. 1166.470

STR DEPTH 7.40

CONDITION: N G P X

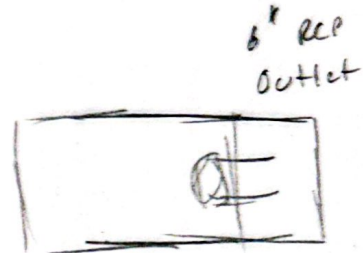


SAN STM CB CI CC WV

ID NO. 14167

RIM ELEV. _____

STR DEPTH _____

CONDITION: N G P X

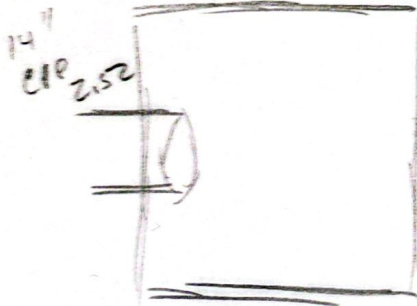

SAN STM CB CI CC WV

ID NO. 14166

RIM ELEV. 1161.634

STR DEPTH 2.80

CONDITION: N G P X

SAN STM CB CI CC WV

ID NO. _____

RIM ELEV. _____

STR DEPTH _____

CONDITION: N G P X

10/14/25 095059 1326/740FAS

BASE 104 2M 110 110

CHE 105 2M .007 .011

Weather 54° - 70° Partly Cloudy

POINTS 14020 - 14160

TRUCK 1406440




