

STRUCTURE

PROJ. NO: 095059

DATE: 10/22/25

SURVEYED BY: N. Brown

STRUCTURE TYPE:

SAN = SANITARY

CI = CURB INLET

STM = STORM

CC = CB & CI

CB = CATCH BASIN

WV = WATER VALVE

LID INFO: MH, 2X2 GRATE, ETC.

CONDITION:

N = NEW

P = POOR


G = GOOD

X = CAN'T OPEN



SH: _____

OF: _____

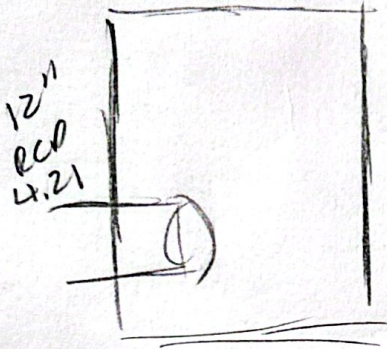


SAN STM CB (CI) CC WV

ID NO. 14654

RIM ELEV. 1170.748

STR DEPTH 4.35

CONDITION: N G (P) X

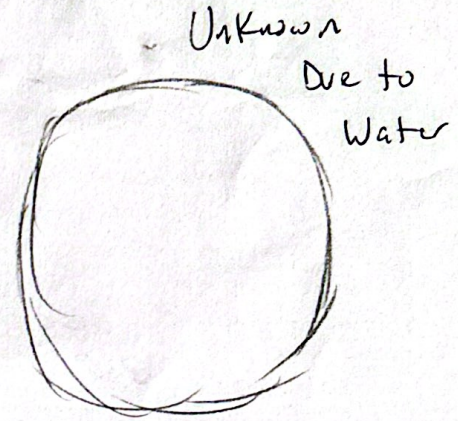


SAN (STM) CB CI CC WV

ID NO. 14005

RIM ELEV. 1158.504

STR DEPTH 7.10 Water to 2.30

CONDITION: N G (P) X

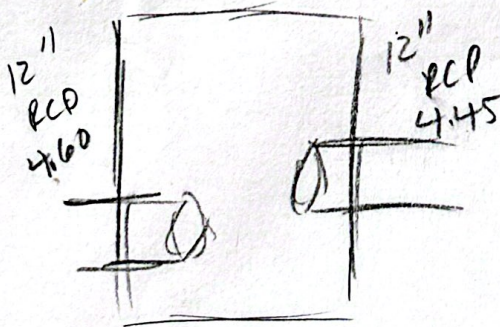

SAN STM CB (CI) CC WV

ID NO. 14655

RIM ELEV. 1164.271

STR DEPTH 4.57

CONDITION: N G (P) X

SAN STM CB CI CC WV

ID NO. _____

RIM ELEV. _____

STR DEPTH _____

CONDITION: N G P X

[illegible]