

STRUCTURE

PROJ. NO: 095059

DATE: 10/24/25

SURVEYED BY: N. Brown

STRUCTURE TYPE:

SAN = SANITARY

CI = CURB INLET

STM = STORM

CC = CB & CI

CB = CATCH BASIN

WV = WATER VALVE

LID INFO: MH, 2X2 GRATE, ETC.

CONDITION:

N = NEW

P = POOR

G = GOOD


X = CAN'T OPEN



SH: _____

OF: _____

NORTH

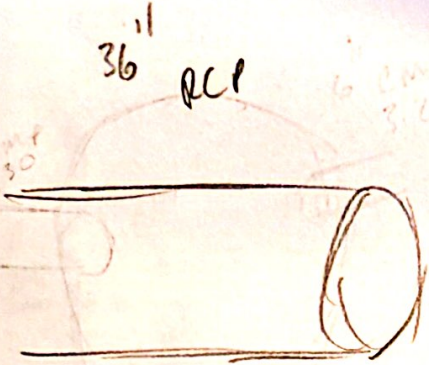


SAN ☒ STM ☒ CB ☐ CI ☐ CC ☐ WV

ID NO. 14755

RIM ELEV. _____

STR DEPTH 3.05

CONDITION: N G P X

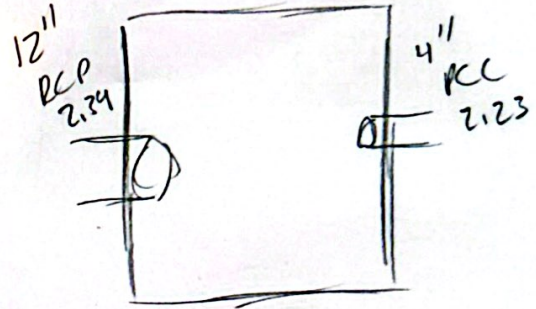

SAN ☐ STM ☐ ☒ CB ☐ CI ☐ CC ☐ WV

ID NO. 14756

RIM ELEV. 1160.639

STR DEPTH 2.25

CONDITION: N ☒ G ☐ P ☐ X

SAN ☐ STM ☐ CB ☐ CI ☐ CC ☐ WV

ID NO. _____

RIM ELEV. _____

STR DEPTH _____

CONDITION: N G P X

SAN ☐ STM ☐ CB ☐ CI ☐ CC ☐ WV

ID NO. _____

RIM ELEV. _____

STR DEPTH _____

CONDITION: N G P X