

10/20/20 0550 PM Intel/T-8000

045 104	200		
046 105	200	1012	.015

WEATHER 40° - 58° 1400/0000

(X)INTS = 14631 - 14652

REVIEW C30

95150
95204
95210
95227

STRUCTURE

PROJ. NO: 095059

DATE: 10/21/25

SURVEYED BY: N. Brown

STRUCTURE TYPE:

SAN = SANITARY

CI = CURB INLET

STM = STORM

CC = CB & CI

CB = CATCH BASIN

WV = WATER VALVE

LID INFO: MH, 2X2 GRATE, ETC.


CONDITION:

N = NEW

P = POOR

G = GOOD


X = CAN'T OPEN

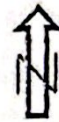

SH: _____

OF: _____

NORTH

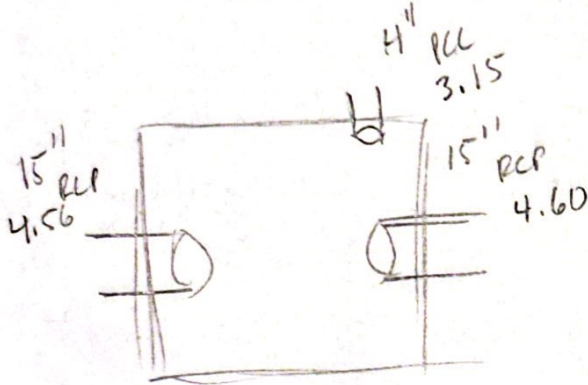


SAN ☐ STM ☒ CB ☐ CI ☐ CC ☐ WV

ID NO. 14633

RIM ELEV. 1163.048

STR DEPTH 4.40

CONDITION: N ☐ ☒ G ☐ P ☐ X

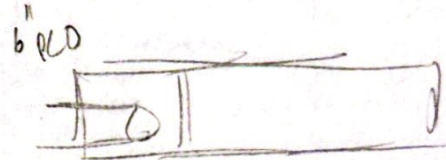

SAN ☐ STM ☒ CB ☐ CI ☐ CC ☐ WV

ID NO. 14642

RIM ELEV. N/A

STR DEPTH N/A

CONDITION: N ☐ ☒ G ☐ P ☐ X




SAN ☐ STM ☒ CB ☐ CI ☐ CC ☐ WV

ID NO. 14641

RIM ELEV. N/A

STR DEPTH N/A

CONDITION: N ☐ ☒ G ☐ P ☐ X

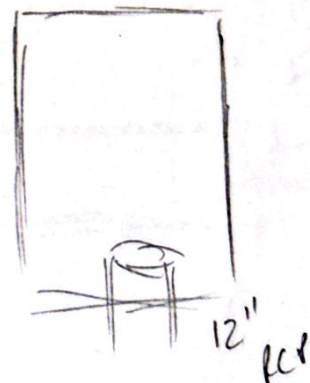

SAN ☐ STM ☒ CB ☐ CI ☐ CC ☐ WV

ID NO. 14643

RIM ELEV. 1167.837

STR DEPTH ?

CONDITION: N ☐ ☒ G ☐ P ☒ X

STRUCTURE

PROJ. NO: 055055

DATE: 10/21/25

SURVEYED BY: N. Brown

STRUCTURE TYPE:

SAN = SANITARY

CI = CURB INLET

STM = STORM

CC = CB & CI

CB = CATCH BASIN

WV = WATER VALVE

LID INFO: MH, 2X2 GRATE, ETC.


CONDITION:

N = NEW

P = POOR

G = GOOD


X = CAN'T OPEN

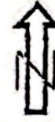

SH: _____

OF: _____

NORTH

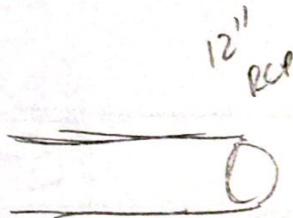


SAN ☒ STM ☐ CB ☐ CI ☐ CC ☐ WV

ID NO. 14644

RIM ELEV. _____

STR DEPTH _____

CONDITION: N G ☒ P X

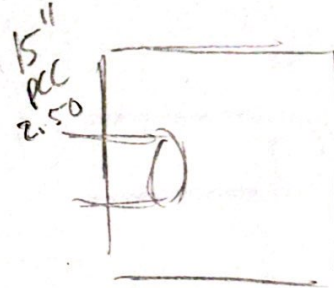


SAN ☐ STM ☒ CB ☐ CI ☐ CC ☐ WV

ID NO. 14646

RIM ELEV. 1161.618

STR DEPTH 2.81

CONDITION: N ☒ G ☐ P X

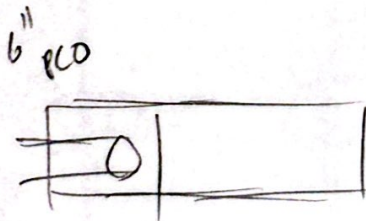


SAN ☒ STM ☐ CB ☐ CI ☐ CC ☐ WV

ID NO. 14645

RIM ELEV. N/A

STR DEPTH N/A

CONDITION: N ☒ G ☐ P X

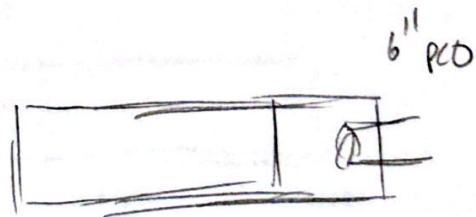

SAN ☒ STM ☐ CB ☐ CI ☐ CC ☐ WV

ID NO. 14647

RIM ELEV. N/A

STR DEPTH N/A

CONDITION: N ☒ G ☐ P X

STRUCTURE

PROJ. NO: 095059 DATE: 10/21/25 SURVEYED BY: N. Brown

STRUCTURE TYPE:

SAN = SANITARY

CI = CURB INLET

STM = STORM

CC = CB & CI

CB = CATCH BASIN

WV = WATER VALVE

LID INFO: MH, 2X2 GRATE, ETC.


CONDITION:

N = NEW

P = POOR

G = GOOD

X = CAN'T OPEN

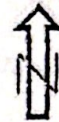

SH: _____

OF: _____

NORTH

4" RCP



SAN (STM) CB CI CC WV


ID NO. 14648

RIM ELEV. N/A

STR DEPTH N/A

CONDITION: N (G) P X

12" RCP

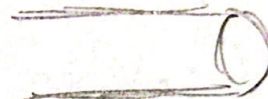

SAN (STM) CB CI CC WV


ID NO. 14650

RIM ELEV. _____

STR DEPTH _____

CONDITION: N G P X

12" RCP
3.34

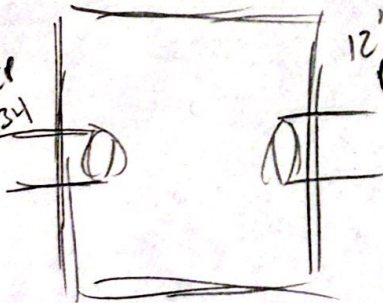

12" RCP
3.54

SAN STM (CB) CI CC WV

ID NO. 14649

RIM ELEV. 1150.696

STR DEPTH 3.35

CONDITION: N (G) P X

4" RCP



SAN STM CB CI CC WV

ID NO. 14651

RIM ELEV. N/A

STR DEPTH N/A

CONDITION: N (G) P X