



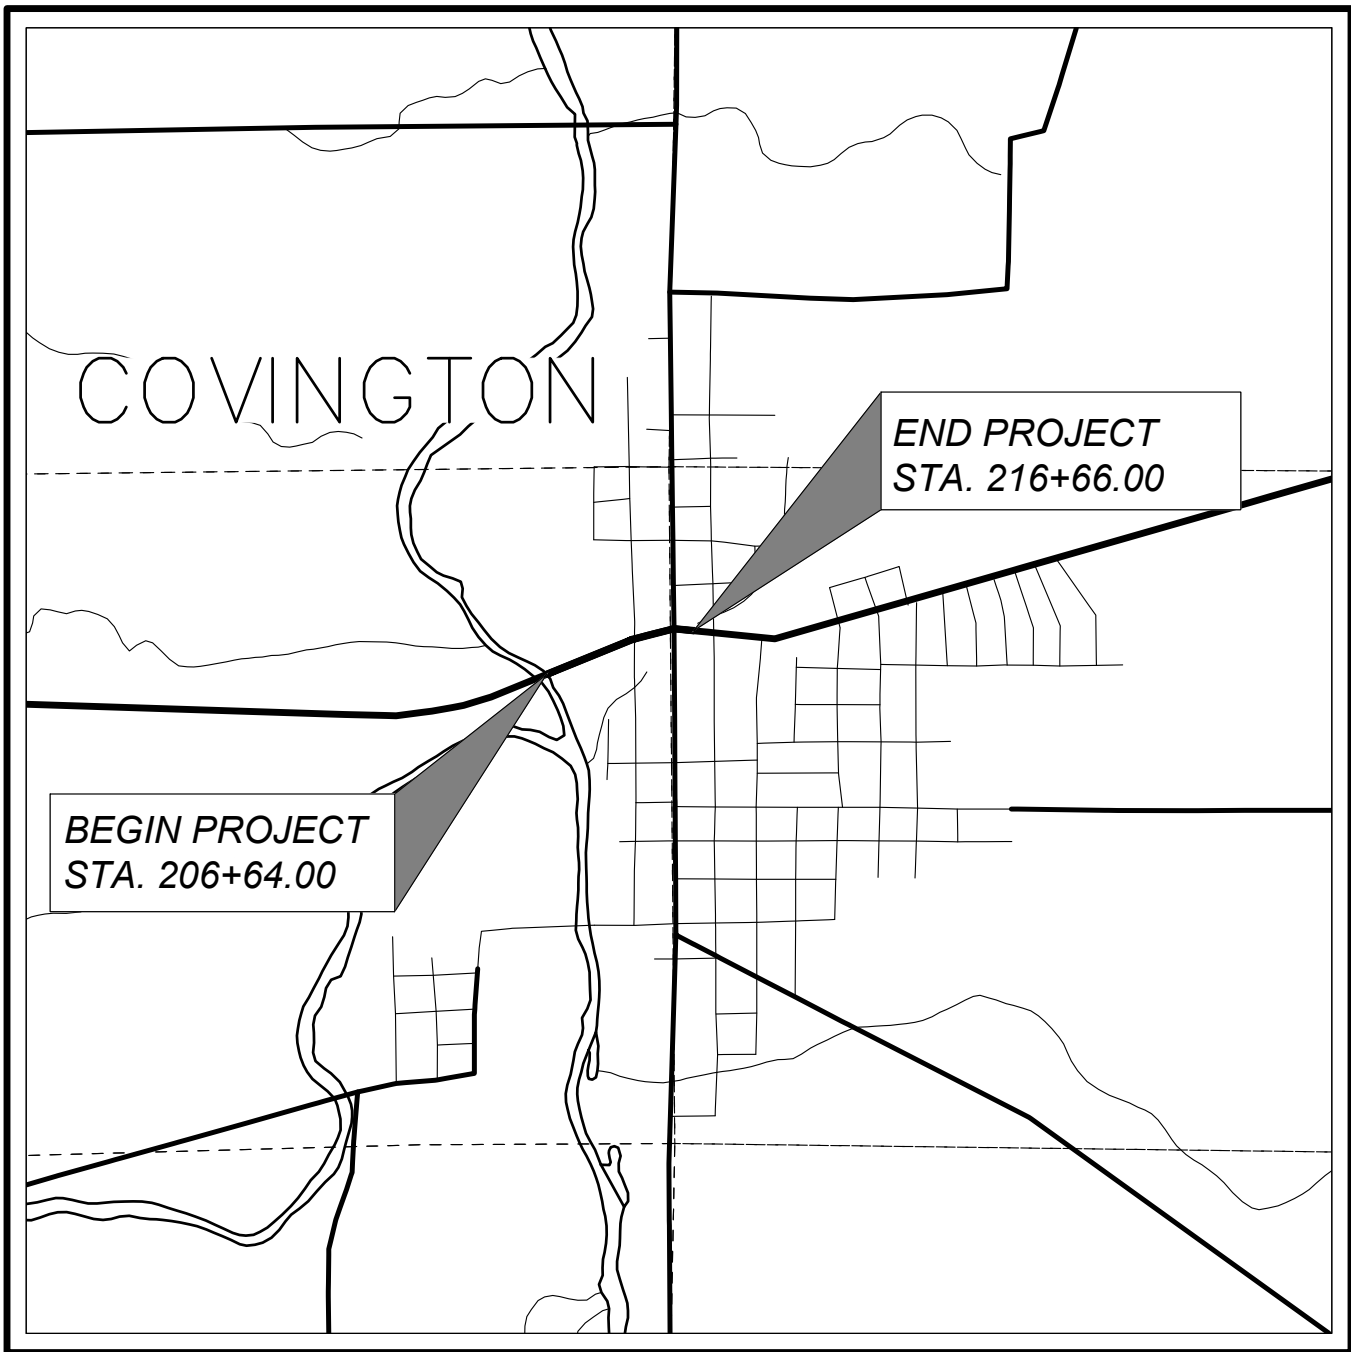

LOCATION MAP

LATITUDE: 40°07'15"N LONGITUDE: 84°21'22"W

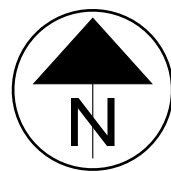

PORTION TO BE IMPROVED -----
INTERSTATE HIGHWAY -----
FEDERAL ROUTES -----
STATE ROUTES -----
COUNTY & TOWNSHIP ROADS -----
OTHER ROADS -----

DESIGN DESIGNATION

CURRENT ADT (2023) ----- 7172
DESIGN YEAR ADT (2043) ----- 7650
DESIGN HOURLY VOLUME (2043) ----- 689
DIRECTIONAL DISTRIBUTION ----- 50%
TRUCKS (24 HOUR B&C) ----- 8%
DESIGN SPEED ----- 35 mph
LEGAL SPEED ----- 35 mph
DESIGN FUNCTIONAL CLASSIFICATION:
04 MINOR ARTERIAL (RURAL)
NHS PROJECT ----- NO

DESIGN EXCEPTIONS

NONE REQUIRED

ADA DESIGN WAIVERS

NONE REQUIRED

UNDERGROUND UTILITIES

Contact Two Working Days
Before You Dig


OHIO811.org
Before You Dig

OHIO811, 8-1-1, or 1-800-362-2764
(Non members must be called directly)

PLAN PREPARED BY:
ACCESS ENGINEERING SOLUTIONS
1200 IRMSCHER BLVD., SUITE B
CELINA, OHIO 45822

STATE OF OHIO
DEPARTMENT OF TRANSPORTATION
MIA-BROADWAY
IMPROVEMENTS
VILLAGE OF COVINGTON
MIAMI COUNTY

INDEX OF SHEETS:

TITLE SHEET	1
SCHEMATIC PLAN	2-4
TYPICAL SECTION	5
GENERAL NOTES	6-7
MAINTENANCE OF TRAFFIC	8-9
GENERAL SUMMARY	10-11
ESTIMATED QUANTITIES	12-13
PROJECT SITE PLAN	17-18
PLAN AND PROFILE	20-25
CROSS SECTIONS	26-32
INTERSECTION DETAILS	33
DRIVE DETAILS	34-35
MISCELLANEOUS DETAILS - CURB RAMPS	36
SIGN AND PAVEMENT MARKING PLAN	37-38
PROPOSED TRUCK STOP	39

CNP GAS DISTRIBUTION WORK PLAN
(COMPLETED BY ENTRUST)

Work Plan Completed: 10/1/2026
Based on Plan Set:
Dated: 03/26/2026 Issued: 03/12/2026

FEDERAL PROJECT NUMBER

E230(649)

RAILROAD INVOLVEMENT

NONE

PROJECT DESCRIPTION

THE PROJECT WILL BE THE COMPLETE RECONSTRUCTION OF BROADWAY STREET FROM THE EAST SIDE OF THE BRIDGE OVER STILLWATER RIVER TO EAST OF HIGH STREET/WEST SIDE OF THE NORTH COMMERCIAL DRIVE TO CASEY'S. RECONSTRUCTION INCLUDING THE INSTALLATION OF NEW PAVEMENT, CURB AND GUTTER, ADA COMPLIANT CURB RAMPS, STORM DRAINAGE SYSTEM INCLUDING MANHOLES, PIPES AND CATCH BASINS, AND PAVEMENT MARKINGS. PARTIAL PAVEMENT REPLACEMENT FROM EAST SIDE OF HIGH STREET TO LARRY AVENUE.

EARTH DISTURBED AREA

PROJECT EARTH DISTURBED AREA: 1.73 ACRES
ESTIMATED CONTRACTOR EARTH DISTURBED AREA: 0.5 ACRES
NOTICE OF INTENT EARTH DISTURBED AREA: 2.23 ACRES

2023 SPECIFICATIONS

THE STANDARD SPECIFICATIONS OF THE STATE OF OHIO, DEPARTMENT OF TRANSPORTATION, INCLUDING SUPPLEMENTAL SPECIFICATIONS LISTED IN THE PLANS AND CHANGES LISTED IN THE PROPOSAL SHALL GOVERN THIS IMPROVEMENT.

I HEREBY APPROVE THESE PLANS AND DECLARE THAT THE MAKING OF THIS IMPROVEMENT WILL REQUIRE THE CLOSING TO TRAFFIC OF THE HIGHWAY AND THAT DETOURS WILL BE PROVIDED AS INDICATED ON


SHEET 7.




John W. O'Brien
District 07 Deputy Director




Pamela Boratyn
Director, Department of Transportation

STANDARD CONSTRUCTION DRAWINGS					SUPPLEMENTAL SPECIFICATIONS	SPECIAL PROVISIONS
		BP-4.1 7-19-13	TC-41.20 10-18-13		800 1-16-26	
		BP-5.1 1-16-26	TC-41.30 4-21-23		832 7-18-25	
		BP-7.1 1-16-26	TC-42.20 10-18-13		895 4-18-14	
			TC-52.10 10-18-13			
		CB-3 1-16-26	TC-52.20 1-15-21			
		CB-3A 1-16-26	TC-71.10 1-16-26			
		MH-3 7-19-24	TC-74.10 1-16-26			
		MT-101.60 1-17-25				
		MT-101.90 7-17-20				
		MT-105.10 1-17-20				
		MT-110.10 7-19-13				

ENGINEER'S SEAL

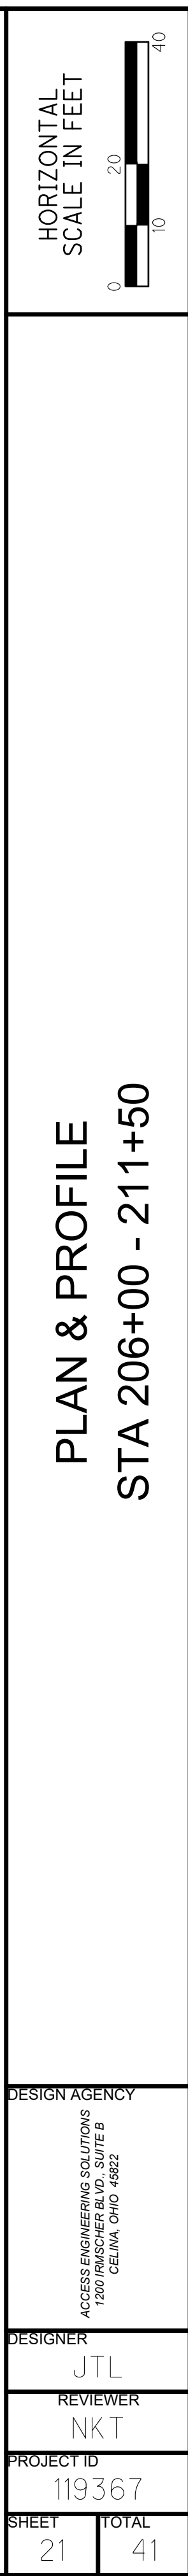

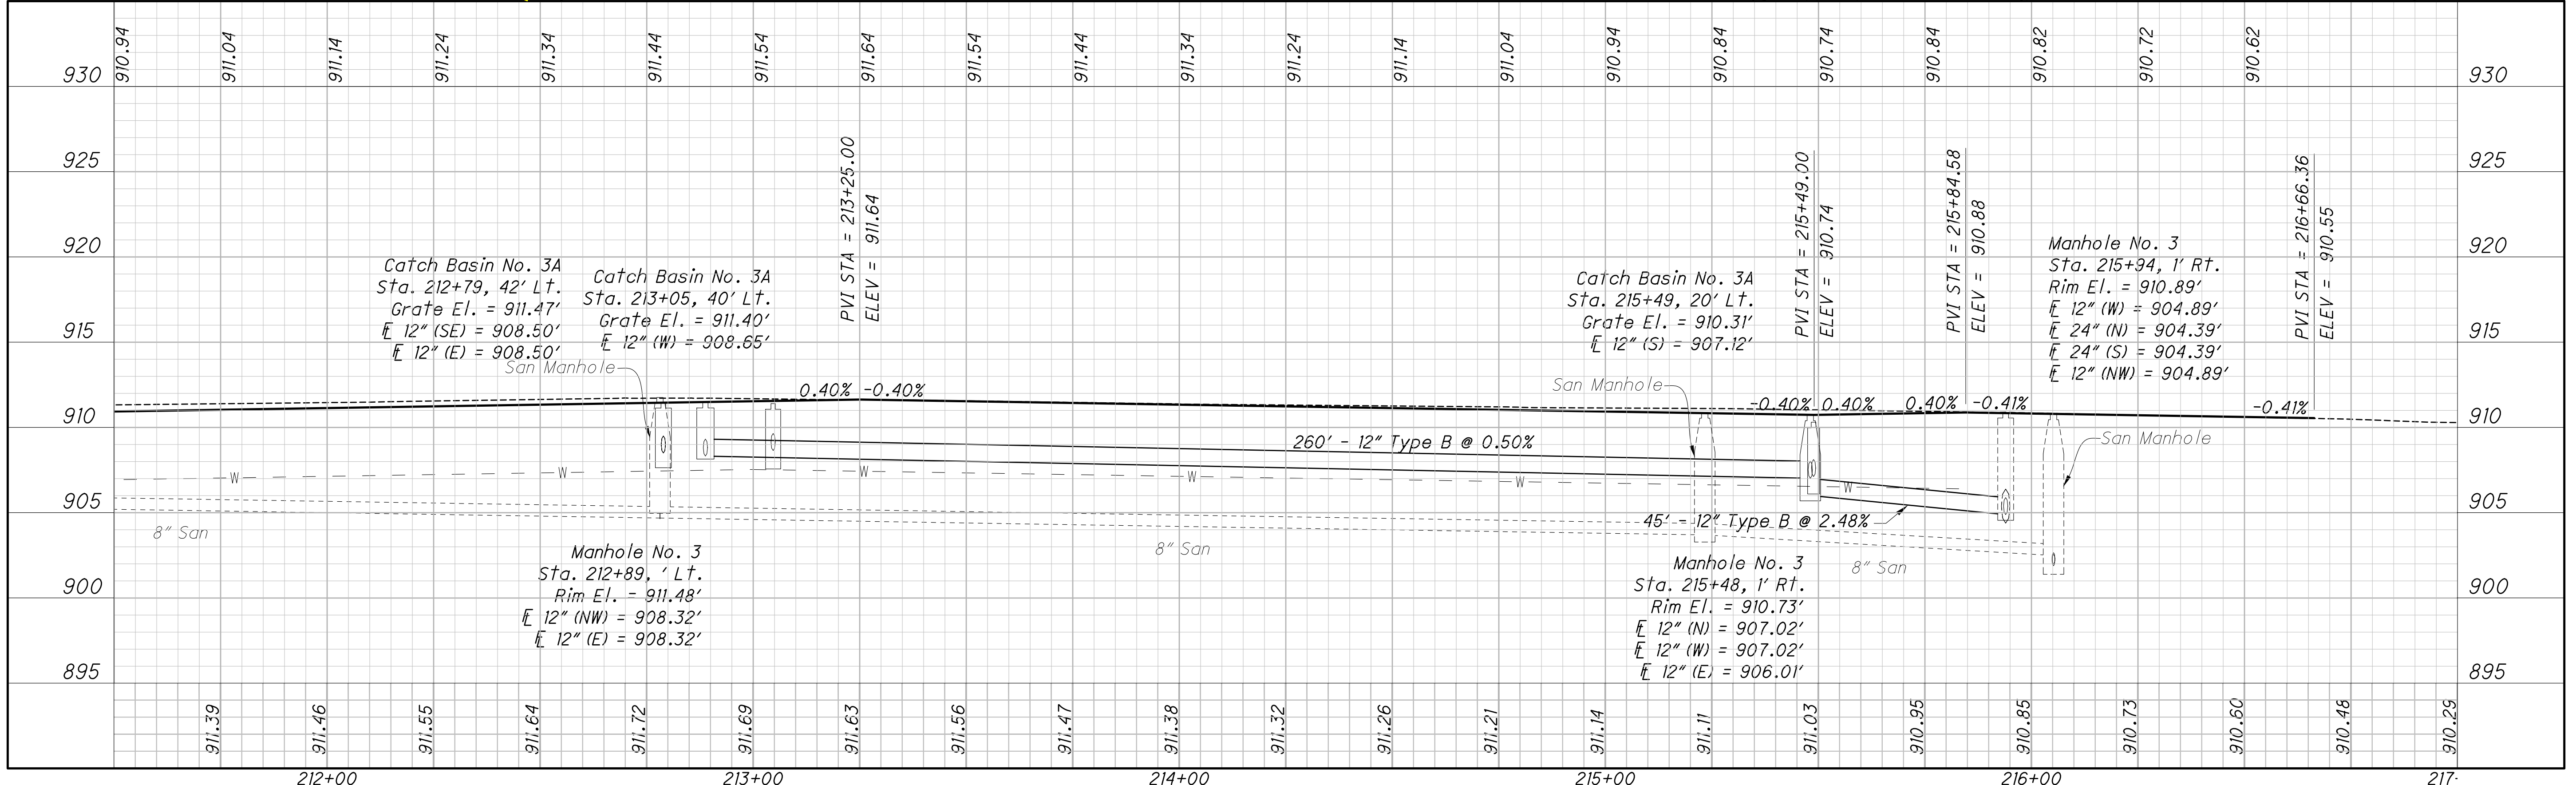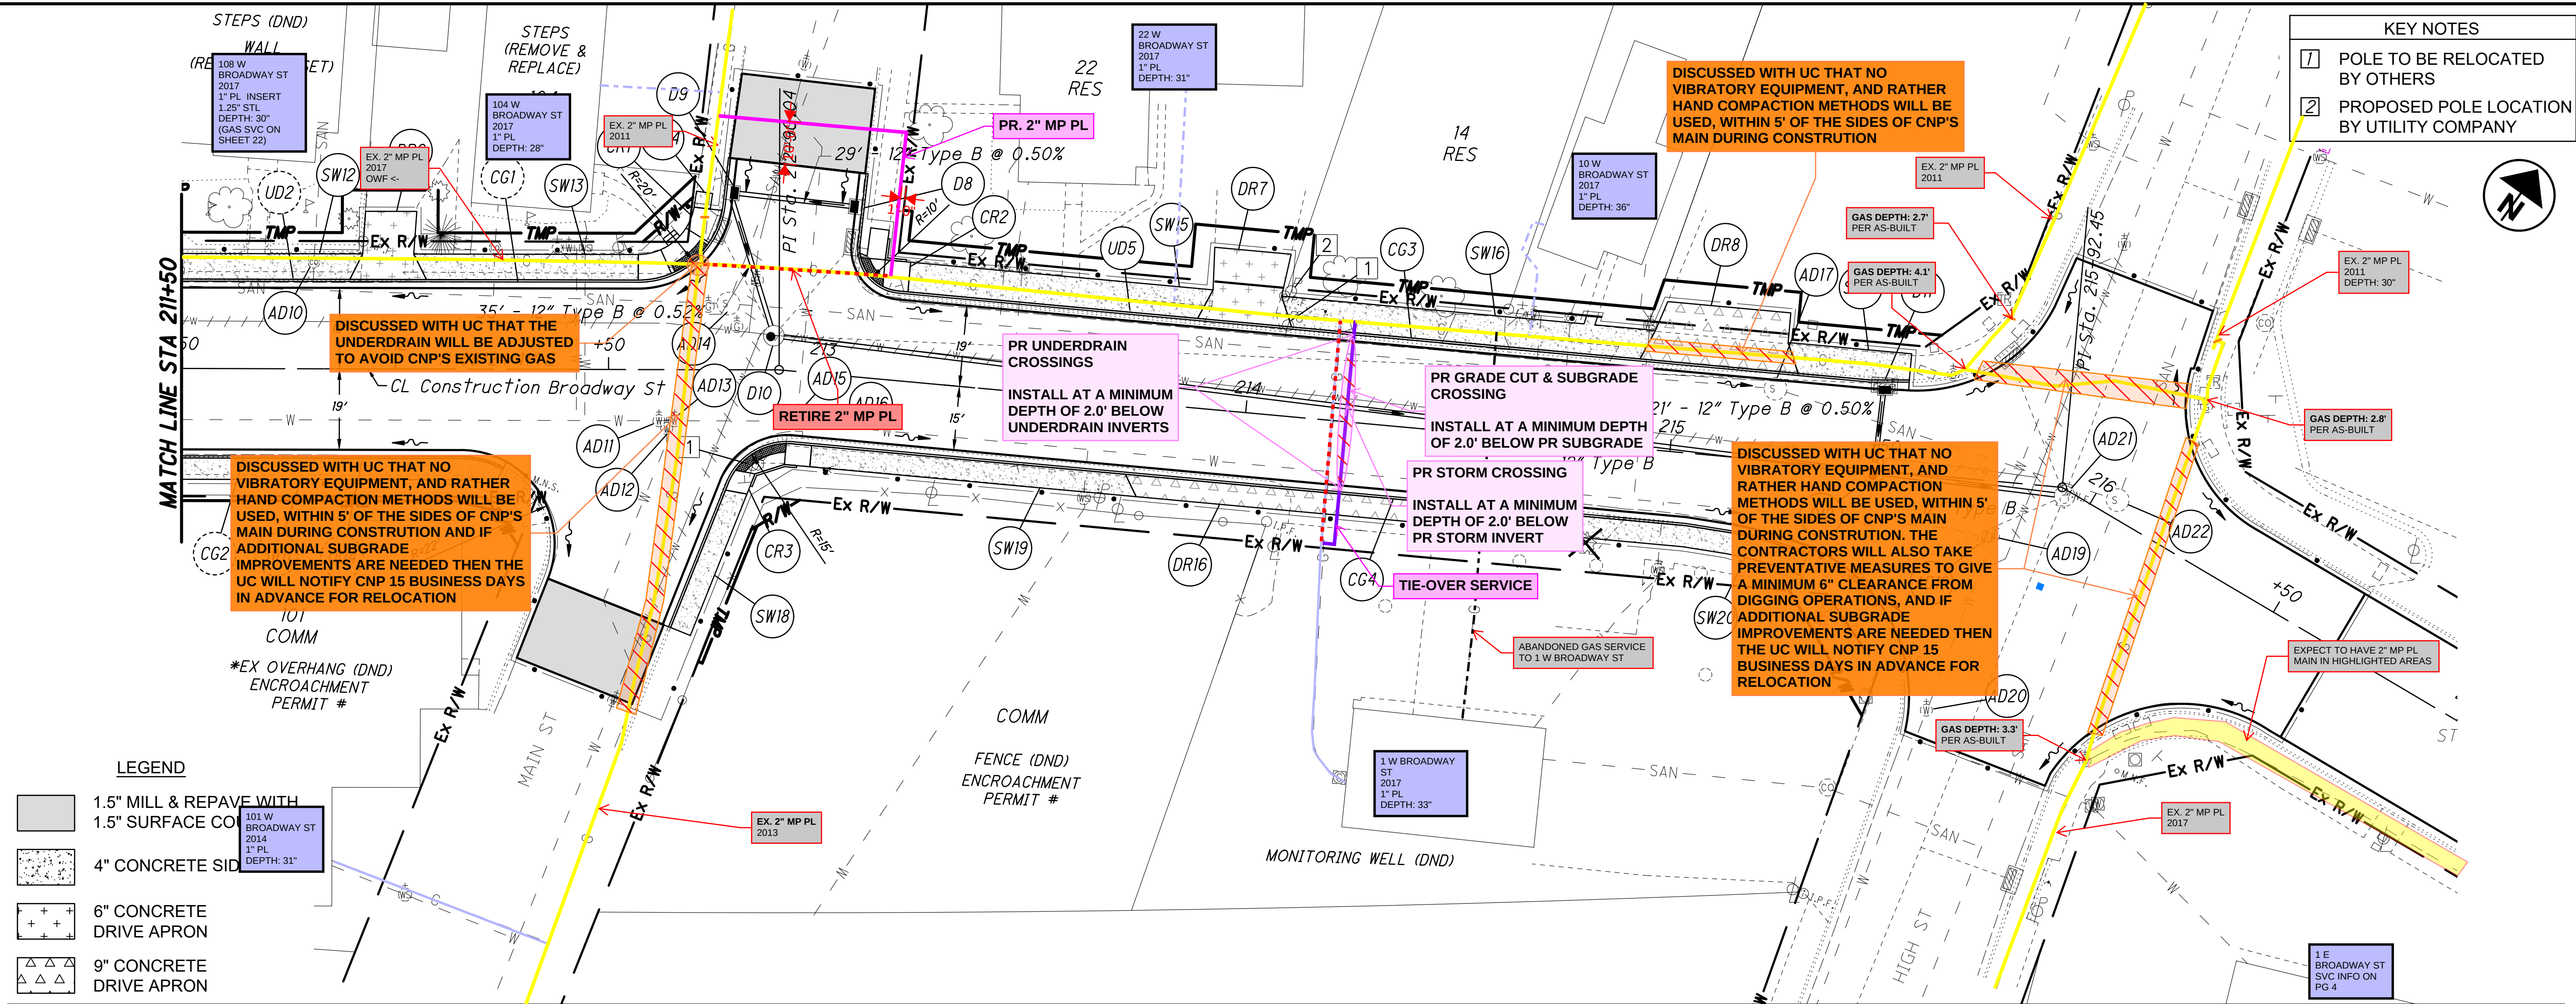

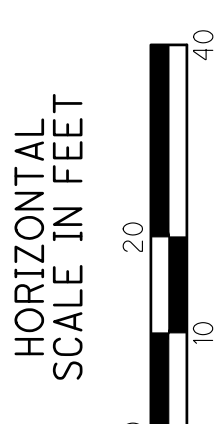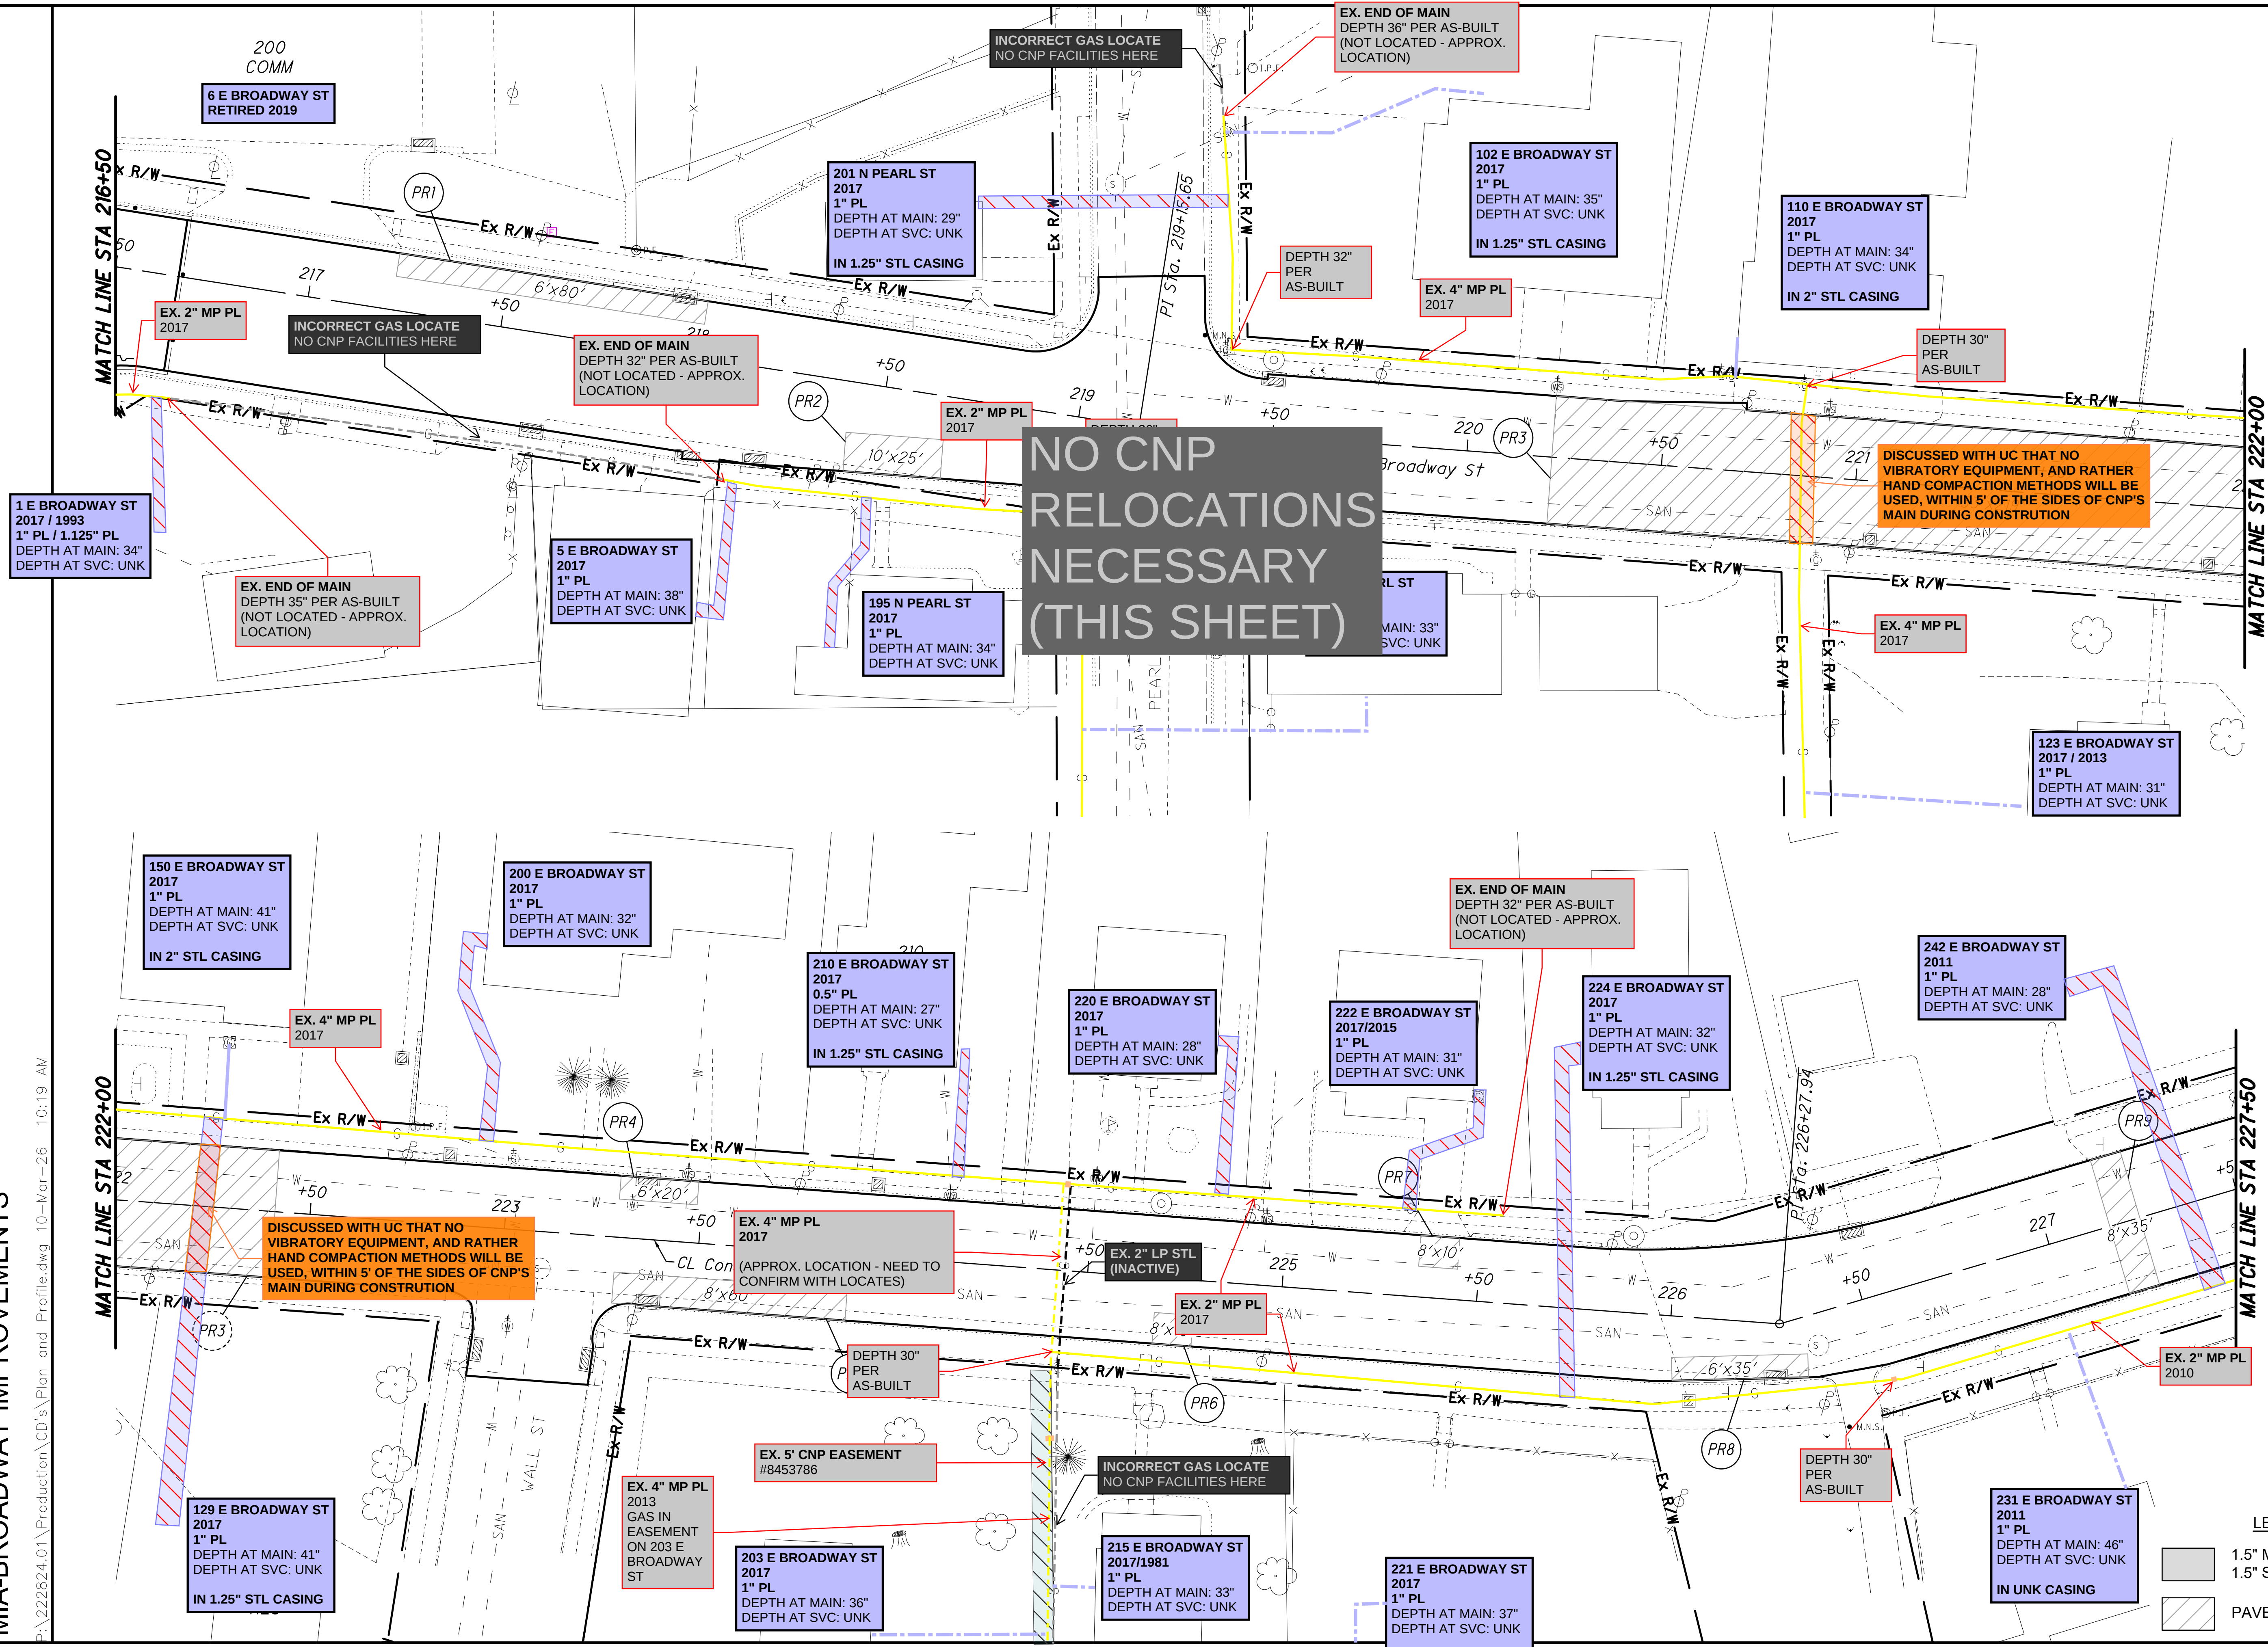


PLAN & PROFILE
STA 216+50 - 227+50

LEGEND


	1.5" MILL & REPAVE WITH 1.5" SURFACE COURSE
	PAVEMENT REPAIRS

DESIGNER	JTL
REVIEWER	NKT
PROJECT ID	119367
SHEET	23
TOTAL	41

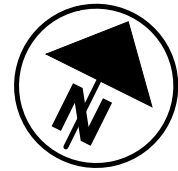

PLAN & PROFILE
STA 227+50 - 238+50

DESIGN AGENCY	
ACCESS ENGINEERING SOLUTIONS 1200 IRMSCHER BLVD., SUITE B CELINA, OHIO 45822	
DESIGNER	
JTL	
REVIEWER	
NKT	
PROJECT ID	
119367	
SHEET	TOTAL
24	41

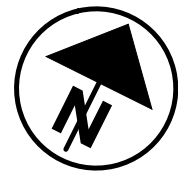

PLAN & PROFILE
STA 238+50 - 245+00

HORIZONTAL
SCALE IN FEET

DESIGN AGENCY

ACCESS ENGINEERING SOLUTIONS
1200 IRMSCHER BLVD., SUITE B
CELINA, OHIO 45822

DESIGNER
JTL

REVIEWER
NKT

PROJECT ID
119367

SHEET	TOTAL
25	4